


Drawing File: G:\Design\11700\11735-MERRIFIELD - Precinct 1 - Stage 15\Acad\RD\11735SP01.dwg - 11735SP01
Date/Time: Wed Nov 25, 2015 - 8:45am -- Byron Shode--

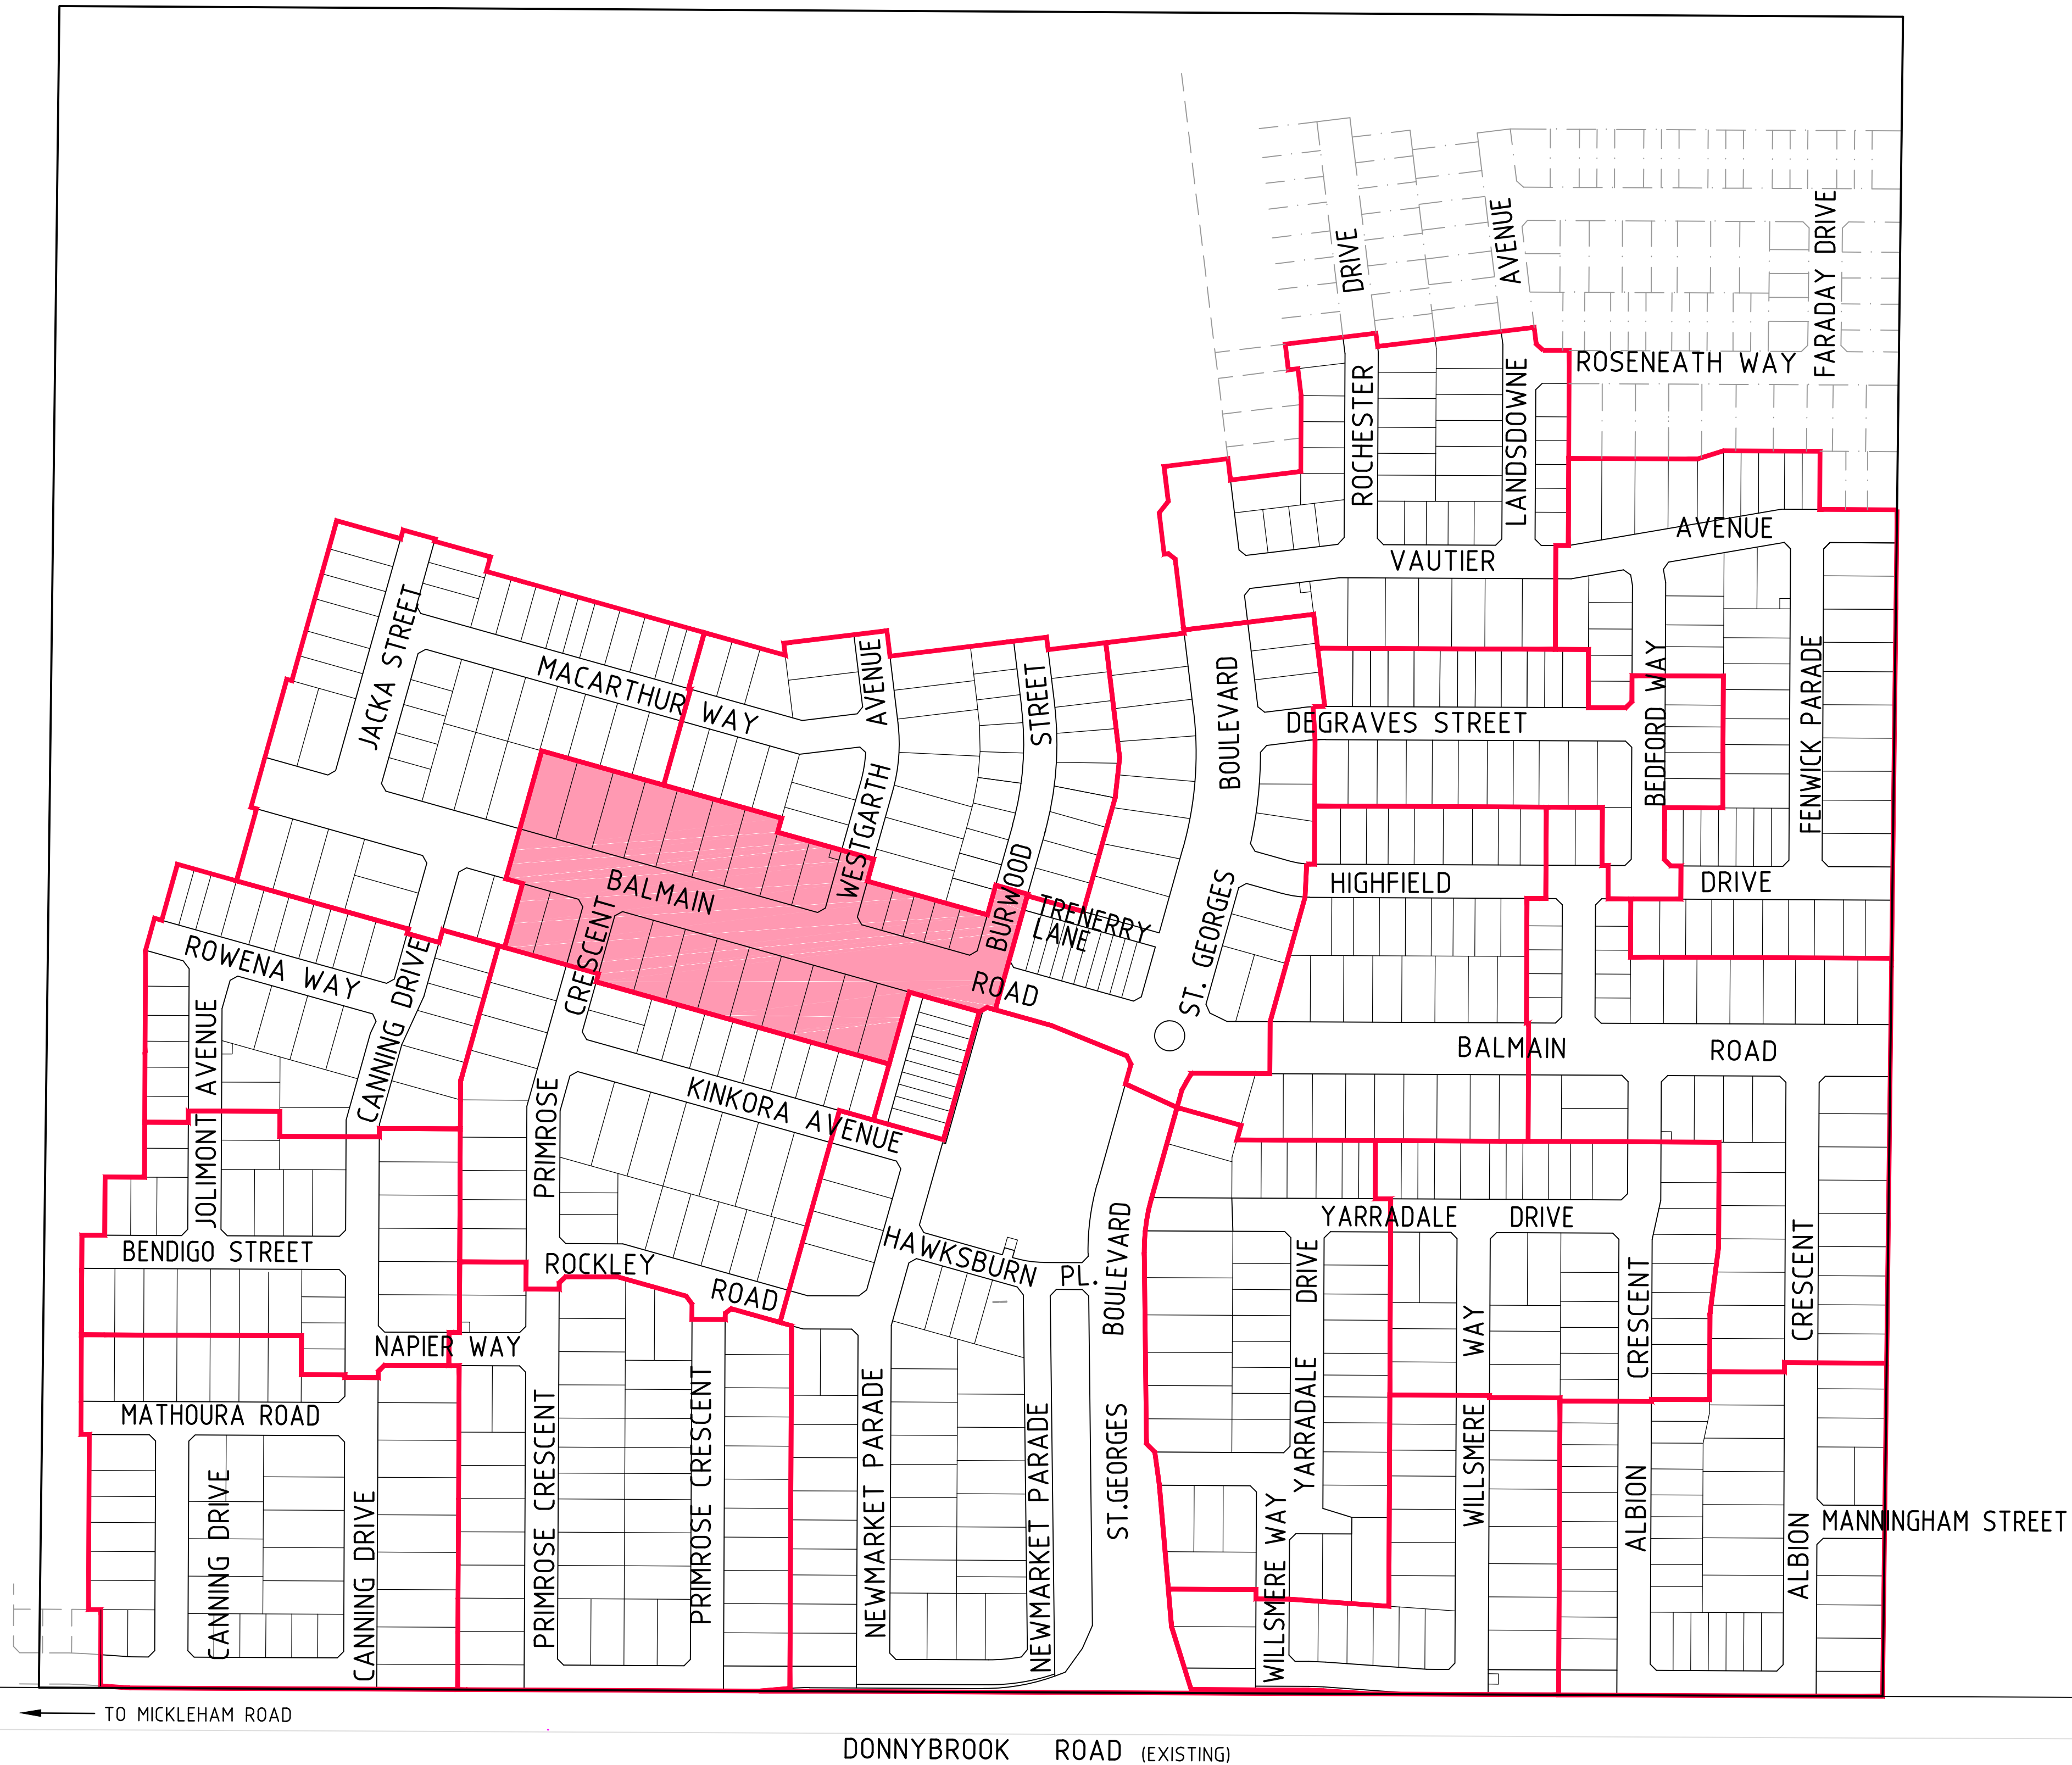


1	AS CONSTRUCTED	24/11/15	TL
0	CONSTRUCTION ISSUE	01/07/15	TL
REV	AMENDMENTS	DATE	APP'D.

Drawn M.CAPALDO
Date 11/11/14
AN 1451024
Designed N.MIRATANA
Date 15/12/14
AN 161548
Verified B.GORDON
Date 03/02/15
AN 162236
Audited R.MASON
Date 03/06/15
AN 702838
Approved T.LIAKOPOULOS
Date 01/07/15
AN 884208

Written dimensions to take precedence over scale. Contractor shall check and verify all dimensions on site. Discrepancies to be brought to the attention of the Superintendent.

AS CONSTRUCTED

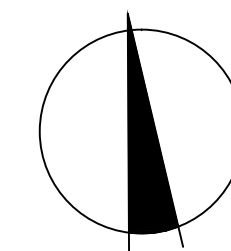

merrifield
MAB gpc

Coords: MGA
Levels: AHD
Hor 1:2000 0m 20m 40m 80m 120m
Scale @ A1/A3 1:2000\1:4000

MERRIFIELD DEVELOPMENT
DONNYBROOK ROAD, MICKLEHAM
STAGE 15
STAGING PLAN

Drawing No. 11735SP01 Rev 1
Sheet No. 03 AS CONSTRUCTED
© Dalton Consulting Engineers Pty Ltd
ABN 78 429 221 049



VICTORIA
T 61 3 9888 6866
W dceng.com.au

DALTON
CONSULTING
ENGINEERS

ABN 78 429 221 049
QUEENSLAND
T 61 7 3367 1732
E info@dceng.com.au


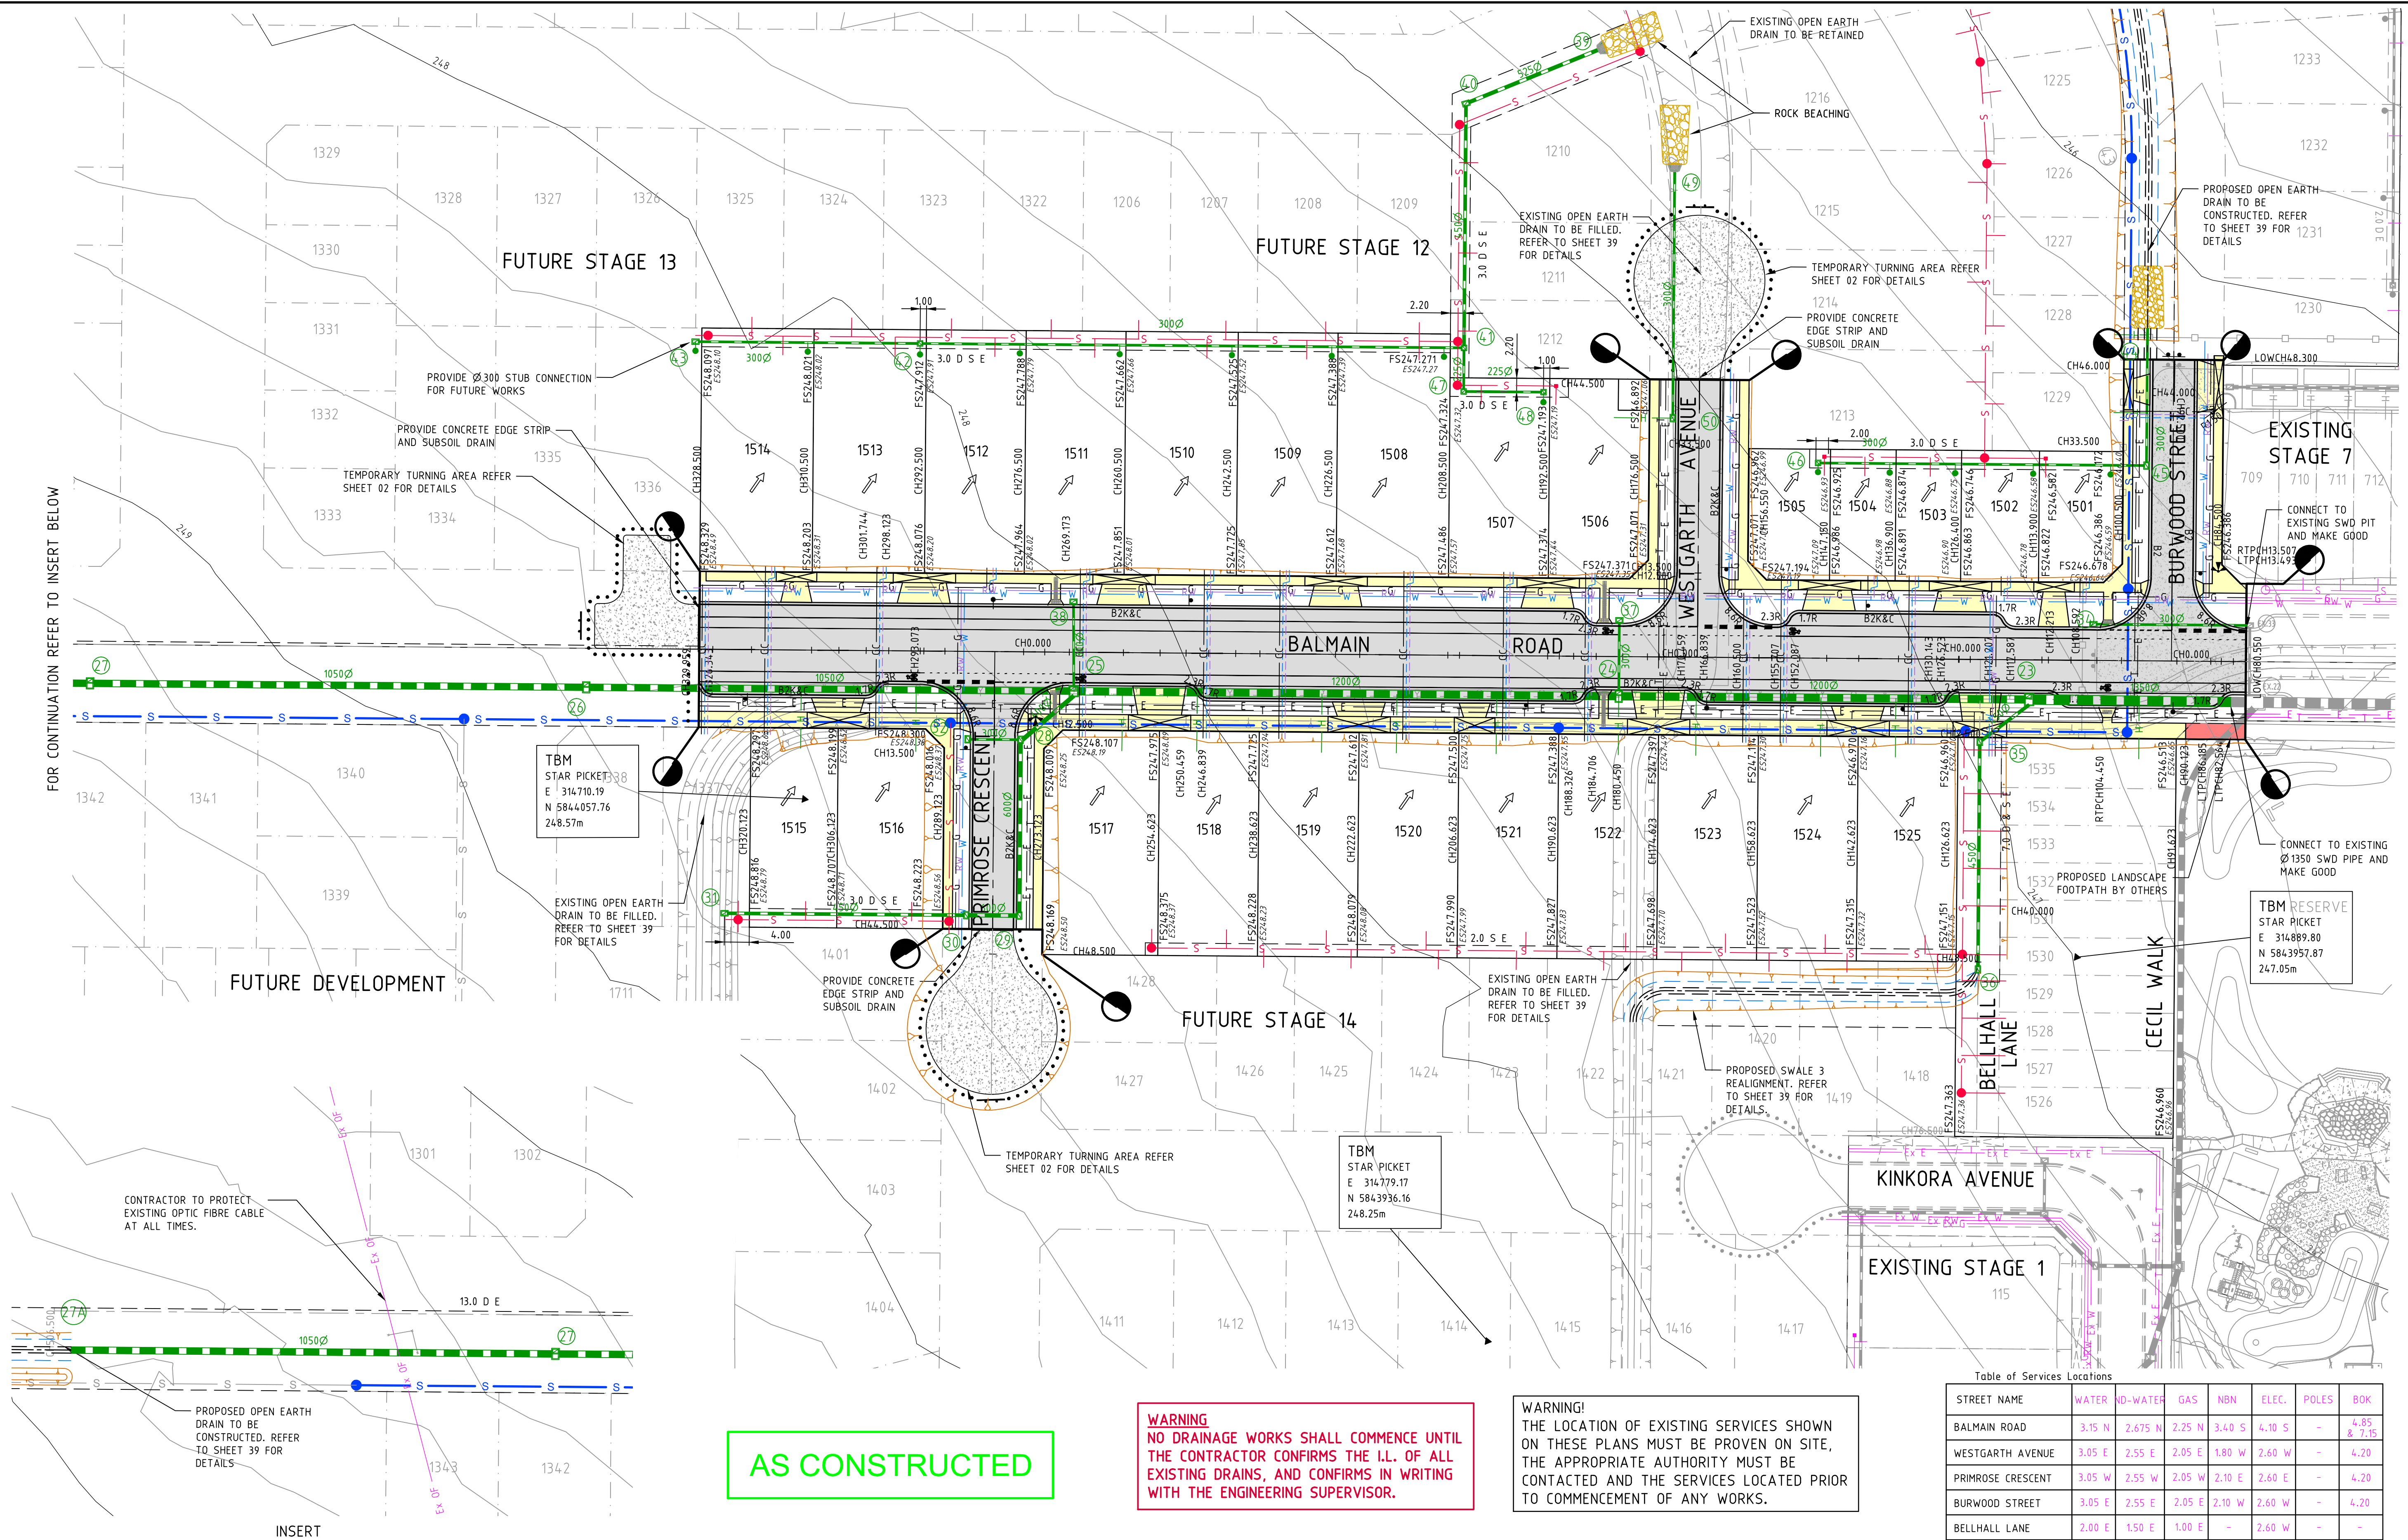


Table of Services Locations						
STREET NAME	WATER	HD-WATER	GAS	NBN	ELEC.	POLES
BALMAIN ROAD	3.15 N	2.675 N	2.25 N	3.40 S	4.10 S	-
WESTGARTH AVENUE	3.05 E	2.55 E	2.05 E	1.80 W	2.60 W	-
PRIMROSE CRESCENT	3.05 W	2.55 W	2.05 W	2.10 E	2.60 E	-
BURWOOD STREET	3.05 E	2.55 E	2.05 E	2.10 W	2.60 W	-
BELLHALL LANE	2.00 E	1.50 E	1.00 E	-	2.60 W	-

REV	AMENDMENTS	DATE	APP'D.
3	AS CONSTRUCTED	24/11/15	TL
2	PERMANENT SUVERY MARKS ADDED	17/11/15	TL
1	EXISTING OPTICAL FIBRE ADDED	24/07/15	TL
0	CONSTRUCTION ISSUE	01/07/15	TL

Drawn M.CAPALDO
Date 11/11/14
AN 1451024
Designed N.MIRATANA
Date 15/12/14
AN 1541019
Verified B.GORDON
Date 03/02/15
AN 162239
Audited R.MASON
Date 03/06/15
AN 702839
Approved T.LIAKOPOULOS
Date 01/07/15
AN 884209

- LEGEND**
- Ex W EXISTING WATER MAIN
 - Ex G EXISTING GAS MAIN
 - Ex E EXISTING ELECTRICAL CABLE
 - Ex S-O EXISTING SEWER MAIN & MANHOLE
 - Ex T-P EXISTING TELECOMM. CABLE AND PIT
 - Ex V-H EXISTING ELEC. POLE & O'HEAD LINES
 - Ex V-P EXISTING STORMWATER DRAIN & PIT
 - CONSTRUCTED PRE DEVELOPMENT
 - EXISTING TREES TO BE REMOVED
 - FINISHED SURFACE LEVEL
 - OPEN EARTH DRAIN (O.E.D.)
 - 300Ø BRANCH SEWER MAIN
 - SEWER MAIN AND MANHOLE
 - STORMWATER DRAIN & PIT
 - SW DRAIN & PIT CONSTRUCTED IN PREVIOUS STAGES
 - PROPERTY INLETS
 - HOUSE DRAIN
 - GAS CONDUIT
 - WATER CONDUIT
 - RECYCLED WATER CONDUIT
 - TELECOMM. CONDUIT
 - PERMANENT SURVEY MARK
 - W WATER
 - RW RECYCLED WATER
 - T TELSTRA/NBN
 - E ELECTRICITY
 - G GAS
 - STREET NAME SIGN
 - REGRADE LOT AT MIN 1 IN 150
 - ASPHALT PAVEMENT
 - CONC FOOTPATH / DRIVEWAY
 - LIMIT OF WORKS
 - FILLING OVER 300mm
 - FINISHED SURFACE CONTOUR

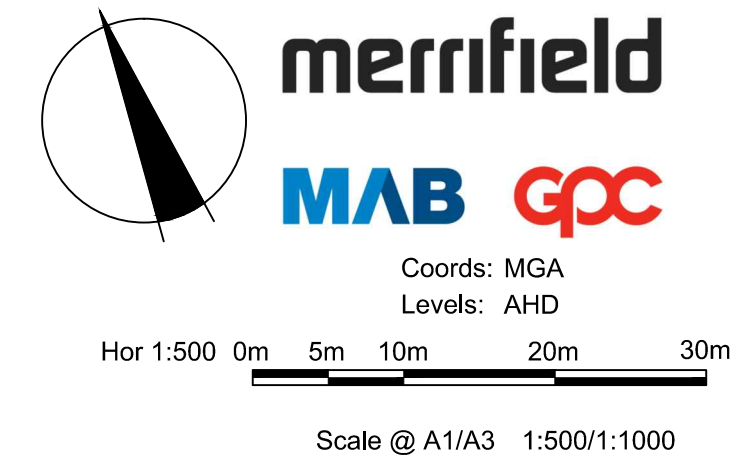

MERRIFIELD DEVELOPMENT
DONNYBROOK ROAD, MICKLEHAM
STAGE 15
DETAIL PLAN

Drawing No. 11735DP01 Rev 3
Sheet No. 04 AS CONSTRUCTED
© Dalton Consulting Engineers Pty Ltd
ABN 78 429 221 049

DALTON CONSULTING ENGINEERS
ABN 78 429 221 049
QUEENSLAND
T 61 7 3367 1732
E info@dceng.com.au

VICTORIA
T 61 3 9888 6866
W dceng.com.au