

# MERRIFIELD DEVELOPMENT

STAGE 19

DONNYBROOK ROAD, MICKLEHAM

HUME CITY COUNCIL

FOR

merrifield



CIVIL DRAWINGS  
ROAD AND DRAINAGE

DCE REF : 11739RD

AS CONSTRUCTED





ABN 78 429 221 049  
VICTORIA  
T 61 3 9813 7400  
W dceng.com.au  
QUEENSLAND  
T 61 7 3374 9000  
E info@dceng.com.au



- ALL WORKS TO BE CARRIED OUT IN ACCORDANCE WITH MPA AND HUME CITY COUNCIL STANDARD DRAWINGS, SPECIFICATIONS, APPROVED PLANS AND TO THE SATISFACTION OF THE SUPERINTENDENT, THE CHIEF EXECUTIVE OFFICER AND/OR THEIR REPRESENTATIVE. ALL WORKS TO BE IN ACCORDANCE WITH AS4000 AMENDED GENERAL CONDITIONS OF CONTRACT AND THE ROAD & DRAINAGE SPECIFICATION.
2. COUNCIL TO BE NOTIFIED SEVEN (7) CLEAR WORKING DAYS PRIOR TO THE COMMENCEMENT OF WORKS WITH A PRE-COMMENCEMENT MEETING BEING HELD BETWEEN HUME CITY COUNCIL, THE CONSULTANT AND THE CONTRACTOR BEFORE WORKS COMMENCE. A SITE MANAGEMENT PLAN IS TO BE SUBMITTED PRIOR TO COMMENCEMENT OF WORKS AND PRIOR TO AN ONSITE PRE-COMMENCEMENT MEETING.
3. PRIOR TO COMMENCEMENT OF THE WORKS, THE CONTRACTOR SHALL PROVIDE THE FOLLOWING INFORMATION:
  - (A) SOURCE OF QUARRY MATERIAL.
  - (B) N.A.T.A APPROVED TEST RESULTS FOR THE F.C.R. THAT IS TO BE USED.
  - (C) IF THE SOURCE OF THE QUARRY MATERIAL IS CHANGED DURING THE COURSE OF THE WORKS, THE NEW TEST RESULTS SHALL BE PROVIDED.
4. PRIOR TO COMMENCEMENT OF WORKS ON SITE, THE CONTRACTOR MUST ENSURE THAT ALL MATTERS RELATING TO THE OCCUPATIONAL HEALTH AND SAFETY ACT 2004 AND OHS REGULATIONS 2007 HAVE BEEN AND WILL BE COMPLIED WITH.
5. ON COMMENCEMENT OF CONSTRUCTION WORKS, THE CONTRACTOR MUST COMPLY WITH THE RECOMMENDATIONS OF THE ENVIRONMENTAL PROTECTION AUTHORITY PUBLICATION "CONSTRUCTION TECHNIQUES FOR SEDIMENT POLLUTION CONTROL." APPROPRIATE SILTATION CONTROL IS TO BE MAINTAINED THROUGHOUT THE CONSTRUCTION AND MAINTENANCE PERIOD FOR THE WORKS.
6. THE DISPOSAL SITE FOR SPOIL REMOVAL FROM SITE AND TRUCK ROUTE IS TO BE SUBMITTED TO AND APPROVED BY THE CHIEF EXECUTIVE OFFICER AND/OR THEIR REPRESENTATIVE AS PER THE HOLD POINTS IN THE HUME CITY COUNCIL SPECIFICATIONS IN WRITING PRIOR TO THE COMMENCEMENT OF ANY WORKS.
7. WHERE WORKS ARE IN THE VICINITY OF EXISTING SERVICES, THESE SERVICES ARE TO BE LOCATED AND EXPOSED/PROVED PRIOR TO COMMENCEMENT OF WORKS, AND THE RELEVANT AUTHORITIES NOTIFIED SEVEN (7) CLEAR DAYS PRIOR TO THE COMMENCEMENT OF THE WORKS
8. ALL DIMENSIONS ARE IN METRES UNLESS NOTED OTHERWISE.
9. ALL LEVELS ARE TO AUSTRALIAN HEIGHT DATUM (AHD).
10. ALL COORDINATES ARE TO MAP GRID OF AUSTRALIA (MGA).
11. THE CONTRACTOR MUST ARRANGE THE REQUISITE INSPECTIONS OF THE WORKS WITH THE CHIEF EXECUTIVE OFFICER AND/OR THEIR REPRESENTATIVE AS PER THE HOLD POINTS IN THE MPA MANUAL AND HUME CITY COUNCIL SPECIFICATIONS.
12. FILL AREAS ARE TO BE STRIPPED OF TOPSOIL, FILLED, AND TOPSOIL REPLACED TO OBTAIN THE FINAL FILL LEVELS SHOWN ON PLAN. FILLING IS TO BE CLEAN CLAY COMPACTED TO A DENSITY NOT LESS THAN 95% OF THE MAXIMUM DRY DENSITY VALUE DETERMINED BY THE STANDARD COMPACTION TEST IN ACCORDANCE WITH AS1289.5.1.1-2003.
13. FILLING TO COMPLY WITH AS3798-2007, LEVEL 1 UNLESS SPECIFIED OTHERWISE.
14. THE CONTRACTOR IS RESPONSIBLE FOR ENSURING THAT ALL IMPORTED FILL MATERIAL, INCLUDING TOPSOIL, SATISFIES THE DESCRIPTION FOR CLEAN FILL MATERIAL IN EPA BULLETIN PUBLICATION NO 448 (SEPT '95) AND SUBSEQUENT REVISIONS. THE CONTRACTOR SHALL IF REQUIRED PROVIDE VERIFICATION INCLUDING TEST CERTIFICATES TO THE CHIEF EXECUTIVE OFFICER AND/OR THEIR REPRESENTATIVE.
15. WHERE, AS A CONDITION OF THE PLANNING PERMIT OR AS A RESULT OF THE PRE-CONSTRUCTION MEETING, FENCING OF AREAS CONTAINING TREES, NATIVE GRASSES AND SHRUBS IS REQUIRED, A THREE STRAND STAR PICKET AND WIRE FENCE SHALL BE CONSTRUCTED.
16. NO TREES OR NATIVE VEGETATION IS TO BE DISTURBED OR REMOVED WITHOUT PRIOR APPROVAL FROM COUNCIL SUSTAINABLE ENVIRONMENT DEPARTMENT. ANY TREES REMOVED, VEGETATION OR OTHER MATERIALS ARE NOT TO BE BURNT ON SITE.
17. BEFORE COMMENCING WORK ON TRENCHES IN EXCESS OF 1.5M DEEP, NOTICE OF SUCH PROPOSAL IS TO BE FORWARDED BY THE CONTRACTOR TO WORKSAFE VICTORIA.
18. THE CONTRACTOR IS TO OBTAIN A BUILDING PERMIT FOR ANY STRUCTURE/FENCES AND FOR ANY RETAINING WALLS OVER 1.0M IN HEIGHT.
19. ANY INFRASTRUCTURE DAMAGE DURING THE DEFECTS LIABILITY PERIOD IS THE RESPONSIBILITY OF THE DEVELOPER OR HIS REPRESENTATIVE AND IS TO BE REINSTITED TO THE SATISFACTION OF THE CHIEF EXECUTIVE OFFICER OR HIS REPRESENTATIVE.
20. ALL DISTURBED AREAS, ie, NATURESTRIPS, BATTERS, ALLOTMENTS & RESERVES, ARE TO BE REINSTITED TO A CLEAN, TIDY CONDITION, TOP DRESSED (100mm LOAMY TOP SOIL FREE OF CLUMPS, SODS AND CLAY LUMPS) AND SOWN WITH GRASS SEED. SEED IS TO BE A DROUGHT TOLERANT COUGH/FESCUE MIX UNLESS OTHERWISE DETAILED. BLEND IS GENERALLY AS FOLLOWS:  
90% DROUGHT TOLERANT PERENNIAL RYE  
10% KIKUYU  
  
NOTE: GRASS IS TO BE ESTABLISHED PRIOR TO THE END OF THE MAINTENANCE PERIOD OR UNLESS OTHERWISE AGREED.
21. FOOTPATHS TO BE OFFSET 50mm FROM THE TITLE BOUNDARIES UNLESS NOTED OTHERWISE. VEHICLE CROSSING ALIGNMENTS ARE GENERALLY TO BE PARALLEL TO THE SIDE BOUNDARY.

22. ALL NEW CONCRETE WORKS SHALL BE JOINED INTO ABUTTING EXISTING CONCRETE WITH 450MM LONG Y20 DOSEL BARS @ 600 CENTERS, UNLESS OTHERWISE SPECIFIED.
23. ANY EXPOSED AGGREGATE CONCRETE WORKS TO BE ACHIEVED BY SAND-BLASTING ONLY. WASHING AGGREGATE OFF WITH WATER IS NOT PERMITTED.
24. ALL SERVICE CONDUITS TRENCHES UNDER ROAD PAVEMENTS ARE TO BE BACKFILLED WITH 20MM 3% CEMENT TREATED CLASS 3 CRUSHED ROCK COMPACTED TO A DENSITY NOT LESS THAN 95% OF THE MAXIMUM DRY DENSITY VALUE DETERMINED BY THE MODIFIED COMPACTION TEST IN ACCORDANCE WITH A51289.5.2.1-2003. ALL SERVICE CONDUITS TRENCHES UNDER FOOTPATH, VEHICULAR CROSSINGS, PARKING BAYS AND WITH 750MM OF PARKING BAYS TO BE BACKFILLED WITH CLASS 3 CRUSHED ROCK.
25. ALL STORMWATER DRAINS ARE TO BE CLASS '2' RC OR RIGID FRC PIPES WITH ADCOL FLEXIBLE COLLARS UNLESS NOTED OTHERWISE. ALL PIPES UP TO AND INCLUDING 750mm DIA. ARE TO BE RUBBER RING JOINTED. INTERLOCKING/PLUSH JOINTS WITH EXTERNAL BANDS CAN ONLY BE USED ON PIPE SIZES OVER 750mm DIA.
26. WHERE NEW ASPHALT, CONCRETE K & C, PATHS AND DRIVEWAYS MATCH INTO EXISTING, THE EXISTING SURFACE IS TO BE SAW CUT AND MATCHED NEATLY.
27. ALL REDUNDANT ASSETS ARE TO BE REMOVED AND DISPOSED OFF SITE.
28. ALL TREES AND SHRUBS ARE TO BE RETAINED UNLESS OTHERWISE SHOWN OR DIRECTED BY THE CHIEF EXECUTIVE OFFICER AND/OR THEIR REPRESENTATIVE.
29. AT THE COMPLETION OF ALL WORKS, ALL RUBBISH DEBRIS AND SURPLUS SPOT SHALL BE REMOVED AND THE SITE SHALL BE CLEARED TO THE SATISFACTION OF THE CHIEF EXECUTIVE OFFICER AND/OR THEIR REPRESENTATIVE.
30. ALL DRAINS BEHIND KERB AND CHANNEL SHALL BE BACKFILLED TO MATCH PAVEMENT SUBGRADE LEVEL WITH 20mm CLASS 2 F.C.R COMPACTED TO 95% OF THE MAXIMUM DRY DENSITY VALUE DETERMINED BY THE MODIFIED COMPACTION TEST IN ACCORDANCE WITH AS 1289.5.2.1-2003. ALL DRAINS, SEWER, GAS & WATER MAINS LAID THROUGH THE ROAD PAVEMENT (EXCEPT CUNTS) ARE TO BE BACKFILLED WITH 20mm CLASS 2 F.C.R COMPACTED TO 98%OF THE MAXIMUM DRY DENSITY VALUE DETERMINED BY THE MODIFIED COMPACTION TEST IN ACCORDANCE WITH AS 1289.5.2.1-2003.
31. PAVEMENT DEPTH SPECIFIED IS A MINIMUM DEPTH AND MAY BE VARIED BY THE CHIEF EXECUTIVE OFFICER AND/OR THEIR REPRESENTATIVE. SOFT SPOTS SHALL BE EXCAVATED TO A PROOF ROLLED BASE AND BACKFILLED WITH APPROVED MATERIAL COMPACTED IN 150MM LAYERS TO ACHIEVE TO A DENSITY NOT LESS THAN 95% OF THE MAXIMUM DRY DENSITY VALUE DETERMINED BY THE STANDARD COMPACTION TEST IN ACCORDANCE WITH AS1289.5.1.1-2003.
32. ALL EXISTING ASSETS AFFECTED BY THE WORKS; EG SIGNS, VEHICLE CROSSINGS, FOOTPATHS, KERB AND LINEMARKING SHALL BE REINSTATED BY THE CONTRACTOR PRIOR TO THE COMPLETION OF THE WORKS TO THE SATISFACTION OF THE CHIEF EXECUTIVE OFFICER AND/OR THEIR REPRESENTATIVE.
33. ALL FIRE HYDRANTS ARE TO BE MARKED IN ACCORDANCE WITH "IDENTIFICATION OF STREET HYDRANTS FOR FIREFIGHTING PURPOSES" PUBLICATION (DEVELOPED BY (C.F.A, M.F.E.S.B & N.R.E). MARKINGS TO BE VIA BLUE PAVEMENT MARKER AND A (RED TOPPED) WHITE POST.
34. AGRICULTURAL DRAINS ARE TO BE PLACED BEHIND ALL KERB AND CHANNEL, KERB ONLY AND EDGE STRIPS IN ACCORDANCE WITH COUNCIL STANDARD DRAWING SD282.
35. ALL TABLE DRAINS AND VERGES ARE TO BE REINSTATED UPON COMPLETION OF WORKS TO THE SATISFACTION CHIEF EXECUTIVE OFFICER AND/OR THEIR REPRESENTATIVE.
36. ALL TRAFFIC CONTROL MEASURES, SIGNS AND LINEMARKING SHALL BE IN ACCORDANCE WITH AS1742 - 1, 2 & 3. STREET NAME SIGNS ARE TO BE IN ACCORDANCE WITH COUNCIL STANDARD DRAWING SD408.
37. ALL LINEMARKING PAINT SHALL BE LONG LIFE IN ACCORDANCE WITH SECTION 9.5 OF THE HUME CITY COUNCIL SPECIFICATIONS. LATERAL WORKS AND ARROWS BEING GOLD APPLIED PLASTIC TROWELLED INTO PLACE (MATERIAL DEGADUR PASTELINE) AND LONGITUDINAL LINES BEING EXTRUDED THERMOPLASTIC MATERIAL.
38. ALL SIGNS TO BE CLASS 1 HIGH INTENSITY TYPE AND COMPLY WITH THE REQUIREMENTS OF AS1743-2001.
39. HOUSE DRAIN CONNECTIONS TO 150mm DIAMETER PIPES TO BE VIA A MANUFACTURED JUNCTION PIECE. 150mm DIAMETER STORMWATER PIPES ARE TO BE HEAVY DUTY SEWER GRADE. PVC SHALL BE BACKFILLED WITH 10mm MINUS F.C.R TO 150mm ABOVE TOP OF PIPE IN ALL LOCATIONS.
40. 100mm HOUSE DRAIN CONNECTIONS TO BE LAID AT AN OFFSET OF 5.0m MINIMUM FROM THE LOW SIDE LOT BOUNDARY AND PROPERTY INLETS 1.0m FROM THE LOW CORNER OF THE LOT UNLESS OTHERWISE SHOWN.
41. BLASTING GENERALLY IS NOT ENCOURAGED, HOWEVER BLASTING MAY BE REQUIRED AS A LAST RESORT DEPENDING ON GROUND CONDITIONS. COUNCIL IS TO BE NOTIFIED IN WRITING IF ANY BLASTING IS NECESSARY. RESIDENTS LIKELY TO BE AFFECTED BY THE BLASTING AND ALL SERVICE AUTHORITIES SHALL BE NOTIFIED IN WRITING PRIOR TO WORKS COMMENCING. COPIES OF THESE NOTIFICATIONS ARE TO BE SUBMITTED TO COUNCIL. RESIDENT NOTIFICATION LETTER IS TO INCLUDE BLASTING GUIDELINES, FIRING AND MISFIRE PROCEDURES AND CONTRACTORS AND CONSULTANT CONTACT NAMES AND NUMBERS. ALL BLASTING IS TO BE WITHIN THE LIMITS FOR AIR AND GROUND VIBRATION LEVELS AS SET DOWN IN AS1287.2-1993. ALL BLASTS SHALL BE MONITORED FOR AIR AND NOISE VIBRATION AT POTENTIALLY AFFECTED RESIDENCES. FORM A" FROM AS1287.2-1993, AND WAVE TRACE COPIES ARE TO BE SUBMITTED TO COUNCIL FOR EACH BLAST. BLASTING IS TO BE RESTRICTED TO BETWEEN 9:00AM AND 3:30PM. BLASTING IS NOT TO OCCUR ON WEEKENDS OR PUBLIC HOLIDAYS. BLASTING AREA SIGNS ARE TO BE PLACED AT ALL ENTRANCES TO THE SITE.

1. ALL BLOCKS ARE TO SURFACE GRADE WITH A MINIMUM FALL OF 1 IN 150 ALONG THE LOW SIDE BOUNDARY TO THE POINT OF DISCHARGE.
2. ALL BATTERS SHALL BE 1 IN 6, UNLESS OTHERWISE SHOWN.
3. ALL CHAINAGES REFER TO ROAD RESERVE DESIGN LINES EXCEPT:
  - IN CROWN HEADS WHERE CHAINAGES REFER TO LIP OF KERB
  - KERB RETURNS WHERE CHAINAGES REFER TO LIP OF KERB.
4. GENERALLY B2 KERB AND CHANNEL IS TO BE USED THROUGHOUT THE SUBDIVISION, WHERE OTHER KERB TYPES ARE REQUIRED THEY ARE SPECIFICALLY SHOWN ON THE DRAWINGS.
5. LIP OF ALL KERB RADI ARE 8.60m UNLESS OTHERWISE SHOWN.
6. WHEN PAVEMENT EXCAVATION IS IN ROCK ALL LOOSE MATERIAL (INCLUDING ROCKS AND CLAY) MUST BE REMOVED, THE SUB-GRADE MUST THEN BE REGULATED WITH COUNCIL APPROVED MATERIAL.
7. TBMS TO BE RE-ESTABLISHED BY THE LICENSED SURVEYOR IF FOUND TO BE MISSING AT THE COMMENCEMENT OF CONSTRUCTION, THE CONTRACTOR WILL BE RESPONSIBLE FOR CARE AND MAINTENANCE OF TBMS THEREAFTER.
8. ALL EXISTING SURFACE LEVELS SHOWN ON THE ENGINEERING DRAWINGS HAVE BEEN INTERPOLATED FROM A DIGITAL TERRAIN MODEL, THESE LEVELS HAVE BEEN USED AS THE BASIS FOR ALL ENGINEERING DESIGN AND DETERMINATION OF QUANTITIES.
9. THE CONTRACTOR IS REQUIRED TO CONFINE CONSTRUCTION VEHICLES TO THE ROAD RESERVE AND EASEMENTS, ANY DAMAGE CAUSED TO ALLOTMENTS MUST BE MADE GOOD.
10. ANY BUILDINGS, TROUGHS, FENCES AND OTHER STRUCTURES ON SITE ARE TO BE REMOVED AS DIRECTED BY THE SUPERINTENDENT, THE COST OF REMOVAL IS TO BE INCLUDED IN THE OVERALL EARTHWORKS FIGURE UNLESS A SPECIFIC ITEM FOR REMOVAL IS DENOTED IN THE SCHEDULE.
11. VEHICULAR CROSSINGS OF THE TYPE INDICATED ARE TO BE OFFSET 1.5m FROM THE LOT BOUNDARY OR EASEMENT UNLESS OTHERWISE SHOWN, DRIVEWAY GRADES TO BE 1 IN 6 MAX.
12. PROVIDE LAYBACKS IN KERB TO ALL PRAM CROSSINGS IN ACCORDANCE WITH COUNCIL STANDARDS.
13. ASPHALT FILLETS/RAMPS ARE TO BE PROVIDED ON THE BASE COURSE ASPHALT TO REMOVE TRIPS AT ALL PEDESTRIAN CROSSING LOCATIONS.
14. ALL TEMPORARY WARNING SIGNS USED DURING CONSTRUCTION SHALL BE IN ACCORDANCE WITH AS 1742-3.
15. ALL EASEMENTS ARE 2.0m OR 3.0m WIDE DRAINAGE AND SEWERAGE EASEMENTS UNLESS OTHERWISE SHOWN.
16. CENTRELINES OF ALL SEWERS ARE OFFSET 1.2m OR 2.2m FROM THE PROPERTY LINE UNLESS OTHERWISE SHOWN.
17. CENTRELINES OF ALL EASEMENT DRAINS ARE OFFSET 1.0m OR 2.2m FROM THE PROPERTY LINE UNLESS OTHERWISE SHOWN.
18. WHERE CURVED PIPES ARE SHOWN ON THE DETAIL PLANS THEY ARE TO BE LAID PARALLEL TO THE BACK OF KERB, EXCEPT WHERE A RADIUS HAS BEEN SPECIFICALLY NOMINATED. ALL DRAINS BEHIND KERBS ARE TO BE LAID AT THE OFFSET SPECIFIED IN THE COUNCIL SPECIFICATION, CURVED PIPES OF DIAMETER LESS THAN 600mm ON LARGE RADIUS CURVES ARE APPROVED BY COUNCIL SUBJECT TO COMPLIANCE WITH MANUFACTURER'S SPECIFICATION.
19. ALL SIDE ENTRY PITS EXCEPT THOSE AT LOW POINTS ARE TO HAVE FLUTES AS SPECIFIED IN THE COUNCIL STANDARD DRAWINGS.
20. ALL SERVICE TRENCHES UNDER DRIVEWAYS, FOOTPATHS AND PARKING BAYS TO BE BACKFILLED WITH CLASS 2 CRUSHED ROCK, SERVICE TRENCHES LESS THAN 750mm BEHIND PARKING BAYS ARE ALSO TO BE BACKFILLED WITH COMPACTED CLASS 2 CRUSHED ROCK.
21. POSITION CONDUITS SO THAT A MINIMUM DISTANCE BETWEEN TAPPINGS IS 1.0m. CONDUITS NOT TO BE LOCATED WITHIN 4.0m OF ALLOTMENT BOUNDARY, UNLESS OTHERWISE SHOWN.
22. WATER TAPPINGS FOR LOTS SITUATED ON THE SAME SIDE AS THE WATERMAIN ARE TO BE LOCATED AT THE CENTRE OF THE LOT, THE KERB IS TO BE MARKED "w" WITH AN ARROW POINTING TO THE TAPPING.
23. GAS TO BE 50mm DIA. CLASS 12 P.V.C. & WATER CONDUITS TO BE 100 DIA. CLASS 12 P.V.C. SINGLE CONDUIT CONTAINING BOTH DW & NDW SERVICES LAID IN ACCORDANCE WITH WSA 03-2002 DUAL WATER SUPPLY SYSTEM STANDARD DRAWING WAT-1806-V
24. ELECTRICITY CONDUITS ARE TO BE LAID WITH THE FOLLOWING MINIMUM COVER TO FINISHED SURFACE LEVELS :
  - UNDER ROADS - 0.90m
  - ELSEWHERE - 0.60m
25. TACTILE GROUND SURFACE INDICATORS (TGSI'S) TO BE INSTALLED. TGSI'S ARE TO COMPLY WITH AS1428.4.
26. CROSSOVERS TO COMPLY WITH WYNDHAM CITY COUNCIL STANDARD DRAWING SD4-1 (EXCLUDING TABLE 11).
27. STREET SIGNS ARE TO BE MOUNTED ON LIGHT POLES WHERE POSSIBLE.

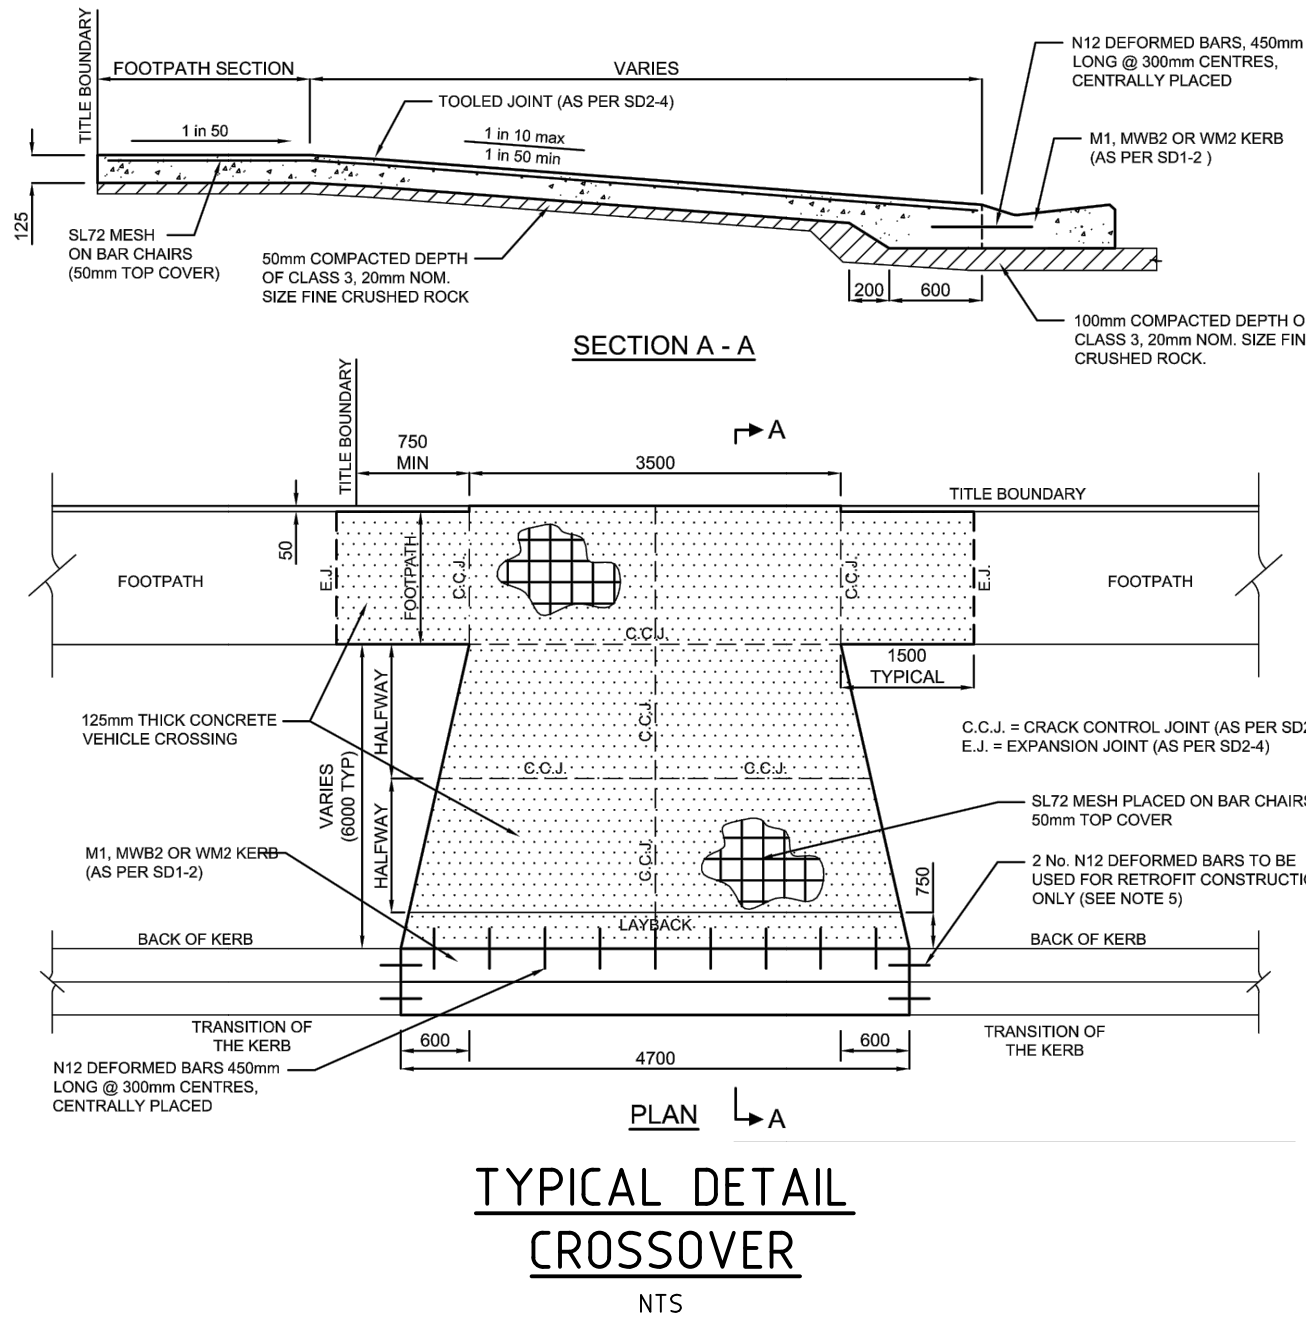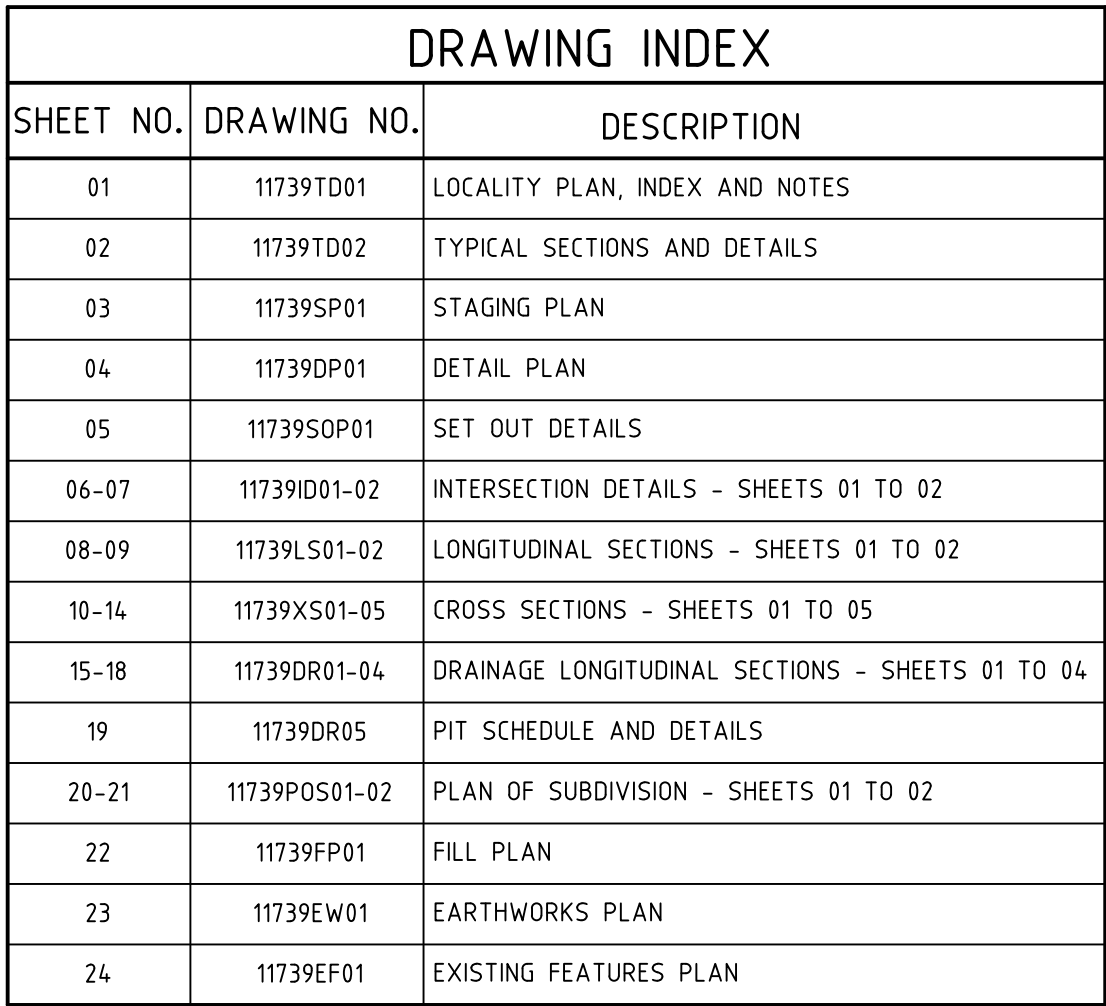

|     |                    |          |        |
|-----|--------------------|----------|--------|
| 1   | AS CONSTRUCTED     | 08/09/16 | TL     |
| 0   | CONSTRUCTION ISSUE | 03/02/16 | TL     |
| REV | AMENDMENTS         | DATE     | APP'D. |

Drawn M.CAPALDO  
Date 04/09/15  
AN 1451046  
Designed N.MIRATANA  
Date 24/06/15  
AN 1541348  
Verified B.GORDON  
Date 14/09/15  
AN 162516  
Audited T.OBOUHOFF  
Date 31/01/16  
AN 912870  
Approved T.LIAKOPOULOS  
Date 03/02/16  
AN 885193

## AS CONSTRUCTED

**merrifield**  
**MAB GPC**

Coords: MGA  
Levels: AHD

Scale @ A1/A3

**MERRIFIELD DEVELOPMENT**  
**DONNYBROOK ROAD, MICKLEHAM**  
**STAGE 19**  
**LOCALITY PLAN, INDEX, NOTES AND DETAILS**

**Drawing No.** 11739TD01      **Rev** 1  
**Sheet No.** 01      **AS CONSTRUCTED**

© Dalton Consulting Engineers Pty Ltd  
ABN 78 429 221 049














**DALTON  
CONSULTING  
ENGINEERS**

ABN 78 429 221 049

VICTORIA  
T 61 3 9813 7400  
W [dceng.com.au](http://dceng.com.au)

QUEENSLAND  
T 61 7 3374 9000  
E [info@dceng.com.au](mailto:info@dceng.com.au)



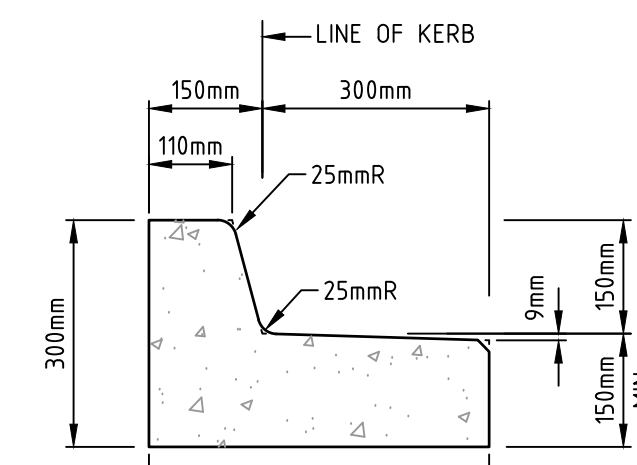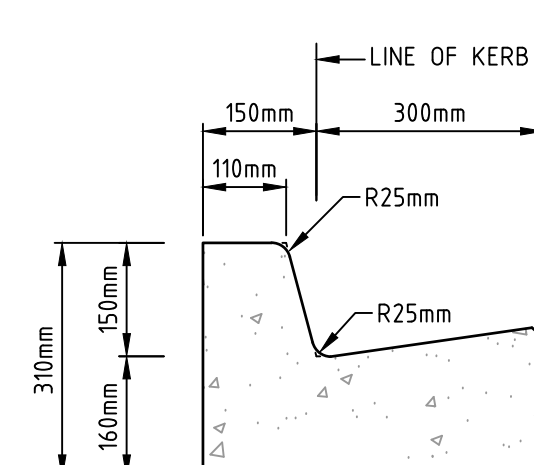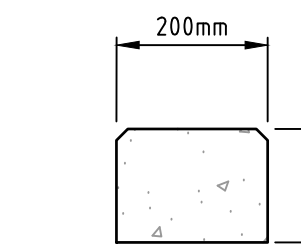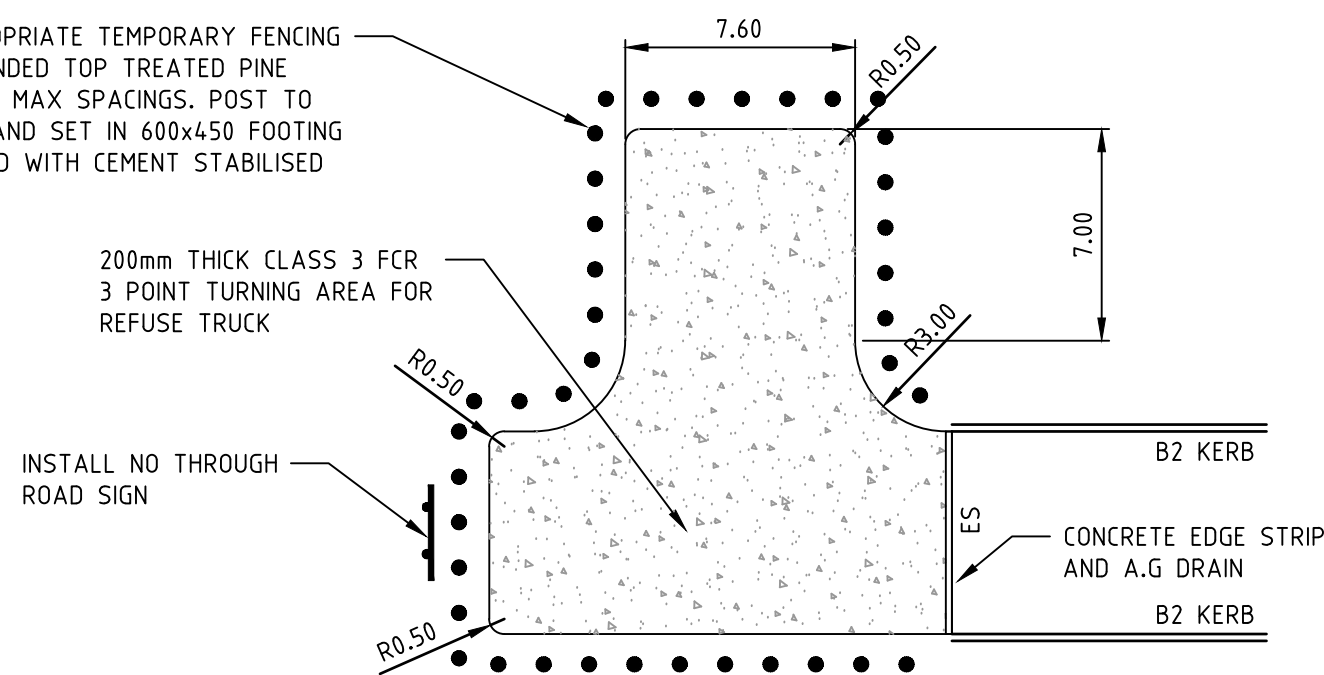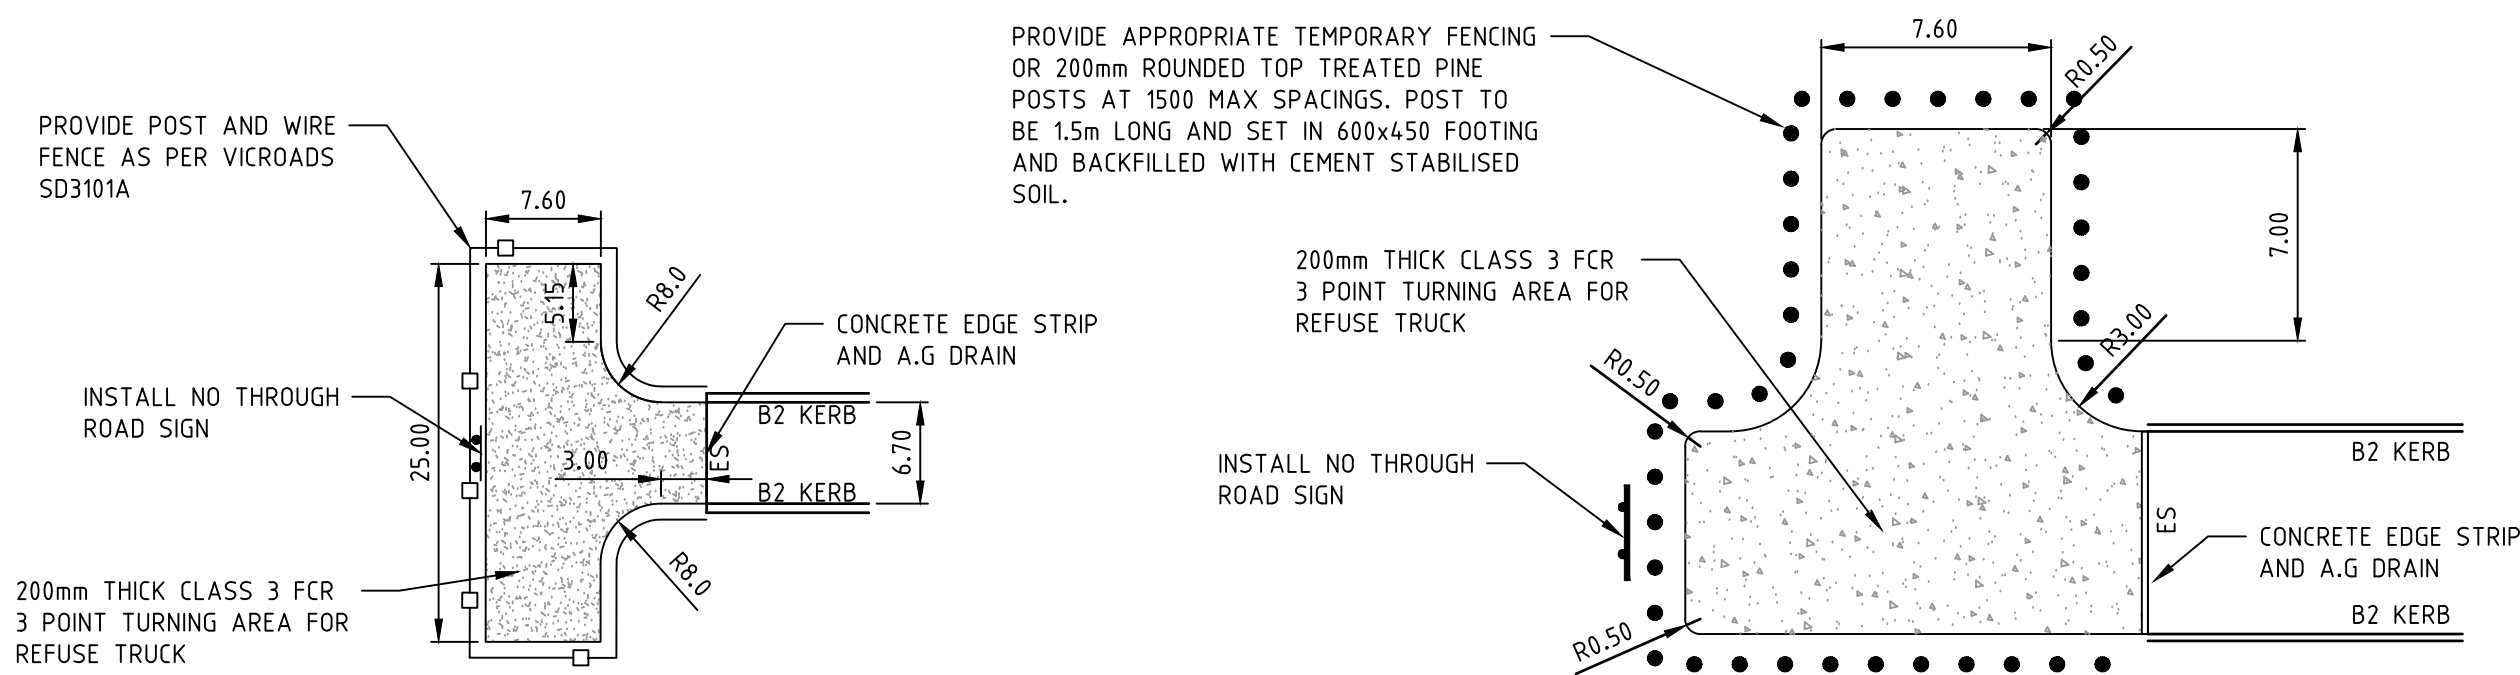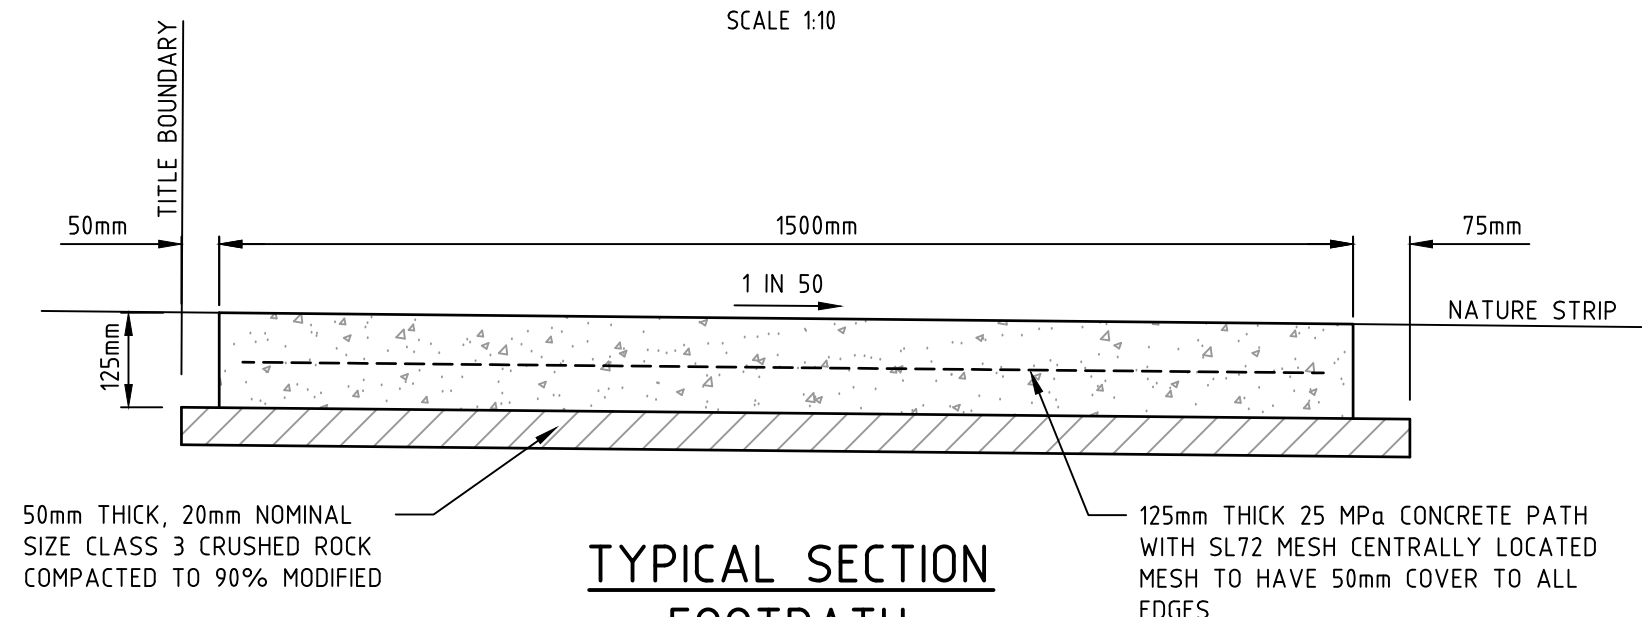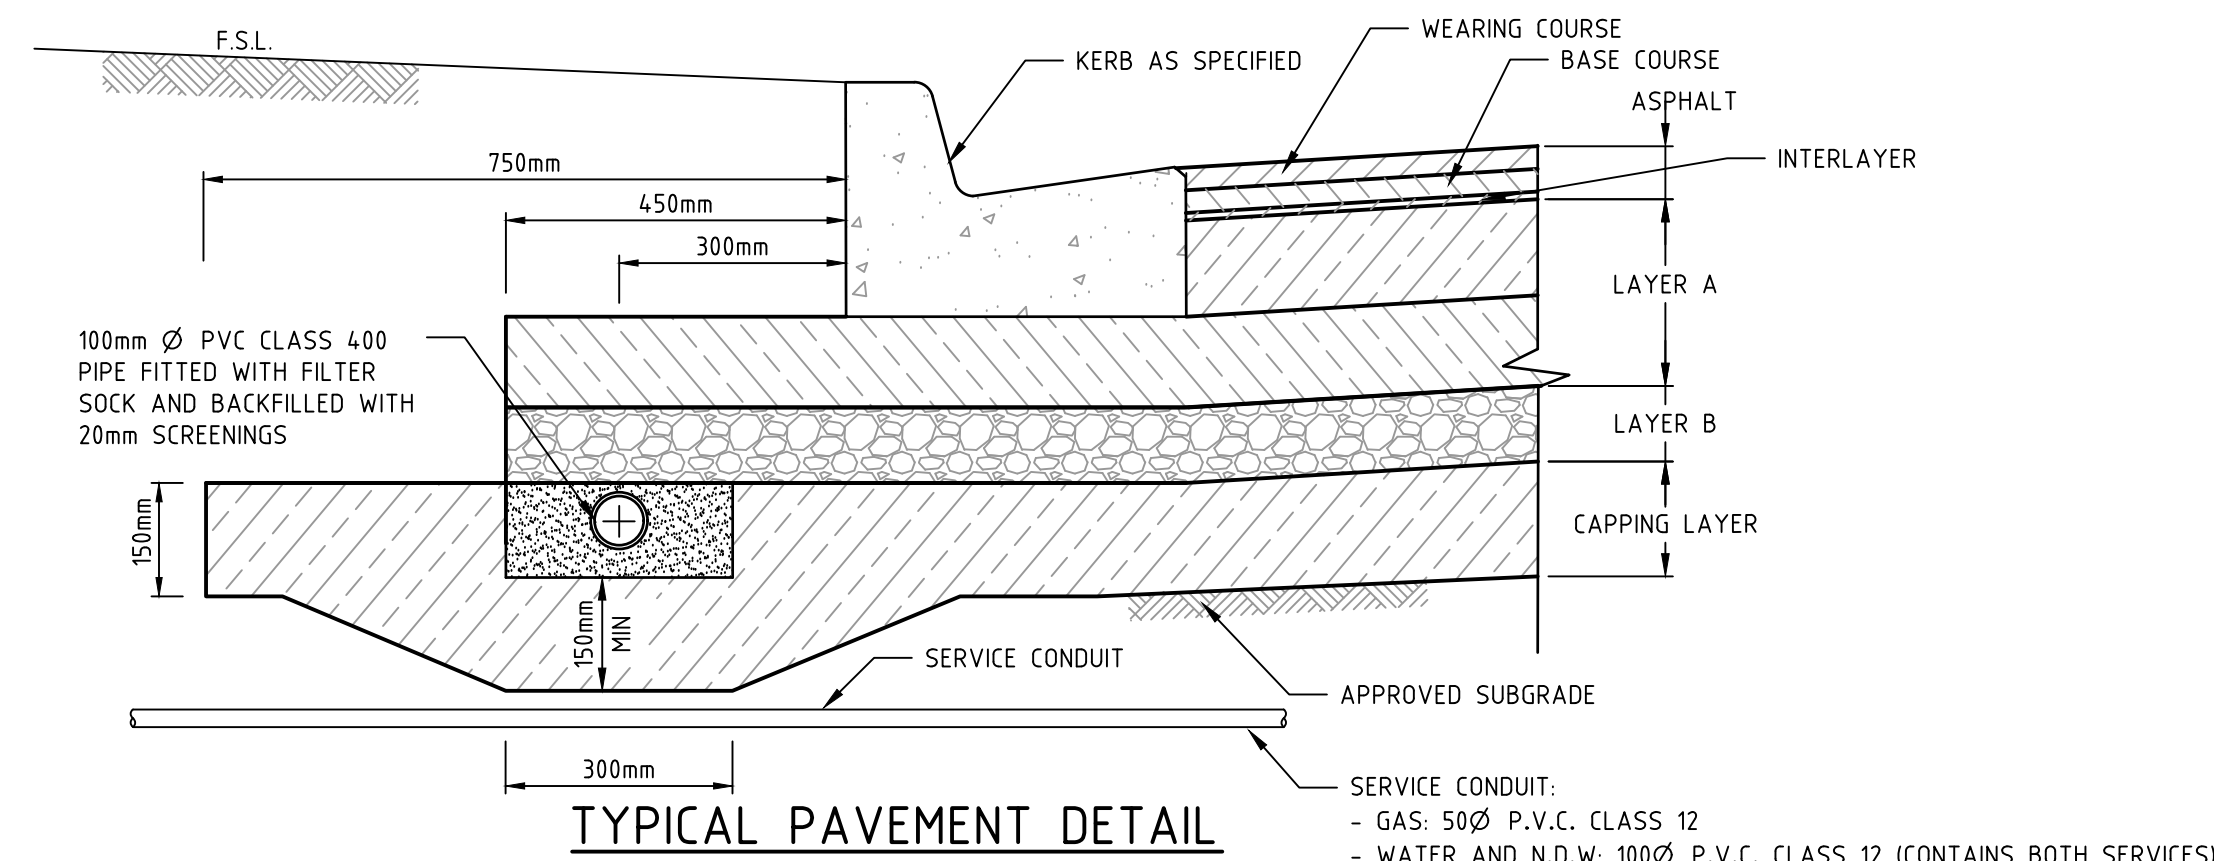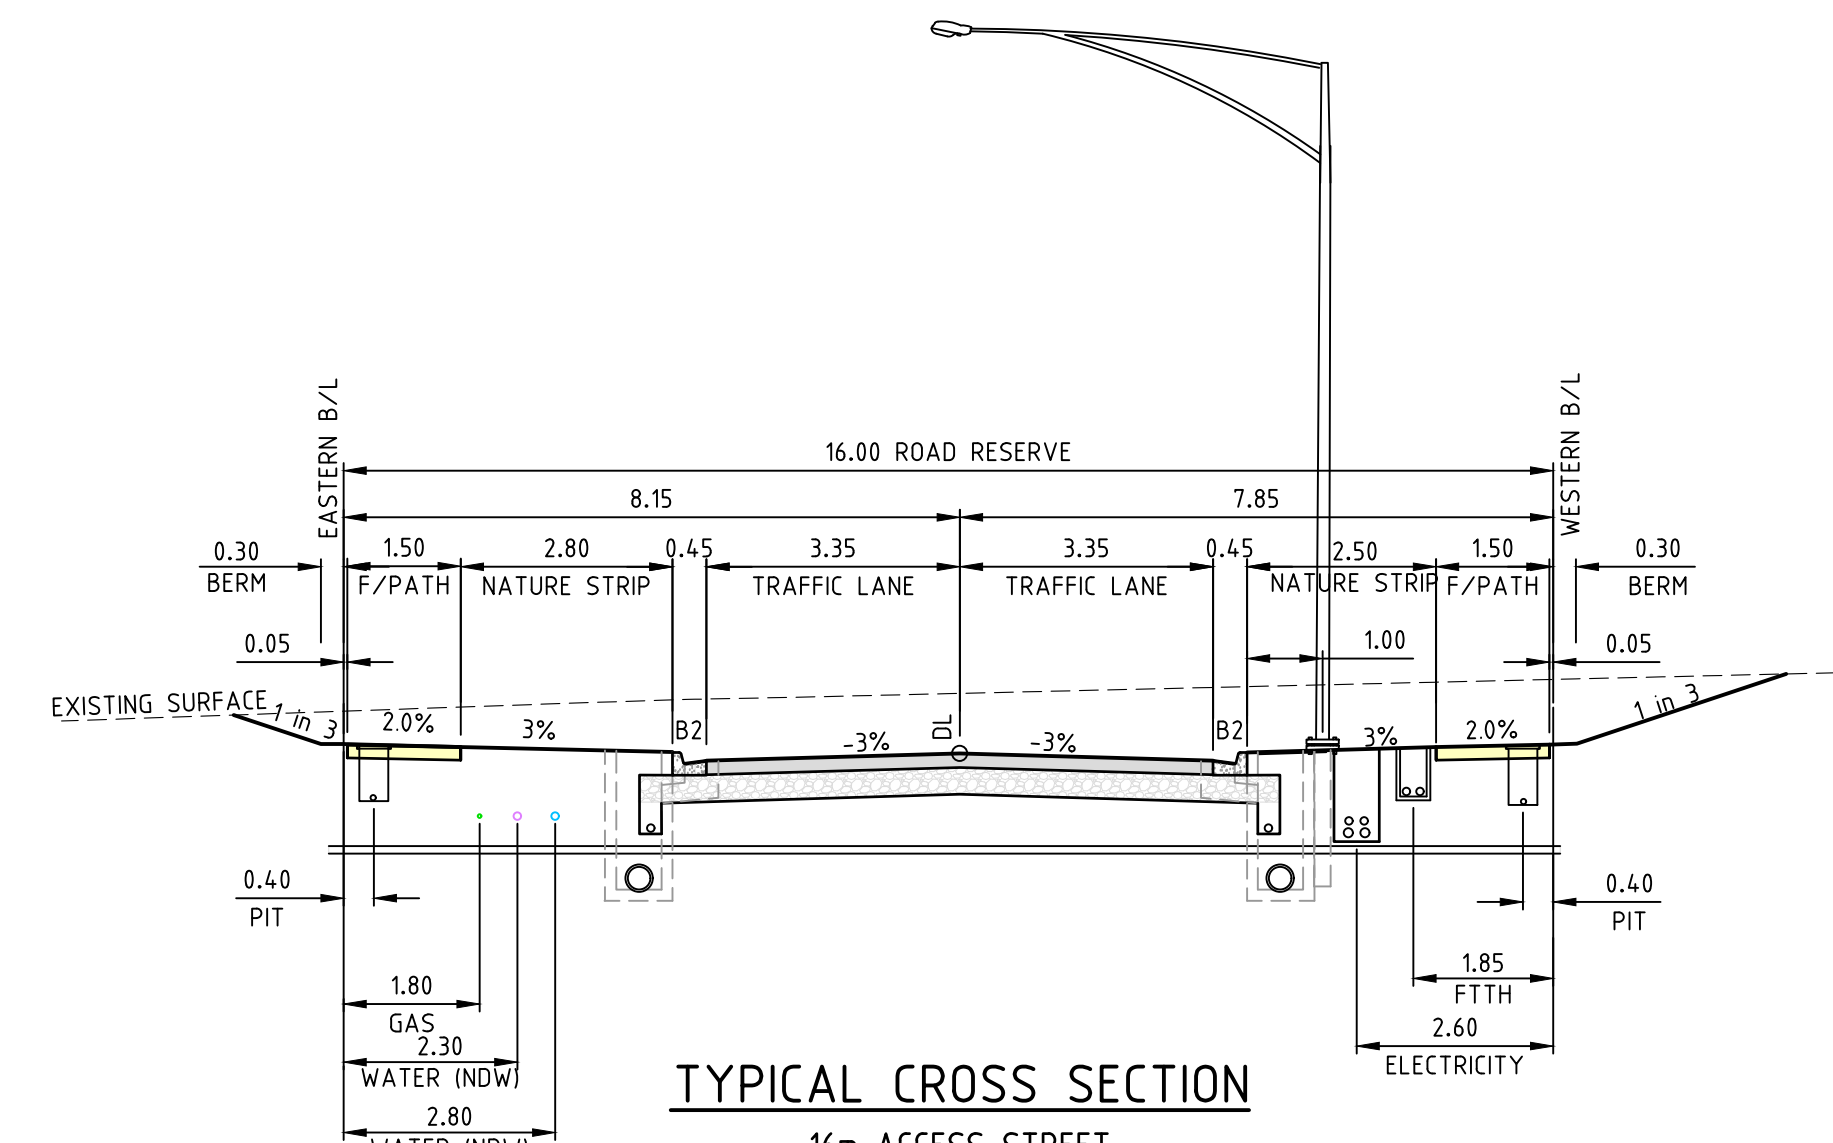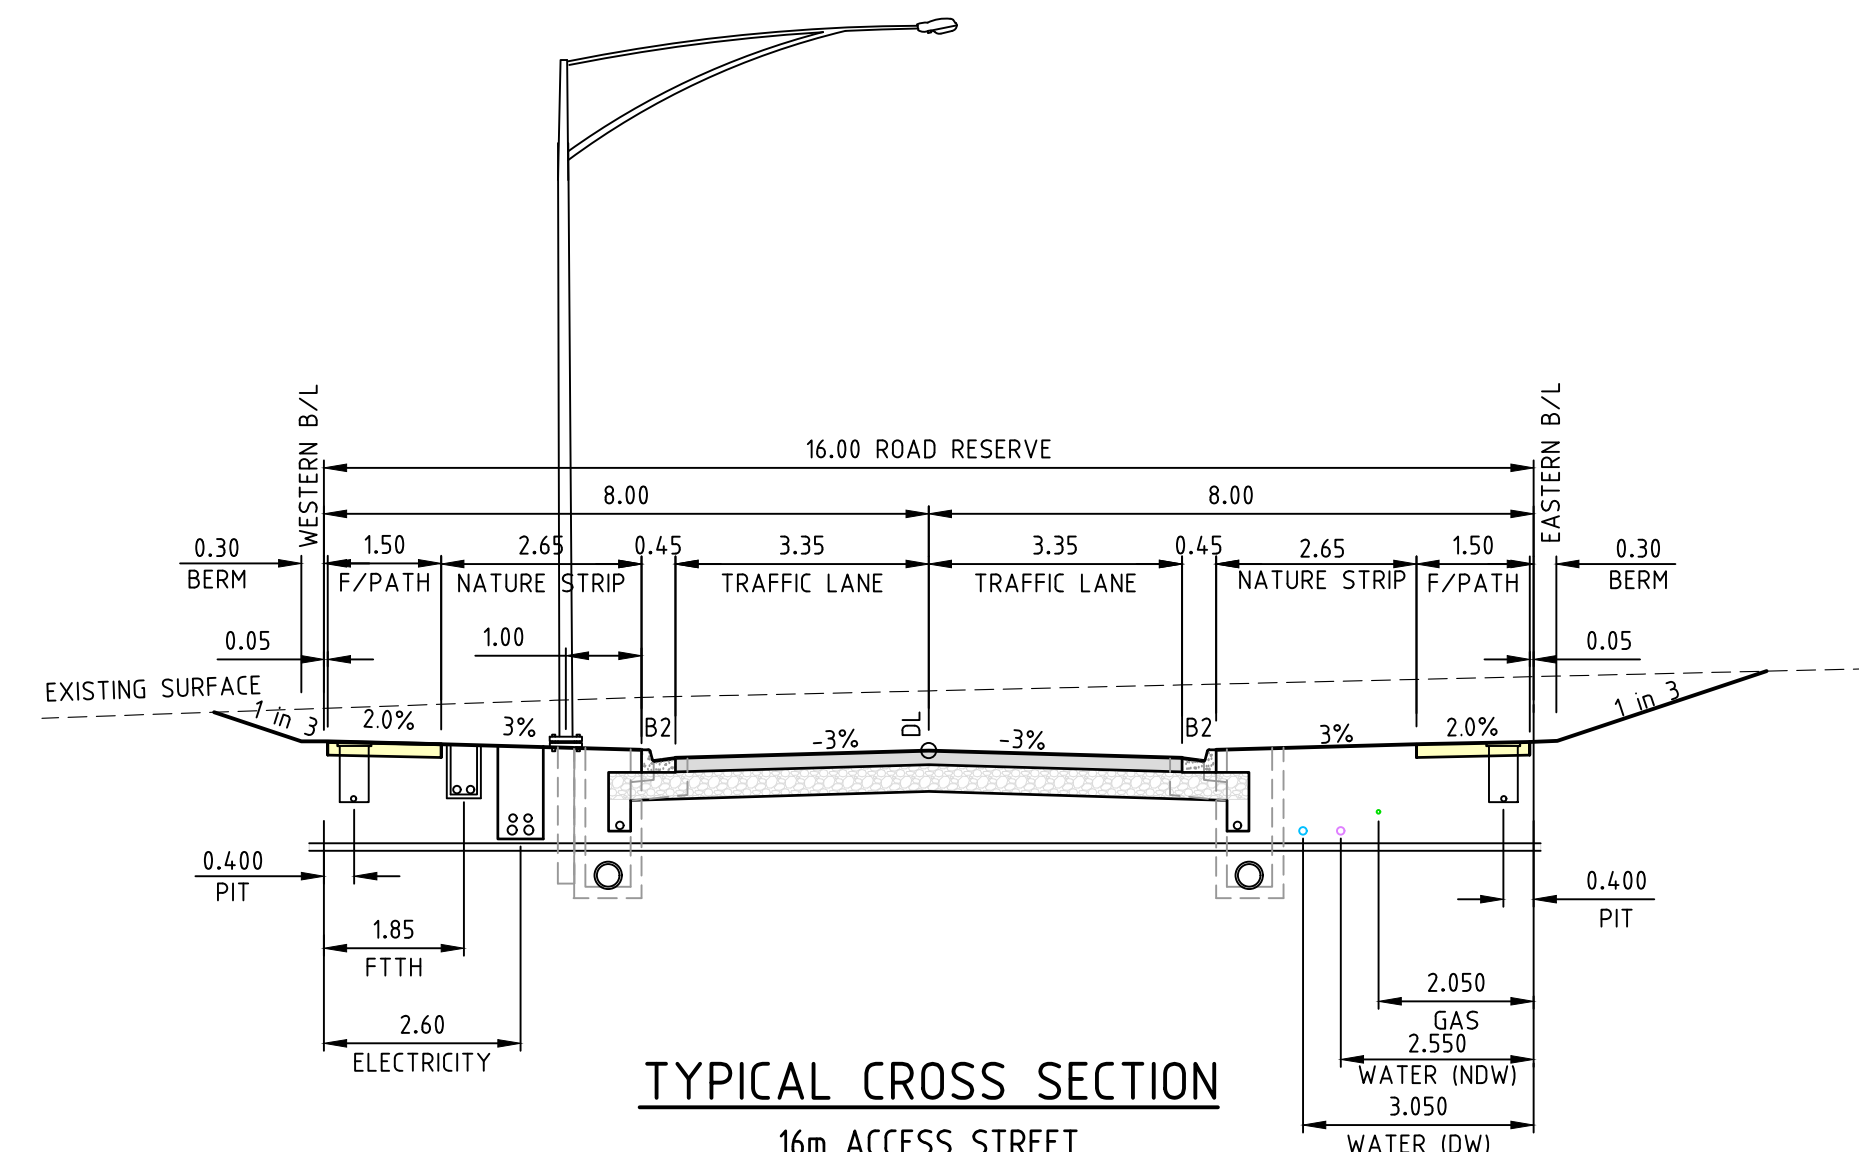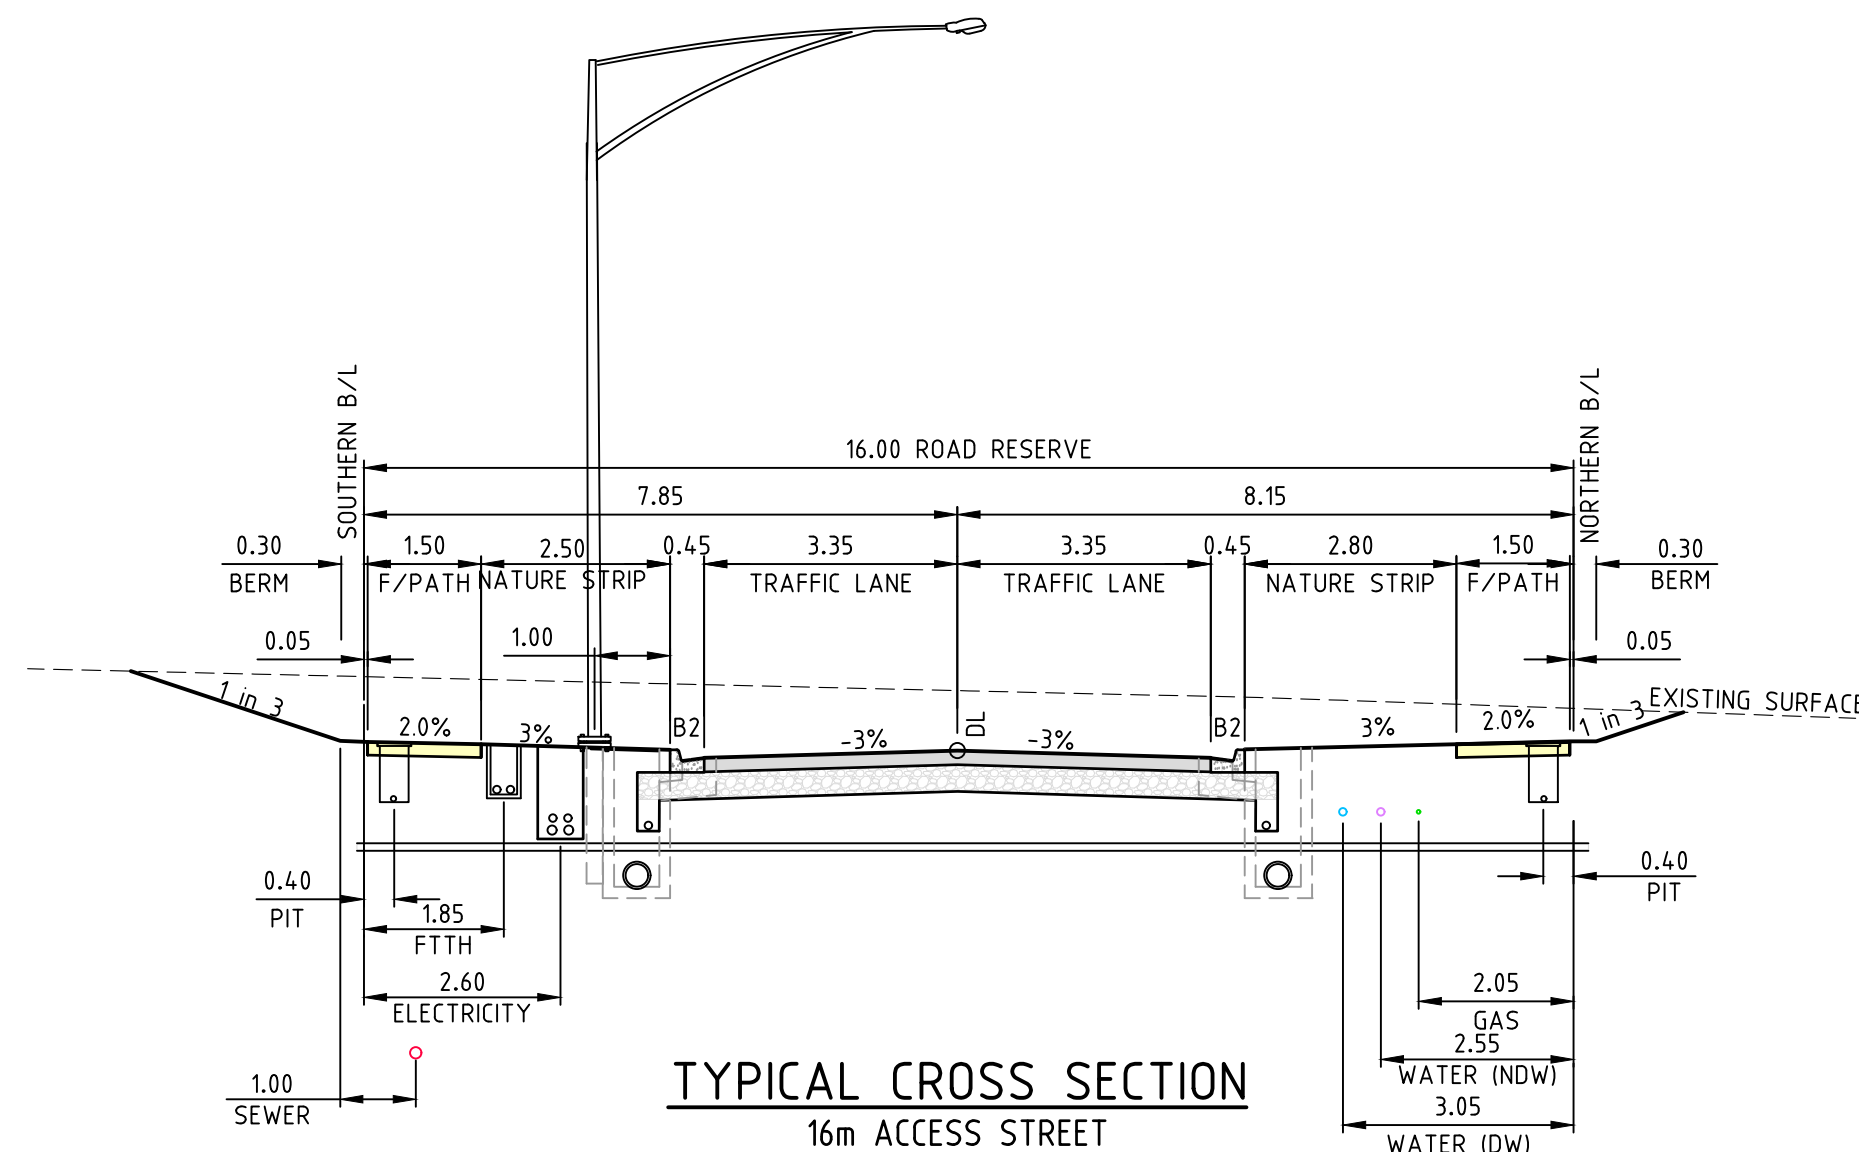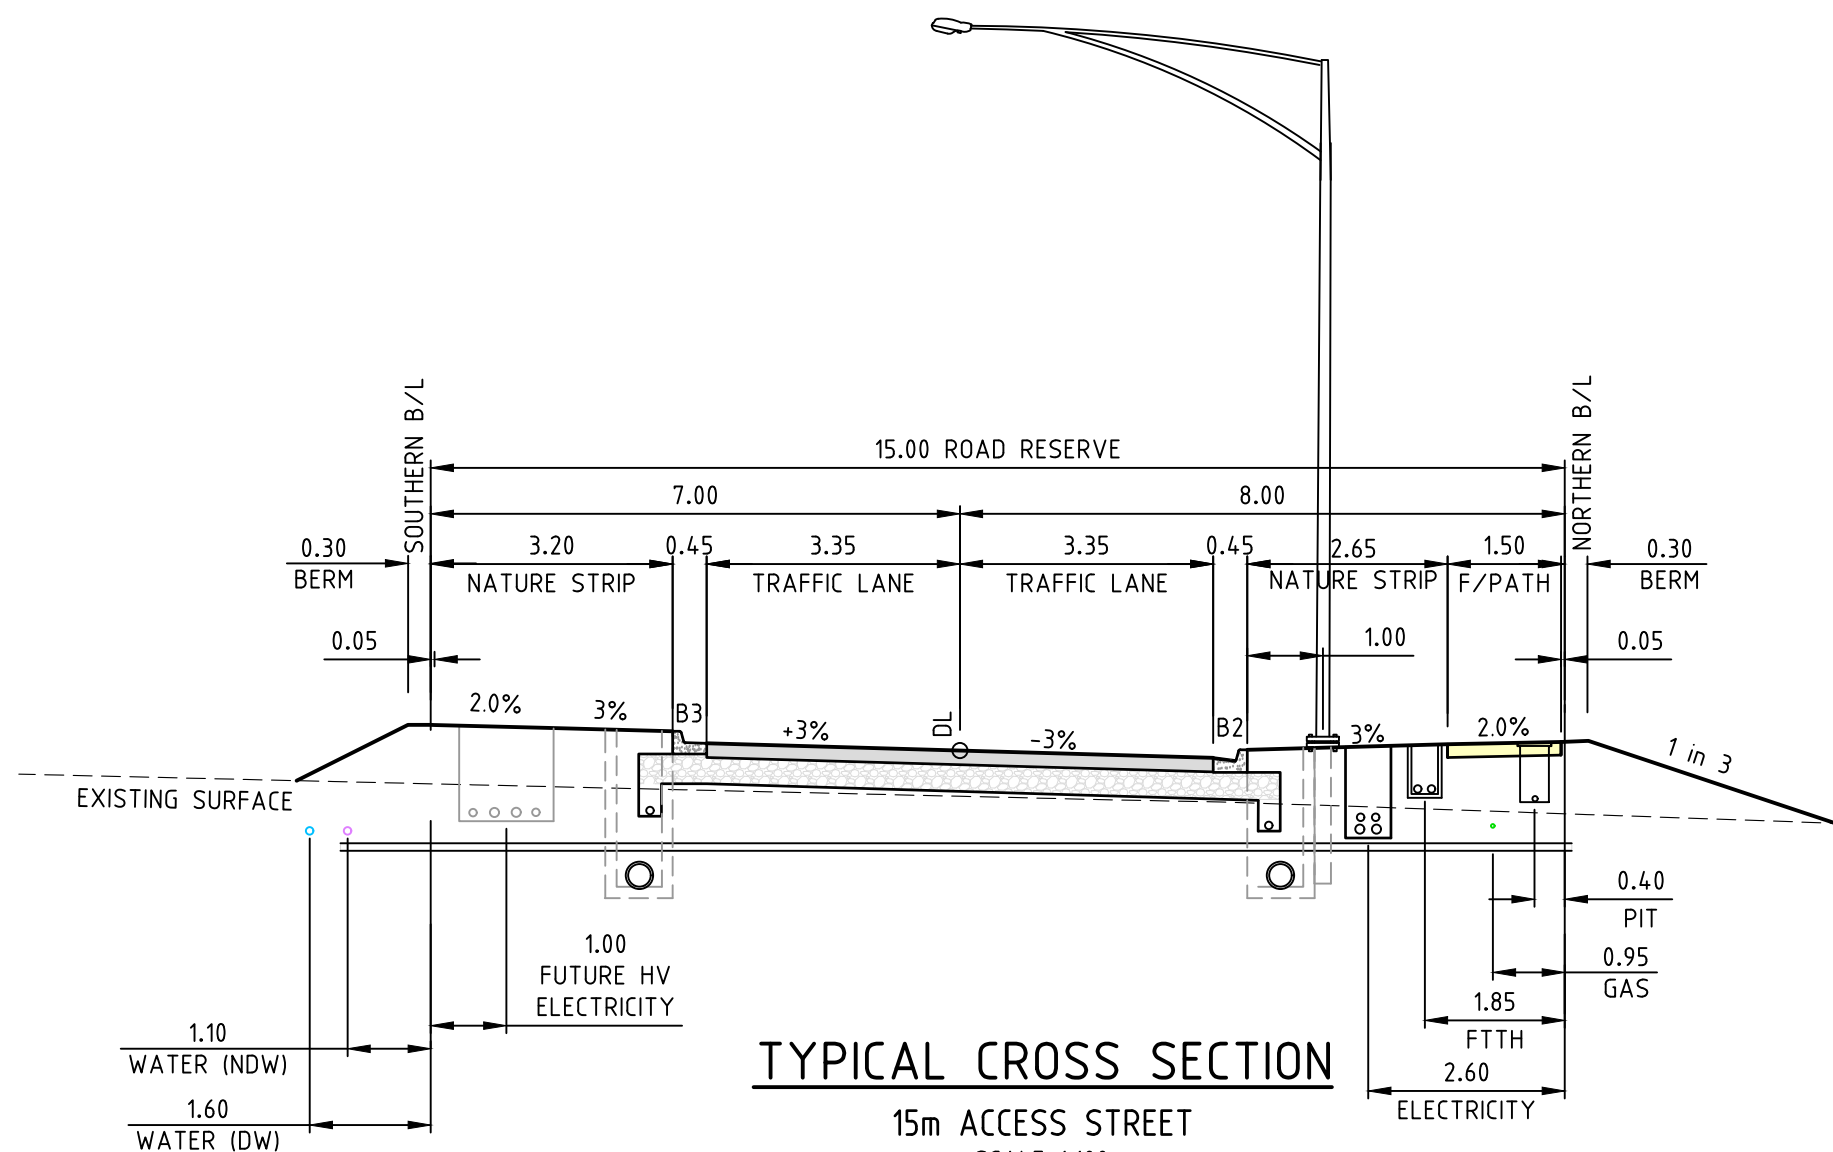

## PAVEMENT DETAILS

| ACCESS STREETS / PLACES                        |                                                     |
|------------------------------------------------|-----------------------------------------------------|
| CANNING DRIVE EAST, FERRARS WAY, MATHOURA ROAD |                                                     |
| ASPHALT                                        | WEARING COURSE<br>30mm SIZE 10mm TYPE N ASPHALT     |
|                                                | BASE COURSE<br>30mm SIZE 10mm TYPE N ASPHALT        |
|                                                | INTERLAYER<br>10mm SAMI TREATMENT PRIME             |
|                                                | UNDERLAID WITH BITUMINOUS PRIME SPRAY               |
| LAYER A                                        | BASE COURSE<br>130mm SIZE 20mm CLASS 2 CRUSHED ROCK |
| LAYER B                                        | UPPER SUBBASE<br>120mm SIZE 20 CLASS 3 CRUSHED ROCK |
| CAPPING LAYER                                  | LOWER SUBBASE<br>100mm SIZE 20 CLASS 4 CRUSHED ROCK |
| DEPTH TOTAL                                    | CAPPING<br>150mm REFER SECTION 7.4 OF REPORT        |
| SUBGRADE                                       | SUBGRADE CBR $\geq$ 2%                              |

REFER TO GOLDER ASSOCIATE'S GEOTECHNICAL REPORT  
NUMBER 127612078-001-R-Rev0 DATED 18/01/2013

NOTE: SHOULD THE SUBGRADE BE SOFT OR ROCKY MATERIAL, SUBGRADE IMPROVEMENT IS REQUIRED WHERE THE SUBGRADE IS TO BE FURTHER EXCAVATED AND THE DEPTH TO BE AT THE DISCRETION OF THE CONTRACTOR AND BROUGHT BACK UP TO SUBGRADE LEVEL IN A UNIFORM LAYER FOR THE COUNCIL SUPERVISOR TO INSPECT AS A HOLD POINT.

AS CONSTRUCTED

**merrifield**  
**MAB gpc**

Coords: MGA  
Levels: AHD

Scale @ A1/A3 AS SHOWN

**MERRIFIELD DEVELOPMENT**  
DONNYBROOK ROAD, MICKLEHAM  
**STAGE 19**  
**TYPICAL SECTIONS AND DETAILS**

**Drawing No. 11739TD02** **Rev 3**  
Sheet No. 02 **AS CONSTRUCTED**

© Dalton Consulting Engineers Pty Ltd  
ABN 78 429 221 049

**DALTON CONSULTING ENGINEERS**

VICTORIA  
T 61 3 9813 7400  
W dceng.com.au

ABN 78 429 221 049  
QUEENSLAND  
T 61 7 3374 9000  
E info@dceng.com.au

| REV | AMENDMENTS                       | DATE     | APP'D. |
|-----|----------------------------------|----------|--------|
| 3   | AS CONSTRUCTED                   | 08/09/16 | TL     |
| 2   | REVISED CANNING DR SOUTH OFFSETS | 08/03/16 | TL     |
| 1   | NBN ALIGNMENT AMENDED            | 17/02/16 | TL     |
| 0   | CONSTRUCTION ISSUE               | 03/02/16 | TL     |


Drawn M.CAPALDO  
Date 04/09/15  
AN 1451046  
Designed N.MIRATANA  
Date 24/06/15  
AN 1541349  
Verified B.GORDON  
Date 14/09/15  
AN 162517  
Audited T.OBOUHOFF  
Date 31/01/16  
AN 912871  
Approved T.LIAKOPOULOS  
Date 03/02/16  
AN 885194

Written dimensions to take precedence over scale. Contractor shall check and verify all dimensions on site. Discrepancies to be brought to the attention of the Superintendent.

Drawing File: G:\Design\11700\11739-MERRIFIELD - Precinct 1 - Stage 19\Acad\RD\11739TD02.dwg - 11739TD02  
Date/Time: Thu Sep 08, 2016 - 4:53pm - ByronShade




Drawing File: G:\Designdata\11700\11739-MERRIFIELD - Precinct 1 - Stage 19\Acad\RD\11739SP01.dwg - 11739SP01  
Date/Time: Thu Sep 08, 2016 - 4:53pm - Byron Ashde

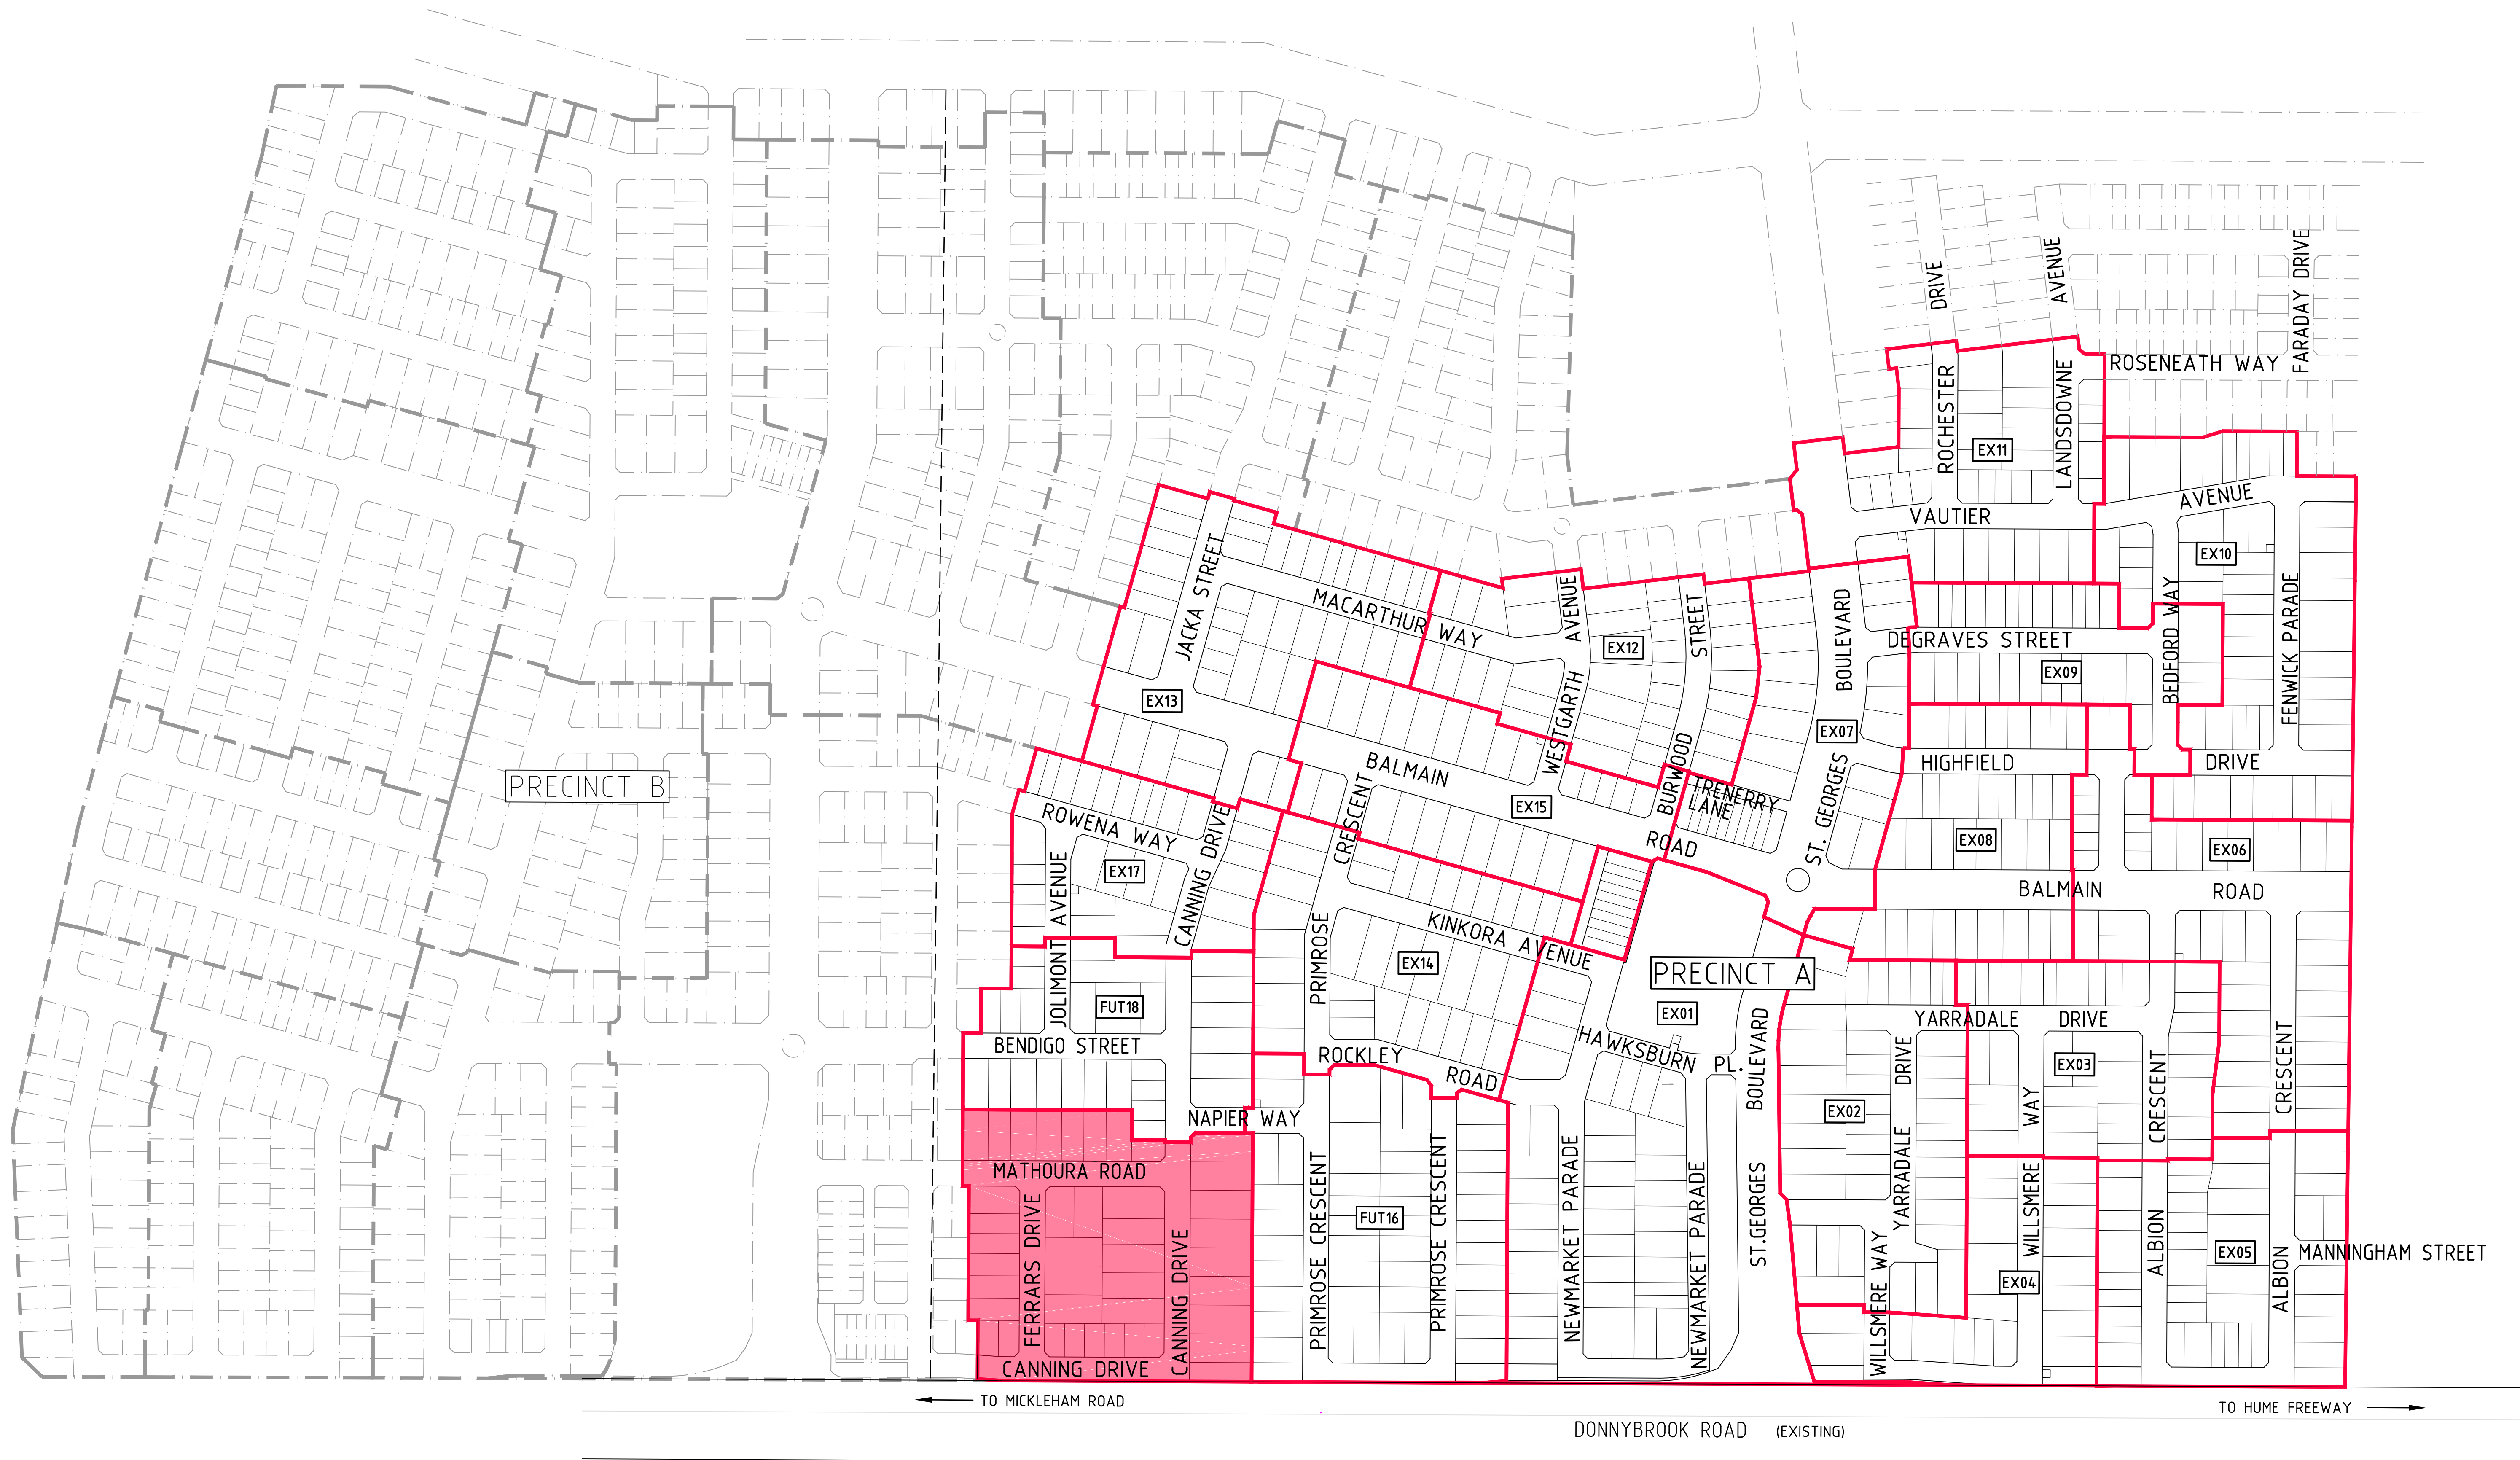

|     |                    |          |        |
|-----|--------------------|----------|--------|
| 1   | AS CONSTRUCTED     | 08/09/16 | TL     |
| 0   | CONSTRUCTION ISSUE | 03/02/16 | TL     |
| REV | AMENDMENTS         | DATE     | APP'D. |

Drawn M. CAPALDO  
Date 04/09/15  
AN 1451046  
Designed N. MIRATANA  
Date 24/06/15  
AN 1541350  
Verified B. GORDON  
Date 14/09/15  
AN 162518  
Audited T. OBOUHOFF  
Date 31/01/16  
AN 912872  
Approved T. LIAKOPOULOS  
Date 03/02/16  
AN 885195

AS CONSTRUCTED

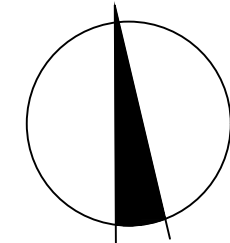


merrifield  
MAB gpc

Coords: MGA  
Levels: AHD  
Hor 1:2000 0m 20m 40m 80m 120m  
Scale @ A1/A3 1:2000/1:4000

MERRIFIELD DEVELOPMENT  
DONNYBROOK ROAD, MICKLEHAM  
STAGE 19  
STAGING PLAN

Drawing No. 11739SP01 Rev 1  
Sheet No. 03 AS CONSTRUCTED  
© Dalton Consulting Engineers Pty Ltd  
ABN 78 429 221 049

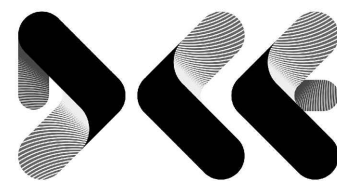


VICTORIA  
T 61 3 9813 7400  
W dceng.com.au

DALTON  
CONSULTING  
ENGINEERS

ABN 78 429 221 049  
QUEENSLAND  
T 61 7 3374 9000  
E info@dceng.com.au

Written dimensions to take precedence over scale. Contractor shall check and verify all dimensions on site. Discrepancies to be brought to the attention of the Superintendent.




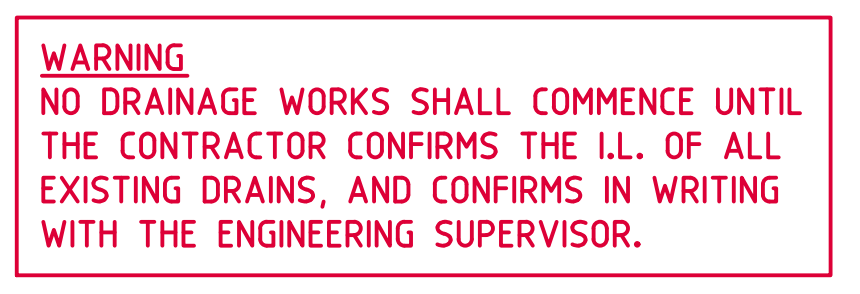

Written dimensions to take precedence over scale. Contractor shall check and verify all dimensions on site, Discrepancies to be brought to the attention of the Superintendent.



Drawing File: G:\Design\11739-11739-MERRIFIELD - Precinct 1 - Stage 19\Acad\RD\11739SOP01.dwg -- 11739SOP01  
Date/Time: Thu Sep 08, 2016 -- 4:53pm -- Byron Ashde--

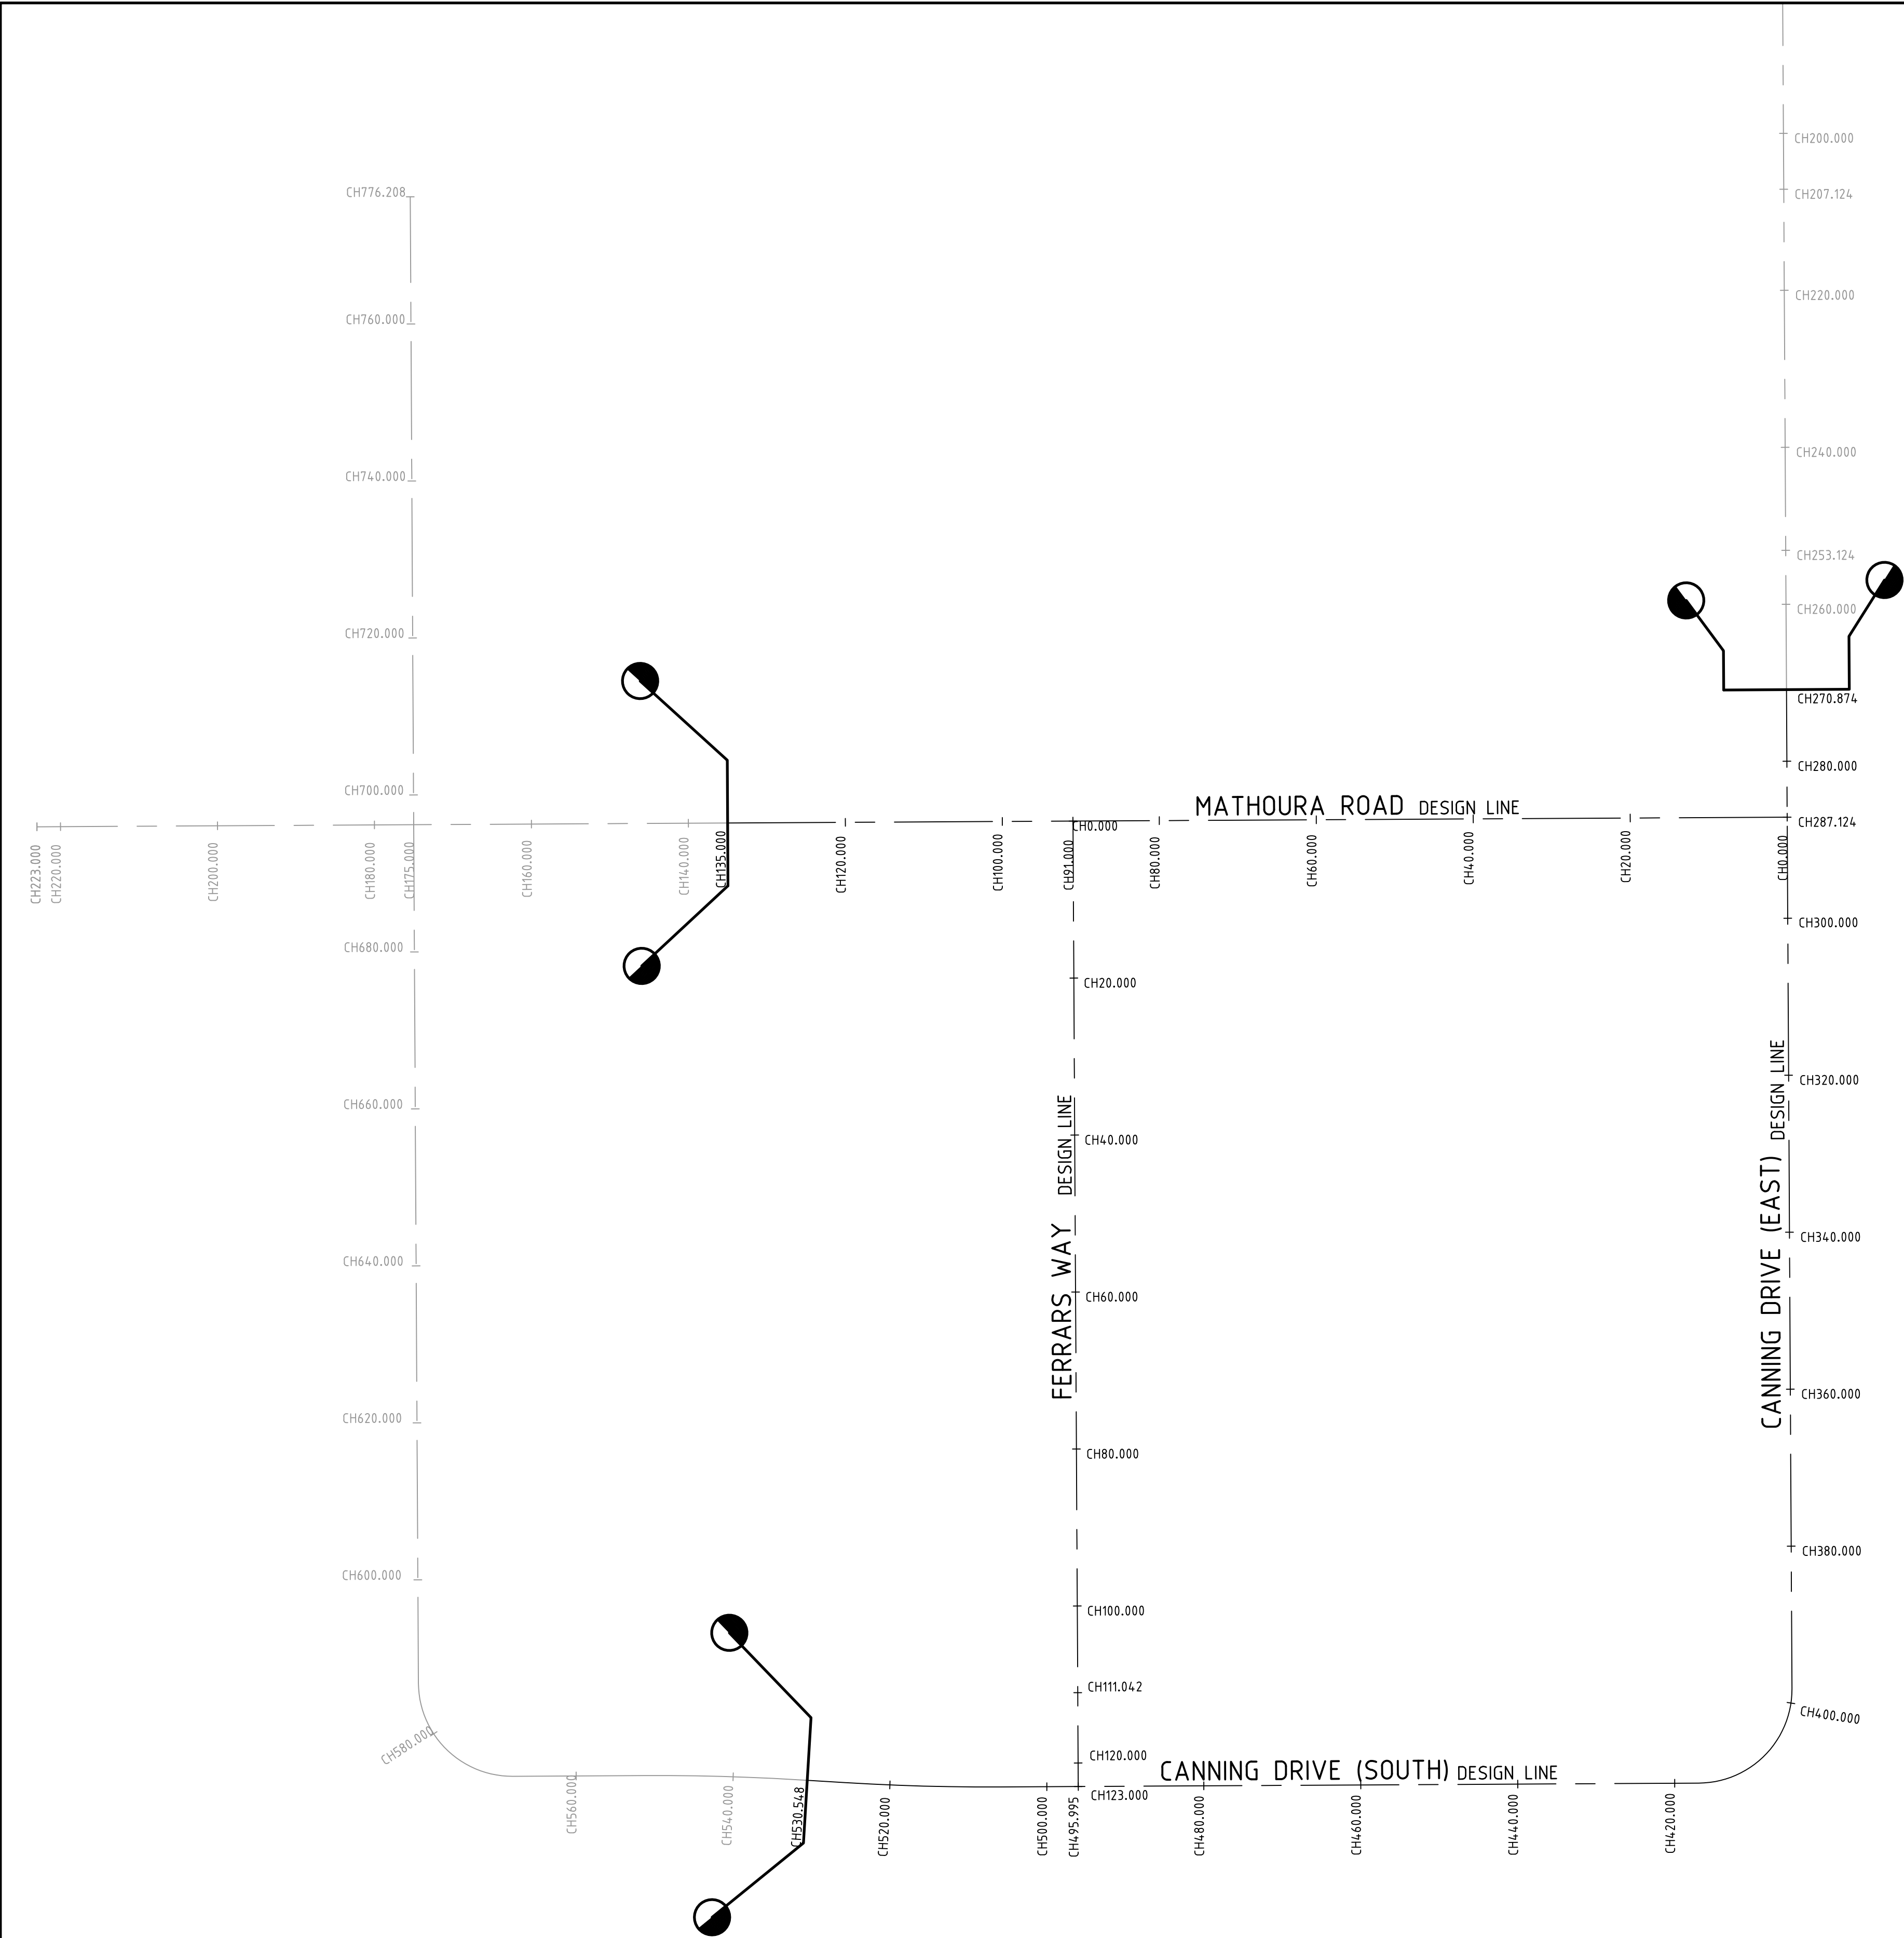

HORIZONTAL ALIGNMENT REPORT FOR FERRARS WAY

| POINT TYPE           | CHAINAGE | EASTING    | COORDINATES<br>NORTHING | RL      | BEARING<br>DEG MIN SEC | RADIUS |
|----------------------|----------|------------|-------------------------|---------|------------------------|--------|
| STRAIGHT (START ALN) | 0.000    | 314508.695 | 5843835.780             | 251.247 | 187°03'10.00"          |        |
| STRAIGHT             | 20.000   | 314506.239 | 5843815.931             | 251.230 | 187°03'10.00"          |        |
| STRAIGHT             | 40.000   | 314503.783 | 5843796.083             | 251.330 | 187°03'10.00"          |        |
| STRAIGHT             | 60.000   | 314501.328 | 5843776.234             | 251.495 | 187°03'10.00"          |        |
| STRAIGHT             | 80.000   | 314498.872 | 5843756.385             | 251.879 | 187°03'10.00"          |        |
| STRAIGHT             | 100.000  | 314496.416 | 5843736.537             | 252.260 | 187°03'10.00"          |        |
| STRAIGHT             | 120.000  | 314493.961 | 5843716.688             | 252.431 | 187°03'10.00"          |        |
| STRAIGHT (END ALN)   | 123.000  | 314493.592 | 5843713.711             | 252.521 | 187°03'10.00"          |        |

HORIZONTAL ALIGNMENT REPORT FOR MATHOURA ROAD IN MODEL

| POINT TYPE           | CHAINAGE | EASTING    | COORDINATES<br>NORTHING | RL      | BEARING<br>DEG MIN SEC | RADIUS |
|----------------------|----------|------------|-------------------------|---------|------------------------|--------|
| STRAIGHT (START ALN) | 0.000    | 314599.006 | 5843824.607             | 250.301 | 277°03'10.00"          |        |
| STRAIGHT             | 20.000   | 314579.157 | 5843827.062             | 250.323 | 277°03'10.00"          |        |
| STRAIGHT             | 40.000   | 314559.309 | 5843829.518             | 250.654 | 277°03'10.00"          |        |
| STRAIGHT             | 60.000   | 314539.460 | 5843831.974             | 250.890 | 277°03'10.00"          |        |
| STRAIGHT             | 80.000   | 314519.611 | 5843834.429             | 251.120 | 277°03'10.00"          |        |
| STRAIGHT             | 100.000  | 314499.763 | 5843836.885             | 251.350 | 277°03'10.00"          |        |
| STRAIGHT             | 120.000  | 314479.914 | 5843839.341             | 251.582 | 277°03'10.00"          |        |
| STRAIGHT             | 135.000  | 314465.028 | 5843841.182             | 251.784 | 277°03'10.00"          |        |
| STRAIGHT             | 140.000  | 314460.065 | 5843841.796             | 251.860 | 277°03'10.00"          |        |
| STRAIGHT             | 160.000  | 314440.217 | 5843844.252             | 252.183 | 277°03'10.00"          |        |
| STRAIGHT             | 180.000  | 314420.368 | 5843846.708             | 252.509 | 277°03'10.00"          |        |
| STRAIGHT             | 200.000  | 314400.519 | 5843849.164             | 252.835 | 277°03'10.00"          |        |
| STRAIGHT             | 220.000  | 314380.671 | 5843851.619             | 253.161 | 277°03'10.00"          |        |
| STRAIGHT (END ALN)   | 223.000  | 314377.694 | 5843851.988             | 253.210 | 277°03'10.00"          |        |

HORIZONTAL ALIGNMENT REPORT FOR CANNING DRIVE


| POINT TYPE         | CHAINAGE | EASTING    | COORDINATES<br>NORTHING | RL      | BEARING<br>DEG MIN SEC | RADIUS   |
|--------------------|----------|------------|-------------------------|---------|------------------------|----------|
| STRAIGHT           | 200.000  | 314609.704 | 5843911.071             | 249.865 | 187°03'10.00"          |          |
| STRAIGHT           | 220.000  | 314607.248 | 5843891.223             | 249.965 | 187°03'10.00"          |          |
| STRAIGHT           | 240.000  | 314604.792 | 5843871.374             | 250.065 | 187°03'10.00"          |          |
| STRAIGHT           | 260.000  | 314602.337 | 5843851.525             | 250.165 | 187°03'10.00"          |          |
| STRAIGHT           | 270.874  | 314601.001 | 5843840.733             | 250.219 | 187°03'10.00"          |          |
| STRAIGHT           | 280.000  | 314599.881 | 5843831.677             | 250.265 | 187°03'10.00"          |          |
| STRAIGHT           | 300.000  | 314597.425 | 5843811.828             | 250.365 | 187°03'10.00"          |          |
| STRAIGHT           | 320.000  | 314594.970 | 5843791.979             | 250.465 | 187°03'10.00"          |          |
| STRAIGHT           | 340.000  | 314592.514 | 5843772.131             | 250.579 | 187°03'10.00"          |          |
| STRAIGHT           | 360.000  | 314590.058 | 5843752.282             | 250.788 | 187°03'10.00"          |          |
| STRAIGHT           | 380.000  | 314587.603 | 5843732.433             | 251.093 | 187°03'10.00"          |          |
| TANGENT-CURVE      | 398.174  | 314585.371 | 5843714.397             | 251.382 | 187°03'10.00"          |          |
| CURVE              | 400.000  | 314585.009 | 5843712.609             | 251.411 | 195°48'30.69"          | 11.950   |
| CURVE              | 402.857  | 314583.911 | 5843709.979             | 251.456 | 209°30'26.84"          | 11.950   |
| CURVE              | 405.714  | 314582.222 | 5843707.683             | 251.502 | 223°12'22.99"          | 11.950   |
| CURVE              | 408.571  | 314580.036 | 5843705.853             | 251.547 | 236°54'19.14"          | 11.950   |
| CURVE              | 411.429  | 314577.480 | 5843704.593             | 251.586 | 250°36'15.29"          | 11.950   |
| CURVE              | 414.286  | 314574.698 | 5843703.973             | 251.617 | 264°18'11.45"          | 11.950   |
| CURVE-TANGENT      | 416.945  | 314572.044 | 5843704.005             | 251.647 | 277°03'10.00"          | 11.950   |
| STRAIGHT           | 420.000  | 314569.012 | 5843704.380             | 251.681 | 277°03'10.00"          |          |
| STRAIGHT           | 440.000  | 314549.164 | 5843706.836             | 251.902 | 277°03'10.00"          |          |
| STRAIGHT           | 460.000  | 314529.315 | 5843709.291             | 252.123 | 277°03'10.00"          |          |
| STRAIGHT           | 480.000  | 314509.466 | 5843711.747             | 252.344 | 277°03'10.00"          |          |
| STRAIGHT           | 500.000  | 314489.618 | 5843714.203             | 252.565 | 277°03'10.00"          |          |
| TANGENT-CURVE      | 505.830  | 314483.831 | 5843714.918             | 252.630 | 277°03'10.00"          |          |
| CURVE              | 510.000  | 314479.697 | 5843715.459             | 252.676 | 277°50'56.87"          | 300.000  |
| CURVE              | 520.000  | 314469.815 | 5843716.990             | 252.786 | 279°45'32.36"          | 300.000  |
| CURVE-TANGENT      | 525.665  | 314464.242 | 5843718.002             | 252.849 | 280°50'27.21"          | 300.000  |
| STRAIGHT           | 530.584  | 314459.446 | 5843718.921             | 252.903 | 280°50'27.21"          |          |
| TANGENT-CURVE      | 531.555  | 314458.457 | 5843719.110             | 252.914 | 280°50'27.21"          |          |
| CURVE              | 540.000  | 314450.141 | 5843720.582             | 253.008 | 279°13'40.81"          | -300.000 |
| CURVE              | 550.000  | 314440.246 | 5843722.021             | 253.118 | 277°19'05.32"          | -300.000 |
| CURVE-TANGENT      | 551.389  | 314438.867 | 5843722.194             | 253.134 | 277°03'10.00"          | -300.000 |
| STRAIGHT           | 560.000  | 314430.322 | 5843723.252             | 253.229 | 277°03'10.00"          |          |
| TANGENT-CURVE      | 568.087  | 314422.296 | 5843724.244             | 253.302 | 277°03'10.00"          |          |
| CURVE              | 568.571  | 314421.816 | 5843724.314             | 253.305 | 279°22'38.11"          | 11.950   |
| CURVE              | 571.429  | 314419.080 | 5843725.110             | 253.323 | 293°04'34.26"          | 11.950   |
| CURVE              | 574.286  | 314416.609 | 5843726.532             | 253.336 | 306°46'30.41"          | 11.950   |
| CURVE              | 577.143  | 314414.546 | 5843728.499             | 253.345 | 320°28'26.56"          | 11.950   |
| CURVE              | 580.000  | 314413.007 | 5843730.898             | 253.351 | 334°10'22.71"          | 11.950   |
| CURVE              | 582.857  | 314412.080 | 5843733.593             | 253.352 | 347°52'18.87"          | 11.950   |
| CURVE              | 585.714  | 314411.818 | 5843736.432             | 253.349 | 1°34'15.02"            | 11.950   |
| CURVE-TANGENT      | 586.858  | 314411.904 | 5843737.571             | 253.347 | 7°03'10.00"            | 11.950   |
| STRAIGHT           | 600.000  | 314413.518 | 5843750.614             | 253.274 | 7°03'10.00"            |          |
| STRAIGHT           | 620.000  | 314415.973 | 5843770.463             | 253.098 | 7°03'10.00"            |          |
| STRAIGHT           | 640.000  | 314418.429 | 5843790.312             | 252.922 | 7°03'10.00"            |          |
| STRAIGHT           | 660.000  | 314420.885 | 5843810.160             | 252.746 | 7°03'10.00"            |          |
| STRAIGHT           | 680.000  | 314423.340 | 5843830.009             | 252.570 | 7°03'10.00"            |          |
| STRAIGHT           | 700.000  | 314425.796 | 5843849.858             | 252.394 | 7°03'10.00"            |          |
| STRAIGHT           | 720.000  | 314428.252 | 5843869.706             | 252.219 | 7°03'10.00"            |          |
| STRAIGHT           | 740.000  | 314430.707 | 5843889.555             | 252.043 | 7°03'10.00"            |          |
| STRAIGHT           | 760.000  | 314433.163 | 5843909.404             | 251.894 | 7°03'10.00"            |          |
| STRAIGHT (END ALN) | 776.208  | 314435.153 | 5843925.489             | 251.930 | 7°03'10.00"            |          |

|     |                    |          |        |
|-----|--------------------|----------|--------|
| 1   | AS CONSTRUCTED     | 08/09/16 | TL     |
| 0   | CONSTRUCTION ISSUE | 03/02/16 | TL     |
| REV | AMENDMENTS         | DATE     | APP'D. |

Drawn M.CAPALDO  
Date 04/09/15  
AN 1451046  
Designed N.MIRATANA  
Date 24/06/15  
AN 1541352  
Verified B.GORDON  
Date 14/09/15  
AN 162520  
Audited T.OBOUHOFF  
Date 31/01/16  
AN 912874  
Approved T.LIAKOPOULOS  
Date 03/02/16  
AN 885197

Written dimensions to take precedence over scale. Contractor shall check and verify all dimensions on site. Discrepancies to be brought to the attention of the Superintendent.

AS CONSTRUCTED

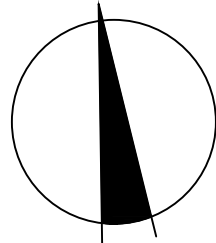


merrifield  
MAB gpc

Coords: MGA  
Levels: AHD  
Hor 1:500 0m 5m 10m 20m 30m  
Scale @ A1/A3 1:500/1:1000

MERRIFIELD DEVELOPMENT  
DONNYBROOK ROAD, MICKLEHAM  
STAGE 19  
SET OUT DETAILS

Drawing No. 11739SOP01 Rev 1  
Sheet No. 05 AS CONSTRUCTED  
© Dalton Consulting Engineers Pty Ltd  
ABN 78 429 221 049

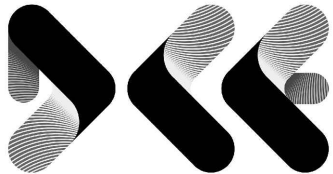

DALTON  
CONSULTING  
ENGINEERS

ABN 78 429 221 049  
QUEENSLAND  
T 61 7 3374 9000  
E info@dceng.com.au

VICTORIA  
T 61 3 9813 7400  
W dceng.com.au



Drawing File: G:\Design\11739-MERRIFIELD - Prelim 1 - Stage 19\A3.dwg  
11739D01.dwg - 11739D01  
Date/Time: Thu Sep 08, 2016 - 4:54pm - Byron Ashode

#### ALIGNMENT A


| POINT NO | EASTING    | NORTHING    | RL      |
|----------|------------|-------------|---------|
| A1       | 314582.596 | 5843830.013 | 250.185 |
| A2       | 314587.558 | 5843829.399 | 250.158 |
| A3       | 314597.149 | 5843836.878 | 250.140 |

| CURVE NO | I      | RADIUS | ARC    | A     | B     | X     | Y     | L     | MID POINT RL |
|----------|--------|--------|--------|-------|-------|-------|-------|-------|--------------|
| A2 - A3  | 90.000 | 8.600  | 13.509 | 2.519 | 1.864 | 3.291 | 2.790 | 3.377 | 250.174      |


#### ALIGNMENT B

| POINT NO | EASTING    | NORTHING    | RL      |
|----------|------------|-------------|---------|
| B1       | 314594.214 | 5843813.159 | 250.260 |
| B2       | 314586.735 | 5843822.749 | 250.149 |
| B3       | 314581.773 | 5843823.363 | 250.185 |


| CURVE NO | I      | RADIUS | ARC    | A     | B     | X     | Y     | L     | MID POINT RL |
|----------|--------|--------|--------|-------|-------|-------|-------|-------|--------------|
| B1 - B2  | 90.000 | 8.600  | 13.509 | 2.519 | 1.864 | 3.291 | 2.790 | 3.377 | 250.209      |

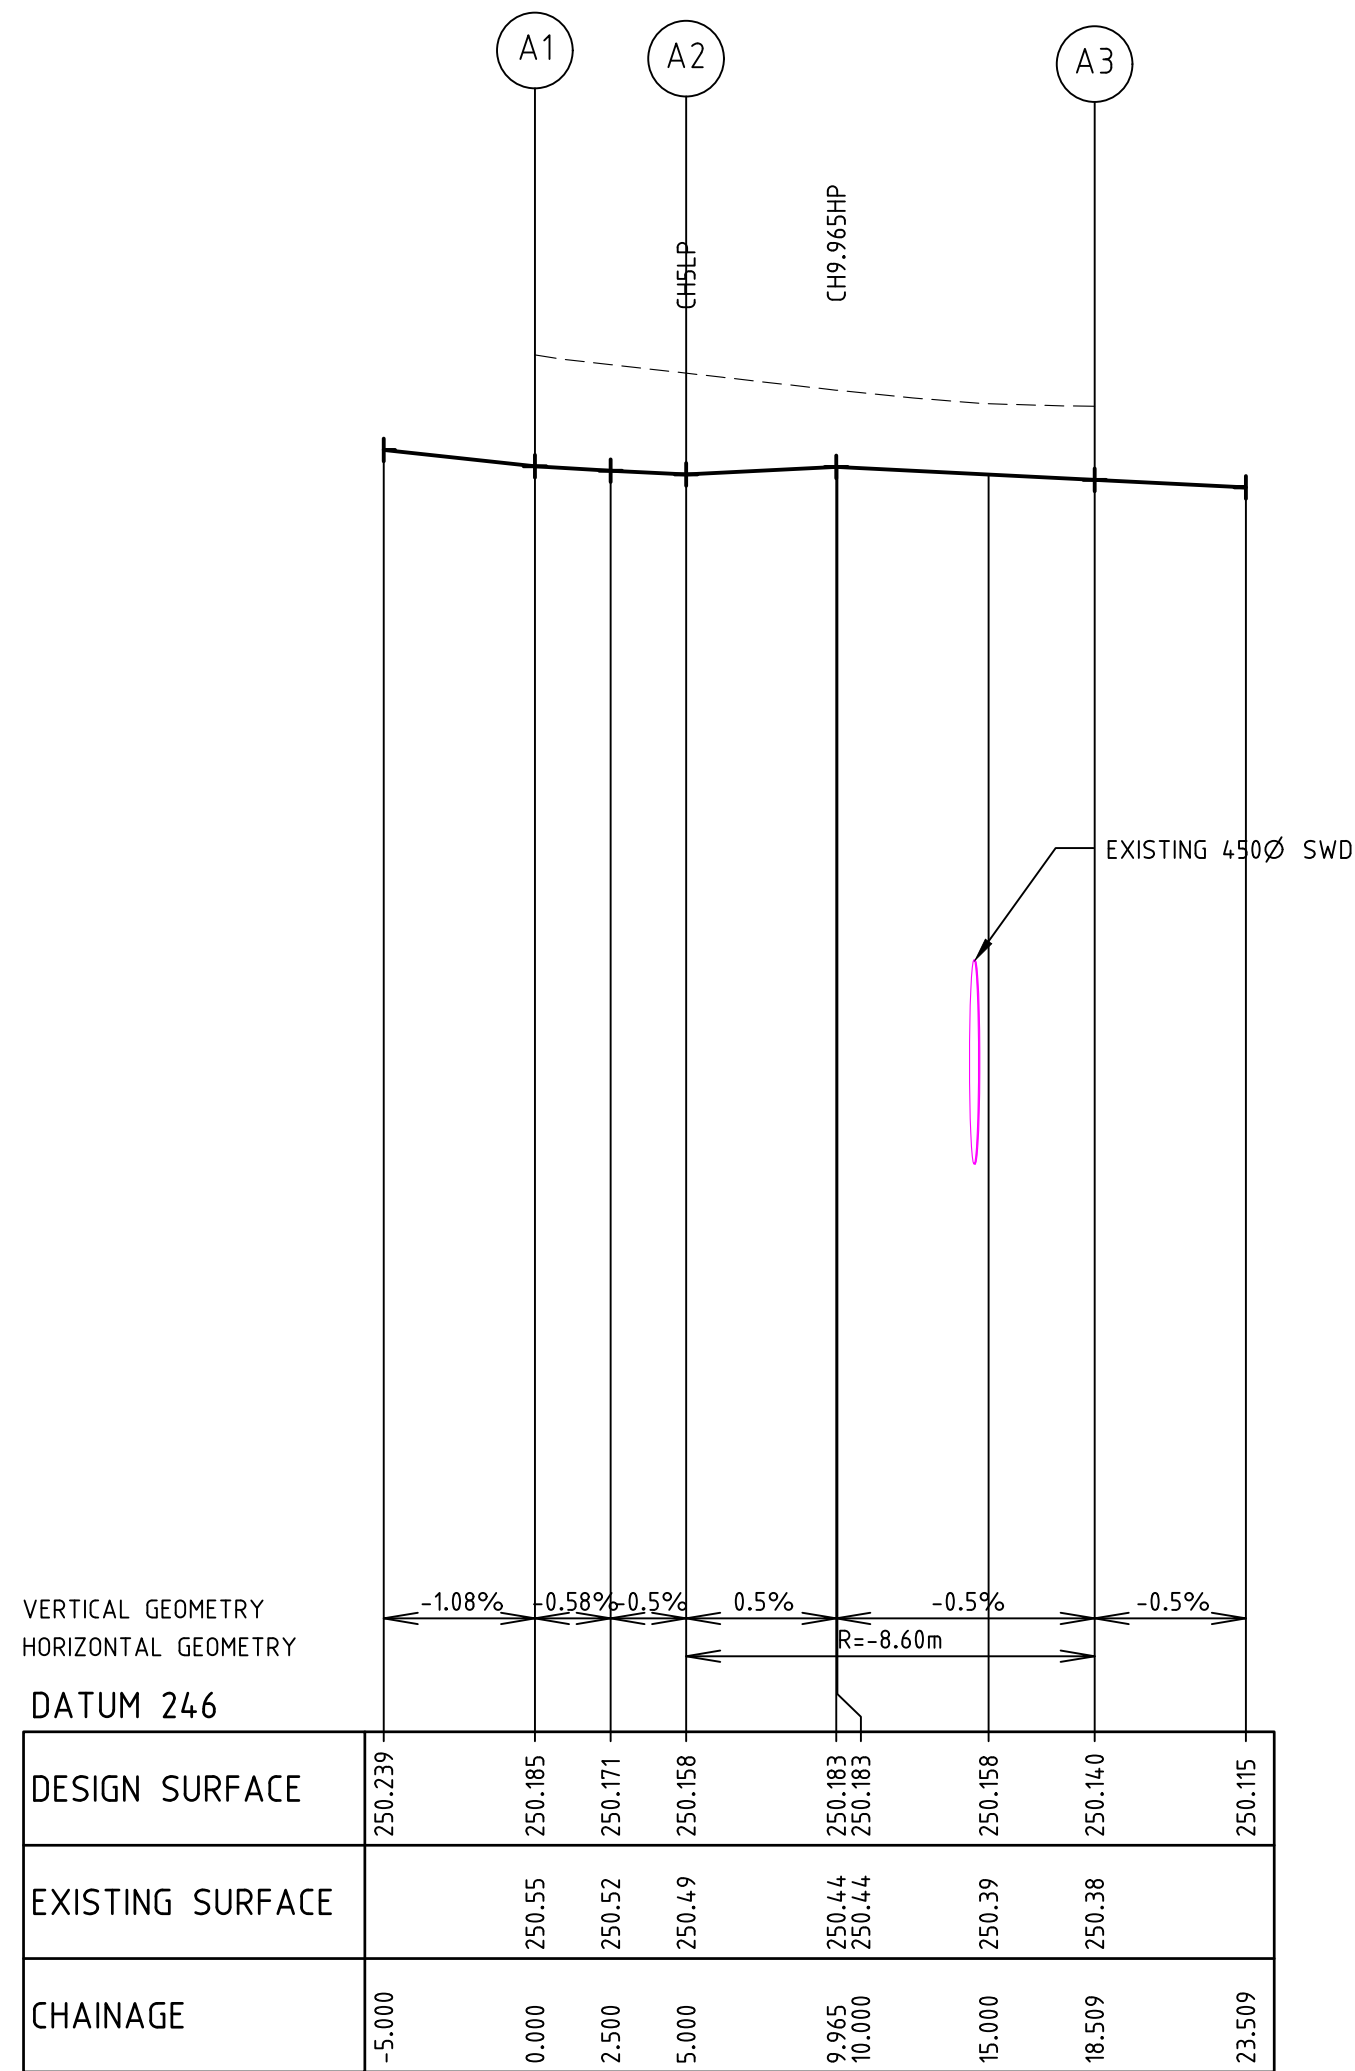

LIP PROFILE A

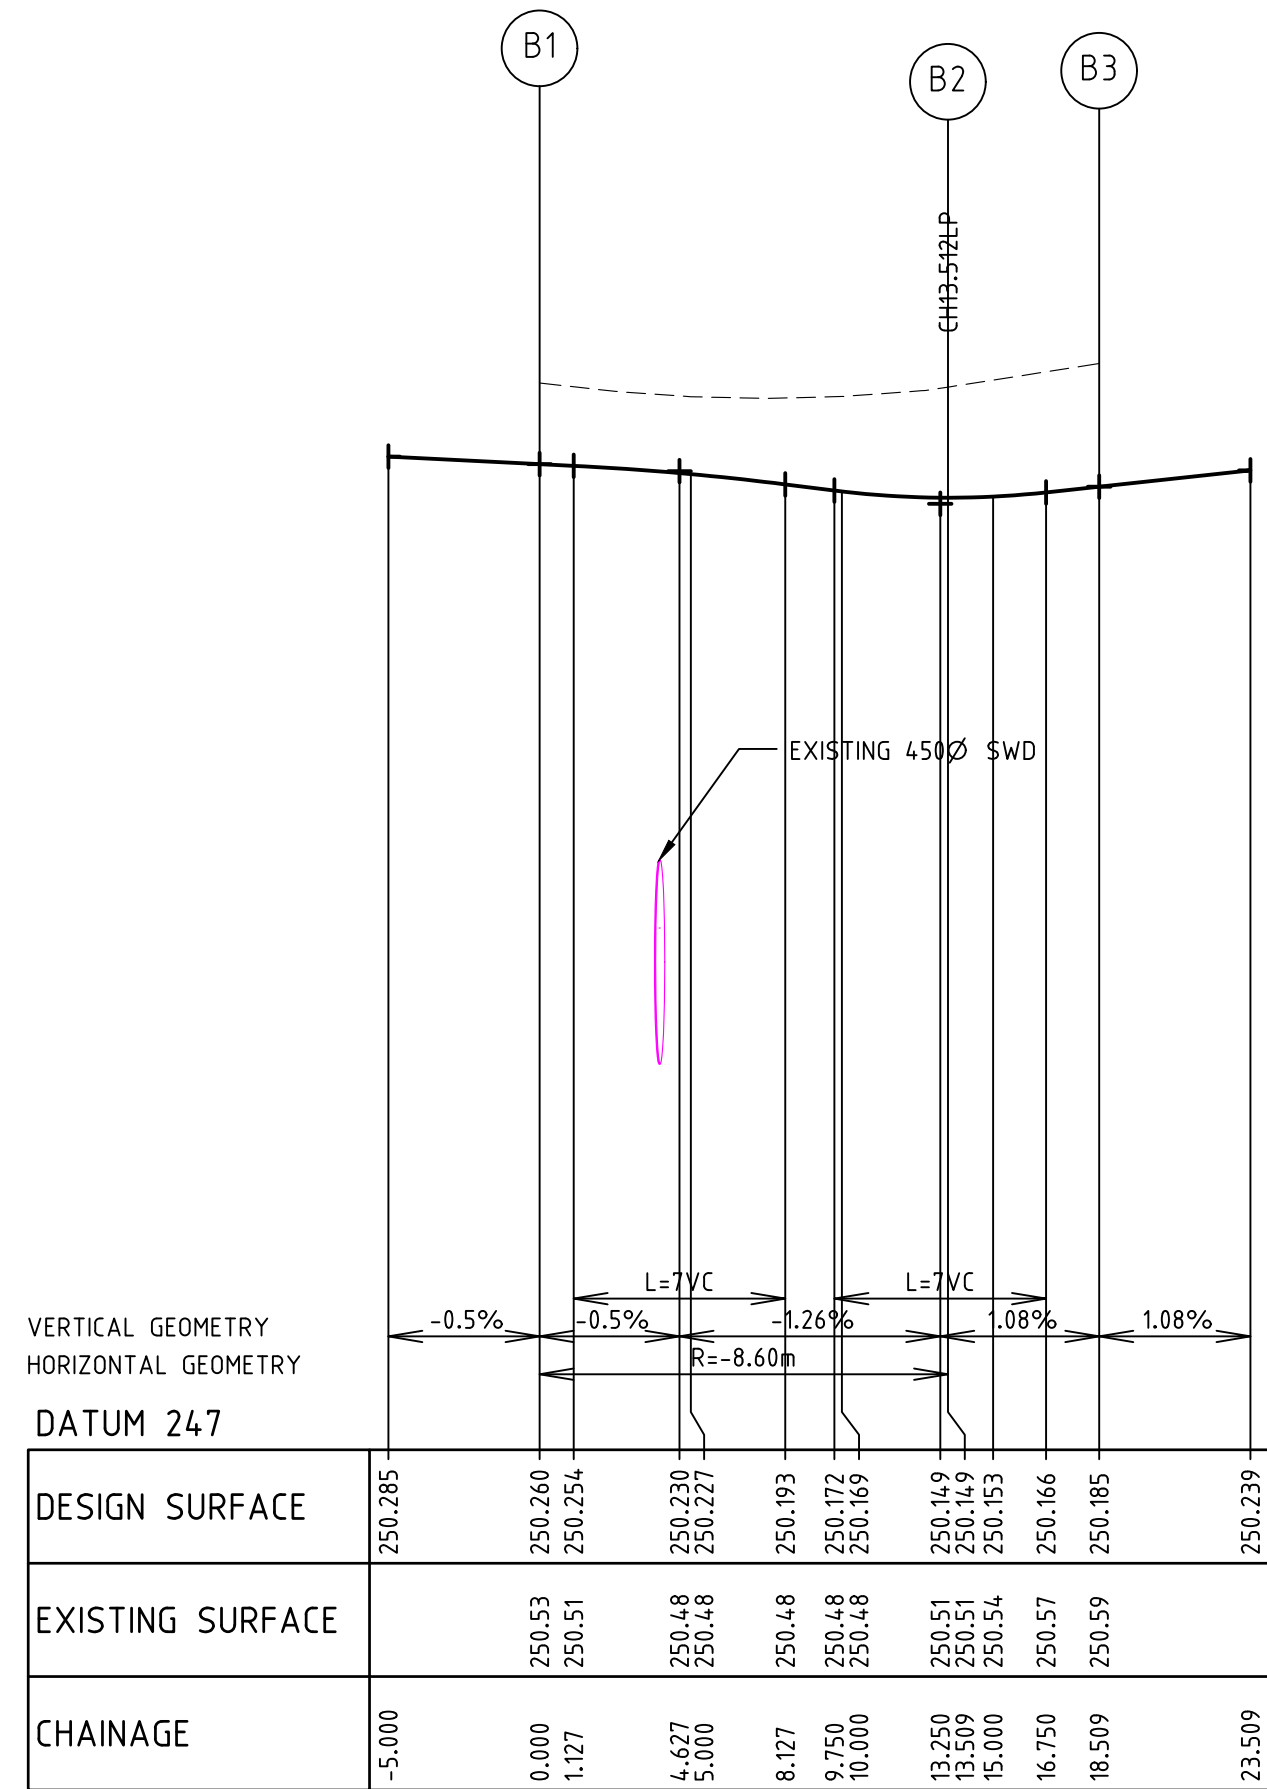

LIP PROFILE B



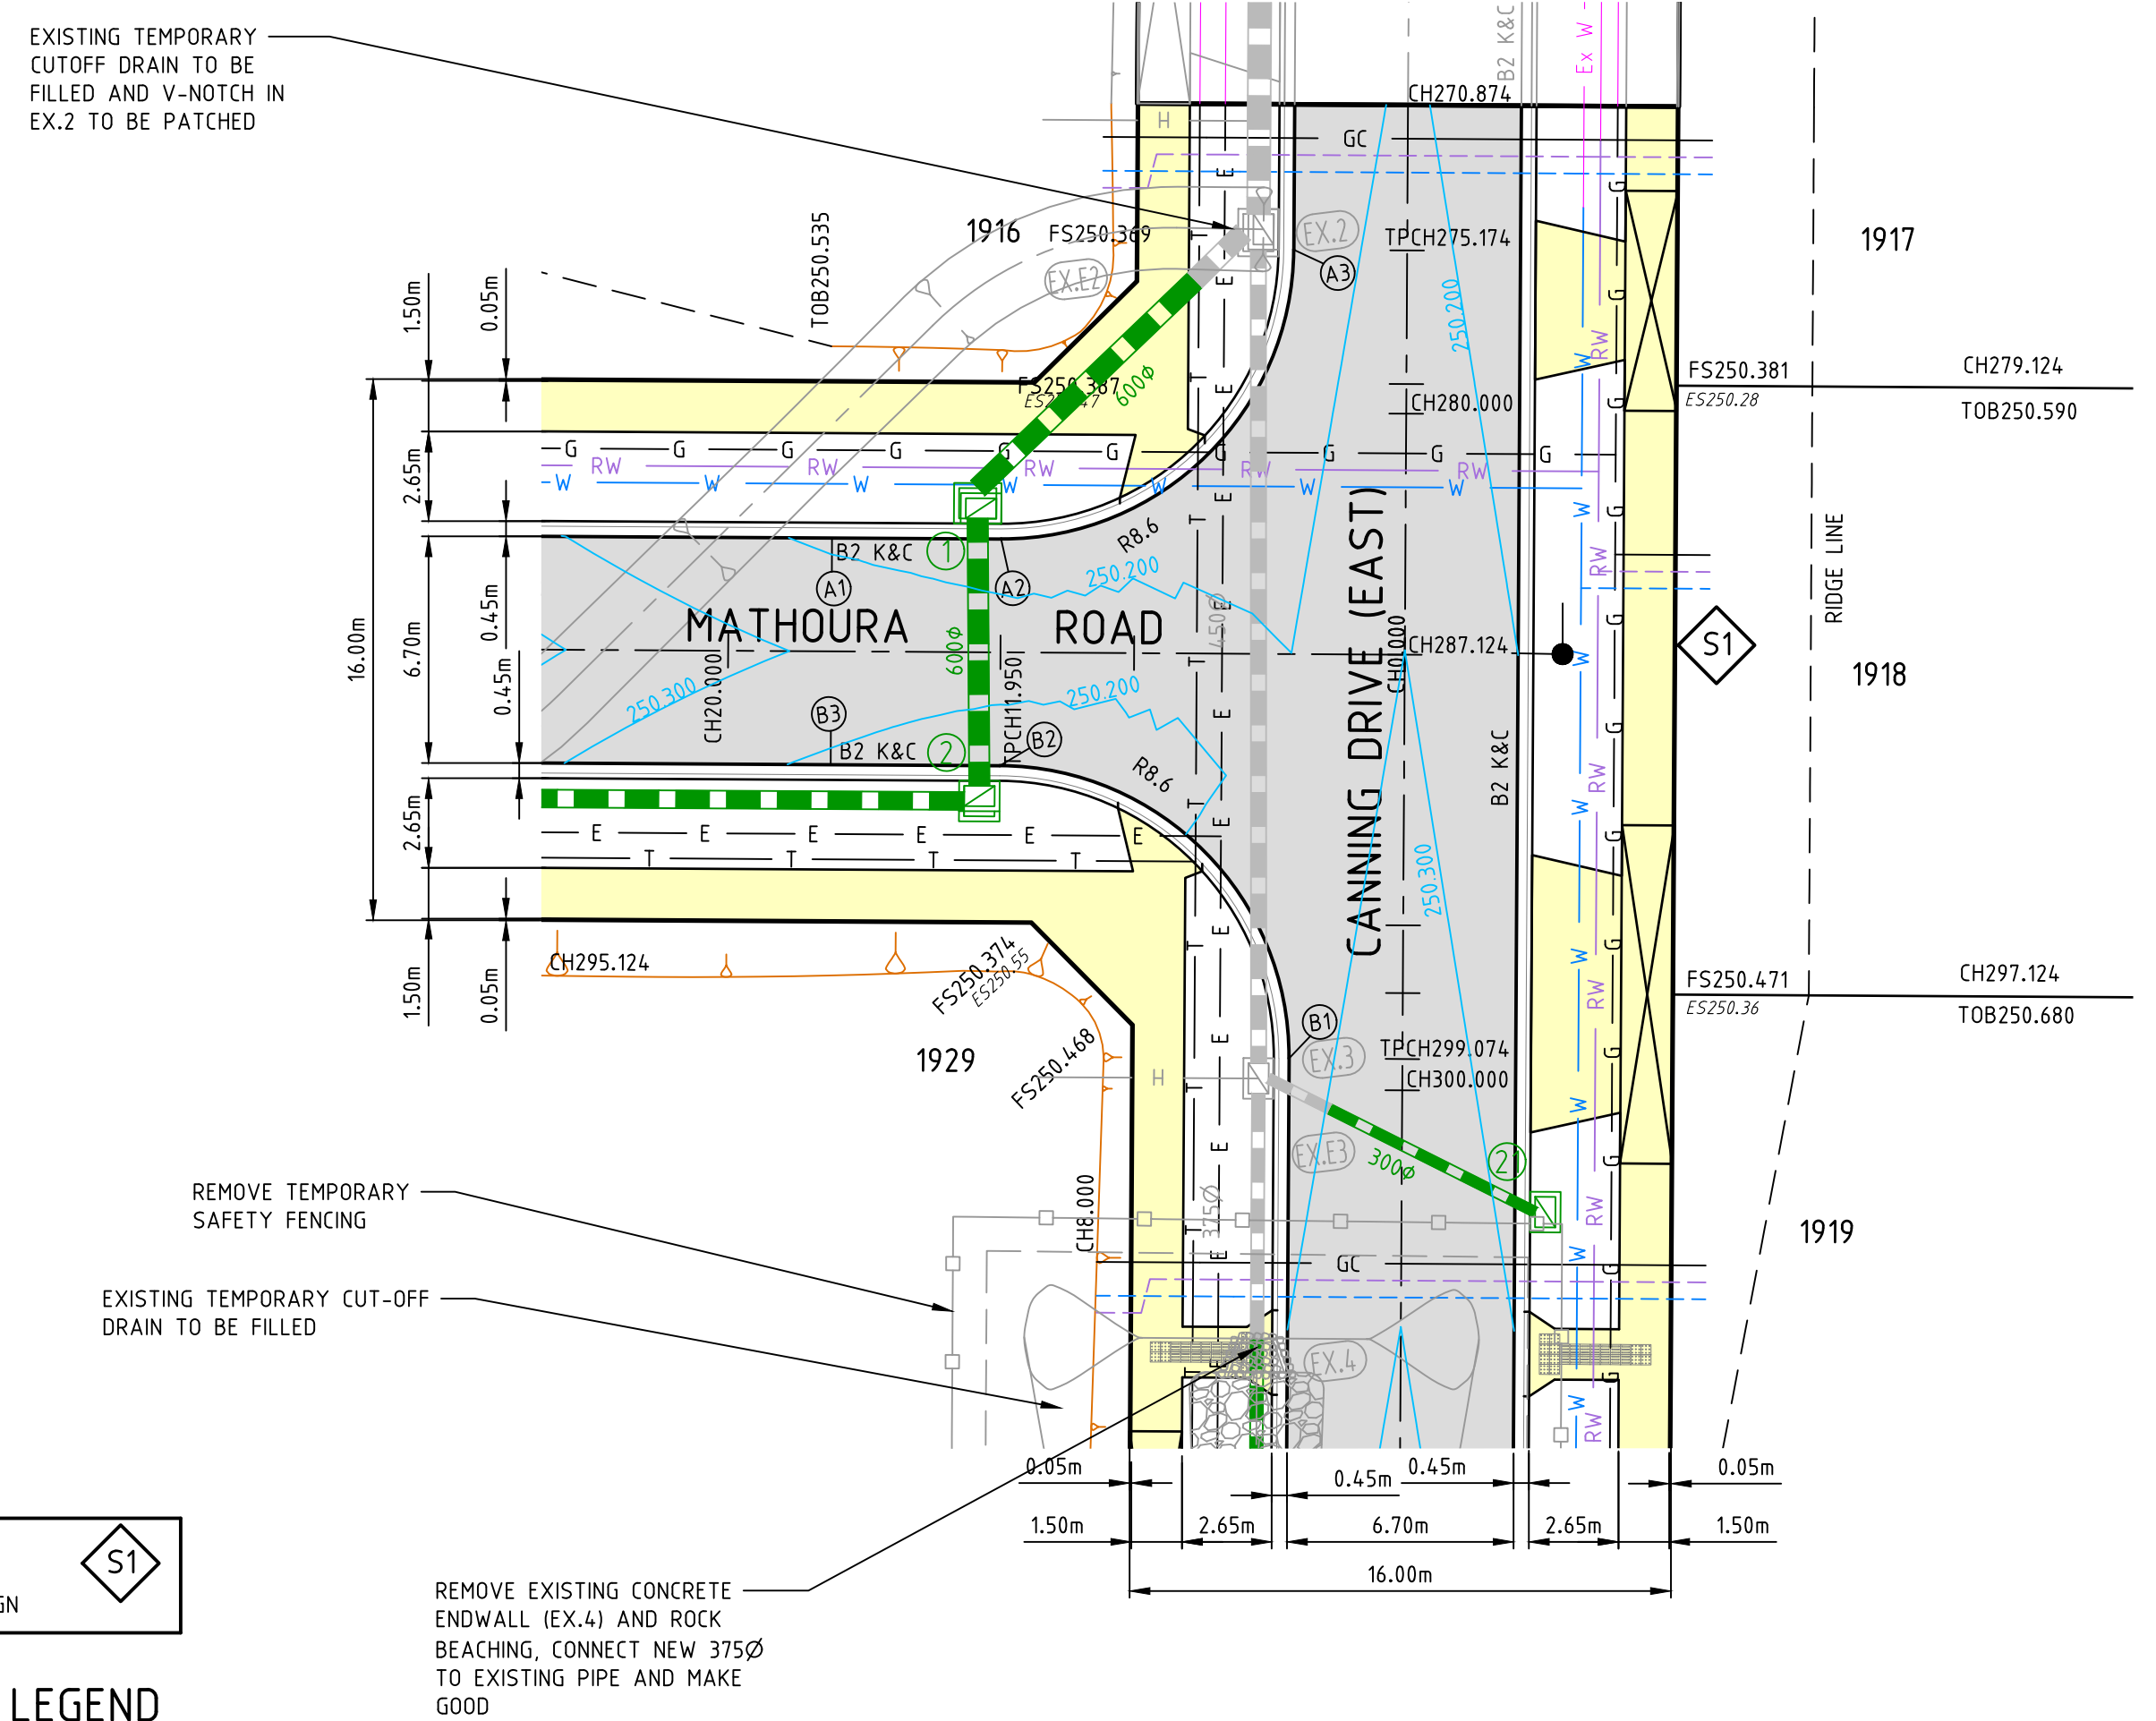


AS CONSTRUCTED

| REV | AMENDMENTS         | DATE     | APP'D. |
|-----|--------------------|----------|--------|
| 1   | AS CONSTRUCTED     | 08/09/16 | TL     |
| 0   | CONSTRUCTION ISSUE | 03/02/16 | TL     |

Drawn M.CAPALDO  
Date 04/09/15  
AN 1451046  
Designed N.MIRATANA  
Date 24/06/15  
AN 1541353  
Verified B.GORDON  
Date 14/09/15  
AN 162521  
Audited T.TOBQUHOFF  
Date 31/01/16  
AN 912875  
Approved T.LIAKOPOULOS  
Date 03/02/16  
AN 885198

Written dimensions to take precedence over scale. Contractor shall check and verify all dimensions on site. Discrepancies to be brought to the attention of the Superintendent.

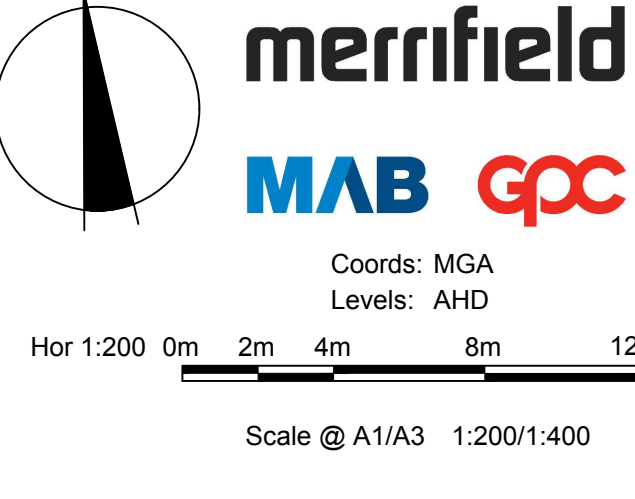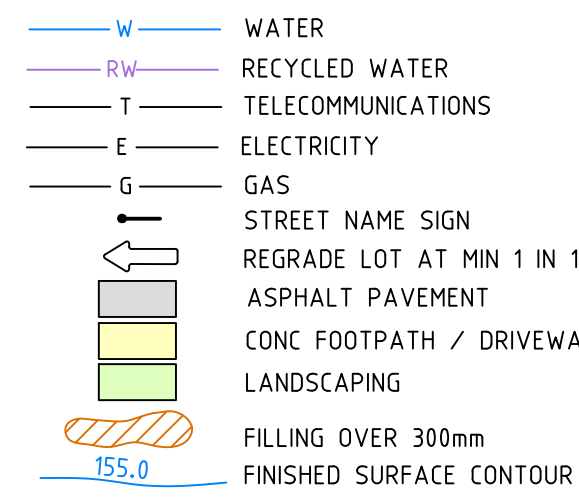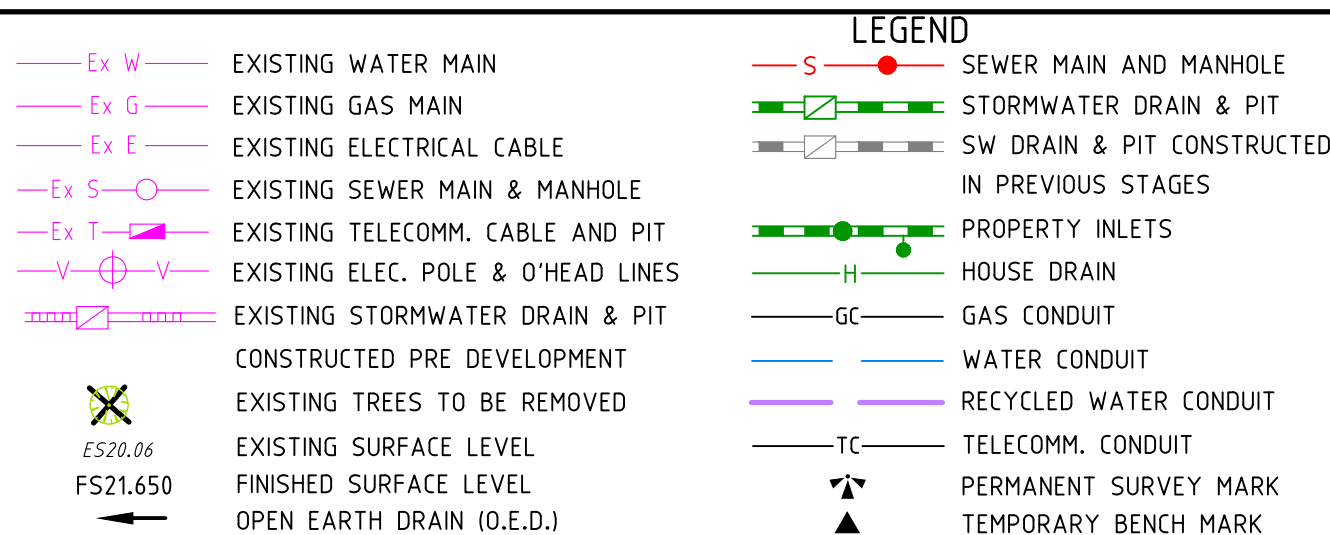


**MERRIFIELD DEVELOPMENT**  
DONNYBROOK ROAD, MICKLEHAM  
STAGE 19  
INTERSECTION DETAILS  
SHEET 01 OF 02  
Drawing No. 11739ID01 Rev 1  
Sheet No. 06 AS CONSTRUCTED  
© Dalton Consulting Engineers Pty Ltd  
ABN 78 429 221 049

**DALTON CONSULTING ENGINEERS**  
ABN 78 429 221 049  
QUEENSLAND  
T 61 7 3374 9000  
E info@dceng.com.au


VICTORIA  
T 61 3 9813 7400  
W dceng.com.au



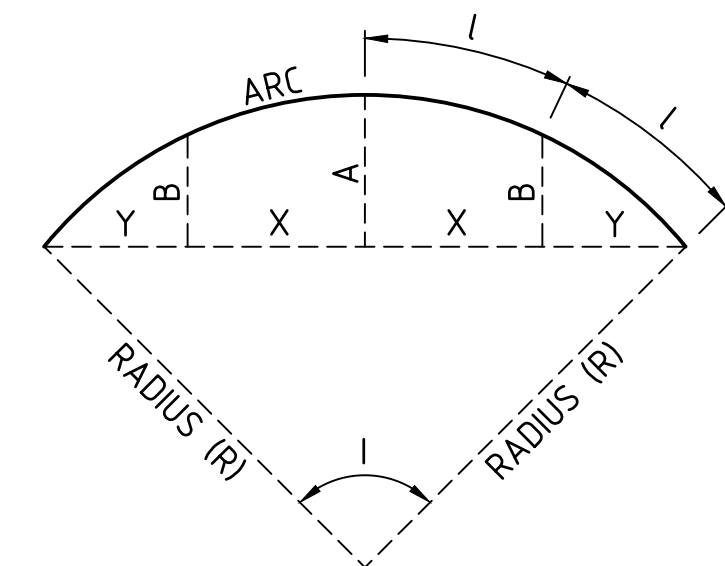

LIP SETOUT DETAIL  
N.T.S

**WARNING!**  
THE LOCATION OF EXISTING SERVICES SHOWN  
ON THESE PLANS MUST BE PROVEN ON SITE,  
THE APPROPRIATE AUTHORITY MUST BE  
CONTACTED AND THE SERVICES LOCATED PRIOR  
TO COMMENCEMENT OF ANY WORKS.

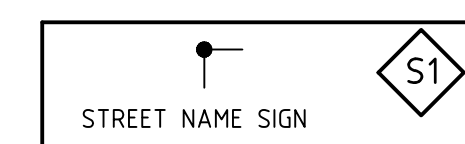


## SIGNAGE LEGEND

| POINT NO | EASTING    | NORTHING    | RL      |
|----------|------------|-------------|---------|
| C1       | 314498.384 | 5843725.159 | 252.273 |
| C2       | 314505.863 | 5843715.568 | 252.288 |

| POINT NO | EASTING    | NORTHING    | RL      |
|----------|------------|-------------|---------|
| D1       | 314482.082 | 5843718.518 | 252.554 |
| D2       | 314491.736 | 5843725.989 | 252.273 |

| POINT NO | EASTING    | NORTHING    | RL      |
|----------|------------|-------------|---------|
| E1       | 314520.143 | 5843830.988 | 251.009 |
| E2       | 314510.552 | 5843823.509 | 251.089 |

| POINT NO | EASTING    | NORTHING    | RL      |
|----------|------------|-------------|---------|
| F1       | 314503.903 | 5843824.332 | 251.089 |
| F2       | 314496.424 | 5843833.923 | 251.283 |

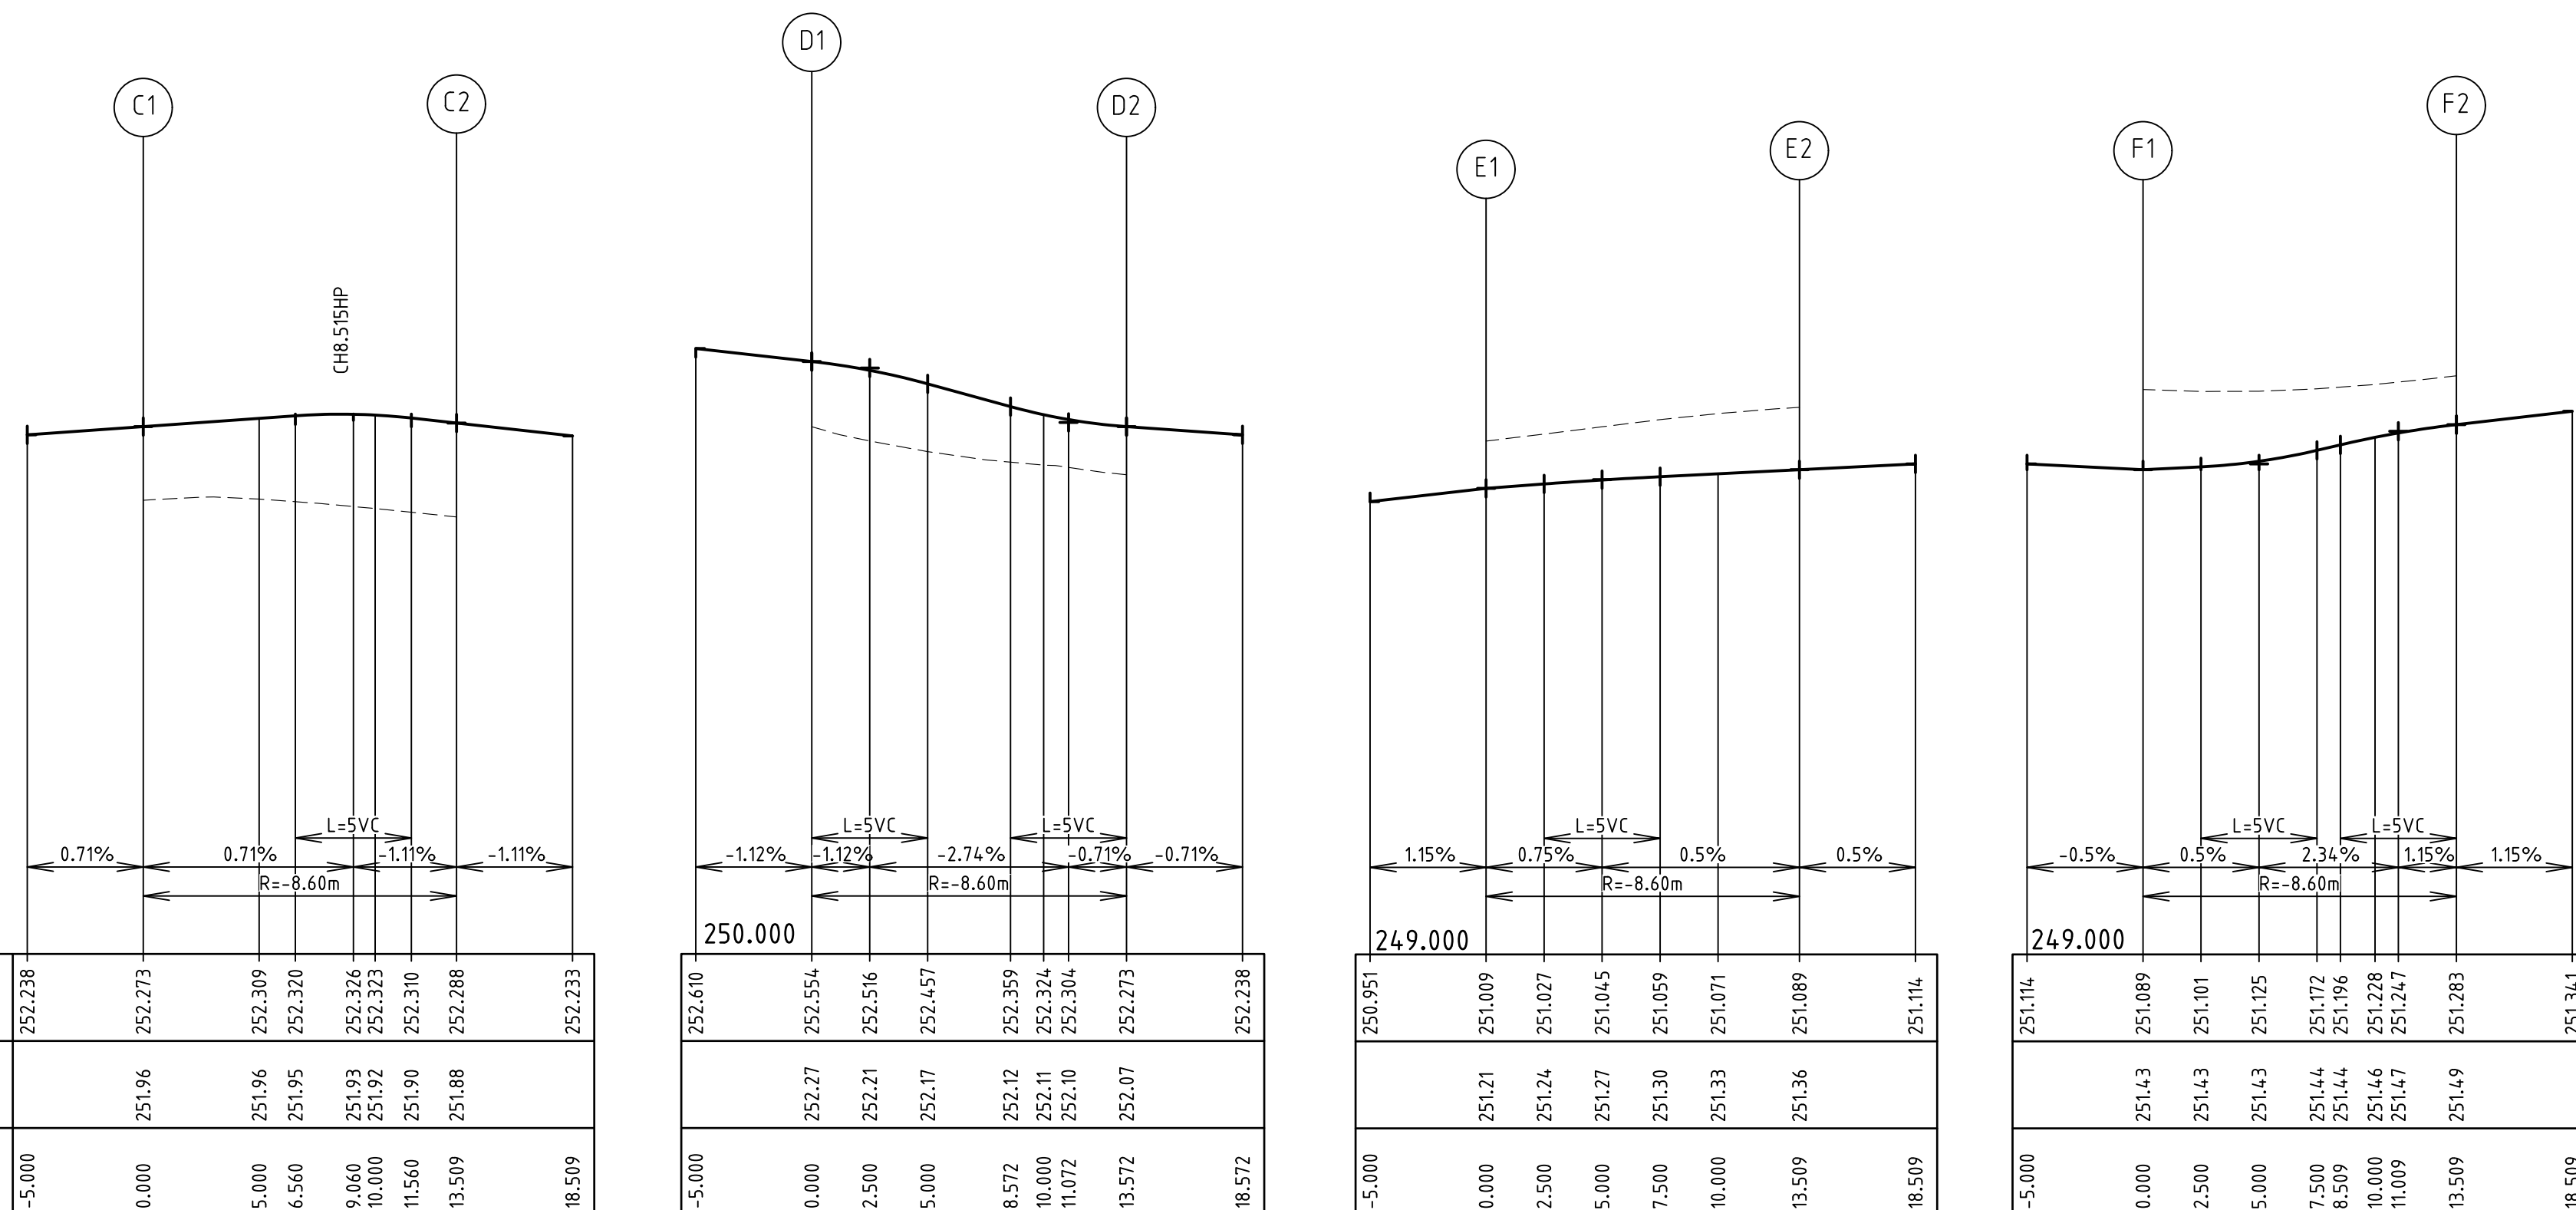LIP PROFILE C

LIP PROFILE D

LIP PROFILE E

LIP PROFILE F

## AS CONSTRUCTED

| VERTICAL GEOMETRY |         | HORIZONTAL GEOMETRY |         | DATUM 250 |         |
|-------------------|---------|---------------------|---------|-----------|---------|
|                   |         | 0.71%               |         | 0.71%     |         |
|                   |         | R=8.60m             |         | -1.11%    |         |
|                   |         |                     |         | -1.11%    |         |
| DESIGN SURFACE    | 252.238 | 252.273             | 252.239 | 252.220   | 252.276 |
| EXISTING SURFACE  | 251.96  | 251.95              | 251.93  | 251.92    | 251.90  |
| CHAINAGE          | -5.000  | 0.000               | 5.000   | 6.560     | 9.060   |
|                   |         |                     |         |           | 10.000  |
|                   |         |                     |         |           | 11.560  |
|                   |         |                     |         |           | 13.509  |
|                   |         |                     |         |           | 14.509  |


|  |        |         |         |
|--|--------|---------|---------|
|  | -5,000 | 252,610 | 252,610 |
|  | 0,000  | 252,27  | 252,554 |
|  | 22,500 | 252,21  | 252,516 |
|  | 45,000 | 252,17  | 252,457 |
|  | 68,572 | 252,12  | 252,359 |
|  | 10,000 | 252,11  | 252,324 |
|  | 11,072 | 252,10  | 252,304 |
|  | 13,572 | 252,07  | 252,273 |
|  | 18,572 |         | 252,238 |

|        |         |         |
|--------|---------|---------|
| -5,000 | 250,951 | 249,000 |
| 0.0000 | 251,009 |         |
| 0.0000 | 251,027 |         |
| 0.0000 | 251,045 |         |
| 0.0000 | 251,059 |         |
| 0.0000 | 251,071 |         |
| 0.0000 | 251,089 |         |
| 0.0000 | 251,116 |         |

|  |        |         |         |
|--|--------|---------|---------|
|  | -5,000 | 251,114 | 249,000 |
|  | 0.000  | 251,43  | 251,089 |
|  | 2,500  | 251,43  | 251,101 |
|  | 45,000 | 251,43  | 251,125 |
|  | 7,500  | 251,44  | 251,172 |
|  | 6,509  | 251,44  | 251,196 |
|  | 10,000 | 251,46  | 251,228 |
|  | 11,009 | 251,47  | 251,247 |
|  | 13,509 | 251,49  | 251,283 |
|  | 18,509 | 251,49  | 251,311 |

 SEWER MAIN AND MANHOLE  
 STORMWATER DRAIN & PIT  
 SW DRAIN & PIT CONSTRUCTED  
 IN PREVIOUS STAGES  
 PROPERTY INLETS  
 HOUSE DRAIN  
 GAS CONDUIT  
 WATER CONDUIT  
 RECYCLED WATER CONDUIT  
 TELECOMM. CONDUIT  
 PERMANENT SURVEY MARK  
 TEMPORARY BENCH MARK

 W WATER  
 RW RECYCLED WATER  
 T TELECOMMUNICATIONS  
 E ELECTRICITY  
 G GAS  
 STREET NAME SIGN  
 REGRADE LOT AT MIN 1 IN 150  
 ASPHALT PAVEMENT  
 CONC FOOTPATH / DRIVEWAY  
 LANDSCAPING  
 FILLING OVER 300mm  
 FINISHED SURFACE CONTOUR

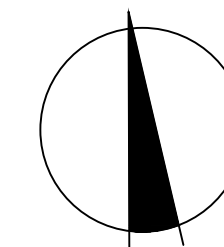

Coords: MGA  
Levels: AHD

Hor 1:200 0m 2m 4m 8m 12m

Scale @ A1/A3 1:200/1:400

**MERRIFIELD DEVELOPMENT**  
DONNYBROOK ROAD, MICKLEHAM  
**STAGE 19**  
**INTERSECTION DETAILS**  
**SHEET 02 OF 02**  
**Drawing No. 11739ID02 Rev 1**  
Sheet No. 07 **AS CONSTRUCTED**  
© Dalton Consulting Engineers Pty Ltd  
ABN 78 429 221 049



DALTON  
CONSULTING  
ENGINEERS

ABN 78 429 221 049  
QUEENSLAND  
T 61 7 3374 9000  
E [info@dceng.com.au](mailto:info@dceng.com.au)

VICTORIA  
T 61 3 9813 7400  
W [dcenq.com.au](http://dcenq.com.au)

|     |                    |          |       |
|-----|--------------------|----------|-------|
| 1   | AS CONSTRUCTED     | 08/09/16 | TL    |
| 0   | CONSTRUCTION ISSUE | 03/02/16 | TL    |
| REV | AMENDMENTS         | DATE     | APP'D |


Drawn M.CAPALDO  
Date 04/09/15  
AN 1451046  
Designed N.MIRATANA  
Date 24/06/15  
AN 1541354  
Verified B.GORDON  
Date 14/09/15  
AN 162522  
Audited T.OBOUHOFF  
Date 31/01/16  
AN 912876  
Approved T.LIAKOPOULOS  
Date 03/02/16  
AN 885198

Written dimensions to take precedence over scale. Contractor shall check and verify all dimensions on site. Discrepancies to be brought to the attention of the Superintendent.

Drawing File: C:\Designdata\11700\11739-MERRIFIELD - Precinct 1 - Stage 19\Acad\RD\1739ID01.dwg    2016 - 4:54pm --byron.shode--  
Date/Time: Thu Sep 08, 2016 - 4:54pm --byron.shode--  
1739ID01.dwg - 11739ID02



Drawing File: G:\Design\11700\11739-MERRIFIELD - Prelim 1 - Stage 19\Acad\10\11739LS01.dwg - 11739LS01  
Date/Time: Thu Sep 08, 2016 - 4:54pm - Byronshade

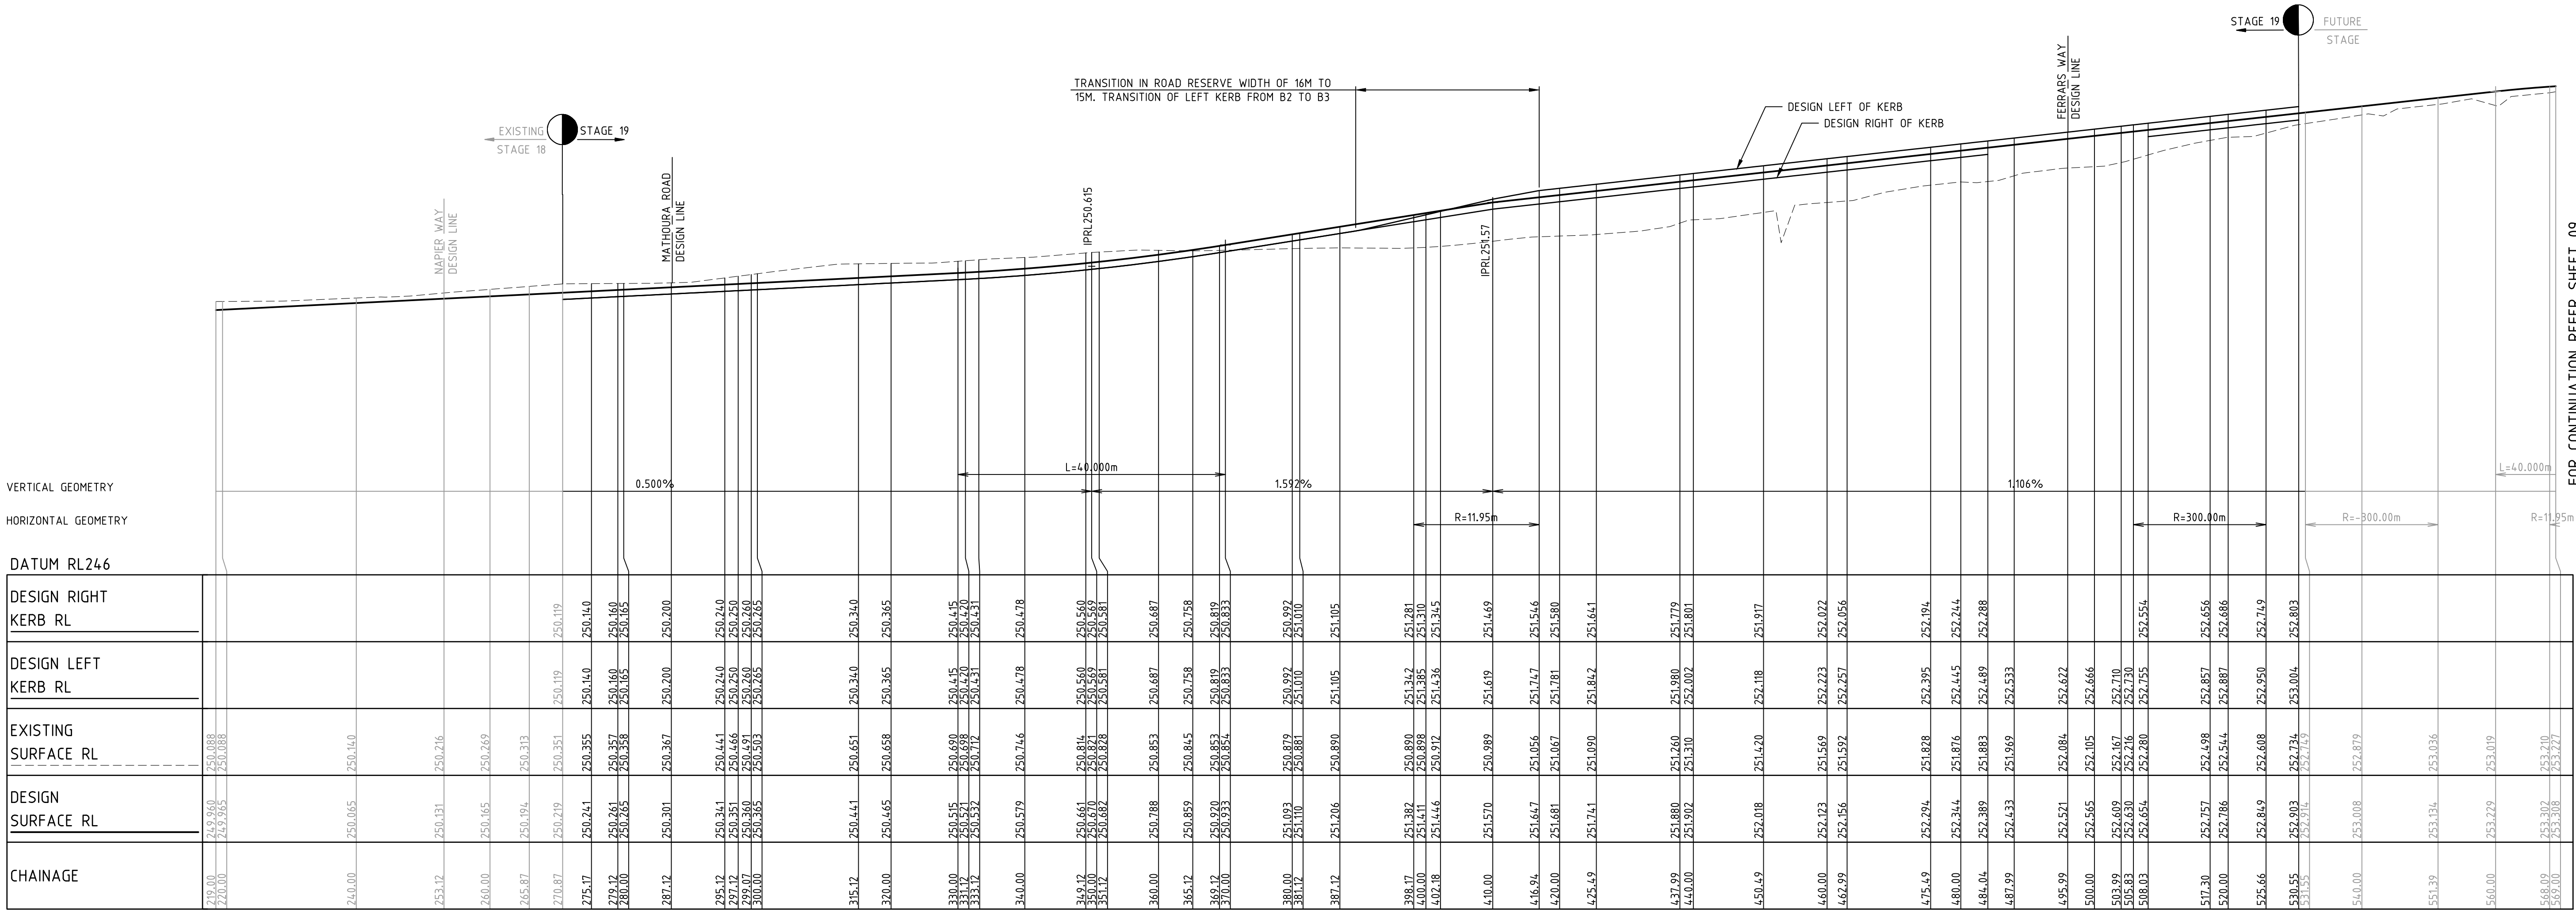

LONGITUDINAL SECTION CANNING DRIVE DESIGN LINE

FOR CONTINUATION REFER SHEET 09

|     |                    |          |        |
|-----|--------------------|----------|--------|
| 1   | AS CONSTRUCTED     | 08/09/16 | TL     |
| 0   | CONSTRUCTION ISSUE | 03/02/16 | TL     |
| REV | AMENDMENTS         | DATE     | APP'D. |


Drawn M.CAPALDO  
Date 04/09/15  
AN 1451046  
Designed N.MIRATANA  
Date 24/06/15  
AN 1541356  
Verified B.GORDON  
Date 14/09/15  
AN 162523  
Audited T.OBOUHOFF  
Date 31/01/16  
AN 912877  
Approved T.LIAKOPOULOS  
Date 03/02/16  
AN 885200

AS CONSTRUCTED



Coords: MGA  
Levels: AHD  
Hor 1:500 0m 5m 10m 20m 30m  
Ver 1:50 0m 0.5m 1m 2m 3m  
Scale @ A1/A3 1:500/1:1000  
VER: 1:500/1:100

MERRIFIELD DEVELOPMENT  
DONNYBROOK ROAD, MICKLEHAM  
STAGE 19  
LONGITUDINAL SECTIONS  
SHEET 01 OF 02  
Drawing No. 11739LS01 Rev 1  
Sheet No. 08 AS CONSTRUCTED  
© Dalton Consulting Engineers Pty Ltd  
ABN 78 429 221 049

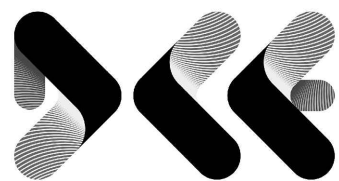


VICTORIA  
T 61 3 9813 7400  
W dceng.com.au  
QUEENSLAND  
T 61 7 3374 9000  
E info@dceng.com.au


ABN 78 429 221 049




FOR CONTINUATION REFER SHEET 08

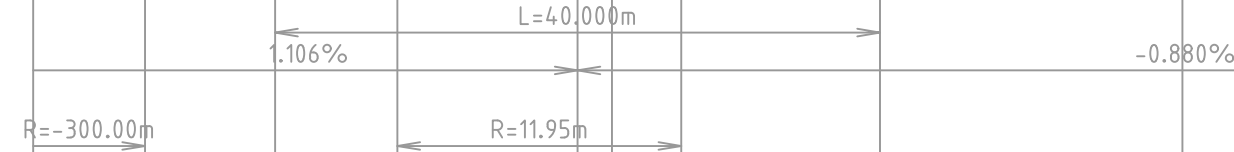[illegible]

LONGITUDINAL SECTION CANNING DRIVE DESIGN LINE

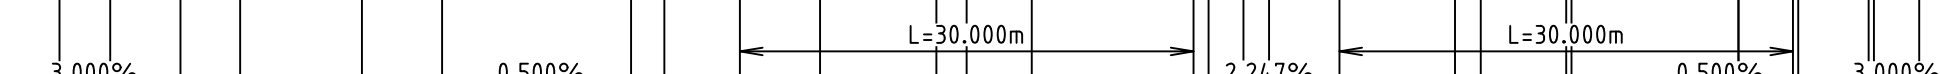[illegible]

## LONGITUDINAL SECTION FERRARS WAY DESIGN LINE

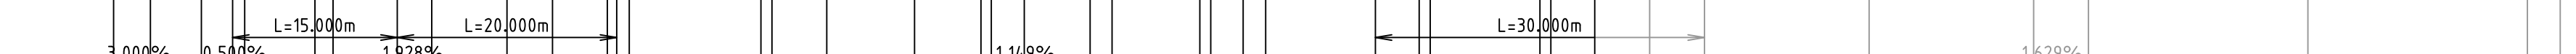

|  |        |         |         |         |
|--|--------|---------|---------|---------|
|  | 0.00   | 250.301 | 250.367 |         |
|  | 3.35   | 250.200 | 250.405 |         |
|  | 8.00   | 250.223 | 250.457 |         |
|  | 10.85  | 250.238 | 250.490 |         |
|  | 11.95  | 250.244 | 250.502 | 250.958 |
|  | 18.35  | 250.302 | 250.595 |         |
|  | 20.00  | 250.323 | 250.621 | 250.201 |
|  |        |         |         | 250.223 |
|  | 25.85  | 250.420 | 250.712 | 250.319 |
|  | 29.00  | 250.479 | 250.750 | 250.378 |
|  | 35.85  | 250.593 | 250.782 | 250.493 |
|  | 40.00  | 250.654 | 250.801 | 250.553 |
|  | 45.00  | 250.718 | 250.824 | 250.617 |
|  | 45.85  | 250.738 | 250.838 | 250.627 |
|  | 47.00  | 250.741 | 250.856 | 250.640 |
|  |        |         |         |         |
|  | 59.00  | 250.838 | 251.021 | 250.778 |
|  | 60.00  | 250.890 | 251.029 | 250.790 |
|  | 65.00  | 250.948 | 251.067 | 250.847 |
|  |        |         |         |         |
|  | 73.00  | 251.040 | 251.130 | 250.939 |
|  | 79.05  | 251.109 | 251.198 | 251.009 |
|  | 80.00  | 251.120 | 251.208 | 251.020 |
|  | 83.00  | 251.155 | 251.242 | 251.054 |
|  | 89.00  | 251.204 | 251.311 | 251.103 |
|  | 91.00  | 251.166 | 251.335 | 251.166 |
|  |        |         |         |         |
|  | 99.00  | 251.338 | 251.432 | 251.238 |
|  | 100.00 | 251.350 | 251.445 | 251.249 |
|  | 102.95 | 251.384 | 251.474 | 251.283 |
|  | 105.00 | 251.407 | 251.497 | 251.307 |
|  |        |         |         |         |
|  | 115.00 | 251.522 | 251.632 | 251.422 |
|  | 119.00 | 251.570 | 251.652 | 251.449 |
|  | 120.00 | 251.582 | 251.660 | 251.461 |
|  |        |         |         |         |
|  | 130.00 | 251.713 | 251.740 | 251.472 |
|  | 131.00 | 251.727 | 251.748 | 251.476 |
|  | 135.00 | 251.784 | 251.817 | 251.684 |
|  | 140.00 | 251.860 | 251.984 |         |
|  | 145.00 | 251.939 | 252.151 |         |
|  |        |         |         |         |
|  | 160.00 | 252.428 | 252.608 |         |
|  | 160.00 | 252.939 | 252.700 |         |
|  |        |         |         |         |
|  | 200.00 | 252.835 | 252.981 |         |
|  |        |         |         |         |
|  | 220.00 | 253.161 | 253.285 |         |
|  | 23.00  | 253.270 | 253.330 |         |

LONGITUDINAL SECTION MATHOURA ROAD DESIGN LINE

## AS CONSTRUCTED



Hor 1:500 0m 5m 10m 20m 30m  
Ver 1:50 0m 0.5m 1m 2m 3m  
Scale @ A1/A3 1:500/1:1000  
VER: 1:50/1/100

**Drawing No.** 11739LS02      **Rev** 1  
Sheet No. 09      **AS CONSTRUCTED**

© Dalton Consulting Engineers Pty Ltd  
ABN 78 429 221 049



**DALTON  
CONSULTING  
ENGINEERS**





VICTORIA  
T 61 3 9813 7400  
W [dceng.com.au](http://dceng.com.au)

QUEENSLAND  
T 61 7 3374 9000  
E [info@dceng.com.au](mailto:info@dceng.com.au)

Drawn M.CAPALDO  
Date 04/09/15  
AN 1451046  
Designed N.MIRATANA  
Date 24/06/15  
AN 1541357  
Verified B.GORDON  
Date 14/09/15  
AN 162524  
Audited T.OBOUHOFF  
Date 31/01/16  
AN 912878  
Approved T.LIAKOPOULOS  
Date 03/02/16  
AN 885201



Drawing File: G:\Design\11700\11739-MERRIFIELD - Precinct 1 - Stage 19\Acad\RD\11739XS01.dwg - 11739XS01  
Date/Time: Thu Sep 08, 2016 - 4:54pm --byronashide--

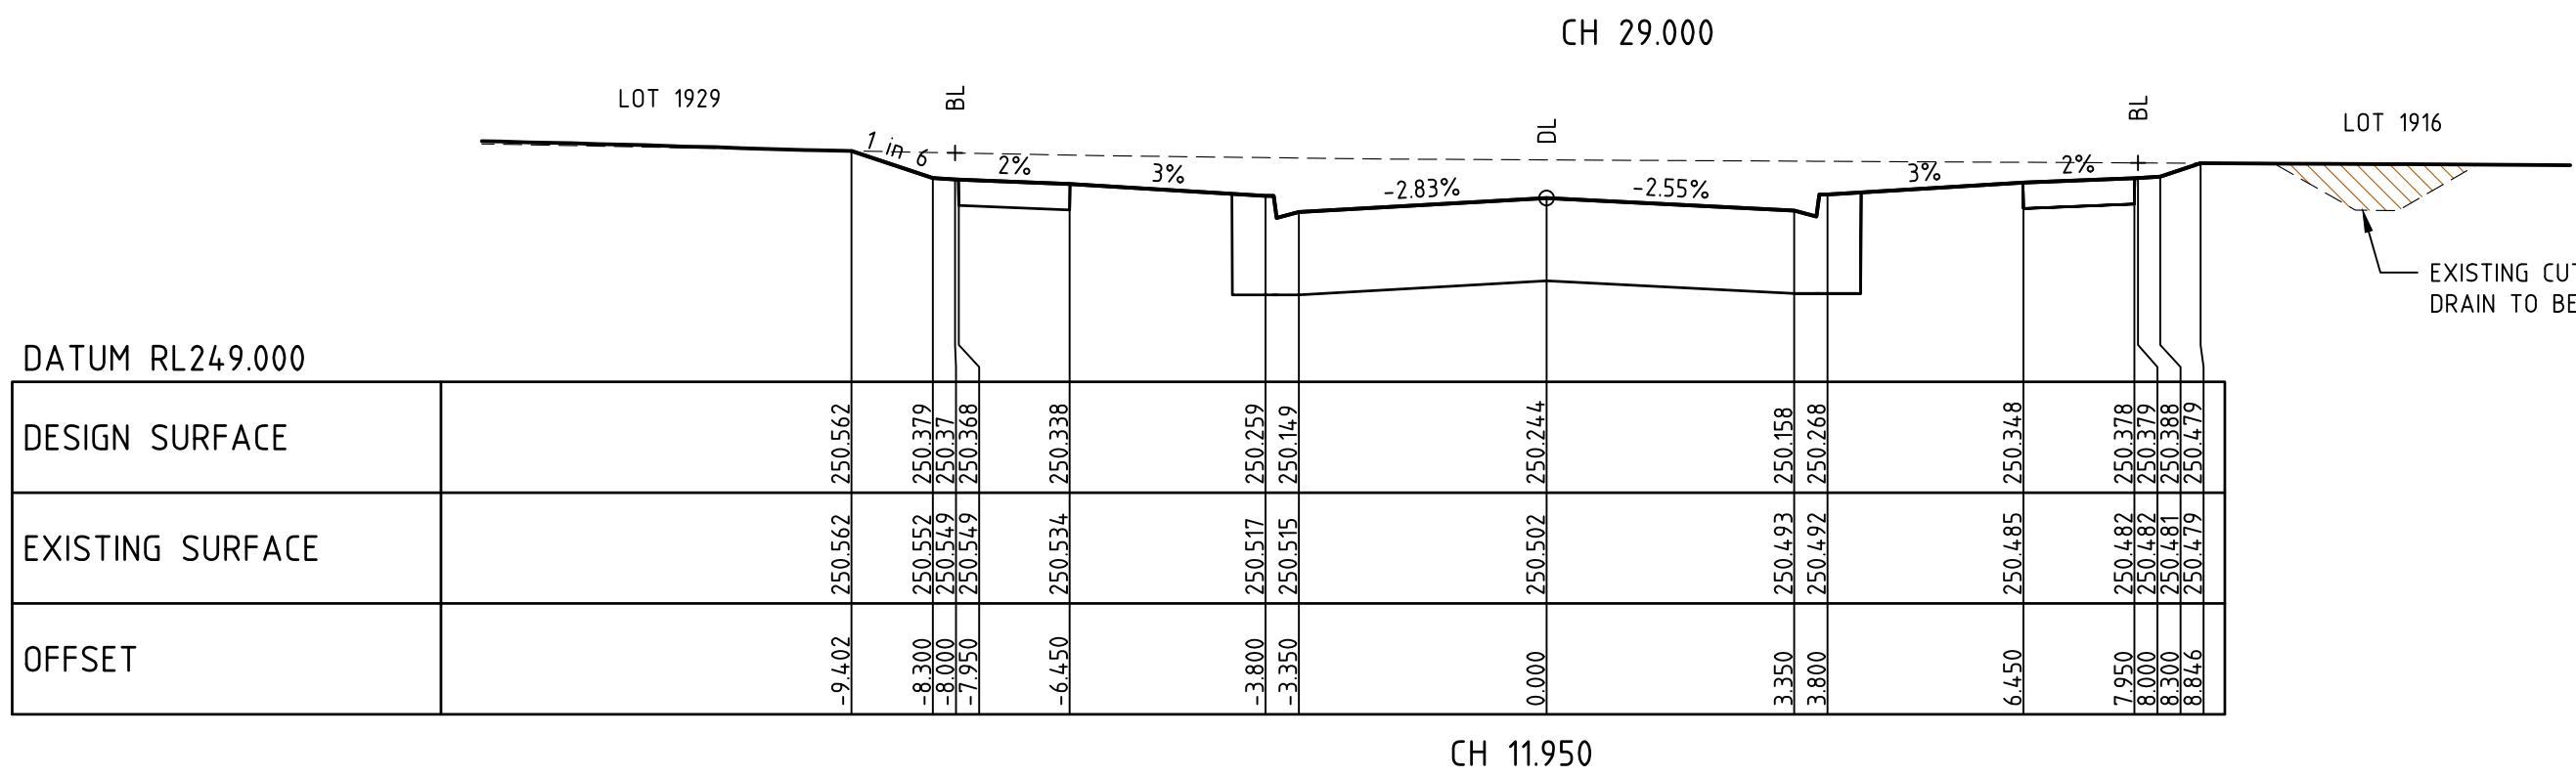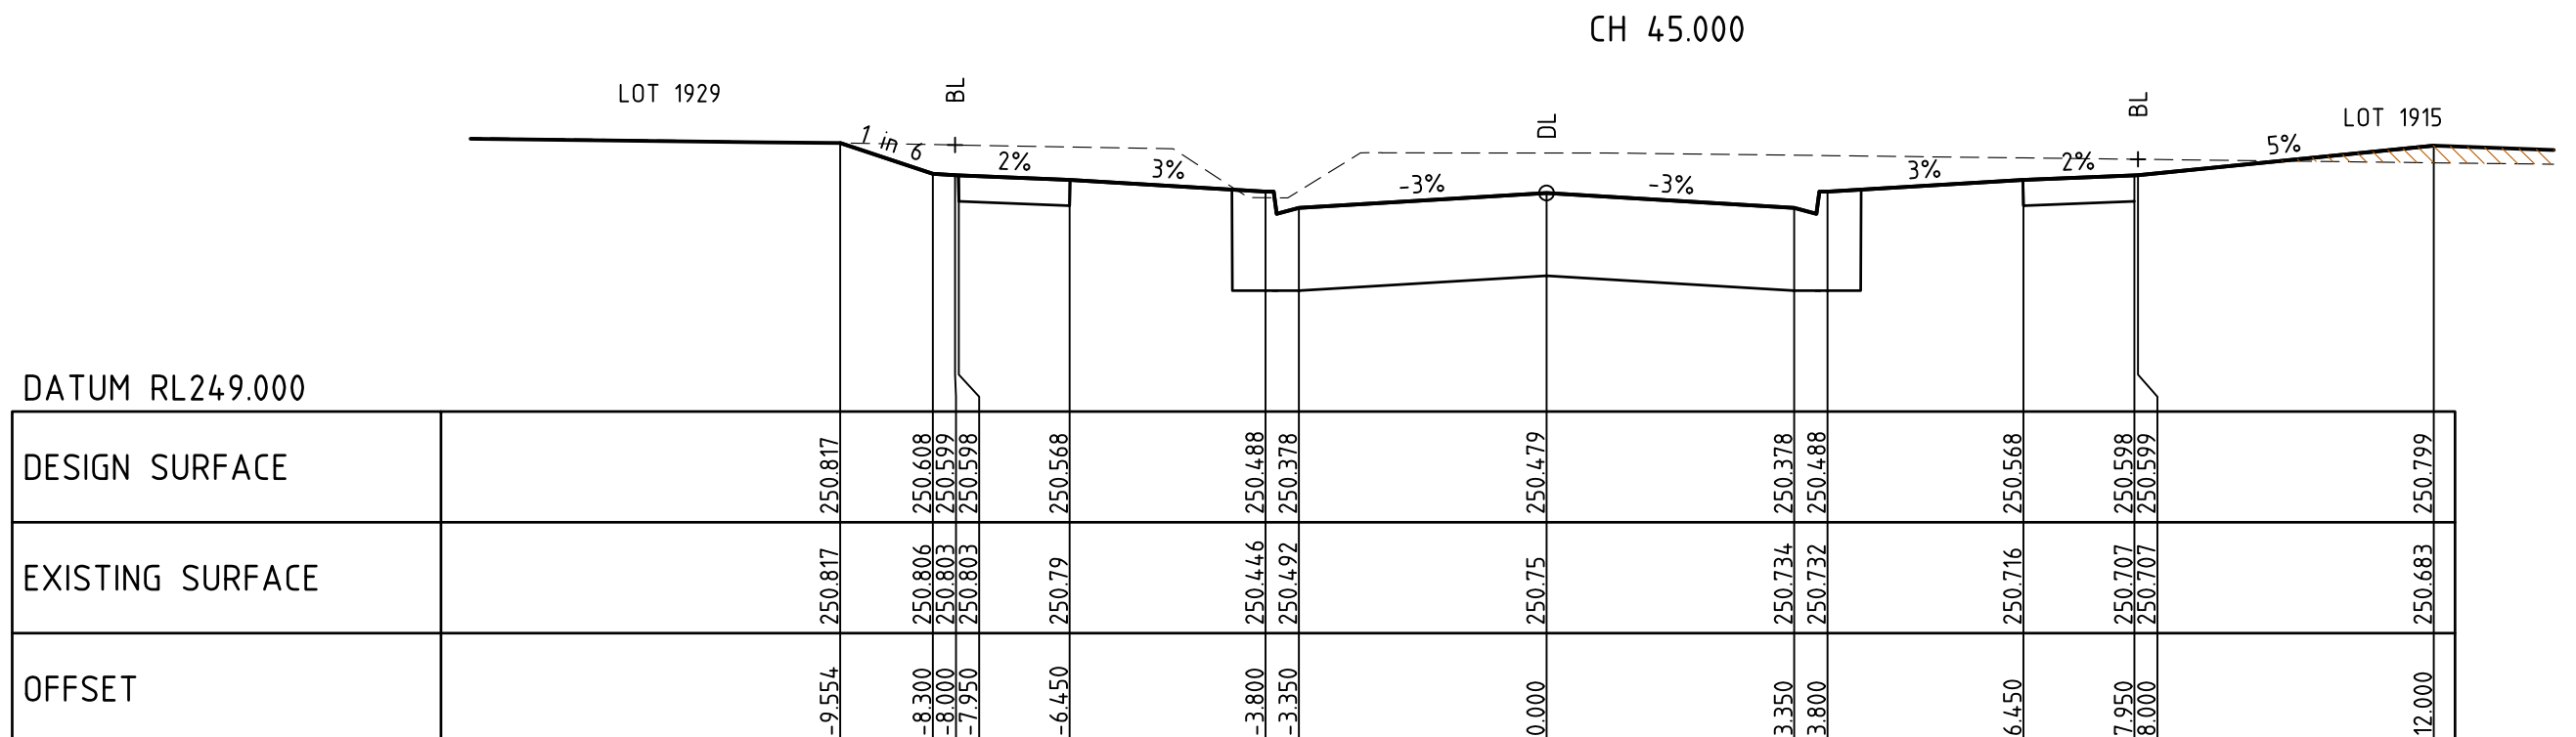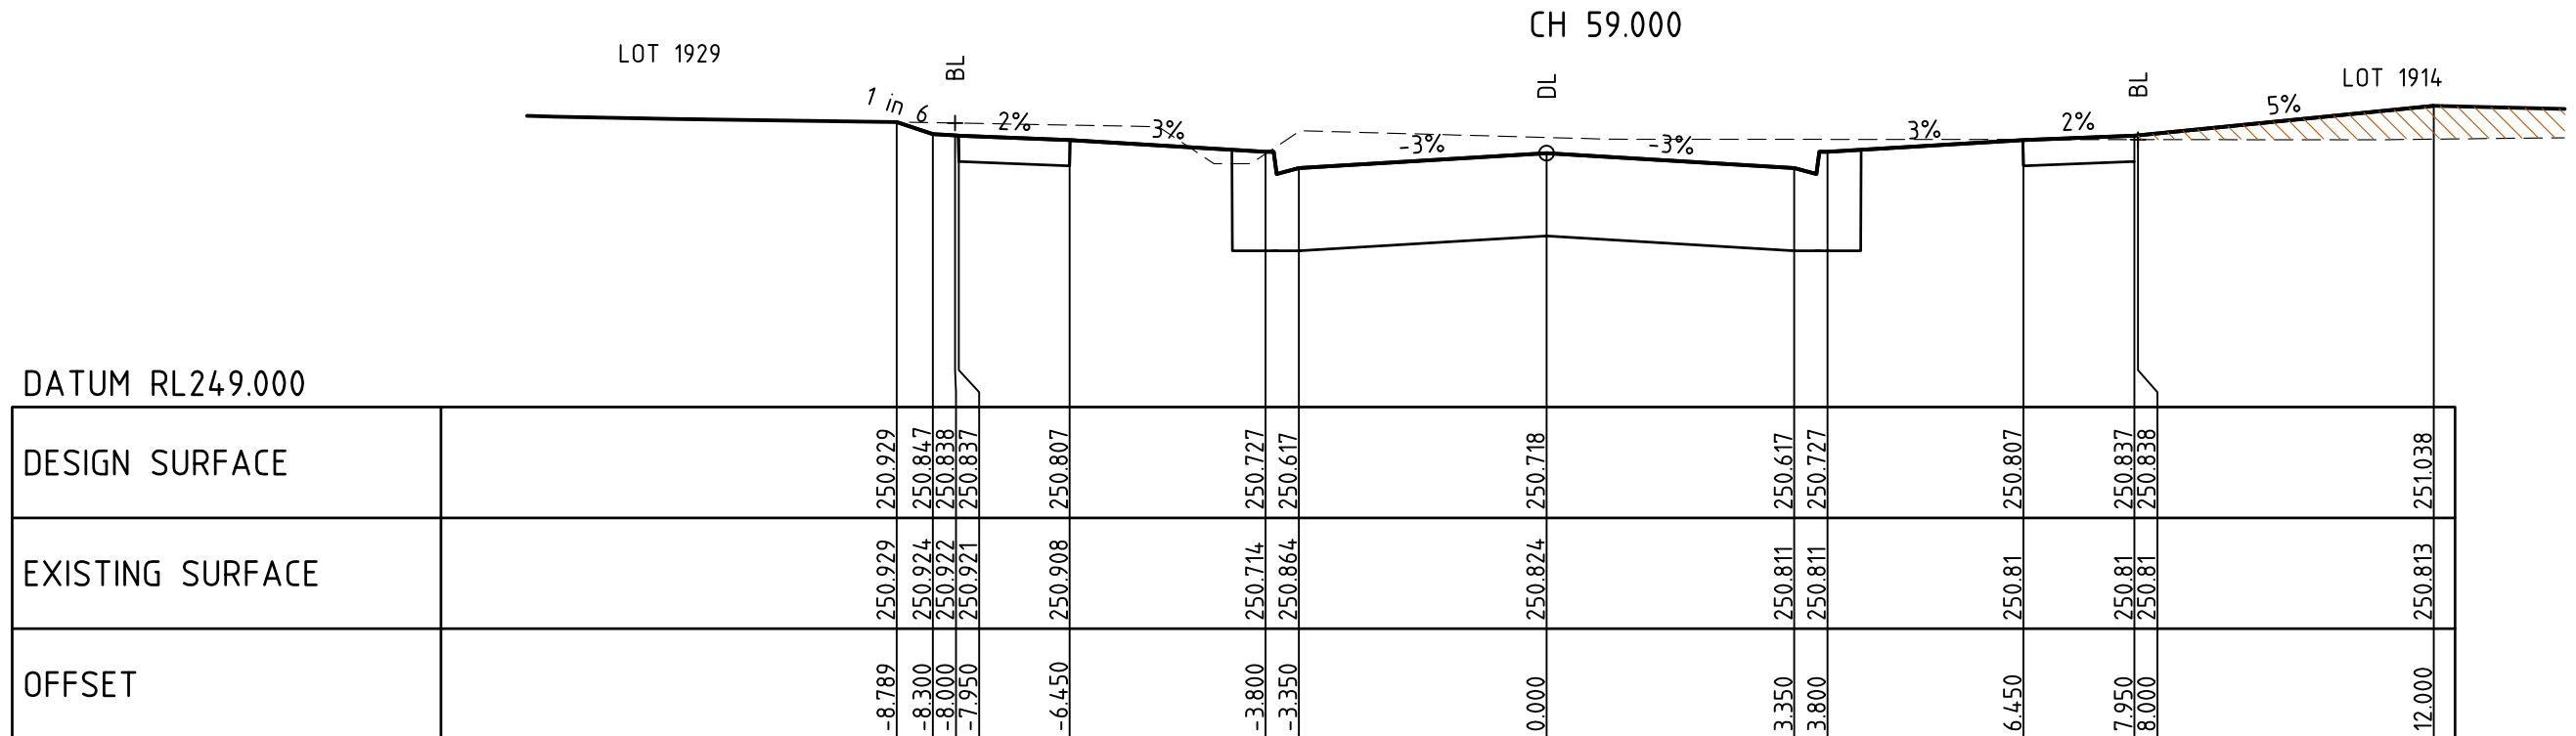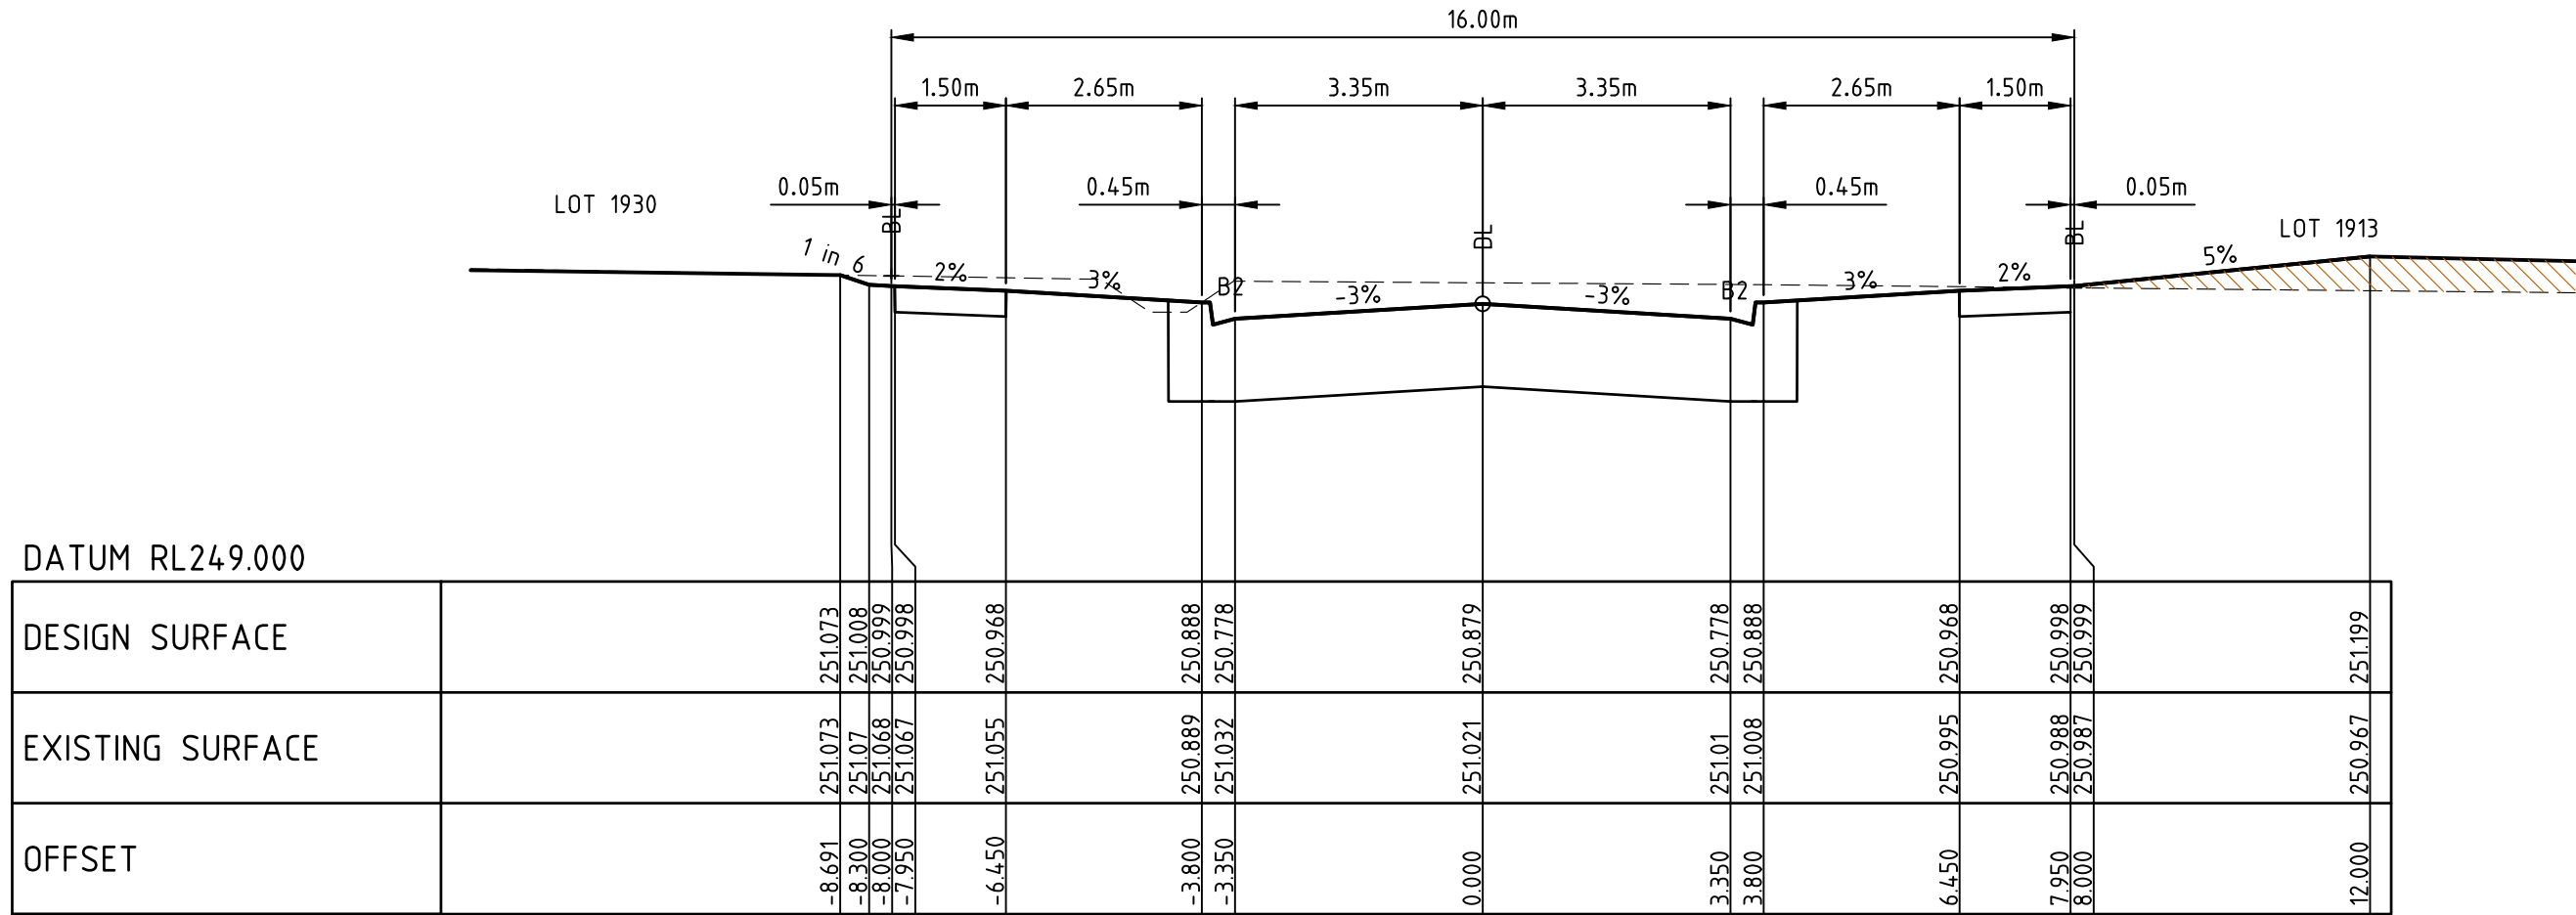





## MATHOURA ROAD

### LEGEND



DENOTES ENGINEERED FILL TO BE IN ACCORDANCE WITH THE GEOTECHNICAL REPORT PREPARED BY GOLDER ASSOCIATES. ENGINEERING FILL TO BE APPROVED BY HUME CITY COUNCIL REFER TO DWG 11739TD01 NOTES, WITH LEVEL 1 SUPERVISION IN ACCORDANCE WITH AS3798-2007.

AS CONSTRUCTED

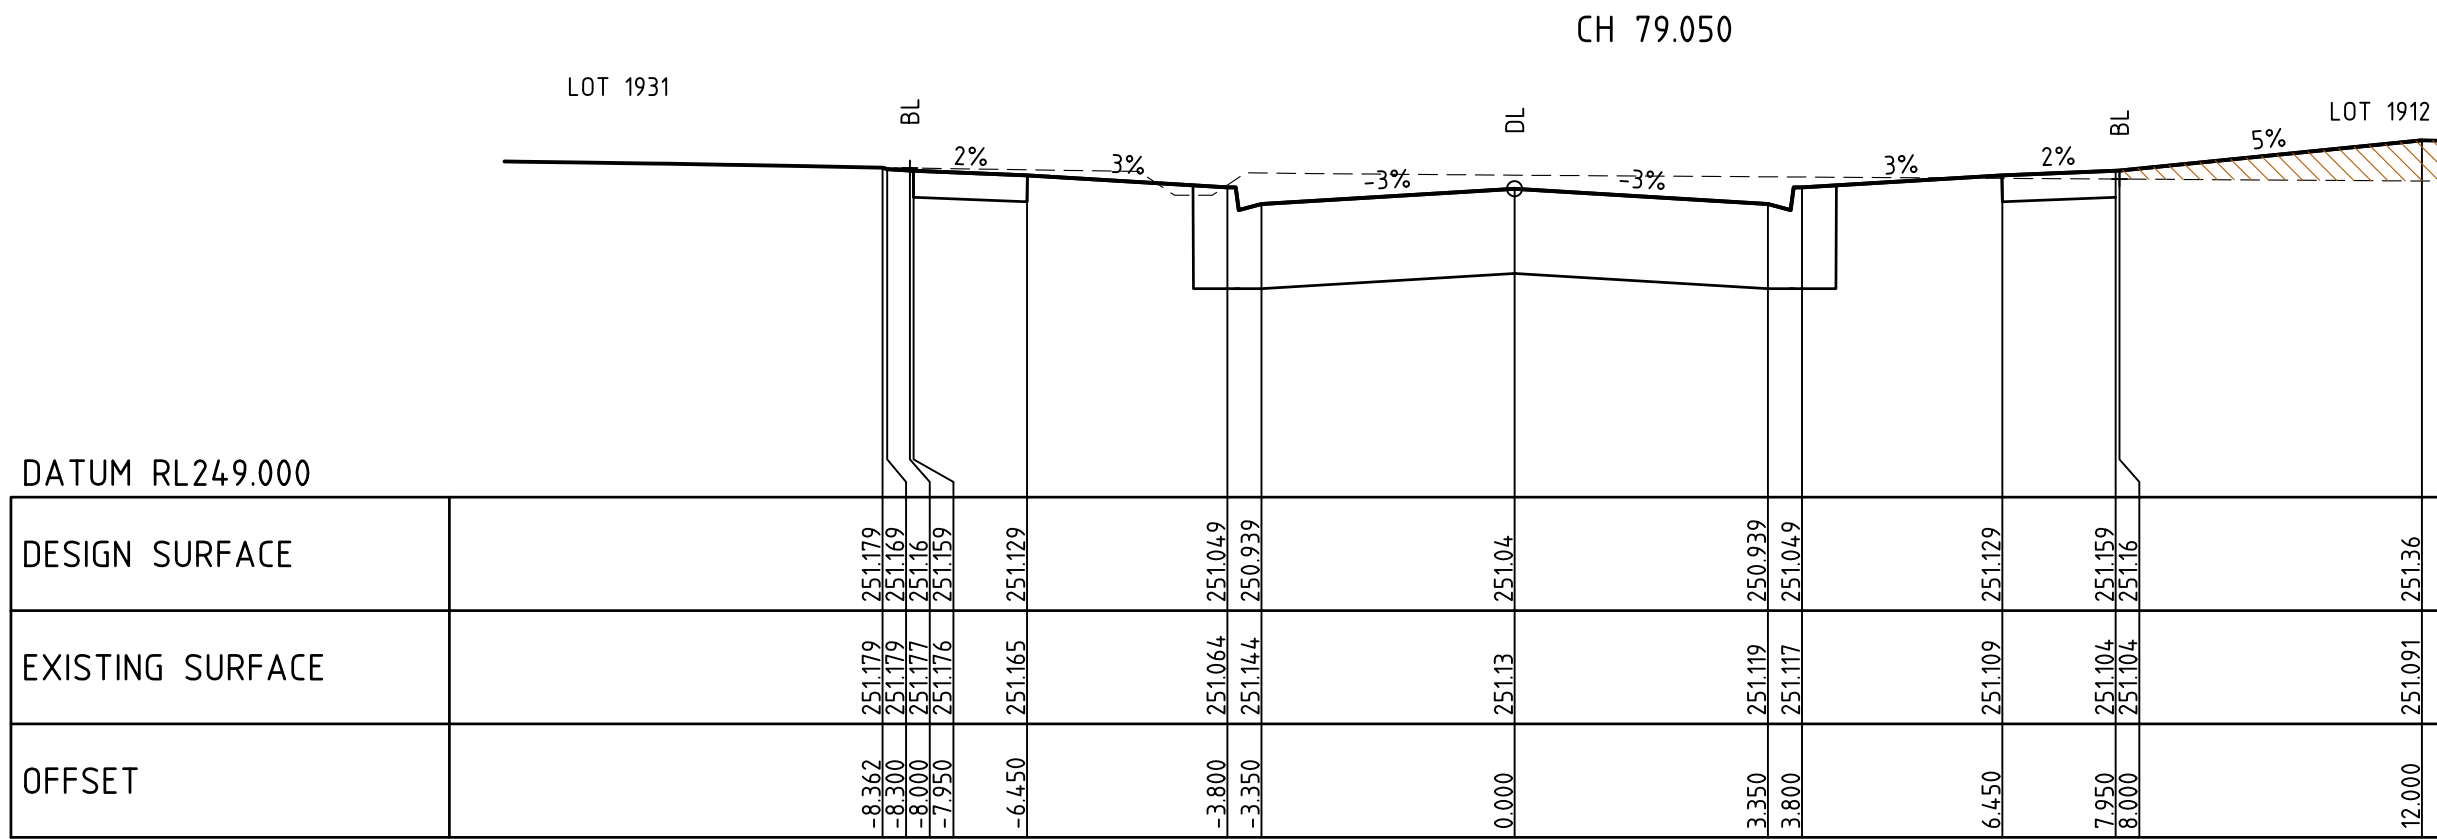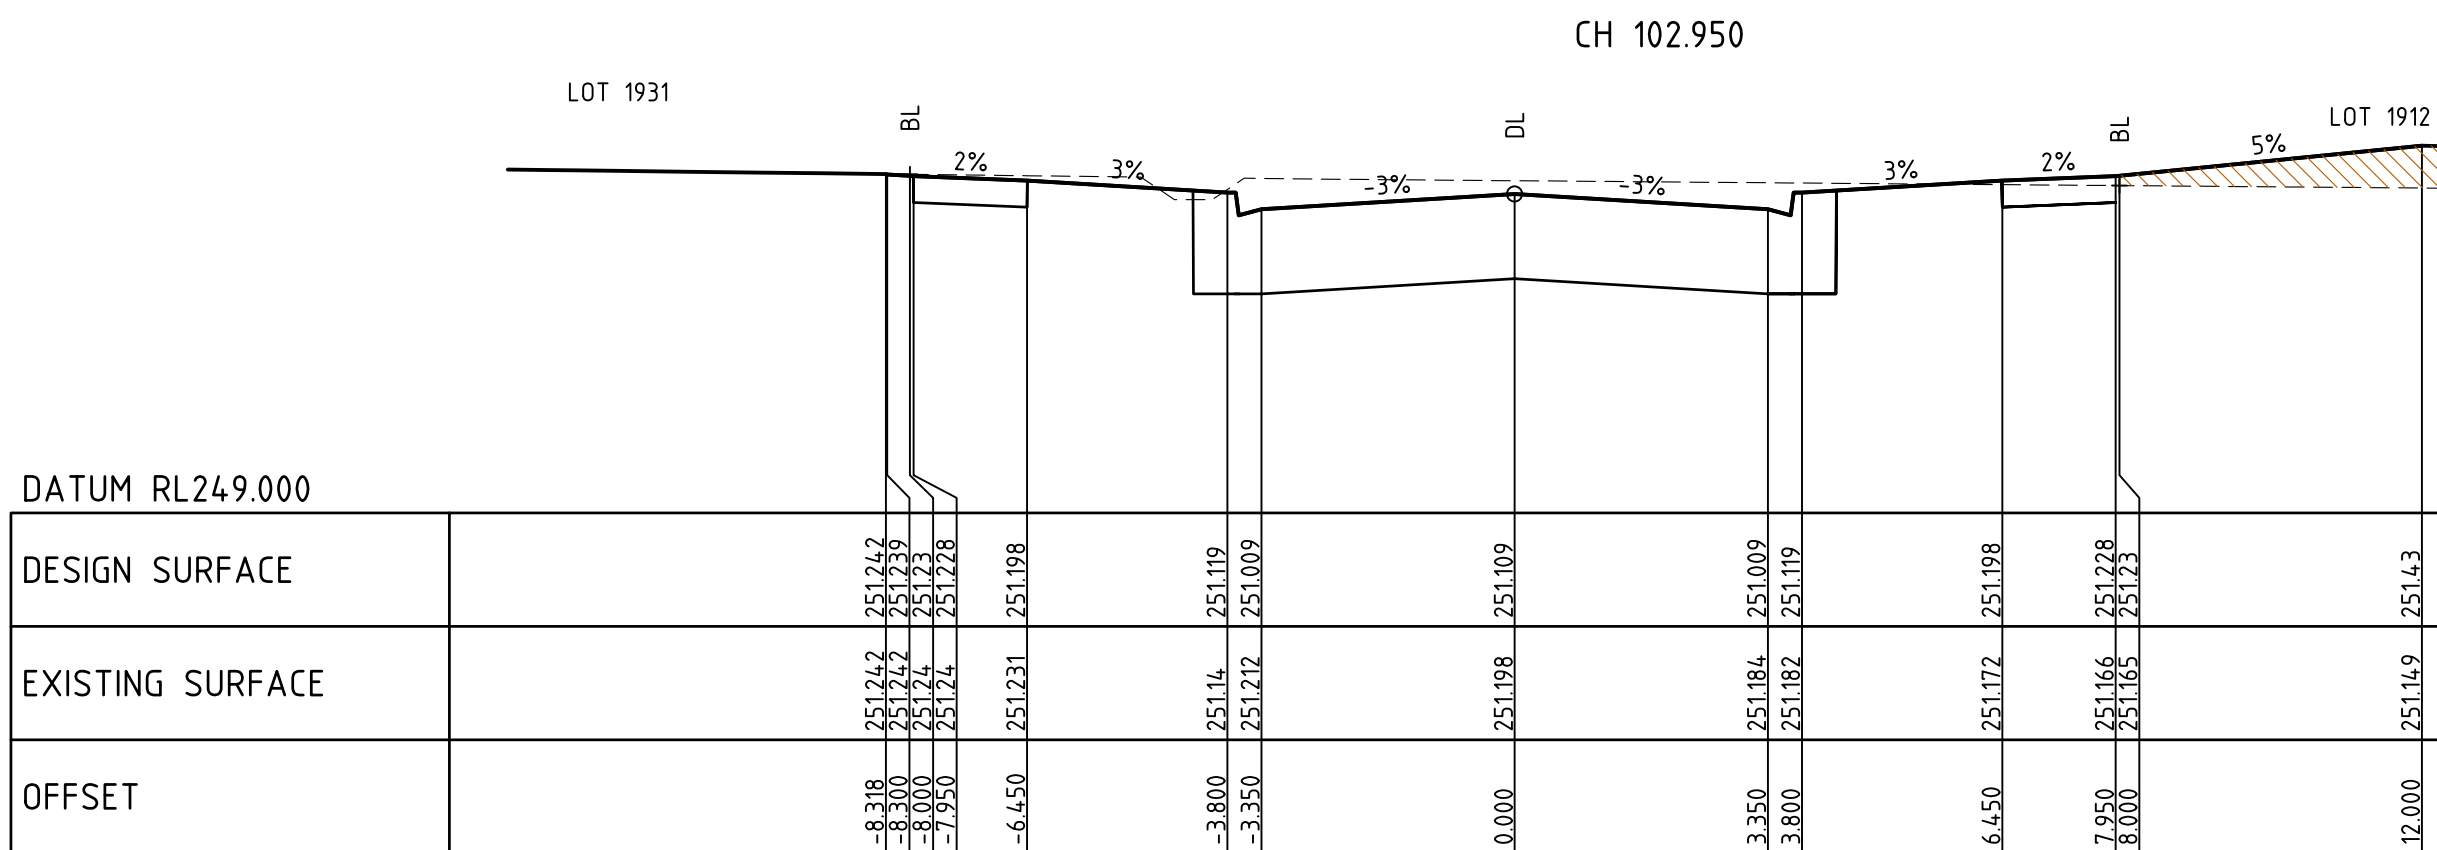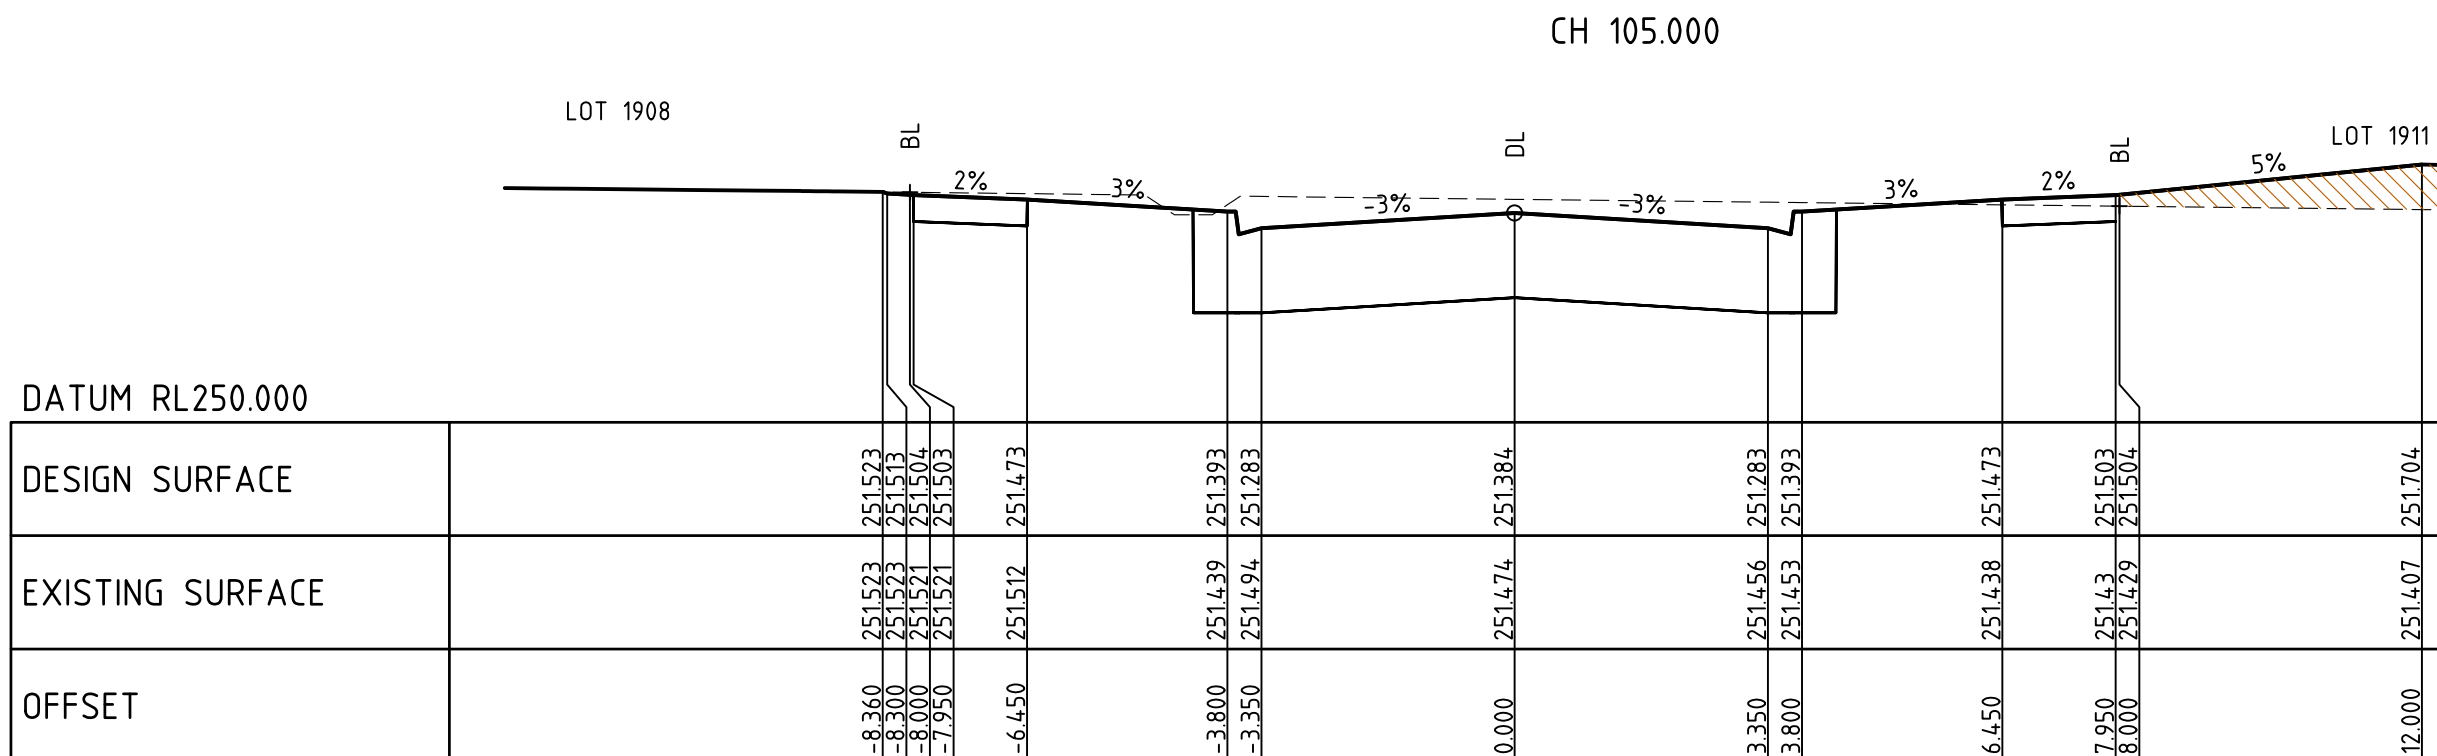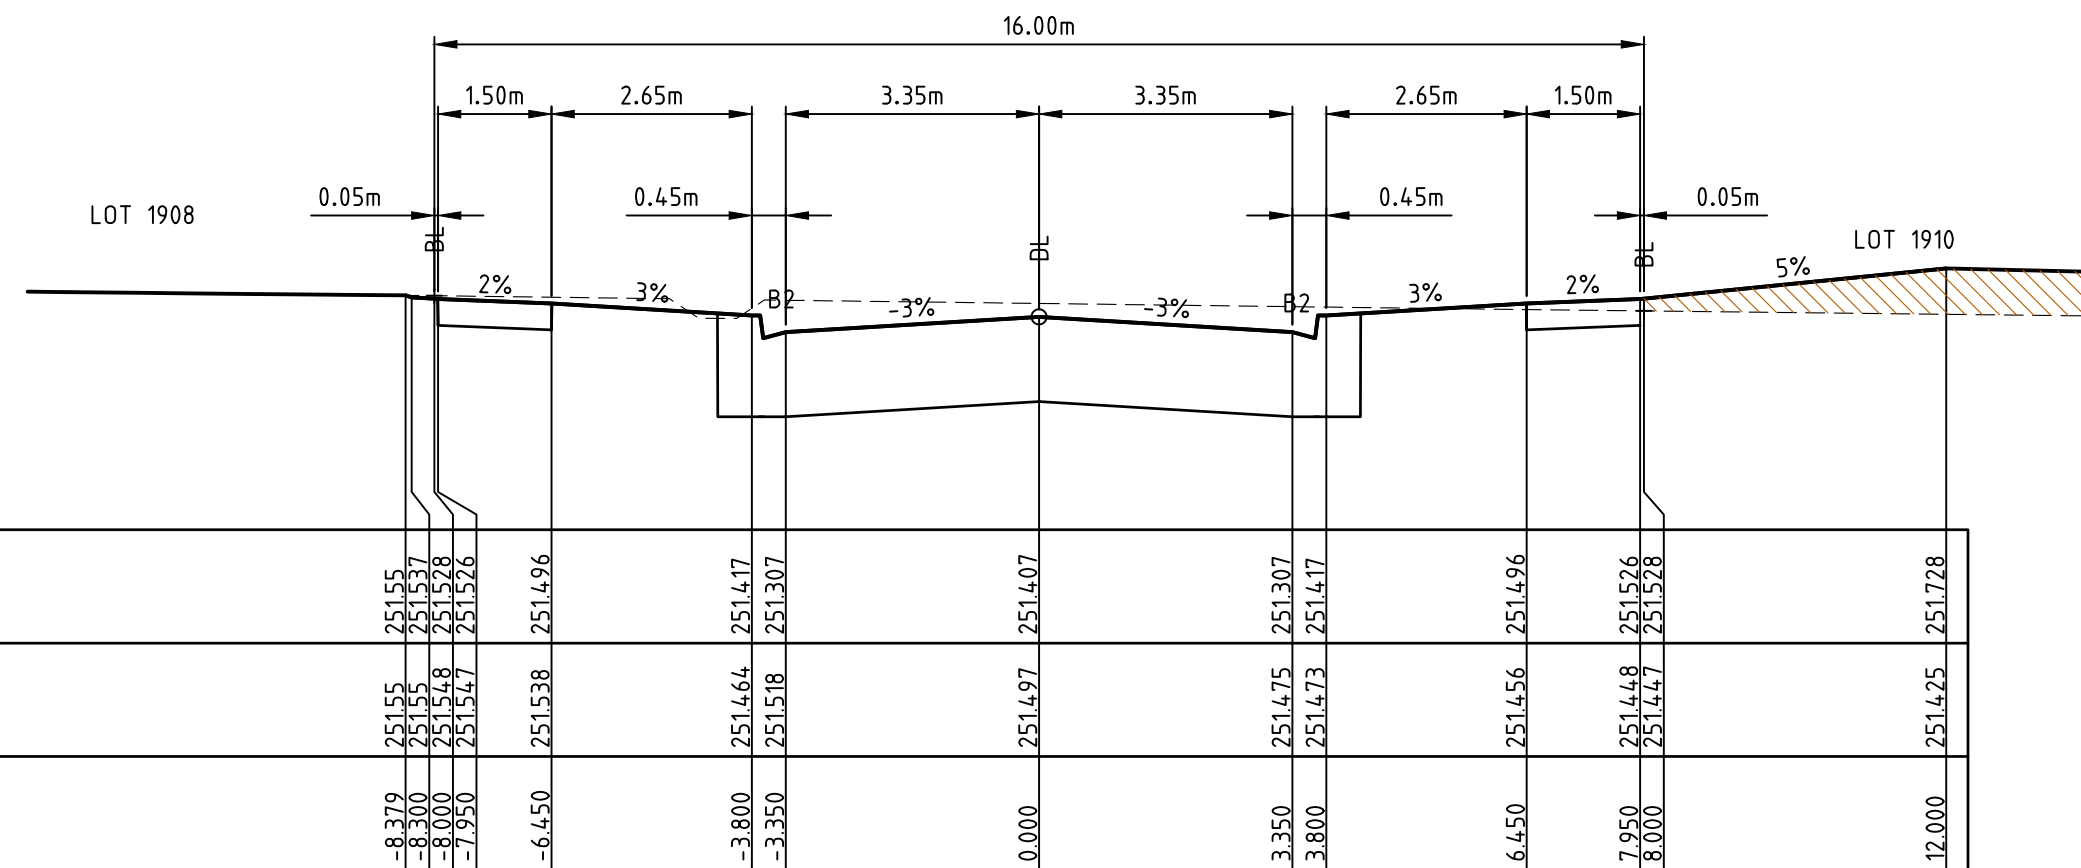

merrifield  
MAB gpc

Coords: MGA  
Levels: AHD  
Hor 1:100 0m 1m 2m 4m 6m  
Ver 1:50 0m 0.5m 1m 2m 3m  
Scale @ A1/A3 1:100/1:200  
VER: 1:50/1:100

MERRIFIELD DEVELOPMENT  
DONNYBROOK ROAD, MICKLEHAM  
STAGE 19  
CROSS SECTIONS  
SHEET 01 OF 05  
Drawing No. 11739XS01 Rev 1  
Sheet No. 10 AS CONSTRUCTED  
© Dalton Consulting Engineers Pty Ltd  
ABN 78 429 221 049



DALTON  
CONSULTING  
ENGINEERS

VICTORIA  
T 61 3 9813 7400  
W dceng.com.au






ABN 78 429 221 049  
QUEENSLAND  
T 61 7 3374 9000  
E info@dceng.com.au

| REV | AMENDMENTS         | DATE     | APP'D |
|-----|--------------------|----------|-------|
| 1   | AS CONSTRUCTED     | 08/09/16 | TL    |
| 0   | CONSTRUCTION ISSUE | 03/02/16 | TL    |

Drawn M.CAPALDO  
Date 04/09/15  
AN 1451046  
Designed N.MIRATANA  
Date 24/06/15  
AN 1541357  
Verified B.GORDON  
Date 14/09/15  
AN 162525  
Audited T.TOBUHOFF  
Date 31/01/16  
AN 912879  
Approved T.LIAKOPOULOS  
Date 03/02/16  
AN 885202

Written dimensions to take precedence over scale. Contractor shall check and verify all dimensions on site. Discrepancies to be brought to the attention of the Superintendent.



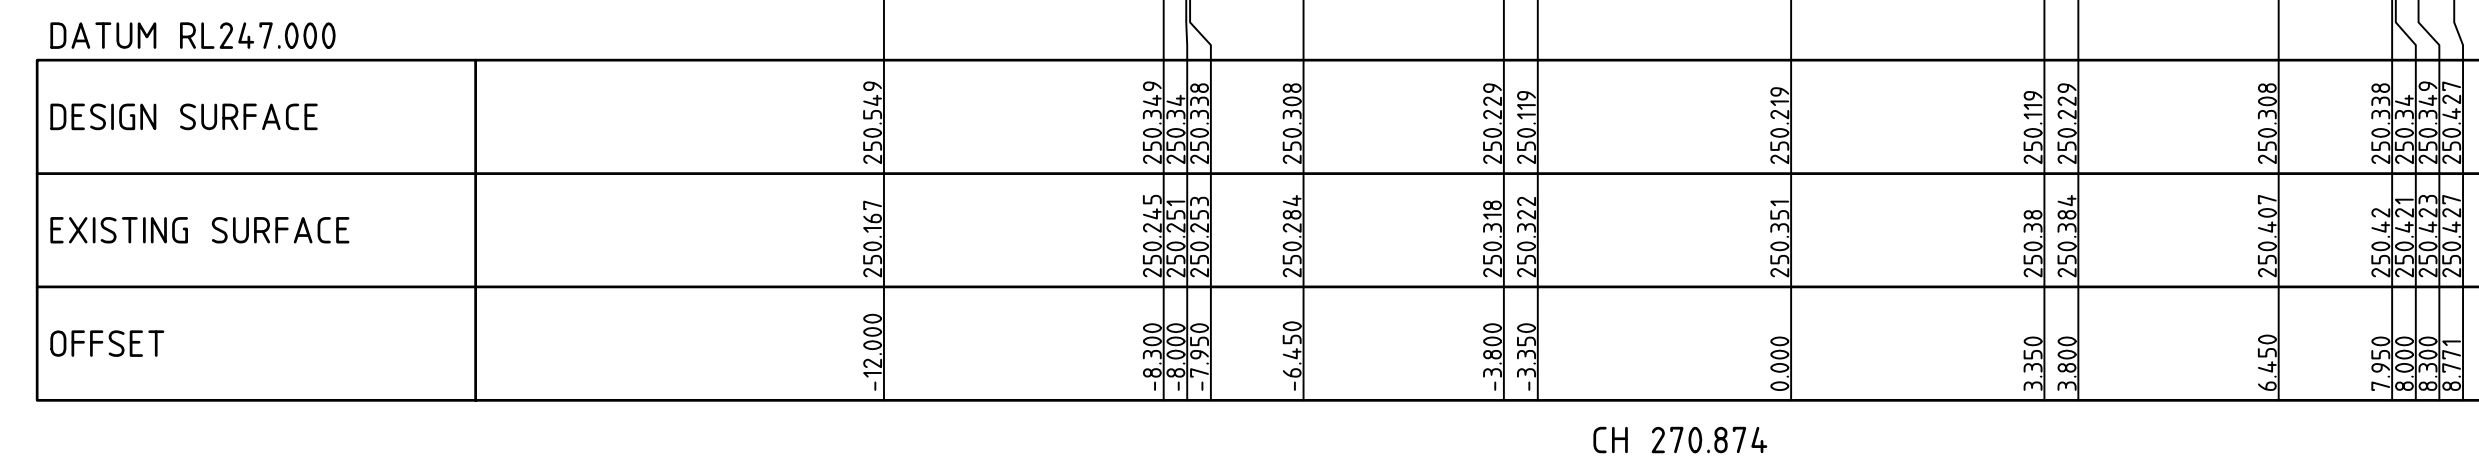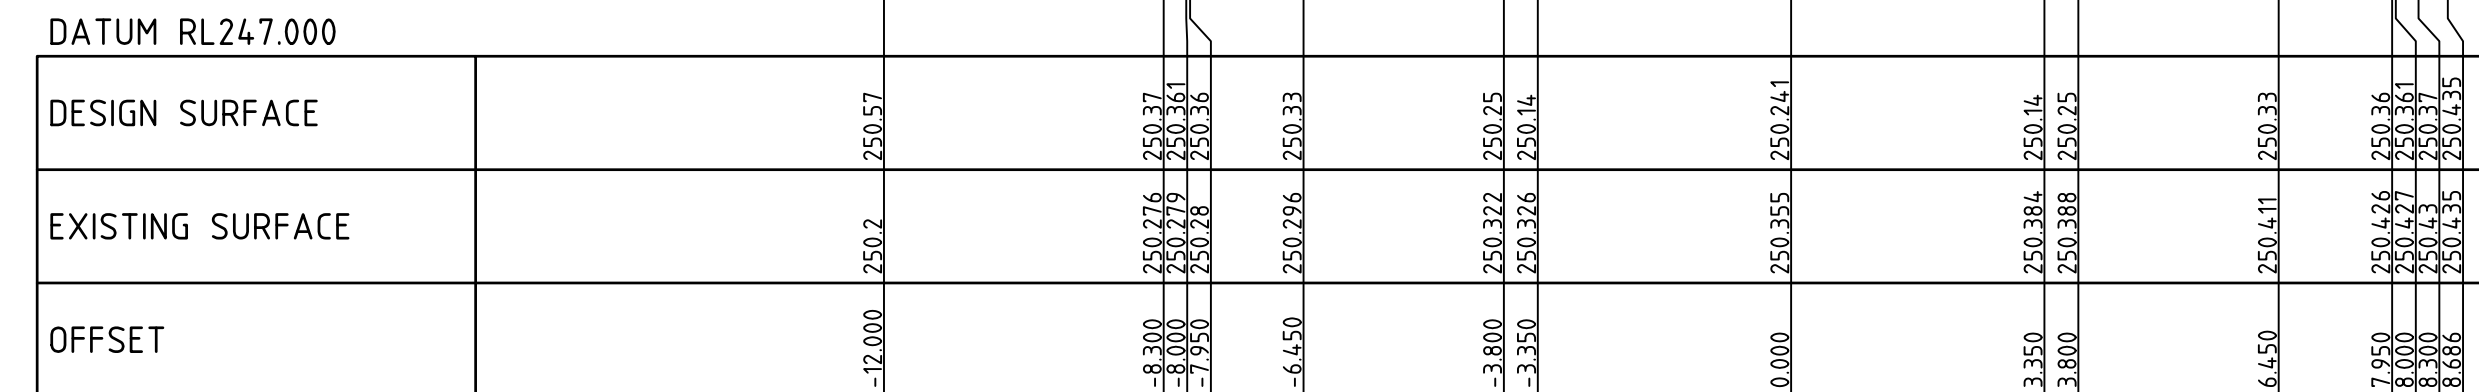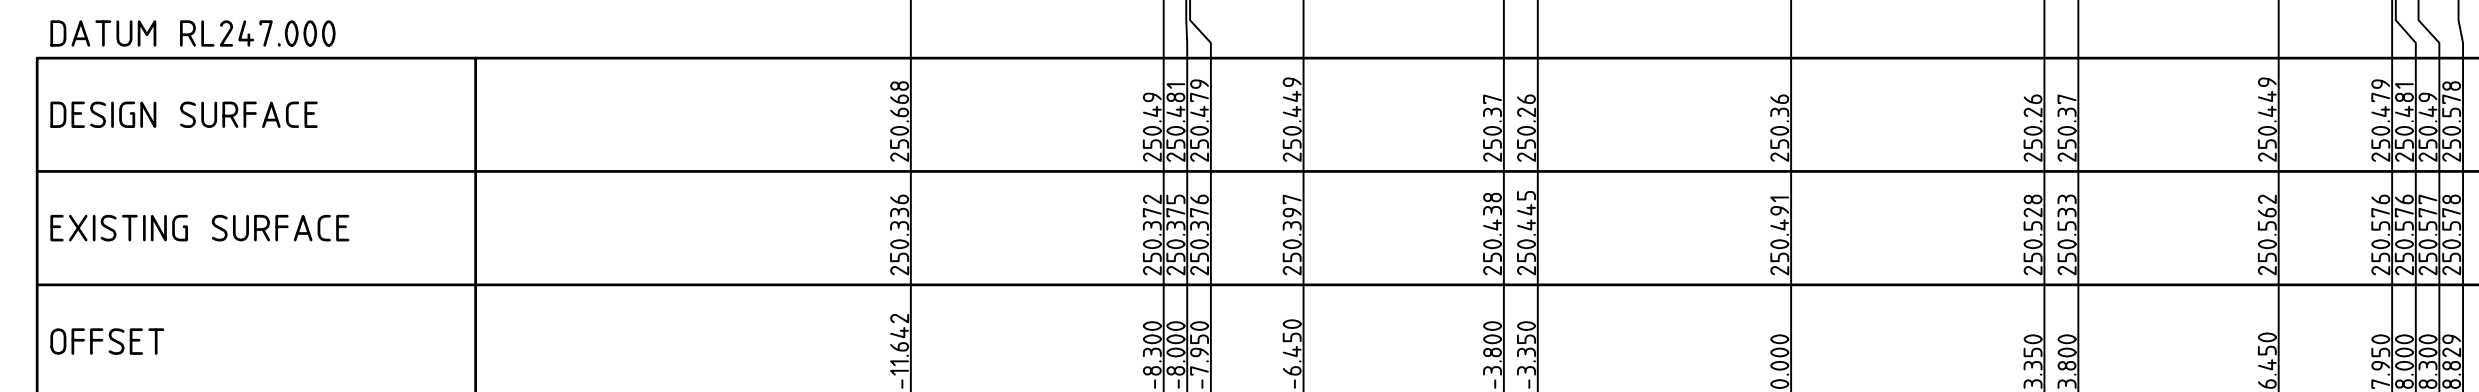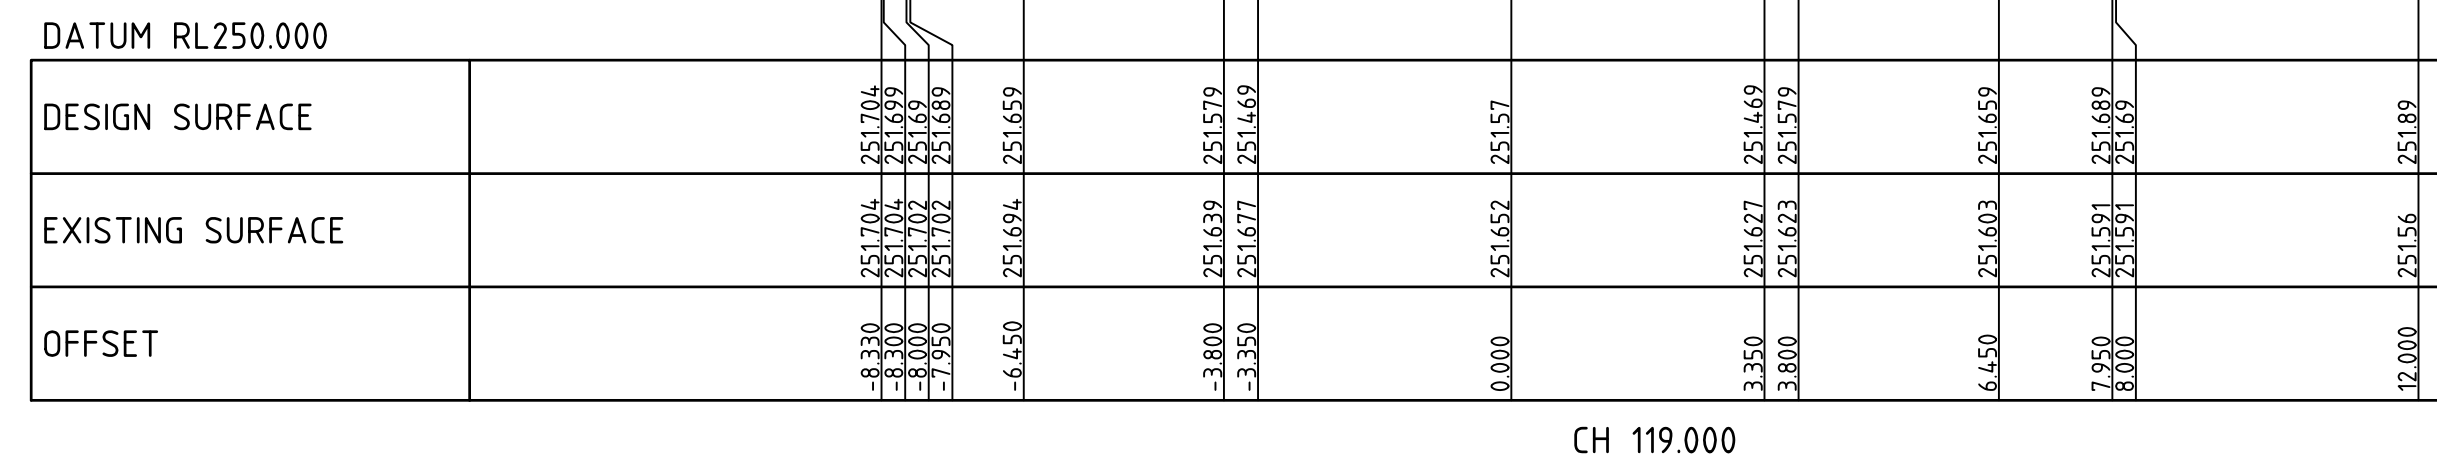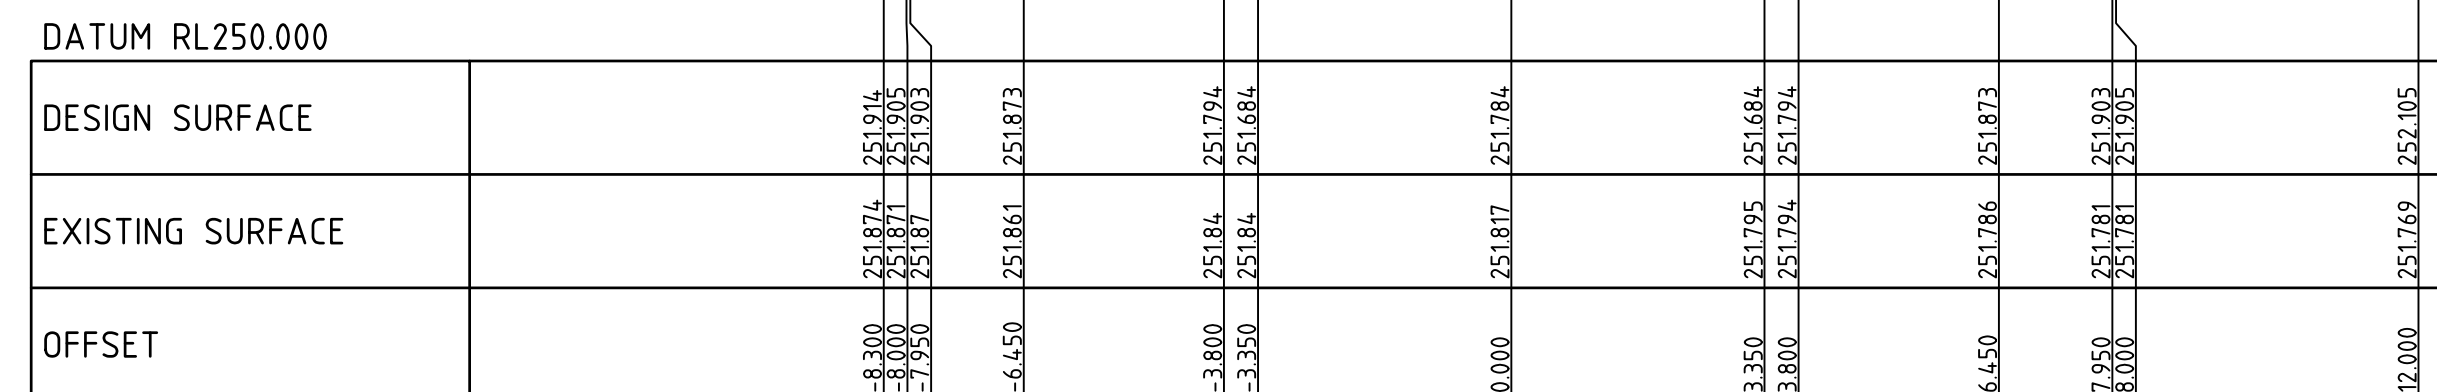

Written dimensions to take precedence over scale. Contractor shall check and verify all dimensions on site, Discrepancies to be brought to the attention of the Superintendent.

AS CONSTRUCTED

Coords: MGA  
Levels: AHD

Hor 1:100 0m 1m 2m 4m 6m  
Ver 1:50 0m 0.5m 1m 2m 3m  
Scale @ A1/A3 1:100/1:200  
VER: 1:50/1:100










ABN 78 429 221 049








Drawing File: G:\Design\11700\11739-MERRIFIELD - Precinct 1 - Stage 19\A304\RD\11739XS04.dwg - 11739XS04  
Date/Time: Thu Sep 08, 2016 - 4:54pm --byronashide--

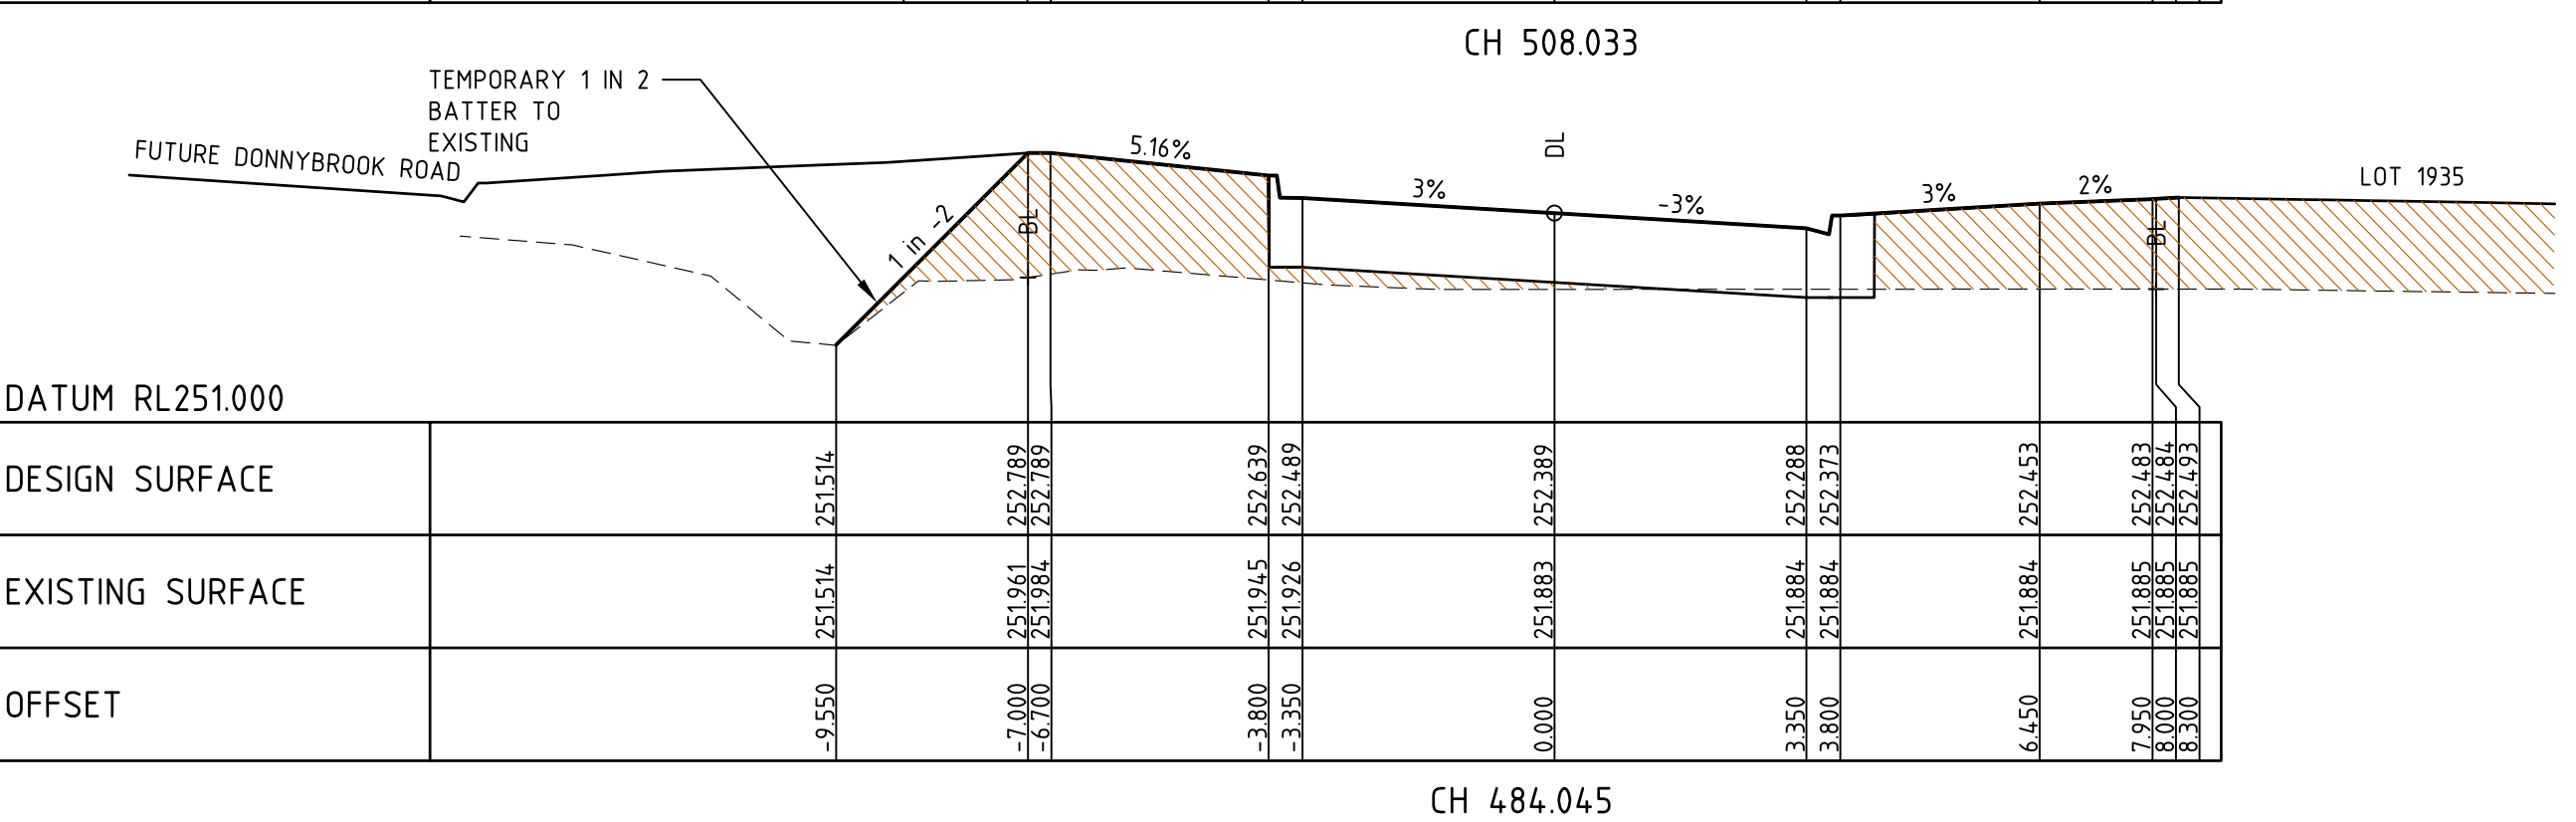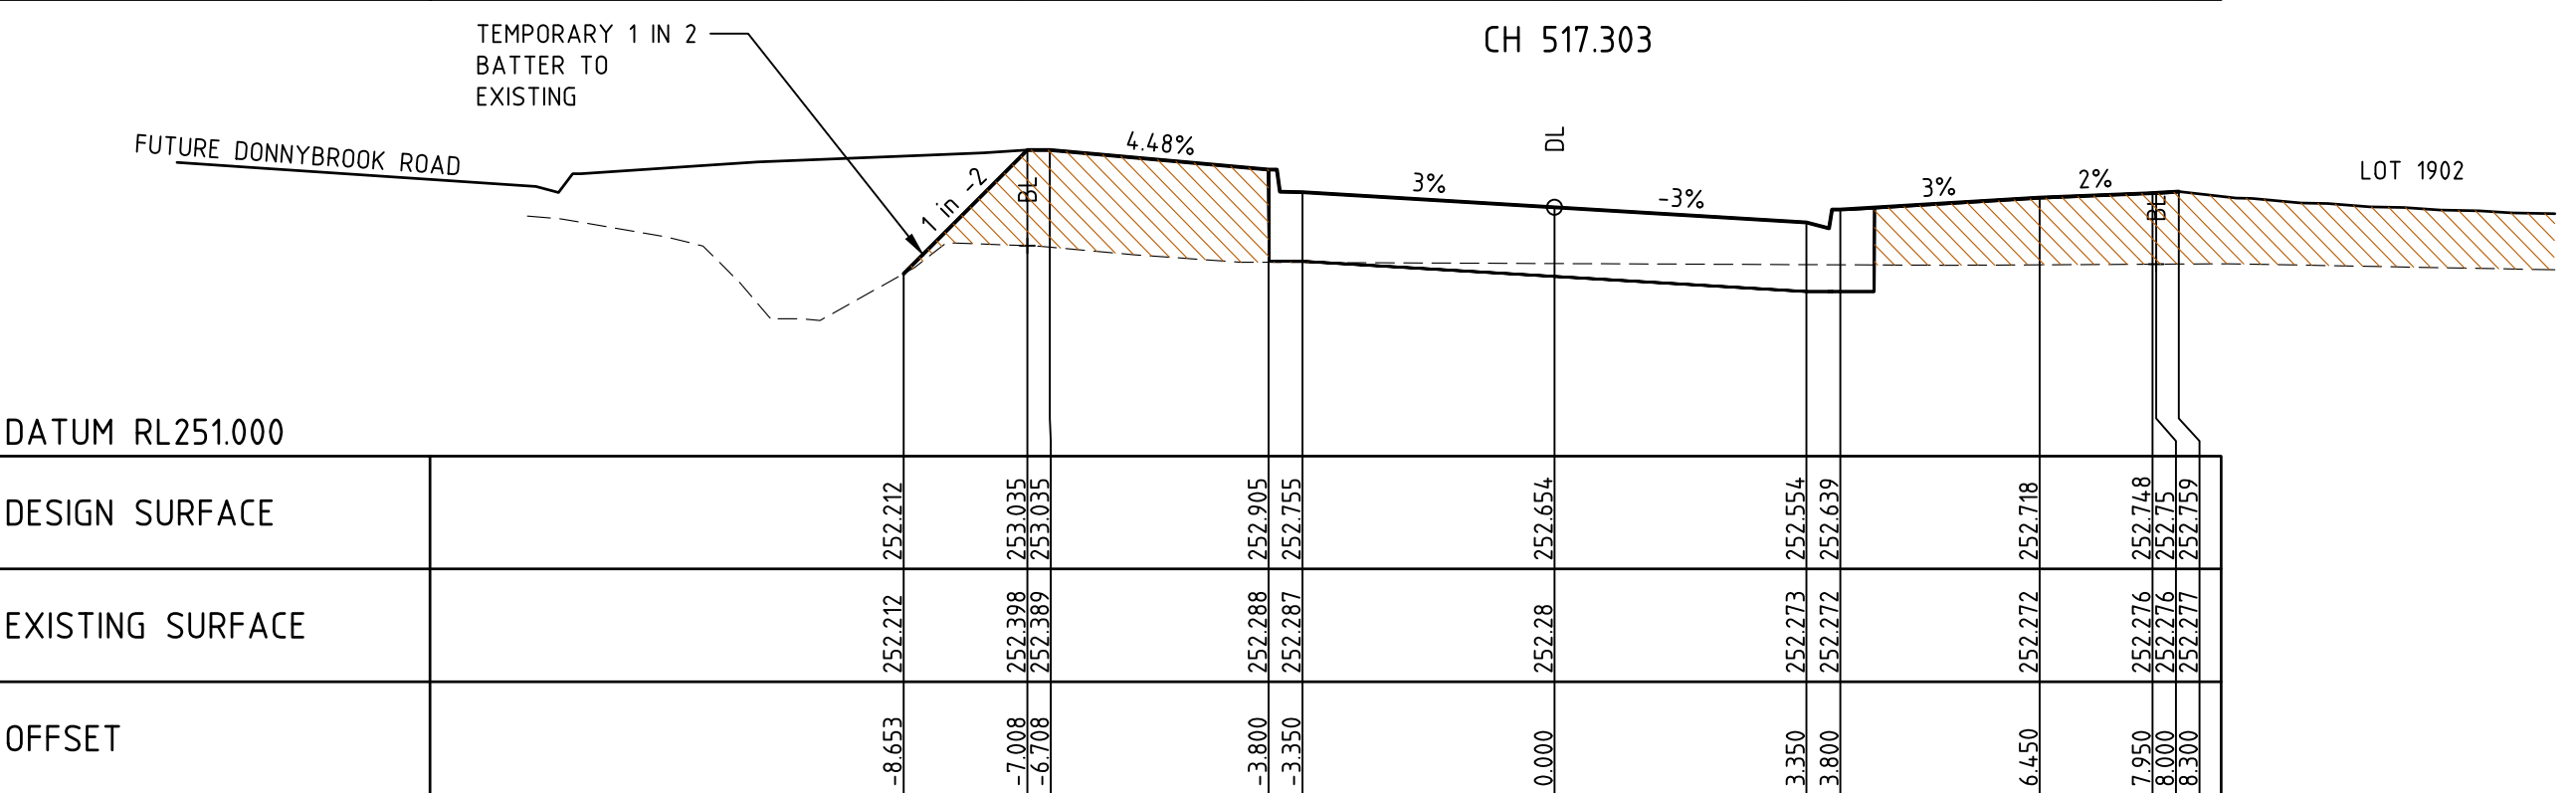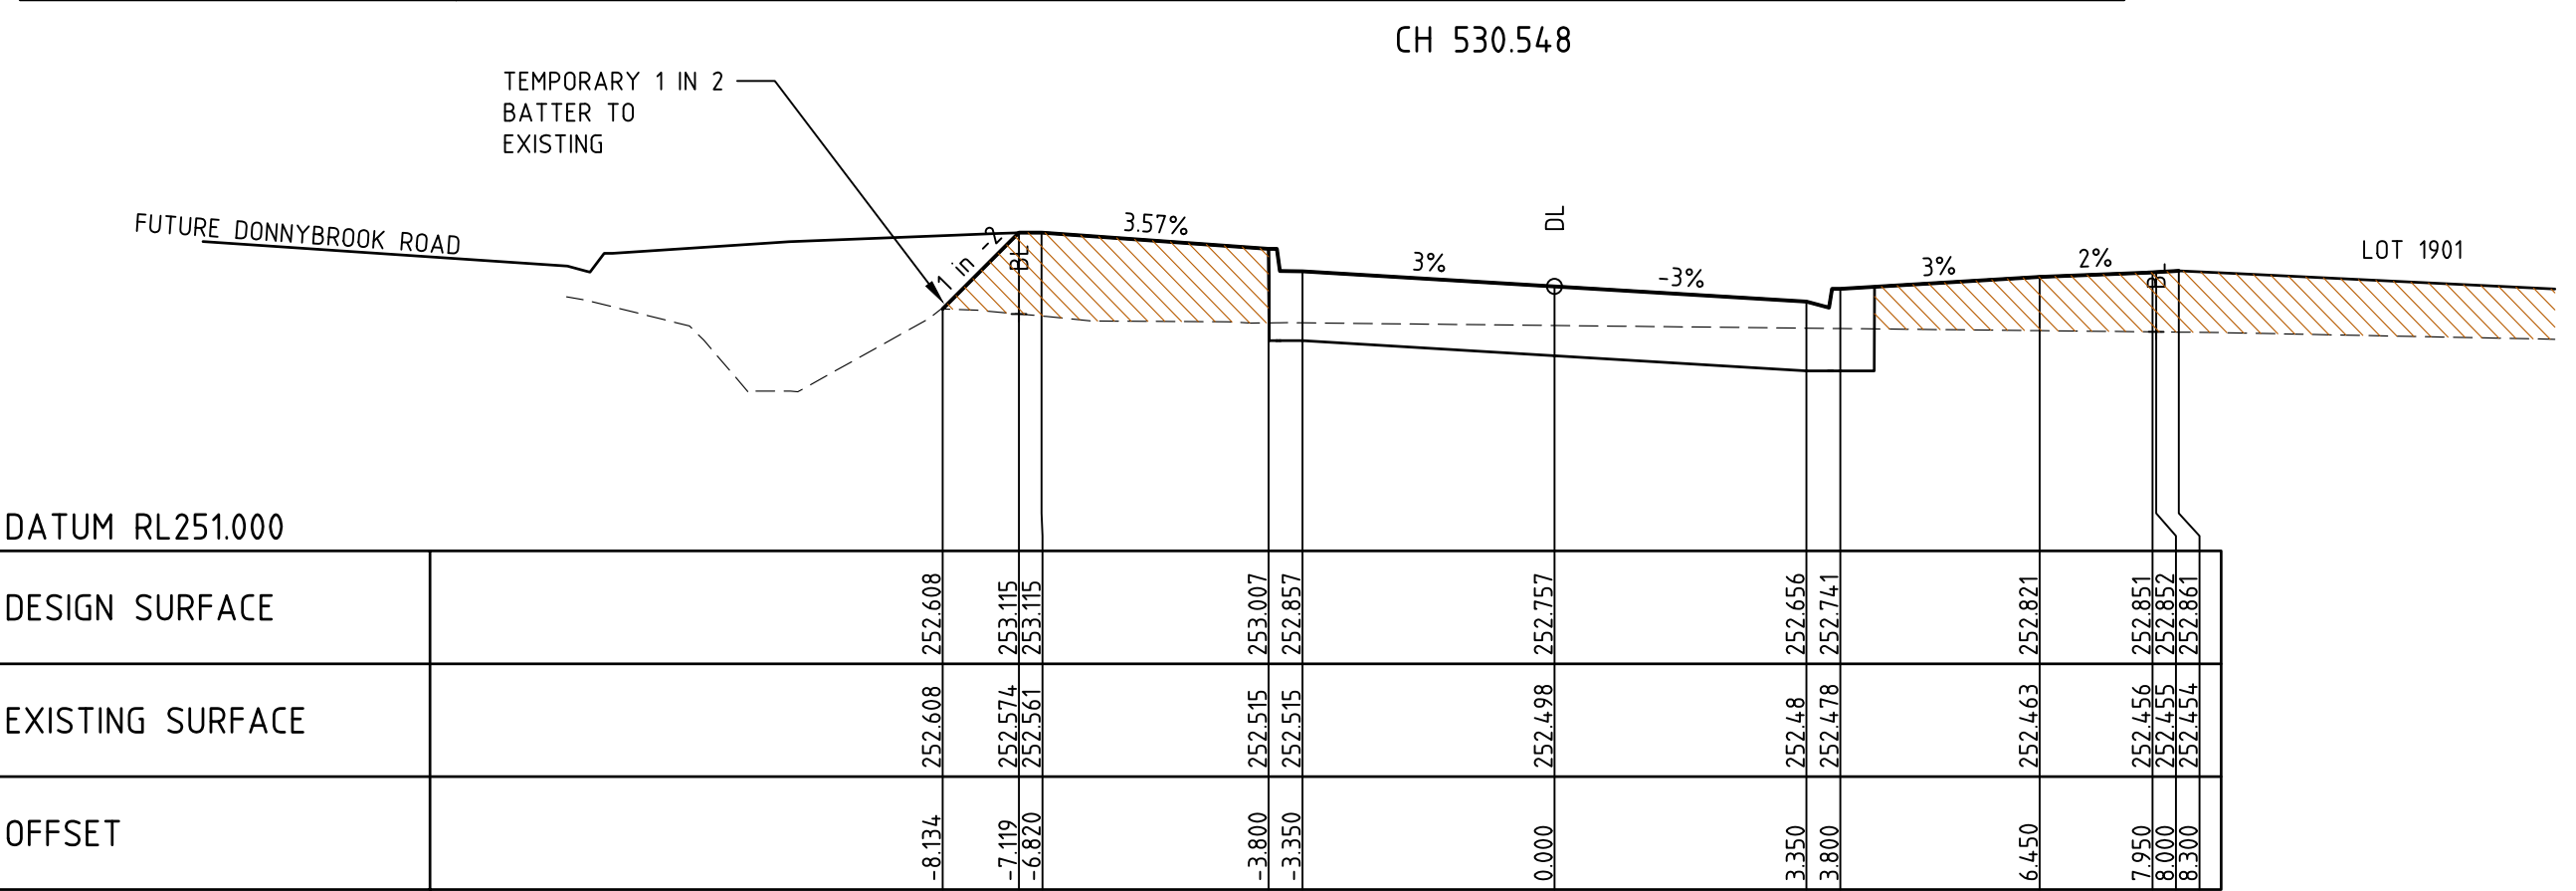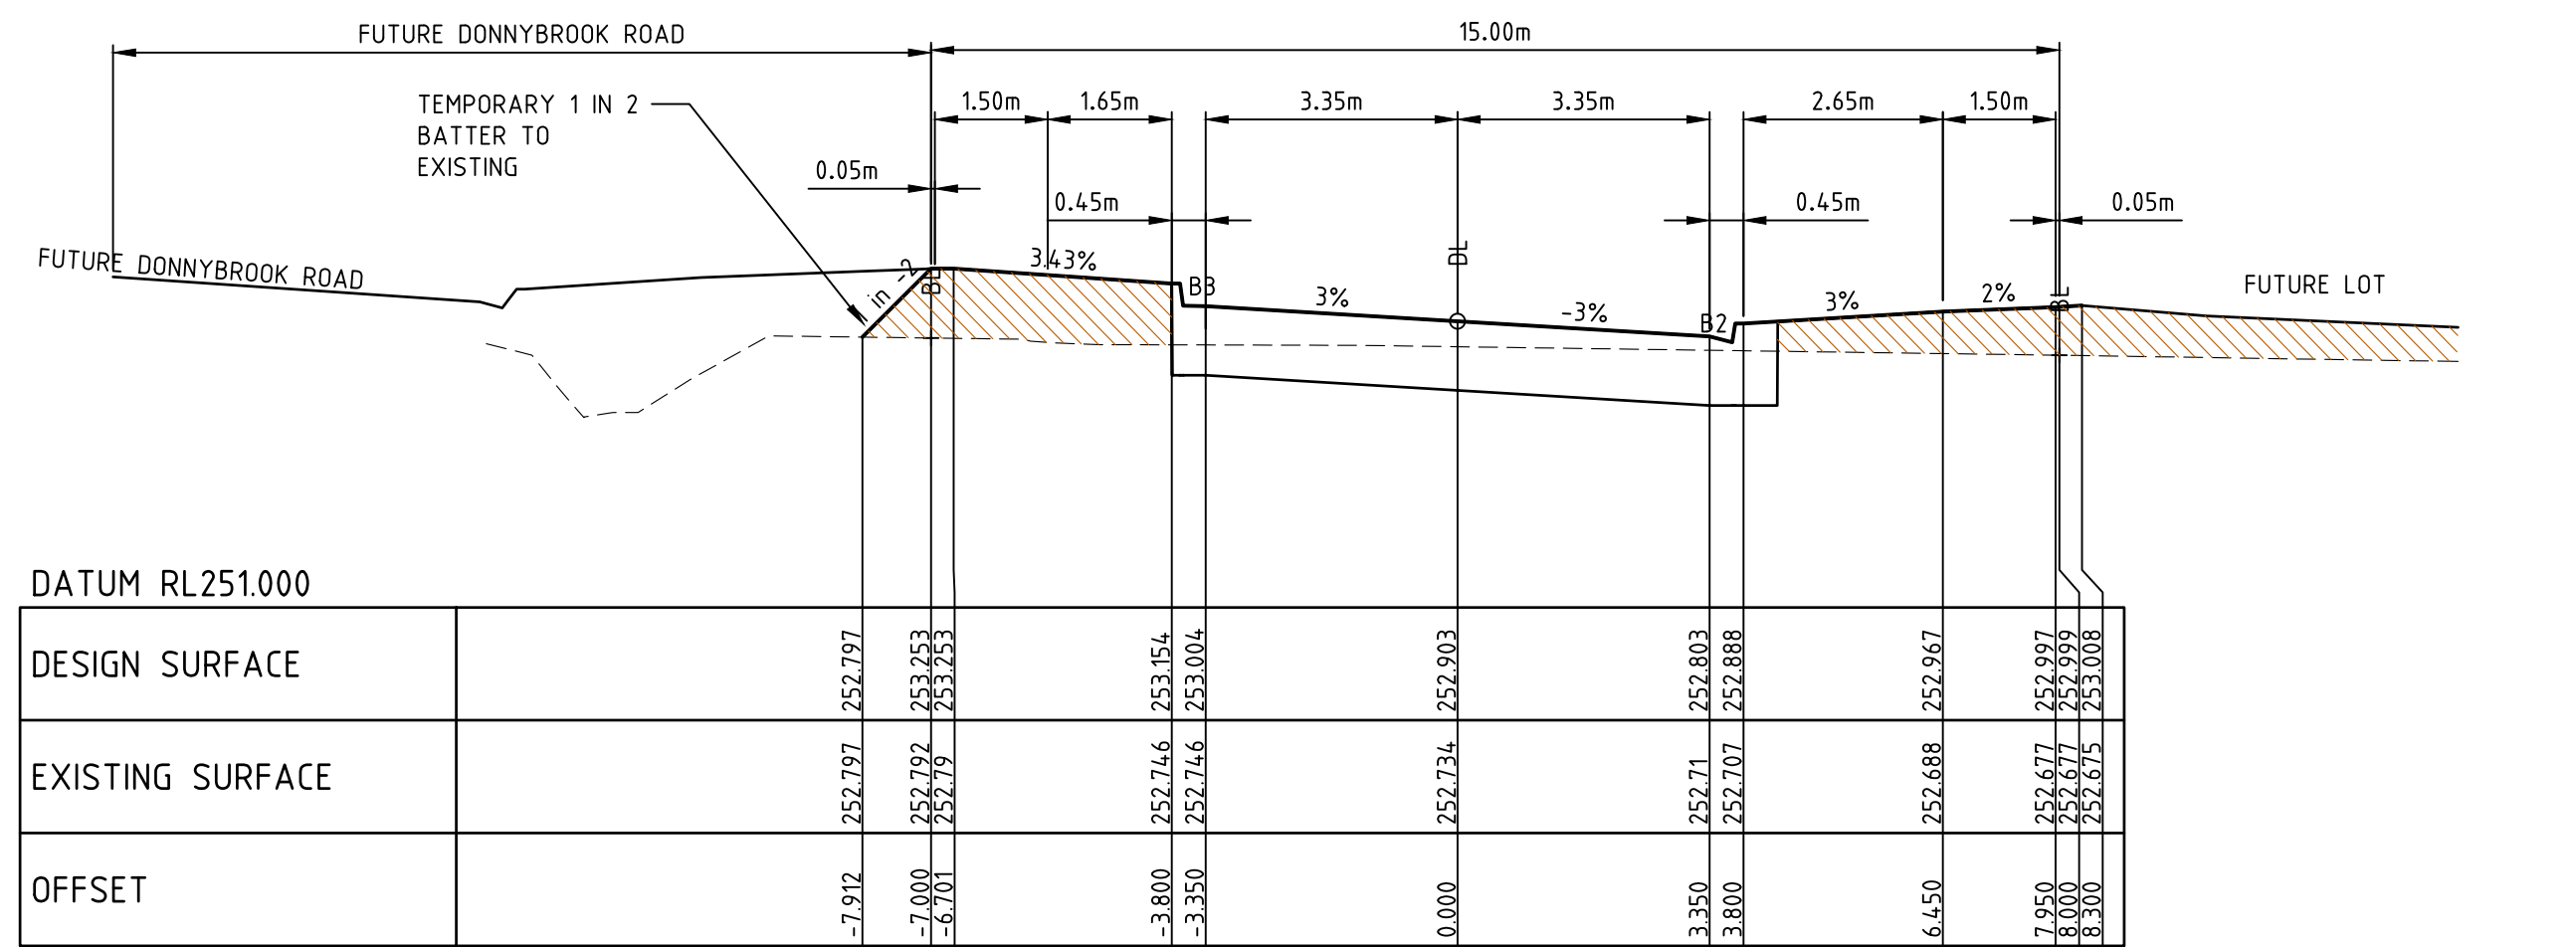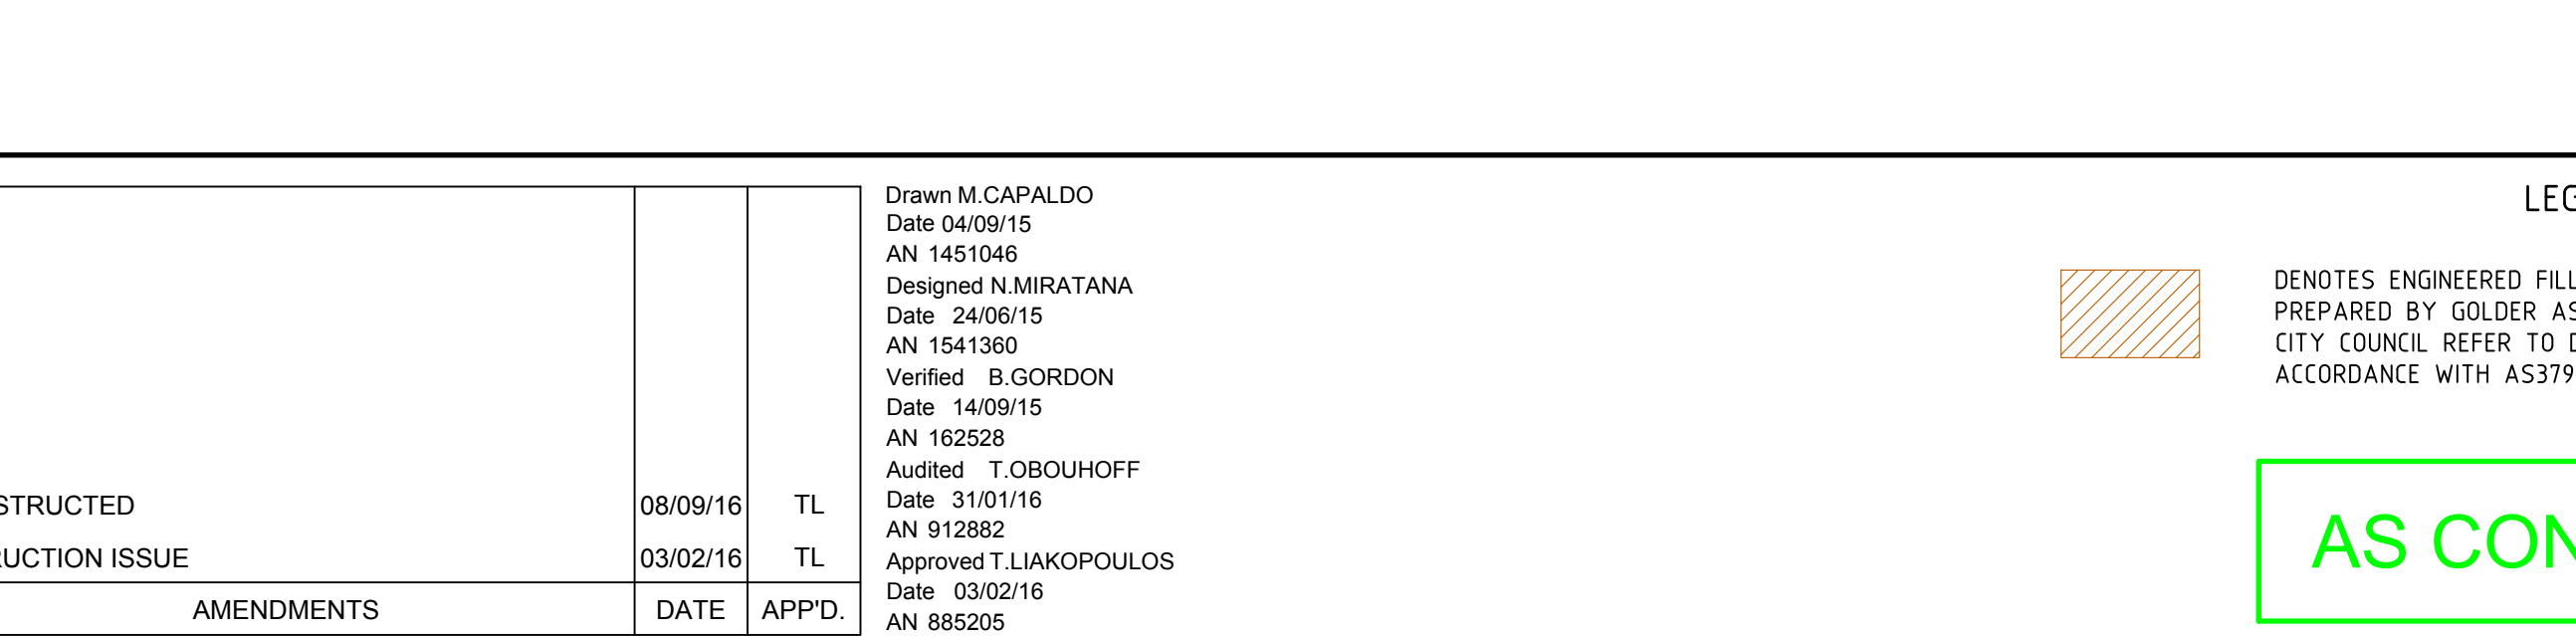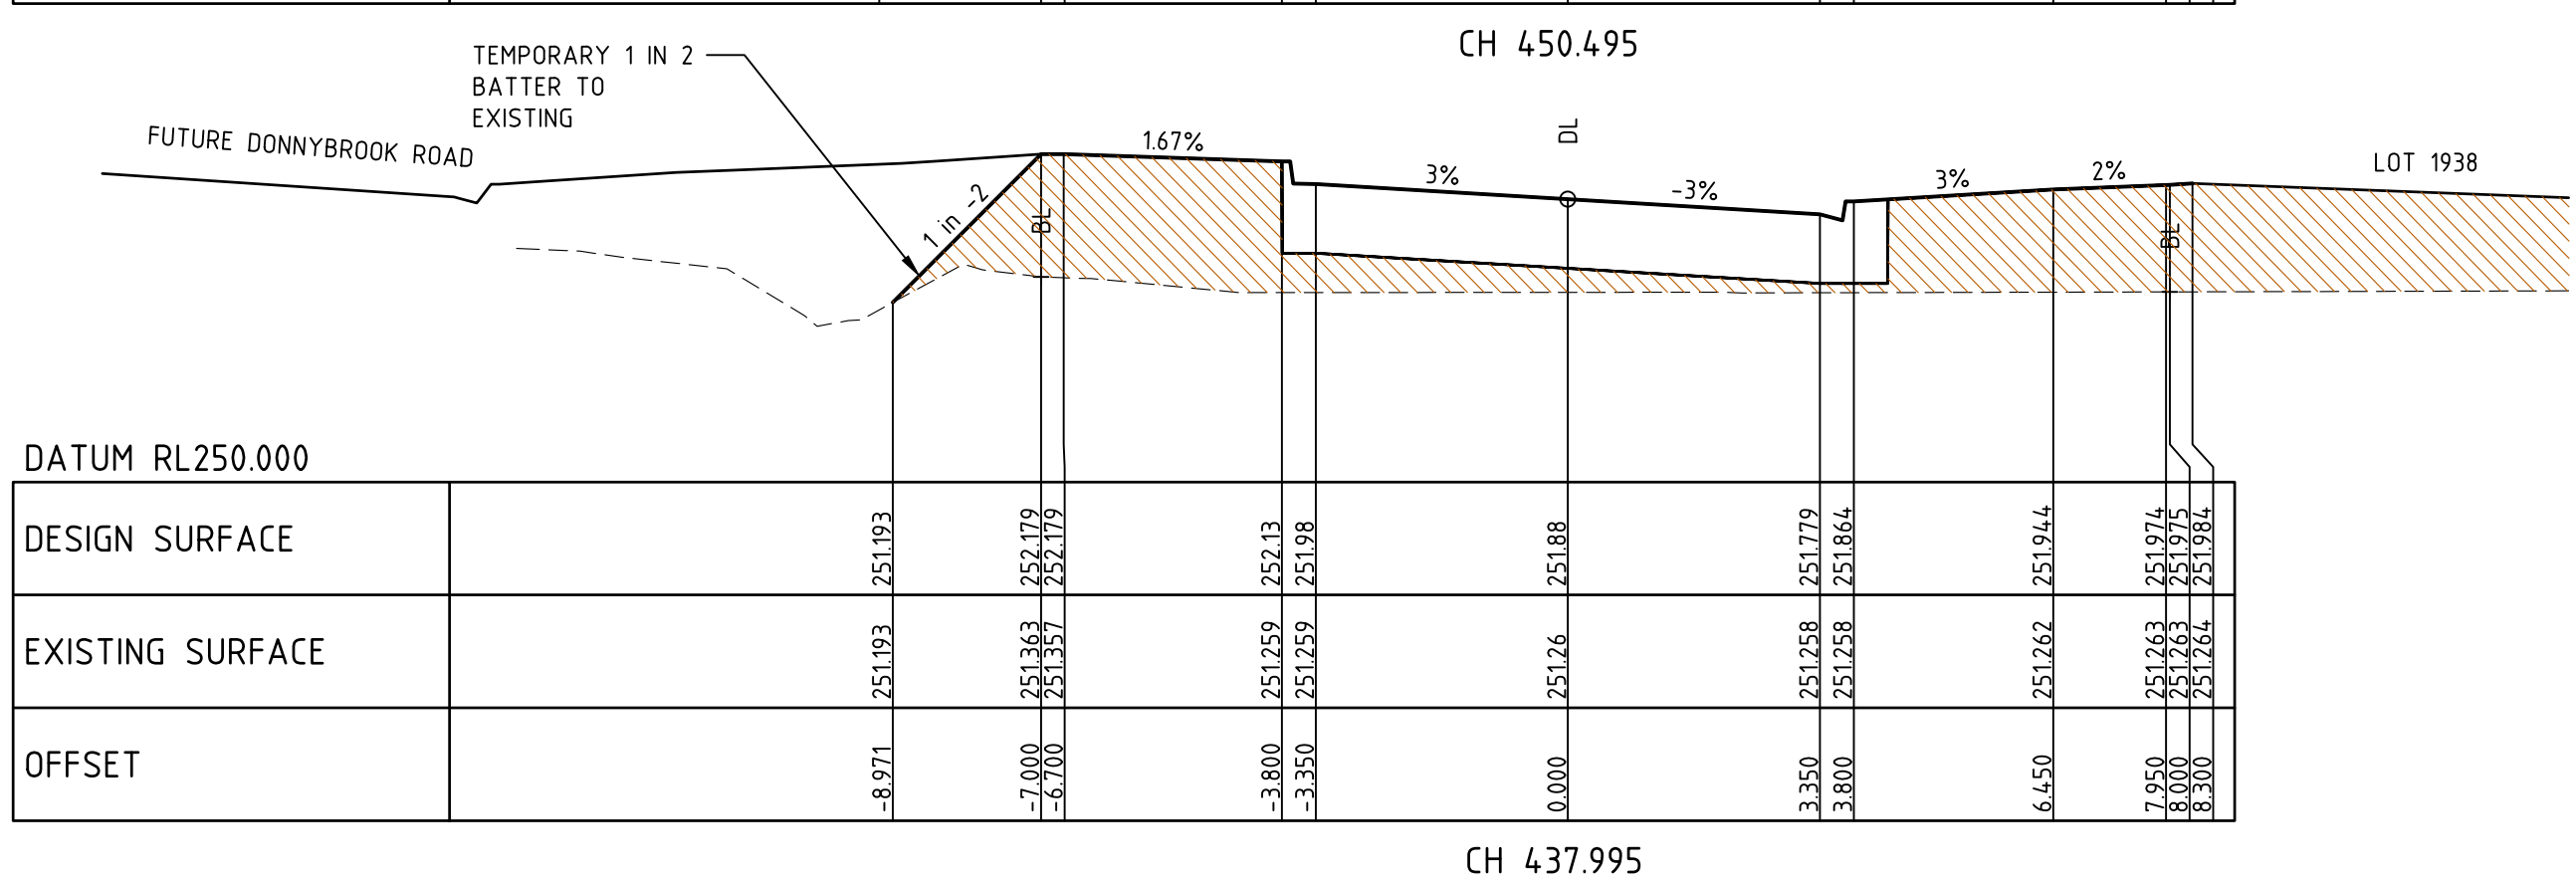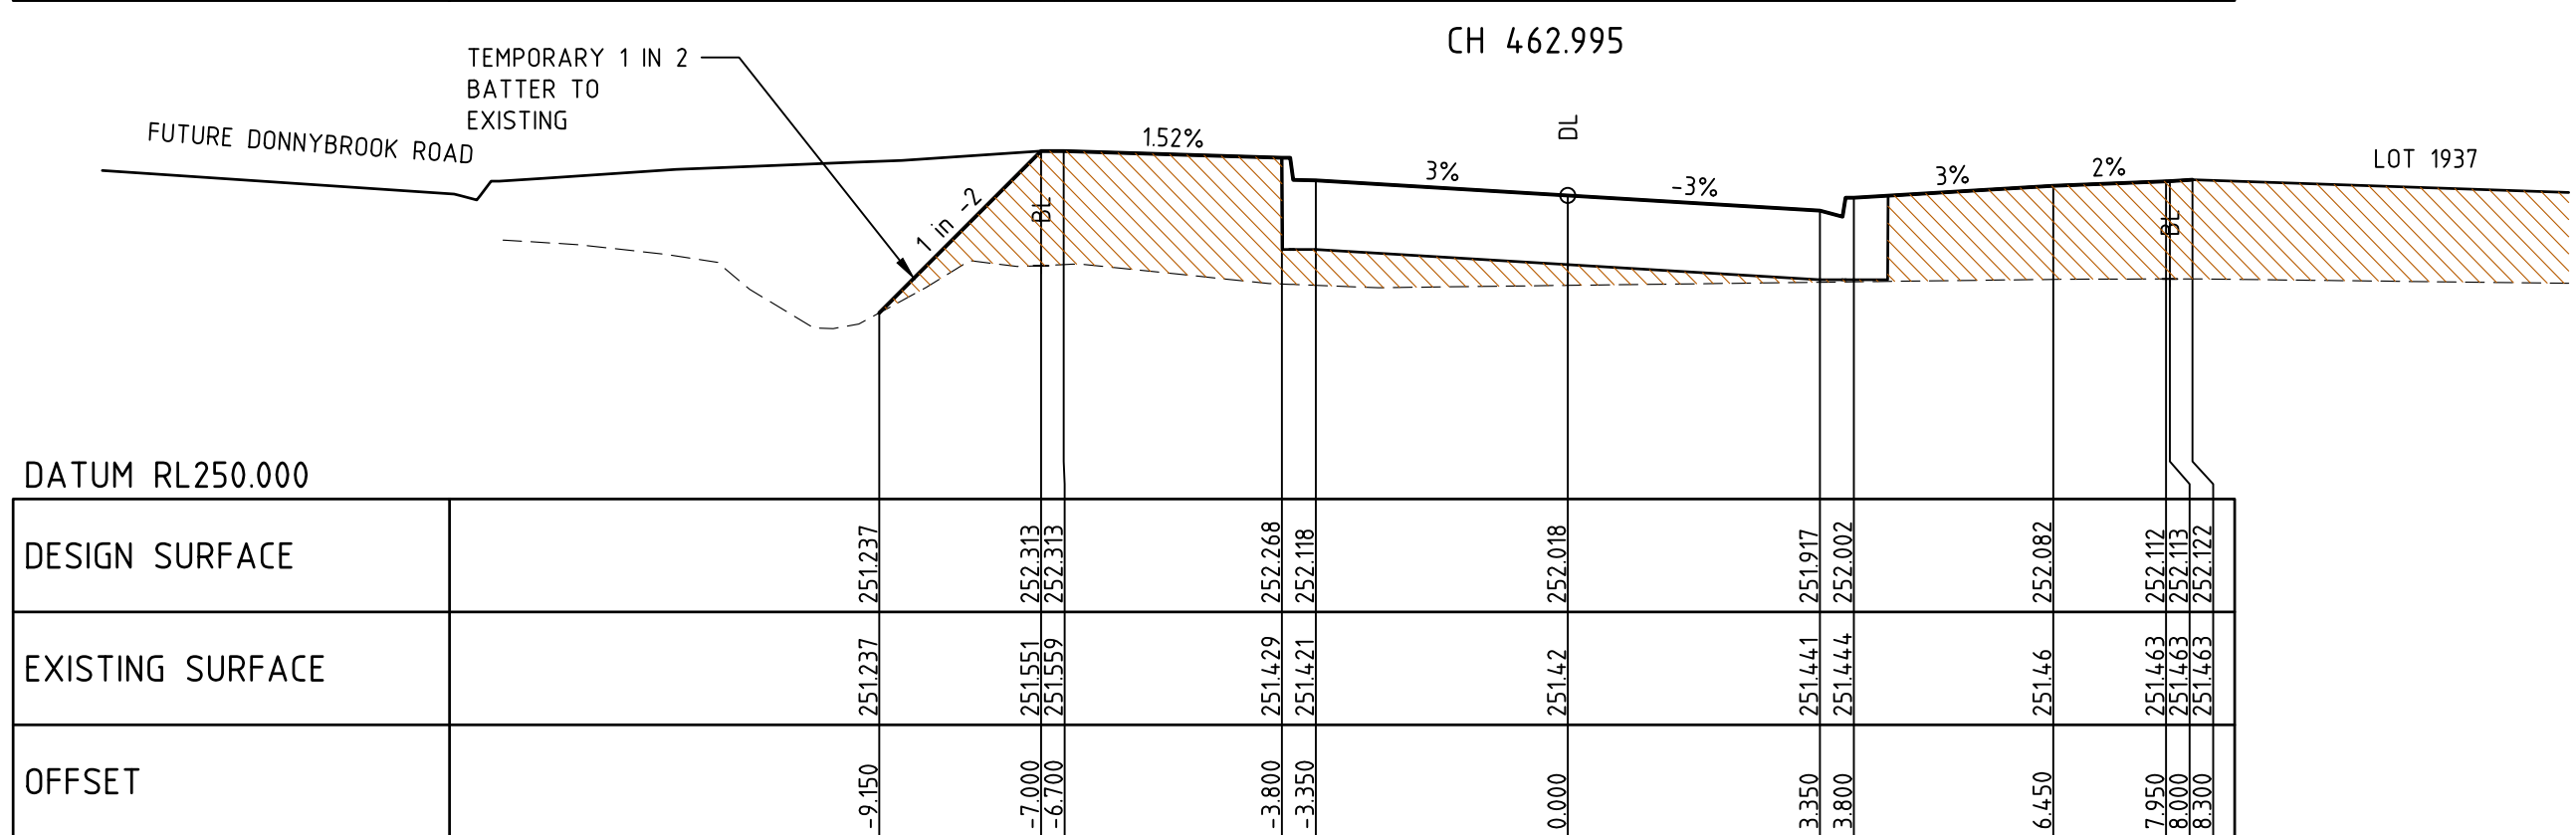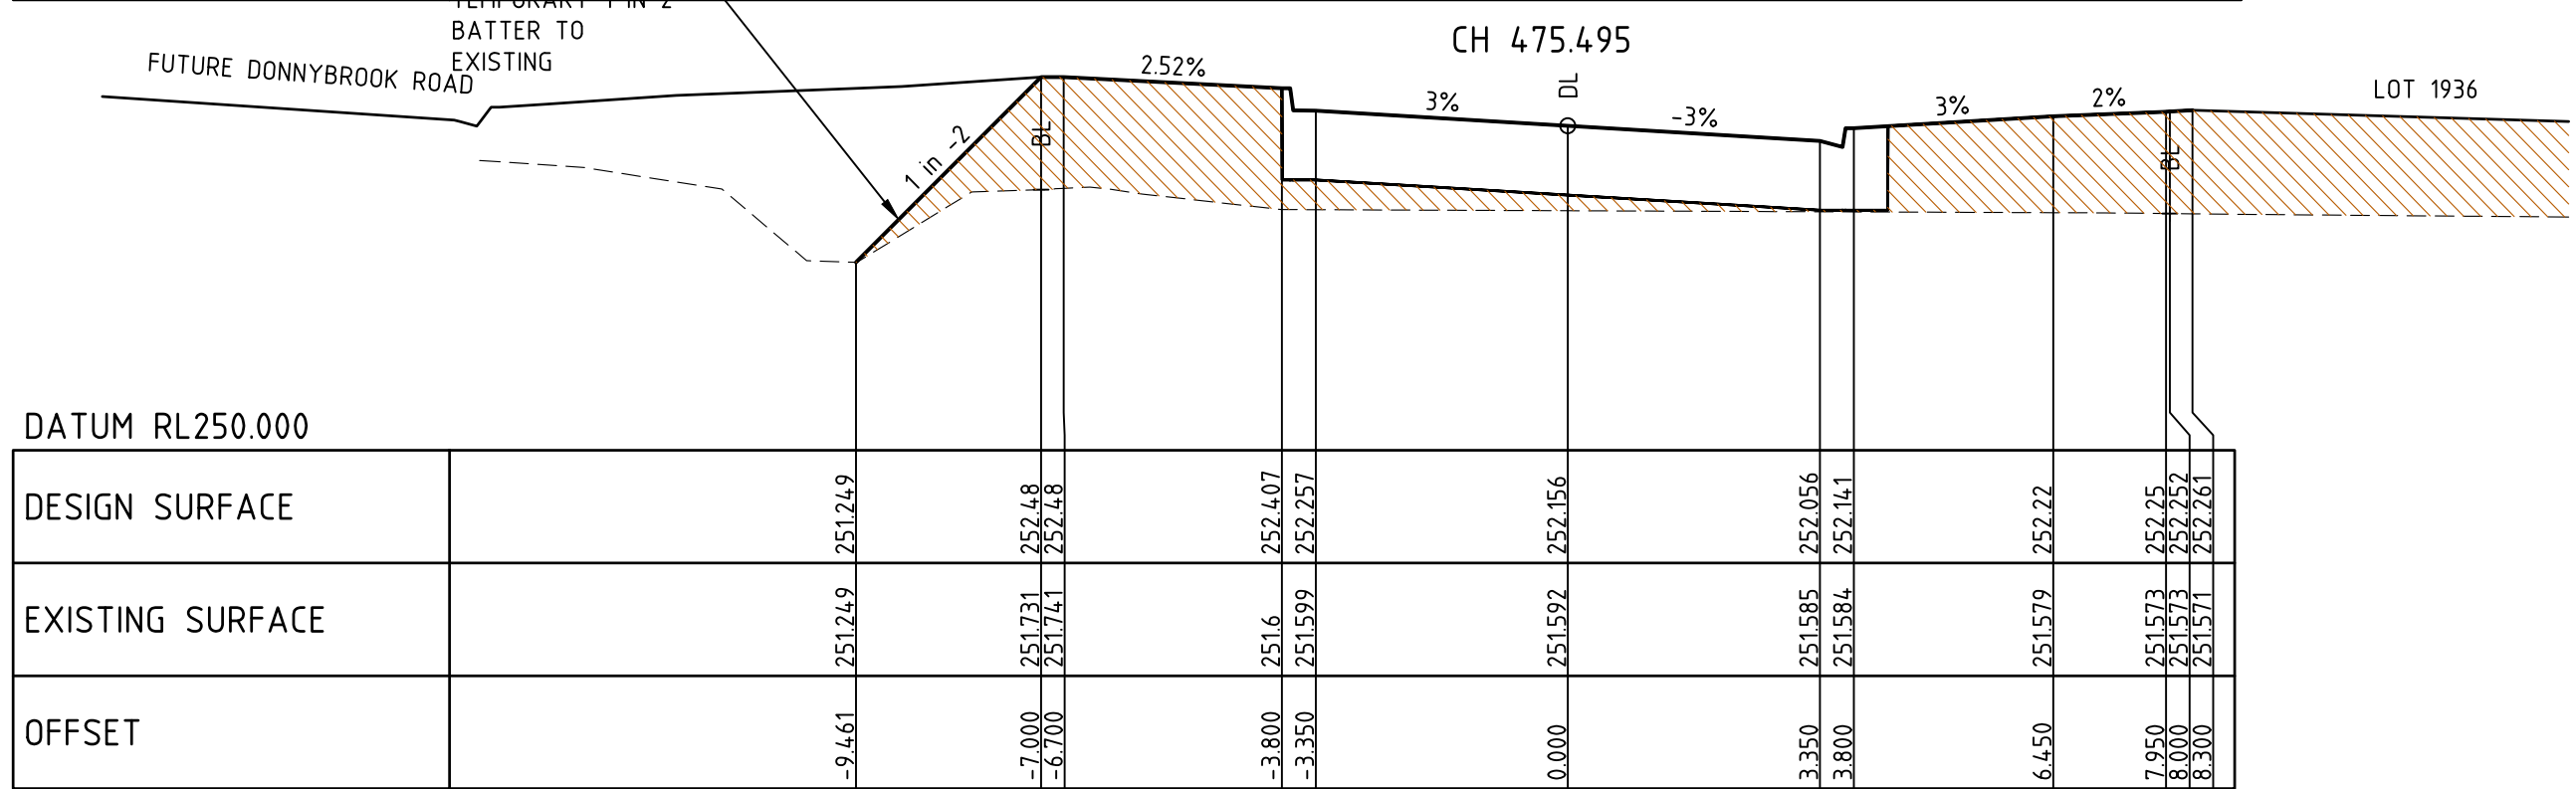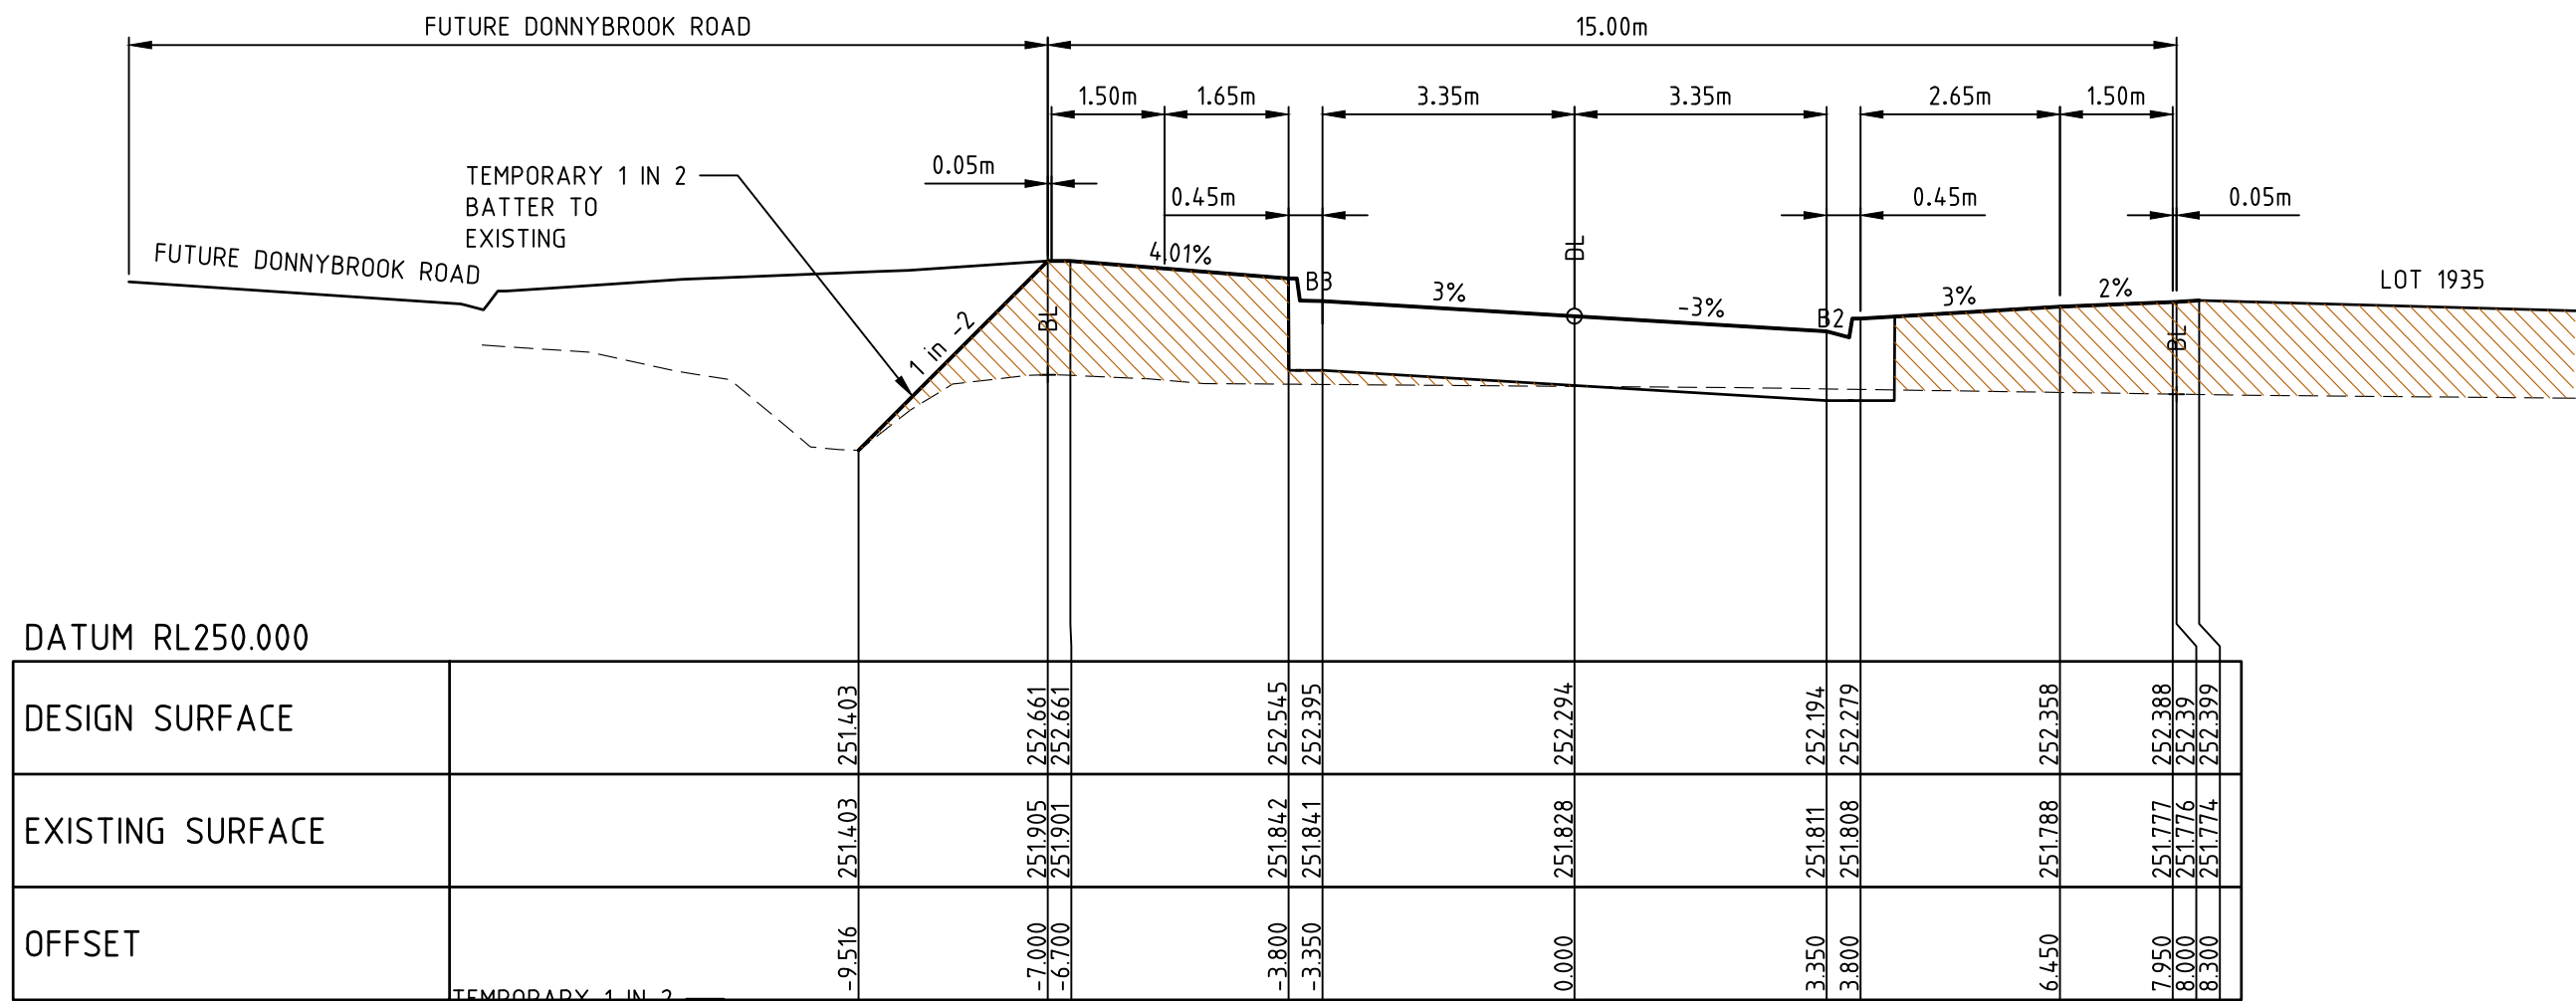

CANNING DRIVE

LEGEND

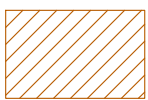


DENOTES ENGINEERED FILL TO BE IN ACCORDANCE WITH THE GEOTECHNICAL REPORT PREPARED BY GOLDER ASSOCIATES. ENGINEERING FILL TO BE APPROVED BY HUME CITY COUNCIL REFER TO DWG 11739TD01 NOTES, WITH LEVEL 1 SUPERVISION IN ACCORDANCE WITH AS3798-2007.

AS CONSTRUCTED



Coords: MGA  
Levels: AHD  
Hor 1:100 0m 1m 2m 4m 6m  
Ver 1:50 0m 0.5m 1m 2m 3m  
Scale @ A1/A3 1:100/1:200  
VER: 1:50/1:100

MERRIFIELD DEVELOPMENT  
DONNYBROOK ROAD, MICKLEHAM  
STAGE 19  
CROSS SECTIONS  
SHEET 04 OF 05  
Drawing No. 11739XS04 Rev 1  
Sheet No. 13 AS CONSTRUCTED  
© Dalton Consulting Engineers Pty Ltd  
ABN 78 429 221 049

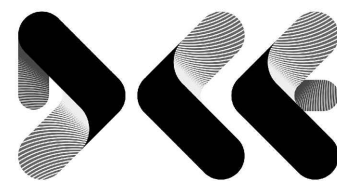

DALTON  
CONSULTING  
ENGINEERS

ABN 78 429 221 049





VICTORIA  
T 61 3 9813 7400  
W dceng.com.au

QUEENSLAND  
T 61 7 3374 9000  
E info@dceng.com.au

Written dimensions to take precedence over scale. Contractor shall check and verify all dimensions on site. Discrepancies to be brought to the attention of the Superintendent.




Drawing File: G:\DesignData\11700\11739-MERRIFIELD - Precinct 1 - Stage 19\Acad\RD\11739XS01.dwg - 11739XS05  
Date/Time: Thu Sep 08, 2016 - 4:54pm --Byronashide--

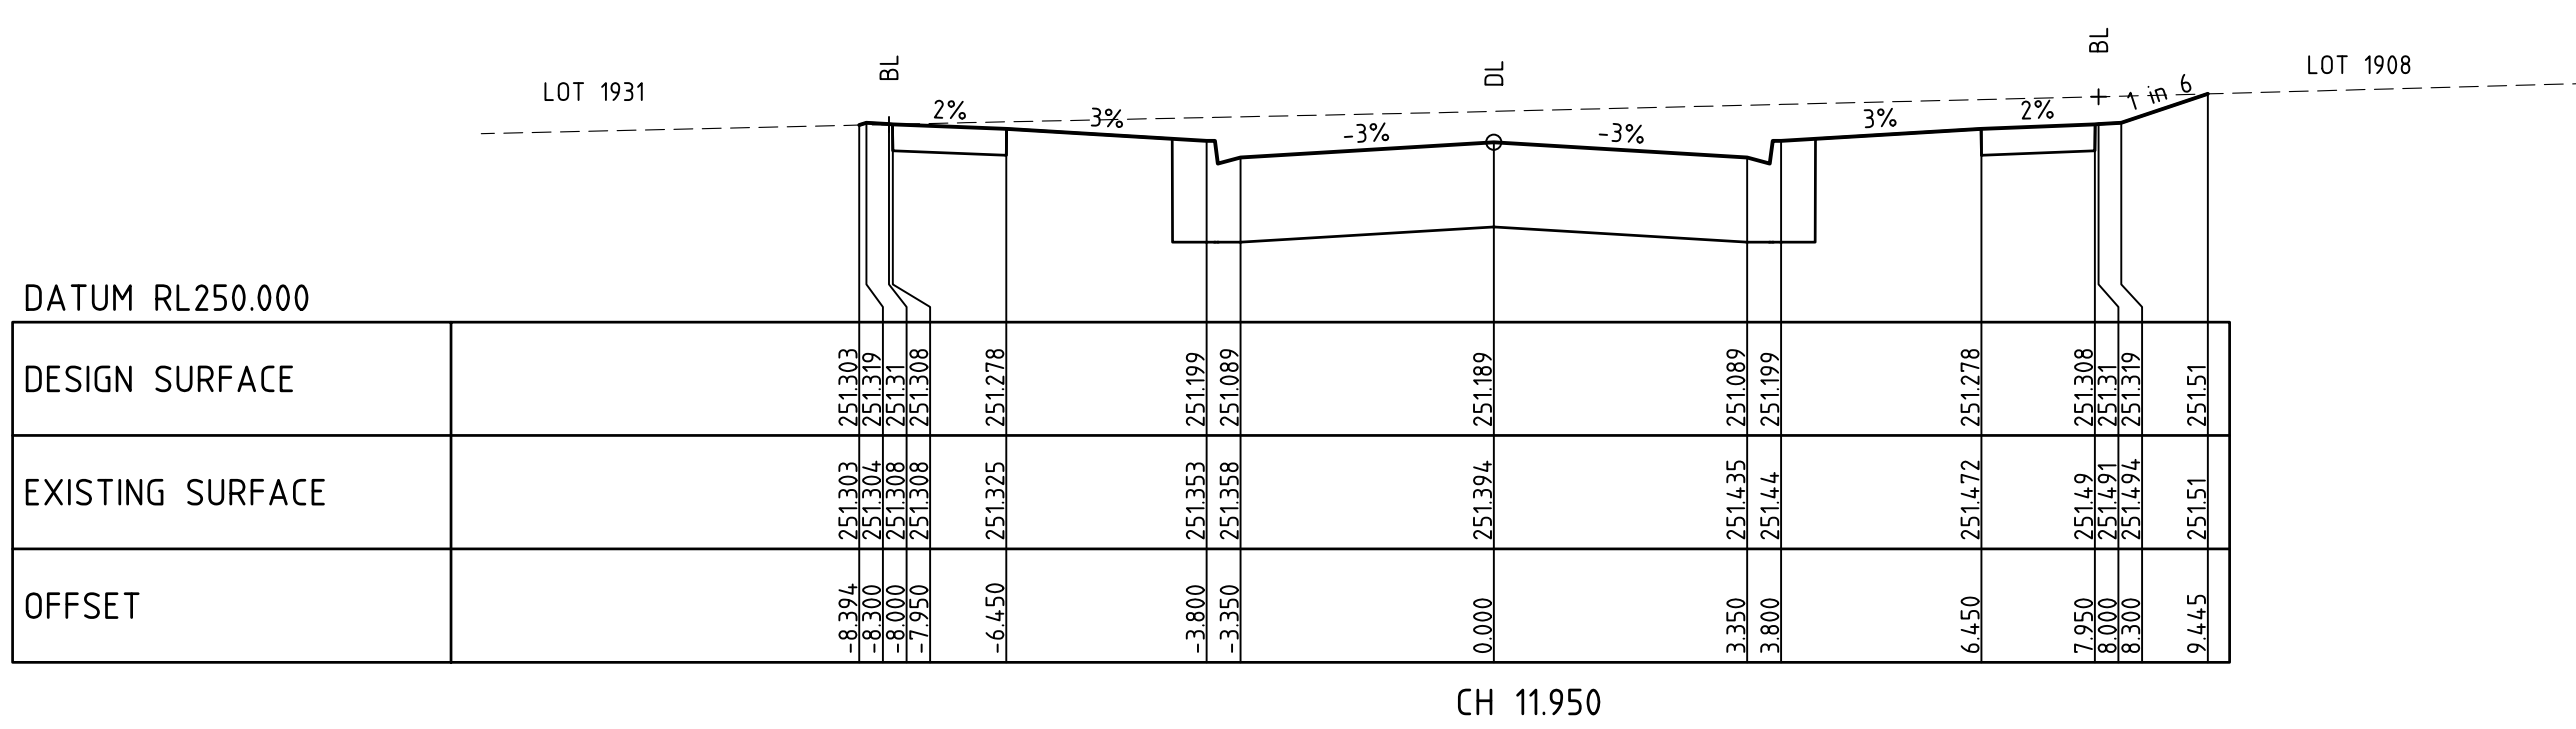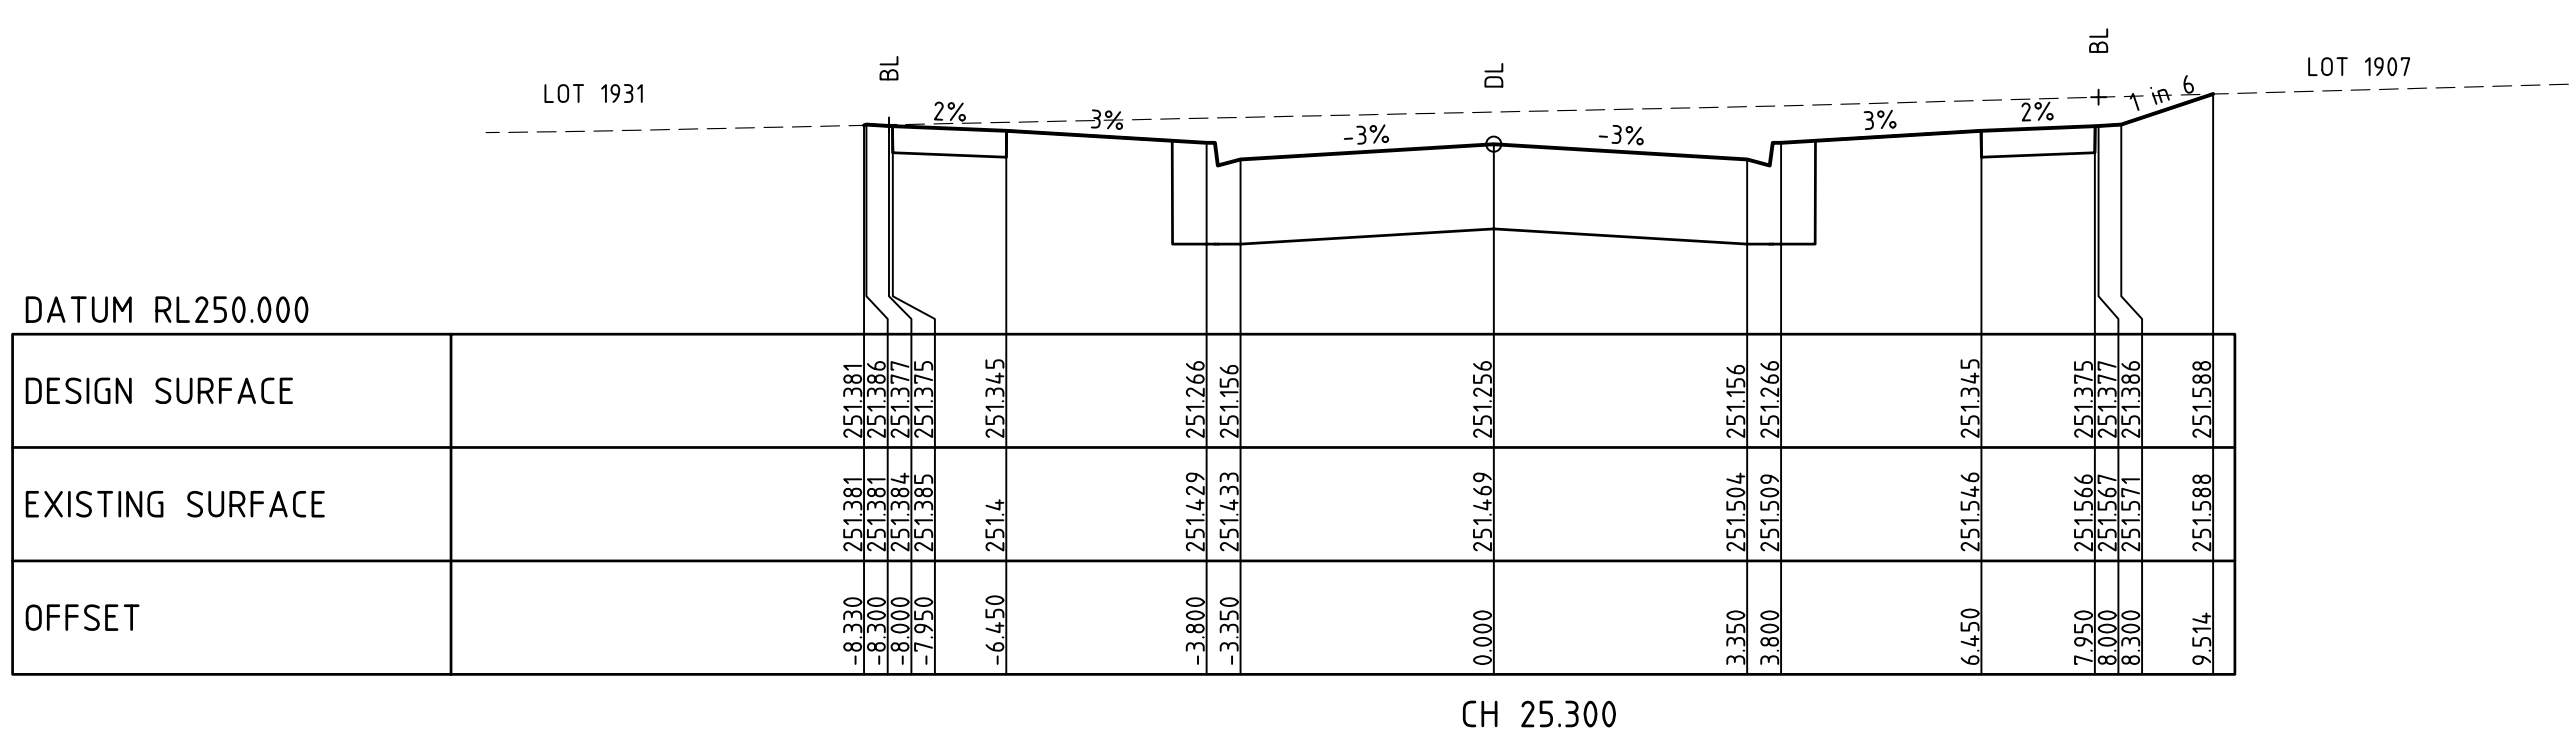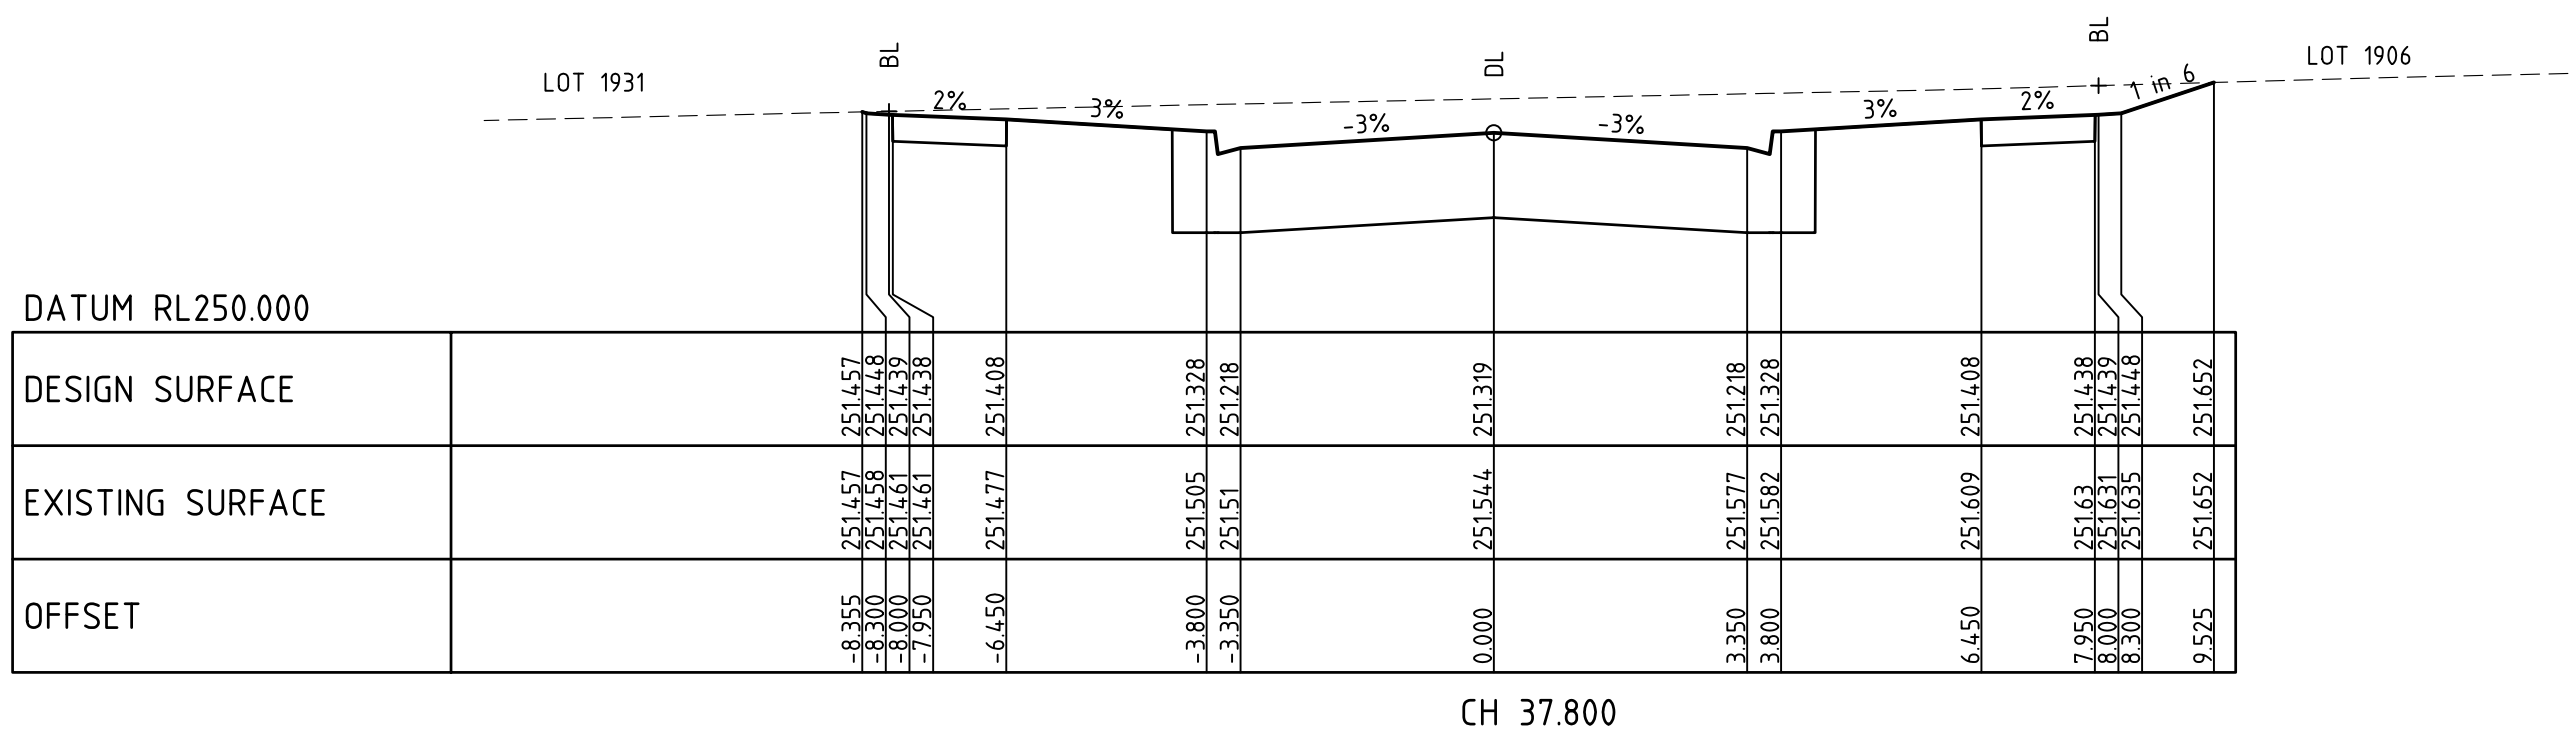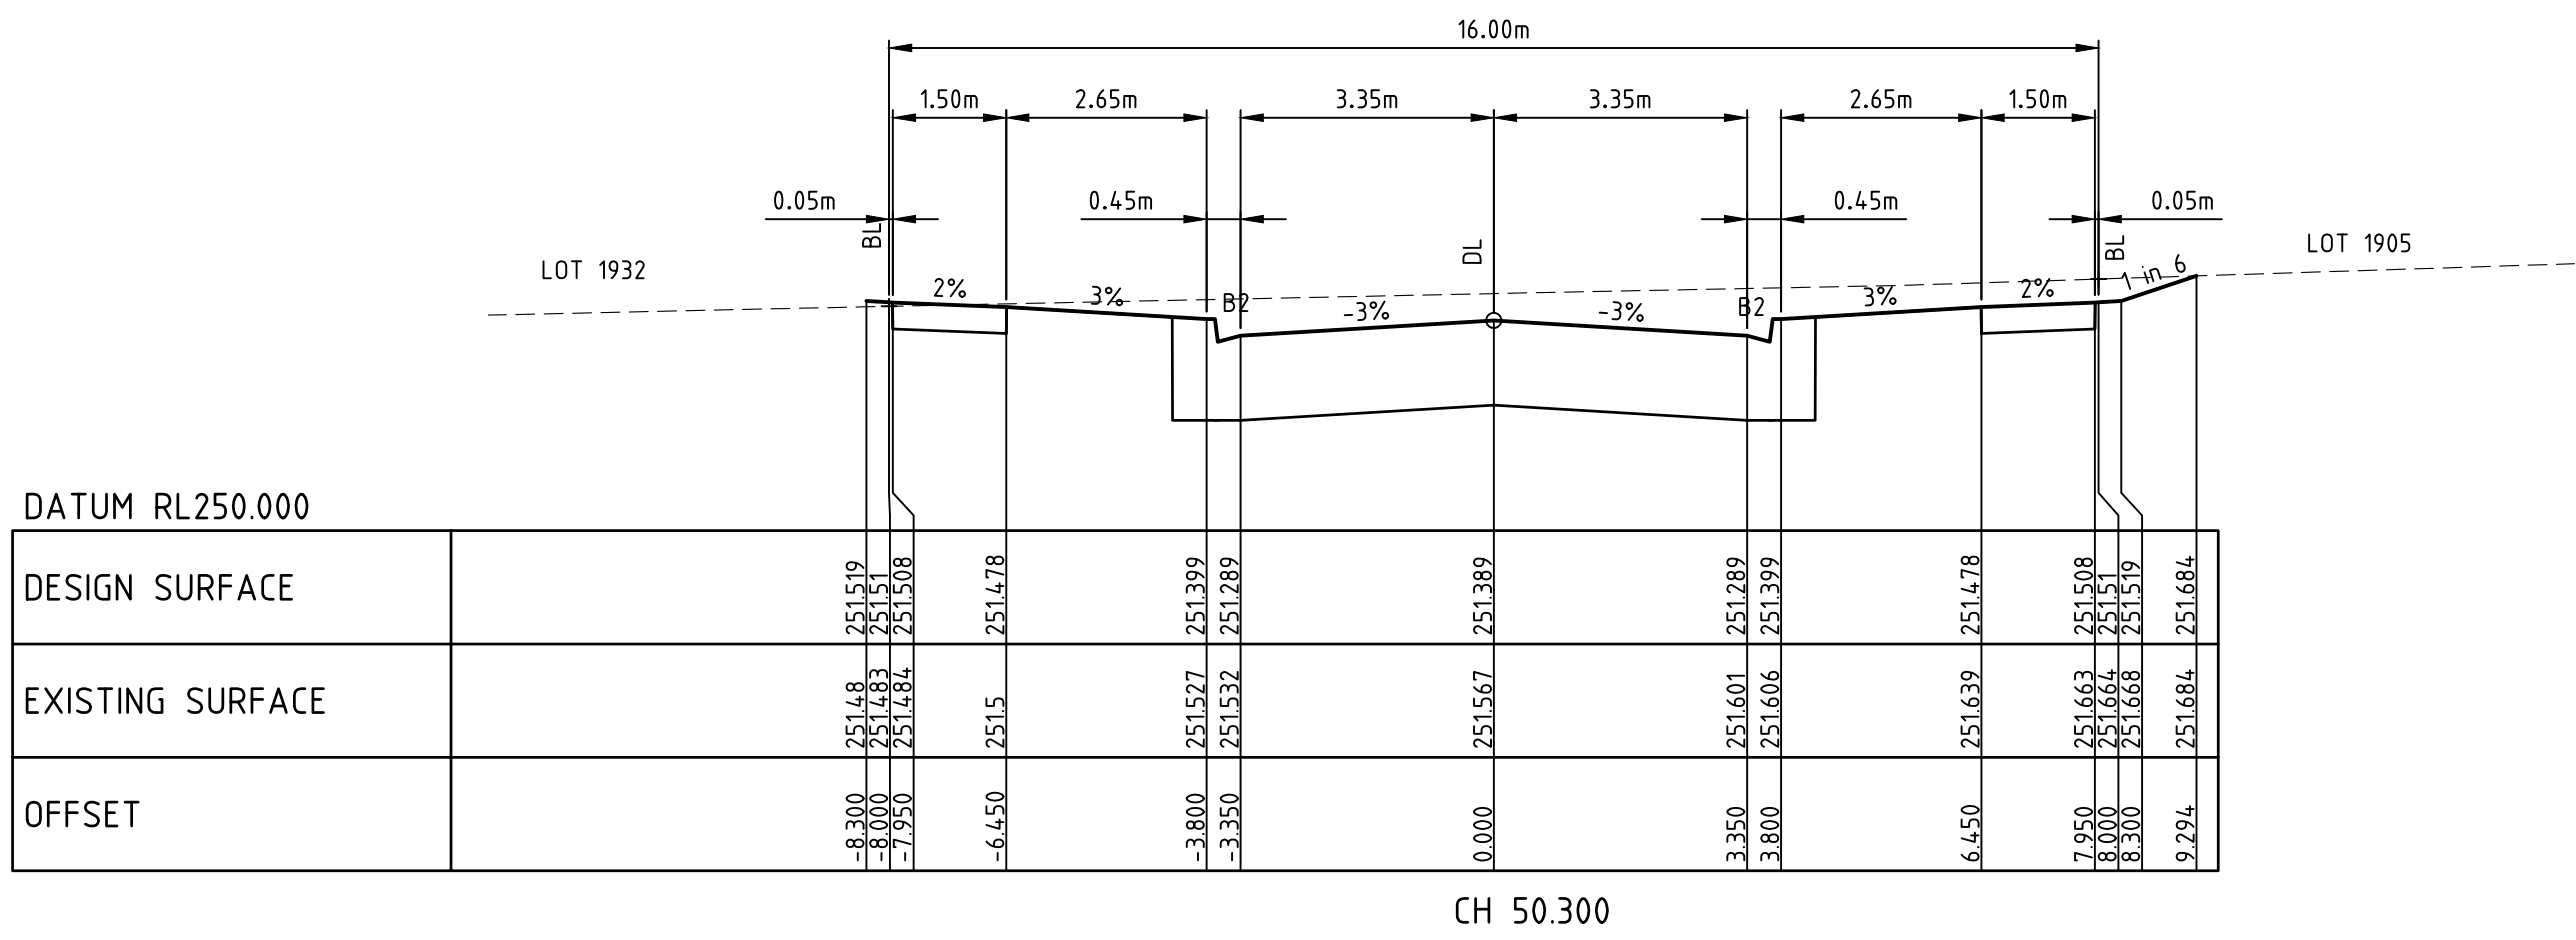





FERRARS WAY

LEGEND

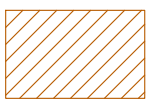

DENOTES ENGINEERED FILL TO BE IN ACCORDANCE WITH THE GEOTECHNICAL REPORT PREPARED BY GOLDER ASSOCIATES. ENGINEERING FILL TO BE APPROVED BY HUME CITY COUNCIL REFER TO DWG 11739TD01 NOTES, WITH LEVEL 1 SUPERVISION IN ACCORDANCE WITH AS3798-2007.

AS CONSTRUCTED

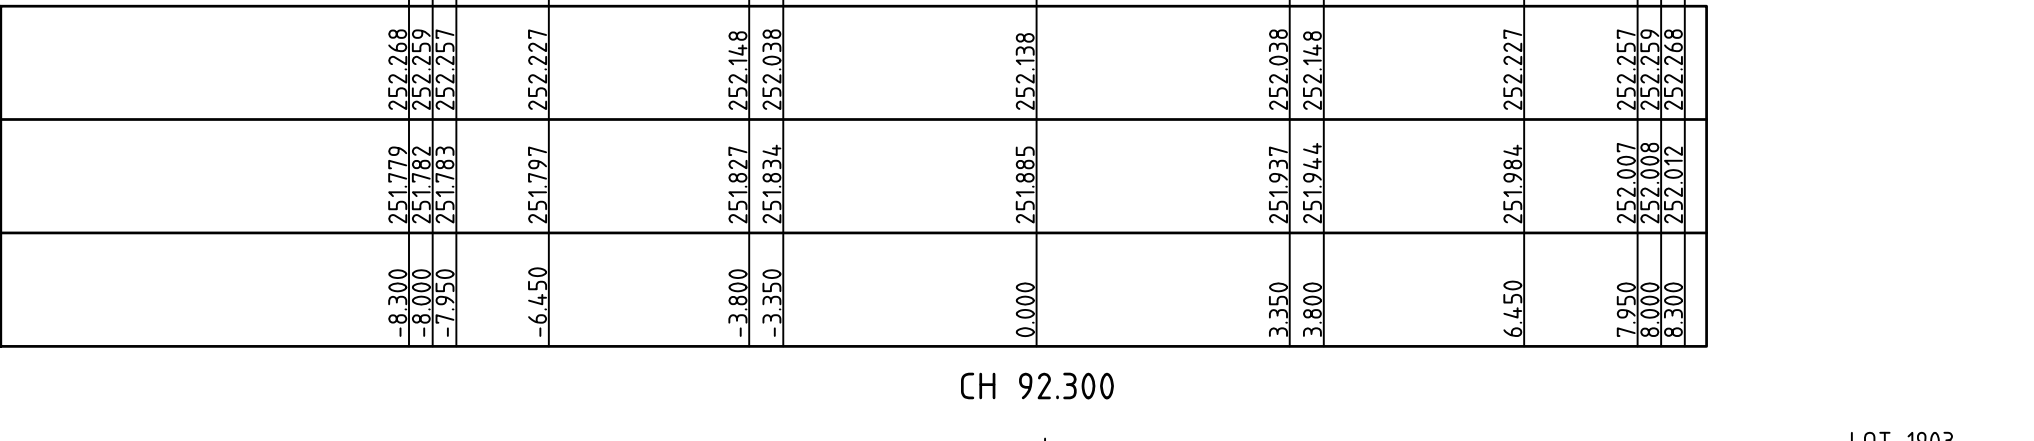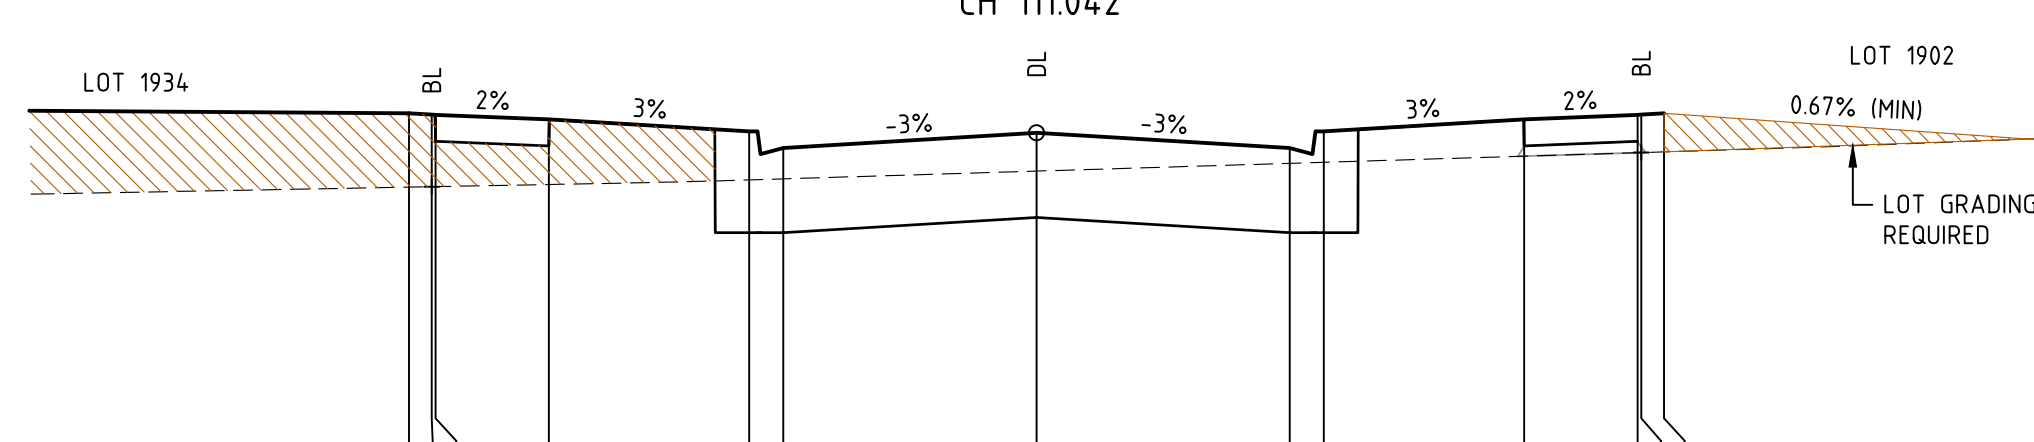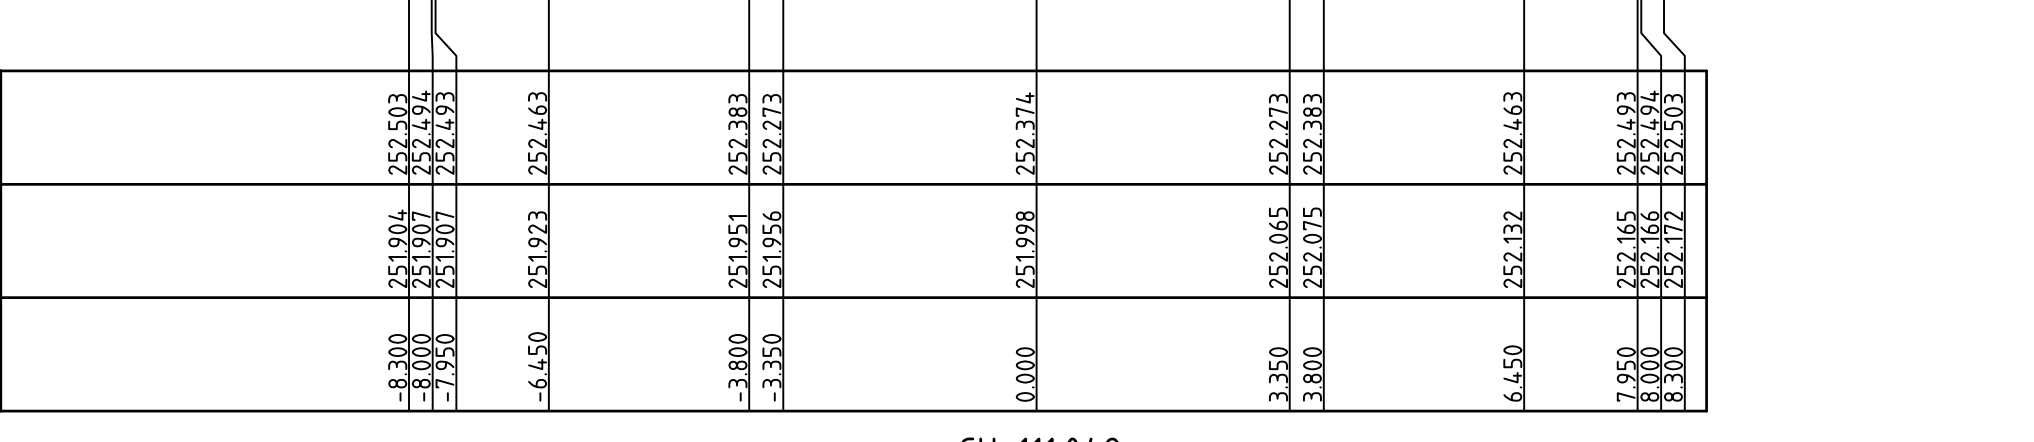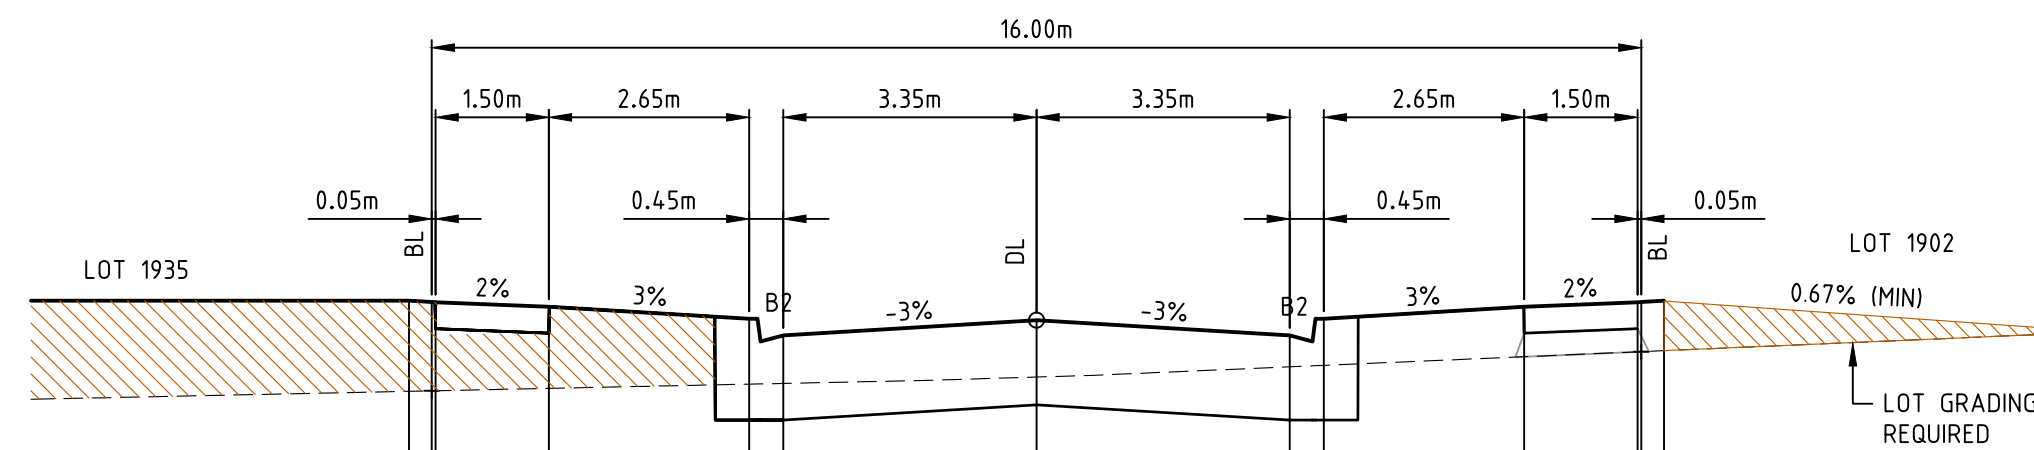

|     |                    |          |        |
|-----|--------------------|----------|--------|
| 1   | AS CONSTRUCTED     | 08/09/16 | TL     |
| 0   | CONSTRUCTION ISSUE | 03/02/16 | TL     |
| REV | AMENDMENTS         | DATE     | APP'D. |


Drawn M.CAPALDO  
Date 04/09/15  
AN 1451046  
Designed N.MIRATANA  
Date 24/06/15  
AN 1541361  
Verified B.GORDON  
Date 14/09/15  
AN 162529  
Audited T.OBOUHOFF  
Date 31/01/16  
AN 912883  
Approved T.LIAKOPOULOS  
Date 03/02/16  
AN 885206

Written dimensions to take precedence over scale. Contractor shall check and verify all dimensions on site. Discrepancies to be brought to the attention of the Superintendent.



Coords: MGA  
Levels: AHD  
Hor 1:100 0m 1m 2m 4m 6m  
Ver 1:50 0m 0.5m 1m 2m 3m  
Scale @ A1/A3 1:100/1:200  
VER: 1:50/1:100

MERRIFIELD DEVELOPMENT  
DONNYBROOK ROAD, MICKLEHAM  
STAGE 19  
CROSS SECTIONS  
SHEET 05 OF 05  
Drawing No. 11739XS05  
Rev 1  
Sheet No. 14  
AS CONSTRUCTED  
© Dalton Consulting Engineers Pty Ltd  
ABN 78 429 221 049

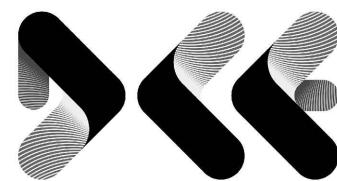

VICTORIA  
T 61 3 9813 7400  
W dceng.com.au

QUEENSLAND  
T 61 7 3374 9000  
E info@dceng.com.au

ABN 78 429 221 049













Drawing File: G:\Design\11700\11739-MERRIFIELD - Prelim 1 - Stage 19\Acad\RD\11739DR03.dwg - 11739DR03  
Date/Time: Thu Sep 08, 2016 - 4:54pm --byronashode--

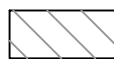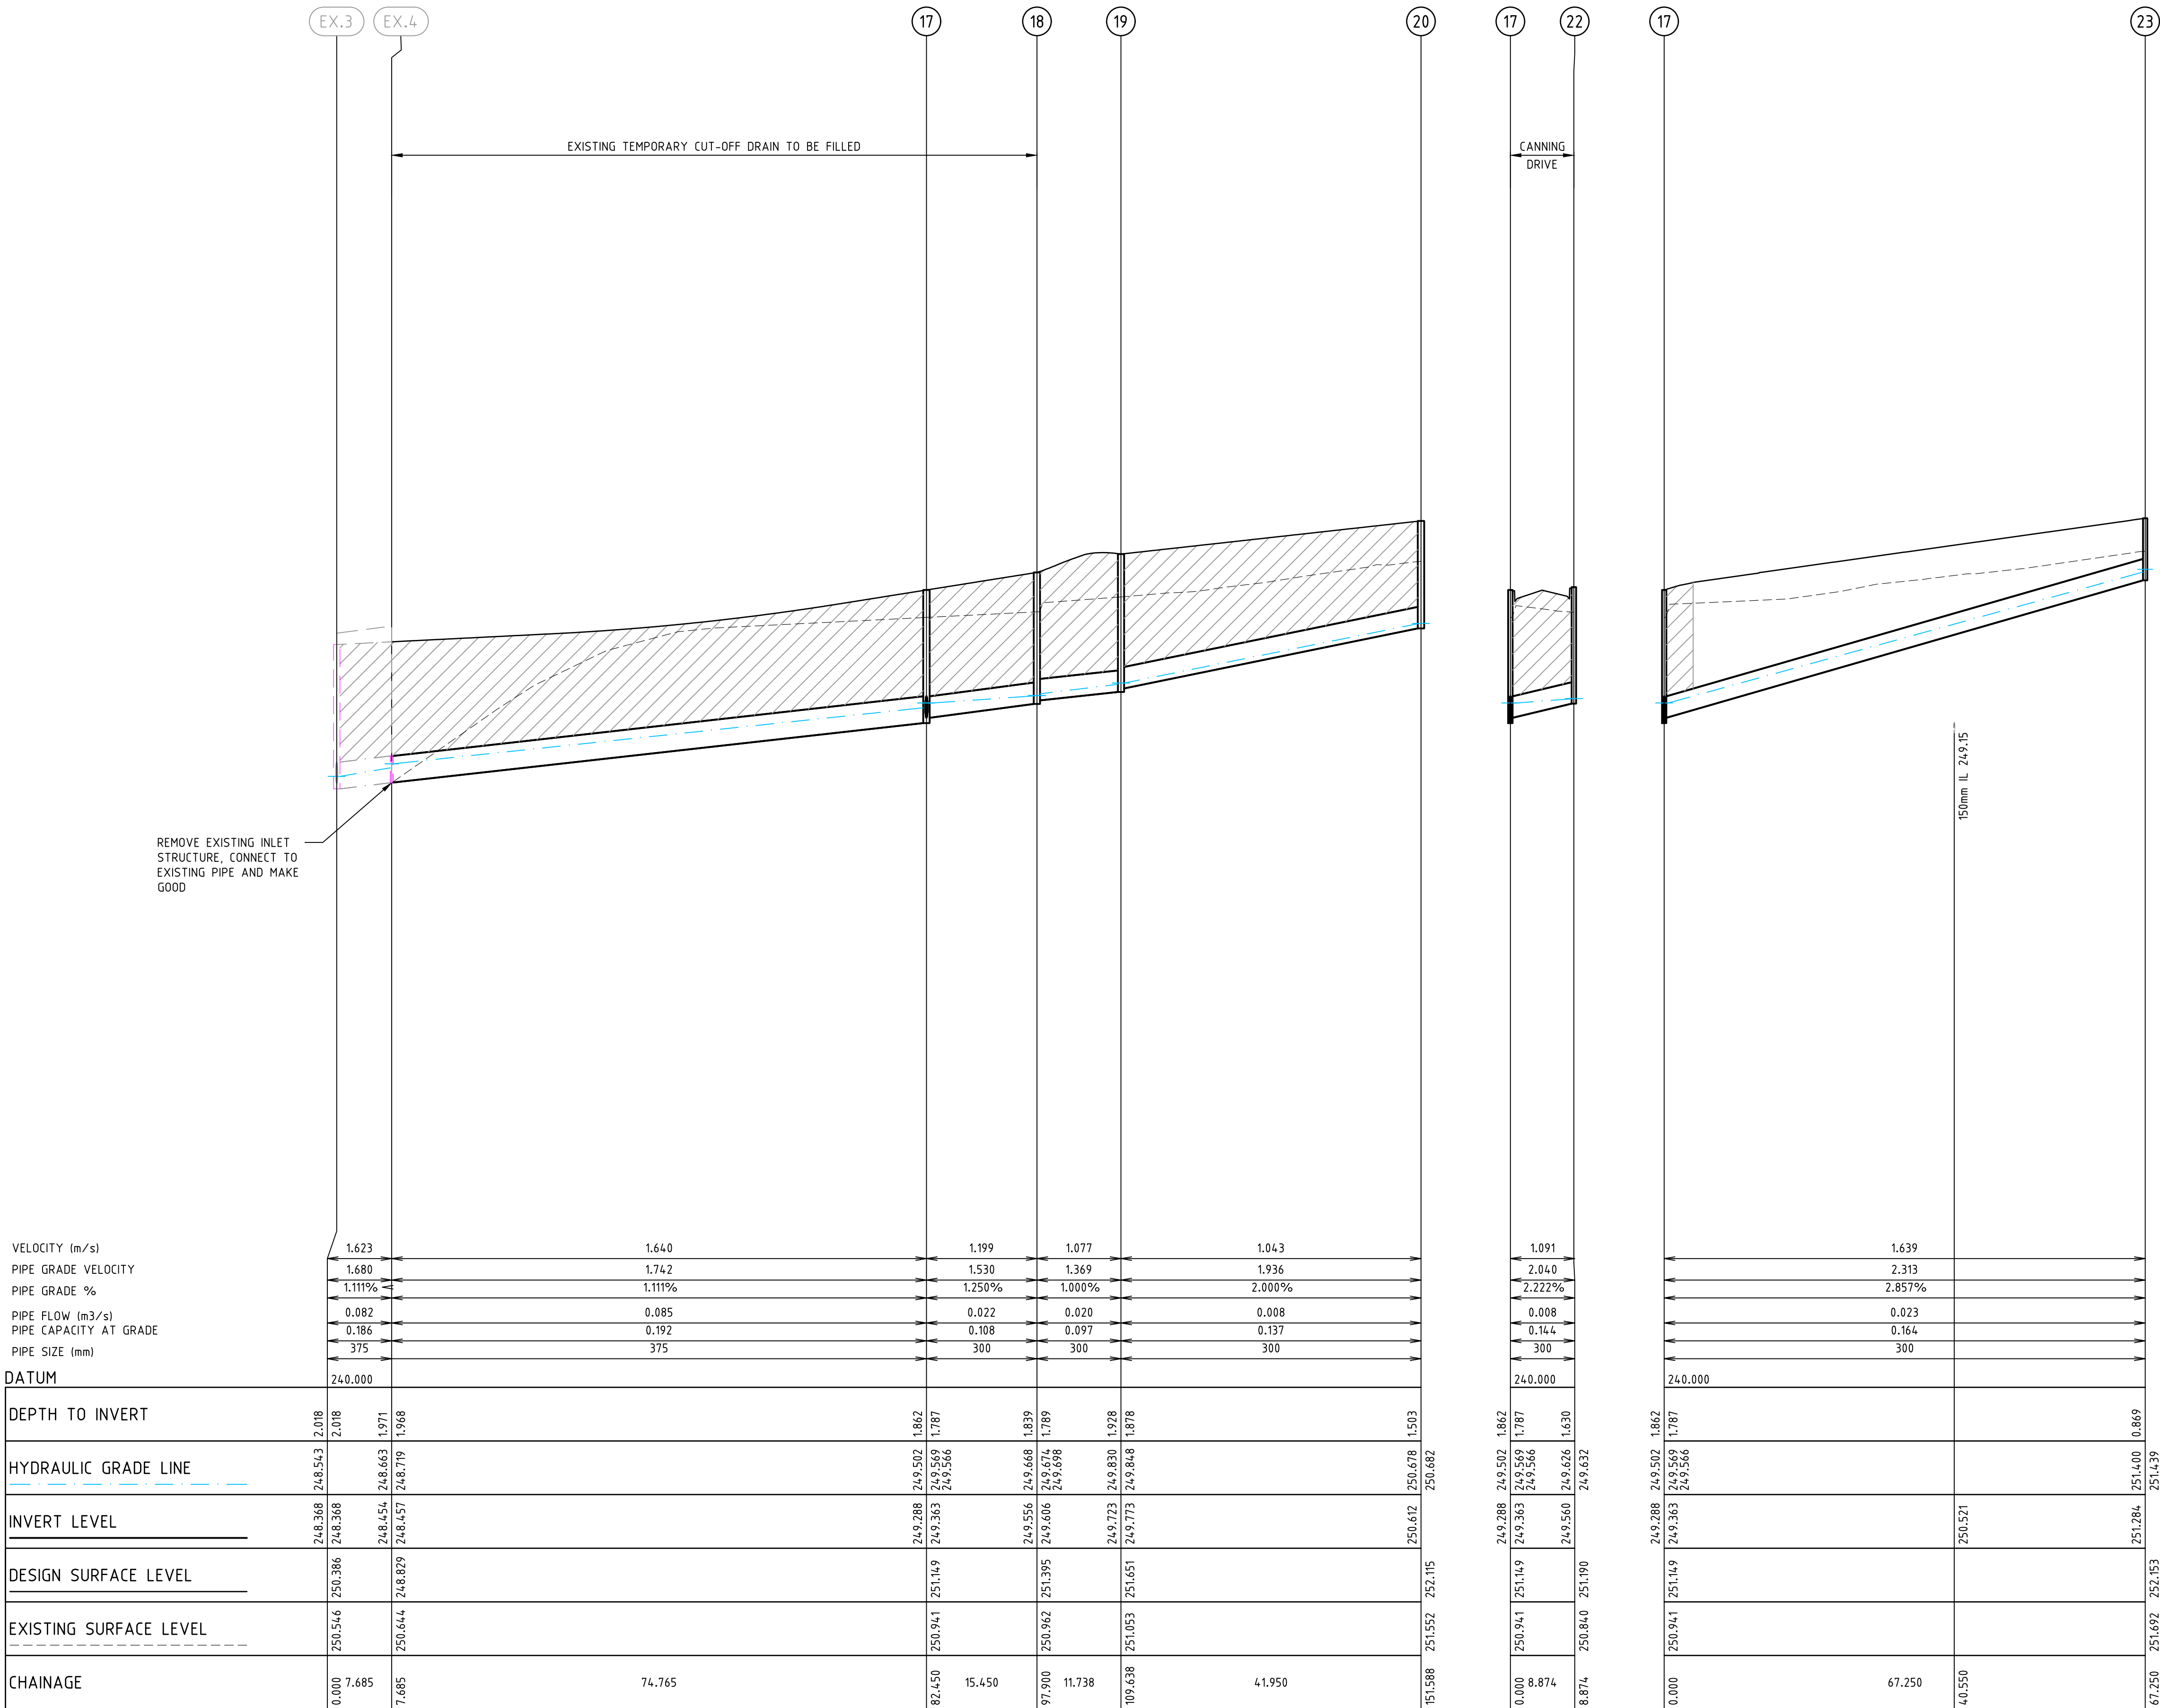

Denotes CRUSHED ROCK BACKFILL

AS CONSTRUCTED

|     |                    |          |        |
|-----|--------------------|----------|--------|
| 1   | AS CONSTRUCTED     | 08/09/16 | TL     |
| 0   | CONSTRUCTION ISSUE | 03/02/16 | TL     |
| REV | AMENDMENTS         | DATE     | APP'D. |

Drawn M.CAPALDO  
Date 04/09/15  
AN 1451046  
Designed N.MIRATANA  
Date 24/06/15  
AN 1541364  
Verified B.GORDON  
Date 14/09/15  
AN 162532  
Audited T.OBOUHOFF  
Date 31/01/16  
AN 912886  
Approved T.LIAKOPOULOS  
Date 03/02/16  
AN 885209

Written dimensions to take precedence over scale. Contractor shall check and verify all dimensions on site. Discrepancies to be brought to the attention of the Superintendent.

MERRIFIELD DEVELOPMENT  
DONNYBROOK ROAD, MICKLEHAM  
STAGE 19  
DRAINAGE LONGITUDINAL SECTIONS  
SHEET 03 OF 04  
Drawing No. 11739DR03  
Rev 1  
AS CONSTRUCTED

Coords: MGA  
Levels: AHD  
Hor 1:500 0m 5m 10m 20m 30m  
Ver 1:50 0m 0.5m 1m 2m 3m  
Scale @ A1/A3 1:500/1:1000  
VER: 1:50/1:100



VICTORIA  
T 61 3 9813 7400  
W dceng.com.au

QUEENSLAND  
T 61 7 3374 9000  
E info@dceng.com.au

ABN 78 429 221 049



Drawing File: G:\Design\11739-11739-MERRIFIELD - Prelim 1 - Stage 19\Acad\11739DR04.dwg - 11739DR04  
Date/Time: Thu Sep 08, 2016 - 4:55pm - ByronShade

CONNECT TO EXISTING  
300Ø DRAINAGE STUB.  
REMOVE END CAP AND  
MARKER POST.

EXISTING DAM TO BE FILLED


PROVIDE 300Ø DRAINAGE  
STUB FOR FUTURE  
CONNECTION

CONNECT TO EXISTING  
375Ø DRAINAGE STUB.  
REMOVE END CAP AND  
MARKER POST.

VELOCITY (m/s)  
PIPE GRADE VELOCITY  
PIPE GRADE %  
PIPE FLOW (m3/s)  
PIPE CAPACITY AT GRADE  
PIPE SIZE (mm)

|                        |         |         |         |  |         |
|------------------------|---------|---------|---------|--|---------|
| DATUM                  | 239.000 |         |         |  |         |
| DEPTH TO INVERT        | 1.281   |         |         |  | 0.753   |
| HYDRAULIC GRADE LINE   | 248.540 |         |         |  | 250.361 |
| INVERT LEVEL           | 248.235 | 249.351 | 249.515 |  | 250.140 |
| DESIGN SURFACE LEVEL   | 248.235 | 249.185 | 249.515 |  | 250.140 |
| EXISTING SURFACE LEVEL | 249.692 | 250.227 | 250.255 |  | 250.893 |
| CHAINAGE               | 0.000   | 72.000  | 54.000  |  | 126.000 |

|  |         |         |         |         |         |
|--|---------|---------|---------|---------|---------|
|  | 1.662   | 1.509   | 1.375   | 1.428   |         |
|  | 1.782   | 1.782   | 1.530   | 1.936   |         |
|  | 1.250%  | 1.250%  | 1.250%  | 2.000%  |         |
|  | 0.076   | 0.053   | 0.036   | 0.022   |         |
|  | 0.197   | 0.197   | 0.108   | 0.137   |         |
|  | 375     | 375     | 300     | 300     |         |
|  | 240.000 |         |         |         |         |
|  | 1.830   |         |         |         |         |
|  | 248.691 | 248.953 |         |         |         |
|  | 248.691 | 248.744 | 248.945 | 1.835   |         |
|  | 248.744 | 248.744 | 248.993 | 1.835   |         |
|  | 249.482 | 249.648 | 1.762   |         |         |
|  | 249.557 | 249.662 | 1.687   |         |         |
|  | 250.131 | 250.277 | 1.527   |         |         |
|  | 250.182 | 250.300 | 1.477   |         |         |
|  | 250.428 |         |         |         |         |
|  | 250.821 | 250.950 | 1.418   |         |         |
|  | 250.520 | 250.573 | 251.194 |         |         |
|  | 250.520 | 250.573 | 251.194 |         |         |
|  | 4.200   | 59.000  | 46.000  | 109.200 | 126.000 |
|  | 0.000   | 4.200   | 63.200  | 126.400 | 141.200 |

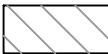

DENOTES CRUSHED ROCK BACKFILL

AS CONSTRUCTED

MERRIFIELD DEVELOPMENT  
DONNYBROOK ROAD, MICKLEHAM  
STAGE 19  
DRAINAGE LONGITUDINAL SECTIONS  
SHEET 04 OF 04  
Drawing No. 11739DR04 Rev 1  
AS CONSTRUCTED

Coords: MGA  
Levels: AHD  
Hor 1:500 0m 5m 10m 20m 30m  
Ver 1:50 0m 0.5m 1m 2m 3m  
Scale @ A1/A3 1:500/1:1000  
VER: 1:50/1:100

Sheet No. 18  
© Dalton Consulting Engineers Pty Ltd  
ABN 78 429 221 049



VICTORIA  
T 61 3 9813 7400  
W dceng.com.au

QUEENSLAND  
T 61 7 3374 9000  
E info@dceng.com.au

|     |                    |          |        |
|-----|--------------------|----------|--------|
| 1   | AS CONSTRUCTED     | 08/09/16 | TL     |
| 0   | CONSTRUCTION ISSUE | 03/02/16 | TL     |
| REV | AMENDMENTS         | DATE     | APP'D. |

Written dimensions to take precedence over scale. Contractor shall check and verify all dimensions on site. Discrepancies to be brought to the attention of the Superintendent.




Drawing File: G:\Design\11739-MERRIFIELD - Precinct 1 - Stage 19\Acad\RD\11739DR05.dwg - 11739DR05  
Date/Time: Thu Sep 08, 2016 - 4:55pm --ByronAshde--


| PIT    |      | EASTING    | NORTHING    | INTERNAL     |               | INLET             |                               | OUTLET     |                    | PIT                |              | REMARKS                                                                                                                                                                      |
|--------|------|------------|-------------|--------------|---------------|-------------------|-------------------------------|------------|--------------------|--------------------|--------------|------------------------------------------------------------------------------------------------------------------------------------------------------------------------------|
| NAME   | TYPE |            |             | WD           | LEN           | DIA               | INV LEV                       | DIA        | INV LEV            | SETOUT RL          | DEPTH        |                                                                                                                                                                              |
| Ex.2   | GSEP | 314596.329 | 5843837.584 | T600<br>B900 | T900<br>B1100 | 450<br>600        | 248.168<br>248.018            | 675<br>600 | 247.943<br>248.043 | 250.261<br>248.642 | 2.243<br>0.6 | EXISTING HAUNCHED JP TO BE CONVERTED TO GSEP. REFER TO MPA STD DRG FIG.012 & HCC STD DRG SD245. PIT TO HAVE EXISTING V-NOTCH PATCHED ONCE TEMPORARY CUT-OFF DRAIN IS FILLED. |
| Ex.E2  | EP   | 314594.837 | 5843836.420 |              |               | 600               | 248.042                       | 600        | 248.043            | 248.642            | 0.6          | EXISTING STUB END. END CAP AND MARKER POST TO BE REMOVED AND NEW PIPE CONNECTED.                                                                                             |
| 1      | GSEP | 314587.073 | 5843830.366 | T600<br>B900 | T900<br>B1100 | 600               | 248.22                        | 600        | 248.17             | 250.285            | 2.115        | HAUNCHED GSEP. REFER TO MPA STD DRG FIG.012 & HUME CITY CD COUNCIL SD 245                                                                                                    |
| 2      | GSEP | 314586.029 | 5843821.930 | T600<br>B900 | T900<br>B900  | 525               | 248.38                        | 600        | 248.305            | 250.274            | 1.969        | HAUNCHED GSEP. REFER TO MPA STD DRG FIG.012 & VICROADS SD 1021-1023                                                                                                          |
| 3      | GSEP | 314552.832 | 5843826.037 | T600<br>B900 | T900<br>B900  | 525<br>300        | 248.765<br>248.94             | 525        | 248.714            | 250.752            | 2.038        | HAUNCHED GSEP. REFER TO MPA STD DRG FIG.012 & VICROADS SD 1021-1023                                                                                                          |
| 4      | GSEP | 314520.628 | 5843830.021 | T600<br>B900 | T900<br>B900  | 525<br>300        | 249.177<br>249.352            | 525        | 249.127            | 251.125            | 1.998        | HAUNCHED GSEP. REFER TO MPA STD DRG FIG.012 & VICROADS SD 1021-1023                                                                                                          |
| 5      | GSEP | 314511.372 | 5843822.803 | T600<br>B900 | T900<br>B900  | 525               | 249.286                       | 525        | 249.236            | 251.215            | 1.979        | HAUNCHED GSEP. REFER TO MPA STD DRG FIG.012 & VICROADS SD 1021-1023                                                                                                          |
| 6      | GSEP | 314502.936 | 5843823.847 | T600<br>B900 | T900<br>B900  | 375<br>450        | 249.478<br>249.403            | 525        | 249.328            | 251.215            | 1.887        | HAUNCHED GSEP. REFER TO MPA STD DRG FIG.012 & VICROADS SD 1021-1023                                                                                                          |
| 7      | GSEP | 314493.021 | 5843743.708 | 600          | 900           | 300<br>300<br>300 | 250.367<br>250.367<br>250.367 | 375        | 250.292            | 252.179            | 1.887        | REFER TO MPA STD DRG FIG.012                                                                                                                                                 |
| 8      | GSEP | 314490.916 | 5843726.695 | 600          | 900           | 300               | 251.203                       | 300        | 251.153            | 252.392            | 1.239        | REFER TO MPA STD DRG FIG.012                                                                                                                                                 |
| 9      | GSEP | 314481.607 | 5843719.492 | 600          | 900           |                   |                               | 300        | 251.46             | 252.657            | 1.198        | REFER TO MPA STD DRG FIG.012                                                                                                                                                 |
| 10     | JP   | 314543.900 | 5843753.837 | 600          | 600           |                   |                               | 300        | 250.7              | 251.551            | 0.851        | REFER TO MPA STD DRG FIG.014                                                                                                                                                 |
| 11     | GSEP | 314520.307 | 5843838.626 | 600          | 900           |                   |                               | 300        | 249.496            | 251.141            | 1.645        | REFER TO MPA STD DRG FIG.012                                                                                                                                                 |
| 12     | GSEP | 314495.718 | 5843833.103 | 600          | 900           | 375               | 249.869                       | 450        | 249.794            | 251.414            | 1.619        | REFER TO MPA STD DRG FIG.012                                                                                                                                                 |
| 13     | GSEP | 314469.468 | 5843836.351 | 600          | 900           | 375<br>300        | 250.333<br>250.358            | 375        | 250.283            | 251.736            | 1.452        | REFER TO MPA STD DRG FIG.012                                                                                                                                                 |
| E13    | EP   | 314463.513 | 5843837.088 |              |               | 375               | 250.393                       | 375        | 250.393            | 250.768            | 0.375        | TEMPORARY END. PROVIDE END CAP AND MARKER POST                                                                                                                               |
| 14     | JP   | 314460.069 | 5843760.380 | 600          | 600           |                   |                               | 300        | 251.634            | 252.515            | 0.881        | REFER TO MPA STD DRG FIG.014                                                                                                                                                 |
| 15     | JP   | 314462.504 | 5843747.484 | 600          | 900           | 225               | 251.467                       | 300        | 251.392            | 252.528            | 1.135        | REFER TO MPA STD DRG FIG.014                                                                                                                                                 |
| E15    | EP   | 314457.542 | 5843748.097 |              |               | 225               | 251.634                       | 225        | 251.634            | 251.859            | 0.225        | TEMPORARY END. PROVIDE END CAP AND MARKER POST                                                                                                                               |
| 16     | GSEP | 314501.137 | 5843740.076 | 600          | 900           |                   |                               | 300        | 250.565            | 252.222            | 1.658        | REFER TO MPA STD DRG FIG.012                                                                                                                                                 |
| Ex.3   | GSEP | 314593.247 | 5843812.674 | T600<br>B900 | T900<br>B900  | 375<br>300        | 248.368<br>248.443            | 450        | 248.293            | 250.386            | 2.018        | EXISTING HAUNCHED JP TO BE CONVERTED TO GSEP. REFER TO MPA STD DRG FIG.012 & HCC STD DRG SD245.                                                                              |
| Ex.4   | EP   | 314592.304 | 5843805.046 |              |               | 375               | 248.457                       | 375        | 248.454            | 248.829            | 0.375        | EXISTING ENDWALL TO BE REMOVED AND NEW PIPE TO BE CONNECTED TO EXISTING PIPE.                                                                                                |
| 17     | GSEP | 314583.124 | 5843730.847 | 600          | 900           | 300<br>300<br>300 | 249.363<br>249.363<br>249.363 | 375        | 249.288            | 251.149            | 1.862        | REFER TO MPA STD DRG FIG.012                                                                                                                                                 |
| 18     | GSEP | 314581.227 | 5843715.514 | 600          | 900           | 300               | 249.606                       | 300        | 249.556            | 251.395            | 1.839        | REFER TO MPA STD DRG FIG.012                                                                                                                                                 |
| 19     | GSEP | 314571.971 | 5843708.296 | 600          | 900           | 300               | 249.773                       | 300        | 249.723            | 251.651            | 1.928        | REFER TO MPA STD DRG FIG.012                                                                                                                                                 |
| 20     | GSEP | 314530.338 | 5843713.447 | 600          | 900           |                   |                               | 300        | 250.612            | 252.115            | 1.503        | REFER TO MPA STD DRG FIG.012                                                                                                                                                 |
| Ex.E3  | EP   | 314594.926 | 5843811.637 |              |               | 300               | 248.506                       | 300        | 248.506            | 250.294            | 1.788        | EXISTING STUB END. END CAP AND MARKER POST TO BE REMOVED AND NEW PIPE CONNECTED.                                                                                             |
| 21     | GSEP | 314601.204 | 5843807.759 | 600          | 900           |                   |                               | 300        | 248.74             | 250.406            | 1.666        | REFER TO MPA STD DRG FIG.012                                                                                                                                                 |
| 22     | GSEP | 314591.246 | 5843727.273 | 600          | 900           |                   |                               | 300        | 249.56             | 251.19             | 1.63         | REFER TO MPA STD DRG FIG.012                                                                                                                                                 |
| 23     | JP   | 314516.383 | 5843739.105 | 600          | 600           |                   |                               | 300        | 251.284            | 252.153            | 0.869        | REFER TO MPA STD DRG FIG.014                                                                                                                                                 |
| Ex.E22 | EP   | 314646.537 | 5843843.917 |              |               | 300               | 248.235                       |            |                    | 248.535            | 0.3          | EXISTING STUB END. END CAP AND MARKER POST TO BE REMOVED AND NEW PIPE CONNECTED.                                                                                             |
| 24     | JP   | 314637.696 | 5843772.462 | 600          | 900           | 300               | 249.185                       | 300        | 249.135            | 250.255            | 1.12         | REFER TO MPA STD DRG FIG.014                                                                                                                                                 |
| 25     | JP   | 314631.066 | 5843718.870 | 600          | 600           |                   |                               | 300        | 250.14             | 250.893            | 0.753        | REFER TO MPA STD DRG FIG.014                                                                                                                                                 |
| Ex.E11 | EP   | 314573.029 | 5843867.118 |              |               | 375               | 248.744                       | 375        | 248.744            | 249.119            | 0.375        | EXISTING STUB END. END CAP AND MARKER POST TO BE REMOVED AND NEW PIPE CONNECTED.                                                                                             |
| 26     | JP   | 314514.476 | 5843874.362 | 600          | 900           | 300               | 249.557                       | 375        | 249.482            | 251.244            | 1.762        | REFER TO MPA STD DRG FIG.014                                                                                                                                                 |
| 27     | JP   | 314468.824 | 5843880.010 | 600          | 900           | 300               | 250.182                       | 300        | 250.131            | 251.659            | 1.527        | REFER TO MPA STD DRG FIG.014                                                                                                                                                 |
| CUL1   | EW   | 314453.163 | 5843856.345 |              |               | 450x300           | 251.526                       |            |                    | 251.826            | 0.3          | BOX CULVERT TO FOLLOW EXISTING CENTRELINE OF OPEN-EARTH DRAIN                                                                                                                |
| CUL2   | EW   | 314449.415 | 5843827.789 |              |               |                   |                               | 450x300    | 251.764            | 252.064            | 0.3          | BOX CULVERT TO FOLLOW EXISTING CENTRELINE OF OPEN-EARTH DRAIN                                                                                                                |

KEY:  
GSEP = GRATED SIDE ENTRY PIT  
JP = JUNCTION PIT  
EW = ENDWALL  
PP = PIPE TO PIPE CONNECTION  
(T) = TOP INTERNAL PIT DIMENSION  
(B) = BOTTOM INTERNAL PIT DIMENSION

**WARNING:**  
NO DRAINAGE WORKS SHALL COMMENCE UNTIL THE CONTRACTOR CONFIRMS THE I.L. OF ALL EXISTING DRAINS, AND CONFIRMS IN WRITING WITH THE ENGINEERING SUPERVISOR.

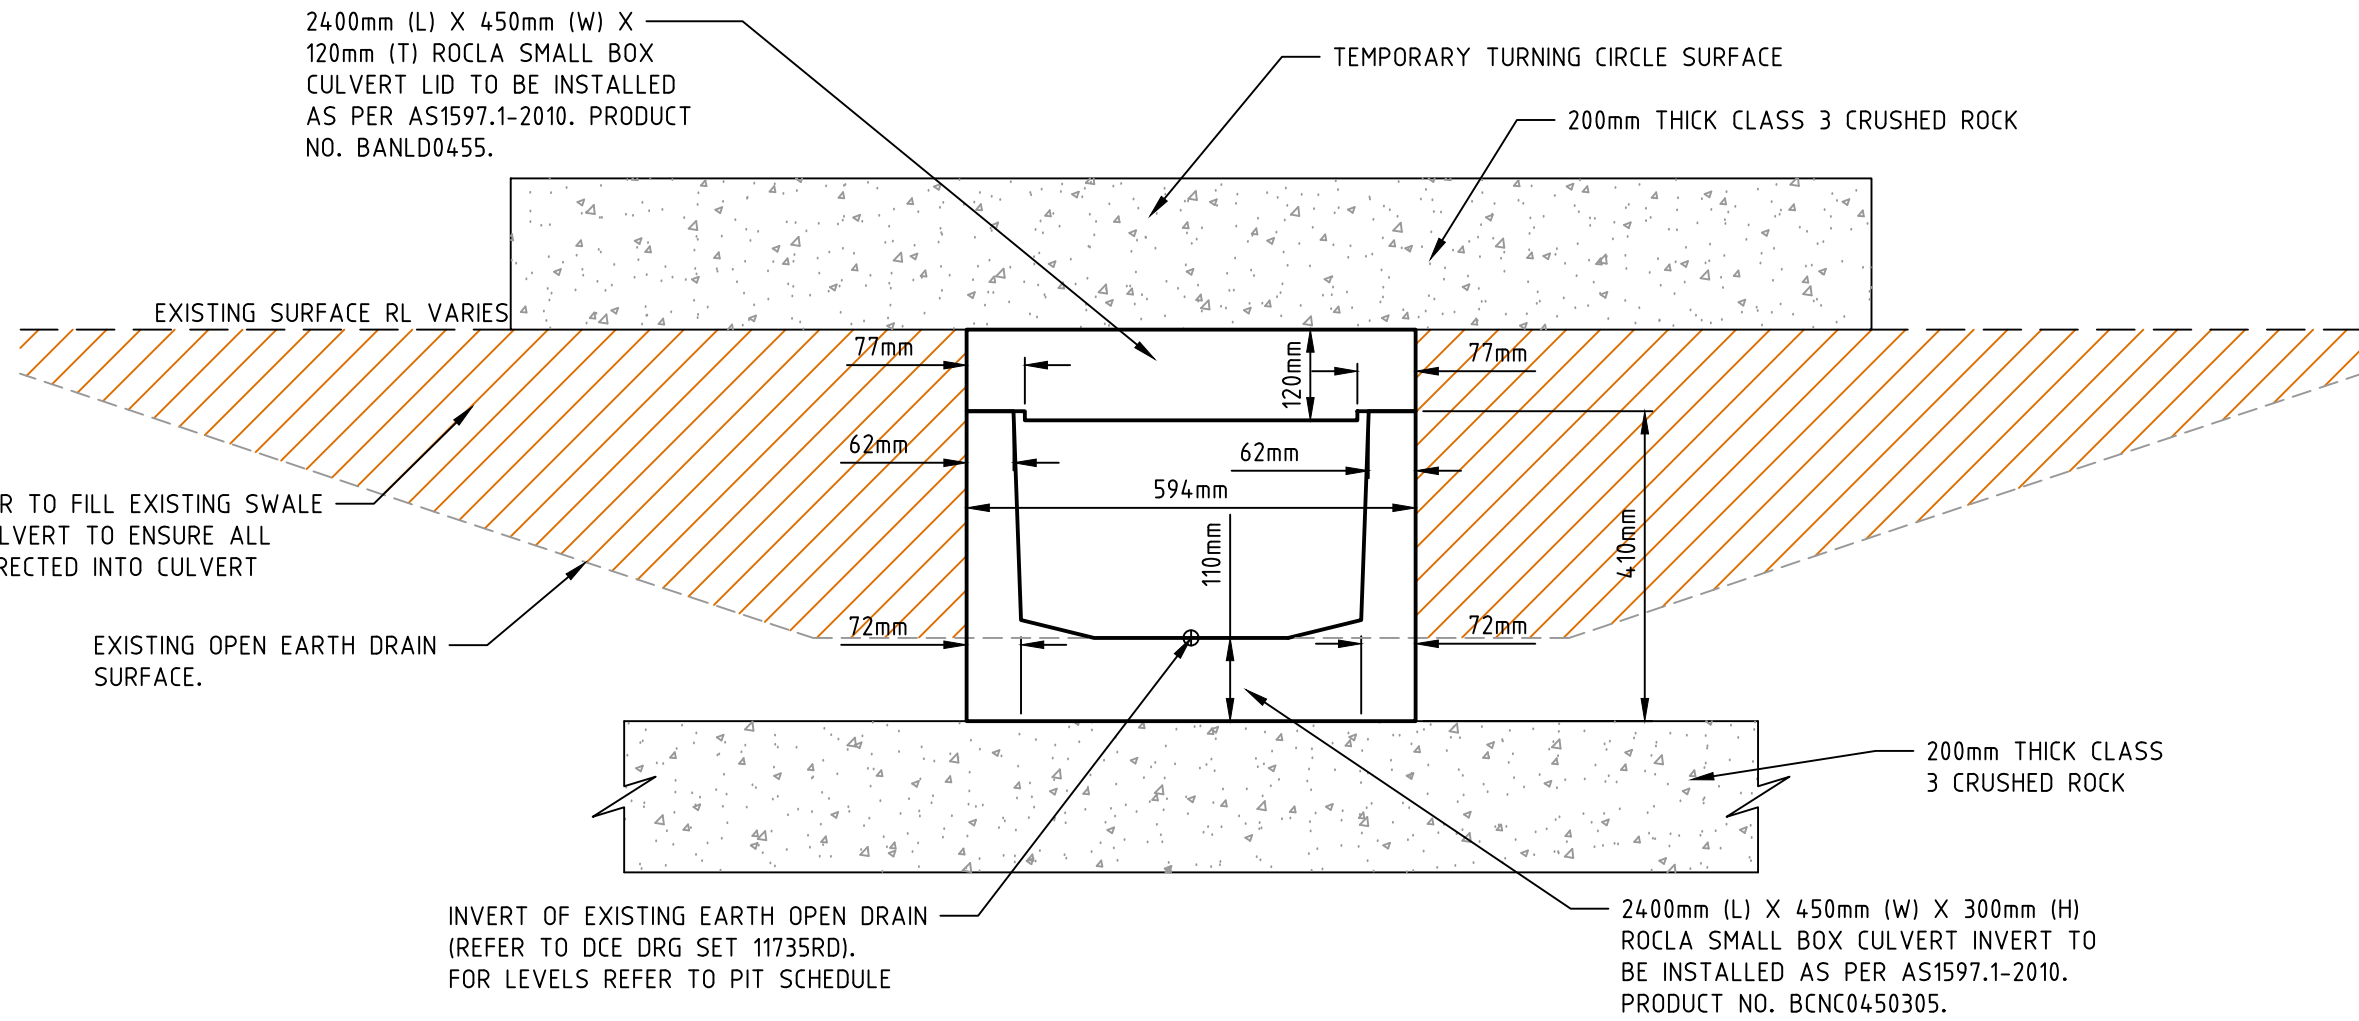


TYPICAL ROCLA SMALL BOX CULVERT INVERT AND LID DETAIL  
N.T.S

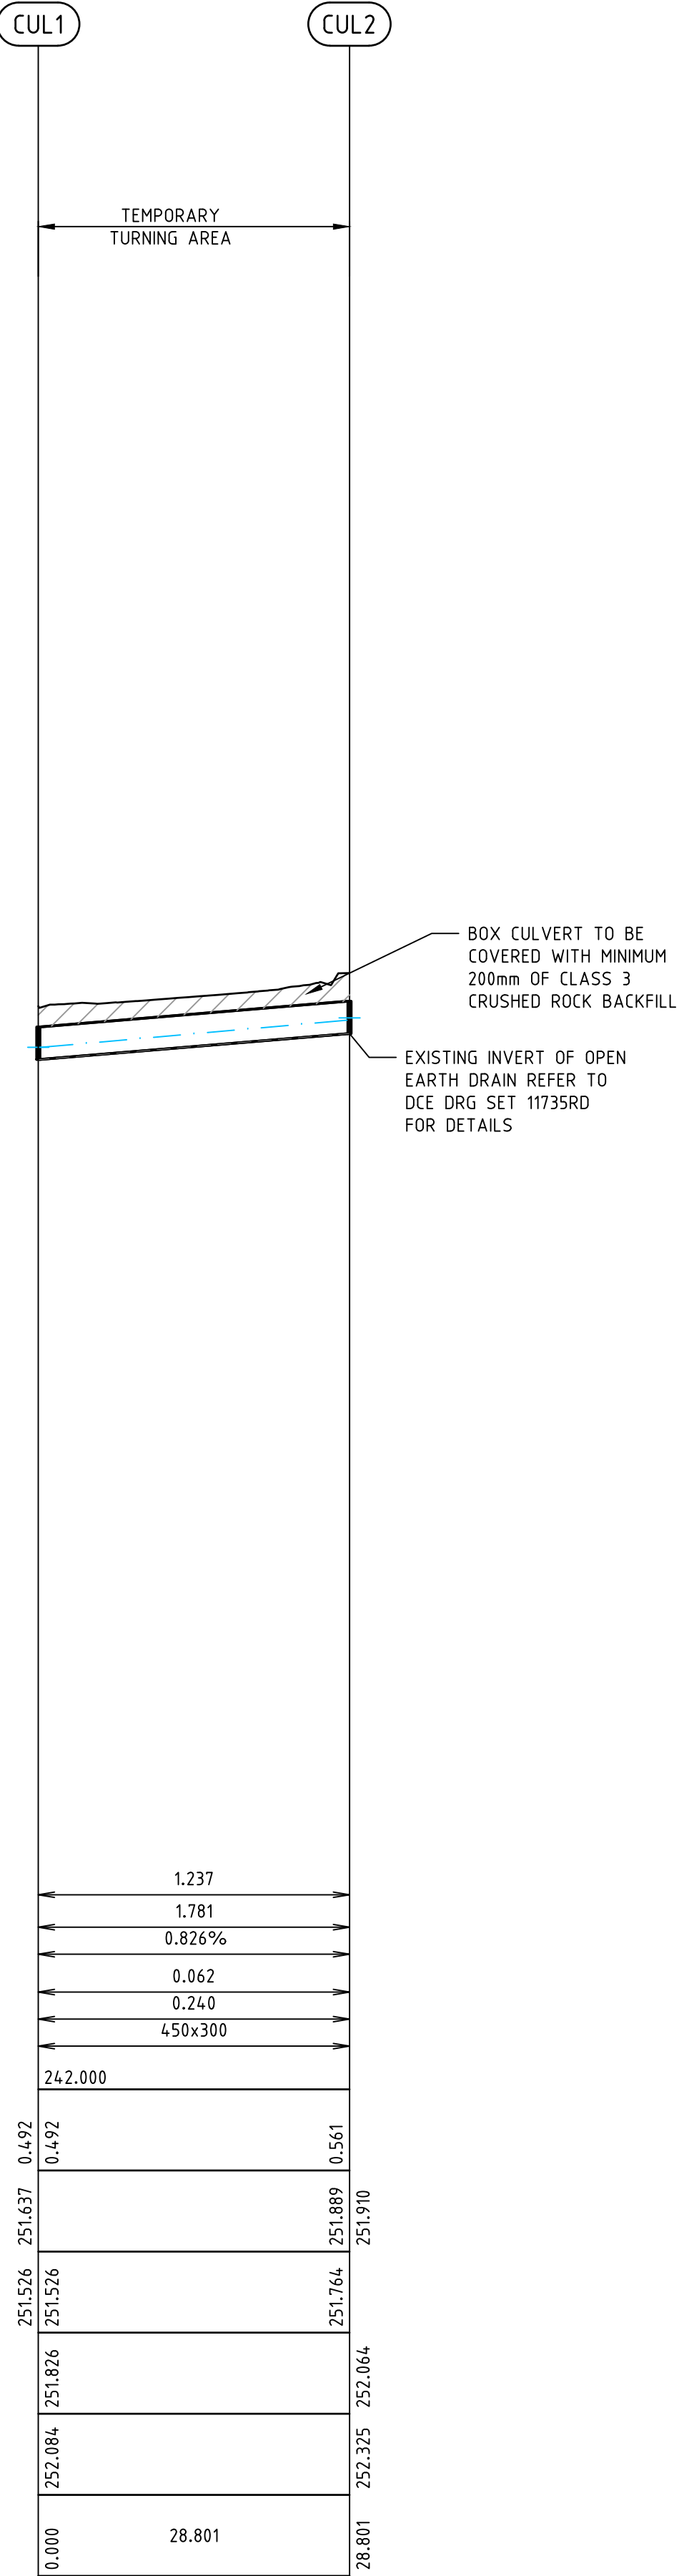

NOTES :

- EASTING, NORTHING SETOUT TO CENTRE OF PIT COVER SHAFT.
- SETOUT LEVEL TO PIT COVER LEVEL.
- EASTING, NORTHING ENDWALL SETOUT POINTS QUOTED TO PIPE BASE CENTRE.
- ALL PIT COVERS TO BE IN ACCORDANCE TO MPA.
- ALL TEMPORARY JUNCTION PITS (JP) TO BE CONSTRUCTED WITH KEYED CONSTRUCTION JOINTS (K.C.J) FOR FUTURE SEP CONVERSION
- ALL DRAINAGE WORKS ARE TO BE CONSTRUCTED TO GROWTH AREA AUTHORITY (GAA) SPECIFICATIONS.
- PIT BASE TO BE SHAPED WITH MASS CONCRETE FOR SMOOTH HYDRAULIC FLOW.
- ALL STORMWATER DRAINS ARE TO BE CLASS 2 R.C. OR RIGID F.R.C PIPES WITH ADCOL FLEXIBLE COLLARS UNLESS NOTED OTHERWISE. ALL PIPES UP TO AND INCLUDING 750mm DIA. ARE TO BE RUBBER RING JOINTED. INTERLOCKING / FLUSH JOINTS WITH EXTERNAL BANDS CAN ONLY BE USED ON PIPE SIZES OVER 600mm DIA.
- ALL HAUNCHED PITS SHALL BE CONSTRUCTED IN ACCORDANCE WITH HUME CITY COUNCIL SD245

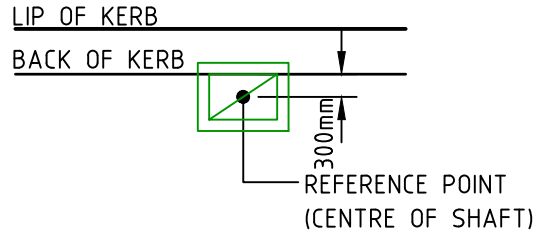

PIT SETOUT POINT  
SCALE 1:100

--- DENOTES CRUSHED ROCK BACKFILL

AS CONSTRUCTED

MERRIFIELD DEVELOPMENT  
DONNYBROOK ROAD, MICKLEHAM  
STAGE 19  
PIT SCHEDULE AND DETAILS

Drawing No. 11739DR05 Rev 1  
Sheet No. 19 AS CONSTRUCTED

Coords: MGA  
Levels: AHD  
Hor 1:500 0m 5m 10m 20m 30m  
Ver 1:50 0m 0.5m 1m 2m 3m  
Scale @ A1/A3 1:500/1:1000  
VER: 1:50/1:100

© Dalton Consulting Engineers Pty Ltd  
ABN 78 429 221 049



VICTORIA  
T 61 3 9813 7400  
W dceng.com.au



QUEENSLAND  
T 61 7 3374 9000  
E info@dceng.com.au

ABN 78 429 221 049

Written dimensions to take precedence over scale. Contractor shall check and verify all dimensions on site. Discrepancies to be brought to the attention of the Superintendent.



Drawing File: G:\Design\11700\11739-MERRIFIELD - Precinct 1 - Stage 19\Acad\PO\11739POS01.dwg - 11739POS01  
Date/Time: Thu, Sep 08, 2016 - 4:55pm --byronashide--

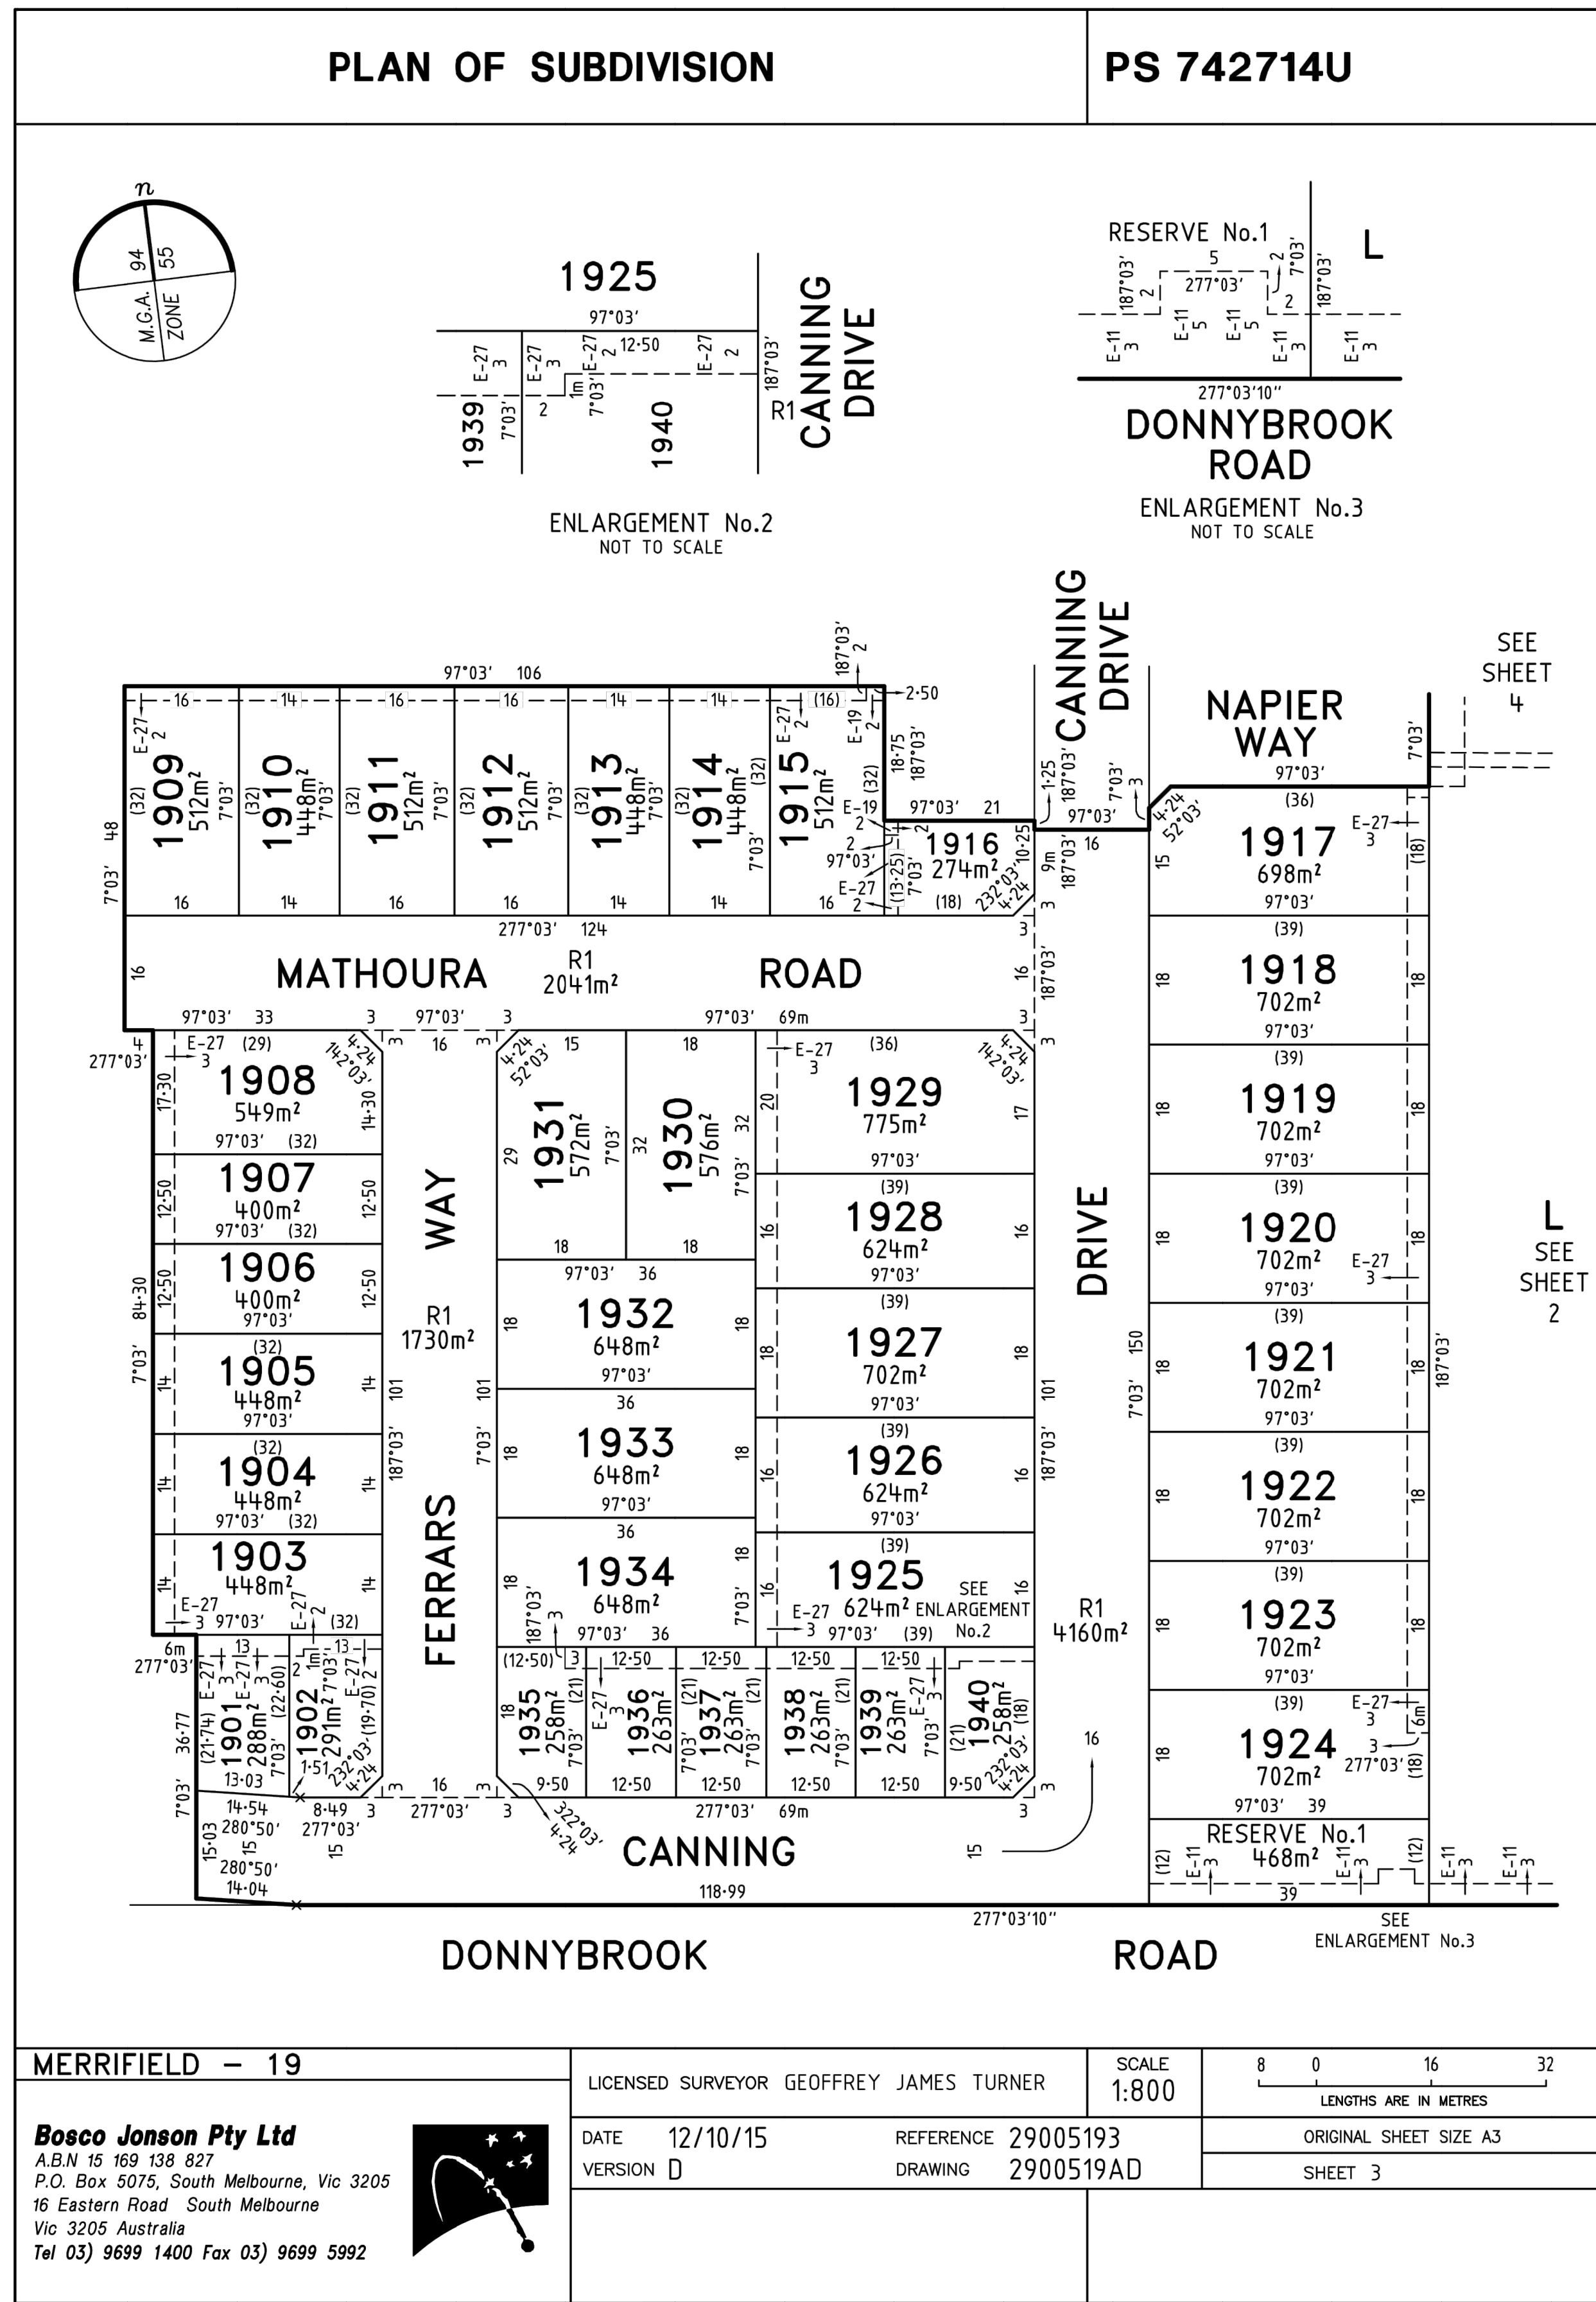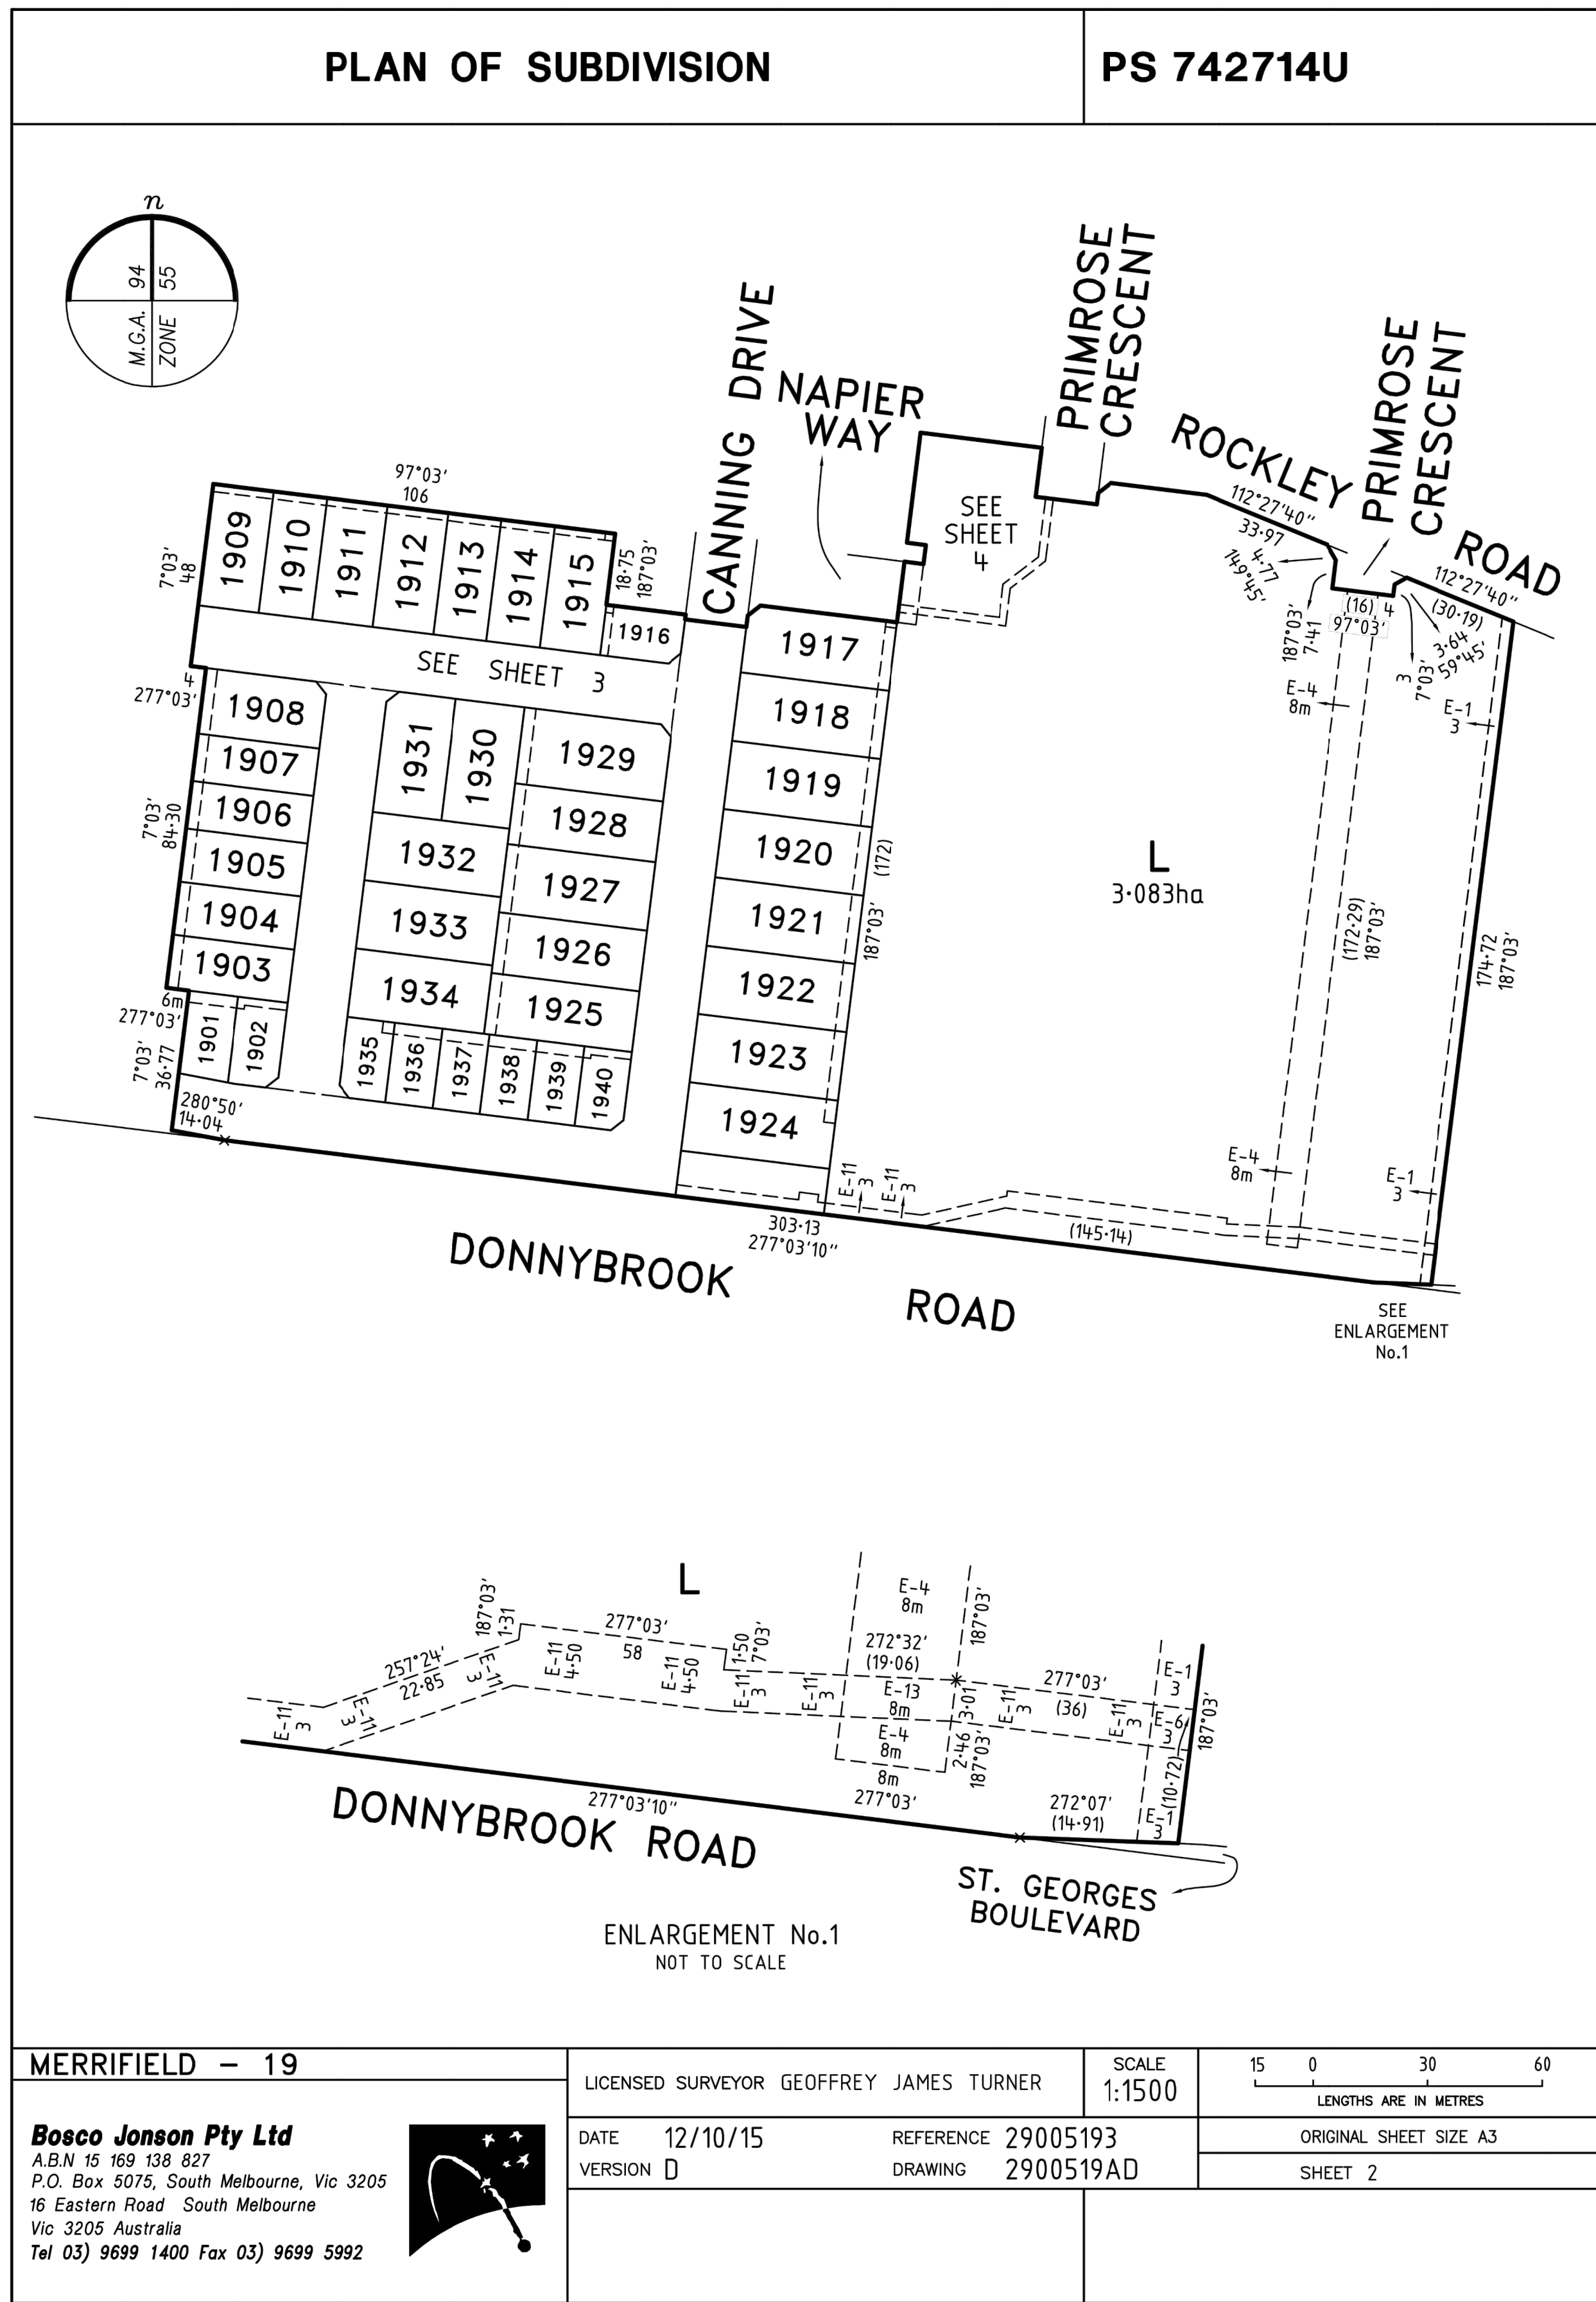

|     |                    |          |        |
|-----|--------------------|----------|--------|
| 1   | AS CONSTRUCTED     | 08/09/16 | TL     |
| 0   | CONSTRUCTION ISSUE | 03/02/16 | TL     |
| REV | AMENDMENTS         | DATE     | APP'D. |


Drawn M.CAPALDO  
Date 04/09/15  
AN 1451046  
Designed N.MIRATANA  
Date 24/06/15  
AN 1541370  
Verified B.GORDON  
Date 14/09/15  
AN 162534  
Audited T.OBOUHOFF  
Date 31/01/16  
AN 912889  
Approved T.LIAKOPOULOS  
Date 03/02/16  
AN 885212

AS CONSTRUCTED



Scale @ A1/A3

**MERRIFIELD DEVELOPMENT**  
**DONNYBROOK ROAD, MICKLEHAM**  
**STAGE 19**  
**PLAN OF SUBDIVISION**  
**SHEET 01 OF 02**  
**Drawing No. 11739POS01 Rev 1**  
Sheet No. 20 **AS CONSTRUCTED**  
© Dalton Consulting Engineers Pty Ltd  
ABN 78 429 221 049

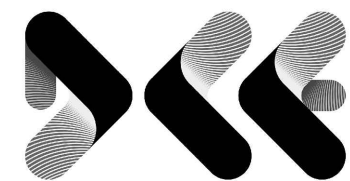


VICTORIA  
T 61 3 9813 7400  
W dceng.com.au

**DALTON CONSULTING ENGINEERS**

ABN 78 429 221 049  
QUEENSLAND  
T 61 7 3374 9000  
E info@dceng.com.au



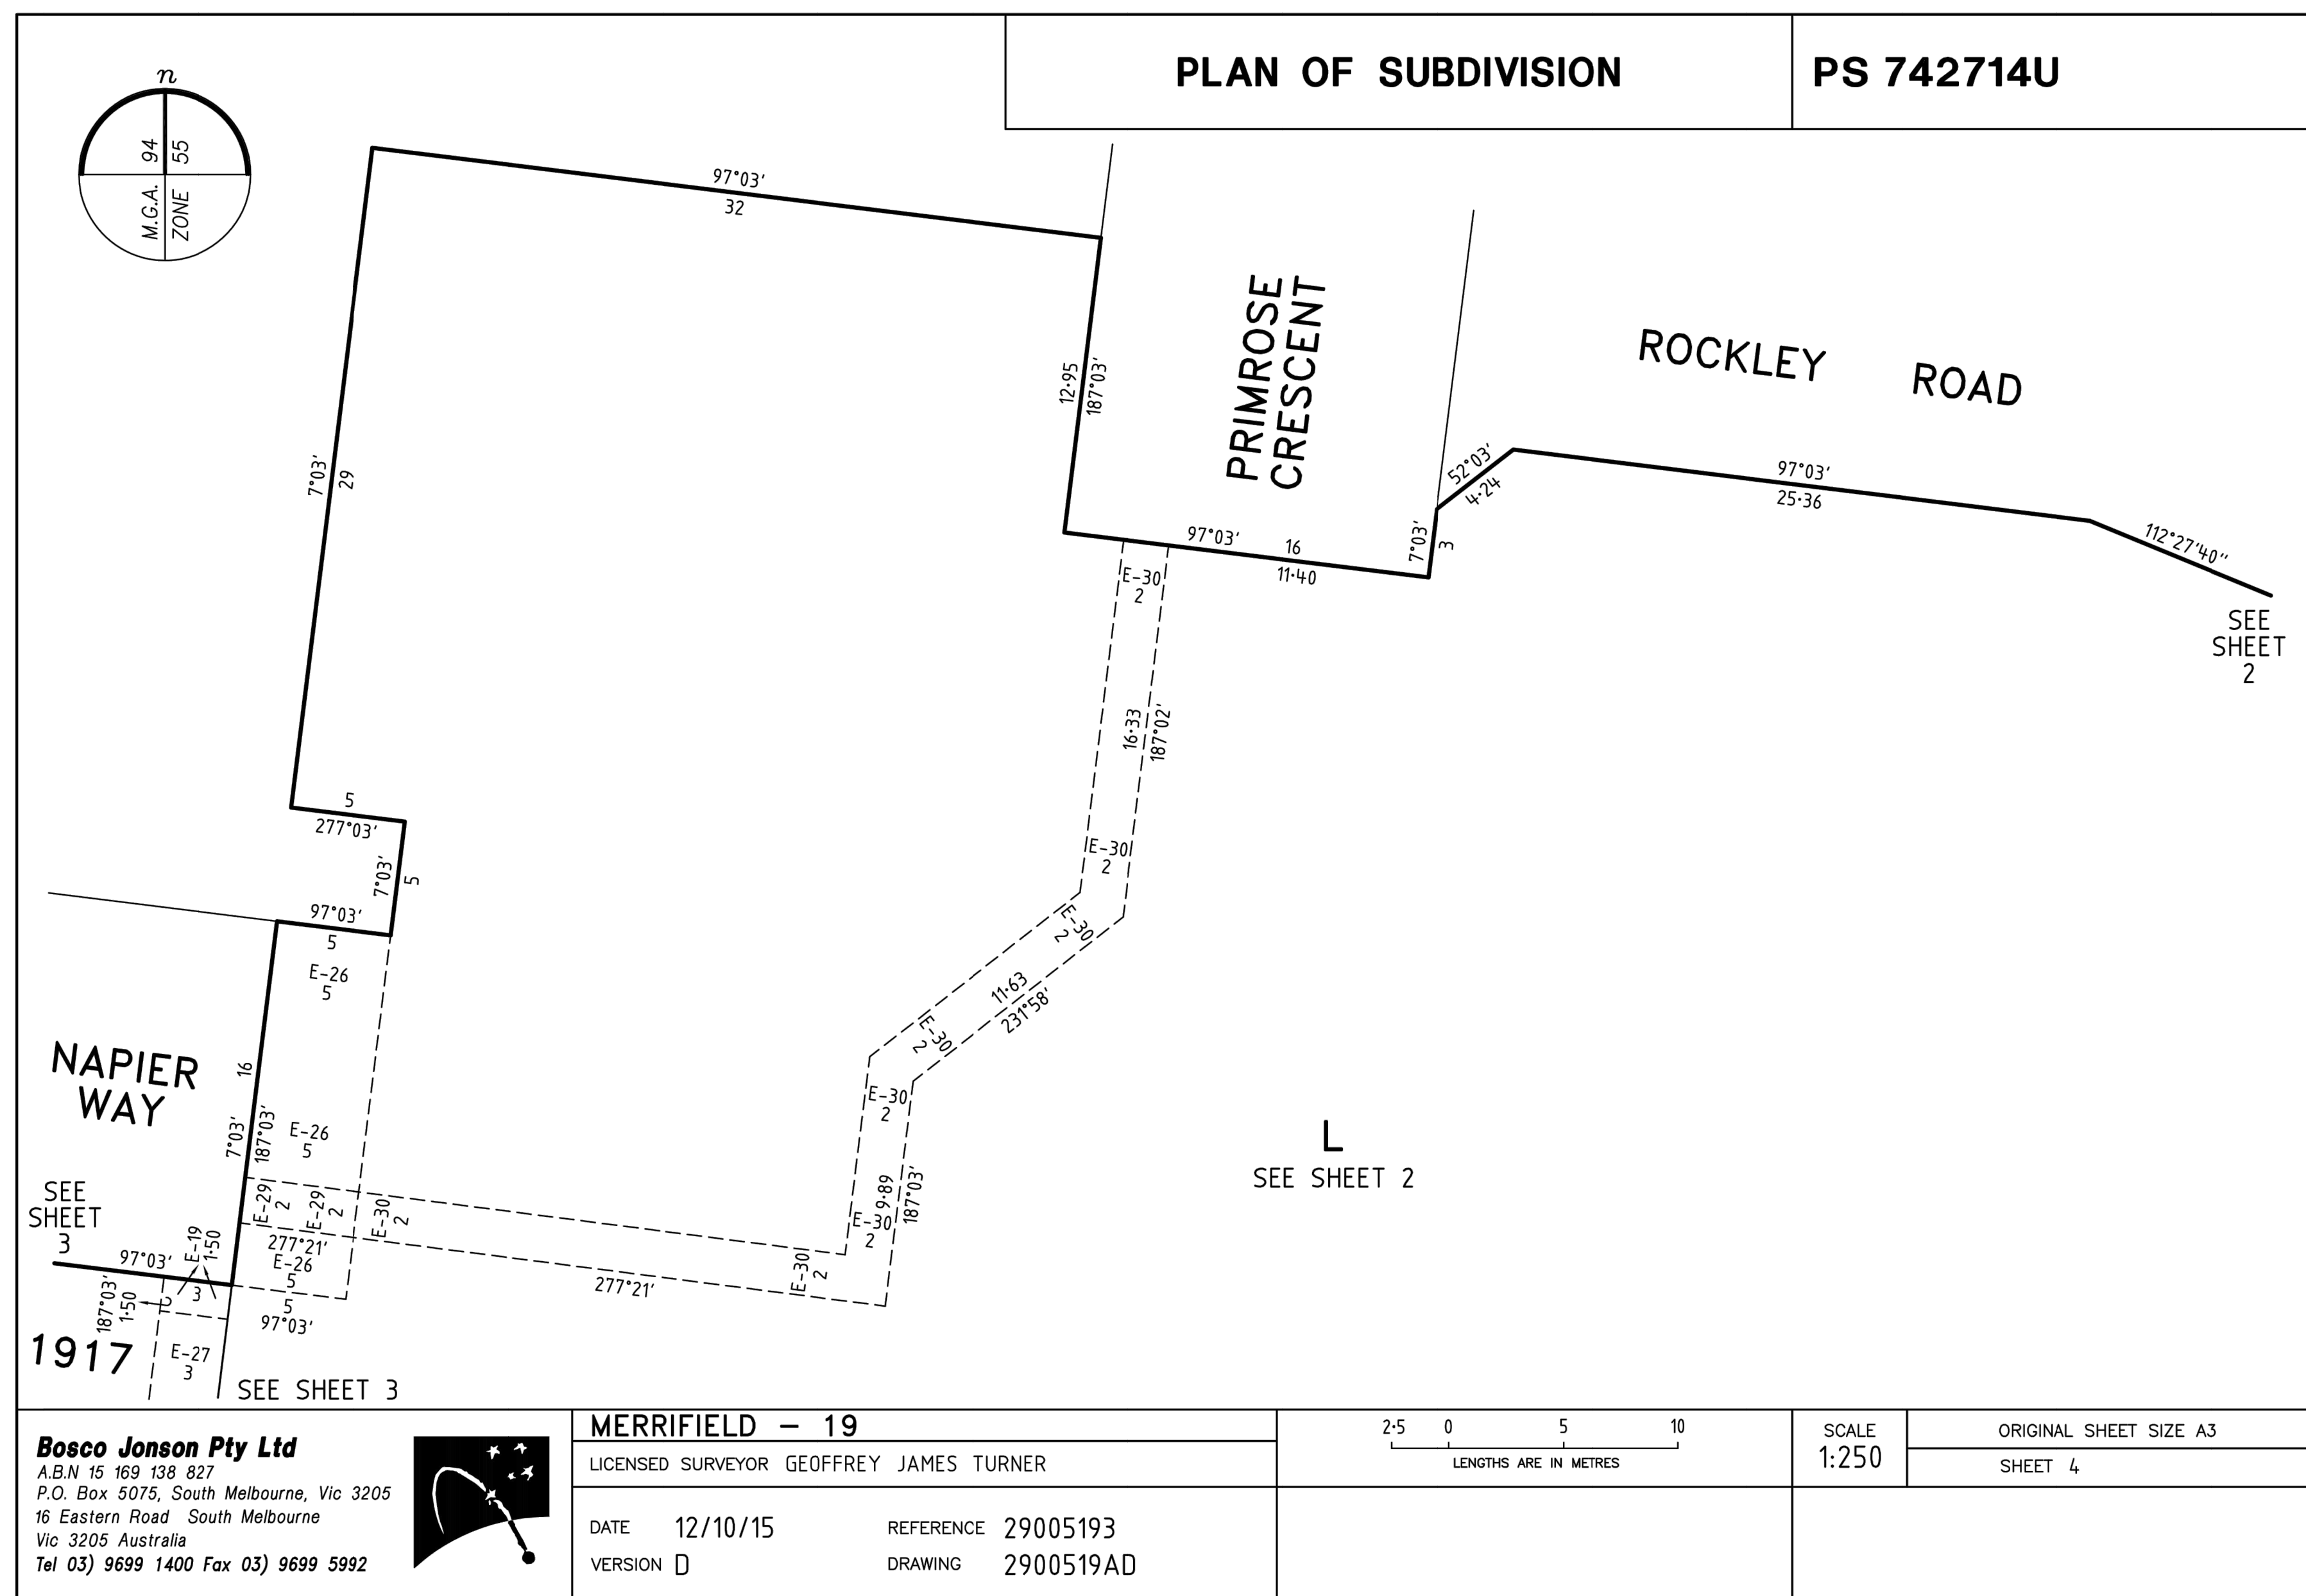

|     |                    |          |        |
|-----|--------------------|----------|--------|
|     |                    |          |        |
| 1   | AS CONSTRUCTED     | 08/09/16 | TL     |
| 0   | CONSTRUCTION ISSUE | 03/02/16 | TL     |
| REV | AMENDMENTS         | DATE     | APP'D. |

Written dimensions to take precedence over scale. Contractor shall check and verify all dimensions on site, Discrepancies to be brought to the attention of the Superintendent.

**merrifield**

**MAB** **GPC**

Coords: MGA  
Levels: AHD

Scale @ A1/A3



**DALTON  
CONSULTING  
ENGINEERS**


ABN 78 429 221 049

**VICTORIA**  
T 61 3 9813 7400  
W [dceng.com.au](http://dceng.com.au)

**QUEENSLAND**  
T 61 7 7374 9000  
E [info@dceng.com.au](mailto:info@dceng.com.au)



Drawing File: G:\Design\11739-MERRIFIELD - Prelim 1 - Stage 19\Acad\10\11739FP01.dwg - 11739FP01  
Date/Time: Thu, Sep 08, 2016 - 4:55pm - Byron Ashde

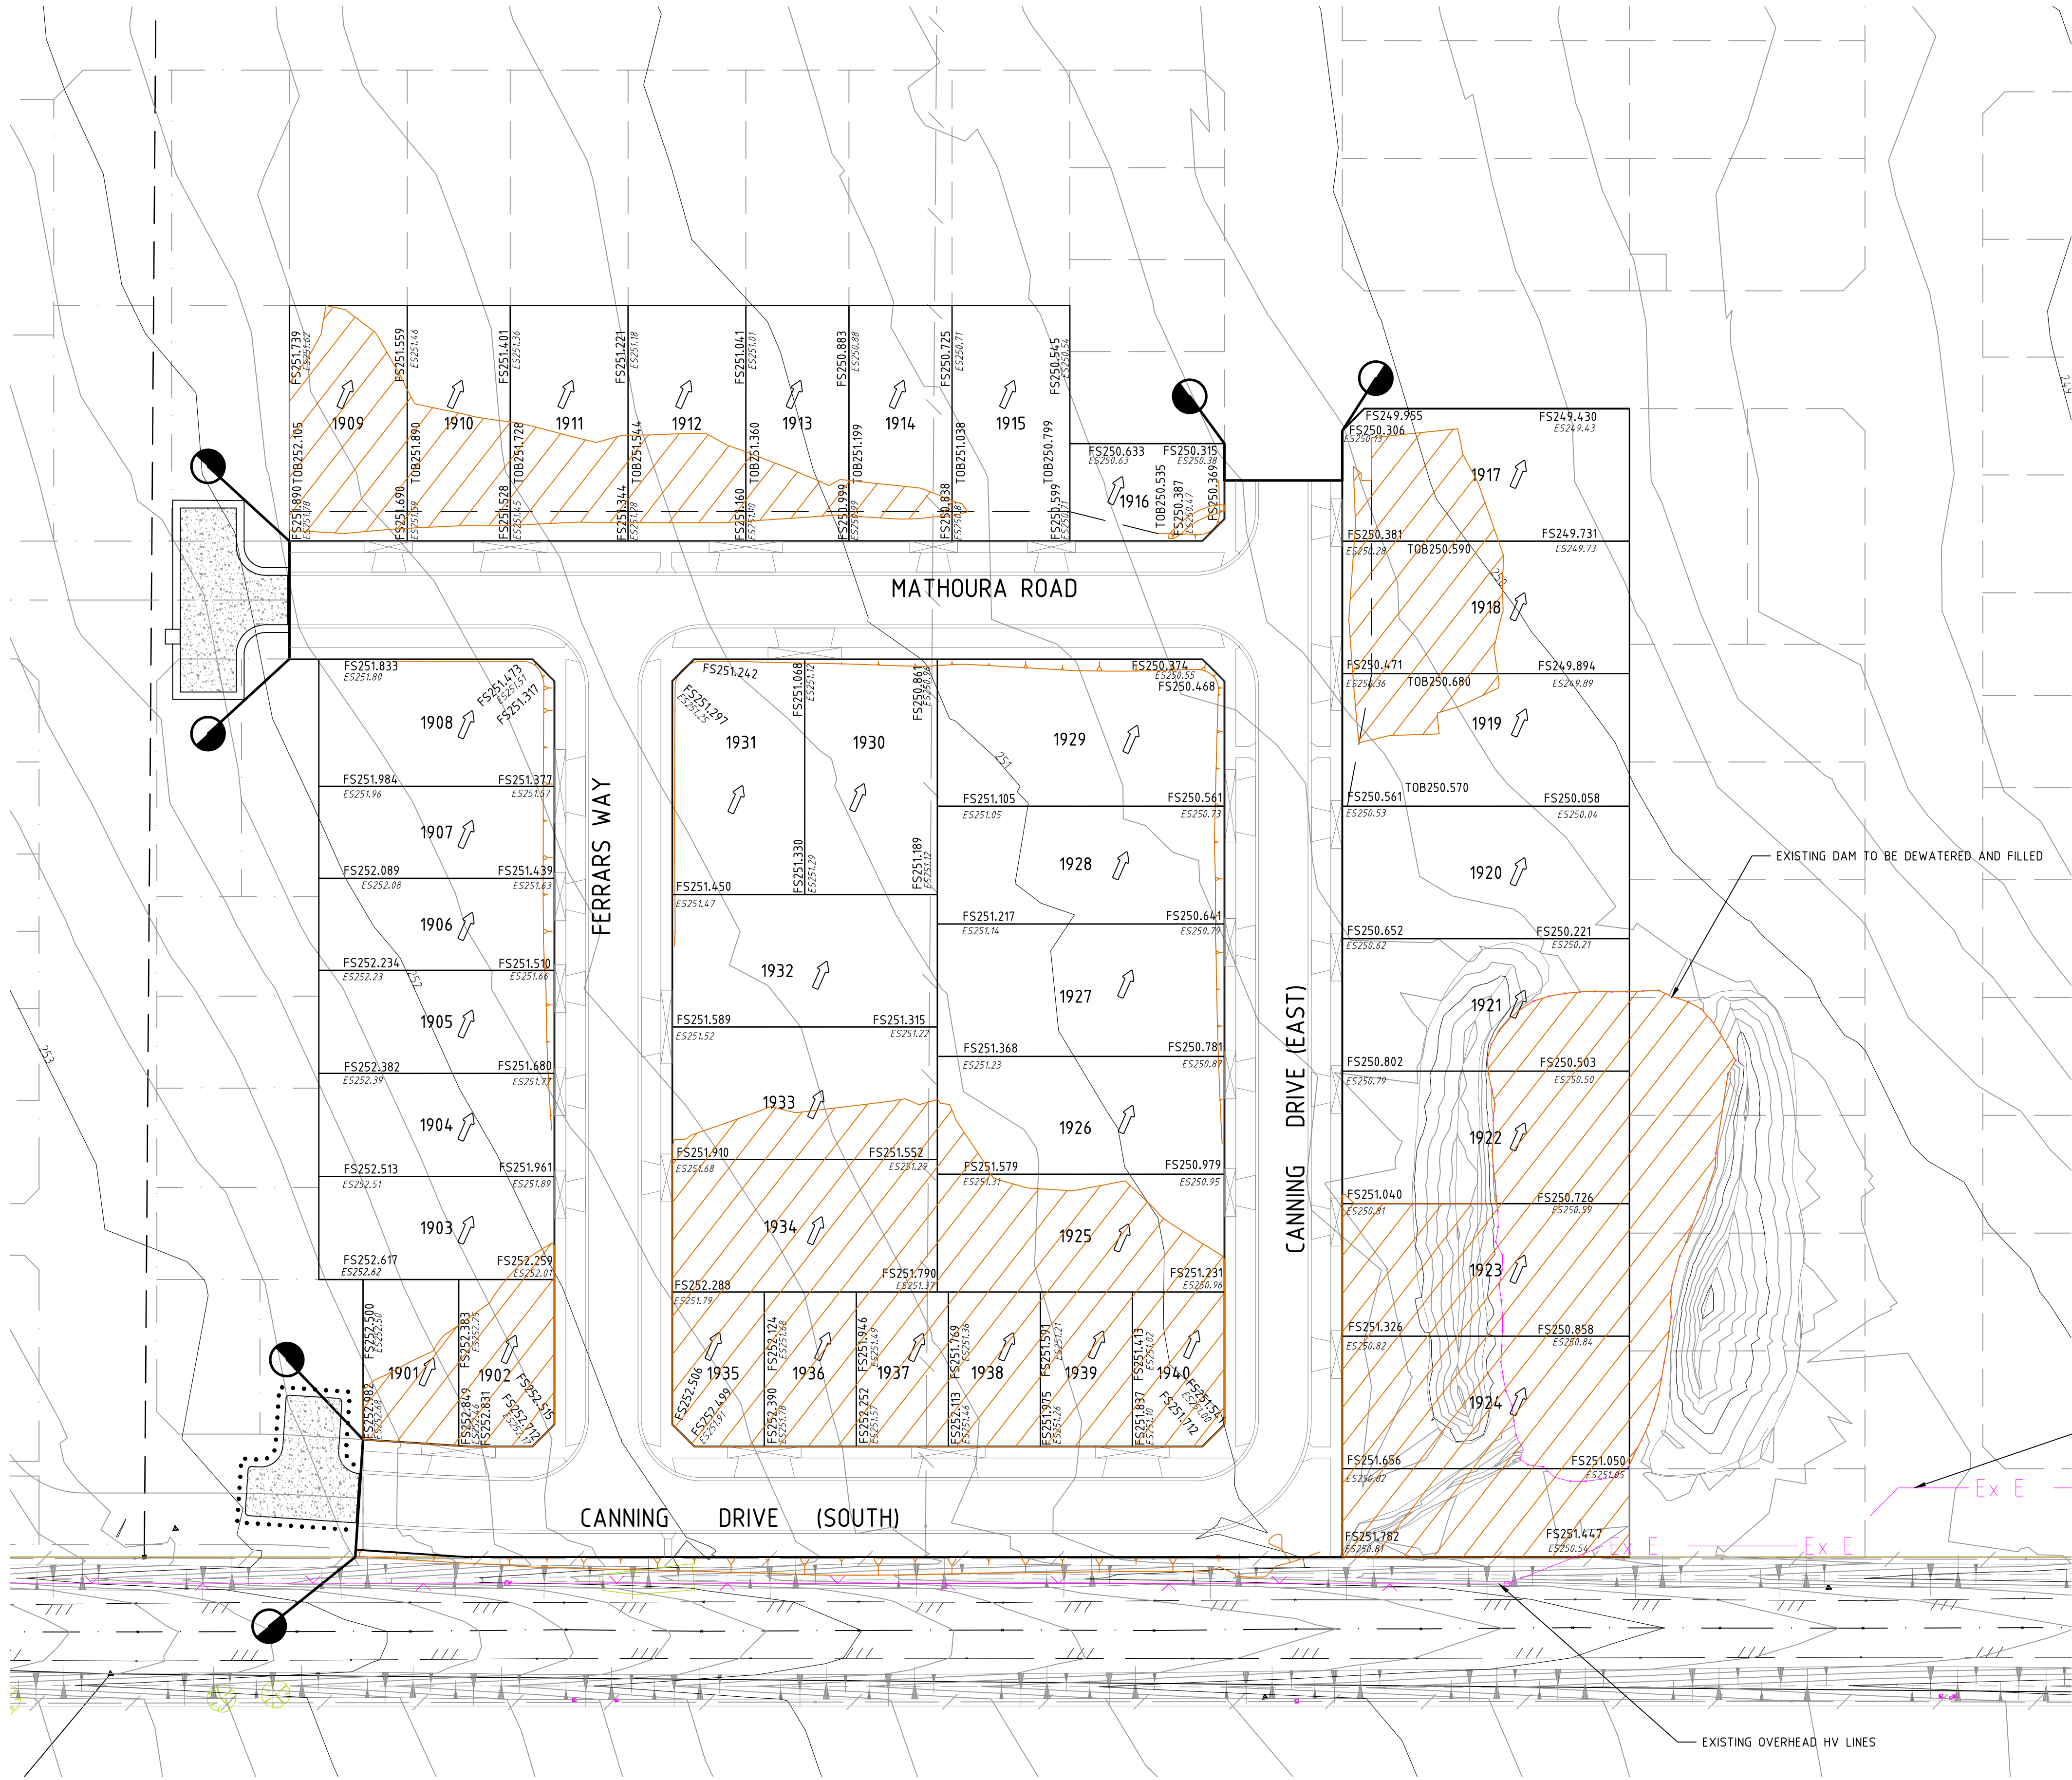

FILL PLAN NOTES

THIS PLAN SHOWS DETAILS OF WORKS AFFECTING THE NATURAL SURFACE OF THE LAND WITHIN THE SUBDIVISION WHICH HAVE BEEN CARRIED OUT OR ARE PROPOSED TO BE CARRIED OUT PRIOR TO REGISTRATION OF THE PLAN OF SUBDIVISION, BEING FILL PLACED ON THE LAND TO THE EXTENT AND DEPTH SHOWN ON THIS PLAN.

THIS PLAN DOES NOT SHOW ANY OTHER FILL WHICH MAY HAVE BEEN PLACED ON THE LAND PRIOR TO THE CIVIL WORKS BEING UNDERTAKEN.

THIS PLAN HAS BEEN PREPARED FOR THE PURPOSE OF CONSTRUCTING SUBDIVISIONAL WORKS AND IS NOT A RECORD OF 'AS BUILT DETAILS'.

FILLING SHOWN LESS THAN 200mm DEEP IS GRADED OR SPREAD OVER ALLOTMENTS TO CORRECT MINOR SURFACE IRREGULARITIES SUCH AS FURROWS ETC AND LOT GRADING.

IRRESPECTIVE OF THE DEPTH OF FILLING FOUNDATIONS MUST BE DESIGNED AND CONSTRUCTED IN ACCORDANCE WITH A SOIL CLASSIFICATION AND REPORT PREPARED FOR THE PURPOSE AND IN ACCORDANCE WITH THE APPROPRIATE BUILDING REGULATIONS.

THE AREA MARKED THUS  ON THIS PLAN INDICATES FILL DEEPER THAN 200mm PLACED ON ALLOTMENTS.

THE EXTENT OF AND DEPTH OF FILL MUST BE CONFIRMED BY A PROPER GEOTECHNICAL INVESTIGATION BY AN EXPERIENCED PRACTITIONER.

NOTES:


- ALL EXCESS CUT MATERIAL IS BE STOCKPILED ONSITE IN DESIGNATED STOCKPILE AREA 'SP3' AS SHOWN ON DWG NO.11720GP01
- PRINCIPAL CONTRACTOR TO ENSURE ALL RELEVANT PERSONAL INCLUDING SUB-CONTRACTORS ARE INDUCTED INTO THE REQUIREMENTS OF THIS PLAN.
- IF ANY MATERIAL IS TO BE TAKEN OFFSITE, IT MUST BE TAKEN TO A LEGAL DISPOSAL SITE. SUPERINTENDENT AND HUME COUNCIL MUST BE NOTIFIED IN WRITING OF DISPOSAL SITES PRIOR TO MATERIAL LEAVING THE SITE.
- THE DEFINITION OF FILL FOR THE PURPOSE OF THIS PLAN INCLUDES ANY SOIL, ROCK, SUBSTRATE CLAY, SAND OR OTHER NATURAL GENERATED THROUGH THE EXCAVATION OF THE SITE.

| 1   | AS CONSTRUCTED     | 08/09/16 | TL     |
|-----|--------------------|----------|--------|
| 0   | CONSTRUCTION ISSUE | 03/02/16 | TL     |
| REV | AMENDMENTS         | DATE     | APP'D. |

Drawn M.CAPALDO  
Date 04/09/15  
AN 1451046  
Designed N.MIRATANA  
Date 24/06/15  
AN 1541366  
Verified B.GORDON  
Date 14/09/15  
AN 162536  
Audited T.OBOUHOFF  
Date 31/01/16  
AN 912891  
Approved T.LIAKOPOULOS  
Date 03/02/16  
AN 885214

Written dimensions to take precedence over scale. Contractor shall check and verify all dimensions on site. Discrepancies to be brought to the attention of the Superintendent.

AS CONSTRUCTED

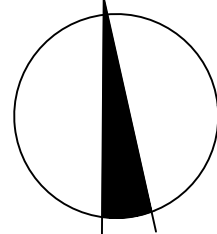

merrifield  
MAB gpc

Coords: MGA  
Levels: AHD

Hor 1:500 0m 5m 10m 20m 30m

Scale @ A1/A3 1:500/1:1000

MERRIFIELD DEVELOPMENT  
DANNYBROOK ROAD, MICKLEHAM  
STAGE 19  
FILL PLAN

Drawing No. 11739FP01 Rev 1  
Sheet No. 22 AS CONSTRUCTED

© Dalton Consulting Engineers Pty Ltd  
ABN 78 429 221 049


DALTON  
CONSULTING  
ENGINEERS

VICTORIA  
T 61 3 9813 7400  
W dceng.com.au

ABN 78 429 221 049  
QUEENSLAND  
T 61 7 3374 9000  
E info@dceng.com.au



Drawing File: G:\Design\1700\1739-MERRIFIELD - Prelim 1 - Stage 19\Acad\DWG\11739EW01.dwg - 11739EW01  
Date/Time: Thu, Sep 08, 2016 - 4:55pm - Byron Ashode

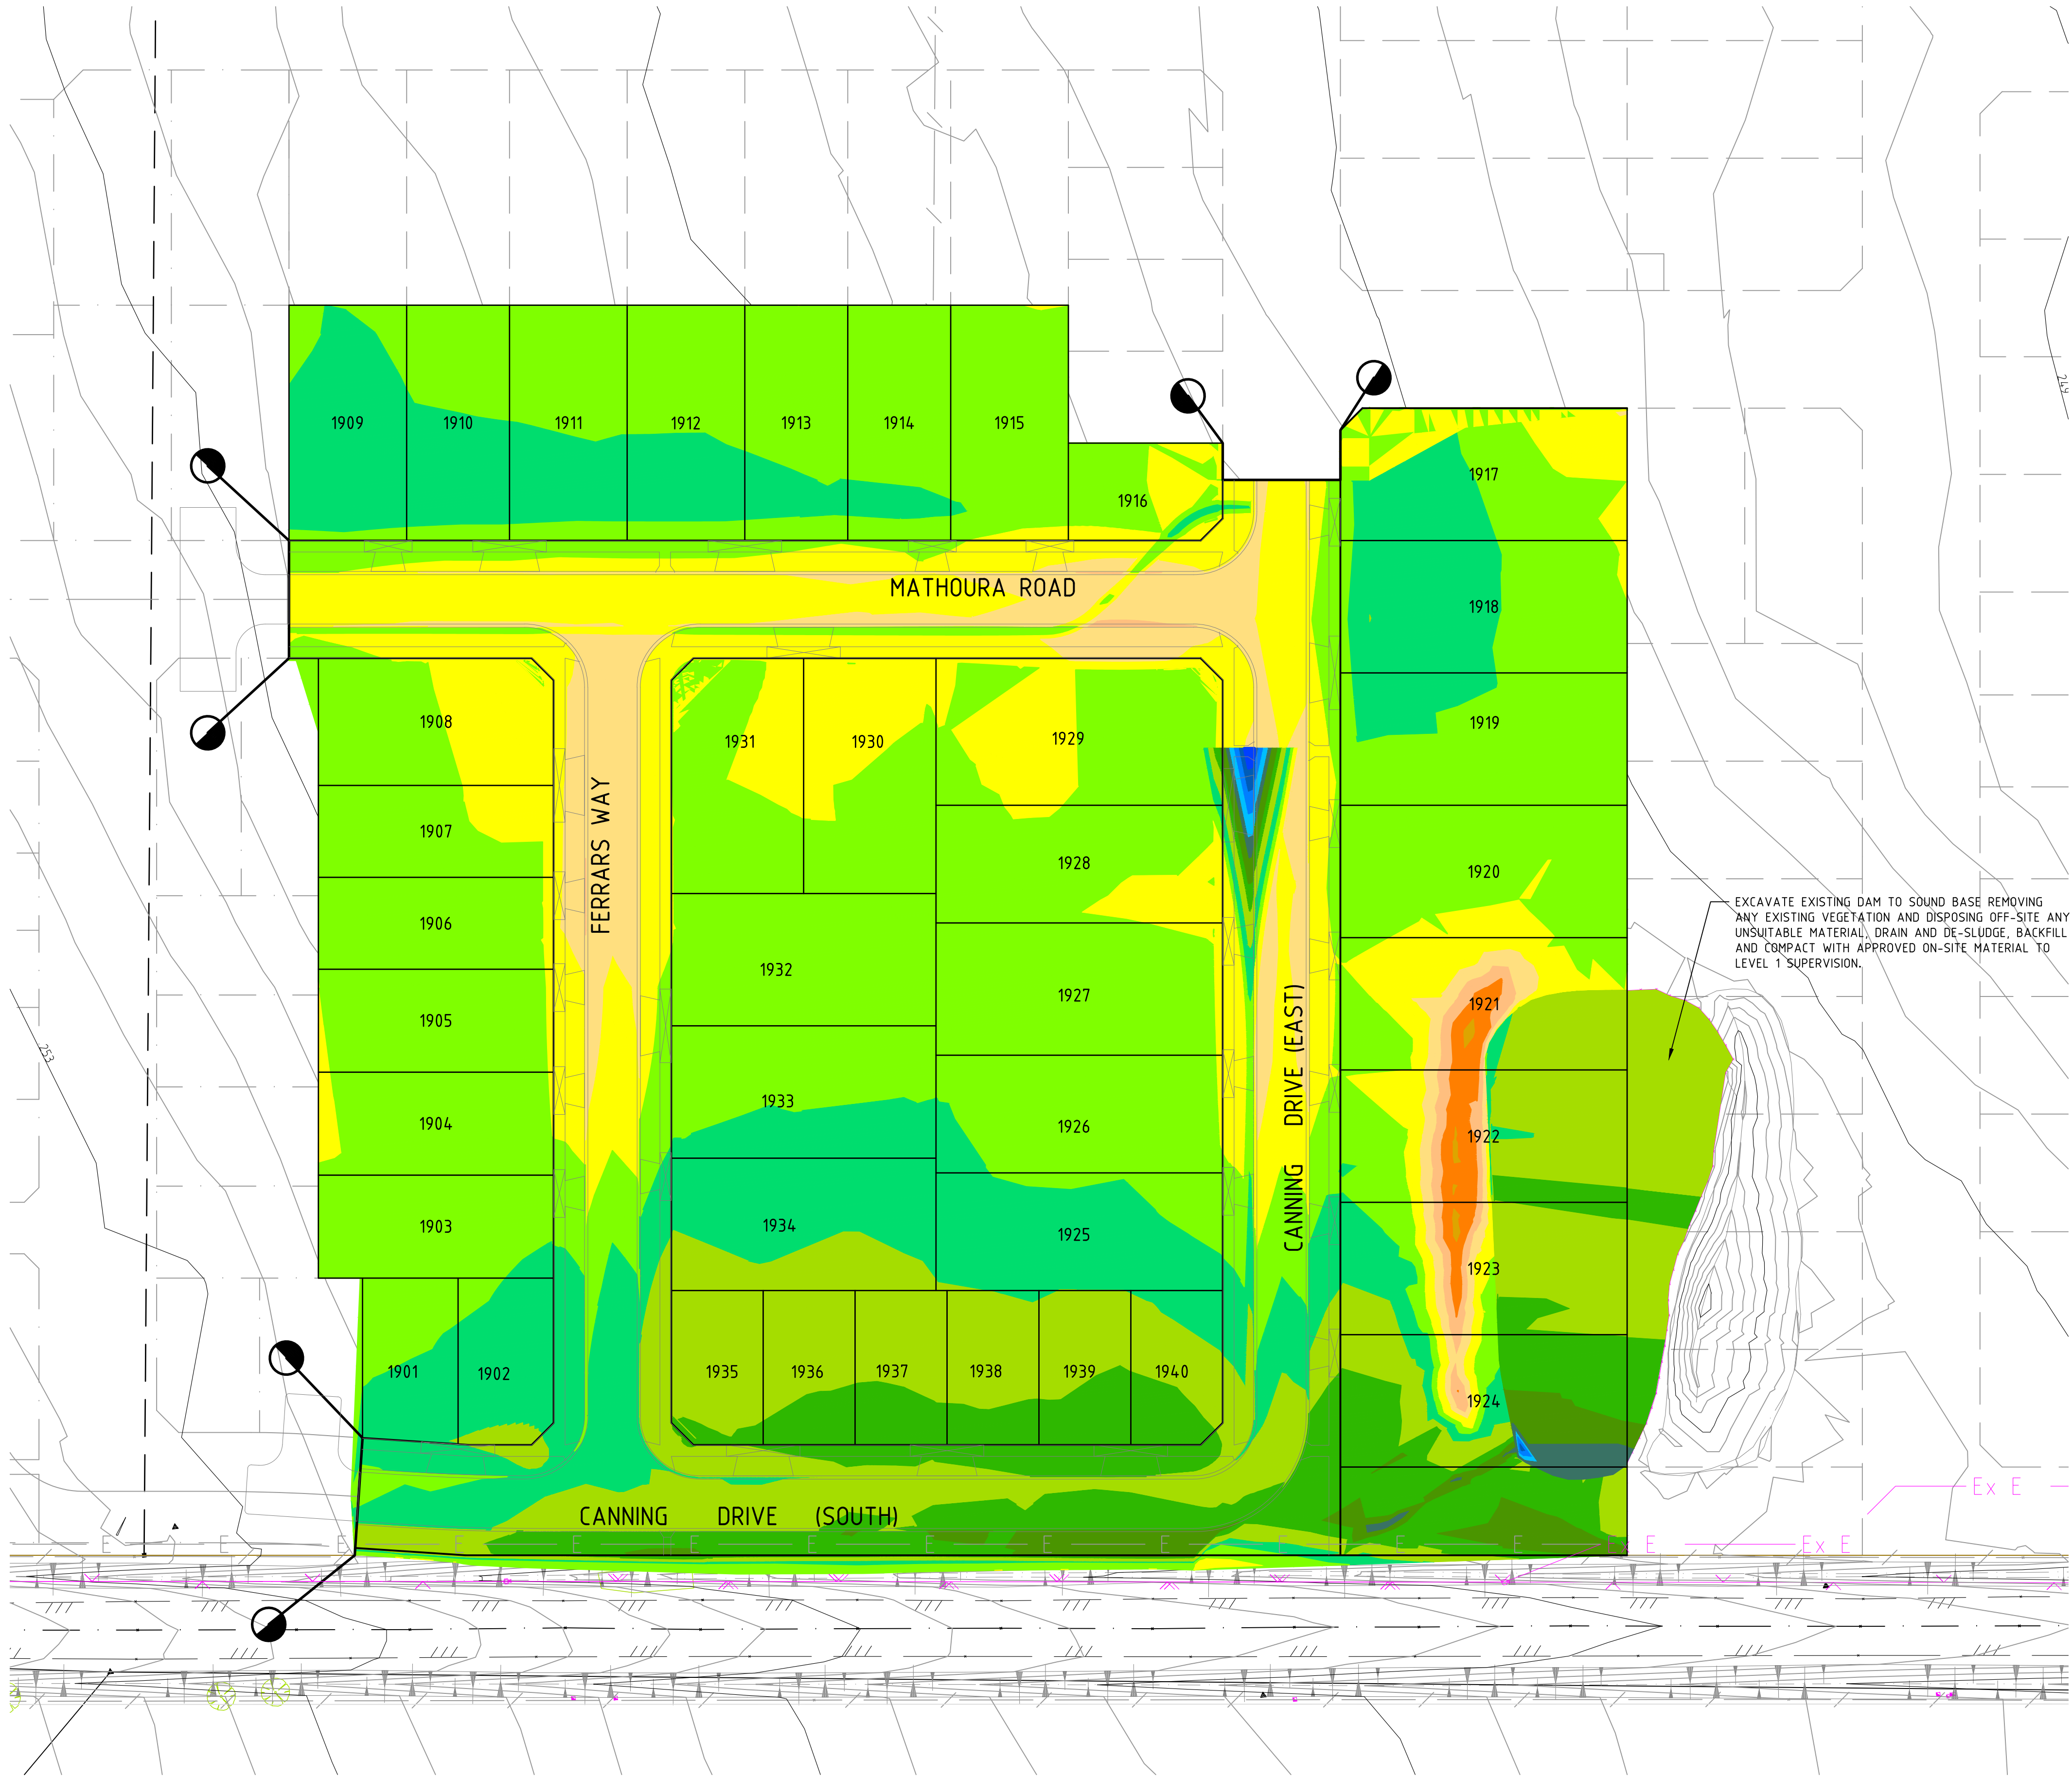

AS CONSTRUCTED

FILL PLAN NOTES

THIS PLAN SHOWS DETAILS OF WORKS AFFECTING THE NATURAL SURFACE OF THE LAND WITHIN THE SUBDIVISION WHICH HAVE BEEN CARRIED OUT OR ARE PROPOSED TO BE CARRIED OUT PRIOR TO REGISTRATION OF THE PLAN OF SUBDIVISION, BEING FILL PLACED ON THE LAND TO THE EXTENT AND DEPTH SHOWN ON THIS PLAN.

THIS PLAN DOES NOT SHOW ANY OTHER FILL WHICH MAY HAVE BEEN PLACED ON THE LAND PRIOR TO THE CIVIL WORKS BEING UNDERTAKEN.

THIS PLAN HAS BEEN PREPARED FOR THE PURPOSE OF CONSTRUCTING SUBDIVISIONAL WORKS AND IS NOT A RECORD OF 'AS BUILT DETAILS'.

FILLING SHOWN LESS THAN 200mm DEEP IS GRADED OR SPREAD OVER ALLOTMENTS TO CORRECT MINOR SURFACE IRREGULARITIES SUCH AS FURROWS ETC AND LOT GRADING.

IRRESPECTIVE OF THE DEPTH OF FILLING FOUNDATIONS MUST BE DESIGNED AND CONSTRUCTED IN ACCORDANCE WITH A SOIL CLASSIFICATION AND REPORT PREPARED FOR THE PURPOSE AND IN ACCORDANCE WITH THE APPROPRIATE BUILDING REGULATIONS.

THE AREA MARKED THUS  ON THIS PLAN INDICATES FILL DEEPER THAN 200mm PLACED ON ALLOTMENTS.

THE EXTENT OF AND DEPTH OF FILL MUST BE CONFIRMED BY A PROPER GEOTECHNICAL INVESTIGATION BY AN EXPERIENCED PRACTITIONER.

NOTES:


- ALL EXCESS CUT MATERIAL IS BE STOCKPILED ONSITE IN DESIGNATED STOCKPILE AREA 'SP3' AS SHOWN ON DWG NO.11720GP01
- PRINCIPAL CONTRACTOR TO ENSURE ALL RELEVANT PERSONAL INCLUDING SUB-CONTRACTORS ARE INDUCTED INTO THE REQUIREMENTS OF THIS PLAN.
- IF ANY MATERIAL IS TO BE TAKEN OFFSITE, IT MUST BE TAKEN TO A LEGAL DISPOSAL SITE. SUPERINTENDENT AND HUME COUNCIL MUST BE NOTIFIED IN WRITING OF DISPOSAL SITES PRIOR TO MATERIAL LEAVING THE SITE.
- THE DEFINITION OF FILL FOR THE PURPOSE OF THIS PLAN INCLUDES ANY SOIL, ROCK, SUBSTRATE CLAY, SAND OR OTHER NATURAL GENERATED THROUGH THE EXCAVATION OF THE SITE.

|     |                    |          |        |
|-----|--------------------|----------|--------|
| 1   | AS CONSTRUCTED     | 08/09/16 | TL     |
| 0   | CONSTRUCTION ISSUE | 03/02/16 | TL     |
| REV | AMENDMENTS         | DATE     | APP'D. |

Drawn M.CAPALDO  
Date 04/09/15  
AN 1451046  
Designed N.MIRATANA  
Date 24/06/15  
AN 1541369  
Verified B.GORDON  
Date 14/09/15  
AN 162537  
Audited T.OBOUHOFF  
Date 31/01/16  
AN 912892  
Approved T.LIAKOPOULOS  
Date 03/02/16  
AN 885215

Written dimensions to take precedence over scale. Contractor shall check and verify all dimensions on site. Discrepancies to be brought to the attention of the Superintendent.

| LEGEND |             |  |               |  |               |  |             |  |           |  |  |
|--------|-------------|--|---------------|--|---------------|--|-------------|--|-----------|--|--|
|        | -100 TO -6m |  | -1.8 TO -1.6m |  | -0.6 TO -0.4m |  | 0.6 TO 0.8m |  | 1.8 TO 2m |  |  |
|        | -6 TO -5m   |  | -1.6 TO -1.4m |  | -0.4 TO -0.2m |  | 0.8 TO 1.0m |  | 2 TO 3m   |  |  |
|        | -5 TO -4m   |  | -1.4 TO -1.2m |  | -0.2 TO 0.0m  |  | 1.0 TO 1.2m |  | 3 TO 4m   |  |  |
|        | -4 TO -3m   |  | -1.2 TO -1.0m |  | 0.0 TO 0.2m   |  | 1.2 TO 1.4m |  | 4 TO 5m   |  |  |
|        | -3 TO -2m   |  | -1.0 TO -0.8m |  | 0.2 TO 0.4m   |  | 1.4 TO 1.6m |  | 5 TO 6m   |  |  |
|        | -2 TO -1.8m |  | -0.8 TO -0.6m |  | 0.4 TO 0.6m   |  | 1.6 TO 1.8m |  | 6 TO 100m |  |  |

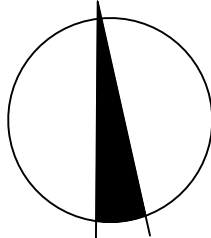

merrifield  
MAB gpc

Coords: MGA  
Levels: AHD

Hor 1:500 0m 5m 10m 20m 30m  
Scale @ A1/A3 1:500/1:1000

MERRIFIELD DEVELOPMENT  
DONNYBROOK ROAD, MICKLEHAM  
STAGE 19  
EARTHWORKS PLAN

Drawing No. 11739EW01 Rev 1  
Sheet No. 23 AS CONSTRUCTED

© Dalton Consulting Engineers Pty Ltd  
ABN 78 429 221 049



VICTORIA  
T 61 3 9813 7400  
W dceng.com.au

QUEENSLAND  
T 61 7 3374 9000  
E info@dceng.com.au

ABN 78 429 221 049



