

MERRIFIELD DEVELOPMENT

STAGE 2

DONNYBROOK ROAD, MICKLEHAM

HUME CITY COUNCIL

FOR

merrifield



CIVIL DRAWINGS

ROAD AND DRAINAGE

DCE REFERENCE

11722

AS CONSTRUCTED






dalton consulting engineers

255 Whitehorse Road PO Box 349 Balwyn Victoria 3103 Australia T 61 3 9888 6866 F 61 3 9888 6880 W www.dceprofile.com	Suite 17 46 Douglas Street PO Box 1178 Milton QLD 4064 Australia T 61 7 3367 1732 E info@dceprofile.com
--	---

GENERAL NOTES

1. ALL LEVELS ARE TO AUSTRALIAN HEIGHT DATUM AND ALL COORDINATES ARE TO MAP GRID OF AUSTRALIA (MGA) ZONE 55.
2. ALL WORKS TO BE CARRIED OUT IN ACCORDANCE WITH AS4000 AMENDED GENERAL CONDITIONS OF CONTRACT, THE ROAD & DRAINAGE SPECIFICATION, APPROVED HUME CITY COUNCIL SPECIFICATION AND STANDARD DRAWINGS, AND TO THE SATISFACTION OF THE SUPERINTENDENT AND THE CITY ENGINEER OR HIS REPRESENTATIVE.
3. A PRE-COMMENCEMENT MEETING WITH COUNCIL IS TO BE ARRANGED PRIOR TO COMMENCEMENT OF THE WORKS.
4. ALL SERVICE AUTHORITIES SHALL BE NOTIFIED IN WRITING SEVEN DAYS PRIOR TO COMMENCEMENT OF THE WORKS.
5. TBMS TO BE RE-ESTABLISHED BY THE LICENSED SURVEYOR IF FOUND TO BE MISSING AT THE COMMENCEMENT OF CONSTRUCTION. THE CONTRACTOR WILL BE RESPONSIBLE FOR CARE AND MAINTENANCE OF TBMS THEREAFTER.
6. ALL EXISTING SURFACE LEVELS SHOWN ON THE ENGINEERING DRAWINGS HAVE BEEN INTERPOLATED FROM A DIGITAL TERRAIN MODEL. THESE LEVELS HAVE BEEN USED AS THE BASIS FOR ALL ENGINEERING DESIGN AND DETERMINATION OF QUANTITIES.
7. THE CONTRACTOR IS REQUIRED TO CONFINE CONSTRUCTION VEHICLES TO THE ROAD RESERVE AND EASEMENTS. ANY DAMAGE CAUSED TO ALLOTMENTS MUST BE MADE GOOD.
8. ANY BUILDINGS, TROUGHS, FENCES AND OTHER STRUCTURES ON SITE ARE TO BE REMOVED AS DIRECTED BY THE ENGINEER. THE COST OF REMOVAL IS TO BE INCLUDED IN THE OVERALL EARTHWORKS FIGURE UNLESS A SPECIFIC ITEM FOR REMOVAL IS DENOTED IN THE SCHEDULE.
9. FILL AREAS IN EXCESS OF 300mm ARE TO BE STRIPPED OF TOPSOIL, FILLED, AND TOPSOIL REPLACED TO OBTAIN THE FINAL FILL LEVELS SHOWN ON THE DRAWINGS. ALL FILLING MUST ENSURE LEVEL 1 GEOTECHNICAL SUPERVISION IS MAINTAINED AS PER CLAUSE 8.2 OF AS3798 "GUIDELINES ON EARTHWORKS FOR COMMERCIAL AND RESIDENTIAL DEVELOPMENTS". STRUCTURAL FILLING MATERIAL IS TO BE IN ACCORDANCE WITH THE SPECIFICATIONS.
10. NO FILL OR STOCKPILING OF MATERIAL IS TO BE PLACED ON ANY RESERVE OR COMMON PROPERTY UNLESS OTHERWISE DIRECTED BY THE ENGINEER. NO TOPSOIL IS TO BE REMOVED FROM SITE. SURPLUS SOIL MUST BE MADE AVAILABLE FOR LOTS AND RESERVES.
11. WHERE PAVEMENT IS CONSTRUCTED ON FILL, FILL MATERIAL IS TO BE APPROVED BY THE SUPERINTENDENT AND COUNCIL AND CONSTRUCTED IN LAYERS 150mm THICK WITH COMPACTION IN ACCORDANCE WITH AS3798. PRIOR TO THE PLACEMENT OF THE FILL MATERIAL UNDER NEW PAVEMENTS, APPROVAL OF THE MATERIAL TO BE USED MUST BE OBTAINED FROM COUNCIL.
12. WHEN PAVEMENT EXCAVATION IS IN ROCK ALL LOOSE MATERIAL INCLUDING ROCKS AND CLAY) MUST BE REMOVED. THE SUB-GRADE MUST THEN BE REGULATED WITH COUNCIL APPROVED MATERIAL.
13. AT LEAST 3 DAYS BEFORE COMMENCING EXCAVATION OF TRENCHES IN EXCESS OF 1.5m DEPTH, A COMPLETED "NOTICE OF INTENTION TO COMMENCE TRENCHING OPERATIONS" FORM SHALL BE SENT TO WORKSAFE VICTORIA. THE NOMINATED SUPERVISOR SHALL BE SUITABLY QUALIFIED IN ACCORDANCE WITH VICTORIAN OHS ACT 1985 & COMMONWEALTH OHS CODE OF PRACTICE 2008.
14. NO BLASTING TO BE CARRIED OUT WITHIN 20 METRES OF EXISTING SERVICES.
15. ALL TREES AND SHRUBS ARE TO BE RETAINED UNLESS OTHERWISE SHOWN. IF ROAD AND DRAINAGE CONSTRUCTION NECESSITATES THEIR REMOVAL, WRITTEN PERMISSION MUST BE OBTAINED FROM THE ENGINEER.
16. ALL DISTURBED SURFACES SHOULD BE OVER EXCAVATED BY 150mm, TOP SOILED WITH MINIMUM 150mm OF LOCAL TOP SOIL AND BITUMEN STRAW HYDROSEED.
17. ALL BLOCKS ARE TO SURFACE GRADE WITH A MINIMUM FALL OF 1 IN 150 ALONG THE LOW SIDE BOUNDARY TO THE POINT OF DISCHARGE.
18. ALL BATTERS SHALL BE 1 IN 6, UNLESS OTHERWISE SHOWN.
19. ALL CHAINAGES REFER TO ROAD RESERVE DESIGN LINES EXCEPT:
- IN COURT HEADS WHERE CHAINAGES REFER TO LIP OF KERB
- KERB RETURNS WHERE CHAINAGES REFER TO LIP OF KERB.
20. GENERALLY B2 KERB AND CHANNEL IS TO BE USED THROUGHOUT THE SUBDIVISION. WHERE OTHER KERB TYPES ARE REQUIRED THEY ARE SPECIFICALLY SHOWN ON THE DRAWINGS.
21. LIP OF ALL KERB RADI ARE 8.60m UNLESS OTHERWISE SHOWN.
22. FOOTPATHS TO BE OFFSET 50mm FROM THE TITLE BOUNDARIES. FOOTPATHS IN ACCORDANCE WITH GAA FIGURE 006 UNLESS NOTED OTHERWISE.
23. VEHICULAR CROSSINGS OF THE TYPE INDICATED ARE TO BE OFFSET 1.5m FROM THE LOT BOUNDARY OR EASEMENT UNLESS OTHERWISE SHOWN. DRIVEWAY GRADES TO BE 1 IN 6 MAX.
24. PROVIDE LAYBACKS IN KERB TO ALL PRAM CROSSINGS IN ACCORDANCE WITH COUNCIL STANDARDS. ASPHALT FILLETS/RAMPS ARE TO BE PROVIDED ON THE BASE COURSE ASPHALT TO REMOVE TRIPS AT ALL PEDESTRIAN CROSSING LOCATIONS.
25. ALL LINE MARKING AND SIGNAGE TO BE INSTALLED IN ACCORDANCE WITH AS 1742-1 AND AS 1742-2, UNLESS SPECIFICALLY SHOWN OTHERWISE. LINEMARKING IS TO BE INSTALLED USING EXTRUDED LONG LIFE THERMOPLASTIC PAINT. STREET SIGNS ARE REQUIRED TO SHOW STREET NUMBERS APPLICABLE TO EACH BLOCK. ALL TEMPORARY WARNING SIGNS USED DURING CONSTRUCTION SHALL BE IN ACCORDANCE WITH AS 1742-3.
26. THE LOCATION OF EXISTING SERVICES SHOWN ON THESE PLANS SHALL BE PROVEN ON SITE. THE APPROPRIATE AUTHORITY SHALL BE CONTACTED AND THE SERVICES LOCATED PRIOR TO COMMENCEMENT OF CONSTRUCTION.
27. ALL EASEMENTS ARE 2.0m OR 3.0m WIDE DRAINAGE AND SEWERAGE EASEMENTS UNLESS OTHERWISE SHOWN.
28. CENTRELINES OF ALL SEWERS ARE OFFSET 1.2m OR 2.2m FROM THE PROPERTY LINE UNLESS OTHERWISE SHOWN.
29. CENTRELINES OF ALL EASEMENT DRAINS ARE OFFSET 1.0m OR 2.2m FROM THE PROPERTY LINE UNLESS OTHERWISE SHOWN.
30. ALL STORMWATER DRAINS ARE TO BE CLASS '2' RC OR FRC PIPES UNLESS OTHERWISE SHOWN. ALL RC PIPES UP TO AND INCLUDING 750mm IN DIAMETER SHALL BE RUBBER RING JOINTED (RRJ). PIPES ABOVE THIS SIZE MAY BE FLUSH JOINTED WITH EXTERNAL SEALING BANDS. FRC PIPES MAY ONLY BE USED IN EASEMENTS.
31. WHERE CURVED PIPES ARE SHOWN ON THE FACE PLANS THEY ARE TO BE LAID PARALLEL TO THE BACK OF KERB, EXCEPT WHERE A RADIUS HAS BEEN SPECIFICALLY NOMINATED. ALL DRAINS BEHIND KERBS ARE TO BE LAID AT THE OFFSET SPECIFIED IN THE COUNCIL SPECIFICATION. CURVED PIPES OF DIAMETER LESS THAN 600mm ON LARGE RADIUS CURVES ARE APPROVED BY COUNCIL SUBJECT TO COMPLIANCE WITH MANUFACTURER'S SPECIFICATION.
32. ALL SIDE ENTRY PITS EXCEPT THOSE AT LOW POINTS ARE TO HAVE FLUTES AS SPECIFIED IN THE COUNCIL STANDARD DRAWINGS.
33. ALL PIPE AND SERVICE TRENCHES THAT EXTEND UNDER ROADWAYS TO BE BACKFILLED WITH CLASS 2 CRUSHED ROCK. ALL SERVICE TRENCHES UNDER DRIVEWAYS, FOOTPATHS AND PARKING BAYS TO BE BACKFILLED WITH CLASS 2 CRUSHED ROCK. SERVICE TRENCHES LESS THAN 750mm BEHIND PARKING BAYS ARE ALSO TO BE BACKFILLED WITH COMPACTED CLASS 2 CRUSHED ROCK.
34. 100mm NOMINAL DIAMETER P.V.C. CLASS 400 A.G. DRAIN TO BE LAID UNDER ALL KERB & CHANNEL AT THE DEEPER OF 750mm BELOW KERB OR TO THE BOTTOM OF THE SUBBASE LAYER, IN ACCORDANCE WITH GROWTH AREA AUTHORITY FIGURE 20
35. PROPERTY INLETS ARE TO BE PLACED 1.0m FROM LOW CORNERS OF ALLOTMENTS UNLESS OTHERWISE SHOWN.
36. 100mm DIA. HOUSE DRAINS IN STREETS TO BE PLACED 6.0m FROM LOW CORNERS UNLESS OTHERWISE SHOWN.
37. POSITION CONDUITS SO THAT A MINIMUM DISTANCE BETWEEN TAPPINGS IS 1.0m. CONDUITS NOT TO BE LOCATED WITHIN 4.0m OF ALLOTMENT BOUNDARY, UNLESS OTHERWISE SHOWN.
38. WATER TAPPINGS FOR LOTS SITUATED ON THE SAME SIDE AS THE WATERMAIN ARE TO BE LOCATED AT THE CENTRE OF THE LOT. THE KERB IS TO BE MARKED "W" WITH AN ARROW POINTING TO THE TAPPING.
39. GAS TO BE 50mm DIA. CLASS 12 P.V.C. & WATER CONDUITS TO BE 100 DIA. CLASS 12 P.V.C. SINGLE CONDUIT CONTAINING BOTH DW & NDW SERVICES LAID IN ACCORDANCE WITH WSA 03-2002 DUAL WATER SUPPLY SYSTEM STANDARD DRAWING WAT-1806-V
40. ELECTRICITY CONDUITS ARE TO BE LAID WITH THE FOLLOWING MINIMUM COVER TO FINISHED SURFACE LEVELS :
UNDER ROADS - 0.90m
ELSEWHERE - 0.60m
41. TACTILE GROUND SURFACE INDICATORS (TGSI'S) TO BE INSTALLED. TGSI'S ARE TO COMPLY WITH AS1428.4

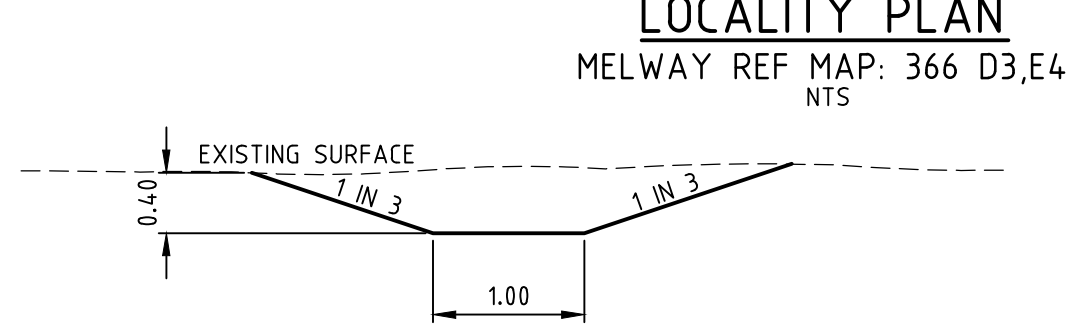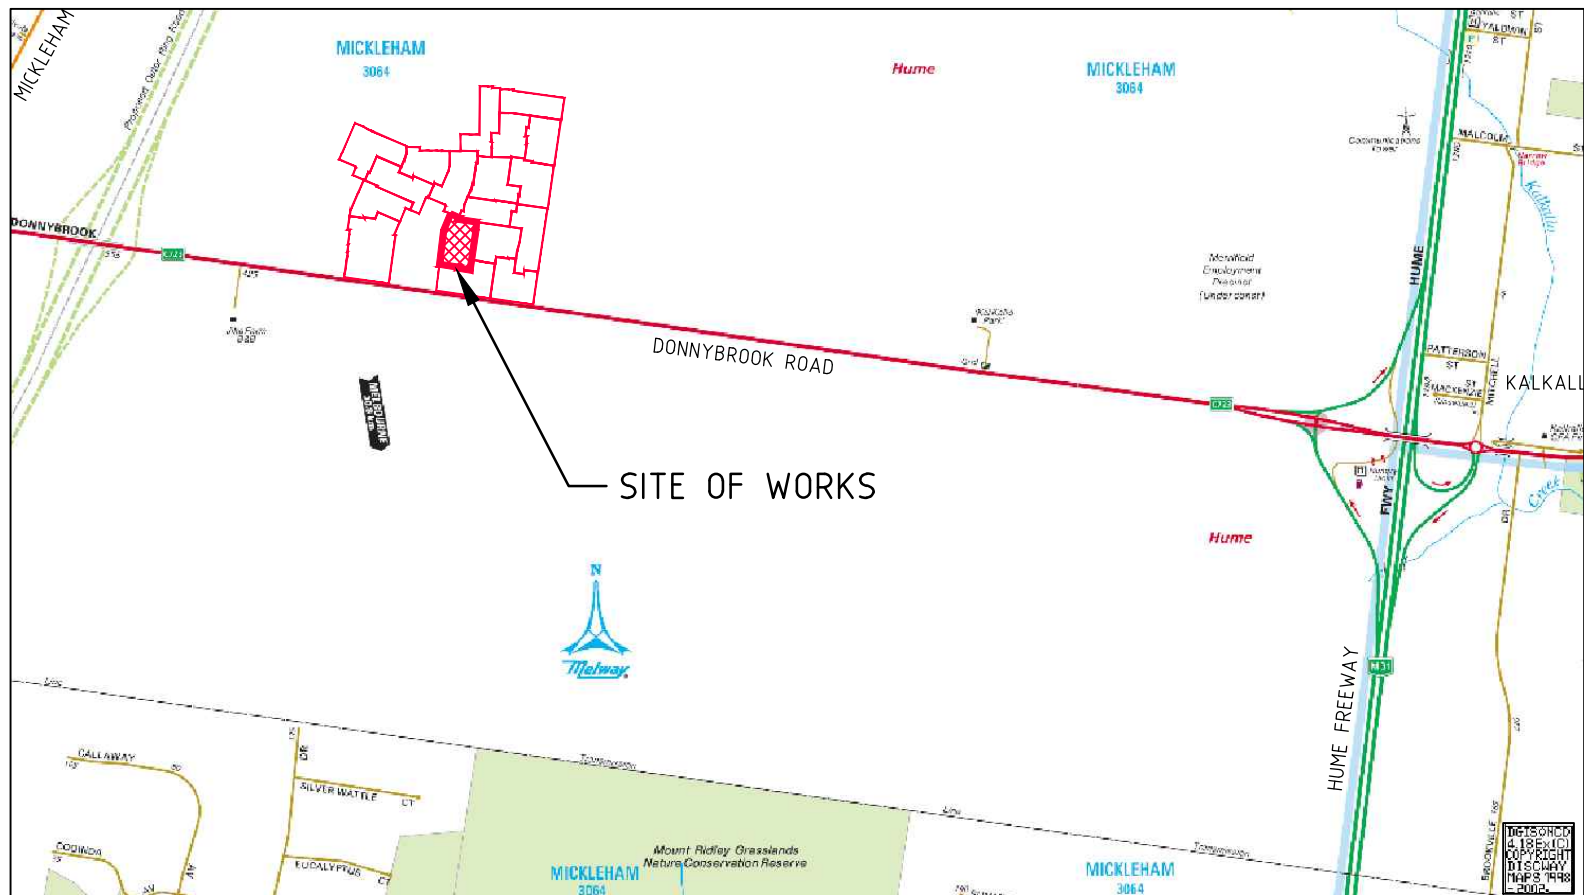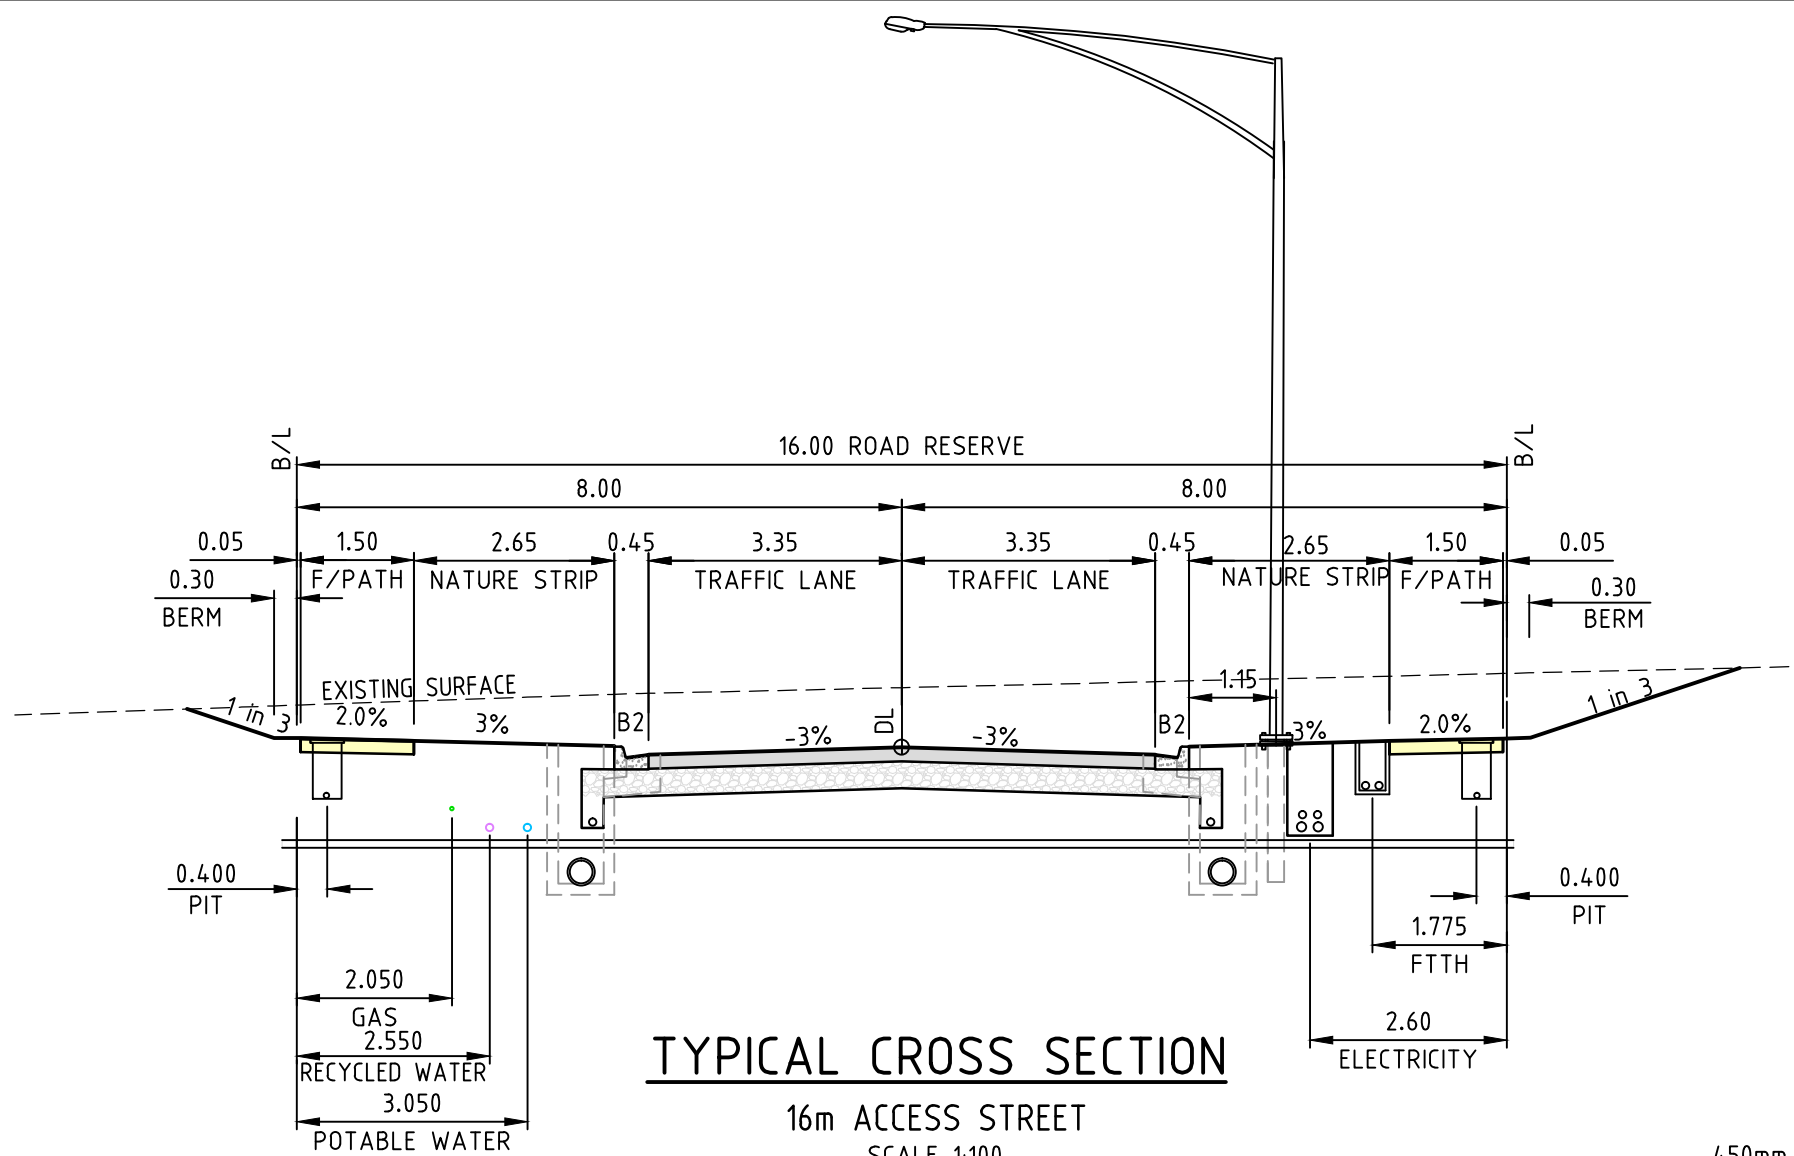


TEMPORARY OPEN EARTH DRAIN

PAVEMENT DETAILS




ACCESS STREETS BOTH ROADS	
ASPHALT	WEARING COURSE 30mm SIZE 10mm TYPE N ASPHALT BASE COURSE 30mm SIZE 10 BITUMEN CRUMB RUBBER ASPHALT BITUMINOUS PRIME PRIME OR SIZE 5 OR SIZE 7 BITUMEN EMULSION PRIMERSEAL (NOT EXCEEDING 60% BITUMEN CONTENT) AT >0.9 L/m ²
LAYER A	BASE COURSE 130mm SIZE 20mm CLASS 2 CRUSHED ROCK
LAYER B	UPPER SUBBASE: 120mm SIZE 20 CLASS 3 CRUSHED ROCK
CAPPING LAYER	LOWER SUBBASE: 100mm SIZE 20 CLASS 4 CRUSHED ROCK
DEPTH TOTAL	CAPPING 150mm REFER SECTION 7.4 OF REPORT
SUBGRADE	560mm SUBGRADE CBR ≥ 2%

REFER TO GOLDER ASSOCIATE'S GEOTECHNICAL REPORT NUMBER 127612078-001-R-Rev0 DATED 18/01/2013

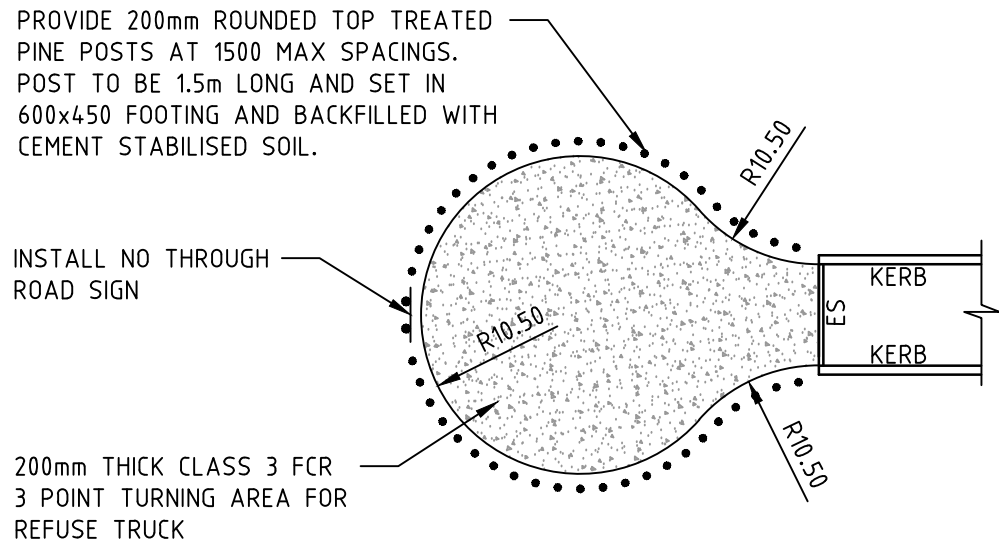

TEMPORARY END ROAD DETAIL


DRAWING INDEX		
SHEET NO.	DRAWING NO.	DESCRIPTION
01	11722TD01	LOCALITY PLAN, NOTES AND DETAILS
02	11722SP01	STAGING PLAN
03	11722DP01	DETAIL PLAN
04	11722SP01	SETOUT DETAILS
05-07	11722ID01-03	INTERSECTION DETAILS - SHEET 1 TO 3
08-09	11722LS01-02	LONGITUDINAL SECTIONS - SHEETS 1 TO 2
10-12	11722XS01-03	CROSS SECTIONS - SHEETS 1 TO 3
13-15	11722DR01-03	DRAINAGE LONGITUDINAL SECTIONS - SHEETS 1 TO 3
16	11722FP01	FILL PLAN
17	11722POS01	PLAN OF SUBDIVISION
18	11722EF01	EXISTING FEATURES PLAN

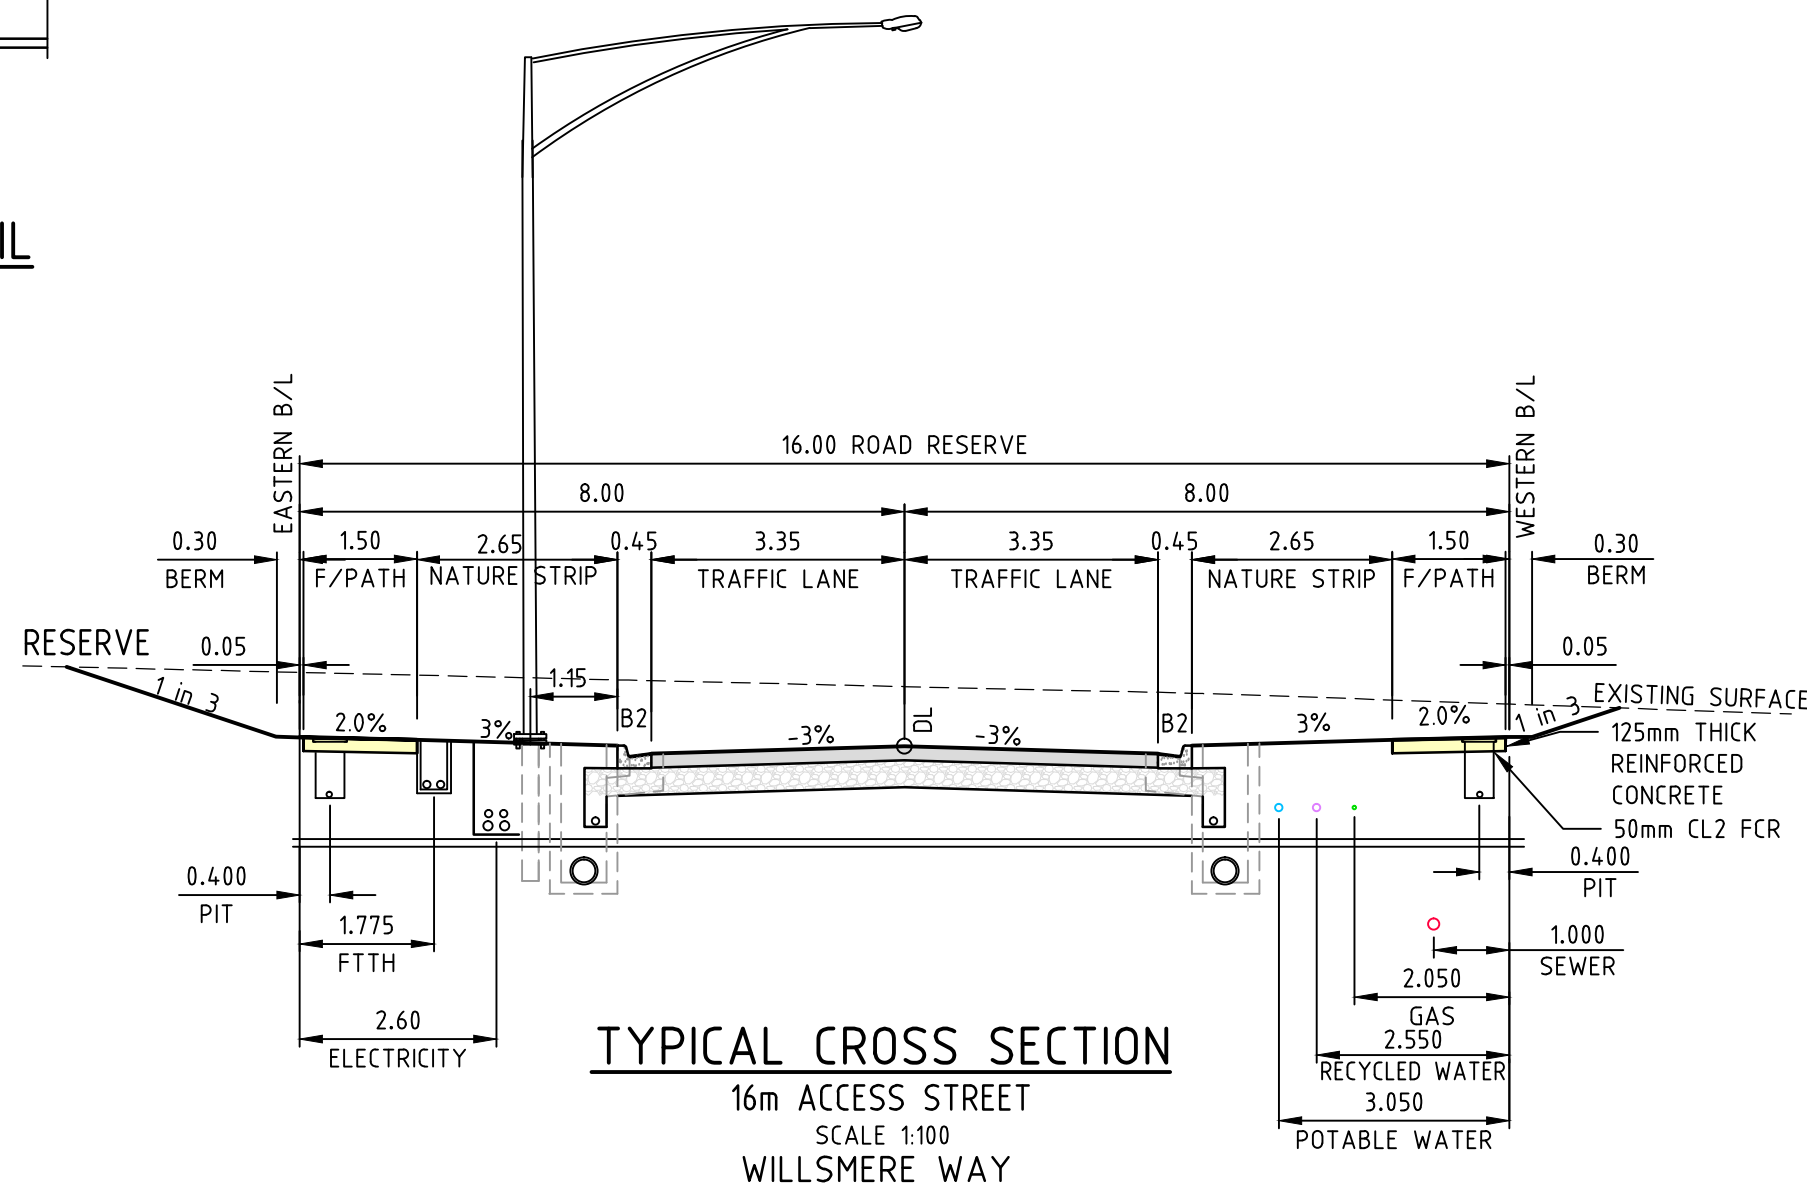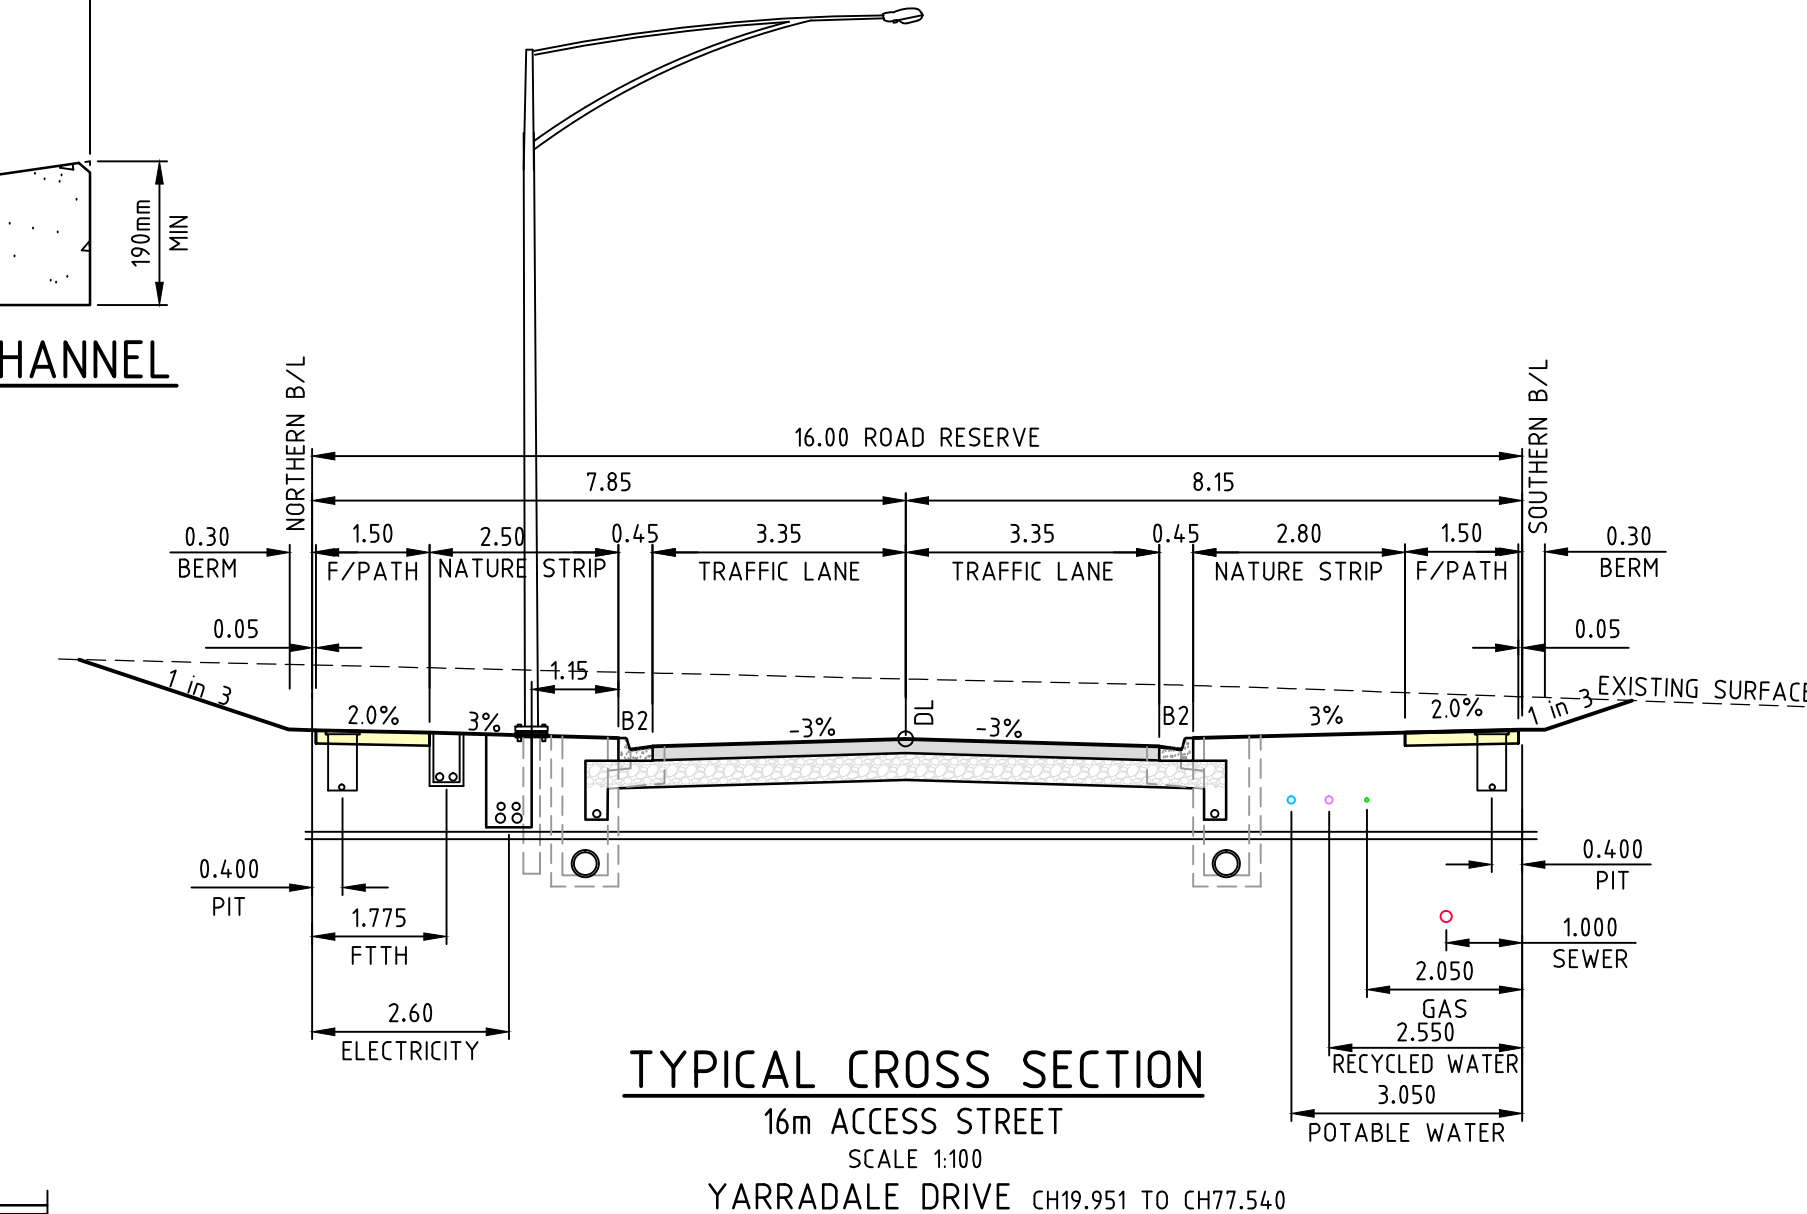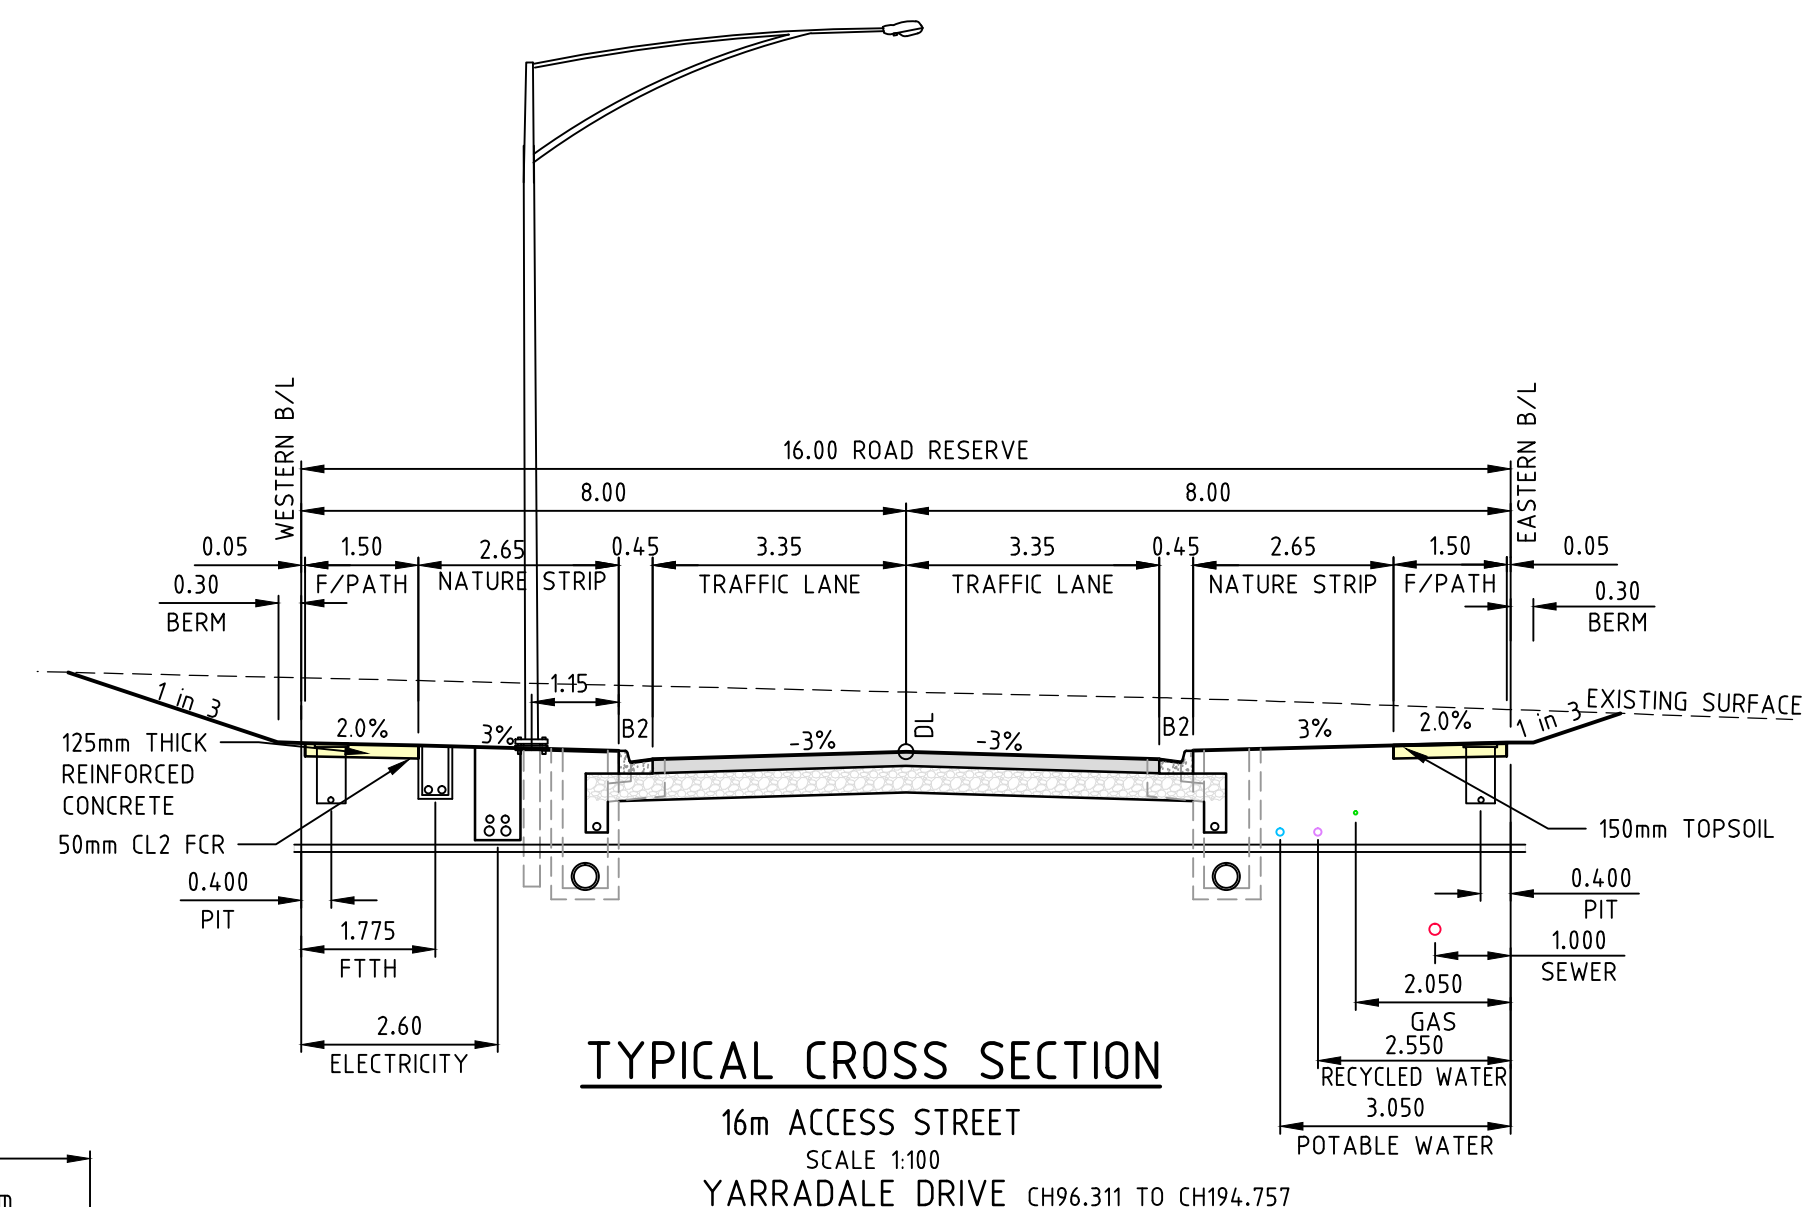

Drawing File: C:\Users\jdo\Documents\11700\11722-MERRIFIELD - Prefect 1 - Stage 2\Acad\11722TD01.dwg - 11722TD01
Date/Time: Thu Jan 05, 2014 - 2:20 pm - ByronShade

REV	AMENDMENTS	DATE	APP'D.
3	AS CONSTRUCTED	05/06/14	TL
2	PLAN OF SUBDIVISION AMENDMENT	04/12/13	TL
1	ISSUED TO COUNCIL FOR FINAL APPROVAL	03/10/13	TL
0	CONSTRUCTION ISSUE	27/08/13	TL
B	ISSUED FOR TENDER	16/07/13	TL
A	ISSUED TO COUNCIL	27/06/13	TL

Drawn HT Date 10/10/12
Designed BG Date 10/10/12
AN 1161107
Verified SL Date 03/06/13
AN 1061034
Audited RCM Date 22/08/13
AN 6415333
Approved TL Date 27/08/13
AN 881878
Written dimensions to take precedence over scale.
Contractor shall check and verify all dimensions on site.
Discrepancies to be brought to the attention of the Superintendent.

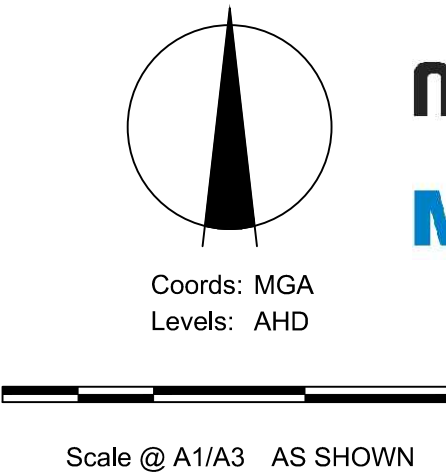

merrifield
MAB gpc


MERRIFIELD DEVELOPMENT
DANNYBROOK ROAD, MICKLEHAM
STAGE 2
LOCALITY PLAN, NOTES AND DETAILS

DCE
dalton consulting engineers

Drawing No. 11722TD01 Rev 3
Sheet No. 01 AS CONSTRUCTED
© Dalton Consulting Engineers Pty Ltd
ABN 78 428 221 048


255 Whitehorse Road
PO Box 349
Bairwyn Victoria 3103
Australia
T 61 3 9888 6866
F 61 3 9888 6880
E info@dceprofile.com
W www.dceprofile.com

Drawing File: C:\Users\merrifield\11722-MERRIFIELD - Project 1 - Stage 2\Acad\11722SP01.dwg - 11722SP01
Date/Time: Thu Jan 05, 2014 - 2:20 pm --byron.shade--

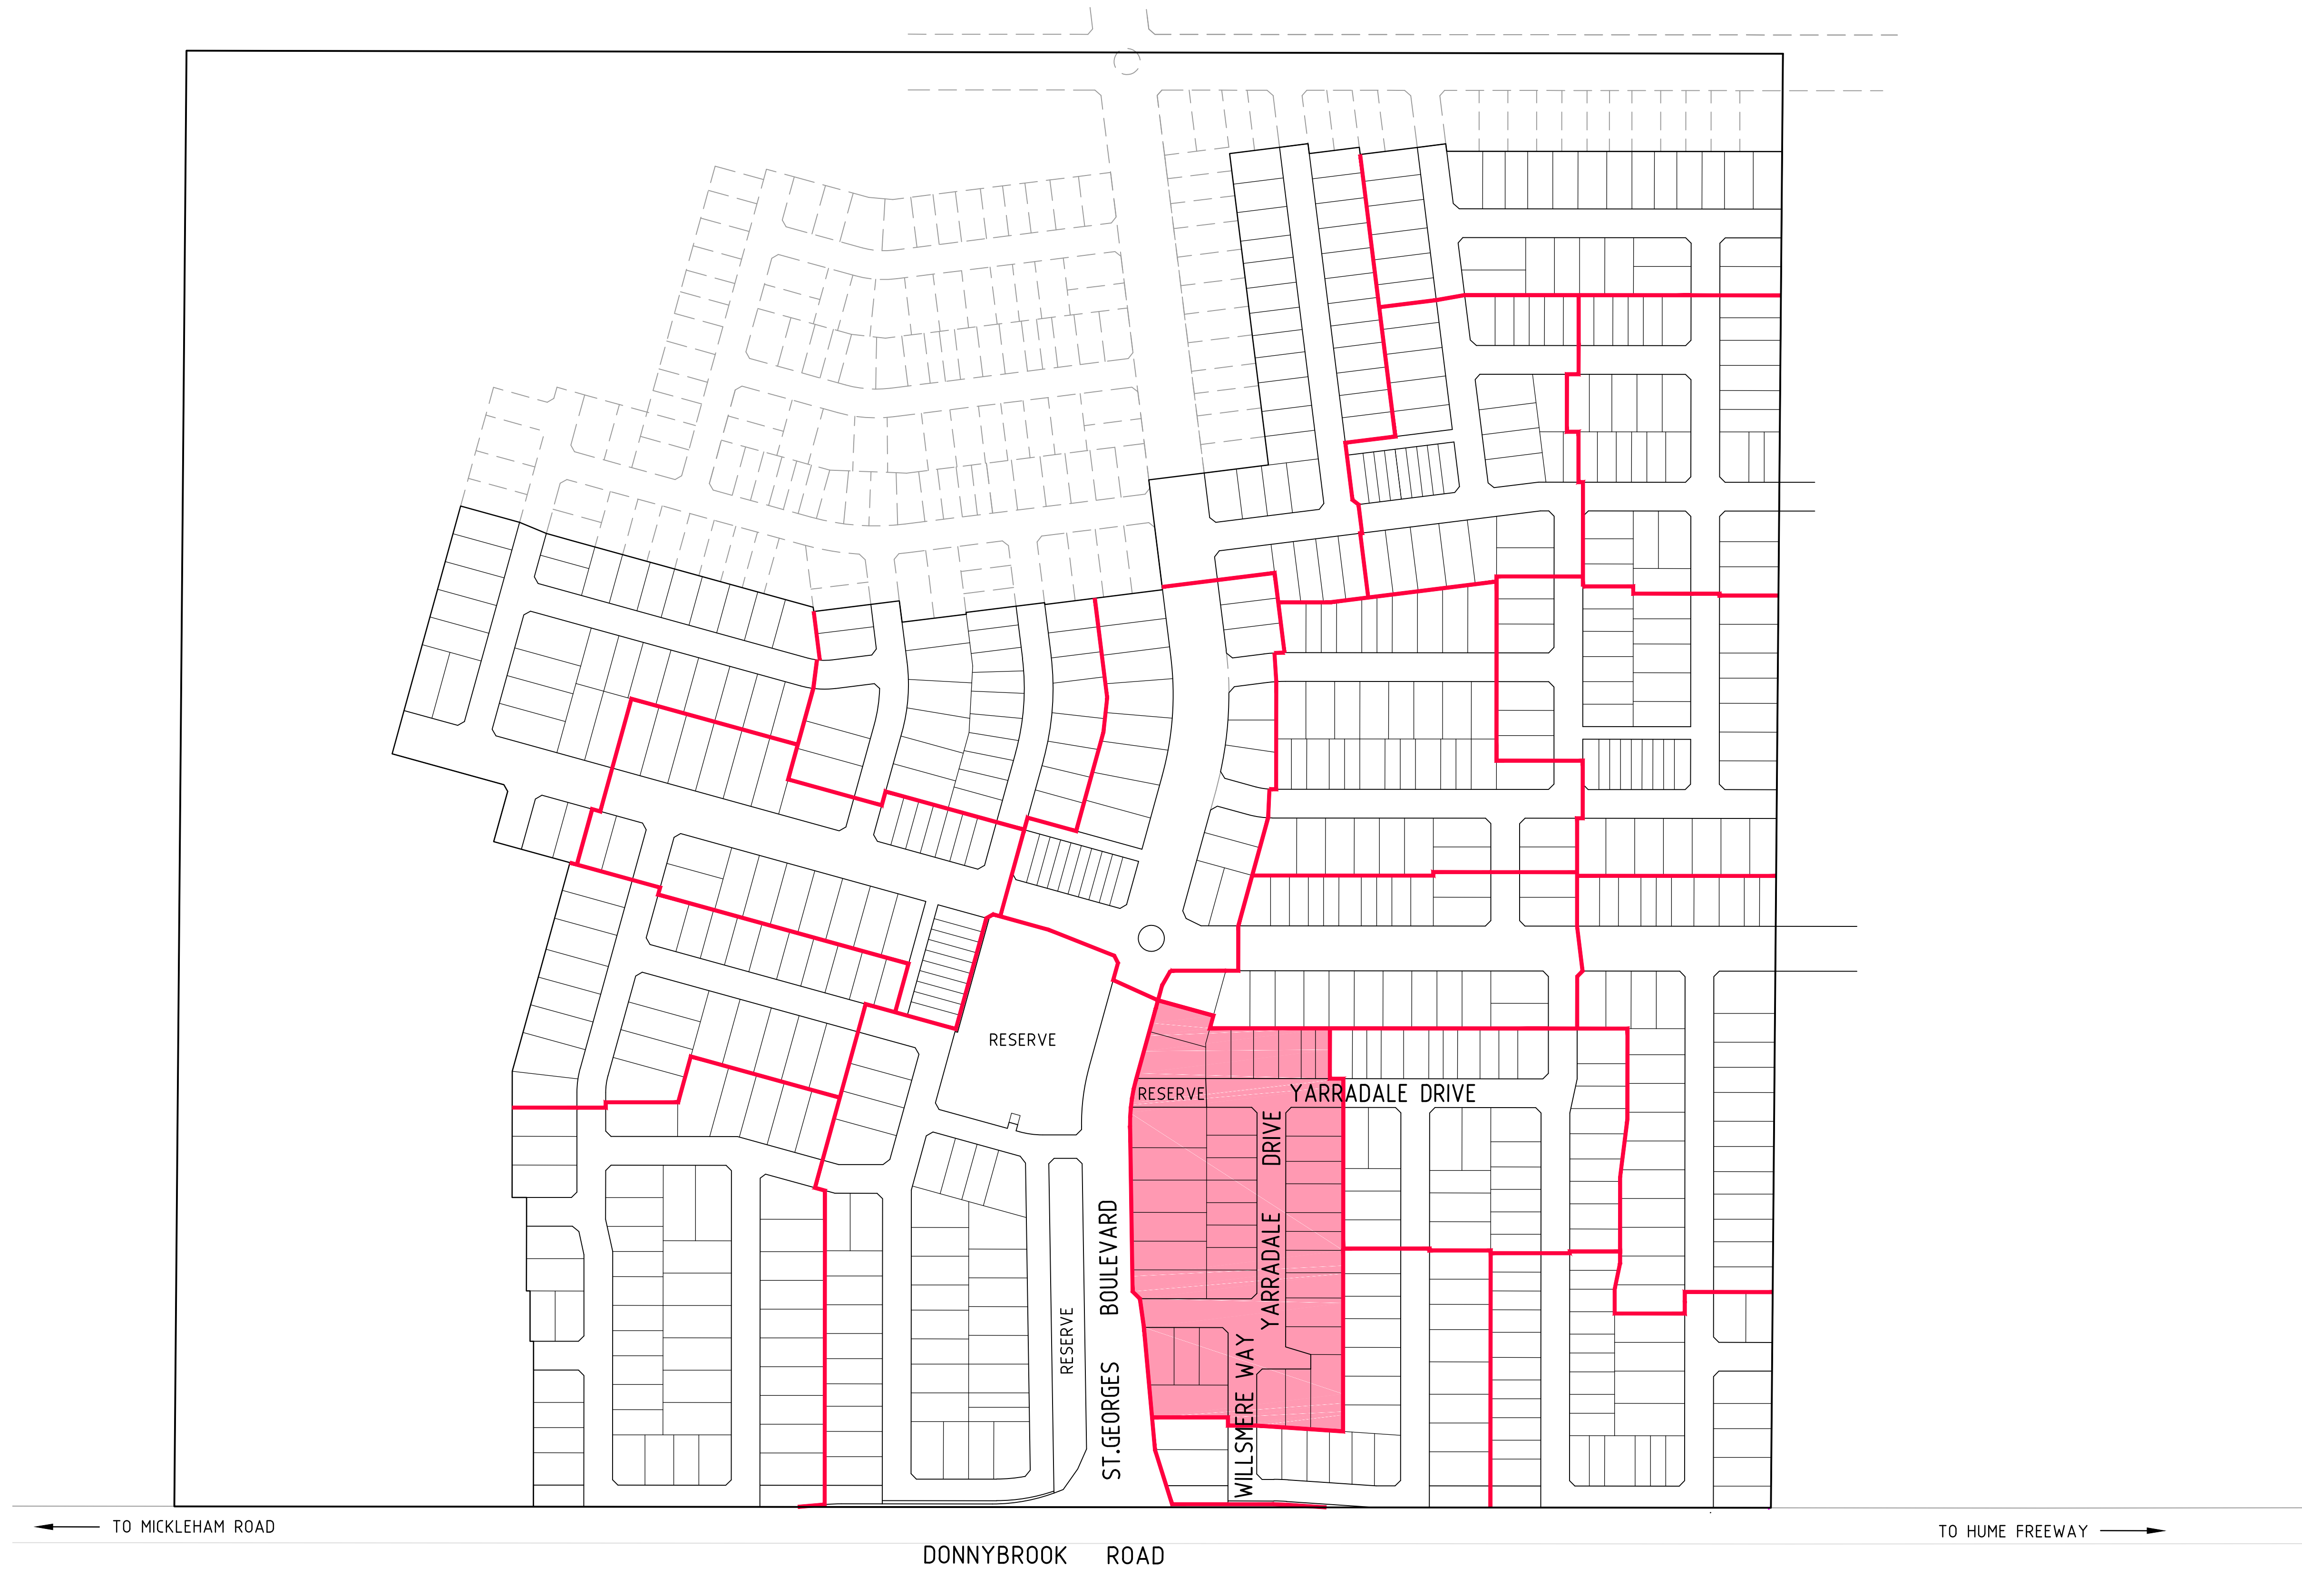

REV	AMENDMENTS	DATE	APP'D.
3	AS CONSTRUCTED	05/06/14	TL
2	PLAN OF SUBDIVISION AMENDMENT	04/06/13	TL
1	ISSUED TO COUNCIL FOR FINAL APPROVAL	03/10/13	TL
0	CONSTRUCTION ISSUE	27/08/13	TL
B	ISSUED FOR TENDER	16/07/13	TL
A	ISSUED TO COUNCIL	27/06/13	TL

Drawn HT Date 10/10/12
Designed BG
Date 10/10/12
AN 161108
Verified SL
Date 03/06/13
AN 1061035
Audited RCM
Date 22/08/13
AN 641534
Approved TL
Date 27/08/13
AN 881879
Written dimensions take precedence over scale.
Contractor shall check and verify all dimensions on site.
Discrepancies to be brought to the attention of the Superintendent.

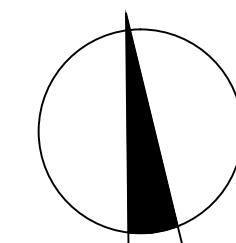

Coords: MGA
Levels: AHD
Hor 1:2000 0m 20m 40m 80m 120m
Scale @ A1/A3 1:2000/1:4000

merrifield
MAB gpc



MERRIFIELD DEVELOPMENT
DONNYBROOK ROAD, MICKLEHAM
STAGE 2
STAGING PLAN

Drawing No. 11722SP01 Rev 3
Sheet No. 02 AS CONSTRUCTED
© Dalton Consulting Engineers Pty Ltd
ABN 78 428 221 048

 **DCE**
dalton consulting engineers

255 Whitehorse Road
PO Box 349
Balwyn Victoria 3103
Australia
T 61 3 9888 6866
F 61 3 9888 6880
E info@dceprofile.com
W www.dceprofile.com


Drawing File: C:\Users\merrifield\1700\1722-MERRIFIELD - Precinct 1 - Stage 2\Acad\1722DP01.dwg - 1722DP01
Date/Time: Thu Jan 05, 2014 - 2:01 pm - Byron Shire

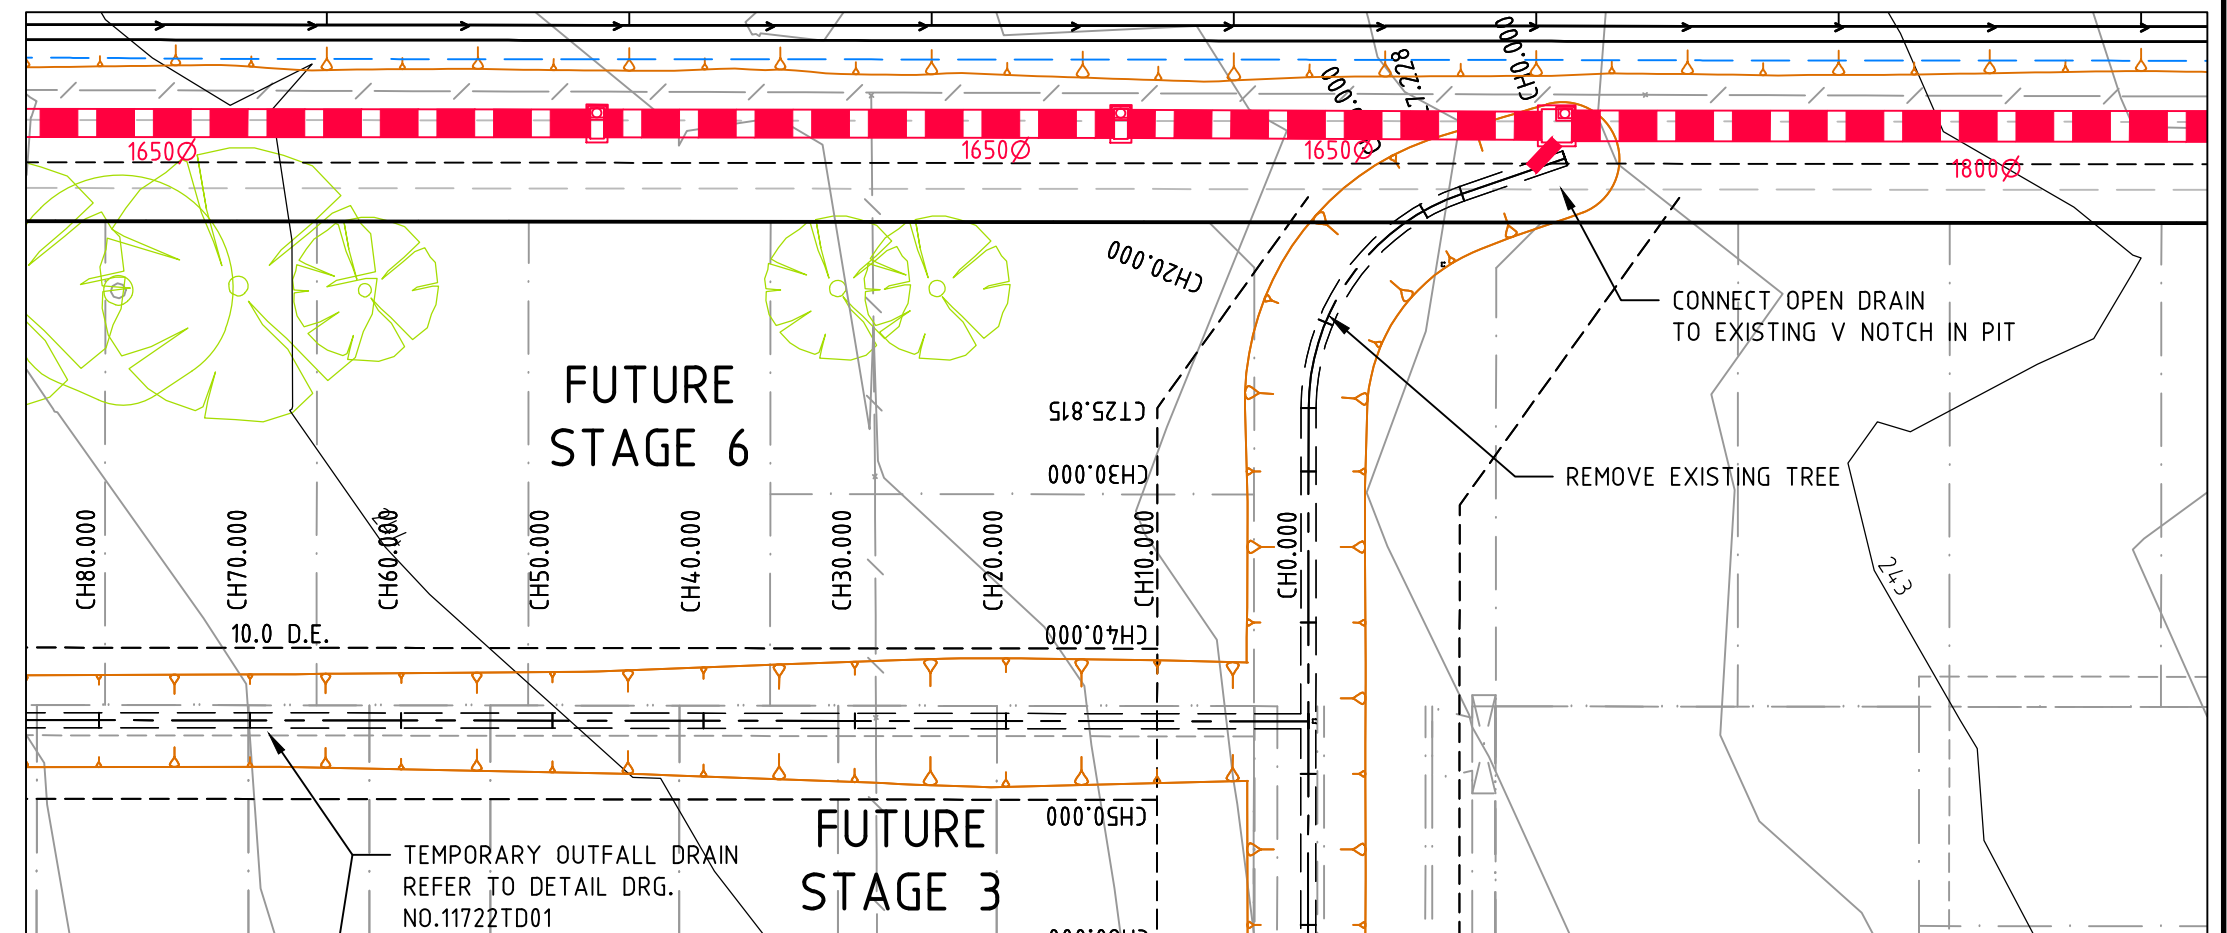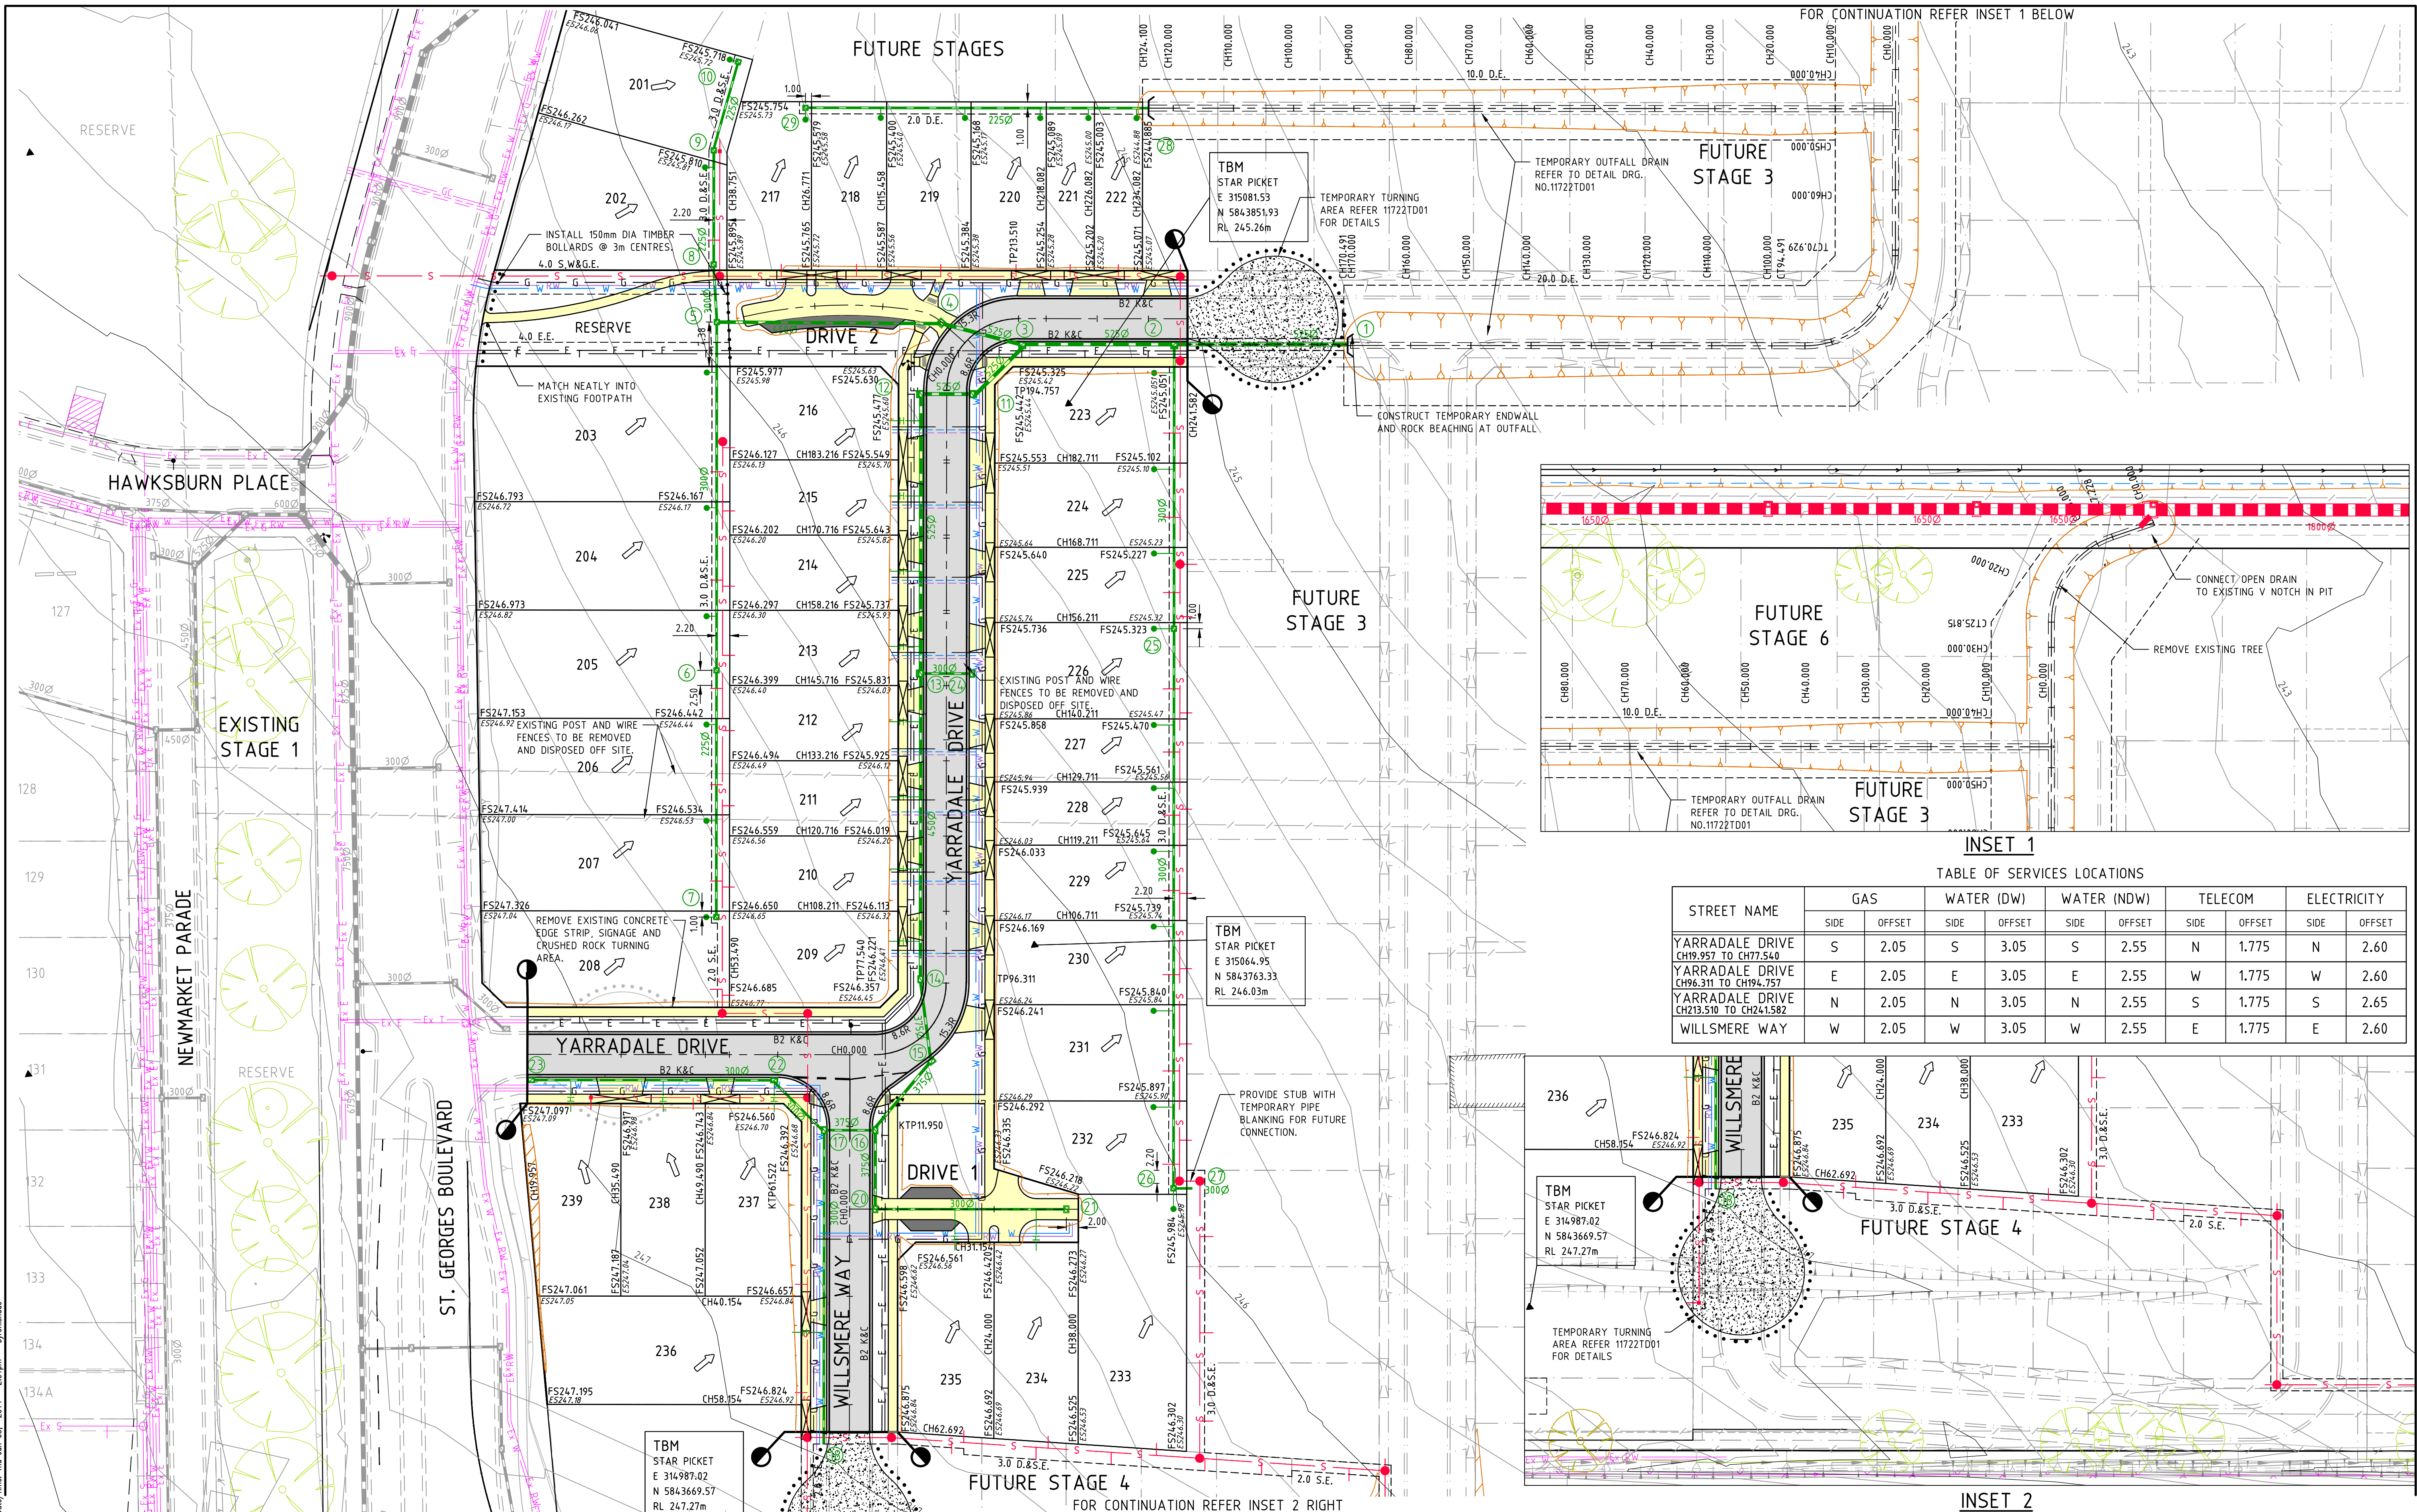

INSET 1

TABLE OF SERVICES LOCATIONS

STREET NAME	GAS		WATER (DW)		WATER (NDW)		TELECOM		ELECTRICITY	
	SIDE	OFFSET	SIDE	OFFSET	SIDE	OFFSET	SIDE	OFFSET	SIDE	OFFSET
YARRADALE DRIVE	S	2.05	S	3.05	S	2.55	N	1.775	N	2.60
YARRADALE DRIVE	E	2.05	E	3.05	E	2.55	W	1.775	W	2.60
YARRADALE DRIVE	N	2.05	N	3.05	N	2.55	S	1.775	S	2.65
WILLSMERE WAY	W	2.05	W	3.05	W	2.55	E	1.775	E	2.60

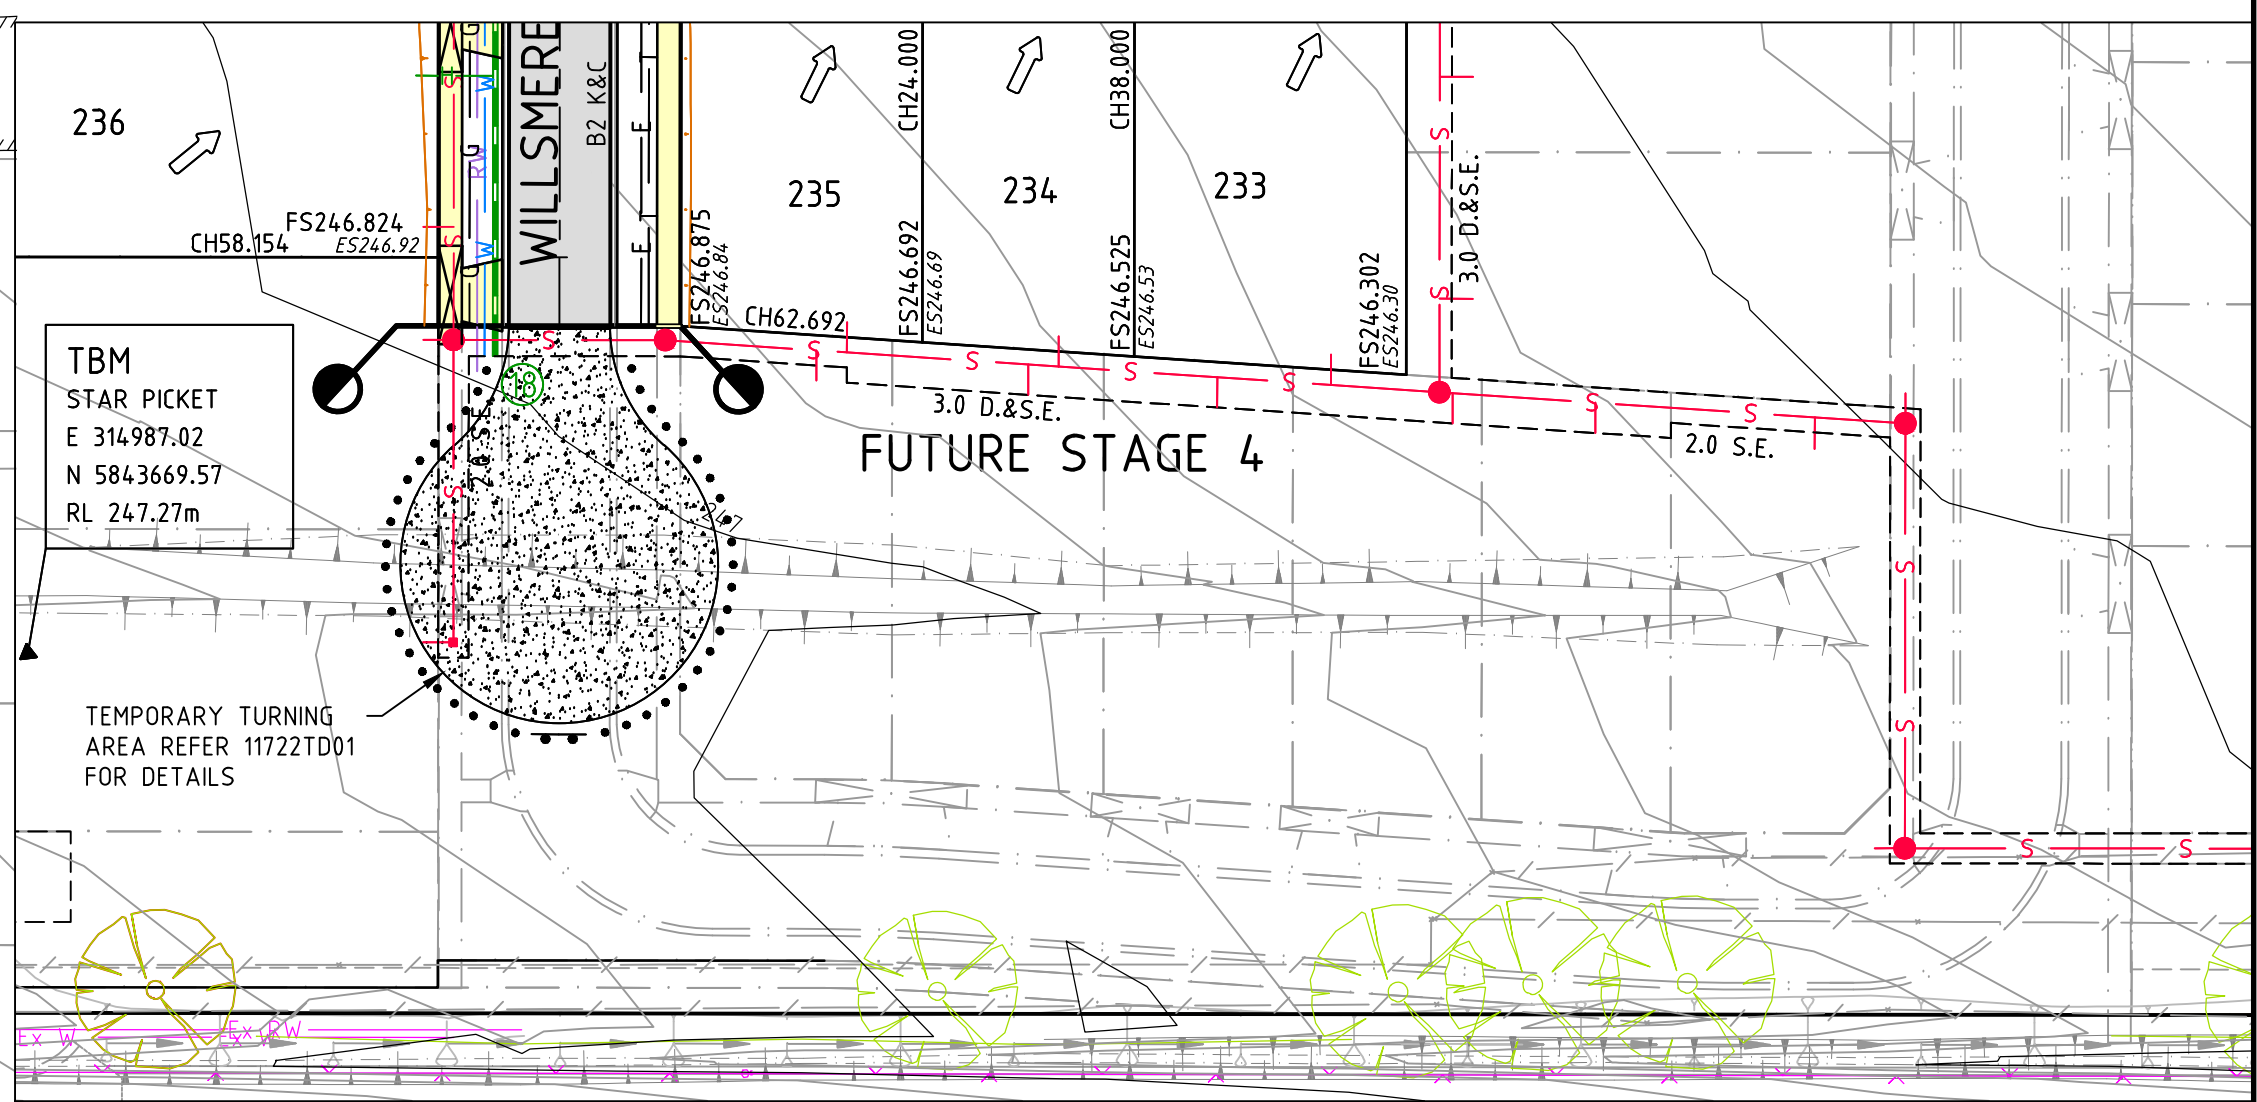

INSET 2

REV	AMENDMENTS	DATE	APP'D.
4	AS CONSTRUCTED	05/06/14	TL
3	PLAN OF SUBDIVISION AMENDMENT	04/12/13	TL
2	ISSUED TO COUNCIL FOR FINAL APPROVAL	03/10/13	TL
1	VEHICLE CROSSOVER ADDED	28/08/13	TL
0	CONSTRUCTION ISSUE	27/08/13	TL
B	ISSUED FOR TENDER	16/07/13	TL
A	ISSUED TO COUNCIL	27/06/13	TL


Drawn HT Date 10/10/12
Designed BG Date 10/10/12
AN 161109
Verified SL Date 03/06/13
AN 1061036
Audited RCM Date 22/08/13
AN 641535
Approved TL Date 27/08/13
AN 881880

Written dimensions to take precedence over scale.
Contractor shall check and verify all dimensions on site.
Discrepancies to be brought to the attention of the Superintendent.

- Ex W EXISTING WATER MAIN
- Ex G EXISTING GAS MAIN
- Ex E EXISTING ELECTRICAL CABLE
- Ex S EXISTING SEWER MAIN & MANHOLE
- Ex T EXISTING TELECOMM. CABLE AND PIT
- Ex P EXISTING ELEC. POLE & O'HEAD LINES
- Ex D EXISTING STORMWATER DRAIN & PIT
- Ex C EXISTING CONDUIT
- Ex R EXISTING RECYCLED WATER CONDUIT
- Ex Tc EXISTING TELECOMM. CONDUIT
- Ex Pm EXISTING PERMANENT SURVEY MARK
- Ex Tbm EXISTING TEMPORARY BENCH MARK
- Ex E EXISTING TREES TO BE REMOVED
- Ex L EXISTING SURFACE LEVEL
- Ex F EXISTING FINISHED SURFACE LEVEL
- Ex O EXISTING OPEN EARTH DRAIN (O.E.D.)

- S SEWER MAIN AND MANHOLE
- G GAS MAIN
- E ELECTRICAL CABLE
- S SW DRAIN & PIT CONSTRUCTED IN PREVIOUS STAGES
- M MAIN DRAIN
- P PROPERTY INLETS
- H HOUSE DRAIN
- GC GAS CONDUIT
- W WATER CONDUIT
- R RECYCLED WATER CONDUIT
- Tc TELECOMM. CONDUIT
- Pm PERMANENT SURVEY MARK
- Tbm TEMPORARY BENCH MARK

- OF OPTIC FIBRE
- W WATER
- RW RECYCLED WATER
- T TELECOMMUNICATIONS
- E ELECTRICITY
- G GAS
- S STREET NAME SIGN
- R REGRADE LOT AT MIN 1 IN 150
- A ASPHALT PAVEMENT
- C CONC FOOTPATH / DRIVEWAY
- L LIMIT OF WORKS
- F FILLING OVER 200mm

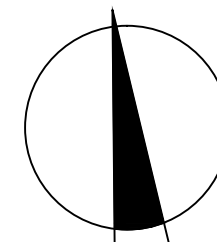

Coords: MGA
Levels: AHD
Hor 1:500 0m 5m 10m 20m 30m
Scale @ A1/A3 1:500/1:1000

merrifield
MAB gpc

MERRIFIELD DEVELOPMENT
DANNYBROOK ROAD, MICKLEHAM
STAGE 2
DETAIL PLAN

Drawing No. 11722DP01 Rev 4
Sheet No. 03 AS CONSTRUCTED
© Dalton Consulting Engineers Pty Ltd
ABN 78 428 221 048

DCE
dalton consulting engineers

255 Whitehorse Road
PO Box 349
Bairym Victoria 3103
Australia
T 61 3 9888 8888
F 61 3 9888 8880
E info@dceprofile.com
W www.dceprofile.com

D:\projects\11722\11722-MERRIFIELD - Precinct 1 - Stage 2\Acad\11722SOP01.dwg - 11722SOP01
Date/Time: Thu Jun 05, 2014 - 2:20 pm -- Byron Shire --

HORIZONTAL ALIGNMENT REPORT FOR YARRADALE DRIVE DESIGN LINE

POINT TYPE	CHAINAGE	COORDINATES		RL	BEARING DEG MIN SEC	RADIUS
		EASTINGS	NORTHINGS			
INTERSECTION POINT	0.000	314959.322	5843758.012	247.255	97°03'10.00"	
VC INTERSECTION POINT	8.210	314967.470	5843757.004	247.090	97°03'10.00"	
STRAIGHT	20.000	314979.171	5843755.556	246.982	97°03'10.00"	
STRAIGHT	40.000	314999.019	5843753.101	246.766	97°03'10.00"	
STRAIGHT	60.000	315018.868	5843750.645	246.517	97°03'10.00"	
TANGENT-CURVE	77.540	315036.276	5843748.491	246.298	97°03'10.00"	-11.950
CURVE	80.000	315038.731	5843748.442	246.269	85°15'32.15"	-11.950
CURVE	82.857	315041.523	5843749.015	246.237	71°33'36.00"	-11.950
CURVE	85.714	315044.100	5843750.232	246.206	57°51'39.85"	-11.950
CURVE	88.571	315046.315	5843752.025	246.178	44°09'43.70"	-11.950
CURVE	91.429	315048.043	5843754.292	246.152	30°27'47.54"	-11.950
CURVE	94.286	315049.185	5843756.904	246.128	16°45'51.39"	-11.950
INTERSECTION POINT	96.311	315049.602	5843758.884	246.112	7°03'10.00"	
STRAIGHT	100.000	315050.055	5843762.545	246.084	7°03'10.00"	
STRAIGHT	120.000	315052.511	5843782.393	245.934	7°03'10.00"	
STRAIGHT	140.000	315054.967	5843802.242	245.783	7°03'10.00"	
STRAIGHT	160.000	315057.422	5843822.091	245.633	7°03'10.00"	
STRAIGHT	180.000	315059.878	5843841.939	245.482	7°03'10.00"	
TANGENT-CURVE	194.761	315061.690	5843856.589	245.371	7°03'10.00"	11.950
CURVE	197.143	315062.216	5843858.908	245.353	18°28'18.78"	11.950
CURVE	200.000	315063.435	5843861.484	245.332	32°10'14.93"	11.950
CURVE	202.857	315065.229	5843863.699	245.310	45°52'11.08"	11.950
CURVE	205.714	315067.497	5843865.429	245.288	59°34'07.23"	11.950
CURVE	208.571	315070.110	5843866.566	245.263	73°16'03.38"	11.950
CURVE	211.429	315072.918	5843867.055	245.236	86°57'59.54"	11.950
CURVE-TANGENT	213.532	315075.017	5843866.981	245.214	97°03'10.00"	11.950
STRAIGHT	220.000	315081.436	5843866.187	245.140	97°03'10.00"	
INTERSECTION POINT	237.582	315098.885	5843864.028	244.909	97°03'10.00"	
STRAIGHT	240.000	315101.285	5843863.731	244.877	97°03'10.00"	
STRAIGHT	260.000	315121.133	5843861.276	244.612	97°03'10.00"	
STRAIGHT	280.000	315140.982	5843858.820	244.359	97°03'10.00"	
STRAIGHT	300.000	315160.831	5843856.364	244.143	97°03'10.00"	
STRAIGHT	320.000	315180.679	5843853.909	243.866	97°03'10.00"	
STRAIGHT	340.000	315200.528	5843851.453	243.436	97°03'10.00"	
STRAIGHT	360.000	315220.377	5843848.997	243.360	97°03'10.00"	
INTERSECTION POINT	361.727	315222.091	5843848.785	243.409	97°03'10.00"	

HORIZONTAL ALIGNMENT REPORT FOR OED 2 DESIGN LINE

POINT TYPE	CHAINAGE	COORDINATES		RL	BEARING DEG MIN SEC	RADIUS
		EASTINGS	NORTHINGS			
INTERSECTION POINT	0.000	315223.863	5843883.833	242.383	277°03'10.00"	
VC INTERSECTION POINT	0.500	315223.366	5843883.894	242.383	277°03'10.00"	
STRAIGHT	10.000	315213.938	5843885.061	242.514	277°03'10.00"	
STRAIGHT	20.000	315204.014	5843886.288	242.653	277°03'10.00"	
STRAIGHT	30.000	315194.090	5843887.516	242.791	277°03'10.00"	
STRAIGHT	40.000	315184.165	5843888.744	242.929	277°03'10.00"	
STRAIGHT	50.000	315174.241	5843889.972	243.068	277°03'10.00"	
STRAIGHT	60.000	315164.317	5843891.200	243.206	277°03'10.00"	
STRAIGHT	70.000	315154.392	5843892.428	243.344	277°03'10.00"	
STRAIGHT	80.000	315144.468	5843893.656	243.483	277°03'10.00"	
STRAIGHT	90.000	315134.544	5843894.883	243.621	277°03'10.00"	
STRAIGHT	100.000	315124.619	5843896.111	243.760	277°03'10.00"	
STRAIGHT	110.000	315114.695	5843897.339	243.898	277°03'10.00"	
STRAIGHT	120.000	315104.771	5843898.567	244.036	277°03'10.00"	
INTERSECTION POINT	124.100	315100.702	5843899.070	244.093	277°03'10.00"	

HORIZONTAL ALIGNMENT REPORT FOR DRIVE 2 DESIGN LINE


POINT TYPE	CHAINAGE	COORDINATES		RL	BEARING DEG MIN SEC	RADIUS
		EASTINGS	NORTHINGS			
INTERSECTION POINT	0.000	315065.647	5843864.085	245.306	318°35'49.27"	
TANGENT-CURVE	5.130	315062.254	5843867.933	245.235	318°35'49.27"	-8.000
CURVE	7.500	315060.448	5843869.454	245.279	301°37'17.55"	-8.000
CURVE-TANGENT	9.664	315058.475	5843870.327	245.320	286°07'19.07"	-8.000
CURVE	13.333	315054.927	5843871.259	245.387	283°19'08.09"	-75.000
CURVE	20.000	315048.380	5843872.505	245.491	278°13'33.44"	-75.000
CURVE	26.667	315041.748	5843873.165	245.583	273°07'58.79"	-75.000
CURVE	33.333	315035.084	5843873.233	245.675	268°02'24.14"	-75.000
CURVE-TANGENT	38.751	315029.681	5843872.852	245.750	263°54'04.95"	-75.000

HORIZONTAL ALIGNMENT REPORT FOR DRIVE 1 DESIGN LINE

POINT TYPE	CHAINAGE	COORDINATES		RL	BEARING DEG MIN SEC	RADIUS
		EASTINGS	NORTHINGS			
INTERSECTION POINT	0.000	315029.107	5843723.533	246.391	97°03'10.00"	
STRAIGHT	20.000	315048.955	5843721.077	246.283	97°03'10.00"	
INTERSECTION POINT	38.000	315066.819	5843718.867	246.138	97°03'10.00"	


HORIZONTAL ALIGNMENT REPORT FOR WILLSMERE WAY DESIGN LINE

POINT TYPE	CHAINAGE	COORDINATES		RL	BEARING DEG MIN SEC	RADIUS
		EASTINGS	NORTHINGS			
INTERSECTION POINT	0.000	315032.257	5843748.993	246.349	187°03'10.00"	
STRAIGHT	20.000	315029.801	5843729.144	246.340	187°03'10.00"	
STRAIGHT	40.000	315027.345	5843709.296	246.570	187°03'10.00"	
STRAIGHT	60.000	315024.890	5843689.447	246.837	187°03'10.00"	
INTERSECTION POINT	62.692	315024.559	5843686.775	246.873	187°03'10.00"	
STRAIGHT	80.000	315022.434	5843669.598	247.107	187°03'10.00"	
TANGENT-CURVE	89.050	315021.323	5843660.617	247.231	187°03'10.00"	-11.050
CURVE	91.429	315021.286	5843658.243	247.263	174°43'15.56"	-11.050
CURVE	94.286	315021.912	5843655.464	247.302	159°54'22.71"	-11.050
CURVE	97.143	315023.227	5843652.936	247.341	145°05'29.86"	-11.050
CURVE	100.000	315025.146	5843650.829	247.379	130°16'37.01"	-11.050
CURVE	102.857	315027.539	5843649.283	247.410	115°27'44.16"	-11.050
CURVE	105.714	315030.248	5843648.400	247.433	100°38'51.30"	-11.050
CURVE-TANGENT	106.407	315030.932	5843648.293	247.438	97°03'15.31"	-11.050
INTERSECTION POINT	106.407	315030.932	5843648.293	247.438	97°03'15.31"	
INTERSECTION POINT	112.916	315037.392	5843647.494	247.458	97°03'15.33"	112.050
TANGENT-CURVE	112.916	315037.392	5843647.494	247.458	97°03'15.33"	112.050
CURVE	113.333	315037.806	5843647.442	247.458	97°16'03.32"	112.050
CURVE	120.000	315044.390	5843646.403	247.436	100°40'35.51"	112.050

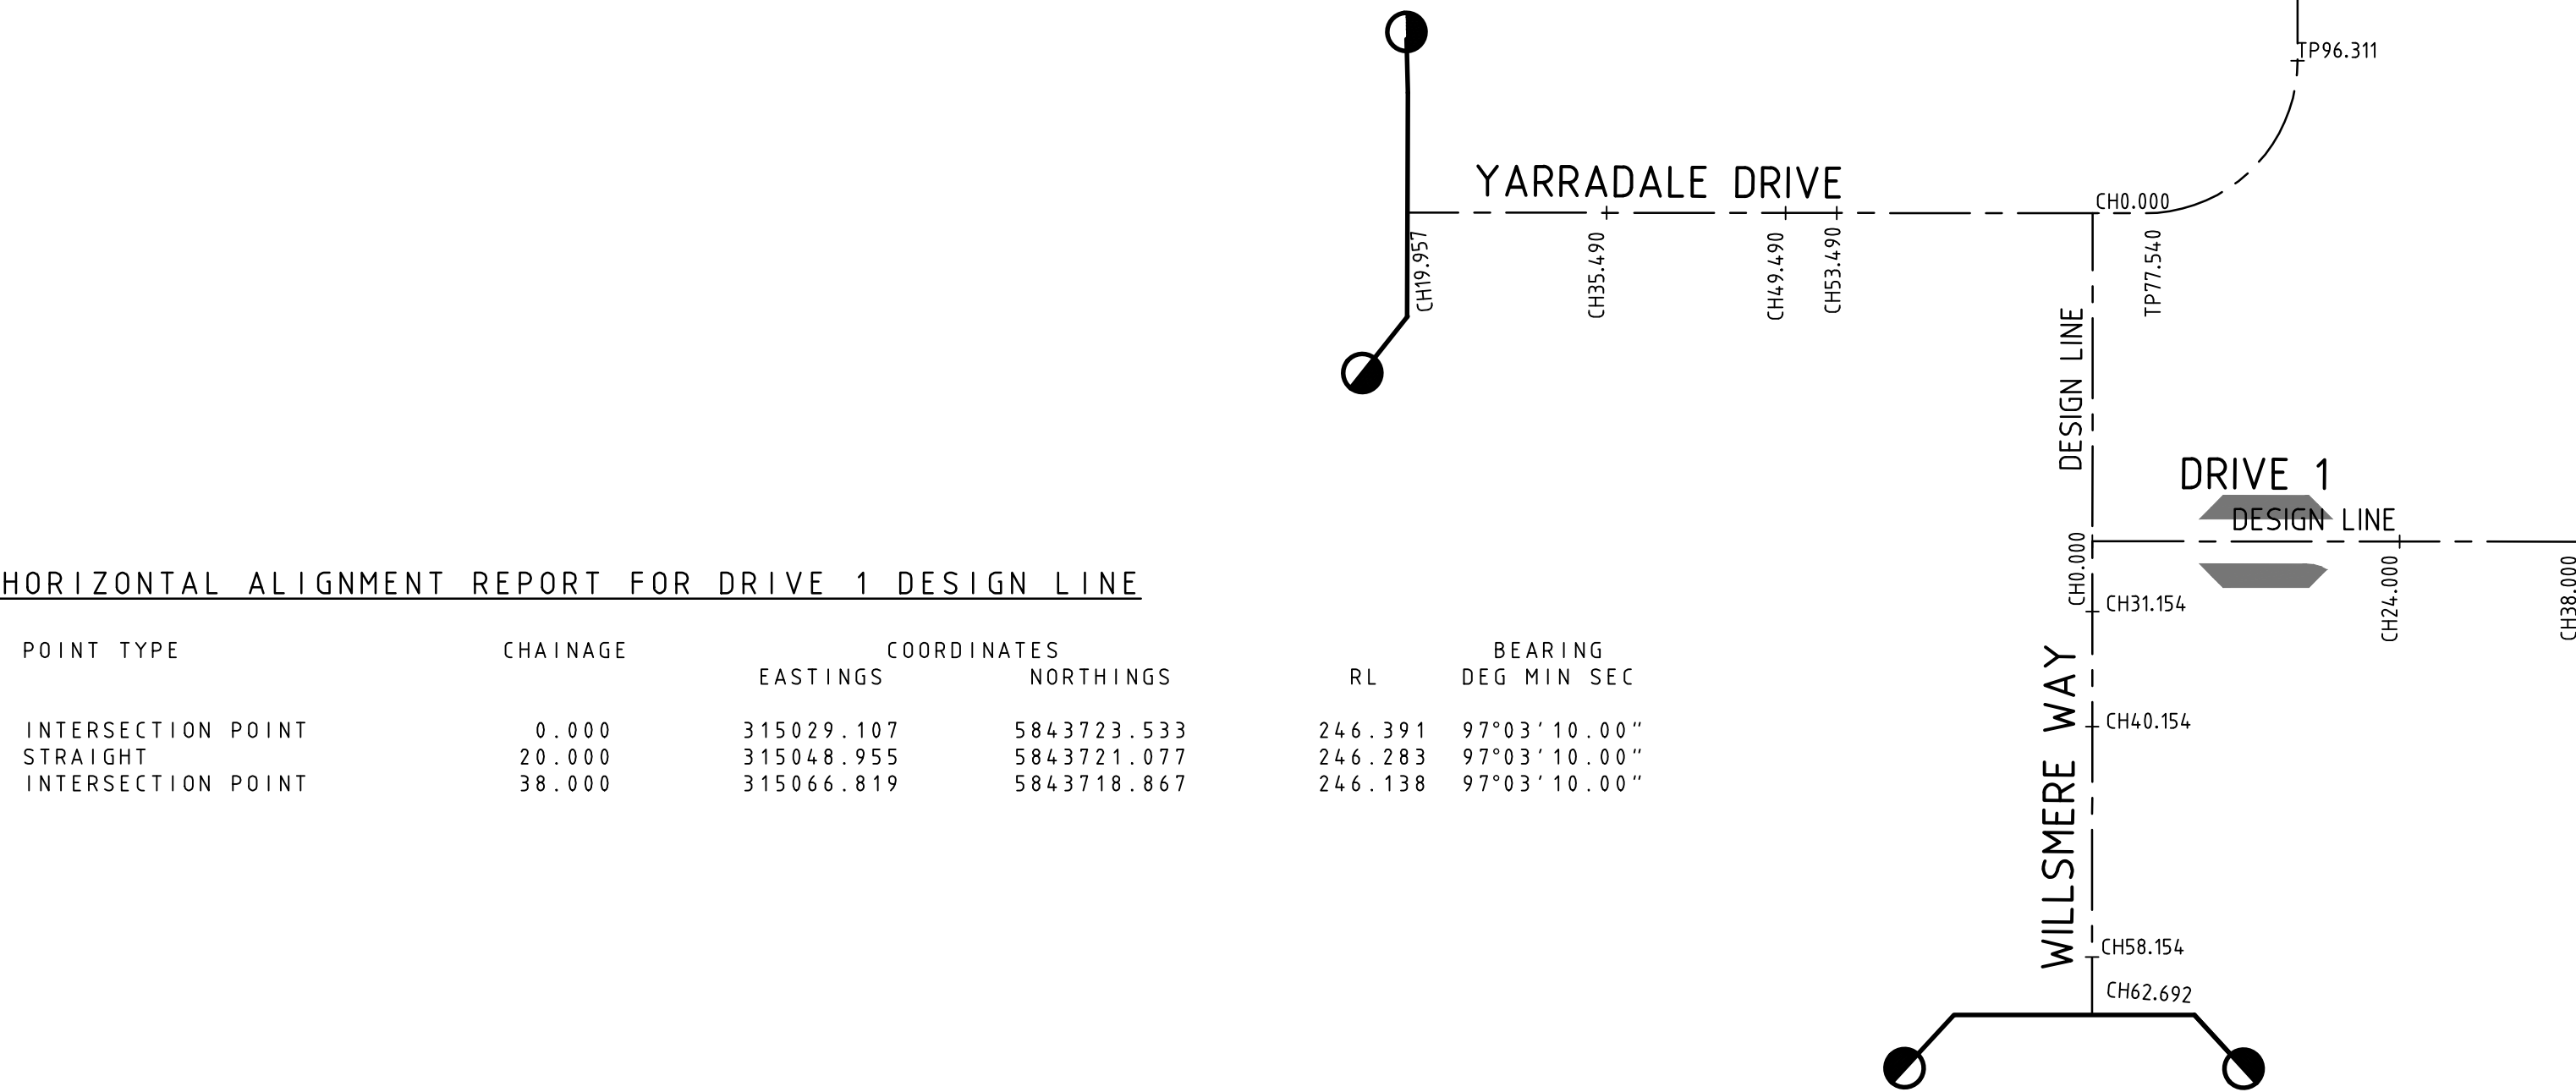

3	AS CONSTRUCTED	05/06/14	TL
2	PLAN OF SUBDIVISION AMENDMENT	04/12/13	TL
1	ISSUED TO COUNCIL FOR FINAL APPROVAL	03/10/13	TL
0	CONSTRUCTION ISSUE	27/08/13	TL
B	ISSUED FOR TENDER	16/07/13	TL
A	ISSUED TO COUNCIL	27/06/13	TL
REV	AMENDMENTS	DATE	APP'D.

Drawn HT Date 10/10/12
Designed BG Date 10/10/12
AN 61110
Verified SL Date 03/06/13
AN 1061037
Audited RCM Date 22/08/13
AN 641536
Approved TL Date 27/08/13
AN 881881
Written dimensions to take precedence over scale.
Contractor shall check and verify all dimensions on site.
Discrepancies to be brought to the attention of the Superintendent.

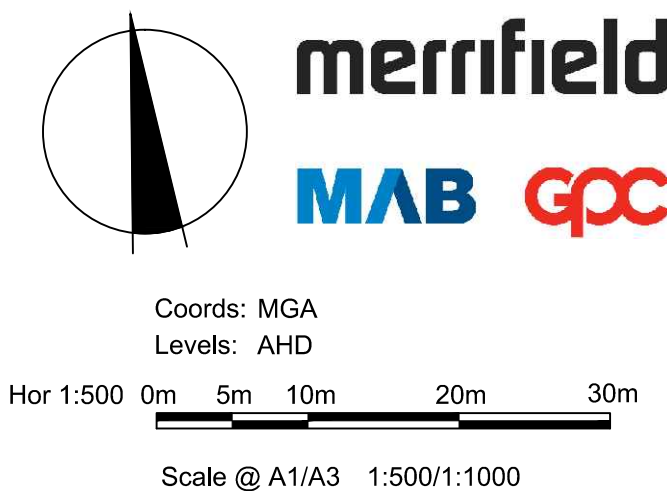

MERRIFIELD DEVELOPMENT
DONNYBROOK ROAD, MICKLEHAM
STAGE 2
SETOUT DETAILS

Drawing No. 11722SOP01 Rev 3
Sheet No. 04 AS CONSTRUCTED
© Dalton Consulting Engineers Pty Ltd
ABN 78 428 221 048



255 Whitehorse Road
PO Box 349
Bairwyn Victoria 3103
Australia
T 61 3 9888 6866
F 61 3 9888 6880
E info@dceprofile.com
W www.dceprofile.com

Drawing File: C:\Desig\merr\11722-MERRIFIELD - Precinct 1 - Stage 2\Acad\11722D01.dwg - 11722D01
Date/Time: Thu Jun 05, 2014 - 2:20 pm --byron.shade--

LINEMARKING LEGEND


- 600mm WIDE GIVE WAY HOLDING LINE
- 200mm WIDE GIVE WAY LINE
- 200mm WIDE CONTINUITY LINE
- 100mm WIDE BARRIER LINE
- RAISED REFLECTIVE PAVEMENT MARKERS (SPACED AT 6m c/c UNLESS NOTED OTHERWISE)
- DENOTES TACTILE GROUND INDICATORS IN ACCORDANCE WITH AS. 1428

NOTES:

- ALL WORKS TO BE IN ACCORDANCE WITH AS1742. ALL LINEMARKING AND SIGNAGE TO BE IN ACCORDANCE WITH VICROADS LINEMARKING AND TRAFFIC MANUALS.
- LINEMARKING SET-OUT SHALL BE INSPECTED AND APPROVED BEFORE FINAL LINEMARKING IS CARRIED OUT.
- ALL LINEMARKING SHALL BE PLACED WITH TWO COATS OF PAINT. ALL LINEMARKING TO BE DEGAUR OR SIMILAR APPROVED LONGLIFE MATERIAL.
- ANY OBSOLETE LINEMARKING IS TO BE REMOVED BY GRINDING, STRIPPING OR THE APPLICATION OF BITUMEN BINDER AND GRIT PRIOR TO "NEW" LINEMARKING BEING PLACED.
- ALL RADII ARE TO LIP OF CHANNEL OR LINE OF KERB. ALL LANE WIDTHS ARE TO LIP OF KERB & CHANNEL.
- RRPM'S TO BE PROVIDED IN ACCORDANCE WITH AS1742.

LINE MARKING:

L.L. = LANE LINE
G.L. = GIVE WAY LINES (STATCON)
C.L. = CONTINUITY LINE

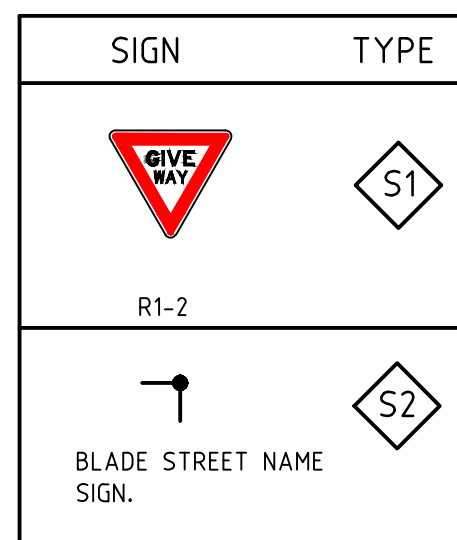


SIGNAGE LEGEND

N.T.S.


ALL SIGNS IN ACCORDANCE WITH AS1742

NOTE: CONCRETE JOINTS TO BE IN ACCORDANCE WITH G.A.A. STD DRG FIGURE007

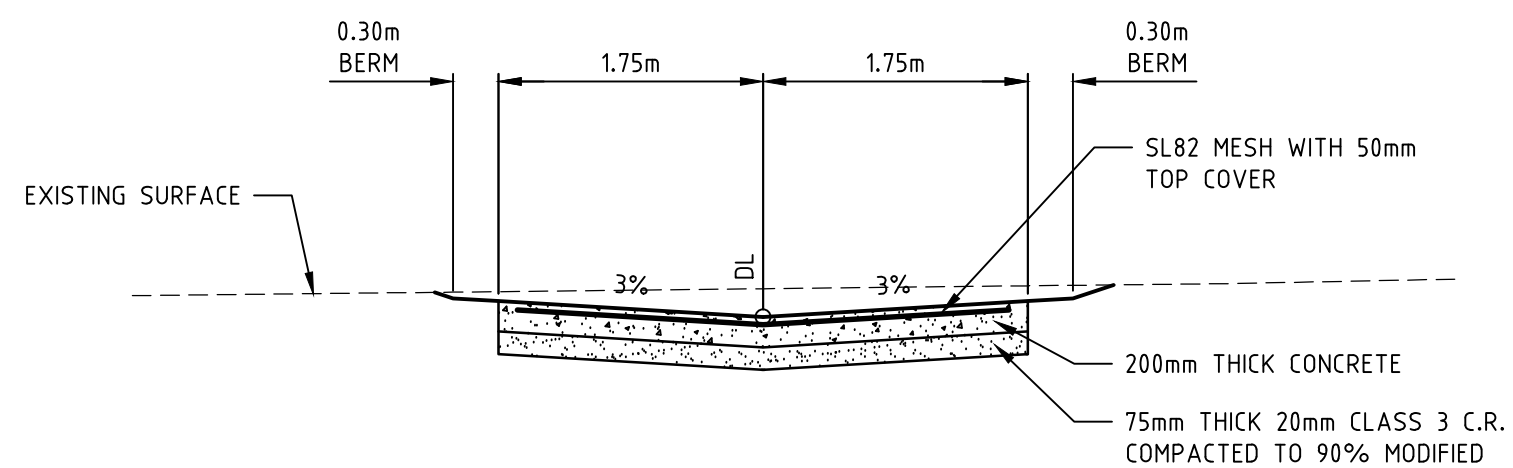


TYPICAL EXTENDED DRIVE

WARNING!
THE LOCATION OF EXISTING SERVICES SHOWN ON THESE PLANS MUST BE PROVEN ON SITE, THE APPROPRIATE AUTHORITY MUST BE CONTACTED AND THE SERVICES LOCATED PRIOR TO COMMENCEMENT OF ANY WORKS.

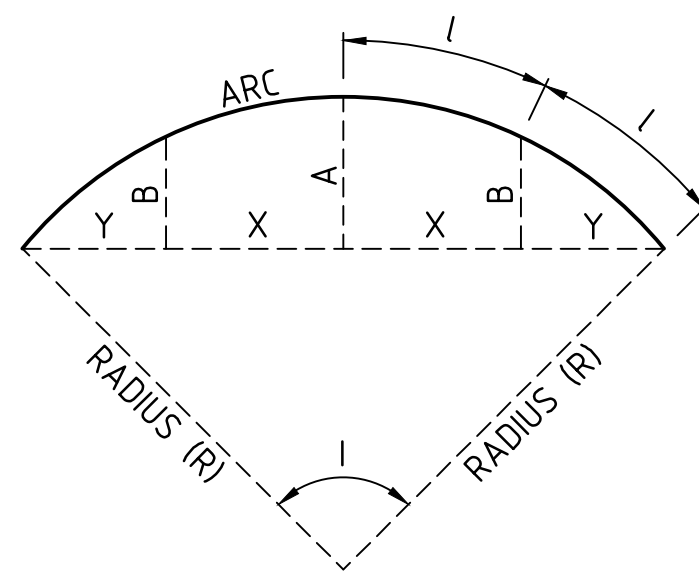

LIP SETOUT DETAIL

- LEGEND
- EXISTING WATER MAIN
 - EXISTING GAS MAIN
 - EXISTING ELECTRICAL CABLE
 - EXISTING SEWER MAIN & MANHOLE
 - EXISTING TELECOMM. CABLE AND PIT
 - EXISTING ELEC. POLE & O'HEAD LINES
 - EXISTING STORMWATER DRAIN & PIT
 - CONSTRUCTED PRE DEVELOPMENT
 - EXISTING TREES TO BE REMOVED
 - FINISHED SURFACE LEVEL
 - OPEN EARTH DRAIN (O.E.D.)
 - SEWER MAIN AND MANHOLE
 - STORMWATER DRAIN & PIT
 - SW DRAIN & PIT CONSTRUCTED IN PREVIOUS STAGES
 - PROPERTY INLETS
 - HOUSE DRAIN
 - GAS CONDUIT
 - WATER CONDUIT
 - RECYCLED WATER CONDUIT
 - TELECOMM. CONDUIT
 - PERMANENT SURVEY MARK
 - TEMPORARY BENCH MARK
 - OPTIC FIBRE
 - WATER
 - RECYCLED WATER
 - TELECOMMUNICATIONS
 - ELECTRICITY
 - GAS
 - STREET NAME SIGN
 - REGRADE LOT AT MIN 1 IN 150
 - ASPHALT PAVEMENT
 - CONC FOOTPATH / DRIVEWAY
 - LANDSCAPING
 - FILLING OVER 200mm
 - FINISHED SURFACE CONTOUR

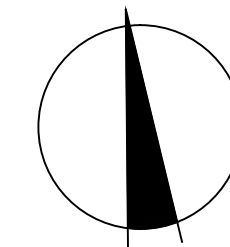

Coords: MGA
Levels: AHD
Hor 1:200 0m 2m 4m 8m 12m
Scale @ A1/A3 1:200/1:400

merrifield
MAB gpc

MERRIFIELD DEVELOPMENT
DONNYBROOK ROAD, MICKLEHAM
STAGE 2
INTERSECTION DETAILS
SHEET 1 OF 3

Drawing No. 11722ID01 Rev 3

Sheet No. 05 **AS CONSTRUCTED**
© Dalton Consulting Engineers Pty Ltd
ABN 78 428 221 048



255 Whitehorse Road
PO Box 349
Bairwyn Victoria 3103
Australia
T 61 3 9888 8888
F 61 3 9888 8880
E info@dceprofile.com
W www.dceprofile.com

REV	AMENDMENTS	DATE	APP'D.
3	AS CONSTRUCTED	05/06/14	TL
2	PLAN OF SUBDIVISION AMENDMENT	04/12/13	TL
1	ISSUED TO COUNCIL FOR FINAL APPROVAL	03/10/13	TL
0	CONSTRUCTION ISSUE	27/08/13	TL
B	ISSUED FOR TENDER	16/07/13	TL
A	ISSUED TO COUNCIL	27/06/13	TPD.

Drawn HT Date 10/10/12
Designed BG Date 10/10/12
AN 161111
Verified SL Date 03/06/13
AN 1061038
Audited RCM Date 22/08/13
AN 641537
Approved TL Date 27/08/13
AN 881882
Written dimensions to take precedence over scale.
Contractor shall check and verify all dimensions on site.
Discrepancies to be brought to the attention of the Superintendent.

Drawing File: C:\designdata\117201\11722-MERRIFIELD - Precinct 1 - Stage 2\Acad\VD\11722D01.dwg - 11722D02
Date/Time: Thu Jun 05, 2014 - 2:02pm --byron.shode--

ALIGNMENT A

POINT NO	EASTING	NORTHING	RL						
A1	315075.429	5843870.306	245.114						
A2	315058.366	5843857.000	245.271						
CURVE NO	I	RADIUS	ARC	A	B	X	Y	L	MID POINT RL
A1 - A2	90.000	15.300	24.033	4.481	3.317	5.855	4.964	6.008	245.208

ALIGNMENT B

POINT NO	EASTING	NORTHING	RL						
B1	315074.606	5843863.656	245.114						
B2	315065.015	5843856.177	245.271						
CURVE NO	I	RADIUS	ARC	A	B	X	Y	L	MID POINT RL
B1 - B2	90.000	8.600	13.509	2.519	1.864	3.291	2.790	3.377	245.197

ALIGNMENT C

POINT NO	EASTING	NORTHING	RL						
C1	315036.687	5843751.816	246.198						
C2	315046.278	5843759.295	246.011						
CURVE NO	I	RADIUS	ARC	A	B	X	Y	L	MID POINT RL
C1 - C2	90.000	8.600	13.509	2.519	1.864	3.291	2.790	3.377	246.097

ALIGNMENT D

POINT NO	EASTING	NORTHING	RL						
D1	315052.932	5843758.512	246.011						
D2	315045.336	5843747.105	246.105						
D3	315038.383	5843743.134	246.149						
D4	315034.114	5843736.722	246.190						
CURVE NO	I	RADIUS	ARC	A	B	X	Y	L	MID POINT RL
D1 - D2	53.212	15.300	14.209	1.620	1.210	3.521	3.332	3.552	246.062
D3 - D4	53.212	8.600	7.987	0.911	0.680	1.979	1.873	1.997	246.170

ALIGNMENT E

POINT NO	EASTING	NORTHING	RL						
E1	315027.464	5843737.540	246.190						
E2	315019.985	5843747.131	246.397						
CURVE NO	I	RADIUS	ARC	A	B	X	Y	L	MID POINT RL
E1 - E2	90.000	8.600	13.509	2.519	1.864	3.291	2.790	3.377	246.281

ALIGNMENT F

POINT NO	EASTING	NORTHING	RL						
F1	315033.167	5843725.398	246.378						
F2	315035.078	5843724.557	246.355						
F3	315037.623	5843724.242	246.392						
F4	315039.687	5843725.851	246.474						
F5	315046.336	5843725.029	246.432						
F6	315047.945	5843722.965	246.352						
F7	315050.490	5843722.650	246.318						
F8	315053.715	5843724.709	246.352						
F9	315054.436	5843726.953	246.416						
F10	315057.656	5843725.531	246.343						
F11	315057.600	5843725.359	246.337						
F12	315060.088	5843721.463	246.191						
F13	315067.034	5843720.604	246.190						
F14	315066.604	5843717.130	246.190						
F15	315059.905	5843717.959	246.186						
F16	315056.560	5843715.350	246.315						
F17	315056.468	5843714.606	246.339						
F18	315052.994	5843715.035	246.385						
F19	315053.240	5843717.020	246.325						
F20	315052.588	5843717.857	246.313						
F21	315051.751	5843717.204	246.345						
F22	315051.506	5843715.220	246.405						
F23	315048.032	5843715.649	246.451						
F24	315048.124	5843716.394	246.430						
F25	315047.020	5843719.106	246.371						
F26	315045.452	5843717.883	246.432						
F27	315038.803	5843718.706	246.499						
F28	315037.194	5843720.769	246.431						
F29	315034.648	5843721.084	246.394						
F30	315032.589	5843720.734	246.426						
CURVE NO	I	RADIUS	ARC	A	B	X	Y	L	MID POINT RL
F7 - F8	79.220	3.000	4.148	0.689	0.511	1.016	0.896	1.037	246.316
F11 - F12	100.780	3.000	5.277	1.087	0.802	1.277	1.034	1.319	246.254
F15 - F16	90.000	3.000	4.712	0.879	0.650	1.148	0.973	1.178	246.241
F19 - F20	90.000	0.750	1.178	0.220	0.163	0.287	0.243	0.295	246.312
F20 - F21	90.000	0.750	1.178	0.220	0.163	0.287	0.243	0.295	246.327
F24 - F25	58.424	3.000	3.059	0.382	0.285	0.757	0.708	0.765	246.391

ALIGNMENT G

POINT NO	EASTING	NORTHING	RL						
G1	315061.505	5843865.270	245.217						
G2	315061.287	5843866.384	245.248						
G3	315060.942	5843866.775	245.262						
G4	315057.989	5843868.646	245.358						
G5	315056.240	5843869.128	245.407						
G6	315054.042	5843867.769	245.496						
G7	315034.084	5843869.588	245.799						
G8	315032.116	5843871.318	245.771						
G9	315030.361	5843871.163	245.795						
G10	315029.814	5843871.608	245.786						
G11	315029.548	5843874.094	245.787						
G12	315029.996	5843874.644	245.795						
G13	315034.481	5843874.961	245.735						
G14	315037.335	5843877.590	245.773						
G15	315037.592	5843879.672	245.833						
G16	315041.066	5843879.243	245.771						
G17	315040.637	5843875.777	245.675						
G18	315041.289	5843874.940	245.643						
G19	315042.126	5843875.593	245.653						
G20	315042.555	5843879.058	245.753						
G21	315046.028	5843878.629	245.705						
G22	315045.901	5843877.601	245.673						
G23	315048.456	5843874.262	245.547						
G24	315051.308	5843873.802	245.504						
G25	315054.819	5843876.385	245.551						
G26	315054.960	5843877.524	245.587						
G27	315058.433	5843877.094	245.540						
G28	315058.149	5843874.792	245.476						
G29	315059.980	5843871.652	245.367						
G30	315063.167	5843869.518	245.260						
G31	315063.171	5843869.512	245.260						
G32	315064.994	5843868.345	245.200						
CURVE NO	I	RADIUS	ARC	A	B	X	Y	L	MID POINT RL
G3 - G4	32.475	6.250	3.542	0.249	0.187	0.883	0.865	0.886	245.310
G4 - G5	1.419	73.250	1.814	0.006	0.004	0.454	0.454	0.454	245.382
G6 - G7	16.135	71.400	20.107	0.707	0.530	5.023	4.998	5.027	245.648
G8 - G9	1.378	73.250	1.762	0.005	0.004	0.441	0.441	0.441	245.783
G9 - G10	89.612	0.500	0.782	0.145	0.108	0.191	0.162	0.196	245.793
G11 - G12	90.376	0.500	0.789	0.148	0.109	0.192	0.163	0.197	245.795
G12 - G13	3.358	76.750	4.498	0.033	0.025	1.124	1.124	1.124	245.765
G13 - G14	80.582	3.000	4.219	0.712	0.528	1.033	0.907	1.055	245.730
G17 - G18	90.000	0.750	1.178	0.220	0.163	0.287	0.243	0.295	245.658
G18 - G19	90.000	0.750	1.178	0.220	0.163	0.287	0.243	0.295	245.639
G22 - G23	88.958	3.000	4.658	0.859	0.636	1.135	0.967	1.164	245.600
G23 - G24	2.157	76.750	2.889	0.014	0.010	0.722	0.722	0.722	245.525
G24 - G25	93.198	3.000	4.880	0.939	0.694	1.187	0.993	1.220	245.500
G28 - G29	74.586	3.000	3.905	0.613	0.456	0.959	0.858	0.976	245.422
G29 - G30	22.688	9.750	3.861	0.190	0.143	0.964	0.954	0.965	245.314

3	AS CONSTRUCTED	05/06/14	TL
2	PLAN OF SUBDIVISION AMENDMENT	04/12/13	TL
1	ISSUED TO COUNCIL FOR FINAL APPROVAL	03/10/13	TL
0	CONSTRUCTION ISSUE	27/08/13	TL
B	ISSUED FOR TENDER	16/07/13	TL
A	ISSUED TO COUNCIL	27/06/13	TL
REV	AMENDMENTS	DATE	APP'D.

Drawn HT Date 10/10/12
Designed BG
Date 10/10/12
AN 16112
Verified SL
Date 03/06/13
AN 1061039
Audited RCM
Date 22/08/13
AN 641538
Approved TL
Date 27/08/13
AN 881883
Written dimensions to take precedence over scale.
Contractor shall check and verify all dimensions on site.
Discrepancies to be brought to the attention of the Superintendent.



Coords: MGA
Levels: AHD

Scale @ A1/A3

MERRIFIELD DEVELOPMENT
DONNYBROOK ROAD, MICKLEHAM
STAGE 2
INTERSECTION DETAILS
SHEET 2 OF 3

Drawing No. 11722ID02 Rev 3
Sheet No. 06 AS CONSTRUCTED


© Dalton Consulting Engineers Pty Ltd
ABN 78 428 221 048




255 Whitehorse Road
PO Box 349
Bairwyn Victoria 3103
Australia

T 61 3 9888 6866
F 61 3 9888 6880
E info@dceprofile.com
W www.dceprofile.com


Drawing File: C:\Design\1172\11722-MERRIFIELD - Precinct 1 - Stage 2\Acad\VD\11722D01.dwg - 11722D01
Date/Time: Thu Jan 05, 2014 - 2:02pm - Byronshade--

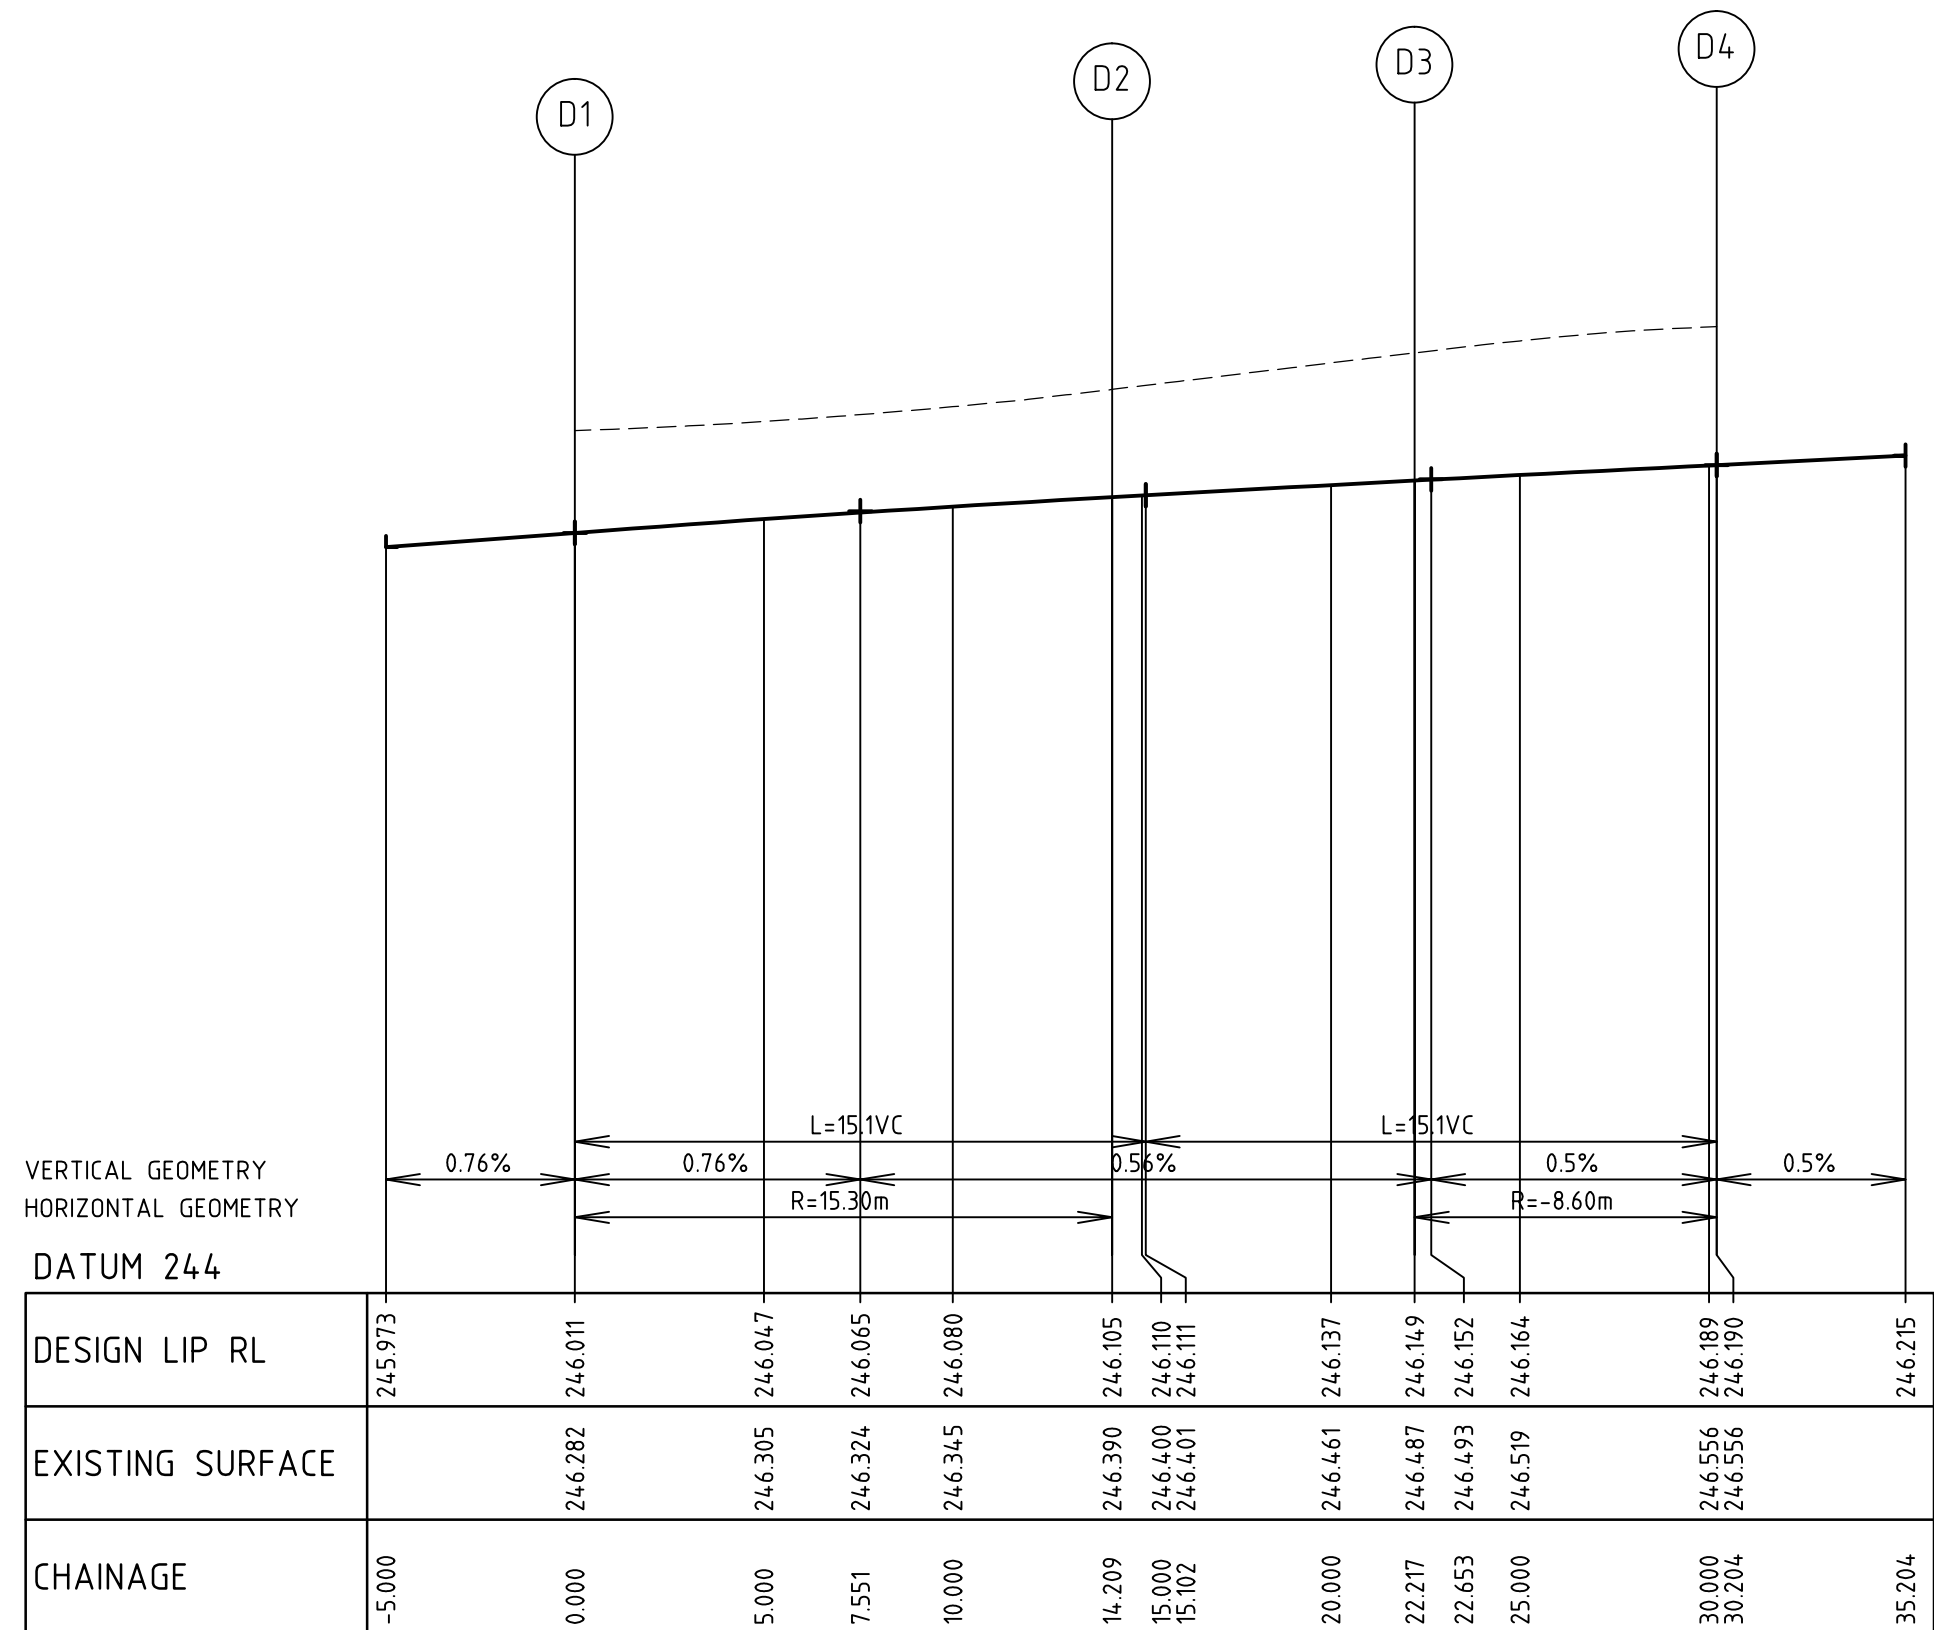


LIP PROFILE D
REFER TO DRG. NO. 11722ID01

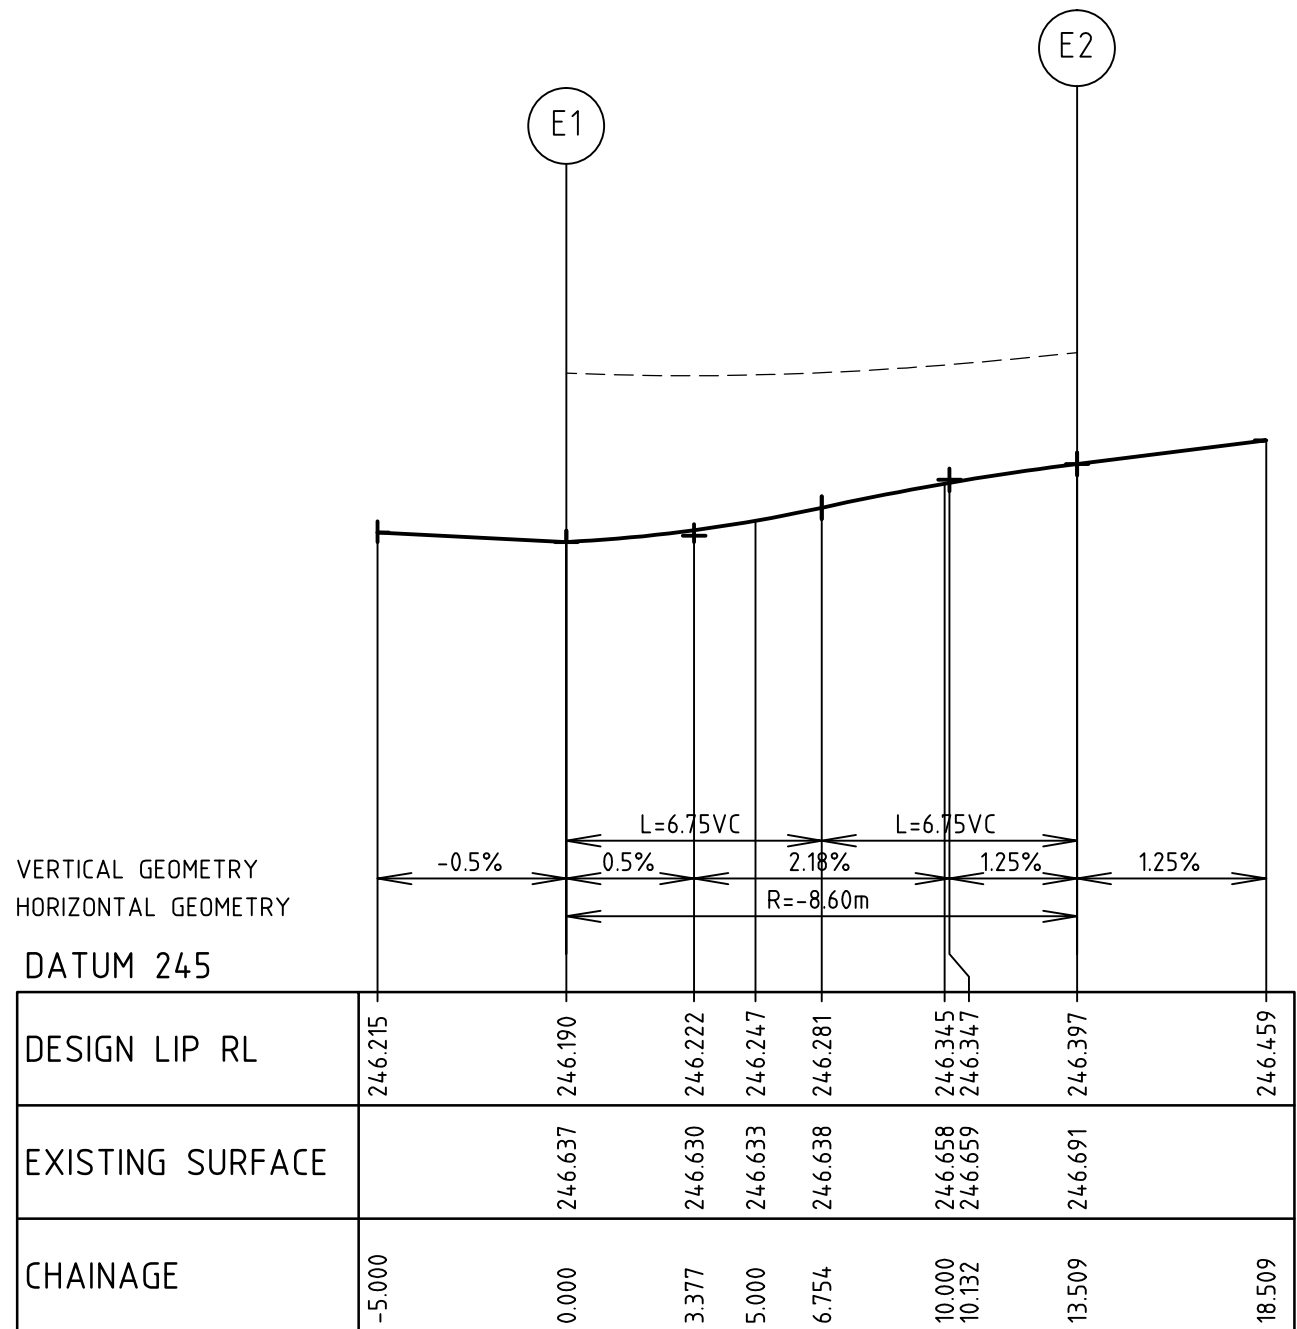


LIP PROFILE E
REFER TO DRG. NO. 11722ID01

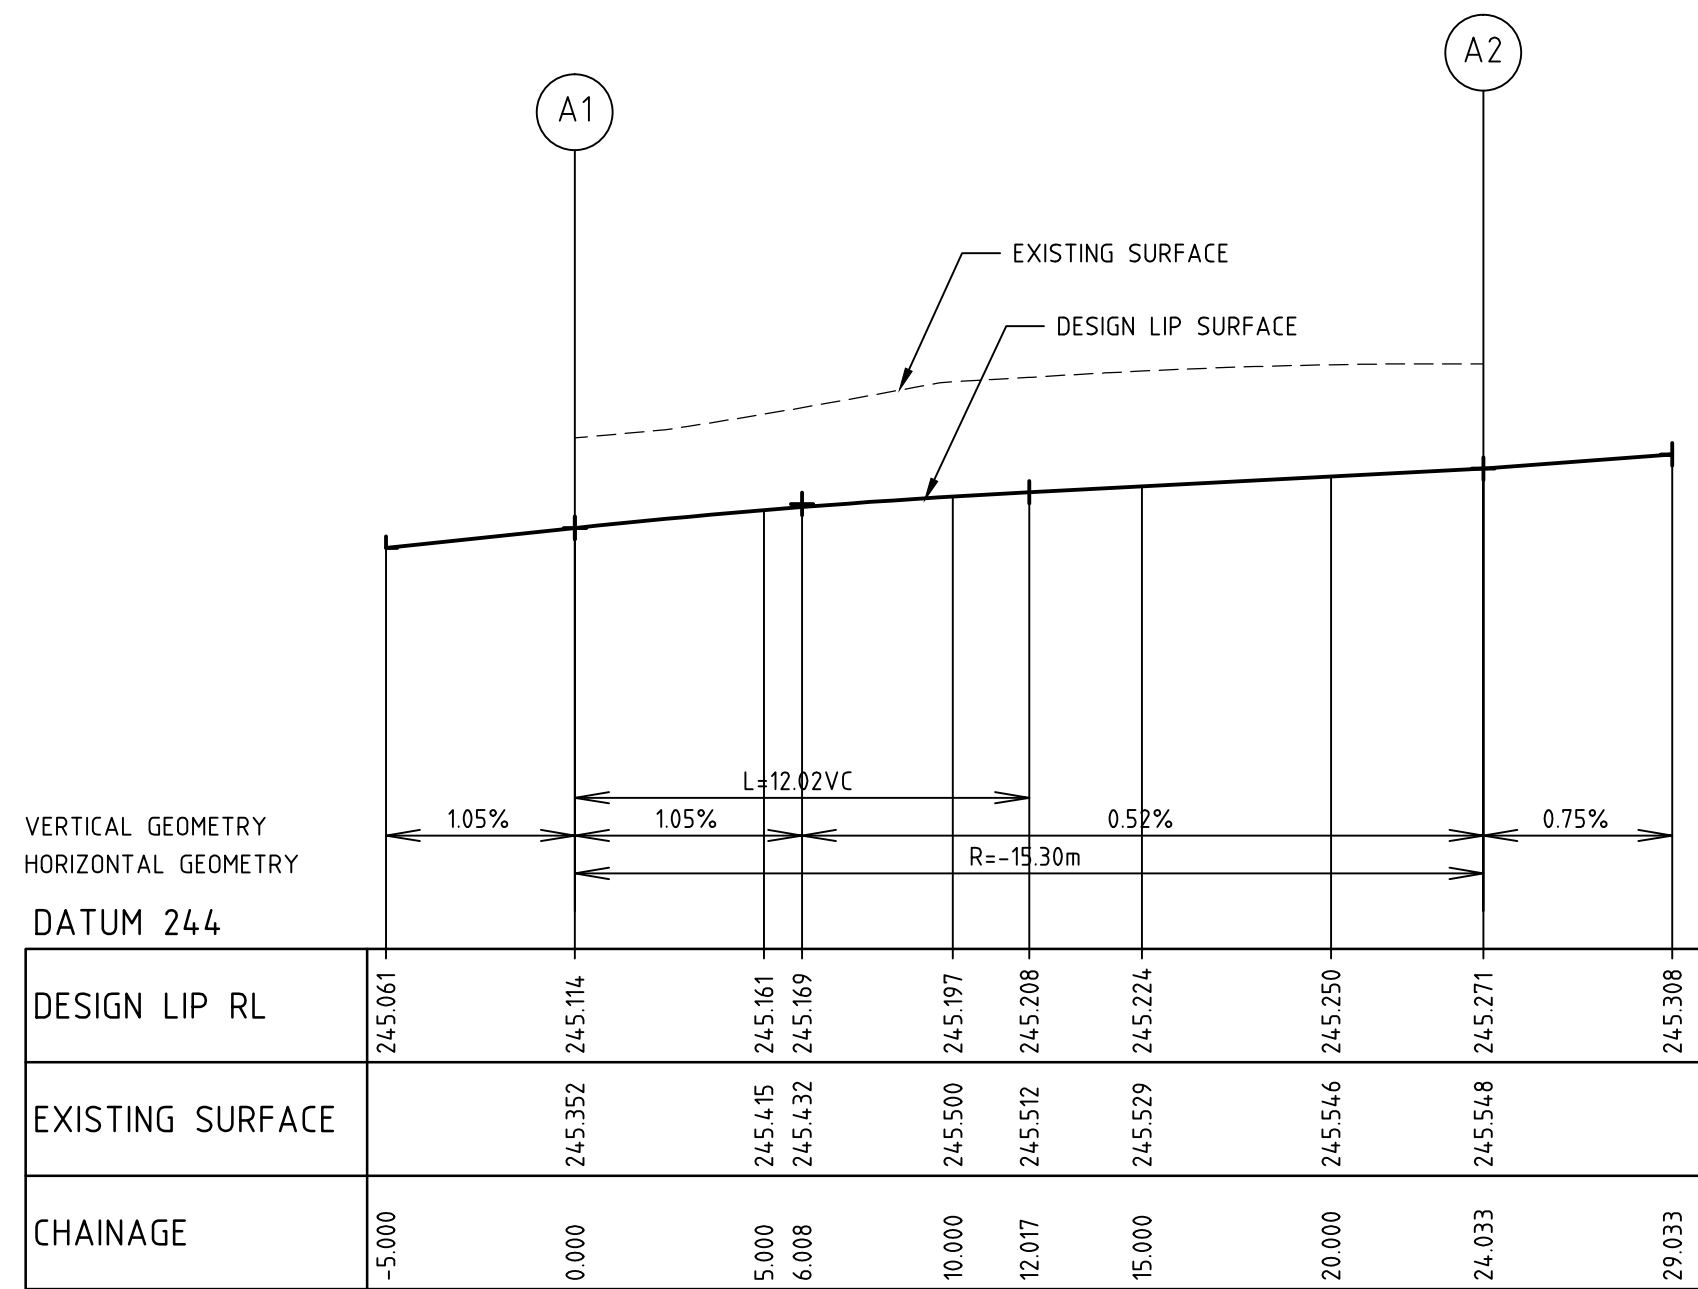

LIP PROFILE A
REFER TO DRG. NO. 11722ID01

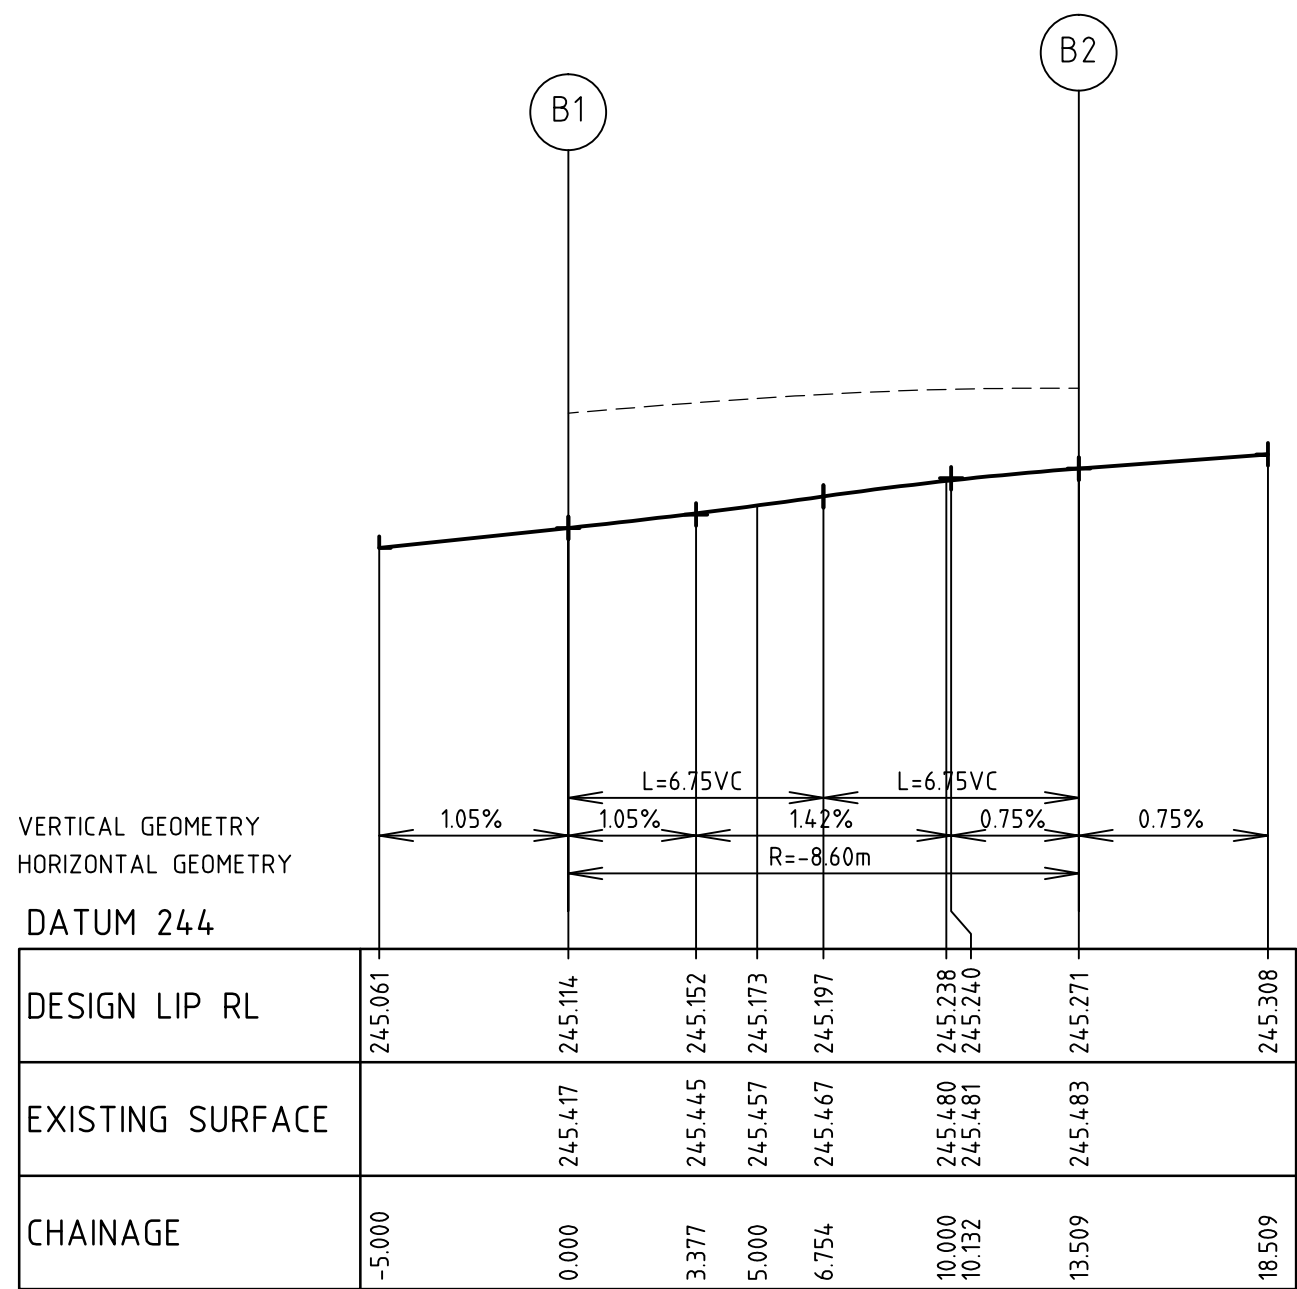

LIP PROFILE B
REFER TO DRG. NO. 11722ID01

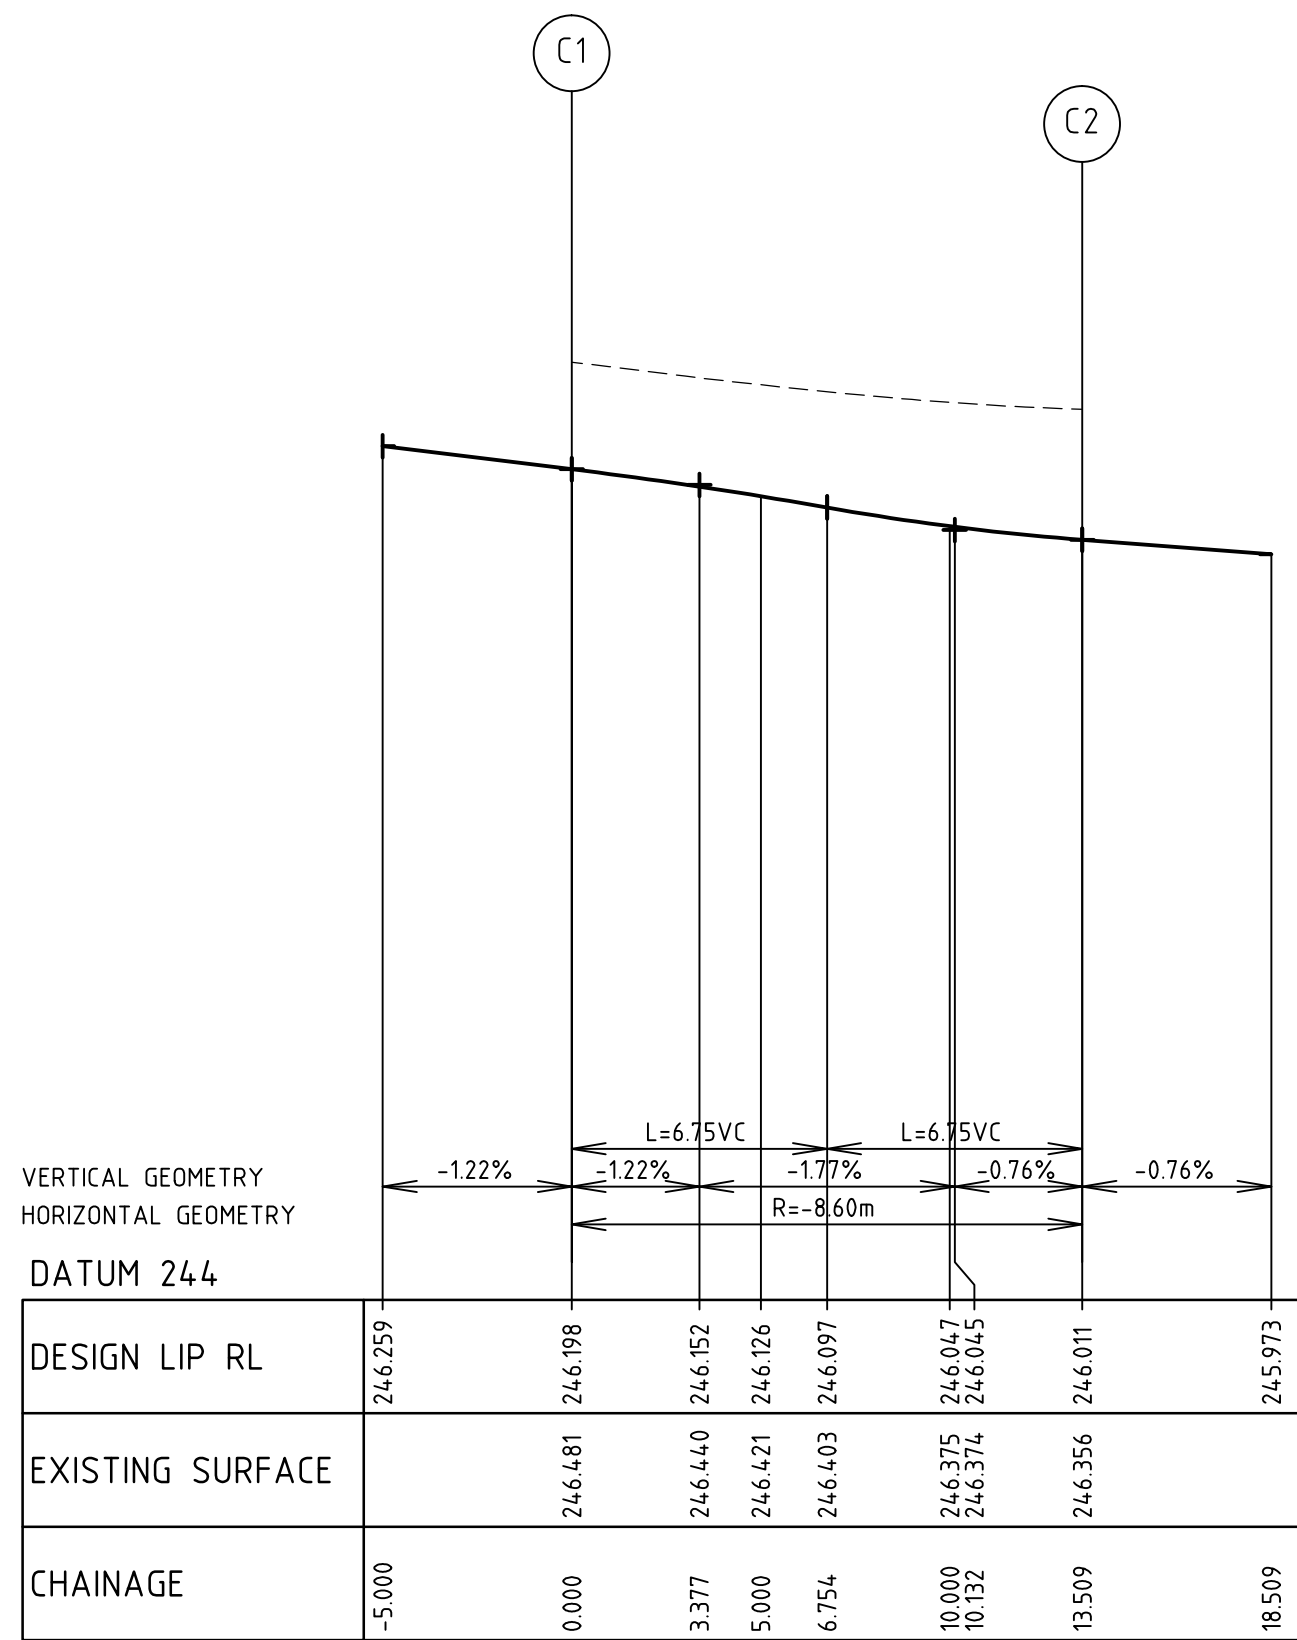

LIP PROFILE C
REFER TO DRG. NO. 11722ID01

REV	AMENDMENTS	DATE	APP'D.
3	AS CONSTRUCTED	05/06/14	TL
2	PLAN OF SUBDIVISION AMENDMENT	04/12/13	TL
1	ISSUED TO COUNCIL FOR FINAL APPROVAL	03/10/13	TL
0	CONSTRUCTION ISSUE	27/08/13	TL
B	ISSUED FOR TENDER	16/07/13	TL
A	ISSUED TO COUNCIL	27/06/13	TL

Drawn HT Date 10/10/12
Designed BG
Date 10/10/12
AN 161113
Verified SL
Date 03/06/13
AN 1061040
Audited RCM
Date 22/08/13
AN 641539
Approved TL
Date 27/08/13
AN 881884
Written dimensions to take precedence over scale.
Contractor shall check and verify all dimensions on site.
Discrepancies to be brought to the attention of the Superintendent.

merrifield
MAB GPC

MERRIFIELD DEVELOPMENT
DONNYBROOK ROAD, MICKLEHAM
STAGE 2
INTERSECTION DETAILS
SHEET 3 OF 3
Drawing No. 11722ID03 Rev 3
Sheet No. 07 AS CONSTRUCTED
© Dalton Consulting Engineers Pty Ltd
ABN 78 428 221 048


DCE
dalton consulting engineers

255 Whitehorse Road
PO Box 349
Bairwyn Victoria 3103
Australia
T 61 3 9888 6866
F 61 3 9888 6880
E info@dceprofile.com
W www.dceprofile.com

Coords: MGA
Levels: AHD
Hor 1:200 0m 2m 4m 8m 12m
Ver 1:20 0m 0.2m 0.4m 0.8m 1.2m
Scale @ A1/A3 1:200/1:400

REV	AMENDMENTS	DATE	APP'D.
2	AS CONSTRUCTED	05/06/14	TL
1	PLAN OF SUBDIVISION AMENDMENT	04/12/13	TL
0	CONSTRUCTION ISSUE	27/08/13	TL
B	ISSUED FOR TENDER	16/07/13	TL
A	ISSUED TO COUNCIL	27/06/13	TL

Drawn HT Date 10/10/12
Designed BG Date 10/10/12
AN 61114
Verified SL Date 03/06/13
AN 1061041
Audited RCM Date 22/08/13
AN 641540
Approved TL Date 27/08/13
AN 881885
Written dimensions to take precedence over scale.
Contractor shall check and verify all dimensions on site.
Discrepancies to be brought to the attention of the Superintendent.

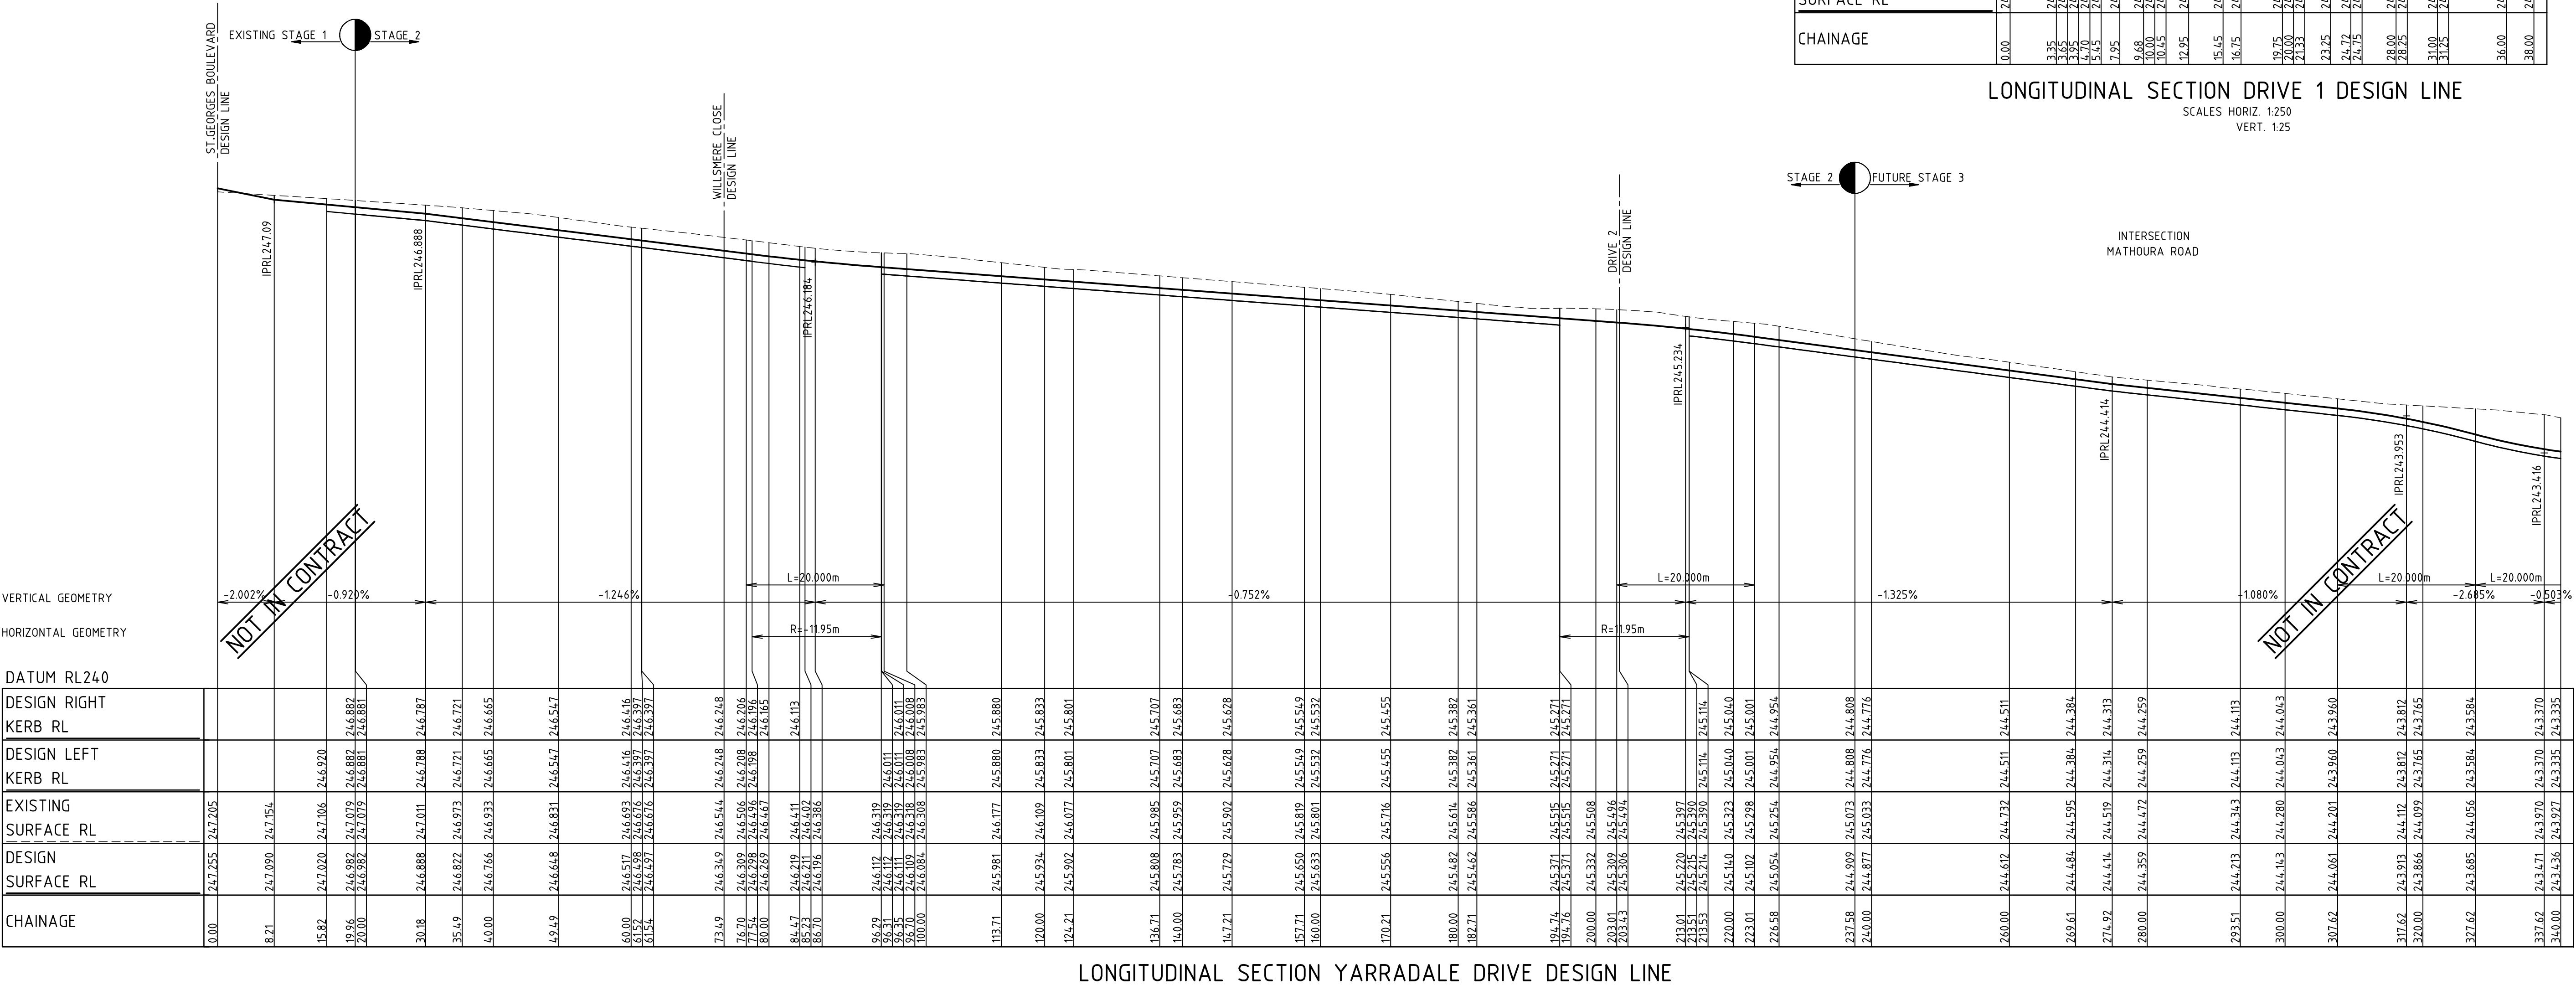

MERRIFIELD DEVELOPMENT
DONNYBROOK ROAD, MICKLEHAM
STAGE 2
LONGITUDINAL SECTIONS
SHEET 1 OF 2
Drawing No. 11722LS01 Rev 2
Sheet No. 08 AS CONSTRUCTED
© Dalton Consulting Engineers Pty Ltd
ABN 78 428 221 048

DCE
dalton consulting engineers
255 Whitehorse Road
PO Box 349
Bairwyn Victoria 3103
Australia
T 61 3 9888 6866
F 61 3 9888 6880
E info@dceprofile.com
W www.dceprofile.com


Coords: MGA
Levels: AHD
Hor 1:500 0m 5m 10m 20m 30m
Ver 1:50 0m 0.5m 1m 2m 3m
Scale @ A1/A3 1:500/1:1000



VERT. 1:25


HORIZONTAL GEOMETRY[illegible]

Drawn HT Date 10/10/12
Designed BG
Date 10/10/12
AN 161116
Verified SL
Date 03/06/13
AN 1061042
Audited RCM
Date 22/08/13
AN 641541
Approved TL
Date 27/08/13
AN 881886
Written dimensions to take precedence over scale.
Contractor shall check and verify all dimensions on site.
Discrepancies to be brought to the attention of the Superintendent.

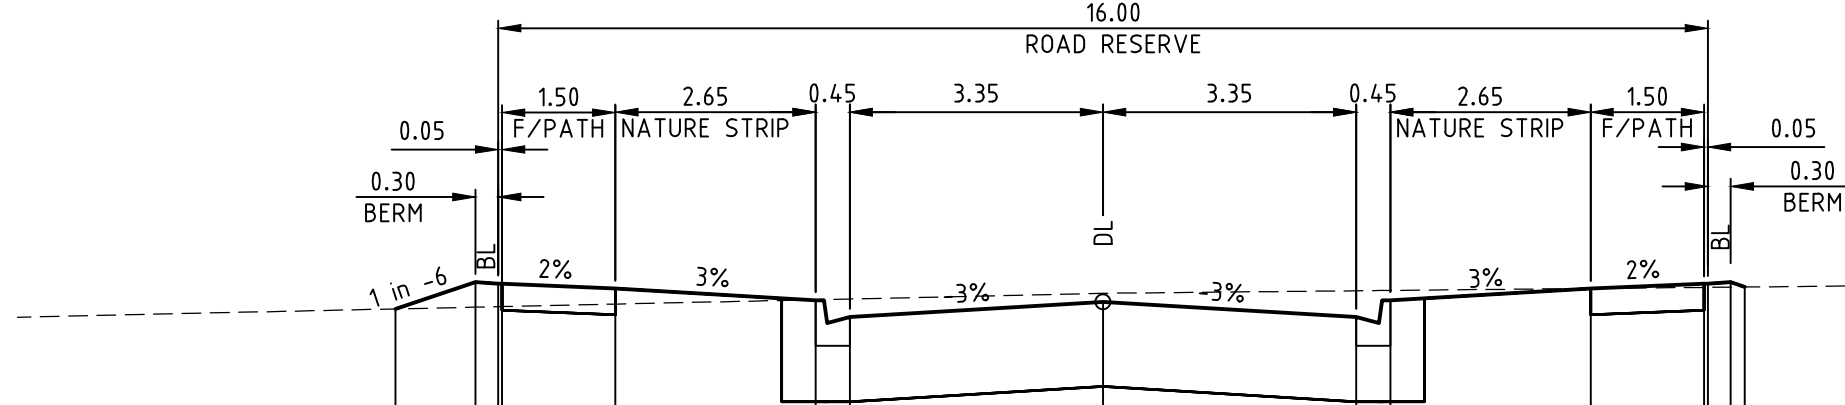


DATUM RL245.000		
DESIGN SURFACE	EXISTING SURFACE	OFFSET
-3.358	246.827	246.827
-8.300	246.838	246.838
-8.300	246.846	246.846
-8.300	246.851	246.851
-6.450	246.858	246.858
-3.800	246.887	246.887
-3.350	246.892	246.892
0.000	246.929	246.929
3.350	246.946	246.946
3.800	246.958	246.958
6.450	246.961	246.962
7.950	246.969	246.972
8.300	246.971	246.971
8.300	246.971	246.971

CH 62.692

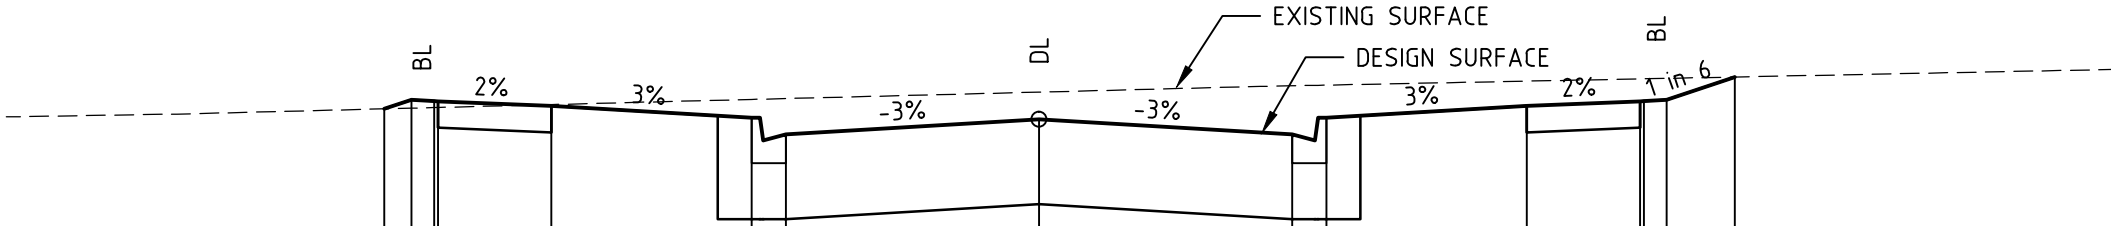

DATUM RL245.000		
DESIGN SURFACE	EXISTING SURFACE	OFFSET
-8.660	246.642	246.642
-8.300	246.646	246.646
-8.300	246.651	246.651
-6.450	246.657	246.661
-3.800	246.704	246.682
-3.350	246.711	246.672
0.000	246.752	246.672
3.350	246.794	246.672
3.800	246.799	246.682
6.450	246.895	246.661
7.950	246.884	246.691
8.300	246.883	246.692
8.300	246.883	246.692
9.203	246.892	246.692


CH 40.154

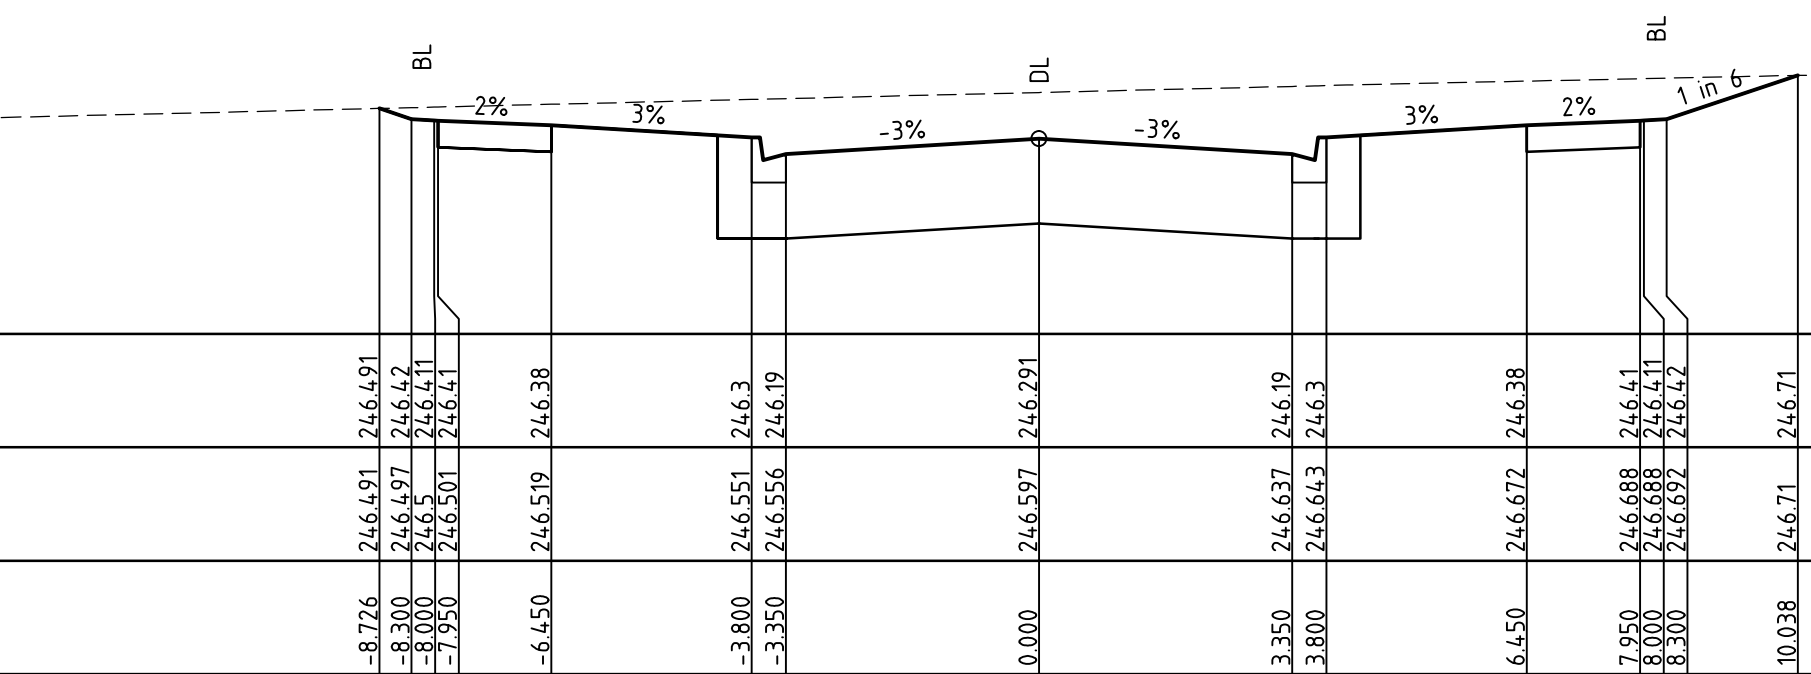

DATUM RL245.000		
DESIGN SURFACE	EXISTING SURFACE	OFFSET
-8.726	246.491	246.491
-8.300	246.497	246.492
-8.300	246.501	246.491
-6.450	246.519	246.438
-3.800	246.551	246.43
-3.350	246.556	246.19
0.000	246.597	246.291
3.350	246.637	246.19
3.800	246.643	246.3
6.450	246.672	246.38
7.950	246.688	246.441
8.300	246.692	246.42
8.300	246.692	246.42
10.038	246.71	246.71


CH 11.950

WILLSMERE WAY

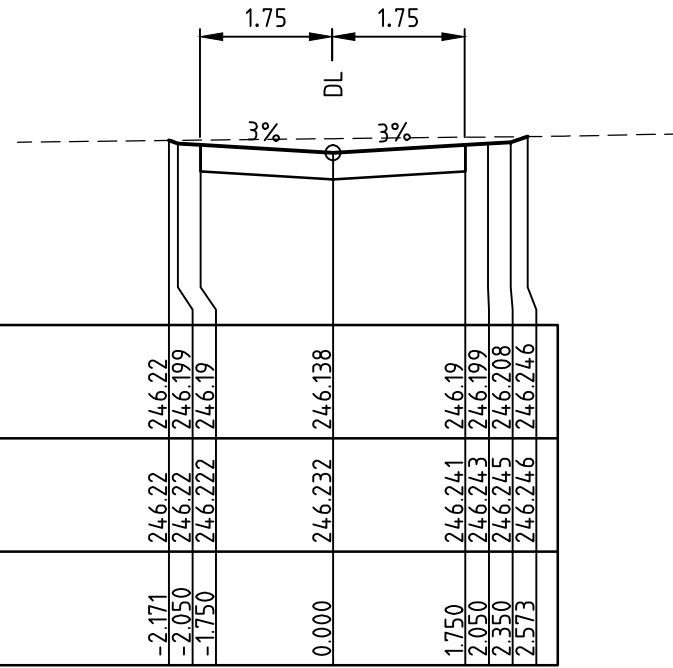


DATUM RL245.000		
DESIGN SURFACE	EXISTING SURFACE	OFFSET
-2.471	246.22	246.22
-2.471	246.22	246.22
-2.471	246.22	246.22
0.000	246.237	246.138
1.750	246.241	246.19
2.050	246.243	246.19
2.350	246.245	246.19
2.350	246.245	246.19
2.350	246.245	246.19

CH 38.000

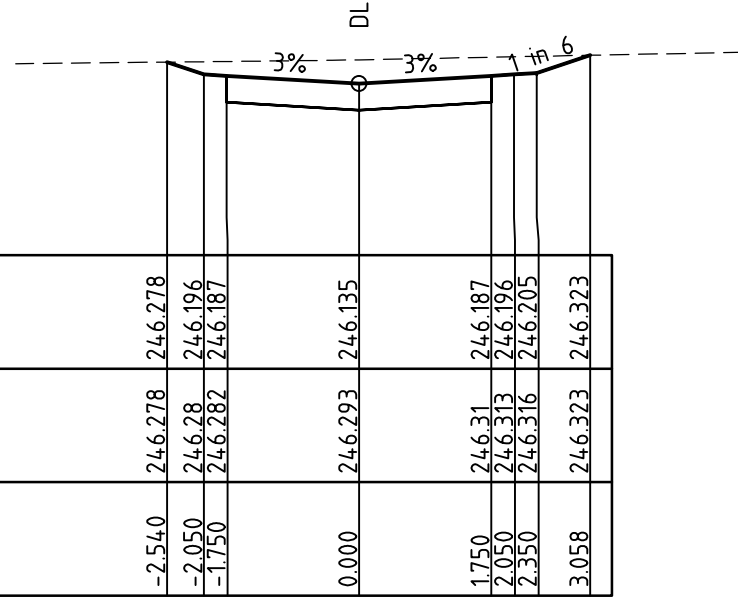


DATUM RL245.000		
DESIGN SURFACE	EXISTING SURFACE	OFFSET
-2.510	246.278	246.278
-2.450	246.28	246.196
-1.750	246.282	246.187
0.000	246.293	246.135
1.750	246.31	246.187
2.050	246.313	246.196
2.350	246.316	246.205
2.350	246.316	246.205
3.058	246.323	246.323

CH 31.250

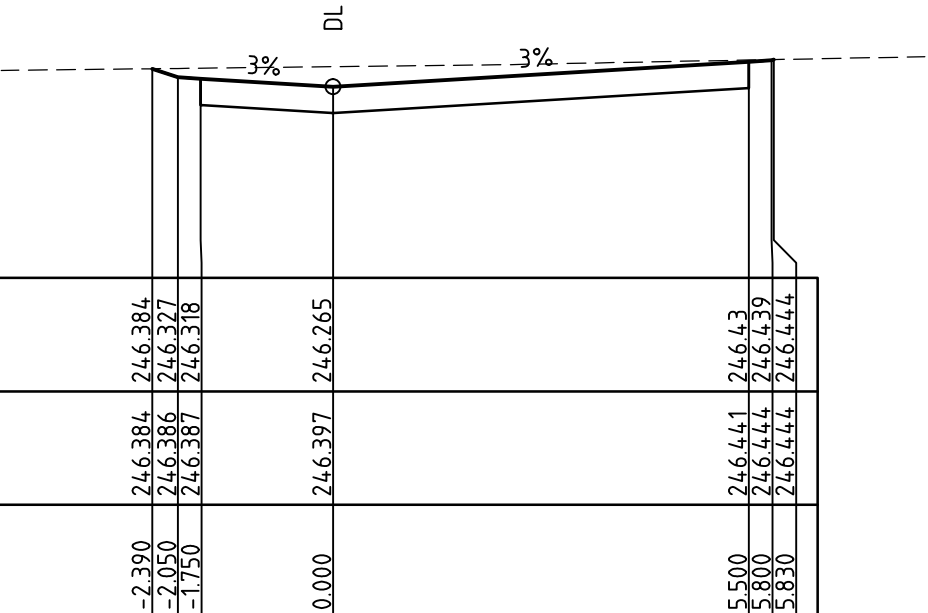


DATUM RL245.000		
DESIGN SURFACE	EXISTING SURFACE	OFFSET
-2.390	246.384	246.384
-2.050	246.386	246.327
-1.750	246.387	246.318
0.000	246.397	246.265
5.500	246.411	246.413
5.800	246.414	246.439
5.830	246.414	246.444
5.830	246.414	246.444

CH 21.330

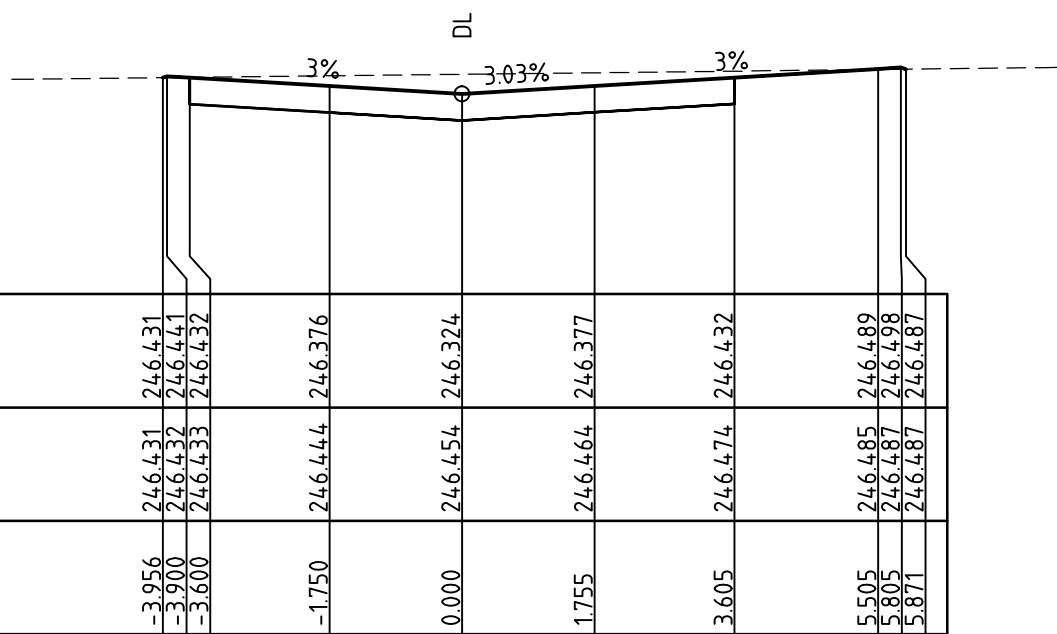

DATUM RL245.000		
DESIGN SURFACE	EXISTING SURFACE	OFFSET
-3.956	246.431	246.431
-3.900	246.431	246.431
-3.600	246.433	246.432
-1.750	246.444	246.376
0.000	246.454	246.374
1.755	246.464	246.377
3.605	246.474	246.432
5.505	246.485	246.489
5.805	246.487	246.498
5.831	246.487	246.487


CH 16.915

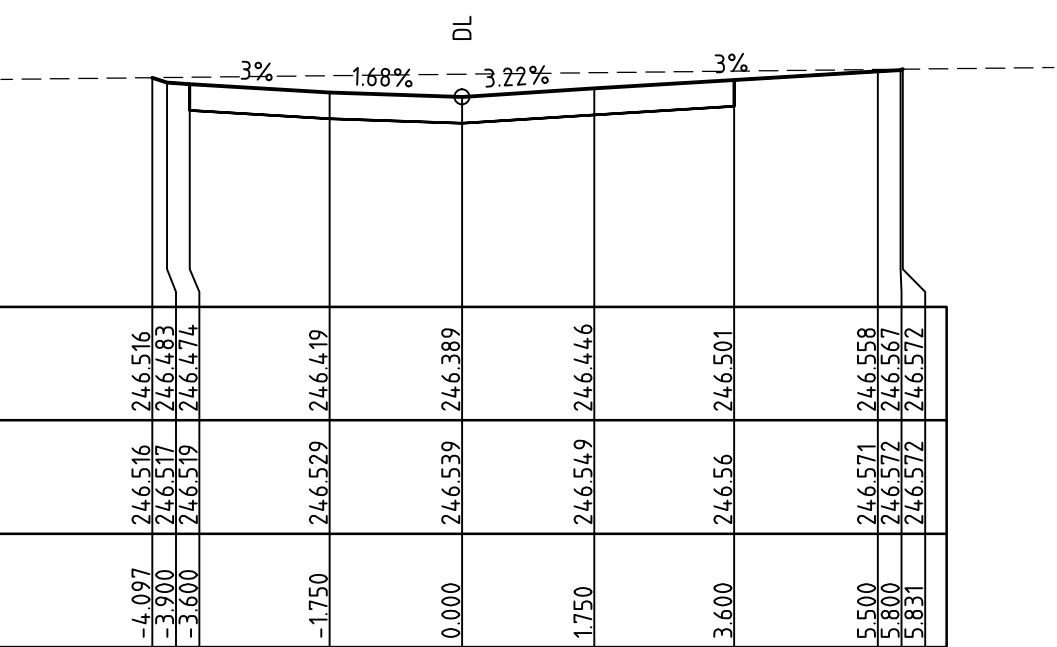

DATUM RL245.000		
DESIGN SURFACE	EXISTING SURFACE	OFFSET
-6.037	246.516	246.516
-3.900	246.517	246.483
-3.600	246.519	246.474
-1.750	246.529	246.419
0.000	246.539	246.389
1.750	246.549	246.446
3.600	246.56	246.501
5.500	246.571	246.558
5.800	246.572	246.569
5.831	246.572	246.572


CH 10.215

DRIVE 1

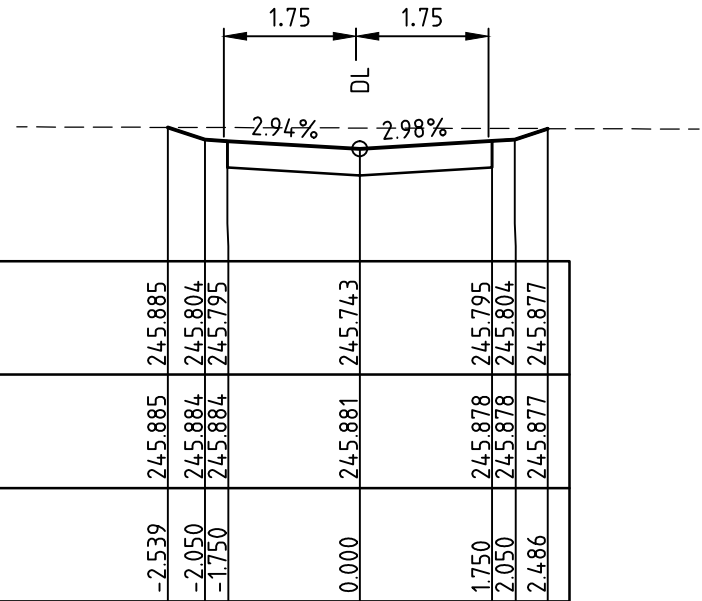


DATUM RL245.000		
DESIGN SURFACE	EXISTING SURFACE	OFFSET
-2.539	245.885	245.885
-2.050	245.886	245.894
-1.750	245.886	245.894
0.000	245.881	245.743
1.750	245.878	245.795
2.050	245.878	245.804
2.486	245.877	245.877

CH 38.242

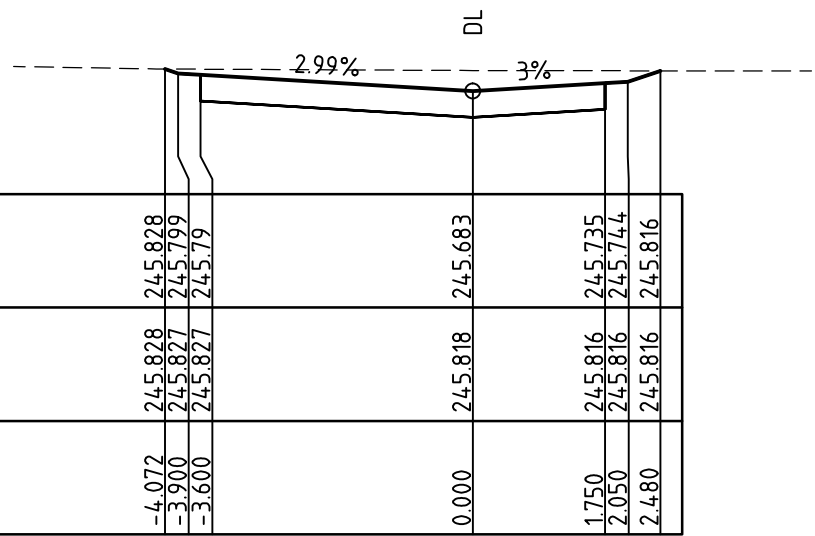


DATUM RL245.000		
DESIGN SURFACE	EXISTING SURFACE	OFFSET
-4.072	245.828	245.828
-3.000	245.827	245.799
-3.600	245.827	245.79
0.000	245.818	245.683
1.750	245.816	245.735
2.050	245.816	245.744
2.480	245.816	245.816

CH 33.864

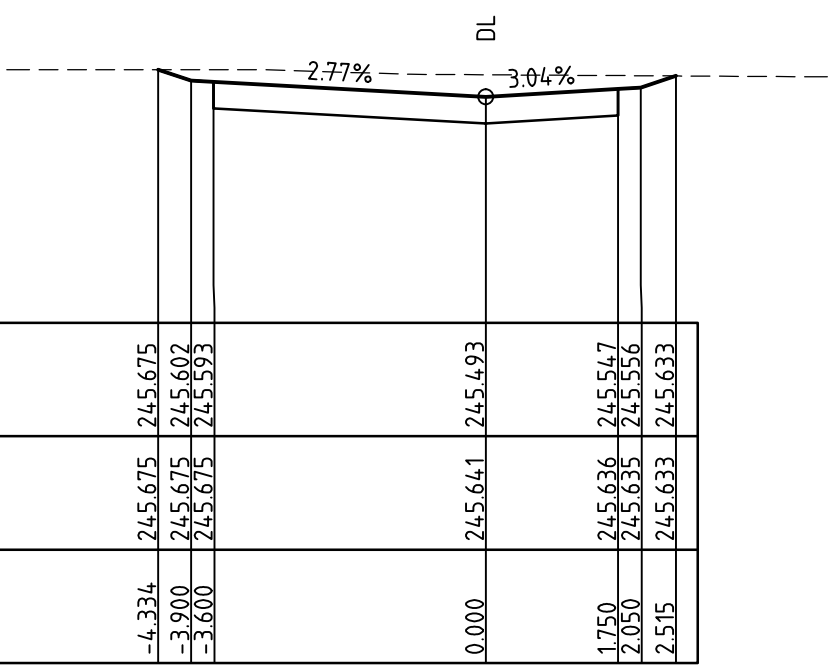


DATUM RL244.000		
DESIGN SURFACE	EXISTING SURFACE	OFFSET
-6.334	245.675	245.675
-3.700	245.675	245.693
-3.600	245.675	245.693
0.000	245.641	245.493
1.750	245.636	245.547
2.050	245.635	245.556
2.515	245.633	245.633

CH 20.172

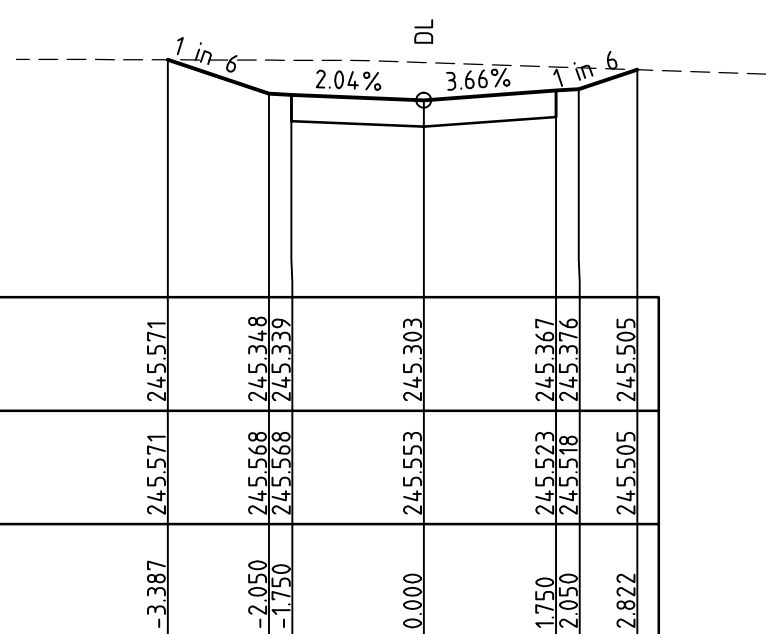

DATUM RL244.000		
DESIGN SURFACE	EXISTING SURFACE	OFFSET
-3.387	245.571	245.571
-2.050	245.568	245.549
-1.750	245.568	245.549
0.000	245.553	245.303
1.750	245.593	245.367
2.050	245.518	245.376
2.872	245.595	245.595

CH 8.778

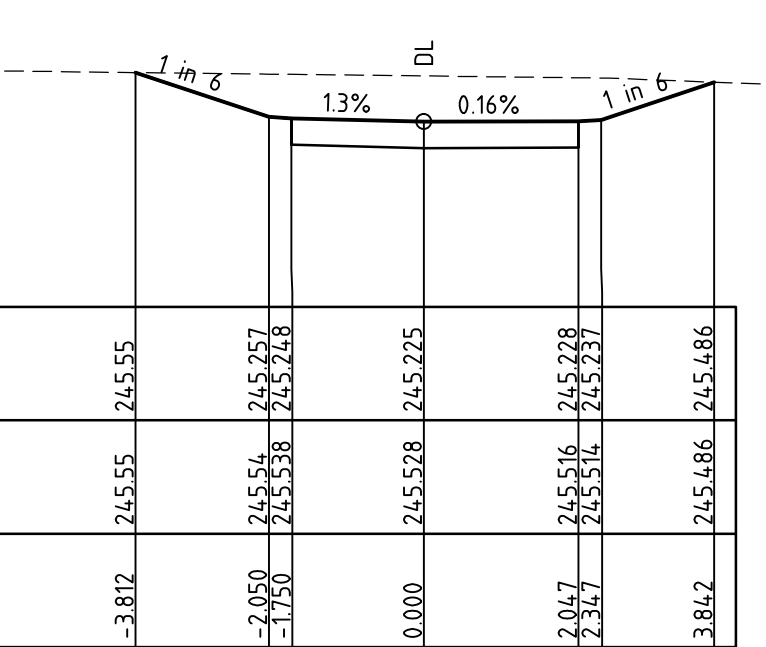

DATUM RL244.000		
DESIGN SURFACE	EXISTING SURFACE	OFFSET
-3.812	245.55	245.55
-2.050	245.54	245.257
-1.750	245.538	245.246
0.000	245.528	245.225
2.047	245.516	245.228
2.347	245.514	245.227
3.812	245.486	245.486

CH 4.608

DRIVE 2

REV	AMENDMENTS	DATE	APP'D.
3	AS CONSTRUCTED	05/06/14	TL
2	PLAN OF SUBDIVISION AMENDMENT	04/12/13	TL
1	ISSUED TO COUNCIL FOR FINAL APPROVAL	03/10/13	TL
0	CONSTRUCTION ISSUE	27/08/13	TL
B	ISSUED FOR TENDER	16/07/13	TL
A	ISSUED TO COUNCIL	27/06/13	TL

Drawn HT Date 10/10/12
Designed BG Date 10/10/12
AN 161118
Verified sL Date 03/06/13
AN 1061045
Audited RCM Date 22/08/13
AN 641544
Approved TL Date 27/08/13
AN 881889
Written dimensions to take precedence over scale.
Contractor shall check and verify all dimensions on site.
Discrepancies to be brought to the attention of the Superintendent.




Coords: MGA
Levels: AHD
Hor 1:200 0m 2m 4m 8m 12m
Ver 1:100 0m 1m 2m 4m 6m
Scale @ A1/A3 1:200/1:400

MERRIFIELD DEVELOPMENT
DONNYBROOK ROAD, MICKLEHAM
STAGE 2
CROSS SECTIONS
SHEET 3 OF 3
Drawing No. 11722XS03 Rev 3
Sheet No. 12 **AS CONSTRUCTED**
© Dalton Consulting Engineers Pty Ltd
ABN 78 428 221 048



255 Whitehorse Road
PO Box 349
Bairwyn Victoria 3103
Australia
T 61 3 9888 6866
F 61 3 9888 6880
E info@dceprofile.com
W www.dceprofile.com

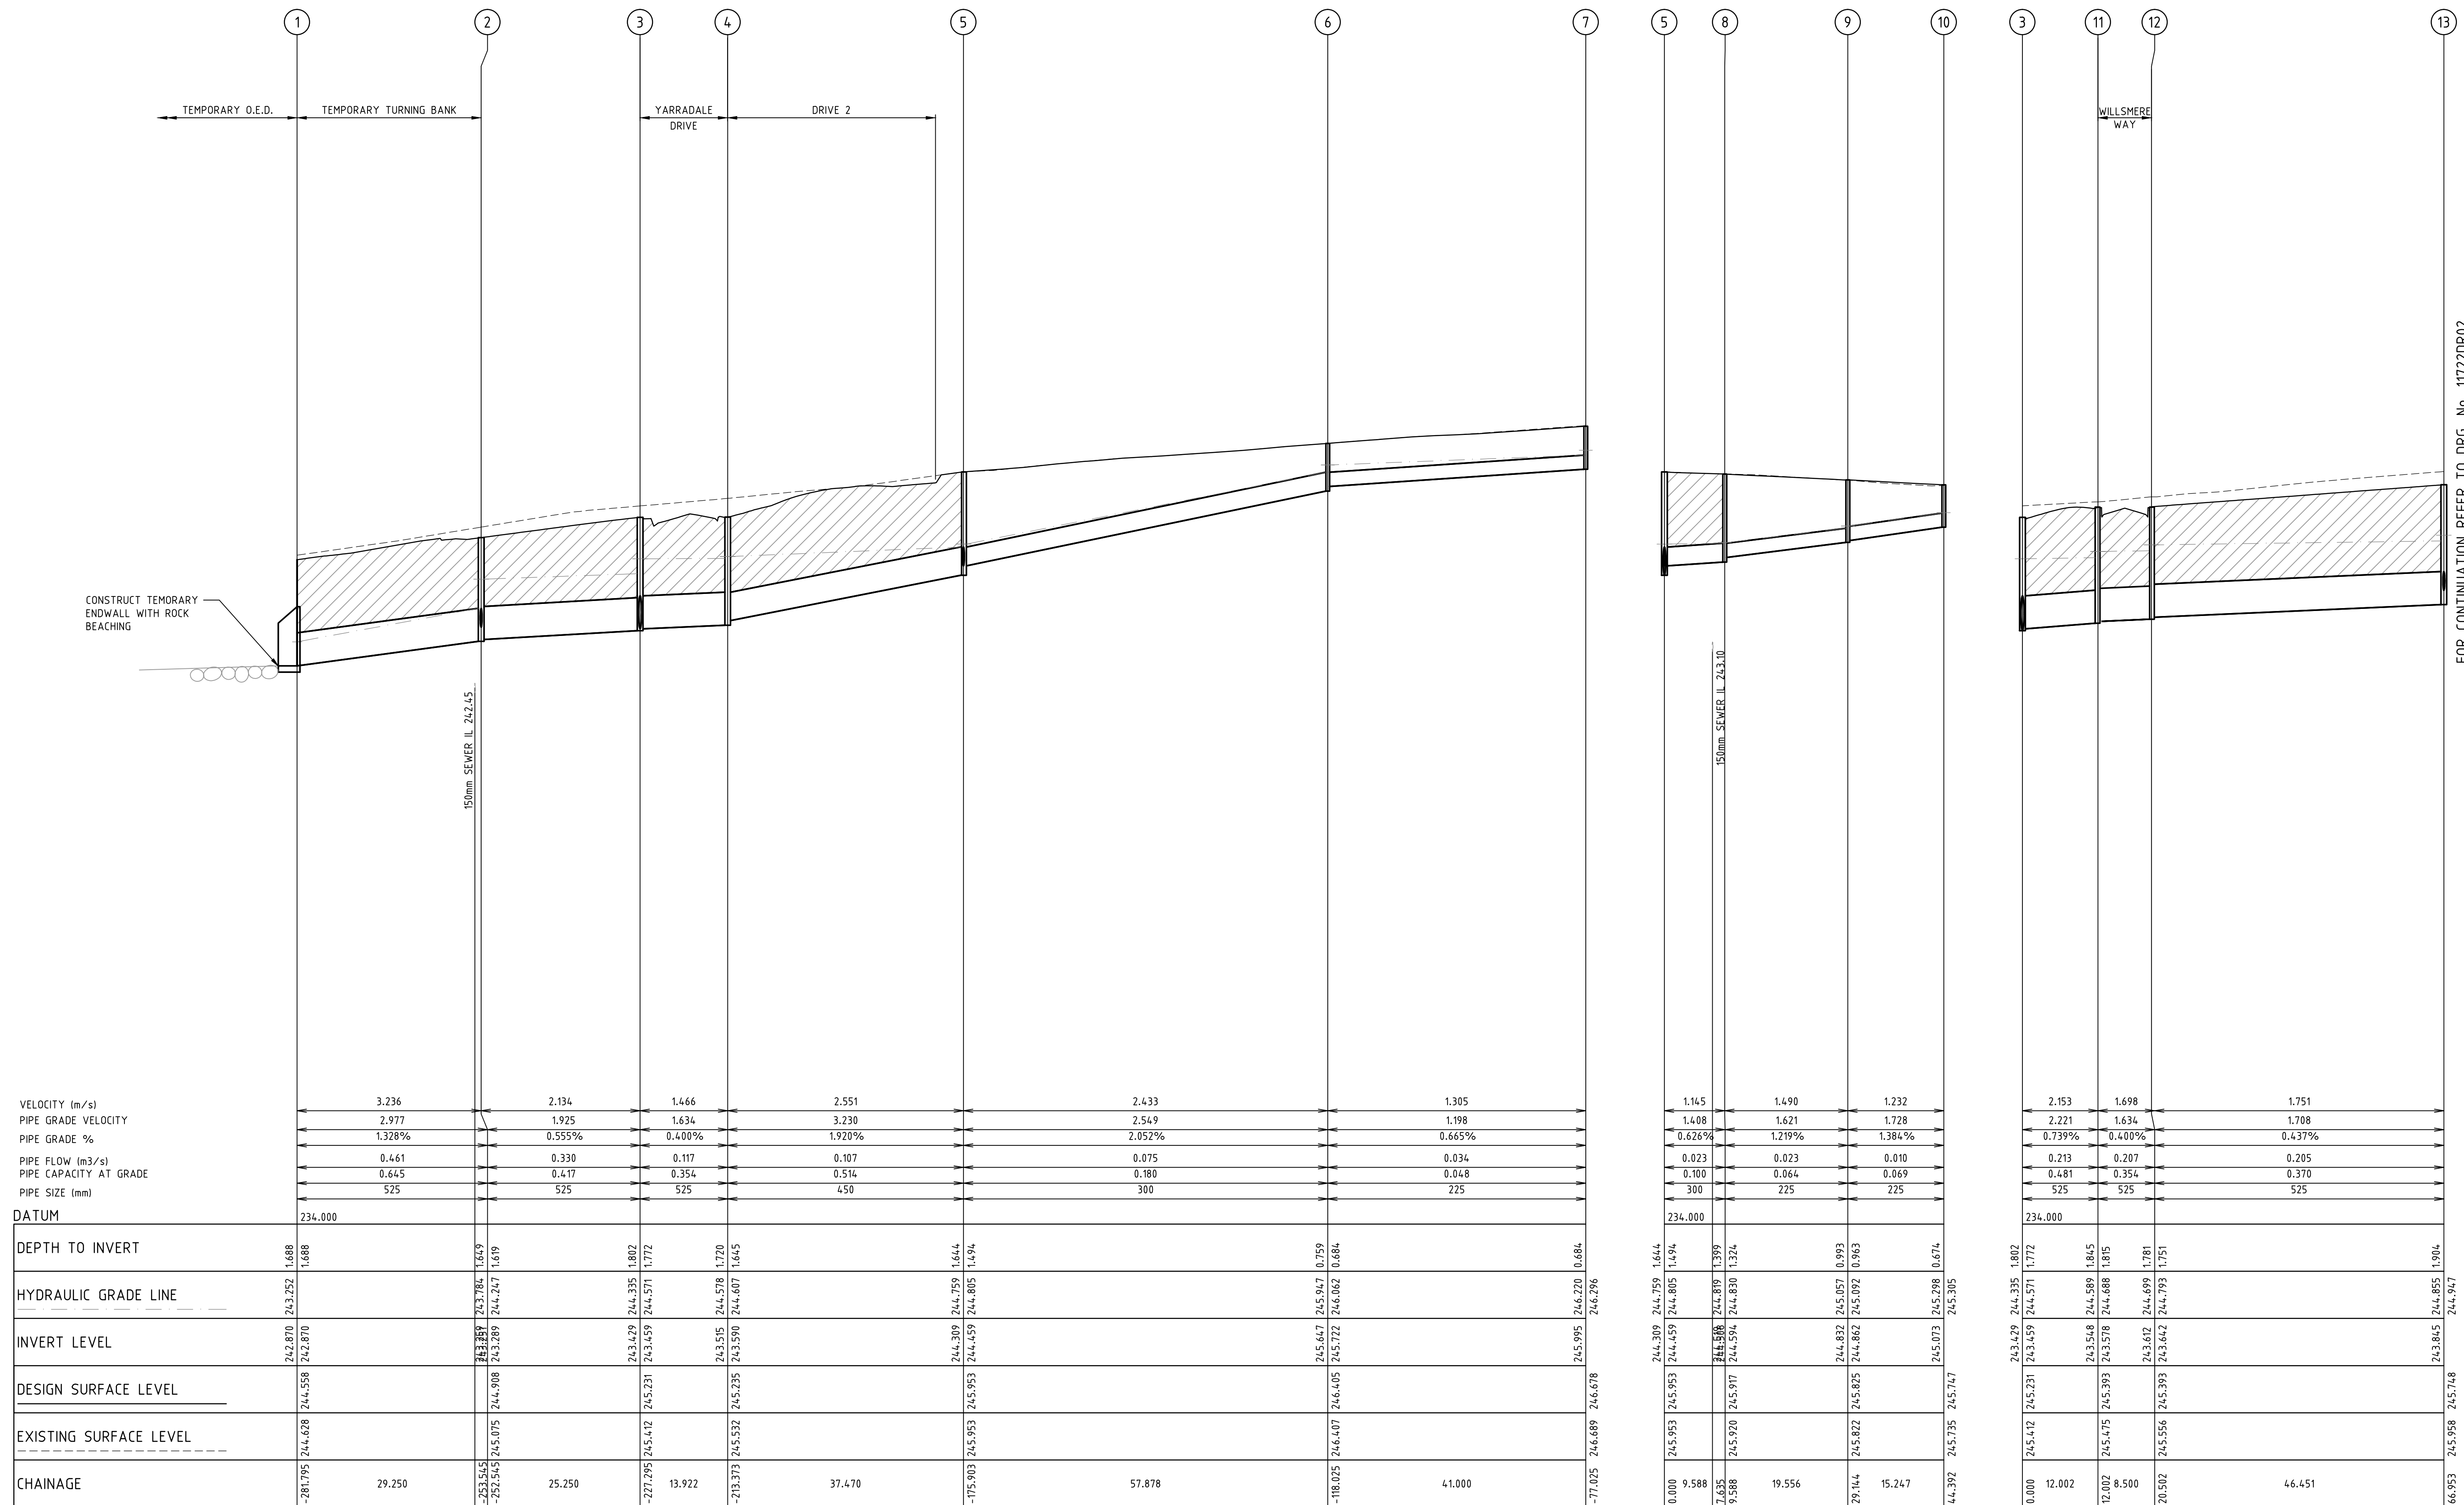


3	AS CONSTRUCTED	05/06/14	TL
2	PLAN OF SUBDIVISION AMENDMENT	04/12/13	TL
1	ISSUED TO COUNCIL FOR FINAL APPROVAL	03/10/13	TL
0	CONSTRUCTION ISSUE	27/08/13	TL
B	ISSUED FOR TENDER	16/07/13	TL
A	ISSUED TO COUNCIL	27/06/13	TL
REV	AMENDMENTS	DATE	APP'D.

LEGEND

DENOTES CRUSHED ROCK BACKFILL

merrifield
MAB GPC


Drawing File: C:\Users\merrifield\11722-MERRIFIELD - Precinct 1 - Stage 2\Acad\11722DR01.dwg - 11722DR02
Date/Time: Thu Jan 05, 2014 - 2:02pm - byron.shade

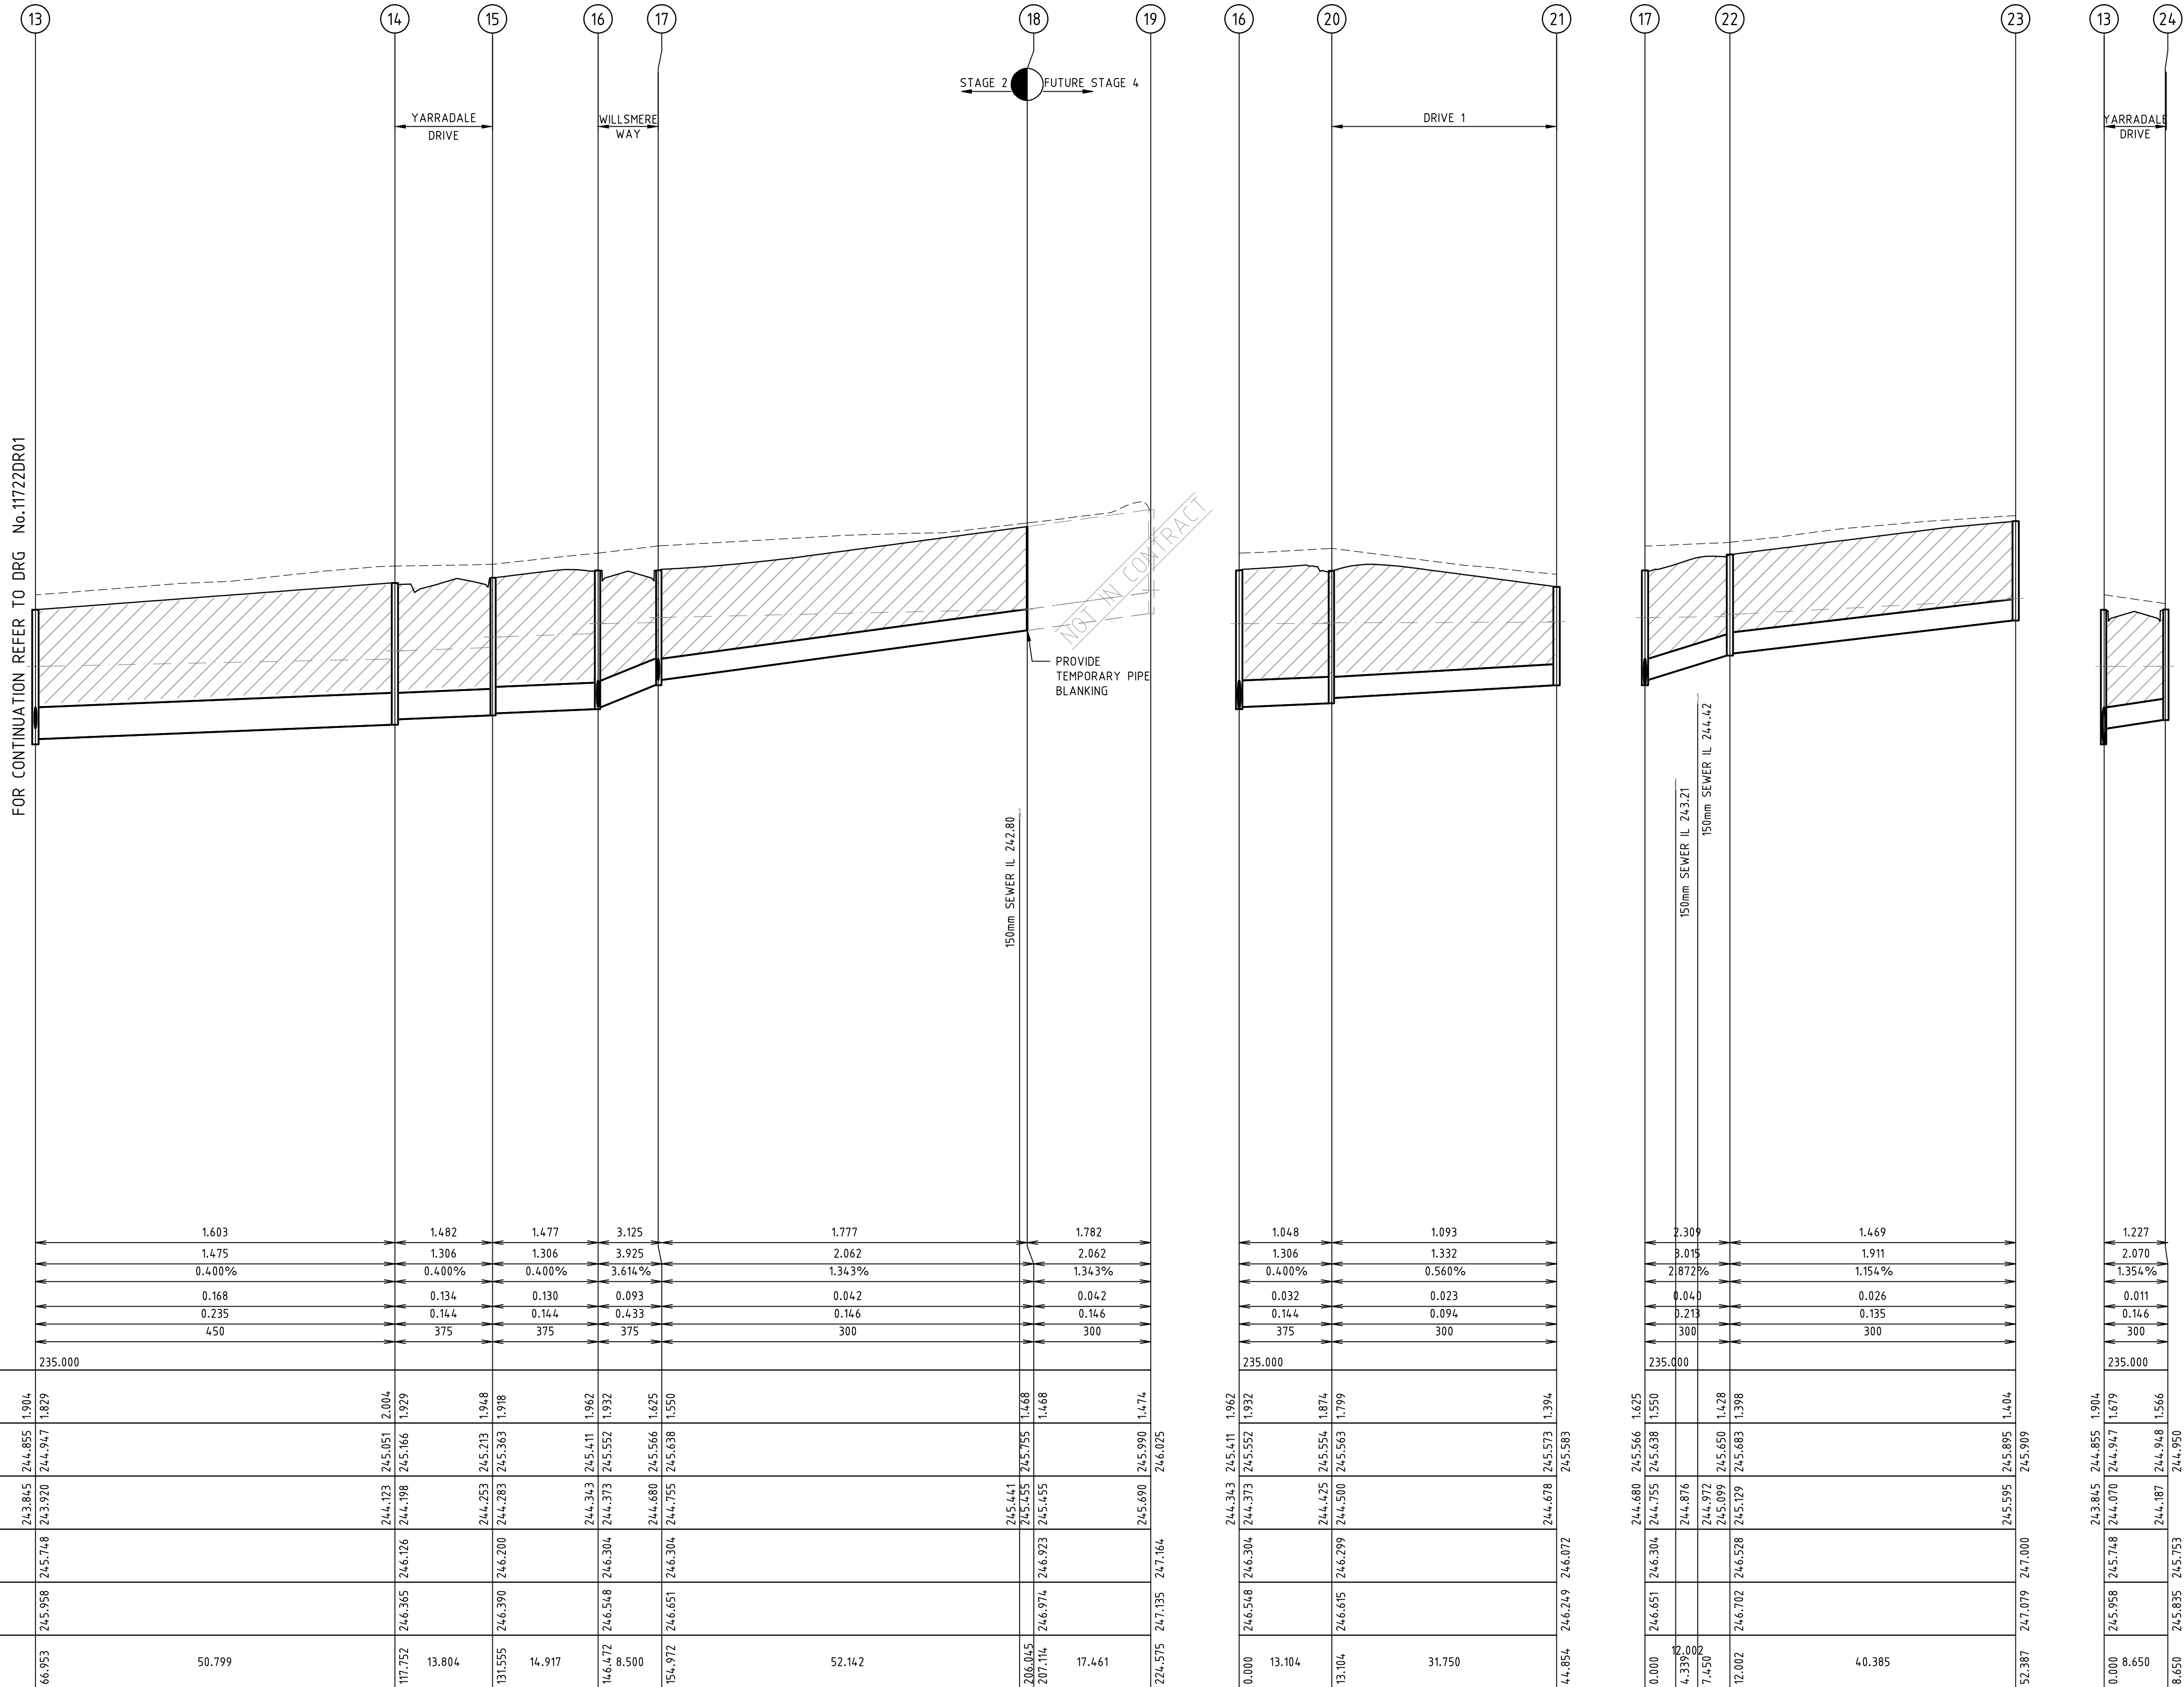

3	AS CONSTRUCTED	05/06/14	TL
2	PLAN OF SUBDIVISION AMENDMENT	04/12/13	TL
1	ISSUED TO COUNCIL FOR FINAL APPROVAL	03/10/13	TL
0	CONSTRUCTION ISSUE	27/08/13	TL
B	ISSUED FOR TENDER	16/07/13	TL
A	ISSUED TO COUNCIL	27/06/13	TL
REV	AMENDMENTS	DATE	APP'D.

Drawn HT Date 10/10/12
Designed BG
Date 10/10/12
AN 161120
Verified SL
Date 03/06/13
AN 1061047
Audited RCM
Date 22/08/13
AN 641546
Approved TL
Date 27/08/13
AN 881891
Written dimensions to take precedence over scale.
Contractor shall check and verify all dimensions on site.
Discrepancies to be brought to the attention of the Superintendent.

LEGEND

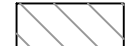
 DENOTES CRUSHED ROCK BACKFILL

merrifield
MAB gpc

Coords: MGA
Levels: AHD

Hor 1:500 0m 5m 10m 20m 30m
Ver 1:50 0m 0.5m 1m 2m 3m
Scale @ A1/A3 1:500/1:1000




MERRIFIELD DEVELOPMENT
DONNYBROOK ROAD, MICKLEHAM
STAGE 2
DRAINAGE LONGITUDINAL SECTIONS
SHEET 2 OF 3
Drawing No. 11722DR02 Rev 3
AS CONSTRUCTED
Sheet No. 14
© Dalton Consulting Engineers Pty Ltd
ABN 78 428 221 048

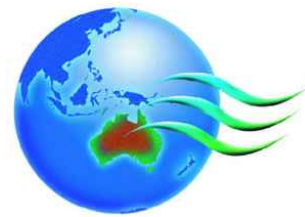
DCE
dalton consulting engineers
255 Whitehorse Road
PO Box 349
Bairwyn Victoria 3103
Australia
T 61 3 9888 6866
F 61 3 9888 6880
E info@dceprofile.com
W www.dceprofile.com

ALL PIT LIDS TO BE IN ACCORDANCE WITH HUME CITY COUNCIL STANDARD DETAILS

PIT SCHEDULE												
PIT		CO-ORDINATES		INTERNAL		INLET		OUTLET		PIT		REMARKS
NAME	TYPE	EASTING	NORTHING	WD	LEN	DIA	INV LEV	DIA	INV LEV	SETOUT RL	DEPTH	
1	EW	315129.179	5843855.988			525	242.870			244.558	1.688	REFER TO VICROADS STD DRG SD1851
2	GSEP	315100.150	5843859.589	(T)600 (B)900	(T)900 (B)900	525	243.289	525	243.259	244.908	1.649	HAUNCHED GSEP. REFER TO GAA STD DWG FIG.012 AND VICROADS STD DWG SD1021
3	GSEP	315075.091	5843862.690	(T)600 (B)900	(T)900 (B)900	525	243.459	525	243.429	245.231	1.802	HAUNCHED GSEP. REFER TO GAA STD DWG FIG.012 AND VICROADS STD DWG SD1021
4	GP	315062.254	5843867.933	(T)600 (B)900	(T)900 (B)900	450	243.59	525	243.515	245.235	1.720	GAA JP WITH GRATED LID. REFER TO GAA STD DRG FIG.014 AND VICROADS STD DWG SD1021
5	GP	315025.170	5843872.521	600	900	300	244.459	450	244.309	245.953	1.644	HAUNCHED GAA JP WITH GRATED LID. REFER TO GAA STD DRG FIG.014
6	JP	315018.064	5843815.081	600	600	225	245.722	300	245.647	246.405	0.759	REFER TO GAA STD DRG FIG.014
7	JP	315013.030	5843774.392	600	600			225	245.995	246.678	0.684	REFER TO GAA STD DRG FIG.014
8	JP	315025.814	5843882.087	600	900	225	244.594	300	244.519	245.917	1.399	REFER TO GAA STD DRG FIG.014
9	JP	315028.143	5843900.910	600	600	225	244.862	225	244.832	245.825	0.993	REFER TO GAA STD DRG FIG.014
10	JP	315033.968	5843915.001	600	600			225	245.073	245.747	0.674	REFER TO GAA STD DRG FIG.014
11	GSEP	315065.835	5843855.471	(T)600 (B)900	(T)900 (B)900	525	243.578	525	243.548	245.393	1.845	HAUNCHED GSEP. REFER TO GAA STD DWG FIG.012 AND VICROADS STD DWG SD1021
12	GSEP	315057.399	5843856.515	(T)600 (B)900	(T)900 (B)900	525	243.642	525	243.612	245.393	1.781	HAUNCHED GSEP. REFER TO GAA STD DWG FIG.012 AND VICROADS STD DWG SD1021
13	GSEP	315051.695	5843810.415	(T)600 (B)900	(T)900 (B)900	450	243.92	525	243.845	245.748	1.904	HAUNCHED GSEP. REFER TO GAA STD DWG FIG.012 AND VICROADS STD DWG SD1021
14	GSEP	315045.458	5843760.001	600	900	375	244.198	450	244.123	246.126	2.004	REFER TO GAA STD DRG FIG.012
15	GSEP	315045.635	5843746.239	600	900	375	244.283	375	244.253	246.200	1.948	REFER TO GAA STD DRG FIG.012
16	GSEP	315034.934	5843736.016	600	900	375	244.373	375	244.343	246.304	1.962	REFER TO GAA STD DRG FIG.012
17	GSEP	315026.497	5843737.055	600	900	300	244.755	375	244.680	246.304	1.625	REFER TO GAA STD DRG FIG.012
18	EP	315020.095	5843685.308			300	244.755					PROVIDE TEMPORARY PIPE BLANKING
19	GSEP	315017.803	5843668.000	600	900	300	245.455	300	245.455	246.923	1.468	PROVIDE TEMPORARY PIPE BLANKING
20	GSEP	315033.325	5843723.011	600	900	300	244.500	375	244.425	246.299	1.874	REFER TO GAA STD DRG FIG.012
21	GP	315064.834	5843719.113	600	900	300	244.678	300	244.678	246.072	1.394	GAA JP WITH GRATED LID. REFER TO GAA STD DRG FIG.014
22	GSEP	315019.279	5843746.312	600	900	300	245.129	300	245.099	246.528	1.428	REFER TO GAA STD DRG FIG.012
23	GSEP	314979.200	5843751.270	600	900	300	245.595	300	245.595	247.000	1.404	REFER TO GAA STD DRG FIG.012
24	GSEP	315060.280	5843809.353	600	900	300	244.187	300	244.187	245.753	1.566	REFER TO GAA STD DRG FIG.012
25	JP	315094.348	5843812.697	600	900	300	243.990	300	243.960	245.367	1.406	REFER TO GAA STD DRG FIG.014
26	JP	315082.929	5843720.401	600	900	300	244.988	300	244.958	246.002	1.044	REFER TO GAA STD DRG FIG.014
27	EP	315086.006	5843720.020					300	245.000	245.962	0.962	
28	EW	315100.702	5843899.070			225	244.093			244.877	0.784	
29	JP	315044.120	5843906.070	600	600			225	244.840	245.600	0.761	REFER TO GAA STD DRG FIG.014

- NOTE:
1. EASTING, NORTHING SETOUT TO PIT CENTRE
2. SETOUT LEVEL TO PIT COVER LEVEL

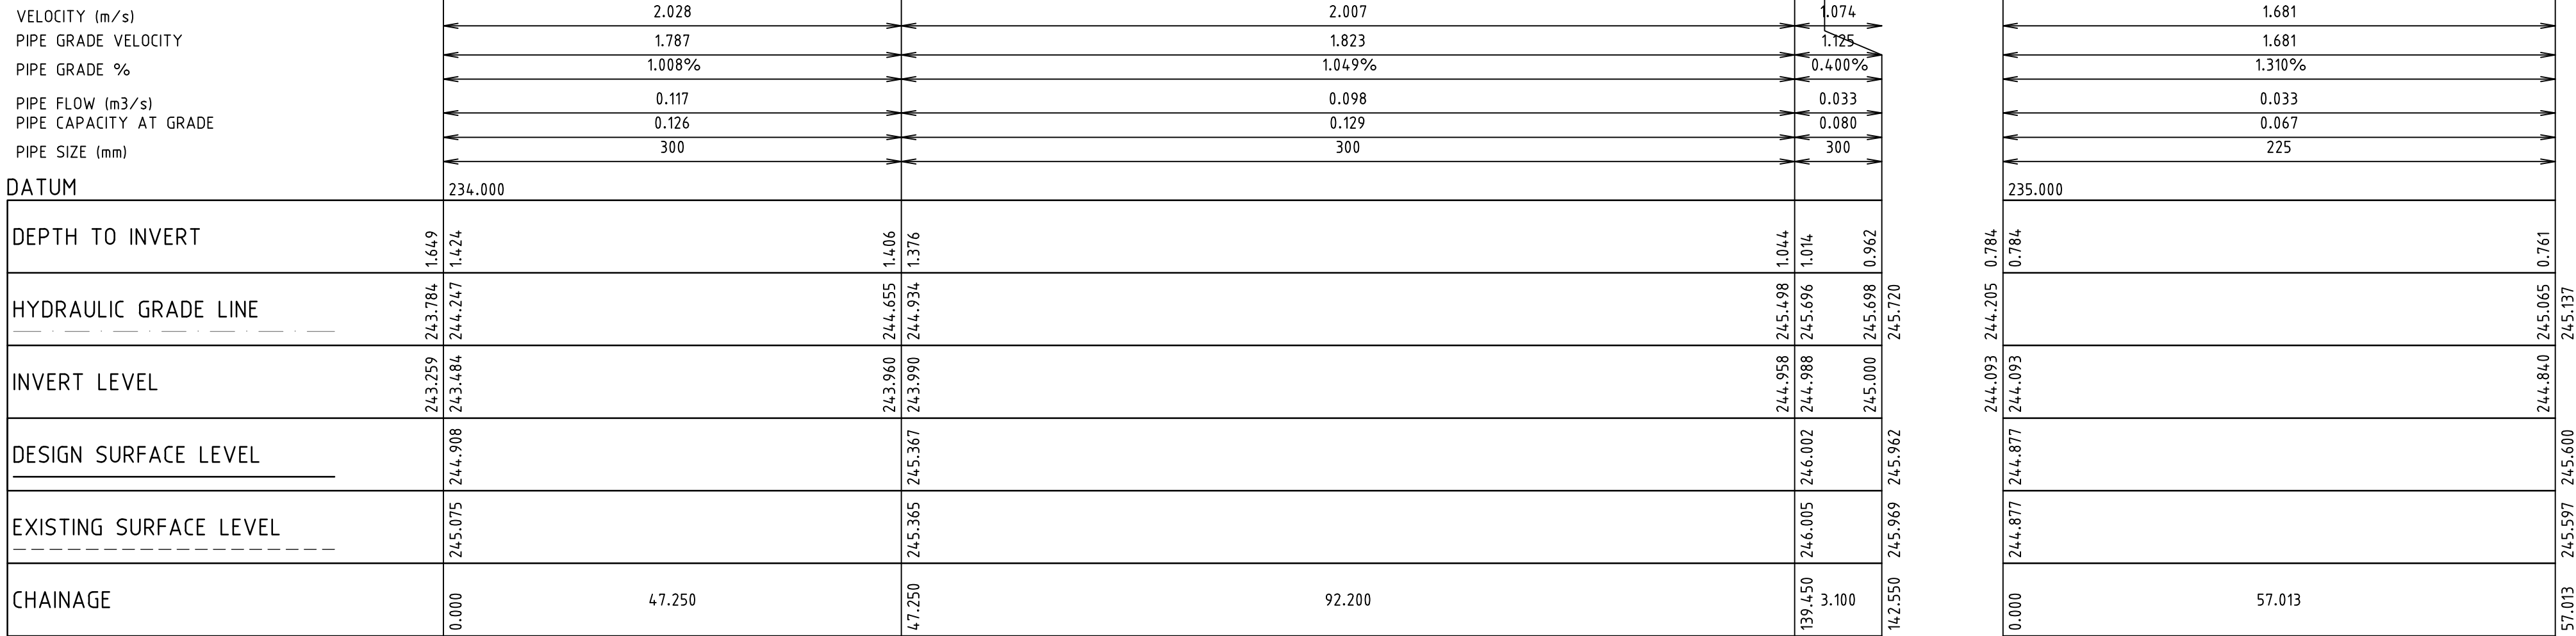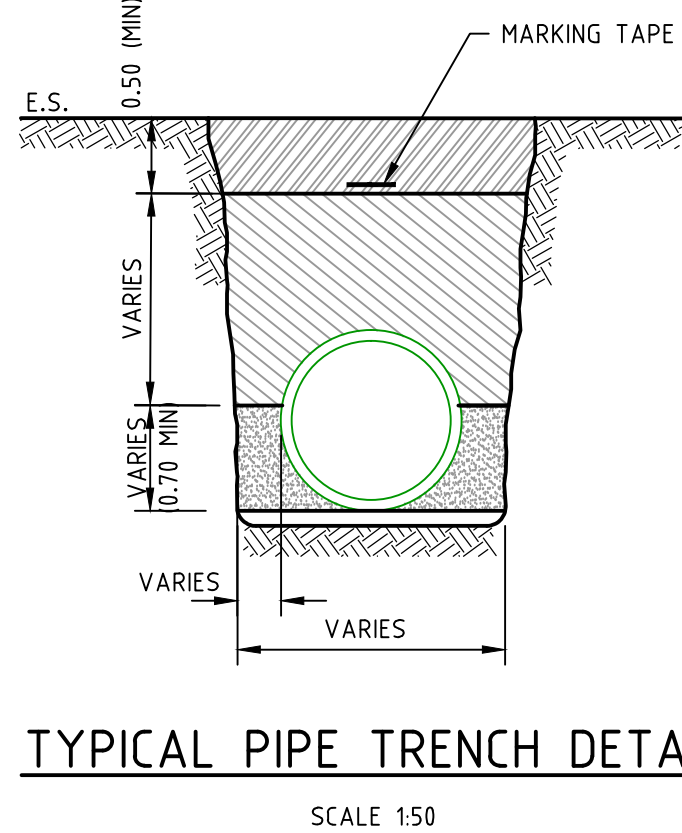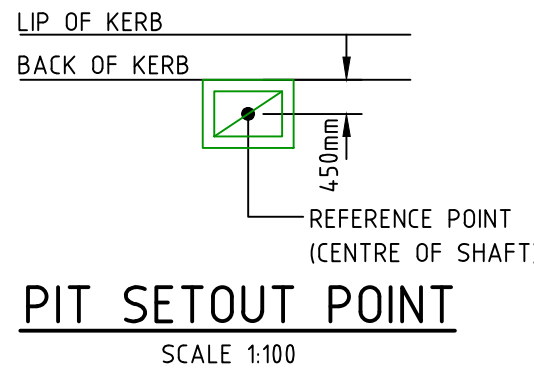

4	AS CONSTRUCTED	05/06/14	TL
3	PIT SCHEDULE AMENEEDED	16/01/14	TL
2	PLAN OF SUBDIVISION AMENDMENT	04/12/13	TL
1	ISSUED TO COUNCIL FOR FINAL APPROVAL	03/10/13	TL
0	CONSTRUCTION ISSUE	27/08/13	TL
B	ISSUED FOR TENDER	16/07/13	TL
A	ISSUED TO COUNCIL	27/06/13	TL
REV	AMENDMENTS	DATE	APPD.

Drawn HT Date 10/10/12
Designed BG
Date 10/10/12
AN 161121
Verified SL
Date 03/06/13
AN 1061048
Audited RCM
Date 22/08/13
AN 641547
Approved TL
Date 27/08/13
AN 881892
Written dimensions to take precedence over scale.
Contractor shall check and verify all dimensions on site.
Discrepancies to be brought to the attention of the Superintendent.

LEGEND

 DENOTES CRUSHED ROCK BACKFILL

merrifield
MAB gpc

MERRIFIELD DEVELOPMENT
DONNYBROOK ROAD, MICKLEHAM
STAGE 2
DRAINAGE LONGITUDINAL SECTIONS
SHEET 3 OF 3

Drawing No. 11722DR03 **Rev 4**
AS CONSTRUCTED


Sheet No. 15
© Dalton Consulting Engineers Pty Ltd
ABN 78 428 221 048

Coords: MGA
Levels: AHD
Hor 1:500 0m 5m 10m 20m 30m
Ver 1:50 0m 0.5m 1m 2m 3m
Scale @ A1/A3 1:500/1:1000

DCE
dalton consulting engineers

255 Whitehorse Road
PO Box 349
Balwyn Victoria 3103
Australia
T 61 3 9888 8888
F 61 3 9888 8880
E info@dceprofile.com
W www.dceprofile.com

Drawing File: C:\Design\11722-MERRIFIELD - Precinct 1 - Stage 2\Acad\11722FP01.dwg - 11722FP01
Date/Time: Thu Jan 05, 2014 - 2:02pm --byron.shode--

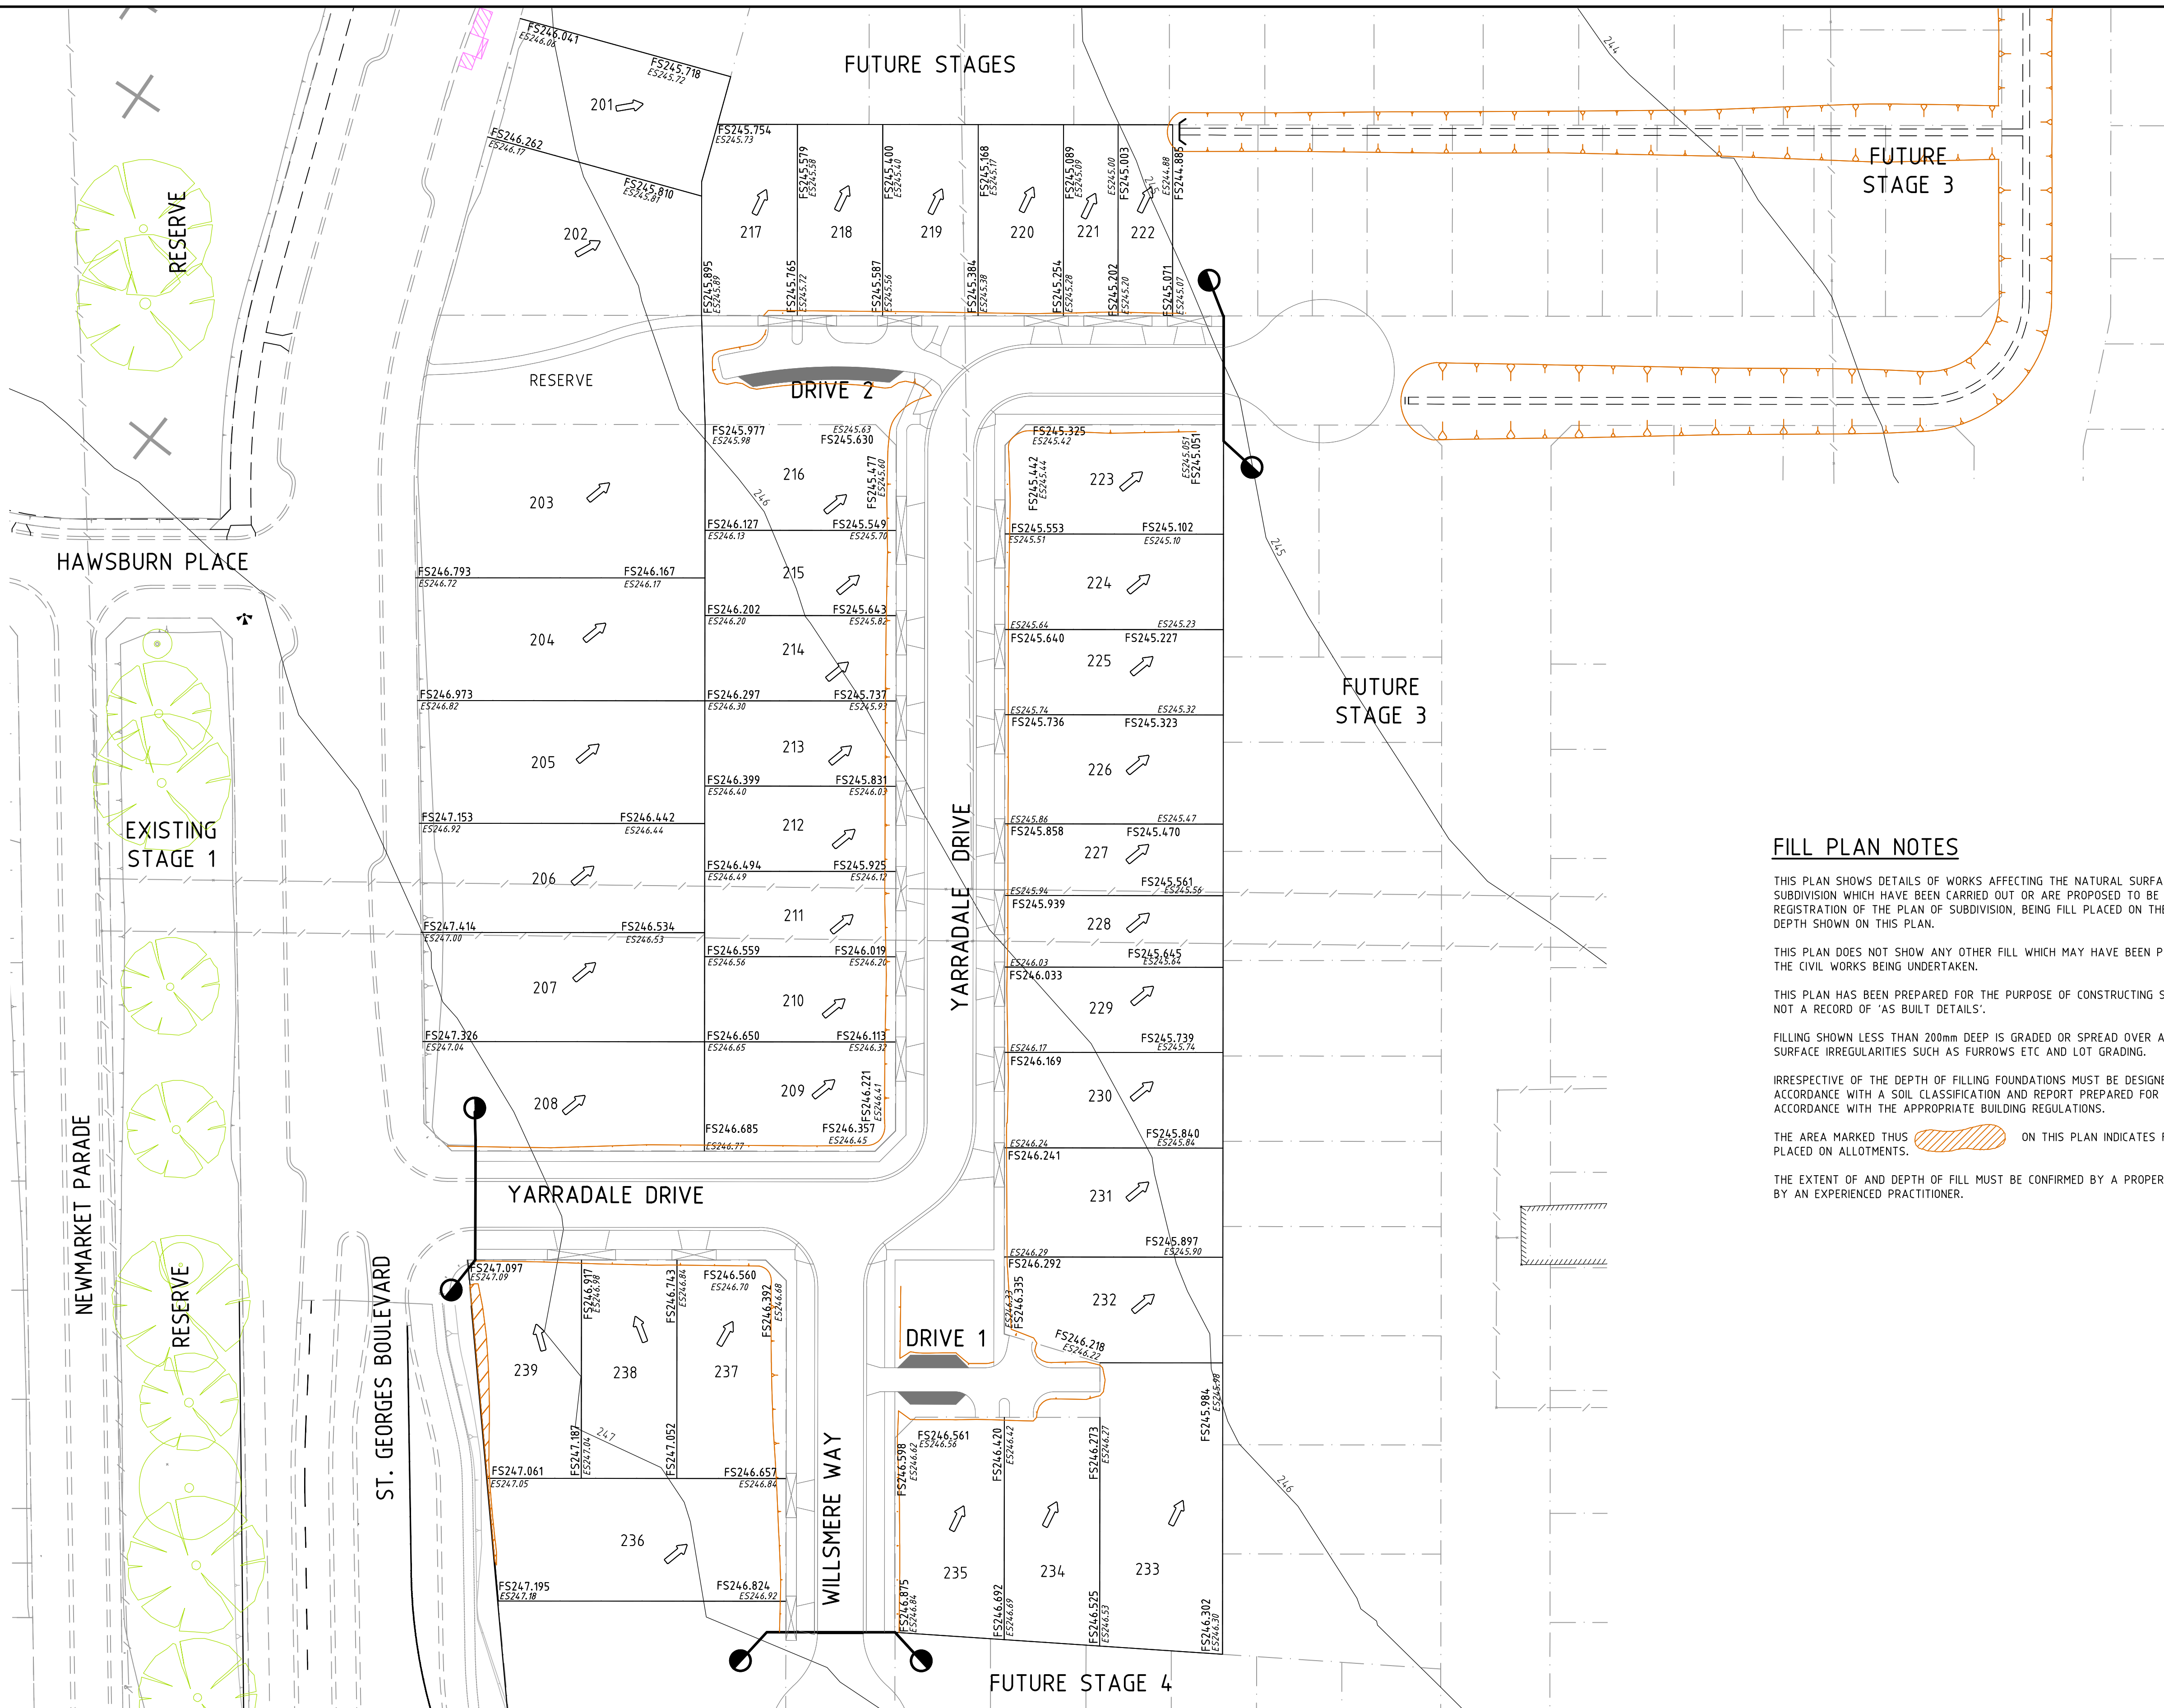

FILL PLAN NOTES

THIS PLAN SHOWS DETAILS OF WORKS AFFECTING THE NATURAL SURFACE OF THE LAND WITHIN THE SUBDIVISION WHICH HAVE BEEN CARRIED OUT OR ARE PROPOSED TO BE CARRIED OUT PRIOR TO REGISTRATION OF THE PLAN OF SUBDIVISION, BEING FILL PLACED ON THE LAND TO THE EXTENT AND DEPTH SHOWN ON THIS PLAN.

THIS PLAN DOES NOT SHOW ANY OTHER FILL WHICH MAY HAVE BEEN PLACED ON THE LAND PRIOR TO THE CIVIL WORKS BEING UNDERTAKEN.

THIS PLAN HAS BEEN PREPARED FOR THE PURPOSE OF CONSTRUCTING SUBDIVISIONAL WORKS AND IS NOT A RECORD OF 'AS BUILT DETAILS'.

FILLING SHOWN LESS THAN 200mm DEEP IS GRADED OR SPREAD OVER ALLOTMENTS TO CORRECT MINOR SURFACE IRREGULARITIES SUCH AS FURROWS ETC AND LOT GRADING.

IRRESPECTIVE OF THE DEPTH OF FILLING FOUNDATIONS MUST BE DESIGNED AND CONSTRUCTED IN ACCORDANCE WITH A SOIL CLASSIFICATION AND REPORT PREPARED FOR THE PURPOSE AND IN ACCORDANCE WITH THE APPROPRIATE BUILDING REGULATIONS.

THE AREA MARKED THUS  ON THIS PLAN INDICATES FILL DEEPER THAN 200mm PLACED ON ALLOTMENTS.


THE EXTENT OF AND DEPTH OF FILL MUST BE CONFIRMED BY A PROPER GEOTECHNICAL INVESTIGATION BY AN EXPERIENCED PRACTITIONER.

3	AS CONSTRUCTED	05/06/14	TL
2	PLAN OF SUBDIVISION AMENDMENT	04/12/13	TL
1	ISSUED TO COUNCIL FOR FINAL APPROVAL	03/10/13	TL
0	CONSTRUCTION ISSUE	27/08/13	TL
B	ISSUED FOR TENDER	16/07/13	TL
A	ISSUED TO COUNCIL	27/06/13	TL
REV	AMENDMENTS	DATE	APP'D.

Drawn HT Date 10/10/12
Designed BG Date 10/10/12
AN 161122
Verified SL Date 03/06/13
AN 1061049
Audited RCM Date 22/08/13
AN 641548
Approved TL Date 27/08/13
AN 881893
Written dimensions to take precedence over scale.
Contractor shall check and verify all dimensions on site.
Discrepancies to be brought to the attention of the Superintendent.

LEGEND

-  LIMIT OF WORKS
-  EXISTING SURFACE LEVEL
-  FINISHED SURFACE LEVEL
-  REGRADE LOT AT MIN. 1 IN 150

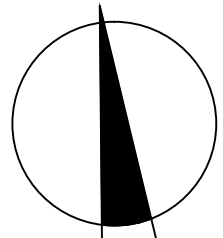

Coords: MGA
Levels: AHD
Hor 1:500 0m 5m 10m 20m 30m
Scale @ A1/A3 1:500/1:1000




MERRIFIELD DEVELOPMENT
DANNYBROOK ROAD, MICKLEHAM
STAGE 2
FILL PLAN

Drawing No. 11722FP01 Rev 3
Sheet No. 16 AS CONSTRUCTED
© Dalton Consulting Engineers Pty Ltd
ABN 78 428 221 048



255 Whitehorse Road
PO Box 349
Bairwyn Victoria 3103
Australia
T 61 3 9888 6866
F 61 3 9888 6880
E info@dceprofile.com
W www.dceprofile.com

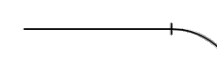Signed by Council: Hume City Council, Council Ref: S006883, Original Certification: 06/12/2013			LV use only		Plan Number	
PLAN OF SUBDIVISION			EDITION		PS 714640G	
Location of Land Parish: MICKLEHAM Township: - Section: - Crown Allotment: - Crown Portion: 24 (PART) Title Reference: VOL FOL Last Plan Reference: LOT A PS711404L Postal Address: DONNYBROOK ROAD (at time of subdivision) MICKLEHAM 3064 MGA 94 Co-ordinates E 314920 Zone: 55 (of approx. centre of land in plan) N 5844060			Council Name: HUME CITY COUNCIL Council Ref:			
Vesting of Roads and/or Reserves			Notations			
Identifier		Council/Body/Person		Staging		
ROAD R1		HUME CITY COUNCIL		This is is not a staged subdivision Planning Permit No. P16701		
RESERVE No.1		HUME CITY COUNCIL		Survey This plan is is not based on survey This survey has been connected to permanent marks no(s) 21, 70 In Proclaimed Survey Area No. 74		
RESERVE No.2		HUME CITY COUNCIL		Depth Limitation DOES NOT APPLY EASEMENT E-3 HAS BEEN OMITTED FROM THIS PLAN TANGENT POINTS ARE SHOWN THUS: 		
LAND SUBDIVIDED (EXCLUDING LOT B) - 2.528ha LOTS 1 TO 200 (BOTH INCLUSIVE) AND LOT A HAVE BEEN OMITTED FROM THIS PLAN						
Easement Information						
Legend: E - Encumbering Easement, Condition in Crown Grant in the Nature of an Easement or Other Encumbrance A - Appurtenant Easement R - Encumbering Easement (Road)						
Subject Land	Purpose	Width (metres)	Origin	Land Benefited/In Favour Of		
E-1 E-1	DRAINAGE SEWERAGE	SEE DIAG. SEE DIAG.	PS711404L PS711404L	HUME CITY COUNCIL YARRA VALLEY WATER CORPORATION		
E-2 E-2	DRAINAGE SEWERAGE	SEE DIAG. SEE DIAG.	THIS PLAN THIS PLAN	HUME CITY COUNCIL YARRA VALLEY WATER CORPORATION		
E-4	DRAINAGE	SEE DIAG.	PS711404L	HUME CITY COUNCIL		
E-5	POWERLINE	SEE DIAG.	PS711404L - SECT. 88 ELECTRICITY INDUSTRY ACT 2000 PS711404L	JEMENA ELECTRICITY NETWORKS (VIC) LTD		
E-6	POWERLINE	SEE DIAG.	PS711404L - SECT. 88 ELECTRICITY INDUSTRY ACT 2000	JEMENA ELECTRICITY NETWORKS (VIC) LTD		
E-6 E-6	DRAINAGE SEWERAGE	SEE DIAG. SEE DIAG.	PS711404L PS711404L	HUME CITY COUNCIL YARRA VALLEY WATER CORPORATION		
E-7	POWERLINE	SEE DIAG.	THIS PLAN - SECT. 88 ELECTRICITY INDUSTRY ACT 2000 THIS PLAN	JEMENA ELECTRICITY NETWORKS (VIC) LTD		
E-7	TRANSMISSION OF TELECOMMUNICATION SIGNALS BY 'UNDERGROUND CABLE'	SEE DIAG.	THIS PLAN	LOTS IN THIS PLAN		
E-8	POWERLINE	SEE DIAG.	THIS PLAN - SECT. 88 ELECTRICITY INDUSTRY ACT 2000	JEMENA ELECTRICITY NETWORKS (VIC) LTD		
E-8 E-8	DRAINAGE TRANSMISSION OF TELECOMMUNICATION SIGNALS BY 'UNDERGROUND CABLE'	SEE DIAG. SEE DIAG.	THIS PLAN THIS PLAN	HUME CITY COUNCIL LOTS IN THIS PLAN		
E-9 E-9 E-9	SUPPLY OF GAS SUPPLY OF WATER BY PIPELINE SEWERAGE	SEE DIAG. SEE DIAG. SEE DIAG.	THIS PLAN THIS PLAN THIS PLAN	"VIC GAS DISTRIBUTION PTY LTD" YARRA VALLEY WATER CORPORATION YARRA VALLEY WATER CORPORATION		
E-10	DRAINAGE	SEE DIAG.	THIS PLAN	HUME CITY COUNCIL		
E-11	POWERLINE	SEE DIAG.	PS711404L - SECT. 88 ELECTRICITY INDUSTRY ACT 2000	JEMENA ELECTRICITY NETWORKS (VIC) LTD		
E-12 E-12 E-12 E-12	SUPPLY OF GAS SUPPLY OF WATER BY PIPELINE SEWERAGE DRAINAGE	SEE DIAG. SEE DIAG. SEE DIAG. SEE DIAG.	THIS PLAN THIS PLAN THIS PLAN THIS PLAN	"VIC GAS DISTRIBUTION PTY LTD" YARRA VALLEY WATER CORPORATION YARRA VALLEY WATER CORPORATION HUME CITY COUNCIL		
MERRIFIELD - 2			LICENSED SURVEYOR (PRINT) GEOFFREY JAMES TURNER SIGNATURE .. DIGITALLY SIGNED .. DATE / / REF 29005023 05/12/13 VERSION J DWG 2900502AJ		Sheet 1 of 7 sheets	
39 LOTS AND BALANCE LOT B					Original sheet size A3	
Bosco Jonson Pty Ltd A.B.N 95 282 532 642 P.O. Box 5075, South Melbourne, Vic 3205 16 Eastern Road, South Melbourne Vic 3205 Australia Tel 03 9699 1400 Fax 03 9699 5992						

Signed by Council: Hume City Council, Council Ref: S006883, Original Certification: 06/12/2013

PLAN OF SUBDIVISION

Plan Number

PS 714640G

B
SEE SHEET 2

SEE
SHEET
6

ST. GEORGES

BOULEVARD

YARRADALE DRIVE

YARRADALE DRIVE

SEE SHEET 4

SEE SHEET 6

SEE SHEET 6

SEE
SHEET
5

MERRIFIELD - 2

Bosco Jonson Pty Ltd

A.B.N 95 282 532 642

P.O. Box 5075, South Melbourne, Vic 3205

16 Eastern Road South Melbourne

Vic 3205 Australia

Tel 03) 9699 1400 Fax 03) 9699 5992

ORIGINAL

SCALE

SCALE
1:750

SHEET
SIZE
A3

7.5 0 15 30

LENGTHS ARE IN METRES

LICENSED SURVEYOR (PRINT) GEOFFREY JAMES TURNER

SIGNATURE DIGITALLY SIGNED . . . DATE / /

REF 29005023
DWG 2900502A J

05/12/13 VERSION J

Sheet 3

Signed by Council: Council of the City of Melbourne, Council File: S006883, Original Certification: 06/12/2013

Plan Number
PS 714640G

PLAN OF SUBDIVISION

SEE SHEET 3

SEE SHEET 2

SEE SHEET 2

MERRIFIELD - 2

Bosco Jonson Pty Ltd

A.B.N 99 282 532 642

P.O. Box 5075, South Melbourne, Vic 3205

16 Eastern Road South Melbourne

Vic 3205 Australia

Tel 03) 9699 1400 Fax 03) 9699 5992

ORIGINAL

SCALE

1:750

A3

15

3	AS CONSTRUCTED	05/06/14	TL
2	PLAN OF SUBDIVISION AMENDMENT	04/12/13	TL
1	ISSUED TO COUNCIL FOR FINAL APPROVAL	03/10/13	TL
0	CONSTRUCTION ISSUE	27/08/13	TL
B	ISSUED FOR TENDER	16/07/13	TL
A	ISSUED TO COUNCIL	27/06/13	TL
REV	AMENDMENTS	DATE	APP'D.

Drawn HT Date 10/10/12
Designed BG
Date 10/10/12
AN 151123
Verified SL
Date 03/06/13
AN 1061050
Audited RCM
Date 22/08/13
AN 641549
Approved TL
Date 27/08/13
AN 881894
Write dimensions to take precedence over scale.
Contractor shall check and verify all dimensions on site.
Discrepancies to be brought to the attention of the Superintendent.

Coords: MGA
Levels: AHD

Scale @ A1/A3

merrifield
MAB GPC

MERRIFIELD DEVELOPMENT
DONNYBROOK ROAD, MICKLEHAM
STAGE 2
PLAN OF SUBDIVISION


Drawing No. 11722POS01 **Rev** 3
Sheet No. 17 **AS CONSTRUCTED**
 © Dalton Consulting Engineers Pty Ltd
 ABN 78 429 221 049




255 Whitehorse Road
PO Box 349
Balwyn Victoria 3103
Australia

T 61 3 9888 6866
F 61 3 9888 6880
E info@dceprofile.com
W www.dceprofile.com

Drawing File: C:\desig\merr\11722-MERRIFIELD - Precinct 1 - Stage 2\Acad\11722EF01.dwg - 11722EF01
Date/Time: Thu Jan 05, 2014 - 2:03pm --byron.shade--

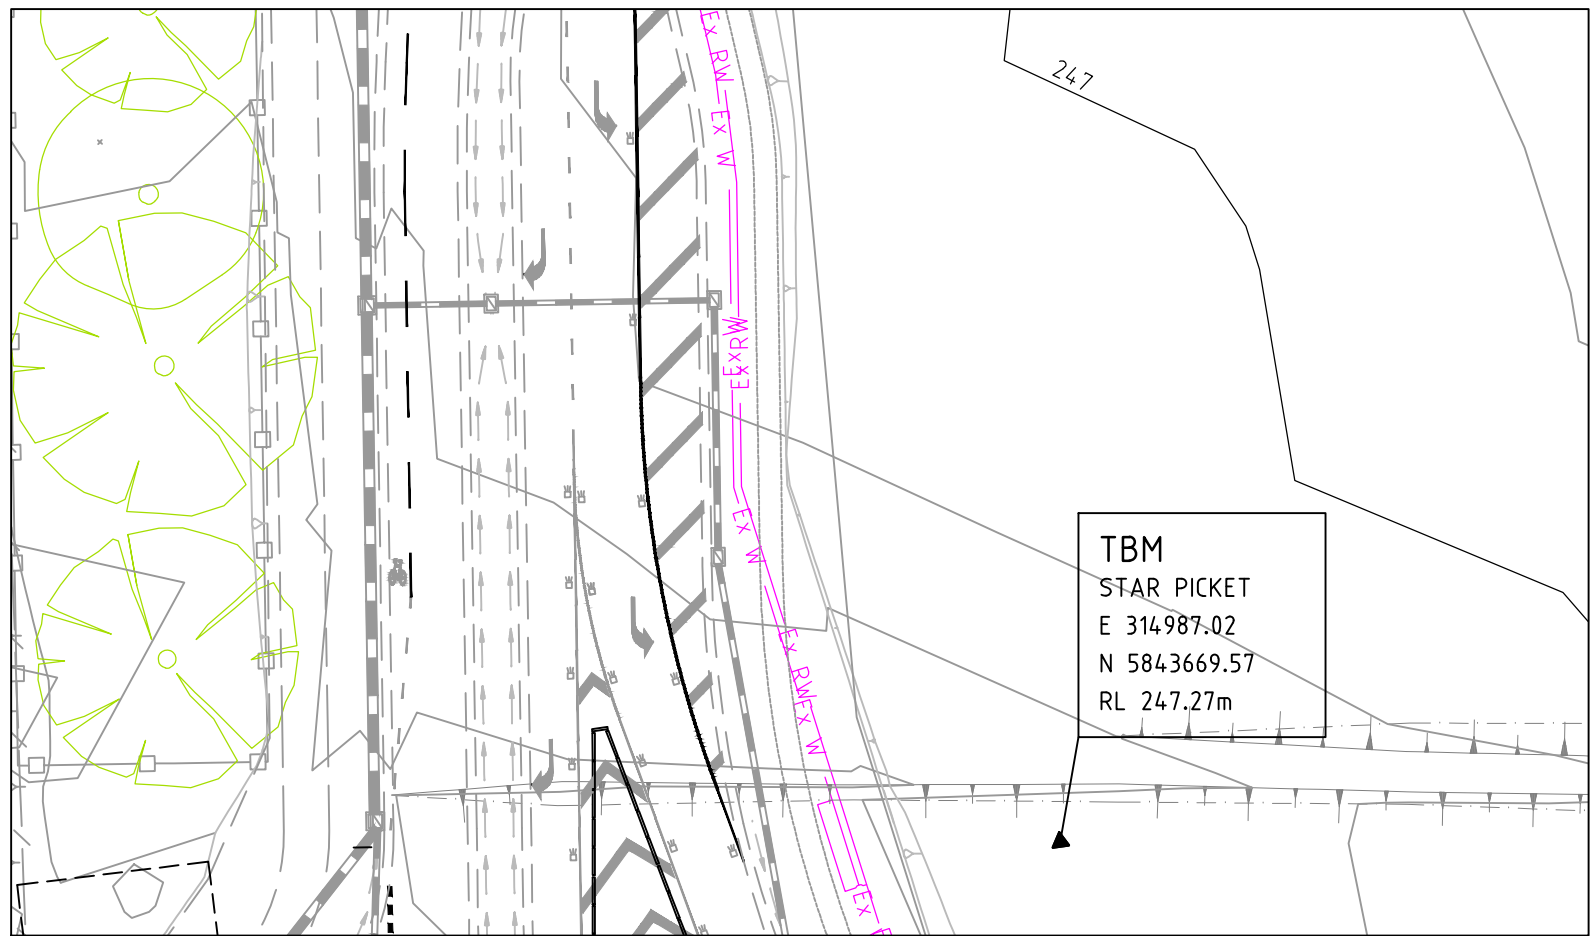

INSET

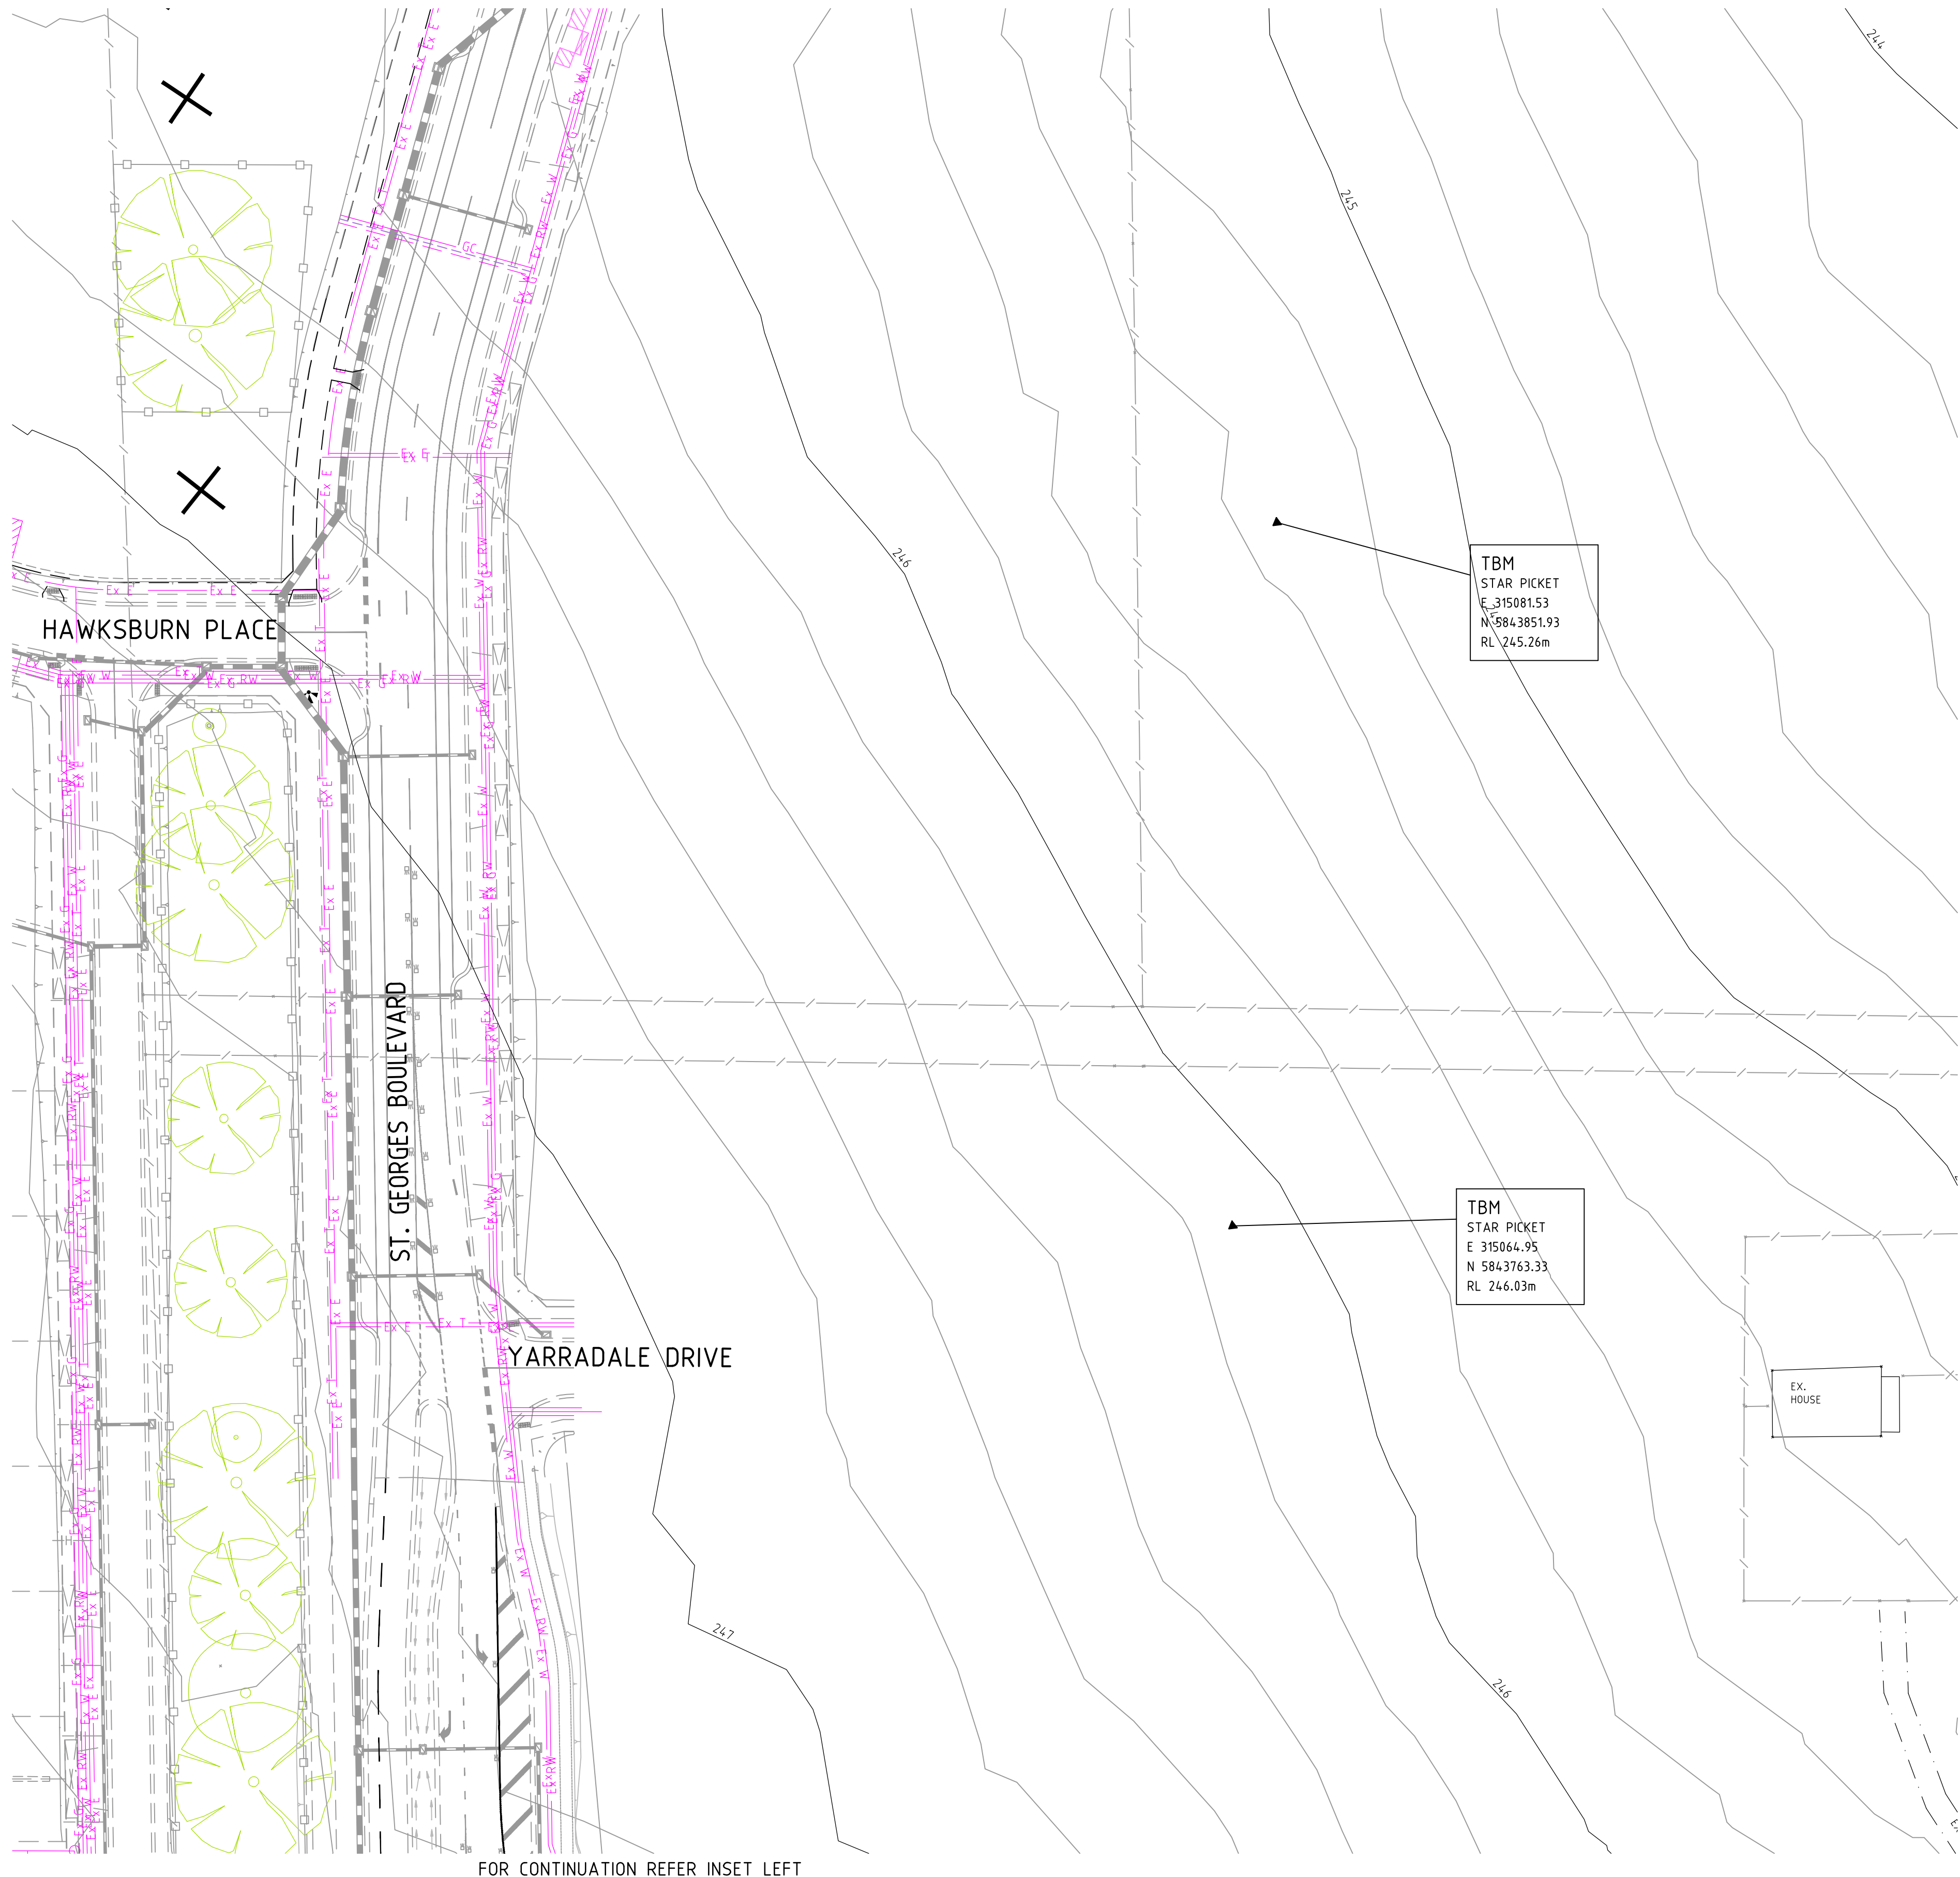


FOR CONTINUATION REFER INSET LEFT

REV	AMENDMENTS	DATE	APP'D.
3	AS CONSTRUCTED	05/06/14	TL
2	PLAN OF SUBDIVISION AMENDMENT	04/12/13	TL
1	ISSUED TO COUNCIL FOR FINAL APPROVAL	03/10/13	TL
0	CONSTRUCTION ISSUE	27/08/13	TL
B	ISSUED FOR TENDER	16/07/13	TL
A	ISSUED TO COUNCIL	27/06/13	TL

Drawn HT Date 10/10/12
Designed BG Date 10/10/12
AN 161124
Verified SL Date 03/06/13
AN 1061051
Audited RCM Date 22/08/13
AN 641550
Approved TL Date 27/08/13
AN 881895
Written dimensions to take precedence over scale.
Contractor shall check and verify all dimensions on site.
Discrepancies to be brought to the attention of the Superintendent.

LEGEND	
---	EXISTING STAGES
Ex W	EXISTING DRINKING WATER MAIN
Ex RW	EXISTING NON DRINKING WATER MAIN
Ex G	EXISTING GAS MAIN
Ex E	EXISTING ELECTRICAL CABLE
Ex S	EXISTING SEWER MAIN & MANHOLE
Ex T	EXISTING TELECOMM. CABLE AND PIT
X	EXISTING TREES TO BE REMOVED
SW	PREVIOUS STAGE SW DRAIN & PIT
TPZ	EXISTING TREE PROTECTION ZONE
246	EXISTING SURFACE CONTOUR (0.2m INTERVAL)

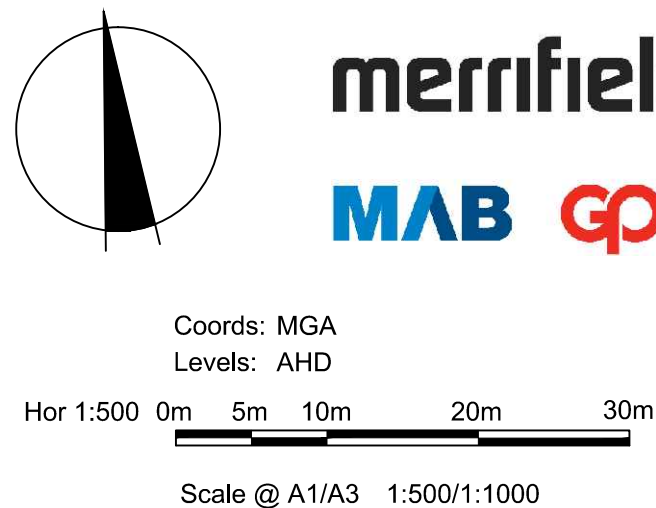

merrifield
MAB gpc

MERRIFIELD DEVELOPMENT
DANNYBROOK ROAD, MICKLEHAM
STAGE 2
EXISTING FEATURES PLAN

Drawing No. 11722EF01 Rev 3
Sheet No. 18 AS CONSTRUCTED
© Dalton Consulting Engineers Pty Ltd
ABN 78 428 221 048

DCE
dalton consulting engineers

255 Whitehorse Road
PO Box 349
Balwyn Victoria 3103
Australia
T 61 3 9888 6866
F 61 3 9888 6880
E info@dceprofile.com
W www.dceprofile.com