

LEGEND - DETAIL PLAN	
	LOT GRADE
	EXISTING CONTOURS
	EXISTING SURFACE LEVEL
	FINISHED SURFACE LEVEL
	TOP OF BATTER LEVEL
	KERB AND TYPE
	PROPOSED VEHICLE CROSSING AND FOOTPATH
	ARC RADIUS AT LIP OF KERB
	CHAINAGE DERIVED FROM ROAD CENTRE
	PROPOSED FENCE
	PROPOSED STAGE BOUNDARY
	PROPOSED RETAINING WALL
	BOLLARDS
	LIMIT OF ROAD WORKS
	STREET SIGN
	NO ROAD SIGN
	PERMANENT SURVEY MARK
	TEMPORARY BENCH MARK AND REF. NO.
	REMOVE EXISTING TREE
	PROPOSED BATTER
	TACTILE MARKERS (TGSi's)
	EASEMENT LINE AND TYPE
	PROPOSED COUNCIL DRAINAGE PIT, HAUNCH, PIPE AND DIAMETER
	PROPOSED FUTURE DRAINAGE
	DRAINAGE PROPERTY INLET CONNECTION
	DRAINAGE HOUSE DRAIN CONNECTION
	TABLE DRAIN
	DRAINAGE PIT NUMBERS
	PROPOSED SEWER, MAINTENANCE STRUCTURE AND PROPERTY CONNECTION
	PROPOSED MAINTENANCE HOLE
	PROPOSED MAINTENANCE CHAMBER
	PROPOSED INSPECTION SHAFT
	PROPOSED GAS CHECK
	PROPOSED SEWER PIPE STUB
	EXISTING COUNCIL DRAINAGE PIPE, PIT
	EXISTING DRAINAGE TO BE REMOVED
	EXISTING SEWER, MAINTENANCE STRUCTURE AND PROPERTY CONNECTION
	CUT >150mm DEPTH
	FILL >300mm DEPTH
	2.5m WIDE FOOTPATH
	ROUNDABOUT THRESHOLD TREATMENT
	G15 EMERALD (AS2700 S1996) OR VICROADS APPROVED EQUIVALENT AS PER VICROADS CYCLE NTE No.14 (2005)

## WARNING

### BWARE OF UNDERGROUND SERVICES

THE LOCATIONS OF UNDERGROUND SERVICES ARE APPROXIMATE ONLY AND THEIR EXACT POSITION SHOULD BE PROVEN ON SITE. NO GUARANTEE IS GIVEN THAT ALL EXISTING SERVICES ARE SHOWN. A DBYD ENQUIRY ON 1100 MUST BE MADE BY THE CONTRACTOR PRIOR TO COMMENCEMENT OF WORKS.


## WARNING

ANY DESIGN SURFACE LEVELS SHOWN ARE PRELIMINARY ONLY AND SUBJECT TO FINAL DETAIL DESIGN, DO NOT USE FOR CONSTRUCTION

REV	DESCRIPTION	APPROVED	DATE
4	AS CONSTRUCTED	G.R.	20.09.19
3	AMENDED ROUNDABOUTS PRAM CROSSINGS, TGSi's, THRESHOLD TREATMENT	GR	08.07.19
2	LEVELS AMENDED	GR	12.03.19
1	POS UPDATED	GR	01.03.19
0	ISSUED FOR CONSTRUCTION	GR	11.02.19
REV	DESCRIPTION	APPROVED	DATE

DRAWN:	J. HOSKING
DESIGNED:	A. CARROLL
APPROVED:	G. ROMANCZ

H 1 : 500  
@ A1

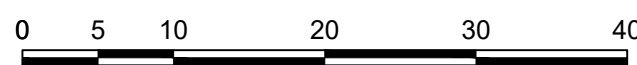

**verve**  
Level 1, 173 Burke Road, Glen Iris VIC 3146  
Tel : 03 8573 1500 Fax: 03 8573 1555  
verveprojects.com



COUNCIL:	HUME CITY COUNCIL
PROJECT:	MERRIFIELD - CITY WEST STAGE 65 MICKLEHAM
ISSUE:	AS CONSTRUCTED
MELWAY REF:	366 F4
PROJECT NO:	17030-65
DWG NO:	RD201
REVISION:	4