



Drawing File: G:\Design\11700\11727-MERRIFIELD - Precinct 1 - Stage 7\Acad\11727SP01.dwg - 11727SP01
Date/Time: Fri Jul 03, 2015 - 9:33am --byron.abade--

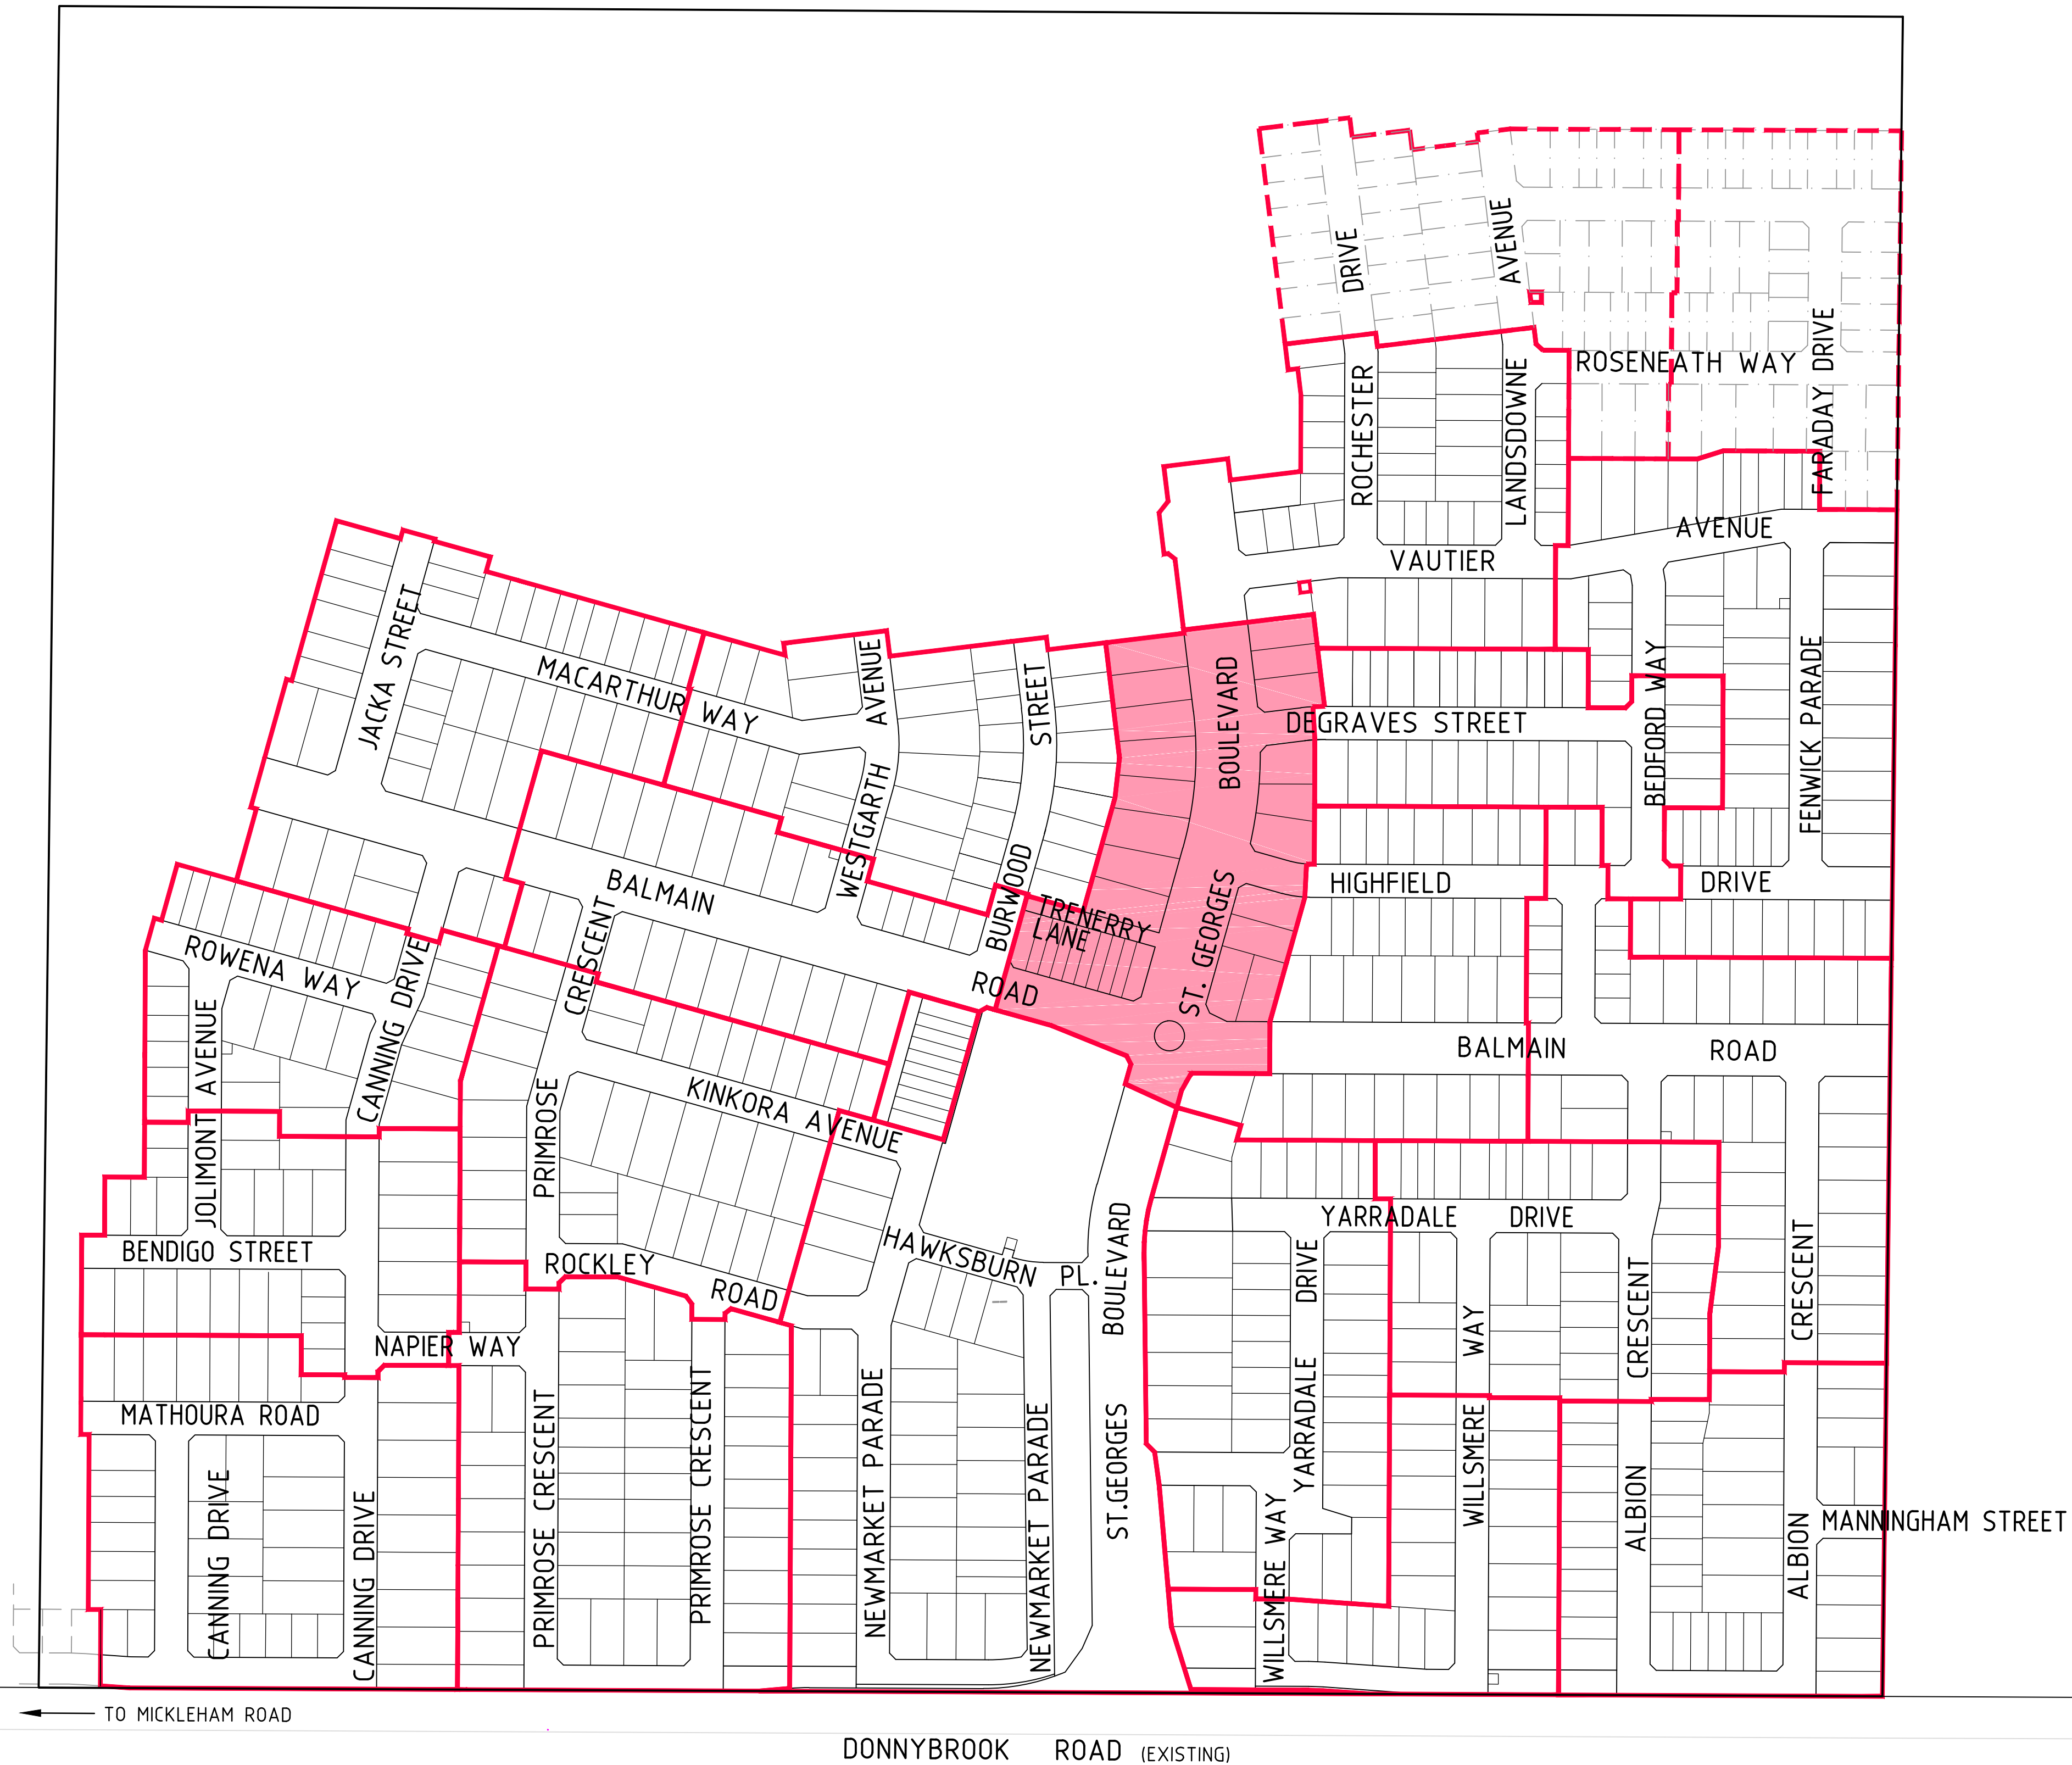

REV	AMENDMENTS	DATE	APP'D.
2	AS CONSTRUCTED	02/07/15	TL
1	LOT LEVELS AMENDED & BURWOOD STREET REMOVED	11/03/15	TL
0	ISSUED FOR CONSTRUCTION	13/02/15	TL

Drawn B.G. Date 19/01/15
Designed B.GORDON
Date 24/03/14
AN 161548
Verified S.LEA
Date 09/9/14
AN 1061480
Audited R.MASON
Date 12/02/15
AN 702569
Approved T.LIAKOPOULOS
Date 13/02/15
AN 883495
Written dimensions to take precedence over scale.
Contractor shall check and verify all dimensions on site.
Discrepancies to be brought to the attention of the Superintendent.

AS CONSTRUCTED

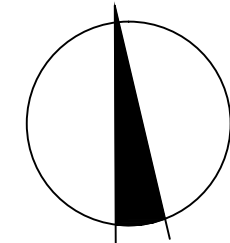

merrifield
MAB gpc

Coords: MGA
Levels: AHD
Hor 1:2000 0m 20m 40m 80m 120m
Scale @ A1/A3 1:2000 1:4000

MERRIFIELD DEVELOPMENT
DONNYBROOK ROAD, MICKLEHAM
STAGE 7
STAGING PLAN

Drawing No. 11727SP01 Rev 2
Sheet No. 04 AS CONSTRUCTED
© Dalton Consulting Engineers Pty Ltd
ABN 78 428 221 049



255 Whitehorse Road
PO Box 349
Balwyn Victoria 3103
Australia
T 61 3 9888 6888
F 61 3 9888 6880
W www.dceprofile.com

Suite 17
46 Douglas Street
PO Box 1178
Milton QLD 4064
Australia
T 61 7 3367 1732
E info@dceprofile.com

WARNING!
THE LOCATION OF EXISTING SERVICES SHOWN
ON THESE PLANS MUST BE PROVEN ON SITE,
THE APPROPRIATE AUTHORITY MUST BE
CONTACTED AND THE SERVICES LOCATED PRIOR
TO COMMENCEMENT OF ANY WORKS.

WARNING
NO DRAINAGE WORKS SHALL COMMENCE UNTIL
THE CONTRACTOR CONFIRMS THE I.L. OF ALL
EXISTING DRAINS, AND CONFIRMS IN WRITING
WITH THE ENGINEERING SUPERVISOR.

NOTE: ALL EXISTING SERVICES
UNDER NEW PAVEMENT TO BE
BACKFILLED WITH FCR

AS CONSTRUCTED

- EXPOSED AGGREGATE PLAIN GREY CONCRETE
COLOUR: PLAIN GREY
AGGREGATE: 12mm BLACK BASALT
FINISH: WATER WASH EXPOSED AGGREGATE
- COLOURED CONCRETE
COLOUR: GREY CONCRETE WITH ABILOX
BLACK CAF X2, DOSE RATE 4.15%
FINISH: LIGHT BROOM FINISH
- EXPOSED AGGREGATE COLOURED CONCRETE
COLOUR: GREY CONCRETE WITH ABILOX
BLACK CAF X2, DOSE RATE 8.3%
AGGREGATE: 12mm BLACK BASALT
FINISH: WATER WASHED EXPOSED AGGREGATE
- ASPHALT PAVEMENT
- CONC FOOTPATH / DRIVEWAY
- CHARCOAL COLORED EXPOSED
AGGREGATE CONCRETE
- GOLDEN BEACH BIANCO
EXPOSED AGGREGATE CONCRETE
- CONC FOOTPATH "BY OTHERS"

STREET NAME	WATER	ND-WATER	GAS	TELSTRA	ELEC.	SEWER
ST. GEORGES BLVD (CH312.368-CH326.869)	3.20 E	2.70 E	2.25 E	3.275 W	4.05 W	-
ST. GEORGES BLVD (CH326.869-CH546.663)	3.20 E	2.70 E	2.25 E	3.275 W	4.05 W	1.00 W
BALMAIN ROAD (EAST OF ST.GEORGES BLVD)	3.15 N	2.675 N	2.25 N	3.10 S	3.60 S	-
BALMAIN ROAD (WEST OF ST.GEORGES BLVD)	3.15 N	2.675 N	2.25 N	0.60 S	1.10 S	1.00 N
HIGHFIELD DRIVE	3.05 N	2.55 N	2.05 N	2.10 S	2.60 S	-
DEGRAVES STREET	3.05 S	2.55 S	2.05 S	2.10 N	2.60 N	-
TRENNERY LANE	-	-	-	-	0.25 N	1.00 S

REV	AMENDMENTS	DATE	APPD.
5	AS CONSTRUCTED	02/07/15	TL
4	DOUBLE DRIVEWAY ADDED TO LOT 728	26/05/15	TL
3	CROSSING TO RESERVE ADDED	01/05/15	TL
2	TRENNERY LANE PAVEMENT AMENDED	24/04/15	TL
1	LOT LEVELS AMENDED & BURWOOD STREET REMOVED	11/03/15	TL
0	ISSUED FOR CONSTRUCTION	13/02/15	TPD

Drawn HT Date 19/01/15
Designed BG
Date 24/03/14
AN 161549
Verified SLEA
Date 09/14
AN 1061481
Audited RMASON
Date 12/02/15
AN 702570
Approved T.LIAKOPOULOS
Date 13/02/15
AN 883498
Written dimensions to take precedence over scale.
Contractor shall check and verify all dimensions on site.
Discrepancies to be brought to the attention of the Superintendent.

- Ex W EXISTING WATER MAIN
- Ex G EXISTING GAS MAIN
- Ex E EXISTING ELECTRICAL CABLE
- Ex S EXISTING SEWER MAIN & MANHOLE
- Ex T EXISTING TELECOMM. CABLE AND PIT
- Ex V EXISTING ELEC. POLE & O'HEAD LINES
- Ex P EXISTING STORMWATER DRAIN & PIT
- CONSTRUCTED PRE DEVELOPMENT
- LIMIT OF WORKS
- POST AND WIRE FENCE
- BRANCH SEWER MAIN AND MANHOLE
- SEWER MAIN AND MANHOLE
- STORMWATER DRAIN & PIT
- SW DRAIN & PIT CONSTRUCTED IN PREVIOUS STAGES
- PROPERTY INLETS
- HOUSE DRAIN
- GAS CONDUIT
- WATER CONDUIT
- RECYCLED WATER CONDUIT
- PERMANENT SURVEY MARK
- TEMPORARY BENCH MARK
- TC TELECOMM. CONDUIT
- OF OPTIC FIBRE
- W WATER
- RW RECYCLED WATER
- T TELECOMMUNICATIONS
- E ELECTRICITY
- G GAS
- STREET NAME SIGN
- REGRADE LOT AT MIN 1 IN 150
- EXISTING SURFACE LEVEL
- FINISHED SURFACE LEVEL

Scale @ A1/A3 1:500/1:1000

Coords: MGA
Levels: AHD

Hor 1:500 0m 5m 10m 20m 30m

merrifield
MAB gpc

MERRIFIELD DEVELOPMENT
DONNYBROOK ROAD, MICKLEHAM
STAGE 7
DETAIL PLAN

Drawing No. 11727DP01 Rev 5
Sheet No. 05 AS CONSTRUCTED

© Dalton Consulting Engineers Pty Ltd
ABN 78 428 221 048

dalton consulting engineers

255 Whitehorse Road
PO Box 345
Balwyn Victoria 3103
Australia
T 61 3 9888 8888
F 61 3 9888 8880
W www.dceprofile.com

Suite 17
PO Box 1178
Milton QLD 4064
Australia
T 61 7 3367 1732
E info@dceprofile.com