


WARNING
NO DRAINAGE WORKS SHALL COMMENCE UNTIL
THE CONTRACTOR CONFIRMS INVERT LEVEL OF
ALL EXISTING DRAINS

MULTI-UNIT
SITE
(LOT 2174 - LOT 2197)
HOUSE DRAIN INVERT LEVEL TO BE LAID
AS LOW AS POSSIBLE

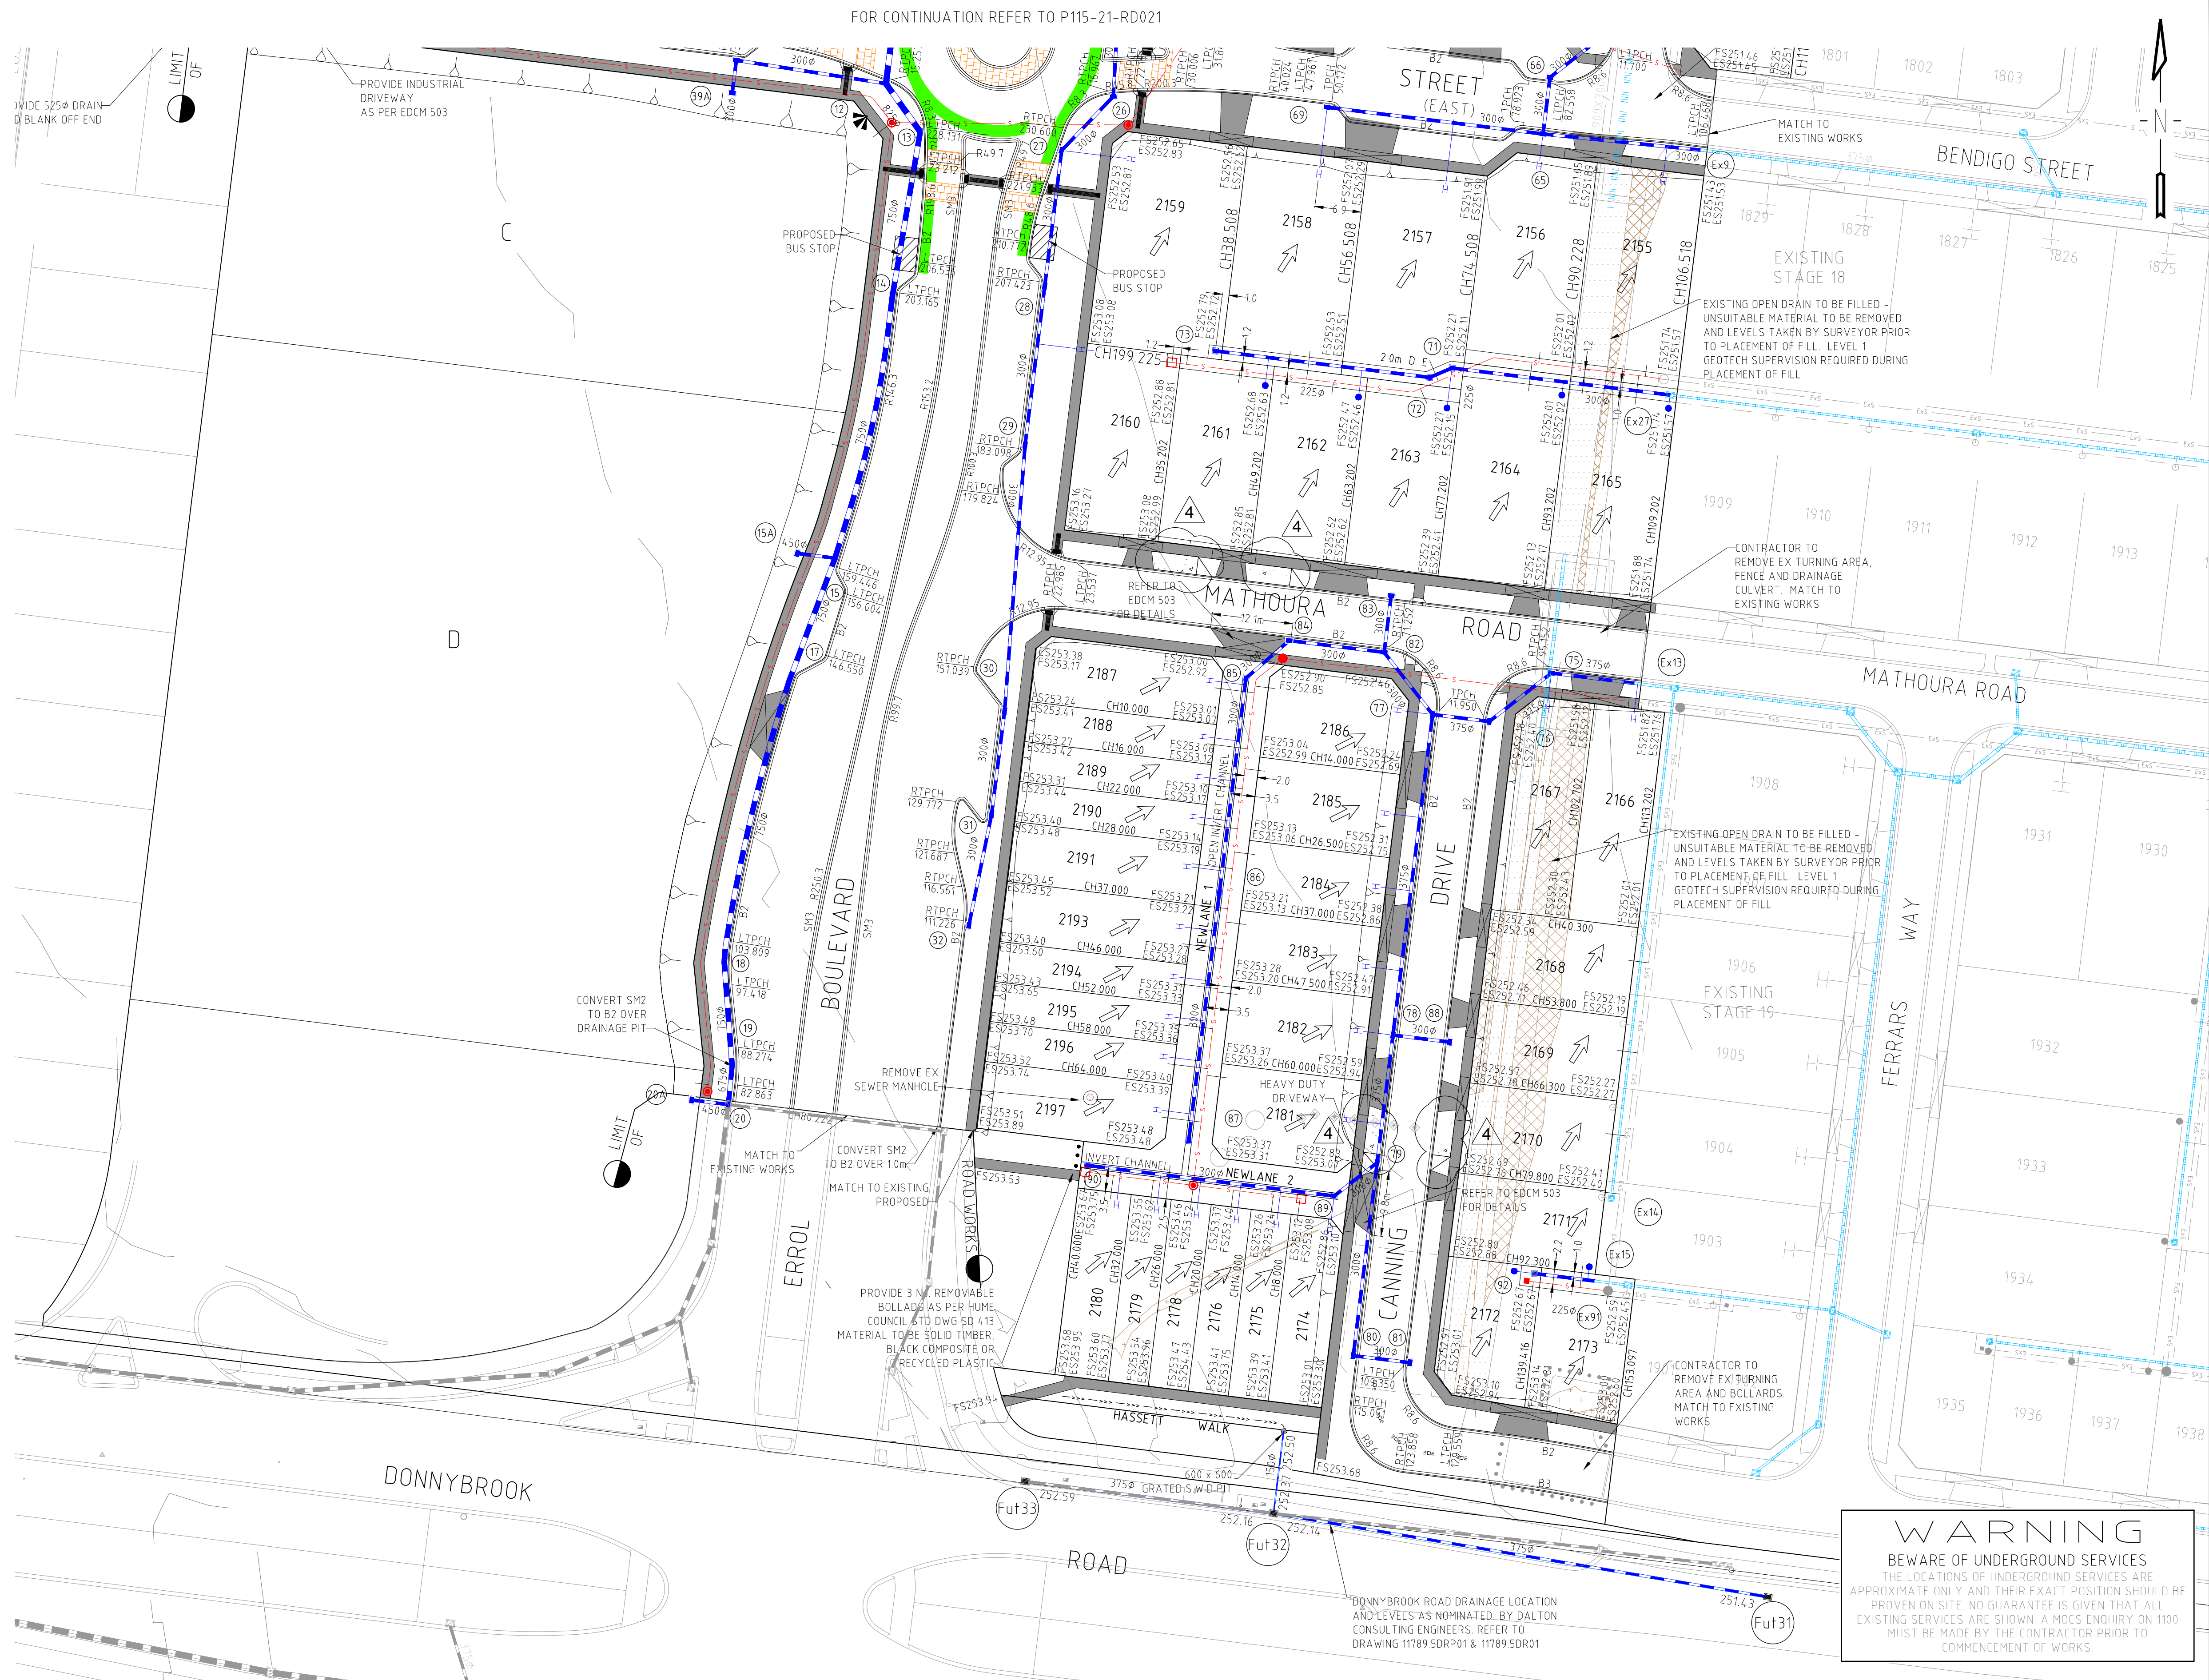

4	AS CONSTRUCTED ISSUE	BG	27/06/17	DRAWN: C.GLEESON
3	AMMENDED FOOTPATH AND DRAINAGE ON HASSETT WALK	BG	14/02/17	DESIGNED: C.J.SANTOS
2	DRAINAGE ALIGNMENT BETWEEN PIT 30-31 AS CONSTRUCTED	BG	16/01/17	
1	DRAINAGE ALIGNMENT BETWEEN PIT 30-31 AMENDED	BG	26/10/16	
0	ISSUED FOR CONSTRUCTION	BG	27/09/16	APPROVED: B.GLEESON
G	COUNCIL COMMENTS	BG	26/09/16	
REV	DESCRIPTION	APPROVED	DATE	

LEGEND	
	LOT GRADE
	EXISTING SURFACE LEVEL
	TOP OF BATTER LEVEL
	PERMANENT SURVEY MARK
	TEMPORARY BENCH MARK
	REMOVE EX TREE
	PROPOSED DRAINAGE
	EXISTING DRAINAGE
	TABLE DRAIN
	PROPERTY INLET
	HOUSE DRAIN
	SWD PIT NUMBERS
	EXISTING SEWER
	PROPOSED SEWER

CLIENT:

merrifield

MAB **GPC**

vervePROJECTS
DELIVERING EXCEPTIONAL RESULTS

Level 1, 173 Burke Road, Glen Iris VIC 3146
Tel : 03 8573 1500 Fax: 03 8573 1555

COUNCIL:

HUME CITY COUNCIL

PROJECT:

MERRIFIELD LIVING - SECTION B
STAGE 21
MICKLEHAM



ISSUE:

AS CONSTRUCTED

MELWAY REF: 366 D3/E4
PROJECT No: P115-21
DWG No: RD020
REVISION: 4

TITLE:	DETAIL PLAN - 1
ISSUE:	AS CONSTRUCTED
MELWAY REF:	366 D3/E4
PROJECT No:	P115-21
DWG No:	RD020
REVISION:	4

WARNING
NO DRAINAGE WORKS SHALL COMMENCE UNTIL
THE CONTRACTOR CONFIRMS INVERT LEVEL OF
ALL EXISTING DRAINS

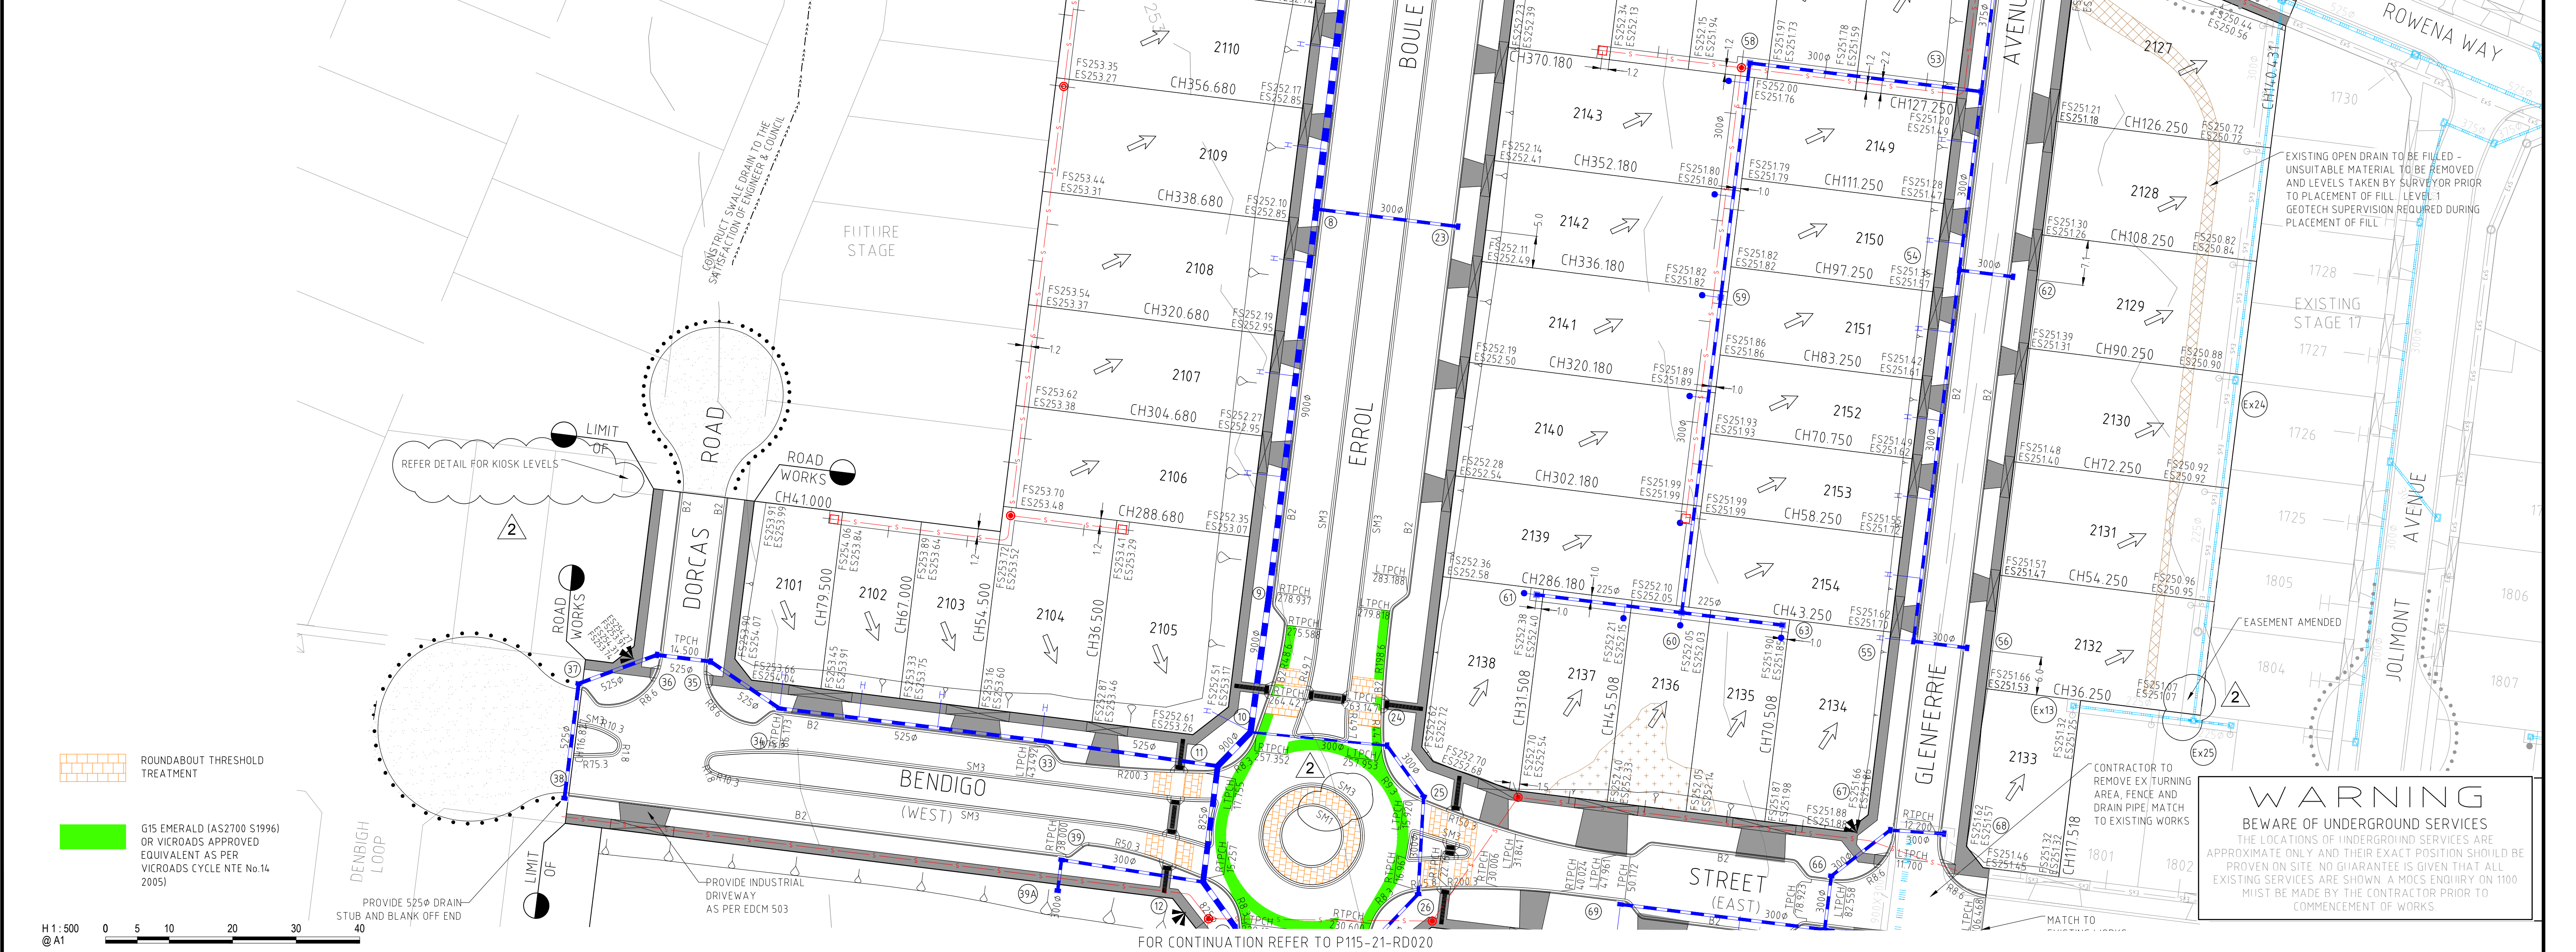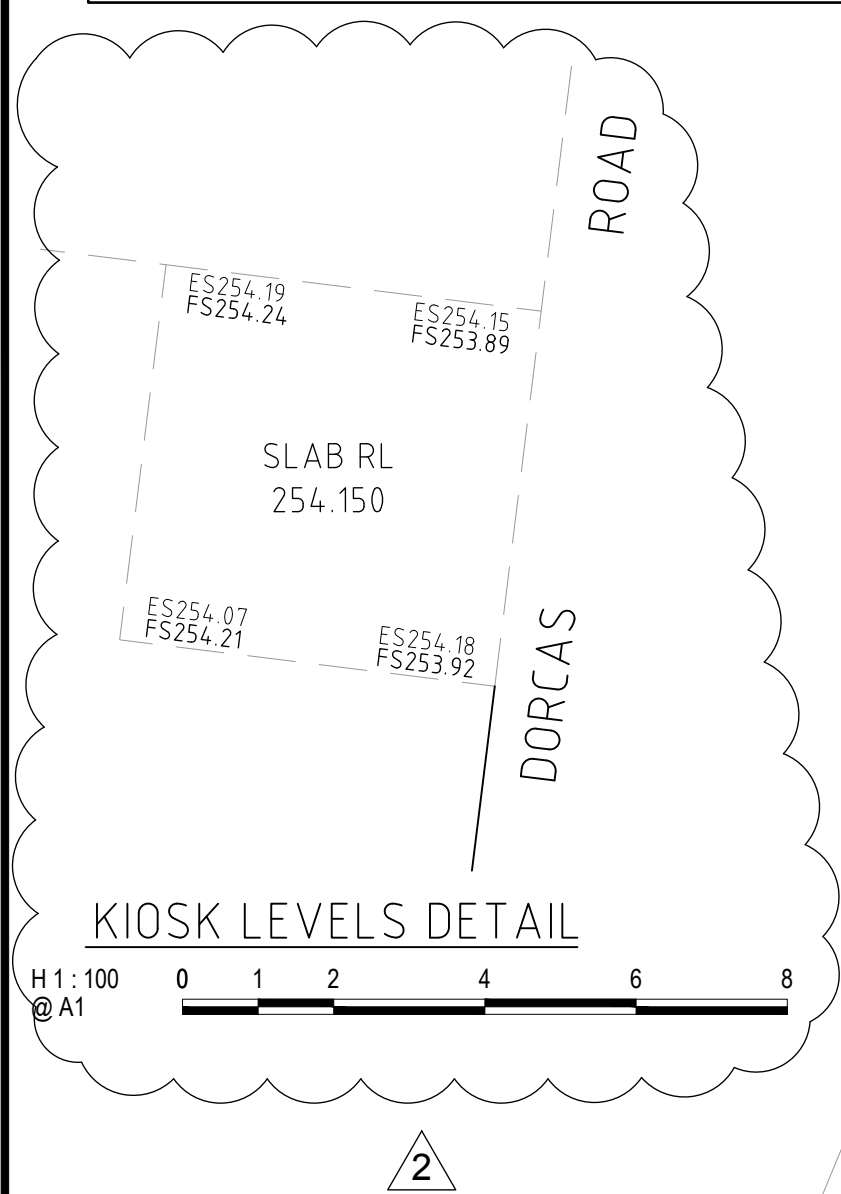

REV	DESCRIPTION	APPROVED	DATE
2	AS CONSTRUCTED ISSUE	BG	27/06/17
1	AMENDED EASEMENT LOT 2132	BG	08/06/17
0	ISSUED FOR CONSTRUCTION	BG	27/09/16
D	COUNCIL COMMENTS	BG	20/09/16
C	COUNCIL COMMENTS	BG	03/08/16
B	COUNCIL COMMENTS	BG	10/06/16

DRAWN: C.GLEESON	DESIGNED: C.J.SANTOS	APPROVED: B.GLEESON
---------------------	-------------------------	------------------------

LEGEND	PROPOSED DRAINAGE	CUT >150mm DEPTH
ES44.26 FS44.60 B44.60	EXISTING SURFACE LEVEL	
	FINISHED SURFACE LEVEL	
	TOP OF BATTER LEVEL	
	PROPERTY INLET	
	HOUSE DRAIN	
	PERMANENT SURVEY MARK	
	TEMPORARY BENCH MARK	
	REMOVE EX TREE	
	PROPOSED DRAINAGE	
	EXISTING DRAINAGE	
	TABLE DRAIN	
	PROPERTY INLET	
	HOUSE DRAIN	
	SWD PIT NUMBERS	
	EXISTING SEWER	
	PROPOSED SEWER	

CLIENT:

merrifield

MAB gpc

vervePROJECTS
DELIVERING EXCEPTIONAL RESULTS

Level 1, 173 Burke Road, Glen Iris VIC 3146
Tel: 03 8573 1500 Fax: 03 8573 1555

COUNCIL: HUME CITY COUNCIL

PROJECT: MERRIFIELD LIVING - SECTION B
STAGE 21
MICKLEHAM

ISSUE: **AS CONSTRUCTED**

MELWAY REF: 366 D3/E4


PROJECT No: P115-21

DWG No: RD021

REVISION: 2

DETAIL PLAN - 2

WARNING
NO DRAINAGE WORKS SHALL COMMENCE UNTIL
THE CONTRACTOR CONFIRMS INVERT LEVEL OF
ALL EXISTING DRAINS

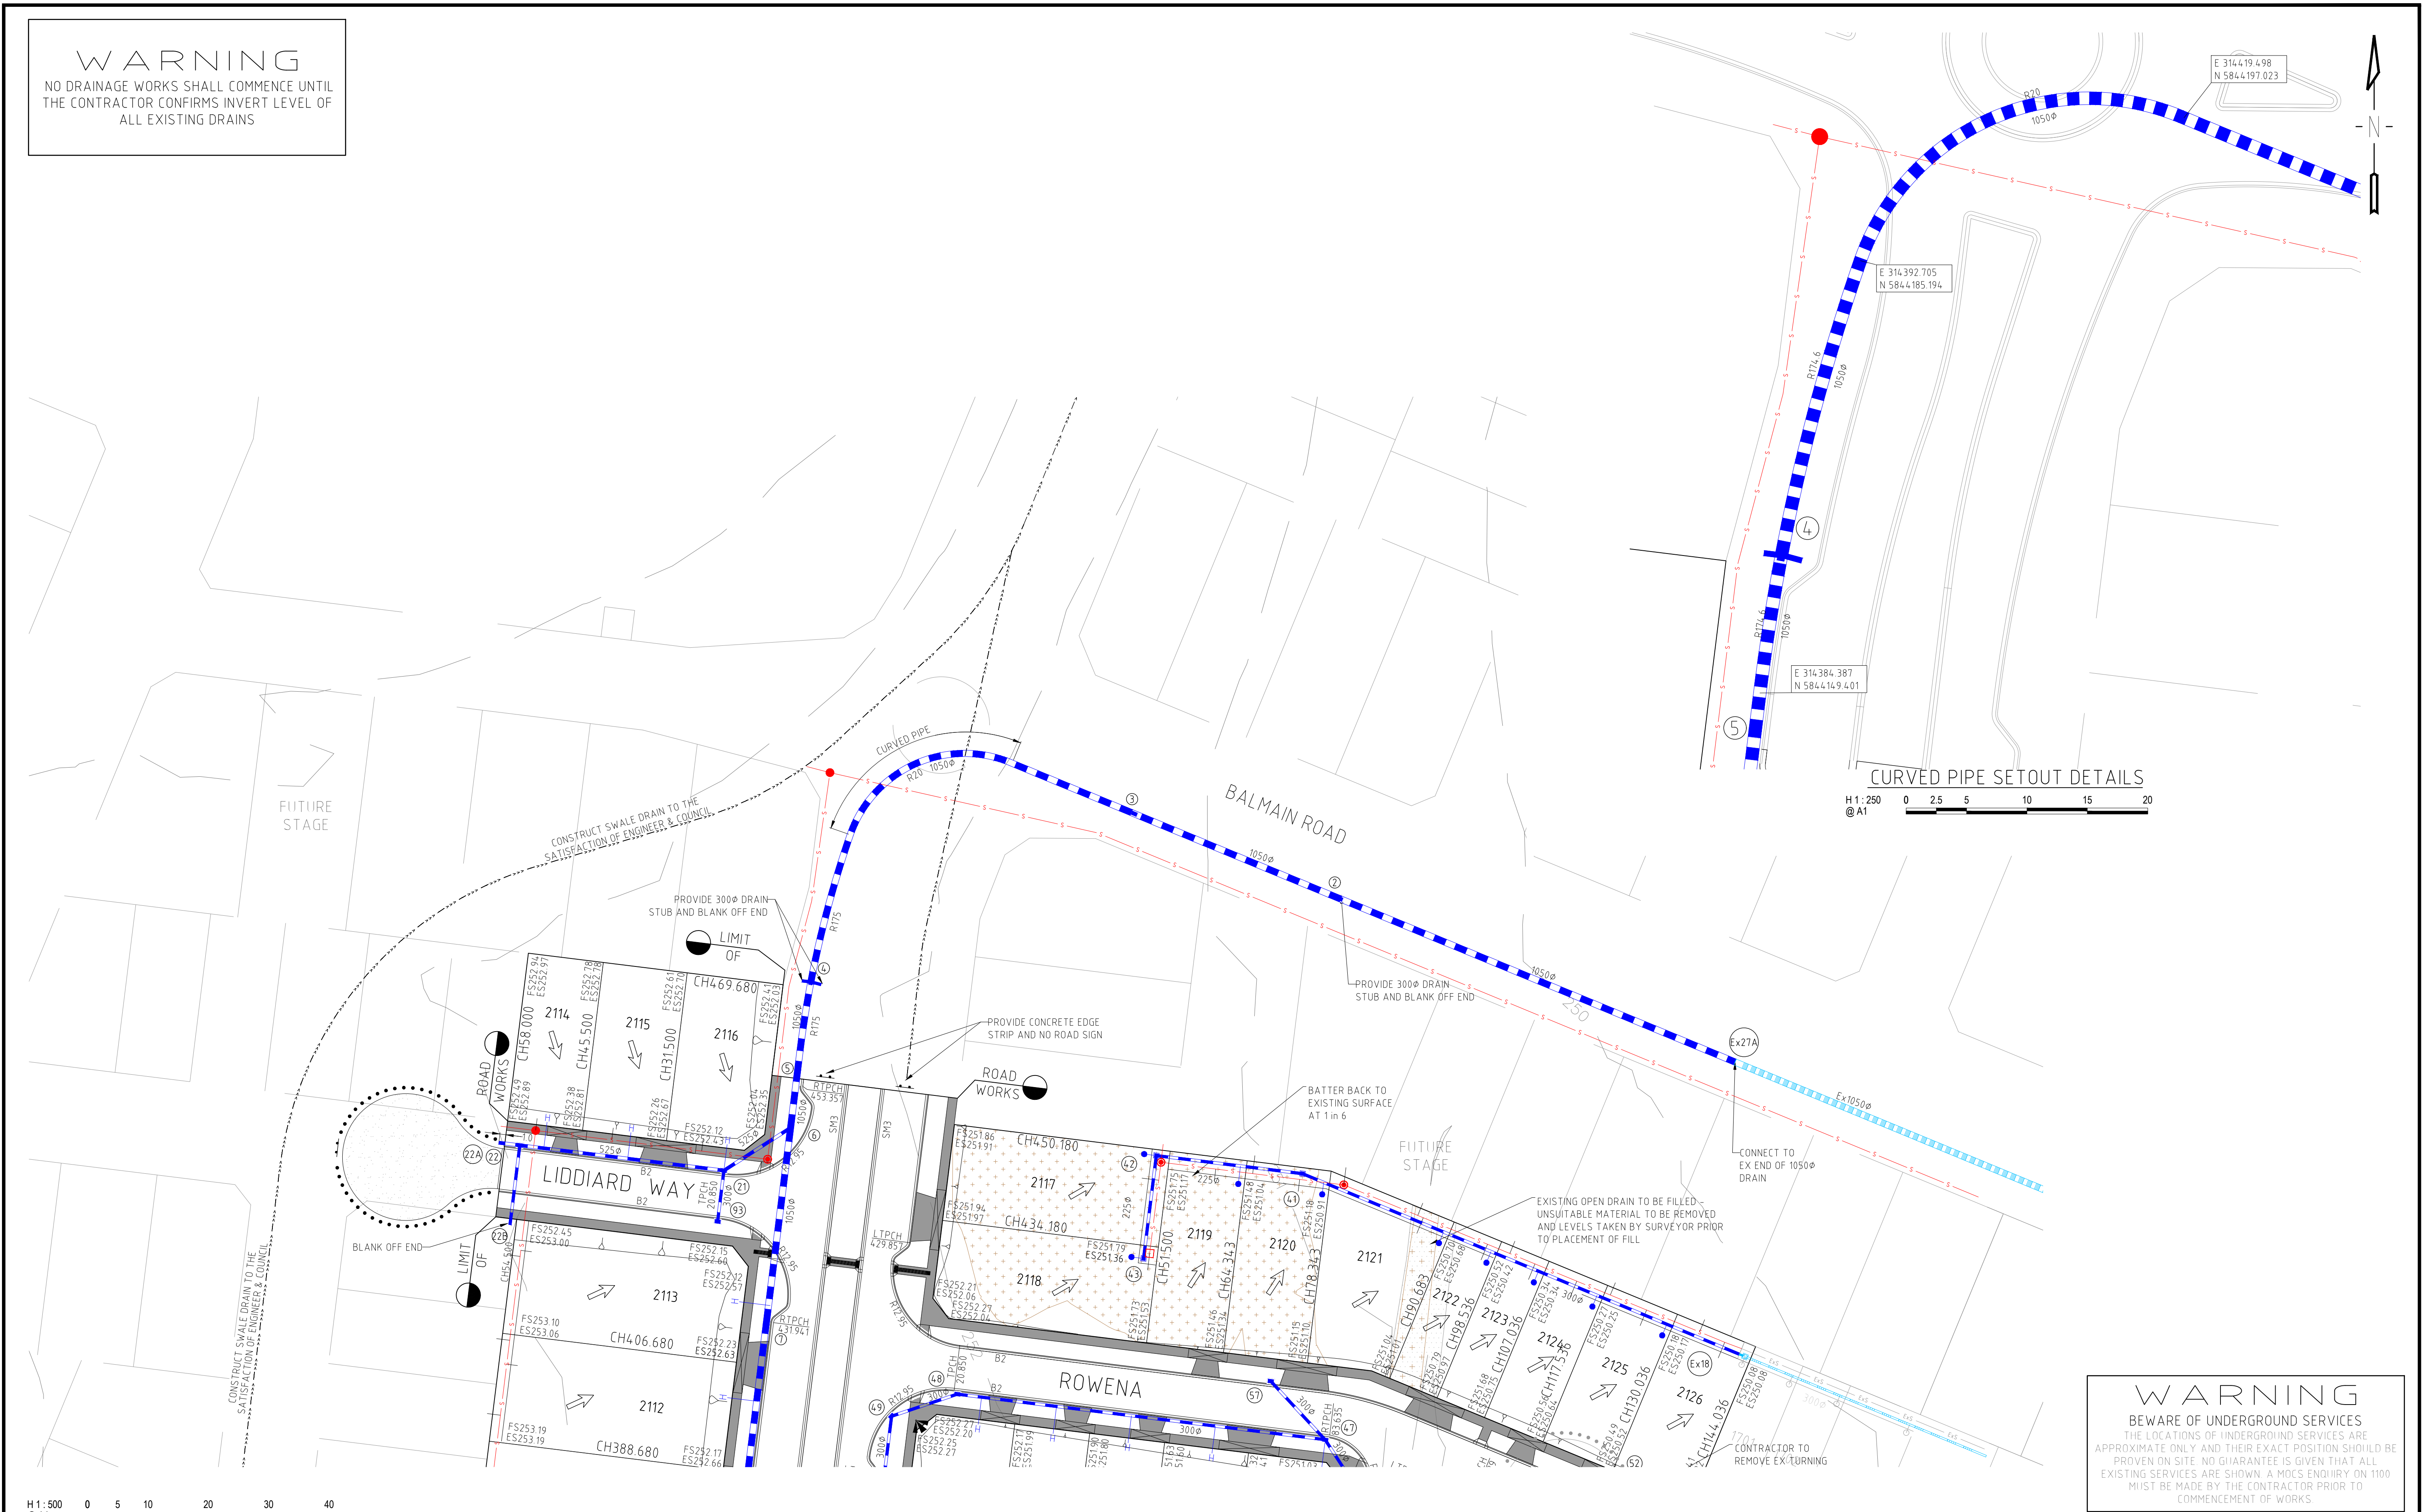

FOR CONTINUATION REFER TO P115-21-RD020

2	AS CONSTRUCTED ISSUE	BG	27/06/17	DRAWN: C.GLEESON
1	SIZE OF DRAINAGE STUBS REVISED	BG	26/10/16	DESIGNED: C.J.SANTOS
0	ISSUED FOR CONSTRUCTION	BG	27/09/16	APPROVED: B.GLEESON
C	COUNCIL COMMENTS	BG	03/08/16	
B	COUNCIL COMMENTS	BG	10/06/16	
A	PRELIMINARY ISSUE	BG	04/03/16	
REV	DESCRIPTION	APPROVED	DATE	

LEGEND	
	LOT GRADE
	EXISTING SURFACE LEVEL
	TOP OF BATTER LEVEL
	PERMANENT SURVEY MARK
	TEMPORARY BENCH MARK
	REMOVE EX TREE
	PROPOSED DRAINAGE
	EXISTING DRAINAGE
	TABLE DRAIN
	PROPERTY INLET
	HOUSE DRAIN
	SWD PIT NUMBERS
	EXISTING SEWER
	PROPOSED SEWER
	CUT >150mm DEPTH
	FILL >300mm DEPTH

CLIENT:

merrifield

MAB **GPC**

vervePROJECTS
DELIVERING EXCEPTIONAL RESULTS

Level 1, 173 Burke Road, Glen Iris VIC 3146
Tel : 03 8573 1500 Fax: 03 8573 1555

COUNCIL:	HUME CITY COUNCIL	TITLE:	DETAIL PLAN - 3
PROJECT:	MERRIFIELD LIVING - SECTION B STAGE 21 MICKLEHAM	MELWAY REF:	366 D3/E4
ISSUE:	AS CONSTRUCTED	PROJECT No:	P115-21
		DWG No:	RD022
		REVISION:	2