



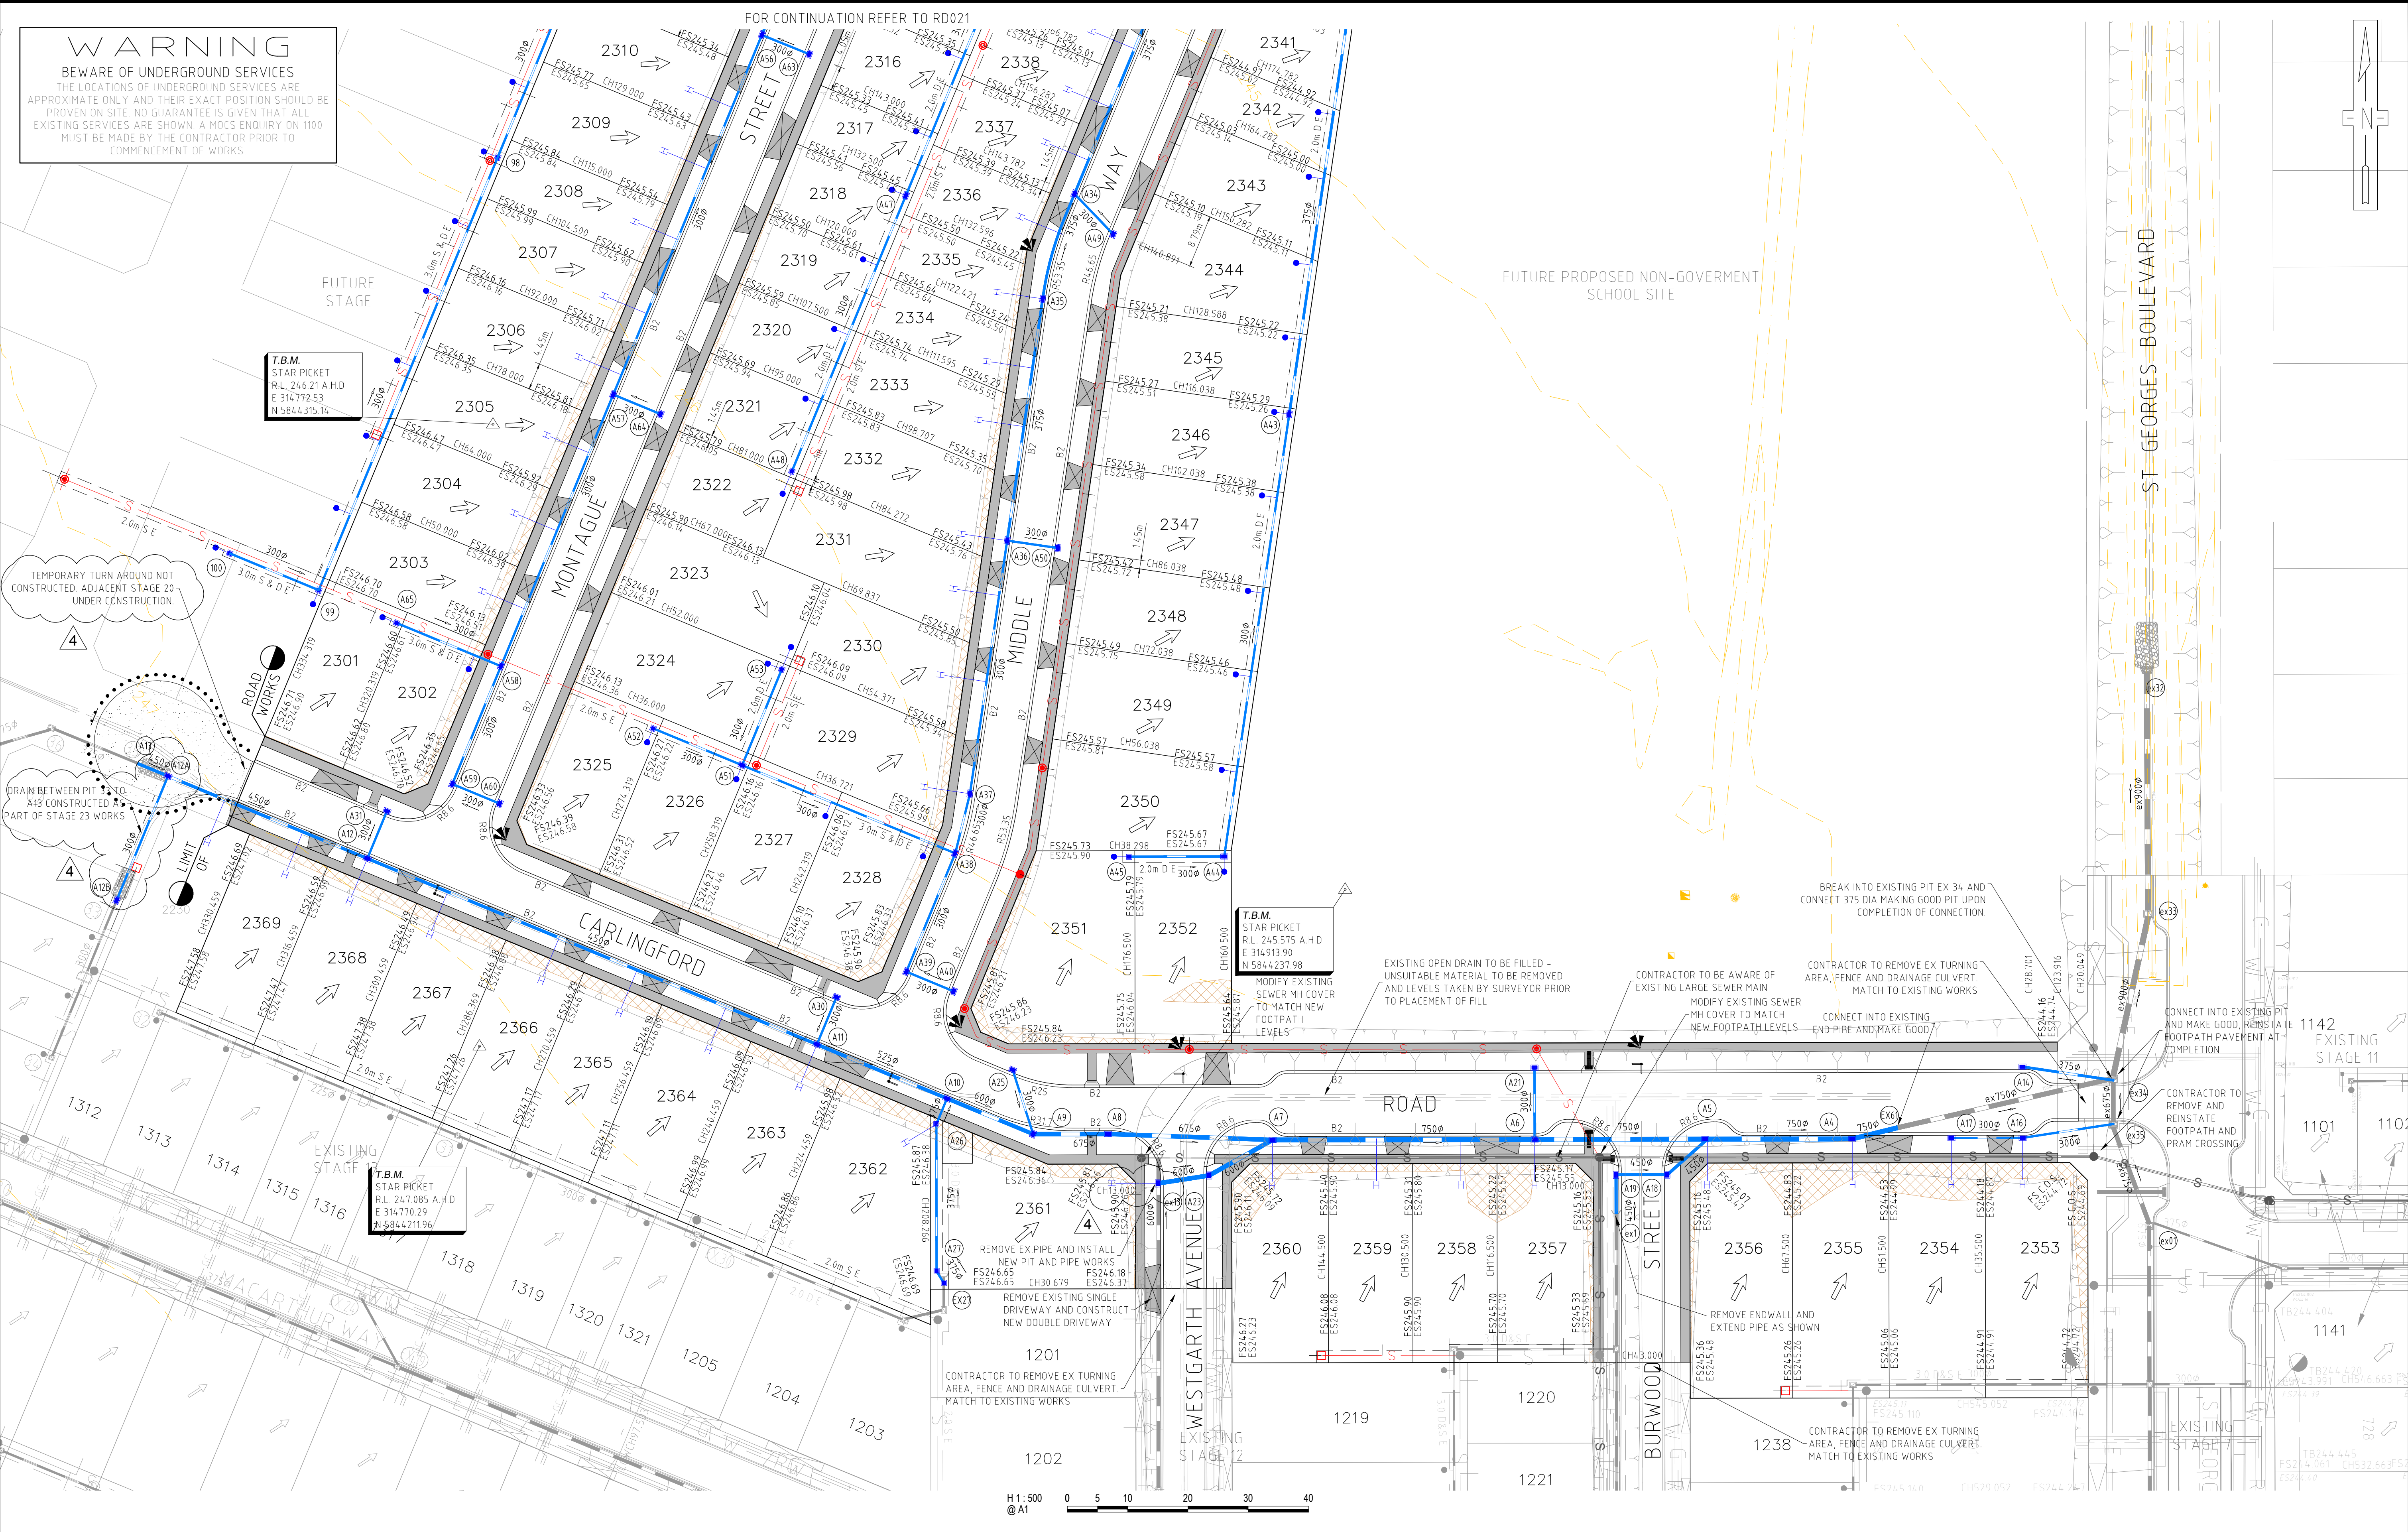


WARNING

BEWARE OF UNDERGROUND SERVICES

THE LOCATIONS OF UNDERGROUND SERVICES ARE APPROXIMATE ONLY AND THEIR EXACT POSITION SHOULD BE PROVEN ON SITE. NO GUARANTEE IS GIVEN THAT ALL EXISTING SERVICES ARE SHOWN. A MOC'S ENQUIRY ON 1100 MUST BE MADE BY THE CONTRACTOR PRIOR TO COMMENCEMENT OF WORKS.

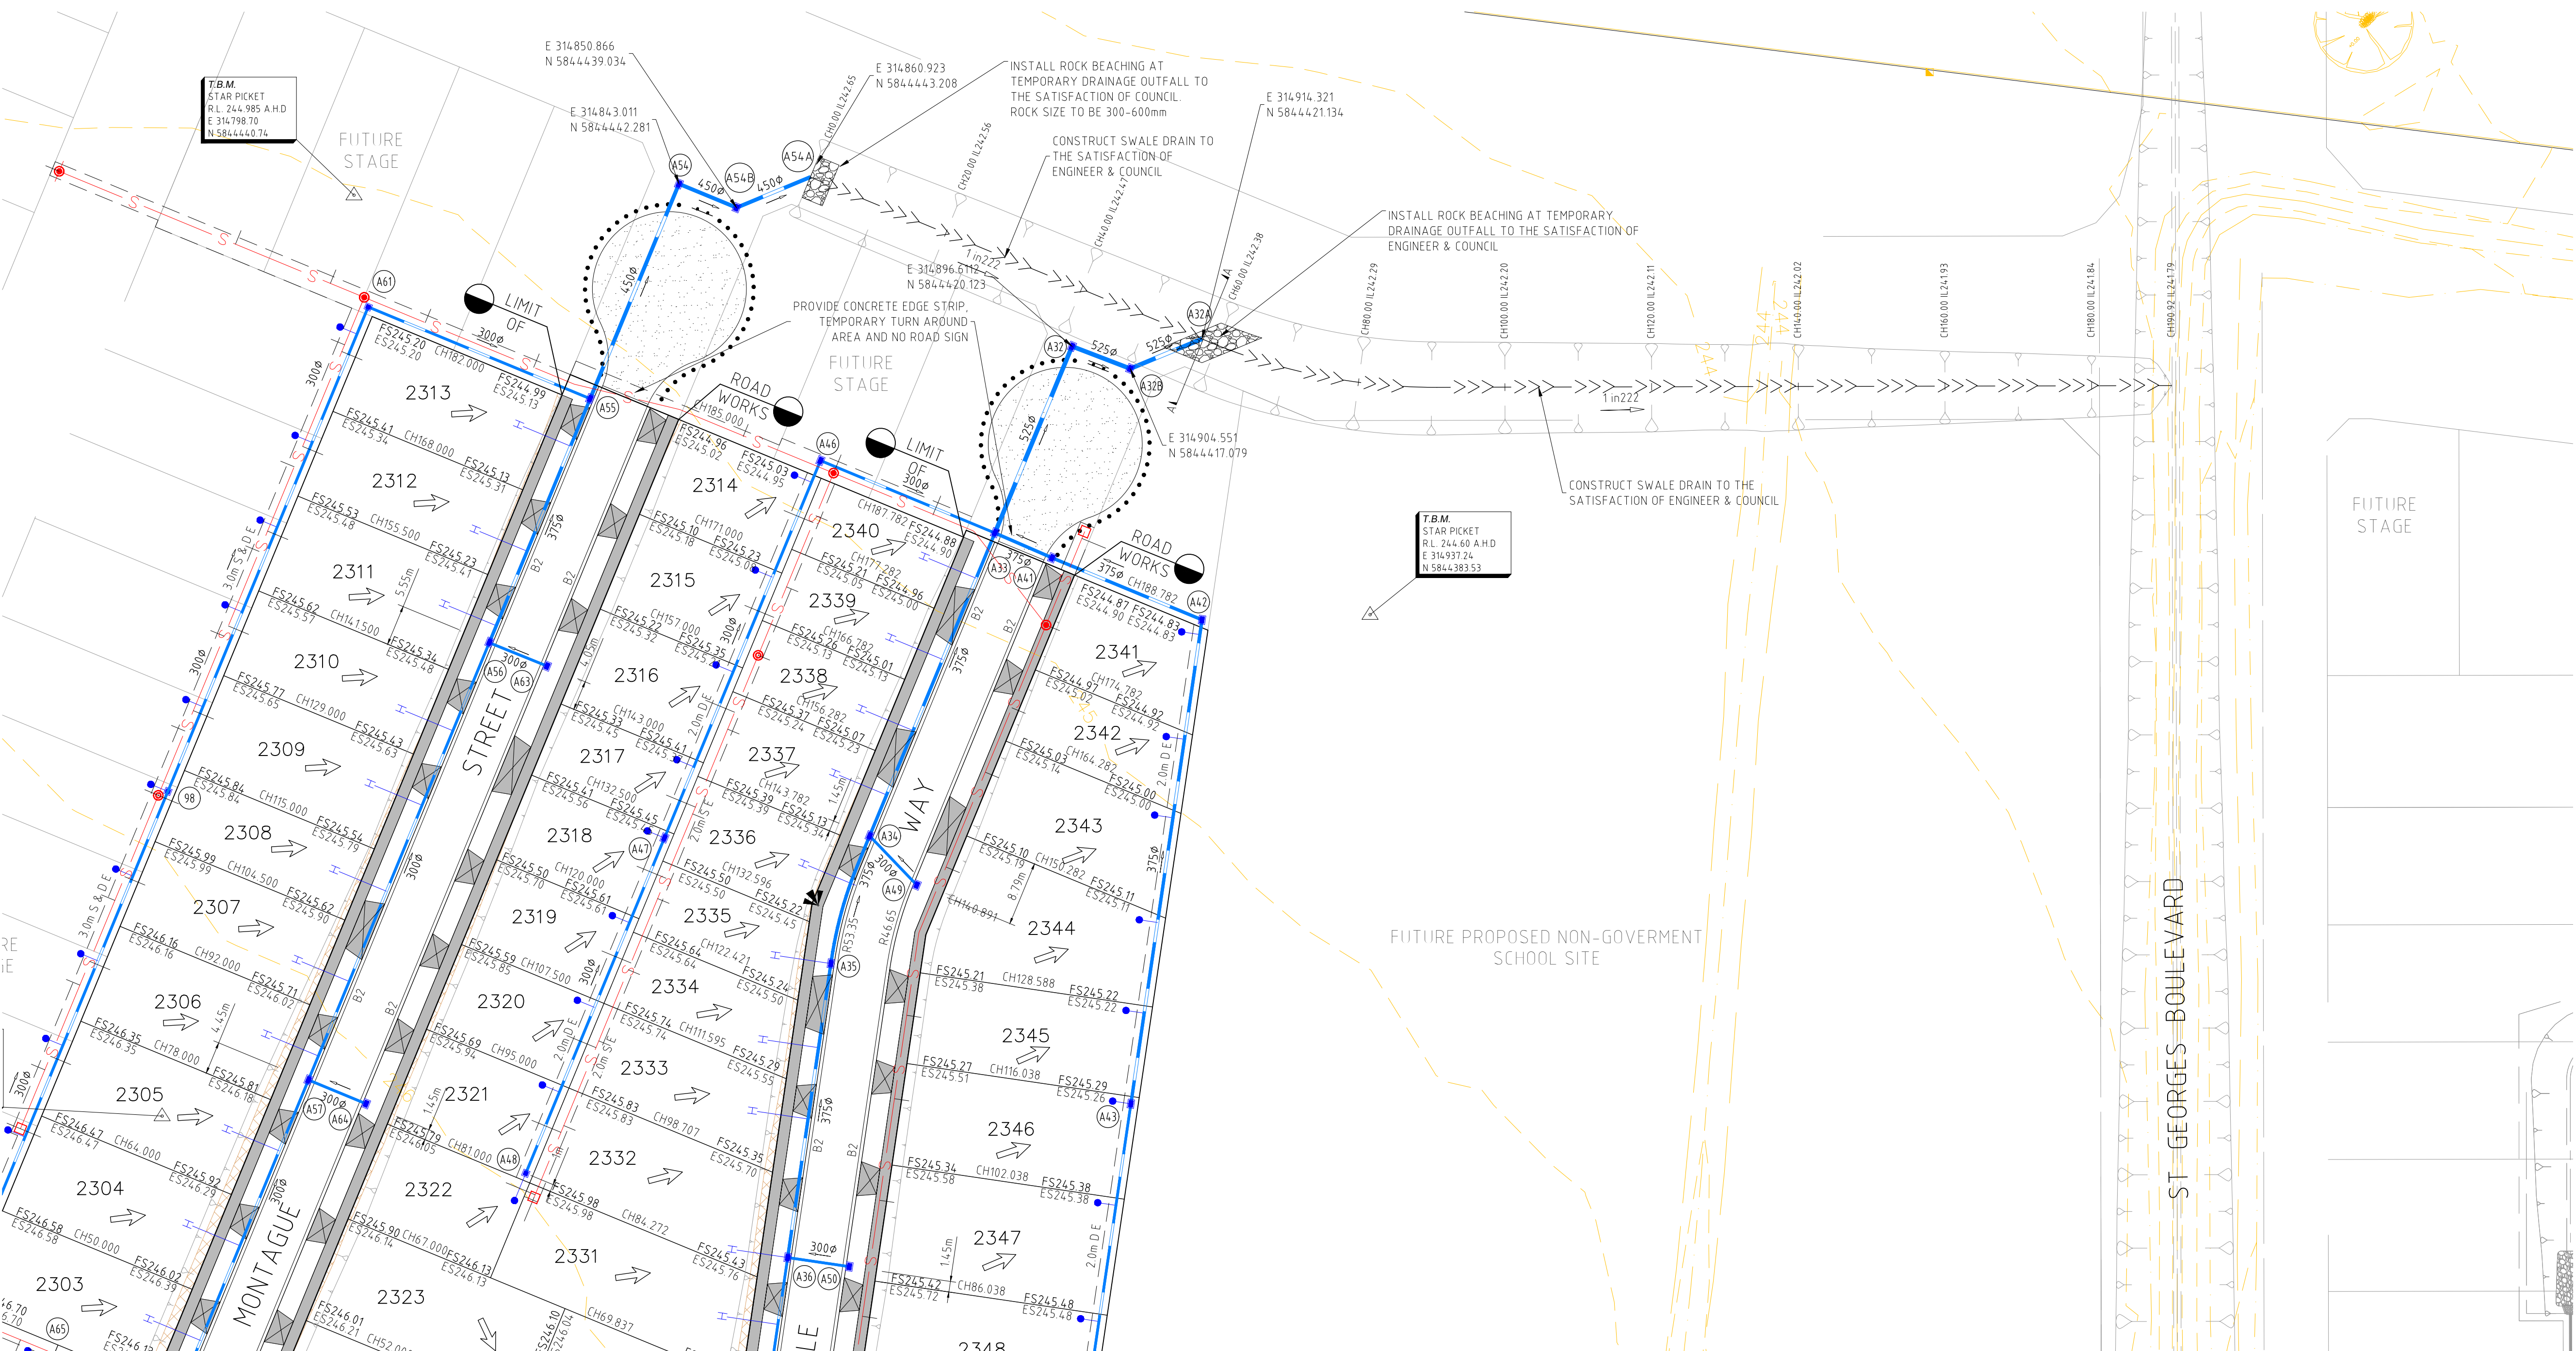

FOR CONTINUATION REFER TO RD020

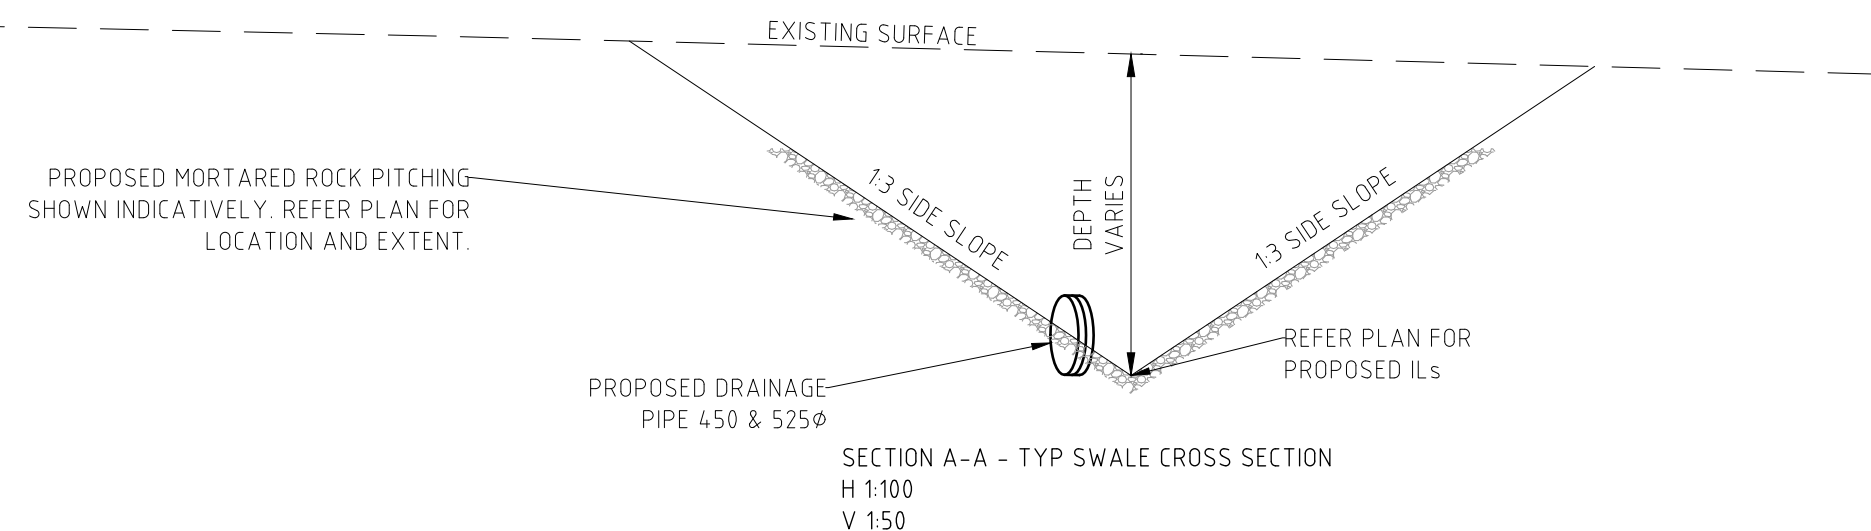

H 1:500
@ A1

2	AS CONSTRUCTED ISSUE	J.W.	31/01/17	DRAWN:
1	CONTRACTORS COMMENTS	B.G.	18/08/16	LAPAP
0	ISSUED FOR CONSTRUCTION	B.G.	10/08/16	DESIGNED:
C	ISSUED FOR APPROVAL	B.G.	01/08/16	T.HOI
B	REVISED SERVICE OFFSETS	B.G.	04/05/16	APPROVED:
A	ISSUED FOR APPROVAL	B.G.	06/04/16	B.GLEESON
REV	DESCRIPTION	APPROVED	DATE	

LEGEND	
	LOT GRADE
	EXISTING SURFACE LEVEL
	FINISHED SURFACE LEVEL
	TOP OF BATTER LEVEL
	PERMANENT SURVEY MARK
	TEMPORARY BENCH MARK
	REMOVE EX TREE
	PROPOSED DRAINAGE
	EXISTING DRAINAGE
	TABLE DRAIN
	PROPERTY INLET
	HOUSE DRAIN
	SWD PIT NUMBERS
	EXISTING SEWER
	PROPOSED SEWER
	CUT >150mm DEPTH
	FILL >300mm DEPTH

CLIENT:

merrifield

MAB gpc

verve

Verve Projects Pty Ltd
Level 11 173 Burke Road
Glen Iris VIC 3146
T 03 8573 1500
verveprojects.com

COUNCIL:	HUME CITY COUNCIL	TITLE:	
PROJECT:	MERRIFIELD LIVING - SECTION B STAGE 23 MICKLEHAM	DETAIL PLAN - 2	
ISSUE:	AS CONSTRUCTED	MELWAY REF:	366 D3/D4
PROJECT No:	P115-23	DWG No:	RD021
REVISION:			2