



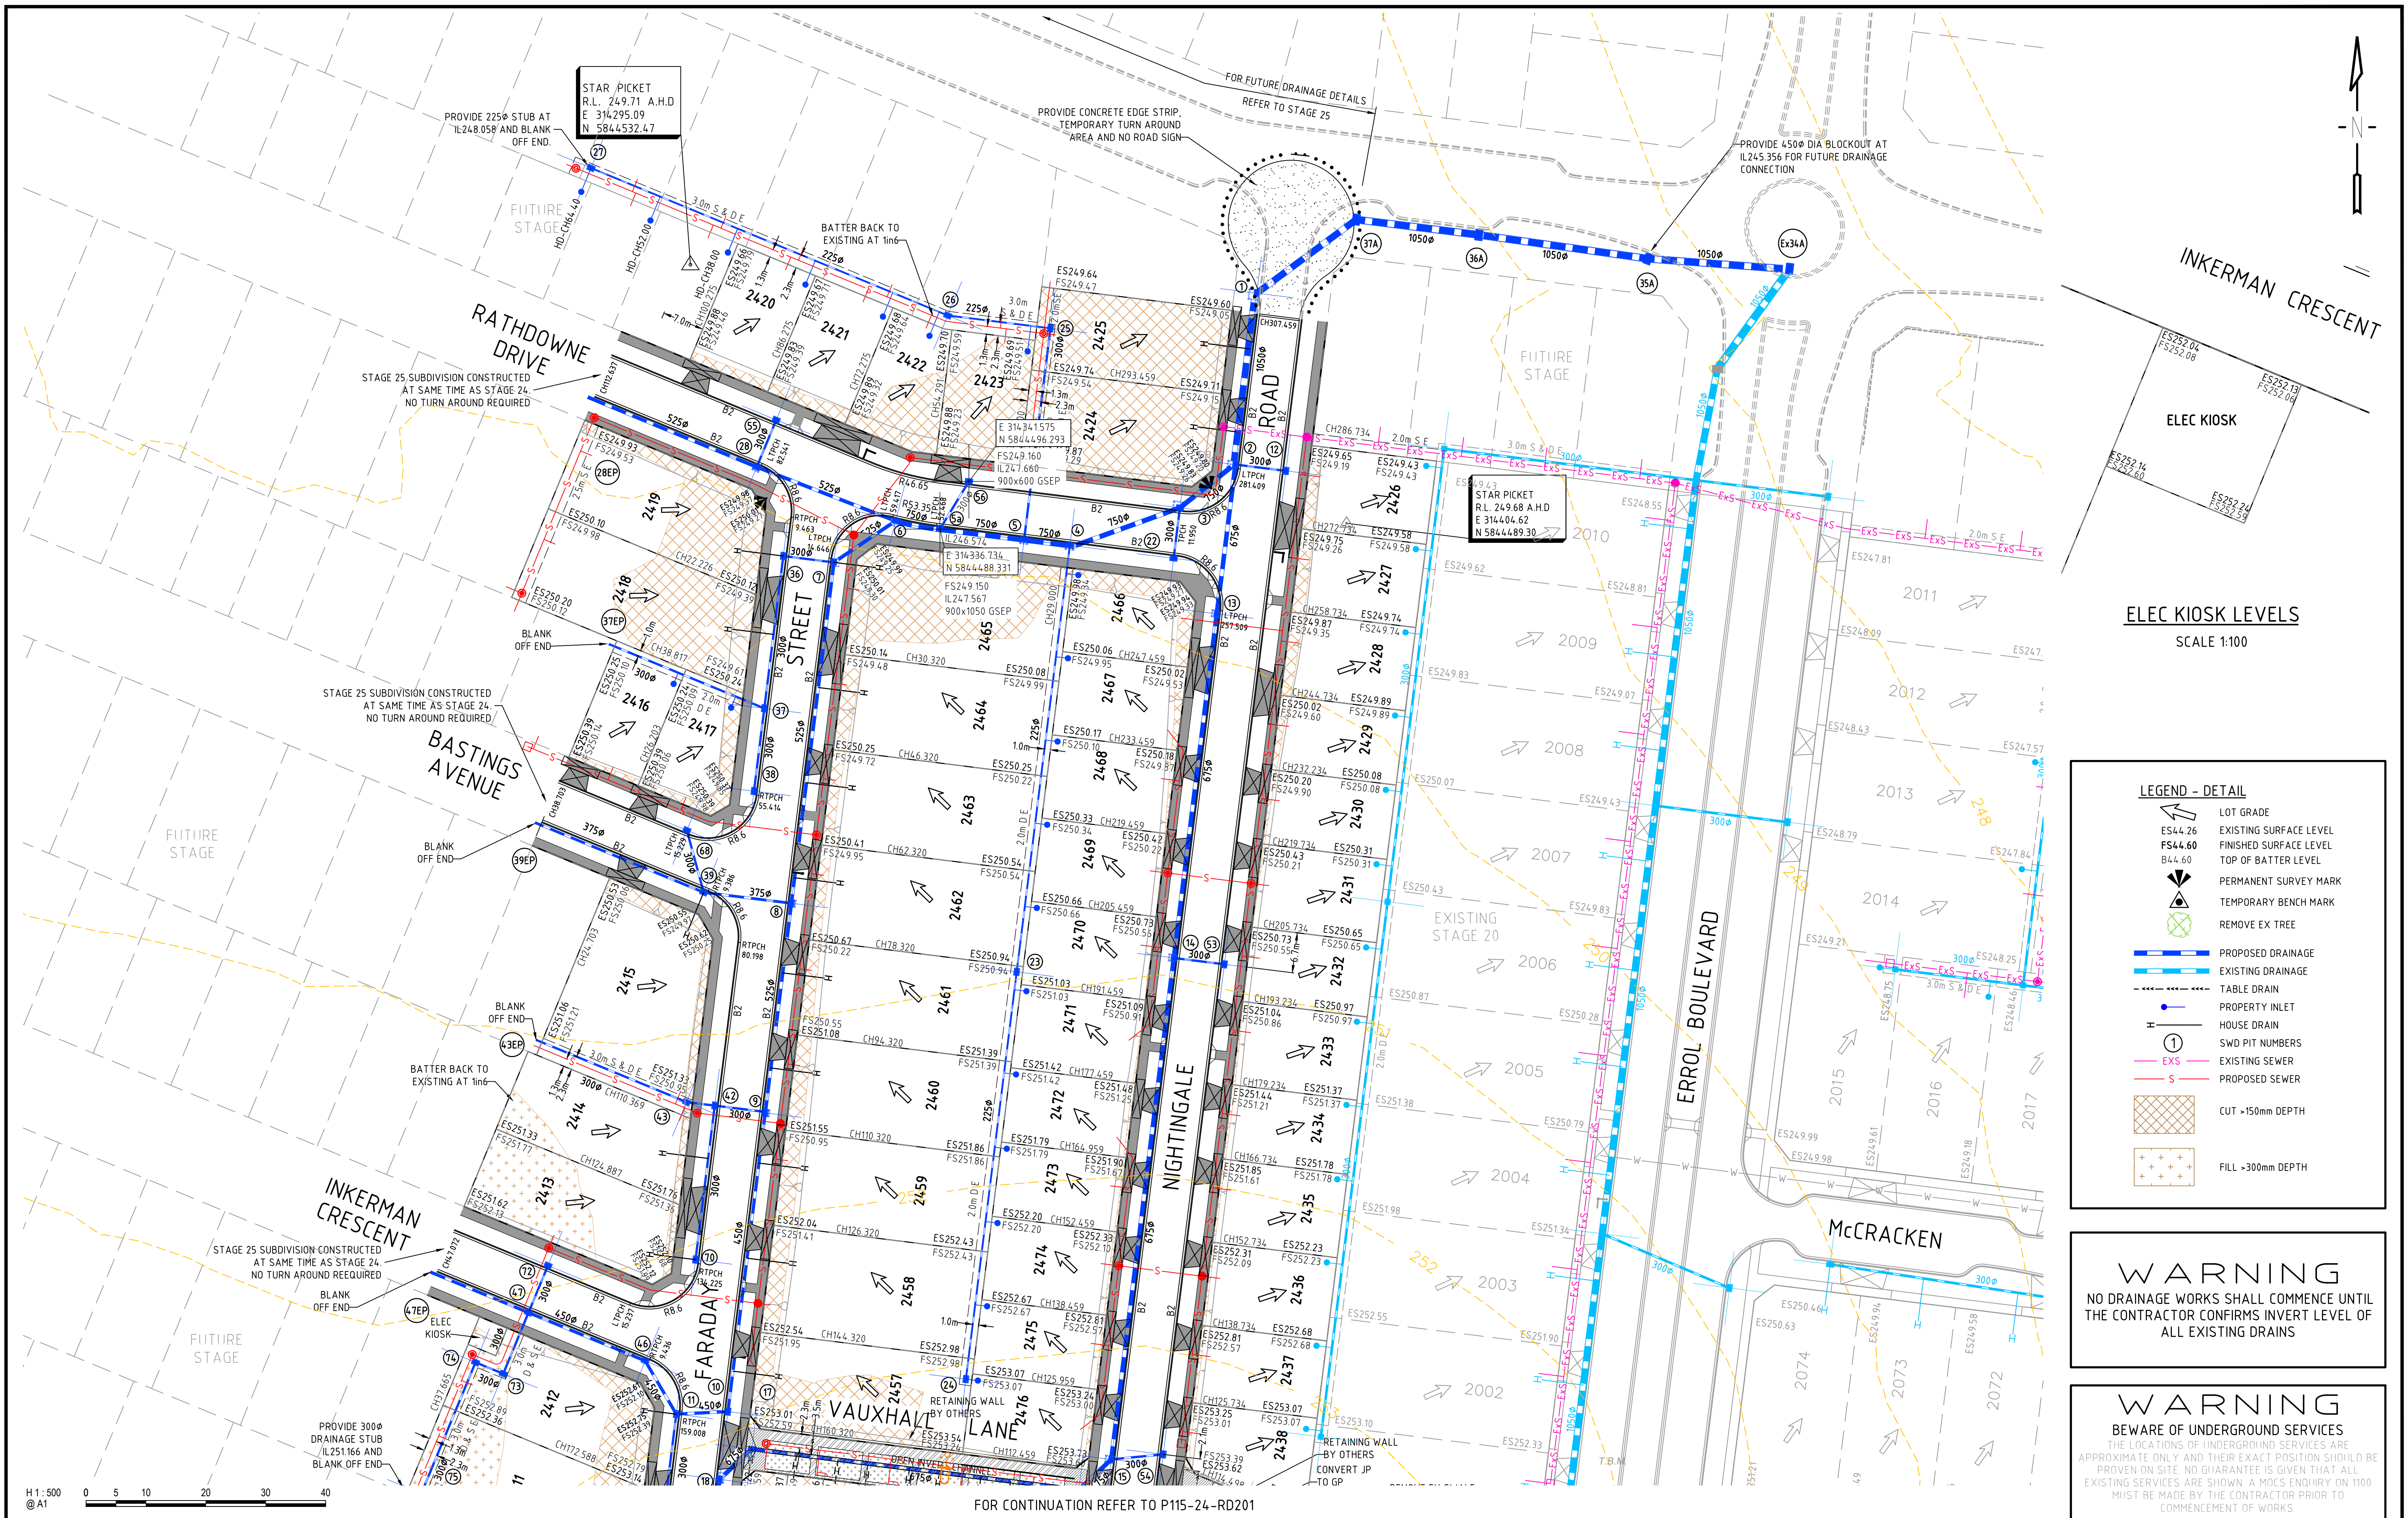


2	AS CONSTRUCTED ISSUE	JW	21.10.17	DRAWN:	C.GLEESON
1	DRAINAGE AMENDMENT	GR	05.04.17	DESIGNED:	C.J.SANTOS
0	CONSTRUCTION ISSUE	GR	14.02.17	APPROVED:	G.ROMANCZ
C	COUNCIL COMMENTS	GR	07.02.17		
B	COUNCIL COMMENTS	GR	23.12.16		
A	PRELIMINARY ISSUE	GR	12.10.16		
REV	DESCRIPTION	APPROVED	DATE		

CLIENT:	merrifield
	MAB gpc
	verve
	Verve Projects Pty Ltd Level 11 173 Burke Road Glen Iris VIC 3146 T 03 8573 1500 verveprojects.com

COUNCIL:	HUME CITY COUNCIL	TITLE:	MERRIFIELD LIVINGS - SECTION B STAGE 24 MICKLEHAM
PROJECT:	AS CONSTRUCTED	MELWAY REF:	366 D3/E4
PROJECT No:	P115-24	DWG No:	RD200
REVISION:	2		

FOR CONTINUATION REFER TO P115-24-RD200

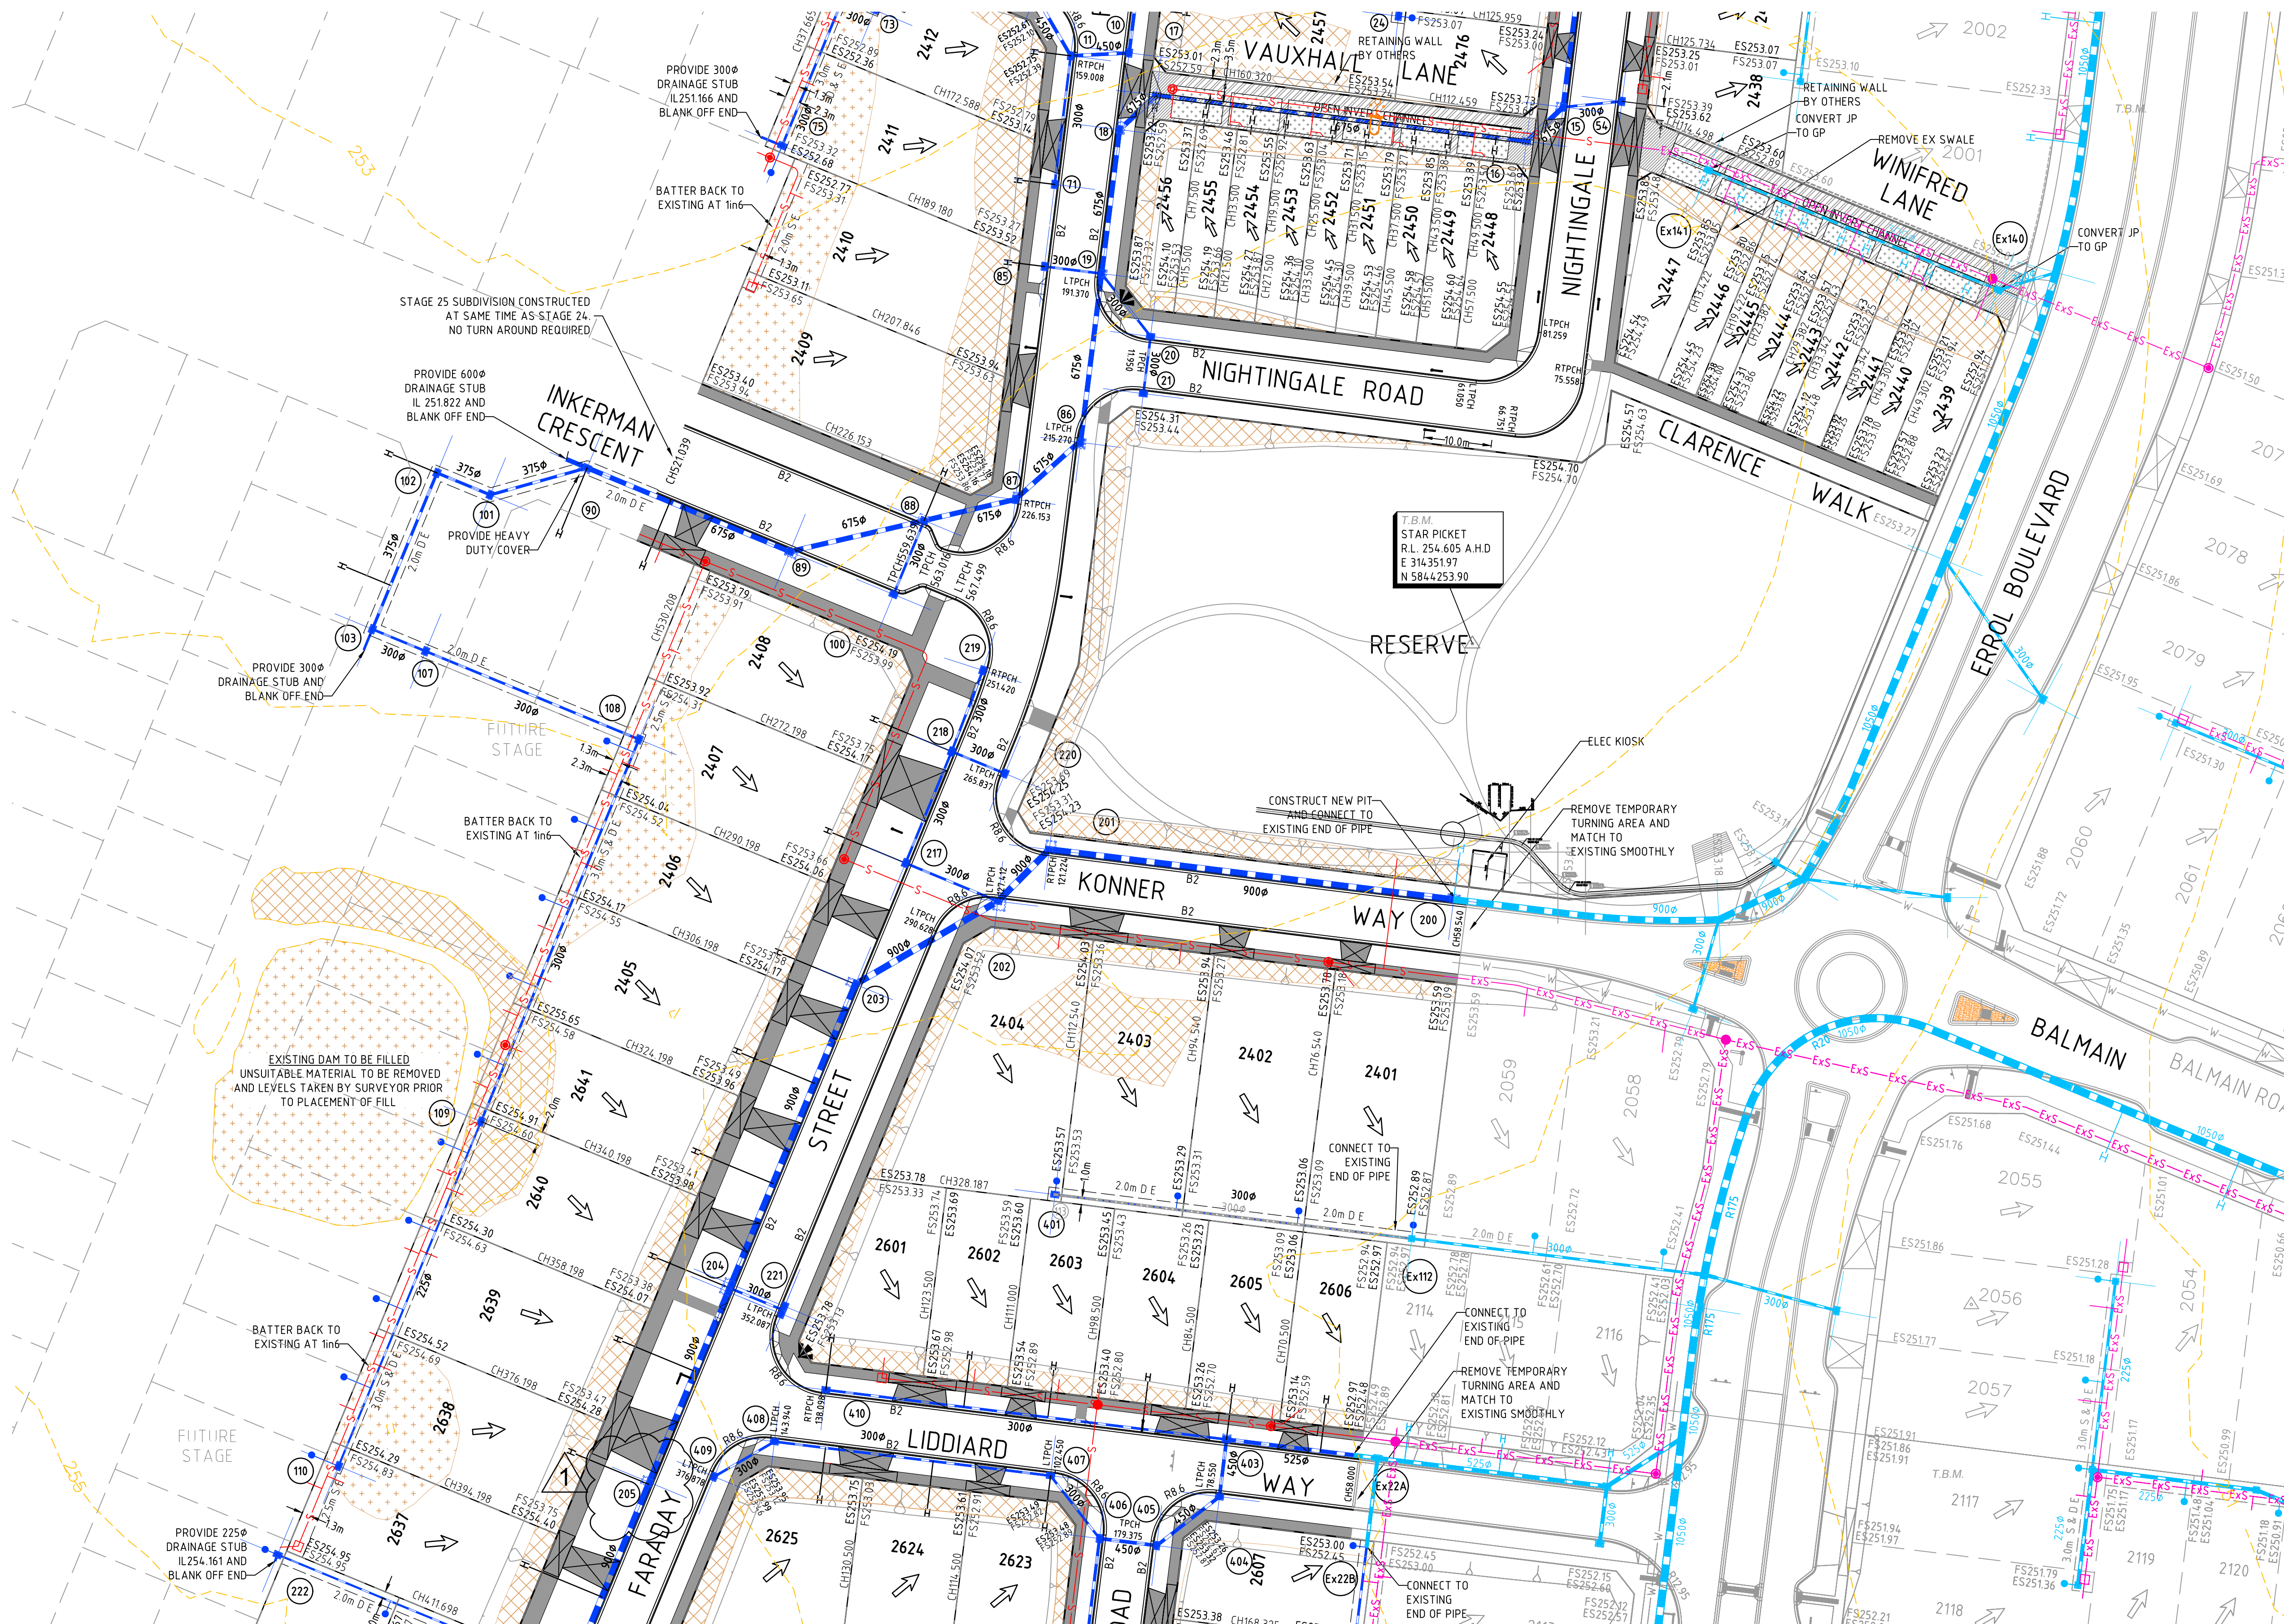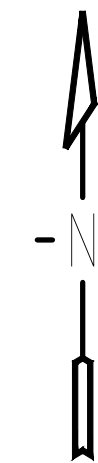

FOR CONTINUATION REFER TO P115-24-RD200

LEGEND - DETAIL

- LOT GRADE
- EXISTING SURFACE LEVEL
- FINISHED SURFACE LEVEL
- TOP OF BATTER MARK
- PERMANENT SURVEY MARK
- TEMPORARY BENCH MARK
- REMOVE EX TREE
- PROPOSED DRAINAGE
- EXISTING DRAINAGE
- TABLE DRAIN
- PROPERTY INLET
- HOUSE DRAIN
- SWD PIT NUMBERS
- EXISTING SEWER
- PROPOSED SEWER
- CUT +150mm DEPTH
- FILL +300mm DEPTH

WARNING

NO DRAINAGE WORKS SHALL COMMENCE UNTIL THE CONTRACTOR CONFIRMS INVERT LEVEL OF ALL EXISTING DRAINS

WARNING

BEWARE OF UNDERGROUND SERVICES
THE LOCATIONS OF UNDERGROUND SERVICES ARE APPROXIMATE ONLY AND THEIR EXACT POSITION SHOULD BE PROVEN ON SITE. NO GUARANTEE IS GIVEN THAT ALL EXISTING SERVICES ARE SHOWN. A MOC'S ENQUIRY ON 1100 MUST BE MADE BY THE CONTRACTOR PRIOR TO COMMENCEMENT OF WORKS.

3	AS CONSTRUCTED ISSUE	JW	21.10.17	DRAWN:	C.GLEESON
2	REVISED FS LEVELS CLARENCE WALK	GR	25.09.17	DESIGNED:	C.J.SANTOS
1	PIT 205 RELOCATED	GR	30.03.17	APPROVED:	G.ROMANCZ
0	CONSTRUCTION ISSUE	GR	14.02.17		
C	COUNCIL COMMENTS	GR	08.02.17		
B	COUNCIL COMMENTS	GR	23.12.16		
REV	DESCRIPTION	APPROVED	DATE		

CLIENT:

merrifield
MAB gpc

verve

Verve Projects Pty Ltd
Level 11 173 Burke Road
Glen Iris VIC 3146
T 03 8573 1500
verveprojects.com

COUNCIL:

HUME CITY COUNCIL

PROJECT:

MERRIFIELD LIVING - SECTION B
STAGE 24
MICKLEHAM

TITLE:

DETAIL PLAN - 2

ISSUE:

AS CONSTRUCTED

MELWAY REF:

366 D3/E4

PROJECT No:



P115-24

DWG No:

RD201

REVISION:

3

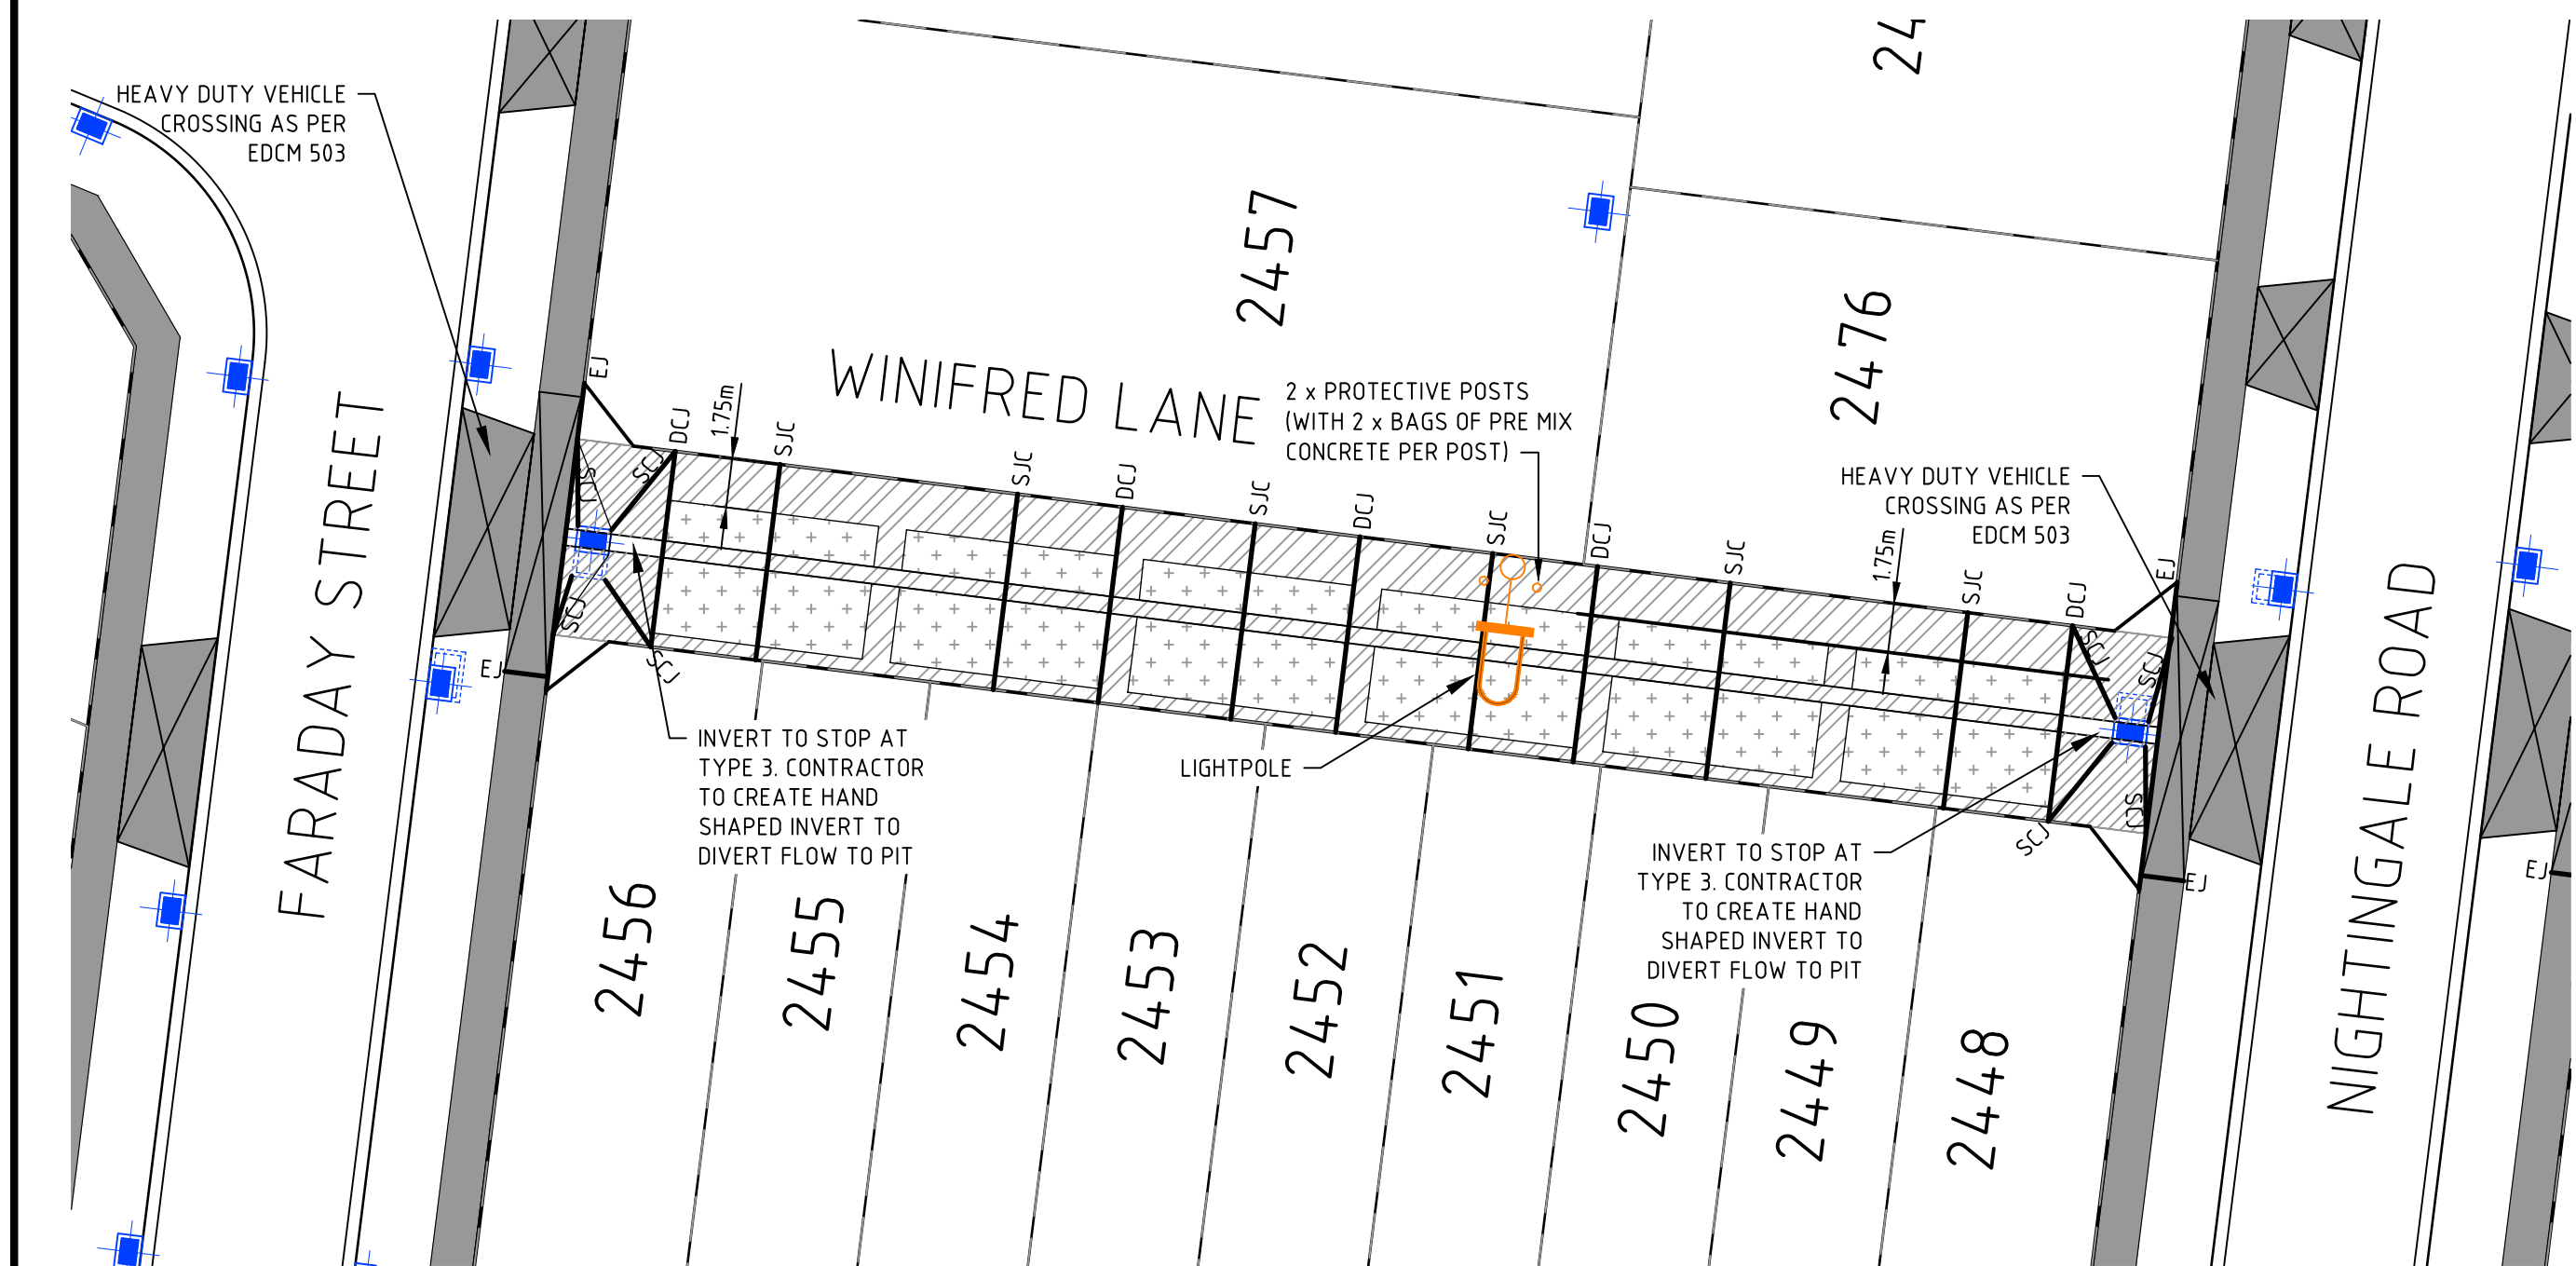
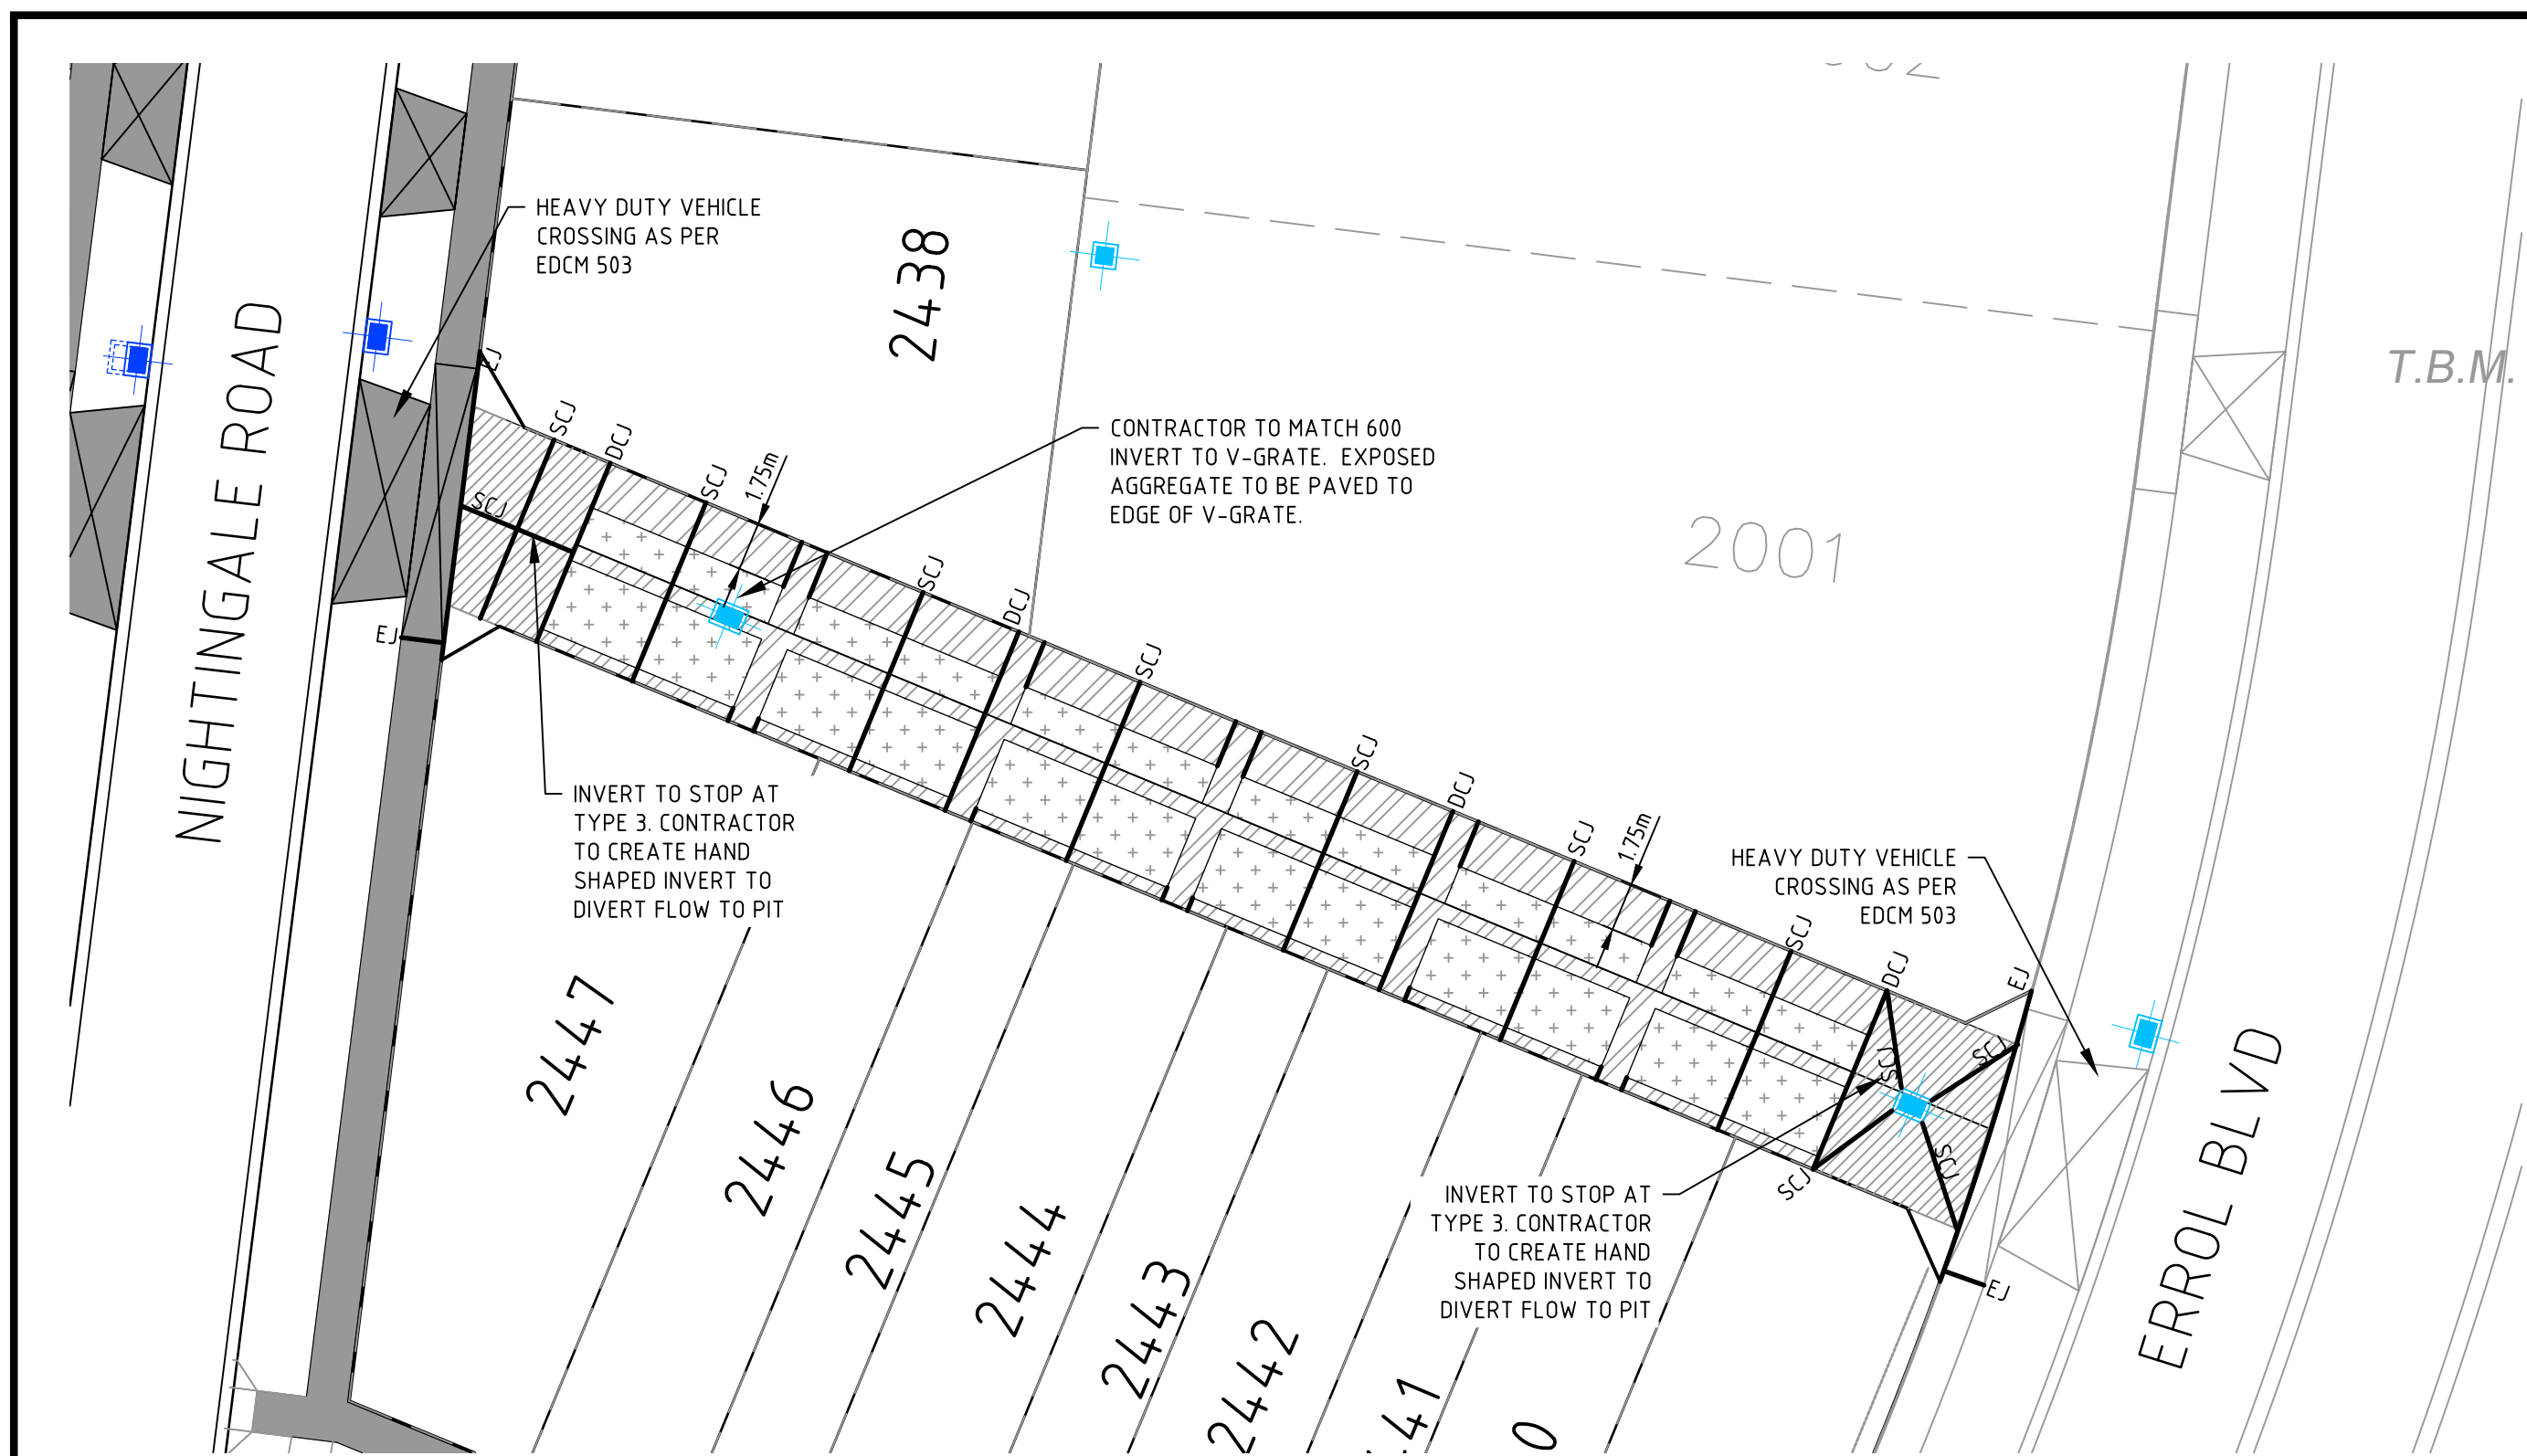


CONCRETE NOTES:

1. ENGINEERING DRAWINGS MUST NOT BE SCALED
2. CONTRACTOR TO VERIFY ALL DIMENSIONS ON SITE PRIOR TO COMMENCEMENT OF WORKS
3. ANY DISCREPANCIES MUST BE REFERRED TO THE ENGINEER IMMEDIATELY TO ENSURE CORRECT RECTIFICATION BEFORE PROCEEDING WITH THE WORKS.
4. ALL CONCRETE SHALL BE IN ACCORDANCE WITH AS 3600
5. ADDITIVES MUST NOT BE USED IN THE CONCRETE WITHOUT THE ENGINEER'S PRIOR APPROVAL
6. MECHANICALLY VIBRATE CONCRETE DURING THE CONCRETE POUR
7. CONCRETE SURFACES MUST BE ADEQUATELY CURED FOR MINIMUM SEVEN DAYS
8. UNSPECIFIED CONSTRUCTION JOINTS, HOLES OR CHASES MUST NOT BE MADE WITHOUT THE ENGINEER'S PRIOR APPROVAL
9. FIELD WELDING OF REINFORCEMENT IS ONLY PERMITTED WITH THE ENGINEER'S PRIOR APPROVAL
10. ALL REINFORCEMENT IS TO BE ACCURATELY PLACED, TIED AND SUPPORTED IN POSITION BY BAR CHAIRS AT 750mm CENTRES WHERE APPROPRIATE AND ADEQUATELY IN OTHER MEMBERS
11. ALL FORMWORK TO BE IN ACCORDANCE WITH AS1509 AND TO BE RETAINED IN POSITION FOR A MIN OF 7 DAYS.


LEGEND

- CONCRETE PAVING TYPE 1 - EXPOSED AGGREGATE PLAIN GREY CONCRETE. COLOUR: PLAIN GREY. AGGREGATE: 12mm BLACK BASALT. FINISH: WATER WASH EXPOSED AGGREGATE.
- CONCRETE PAVING TYPE 2 - COLOURED CONCRETE. COLOUR: GREY CONCRETE WITH ABILOX BLACK CAF X2 DOSE RATE 4.15%. FINISH: LIGHT BROOM FINISH.
- CONCRETE PAVING TYPE 3 - EXPOSED AGGREGATE COLOURED CONCRETE. COLOUR: GREY CONCRETE WITH ABILOX BLACK CAF X2 DOSE RATE 8.3%. AGGREGATE: 12mm BLACK BASALT. FINISH: WATER WASHED EXPOSED AGGREGATE.

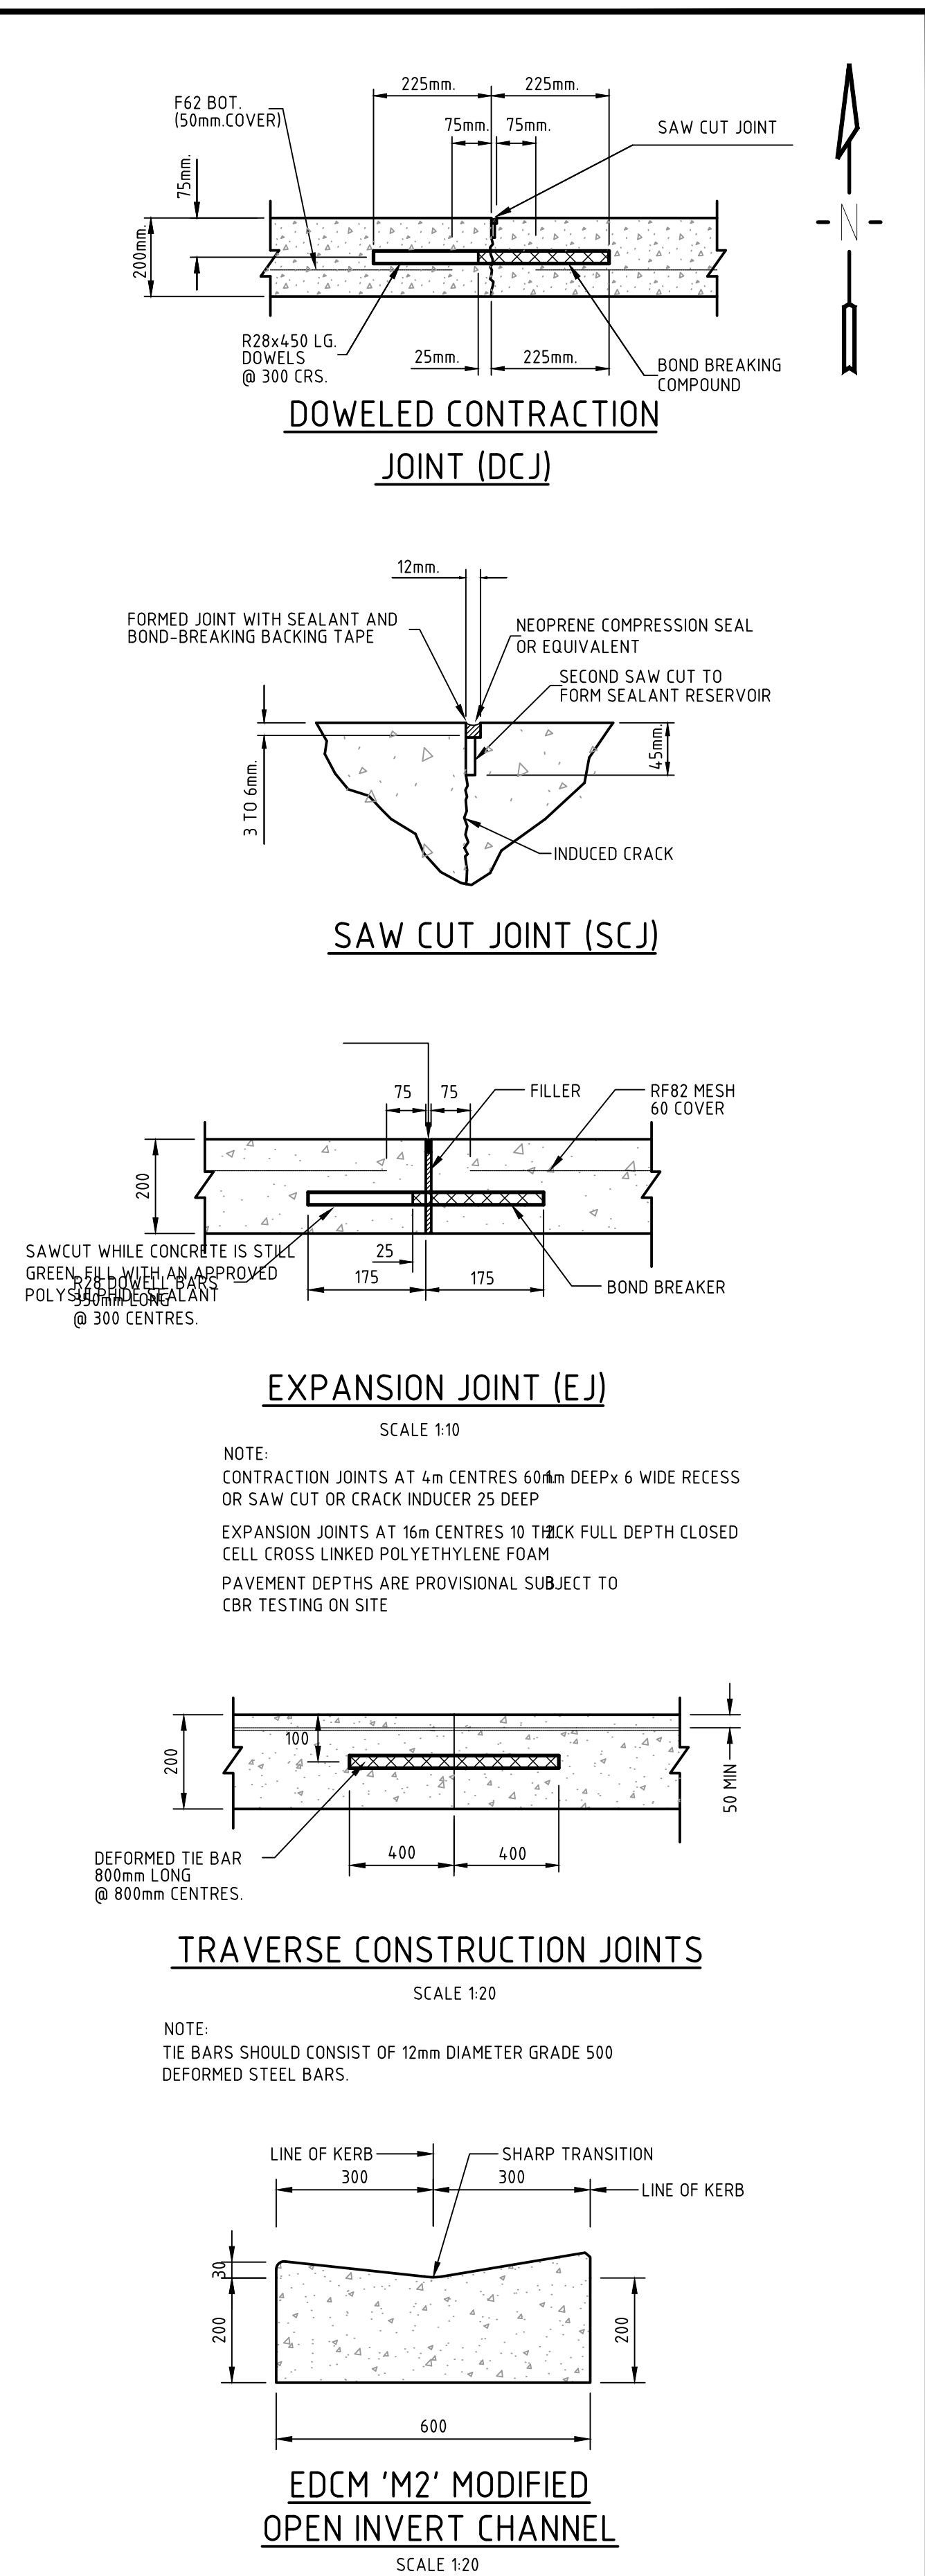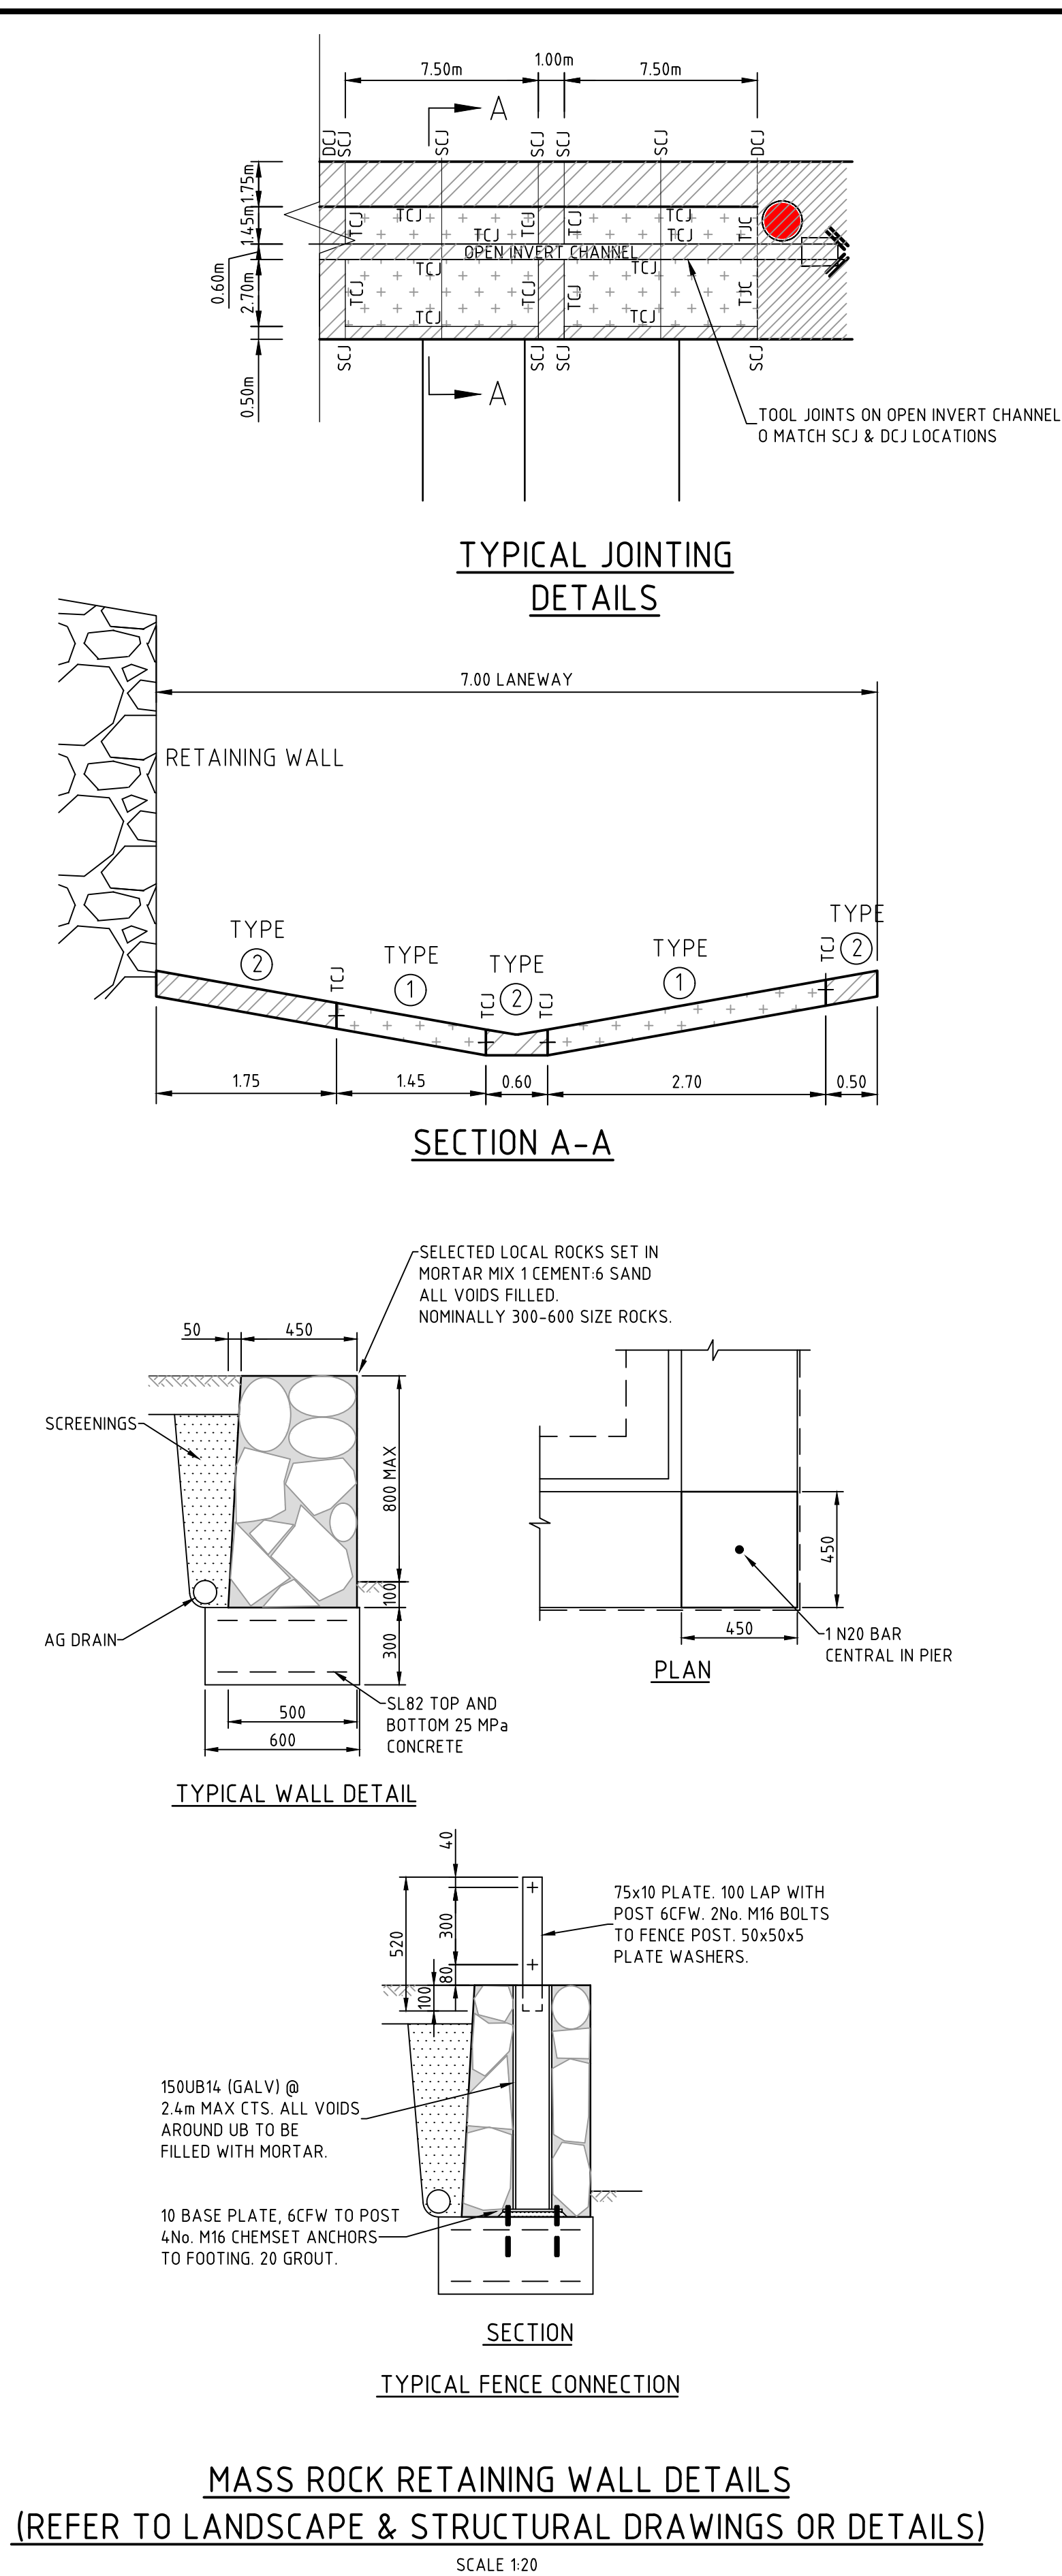

REV	DESCRIPTION	APPROVED	DATE
2	AS CONSTRUCTED ISSUE	JW	21.10.17
1	CONSTRUCTION UPDATE	DL	09.10.17
0	CONSTRUCTION ISSUE	GR	14.02.17
B	COUNCIL COMMENTS	GR	07.02.17
A	PRELIMINARY ISSUE	GR	23.12.16

DRAWN:	C.GLEESON
DESIGNED:	C.J.SANTOS
APPROVED:	G.ROMANCZ

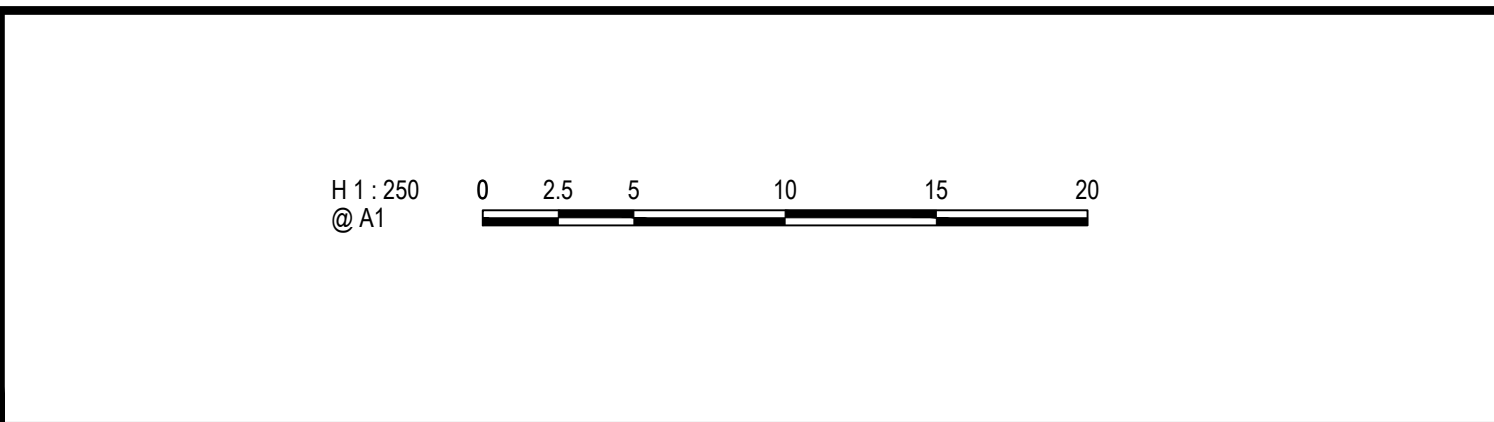

CLIENT:


merrifield

MAB gpc

verve

Verve Projects Pty Ltd
Level 1 173 Burke Road
Glen Iris VIC 3146
T 03 8573 1500
verveprojects.com

COUNCIL:	HUME CITY COUNCIL
PROJECT:	MERRIFIELD LIVINGS - SECTION B STAGE 24 MICKLEHAM
TITLE:	WINIFRED LANE LANEWAY TREATMENT & CONCRETE JOINTING PLAN
ISSUE:	AS CONSTRUCTED
MELWAY REF:	366 D3/E4
PROJECT No:	P115-24
DWG No:	RD203
REVISION:	2

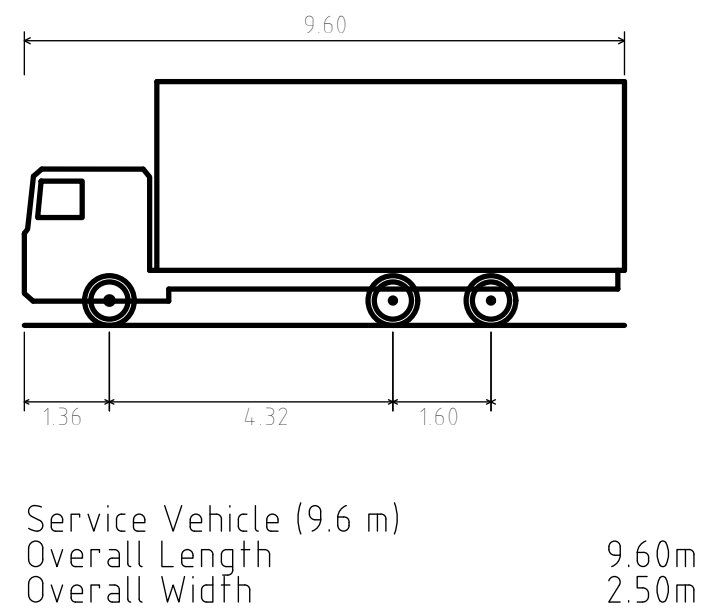

- 500mm CLEAR ZONE BETWEEN GARBAGE TRUCK & FRONT OF BIN
- WIDTH OF BINS - 750mm (GENERAL & RECYCLED)
- 1.0m CLEAR ZONE BETWEEN TITLE AND REAR OF BINS

REV	DESCRIPTION	APPROVED	DATE
1	AS CONSTRUCTED ISSUE	JW	21.10.17
0	CONSTRUCTION ISSUE	GR	14.02.17
A	PRELIMINARY ISSUE	GR	23.12.16

DRAWN: C.GLEESON
DESIGNED: C.J.SANTOS
APPROVED: G.ROMANCZ



CLIENT:

merrifield
MAB gpc

verve
Verve Projects Pty Ltd
Level 11 173 Burke Road
Glen Iris VIC 3146
T 03 8573 1500
verveprojects.com

COUNCIL: HUME CITY COUNCIL

PROJECT: MERRIFIELD LIVINGS - SECTION B
STAGE 24
MICKLEHAM

TITLE: WASTE MANAGEMENT PLAN
FOR LOTS 2439-2456

ISSUE: **AS CONSTRUCTED**

MELWAY REF: 366 D3/E4

PROJECT No: P115-24

DWG No: RD204

REVISION: 1