
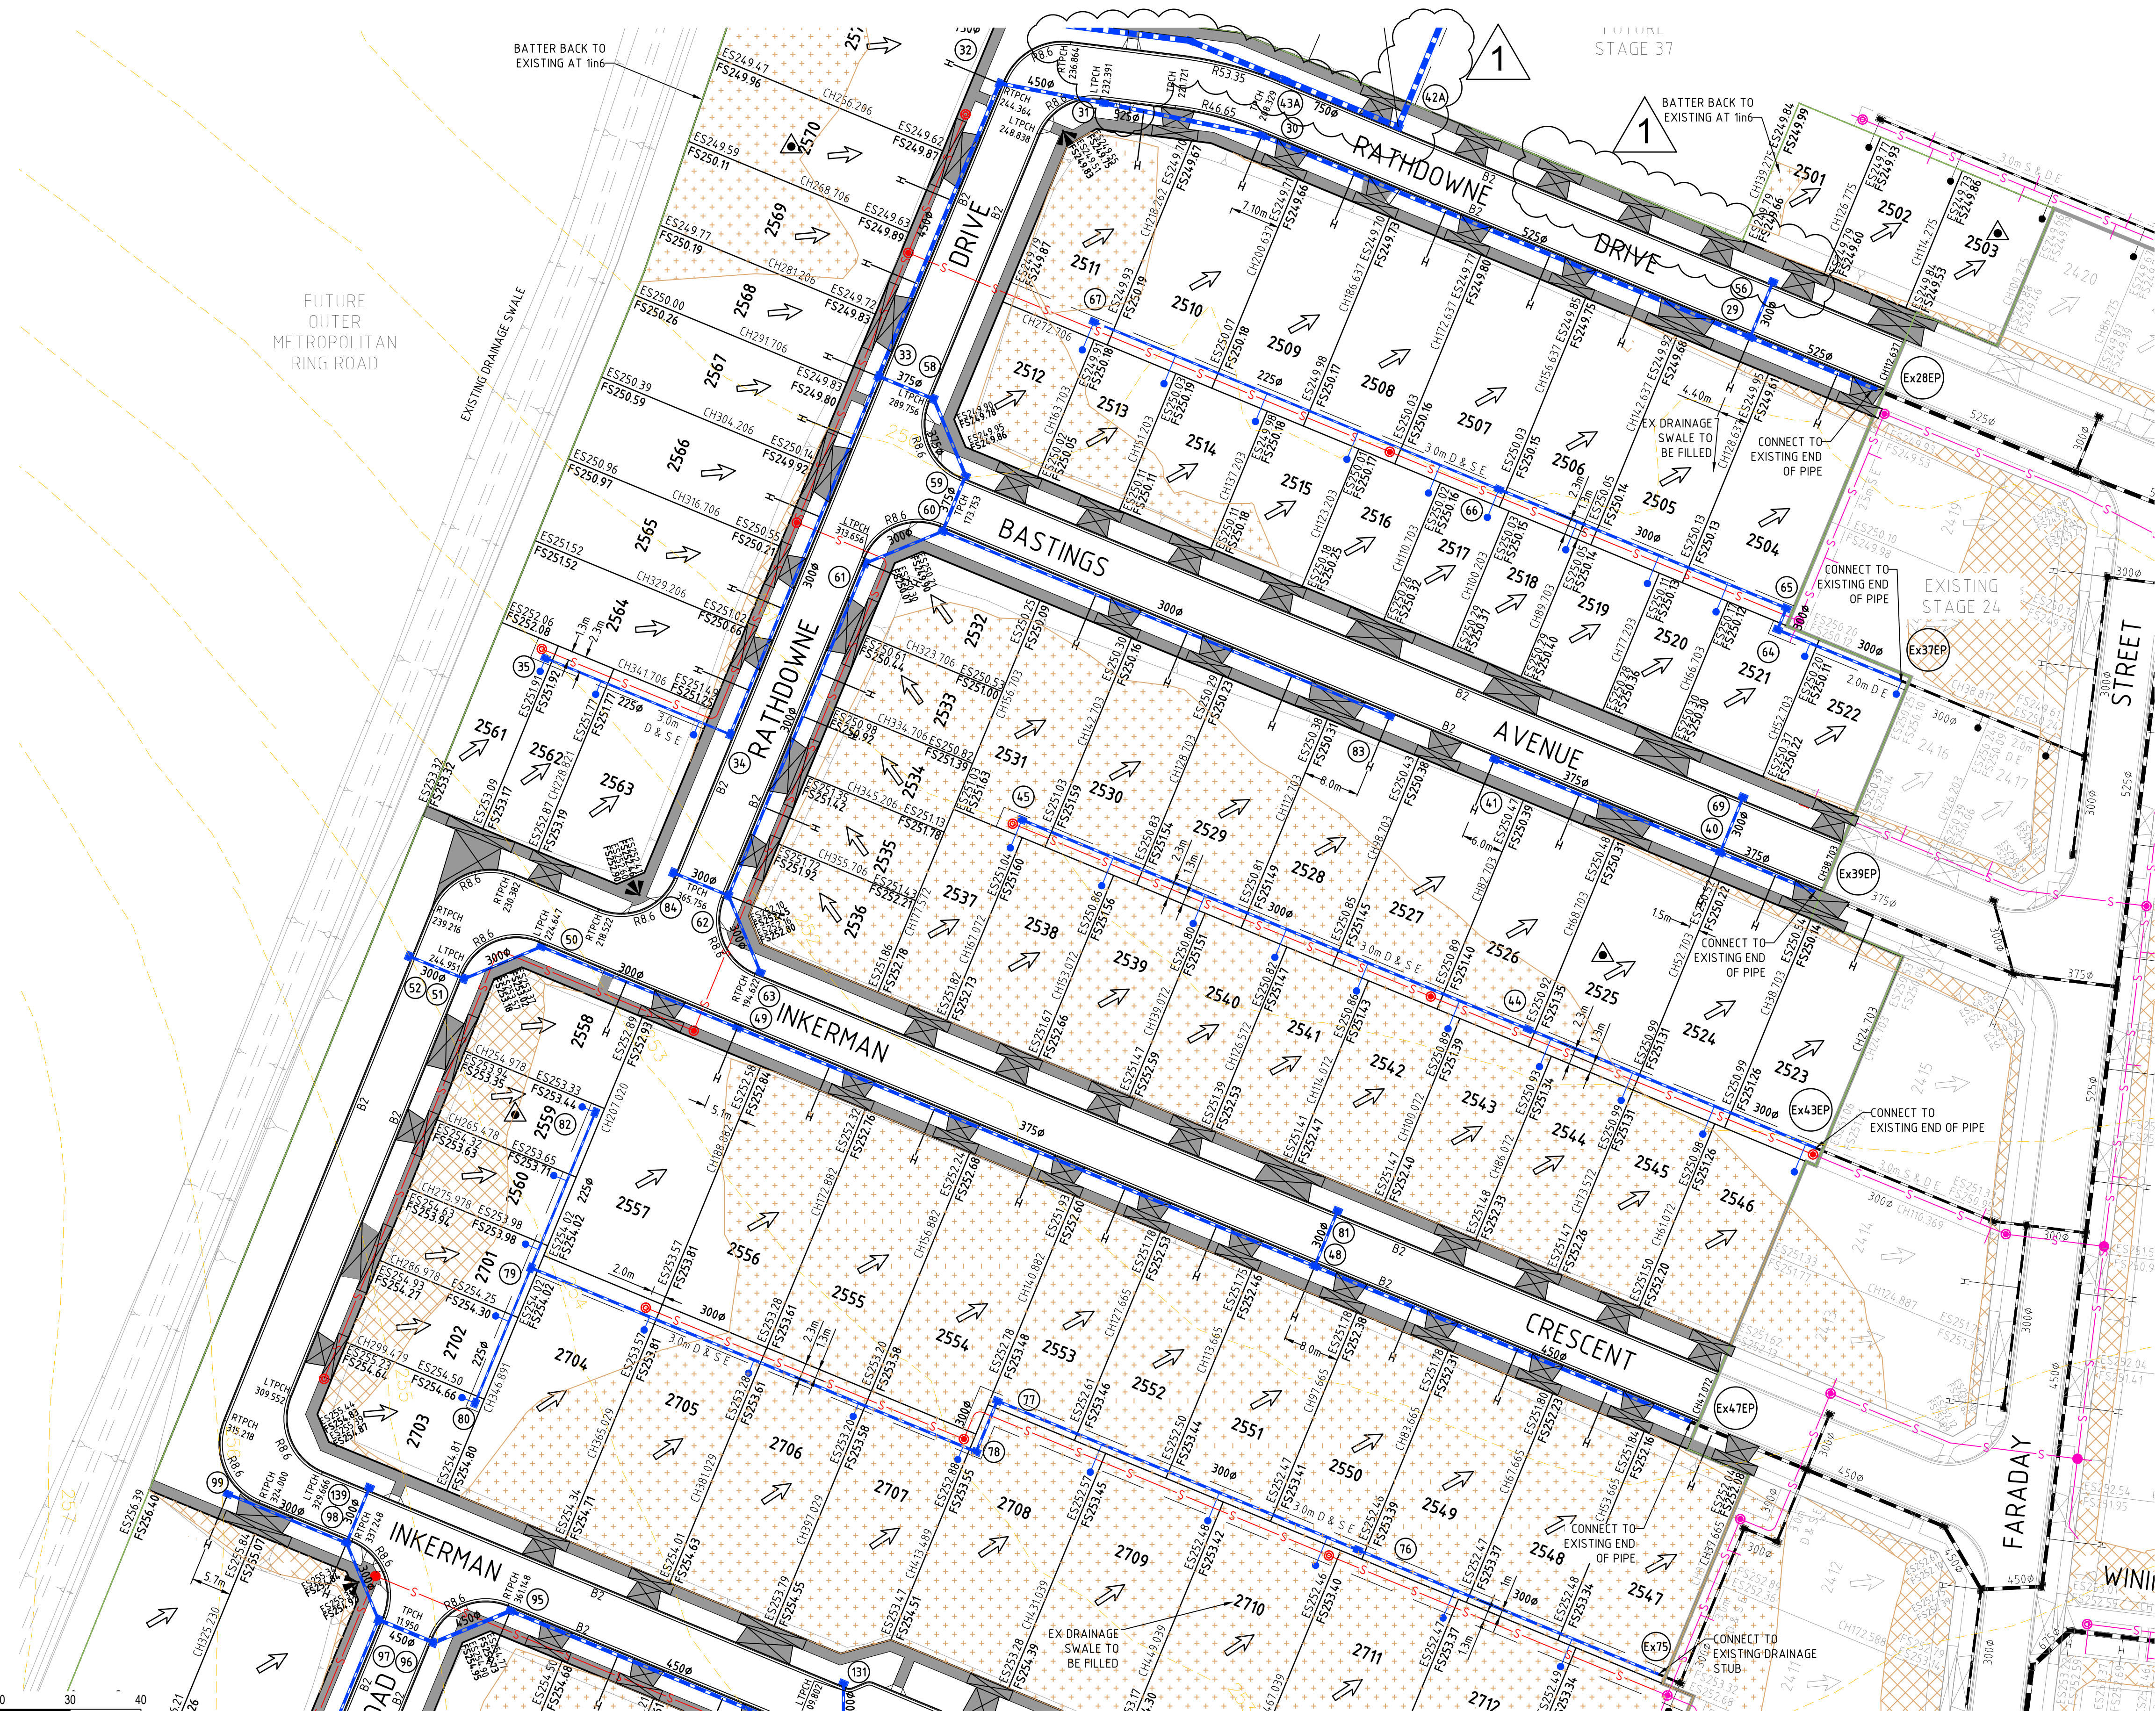


FOR CONTINUATION REFER TO P115-25-RD202

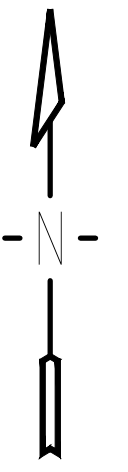

LEGEND - DETAIL

- LOT GRADE
- EXISTING SURFACE LEVEL
- FINISHED SURFACE LEVEL
- TOP OF BATTER LEVEL
- PERMANENT SURVEY MARK
- TEMPORARY BENCH MARK
- REMOVE EX TREE
- PROPOSED DRAINAGE
- EXISTING DRAINAGE
- TABLE DRAIN
- PROPERTY INLET
- HOUSE DRAIN
- SWD PIT NUMBERS
- EXISTING SEWER
- PROPOSED SEWER
- CUT >150mm DEPTH
- FILL >300mm DEPTH

WARNING
NO DRAINAGE WORKS SHALL COMMENCE UNTIL THE CONTRACTOR CONFIRMS INVERT LEVEL OF ALL EXISTING DRAINS

WARNING
BEWARE OF UNDERGROUND SERVICES
THE LOCATIONS OF UNDERGROUND SERVICES ARE APPROXIMATE ONLY AND THEIR EXACT POSITION SHOULD BE PROVEN ON SITE. NO GUARANTEE IS GIVEN THAT ALL EXISTING SERVICES ARE SHOWN. A MOC'S ENQUIRY ON 1100 MUST BE MADE BY THE CONTRACTOR PRIOR TO COMMENCEMENT OF WORKS.

FOR CONTINUATION REFER TO P115-25-RD201

H1:500
@A1

REV	DESCRIPTION	APPROVED	DATE
2	AS CONSTRUCTED ISSUE	JW	22.11.17
1	REVISED DRAINAGE & DRIVEWAY LOCATIONS	GR	05.07.17
0	FOR CONSTRUCTION	GR	05.04.17
B	COUNCIL COMMENTS	GR	09.03.17
A	PRELIMINARY ISSUE	GR	28.10.16
REV	DESCRIPTION	APPROVED	DATE


DRAWN:
L. APAP
DESIGNED:
C.J.SANTOS
APPROVED:
G. ROMANCZ

CLIENT:
merrifield
MAB **GPC**

verve
Verve Projects Pty Ltd
Level 11 173 Burke Road
Glen Iris VIC 3146
T 03 8573 1500
verveprojects.com

COUNCIL:
HUME CITY COUNCIL
PROJECT:
MERRIFIELD LIVINGS - SECTION B
STAGE 25
MICKLEHAM
ISSUE:
AS CONSTRUCTED

DETAIL PLAN - 1
MELWAY REF: 366 D3/E4
PROJECT No: P115-25
DWG No: RD200
REVISION: 2

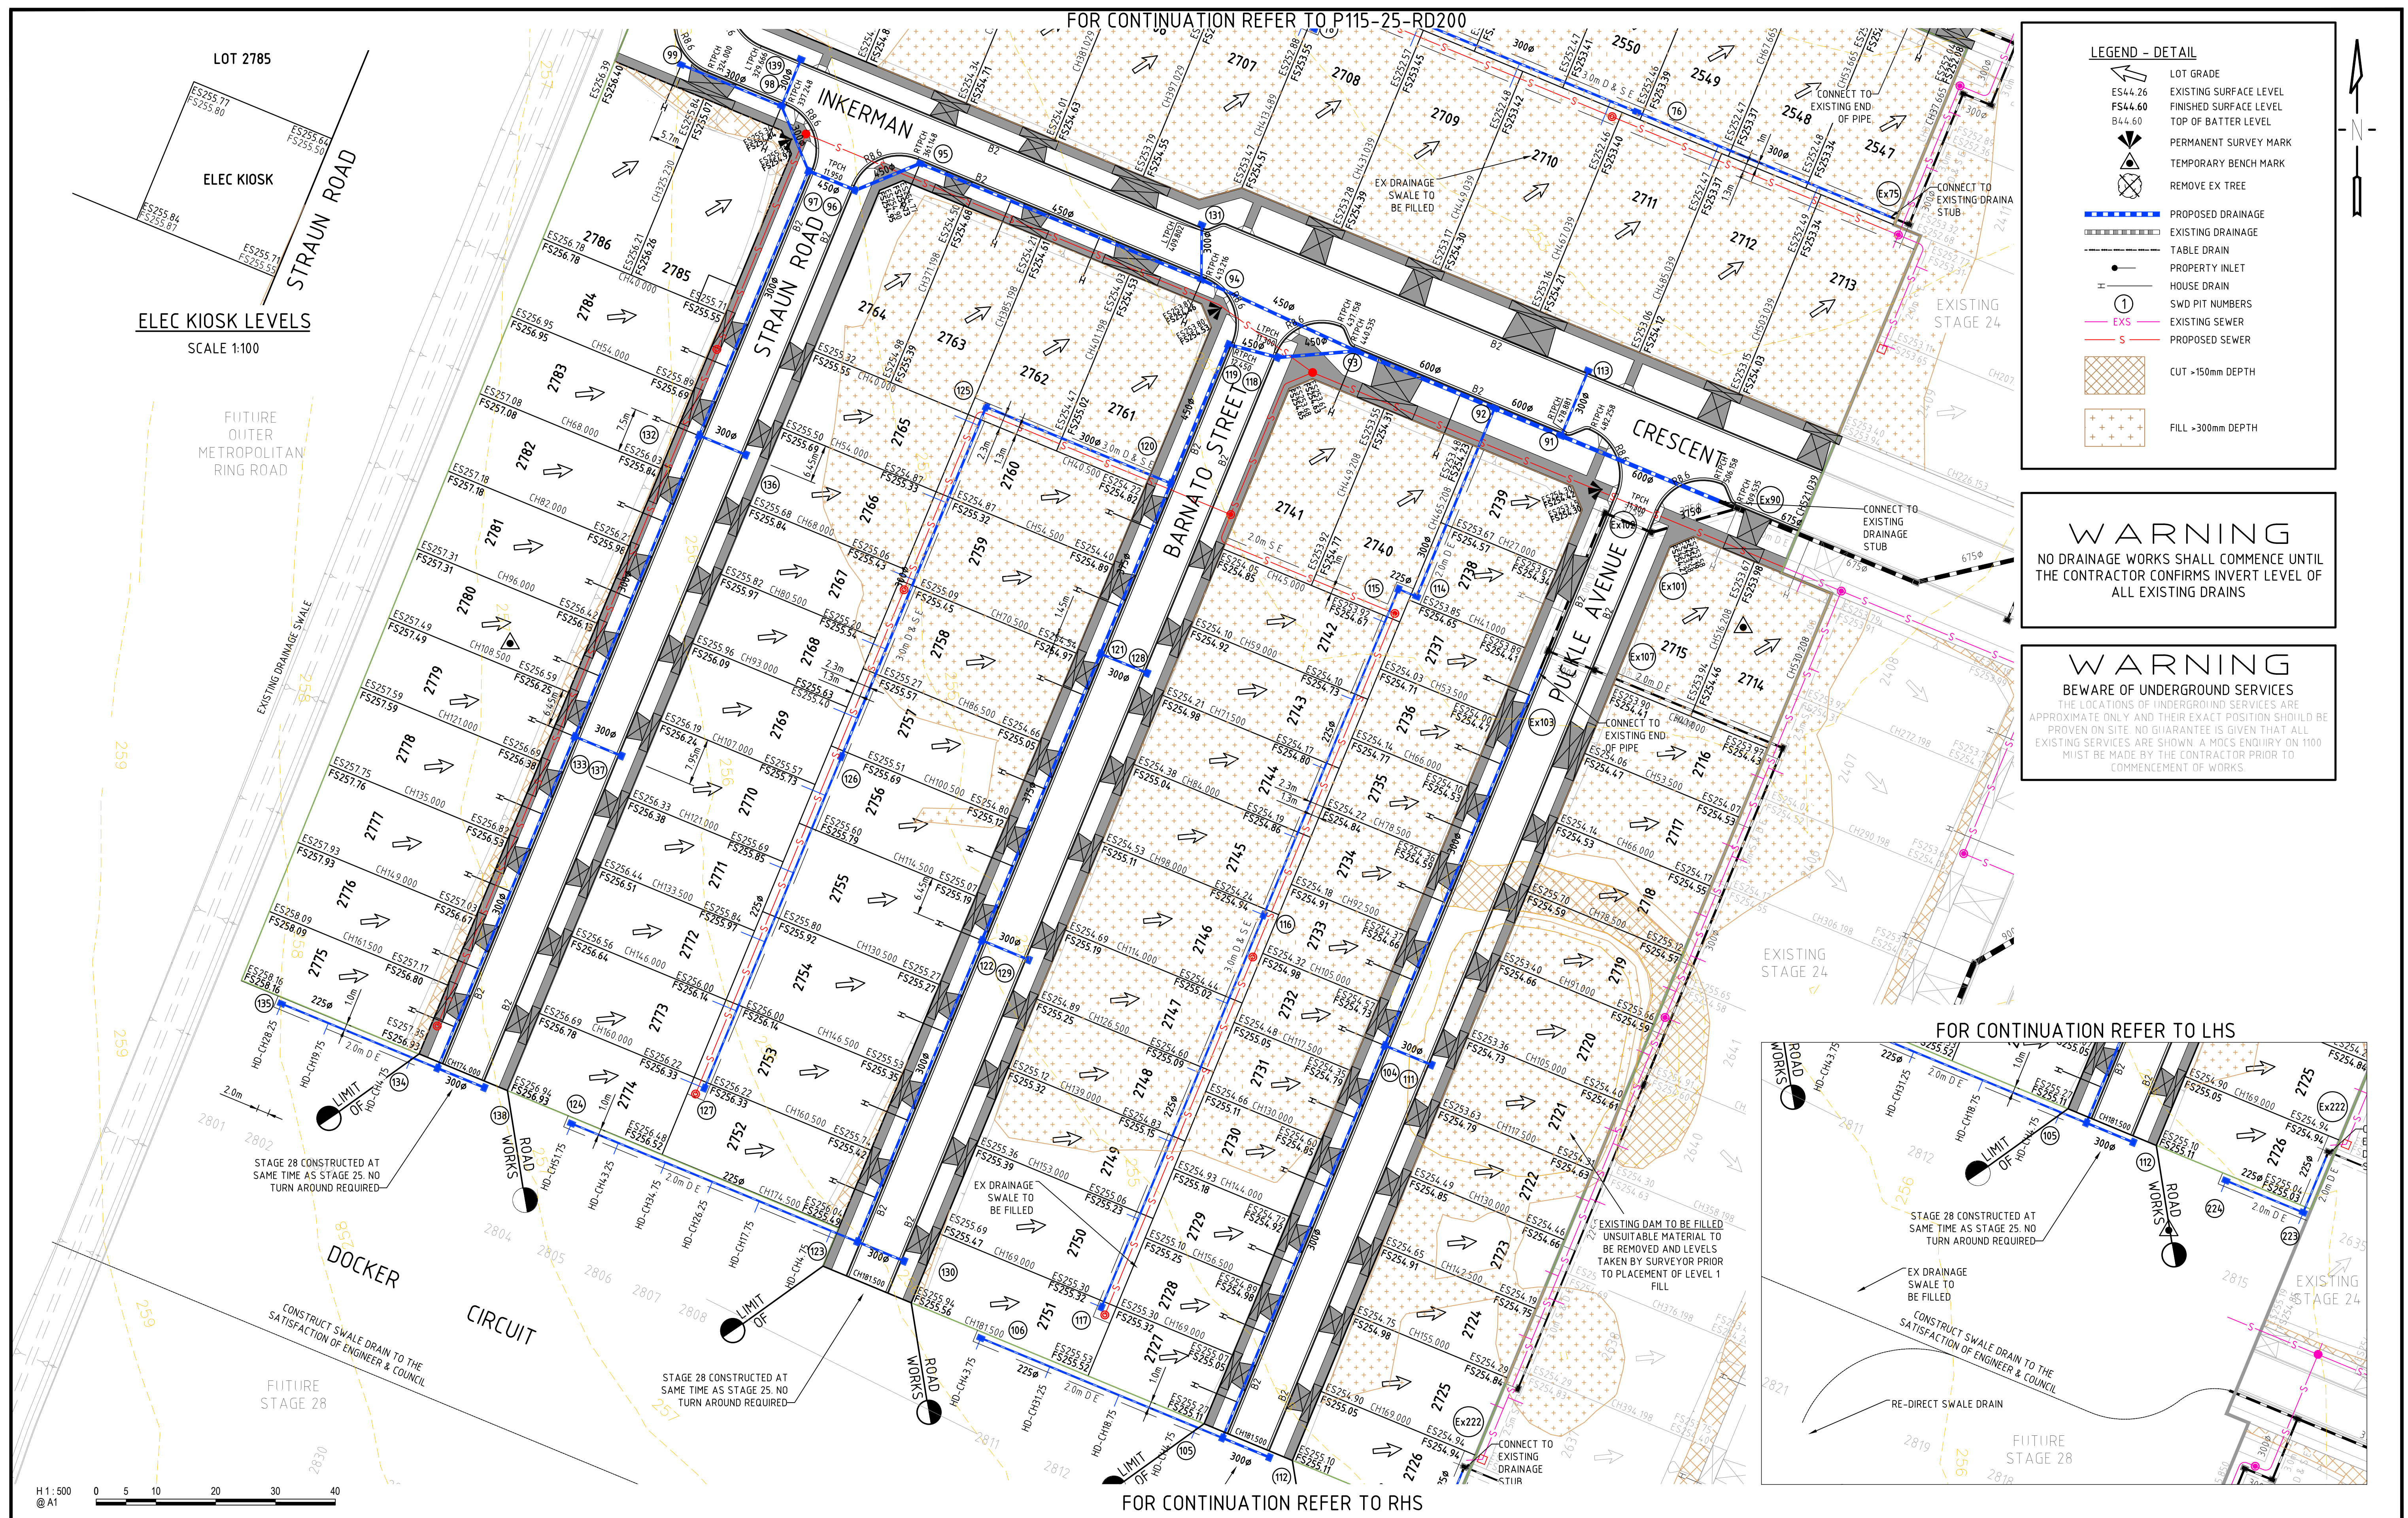

				DRAWN: L. APAP
1	AS CONSTRUCTED ISSUE	JW	22.11.17	DESIGNED: C.J.SANTOS
0	FOR CONSTRUCTION	GR	05.04.17	
B	COUNCIL COMMENTS	GR	09.03.17	APPROVED: G. ROMANCZ
A	PRELIMINARY ISSUE	GR	28.10.16	
REV	DESCRIPTION	APPROVED	DATE	


CLIENT:

Verve Projects Pty Ltd
Level 1 173 Burke Road
Glen Iris VIC 3146
T 03 8573 1500
verveprojects.com

COUNCIL: HUME CITY COUNCIL				
PROJECT: MERRIFIELD LIVINGS - SECTION B STAGE 25 MICKLEHAM		TITLE: DETAIL PLAN - 2		
ISSUE: AS CONSTRUCTED	MELWAY REF: 366 D3/E4	PROJECT No: P115-25	DWG No: RD201	REVISION: 1

Drawings
This drawing is the property of Verve Projects Pty Ltd.
It must not be copied, reproduced or used without the written consent of Verve Projects Pty Ltd.

Quantity
\$20,000.00
\$10,000.00
\$10,000.00

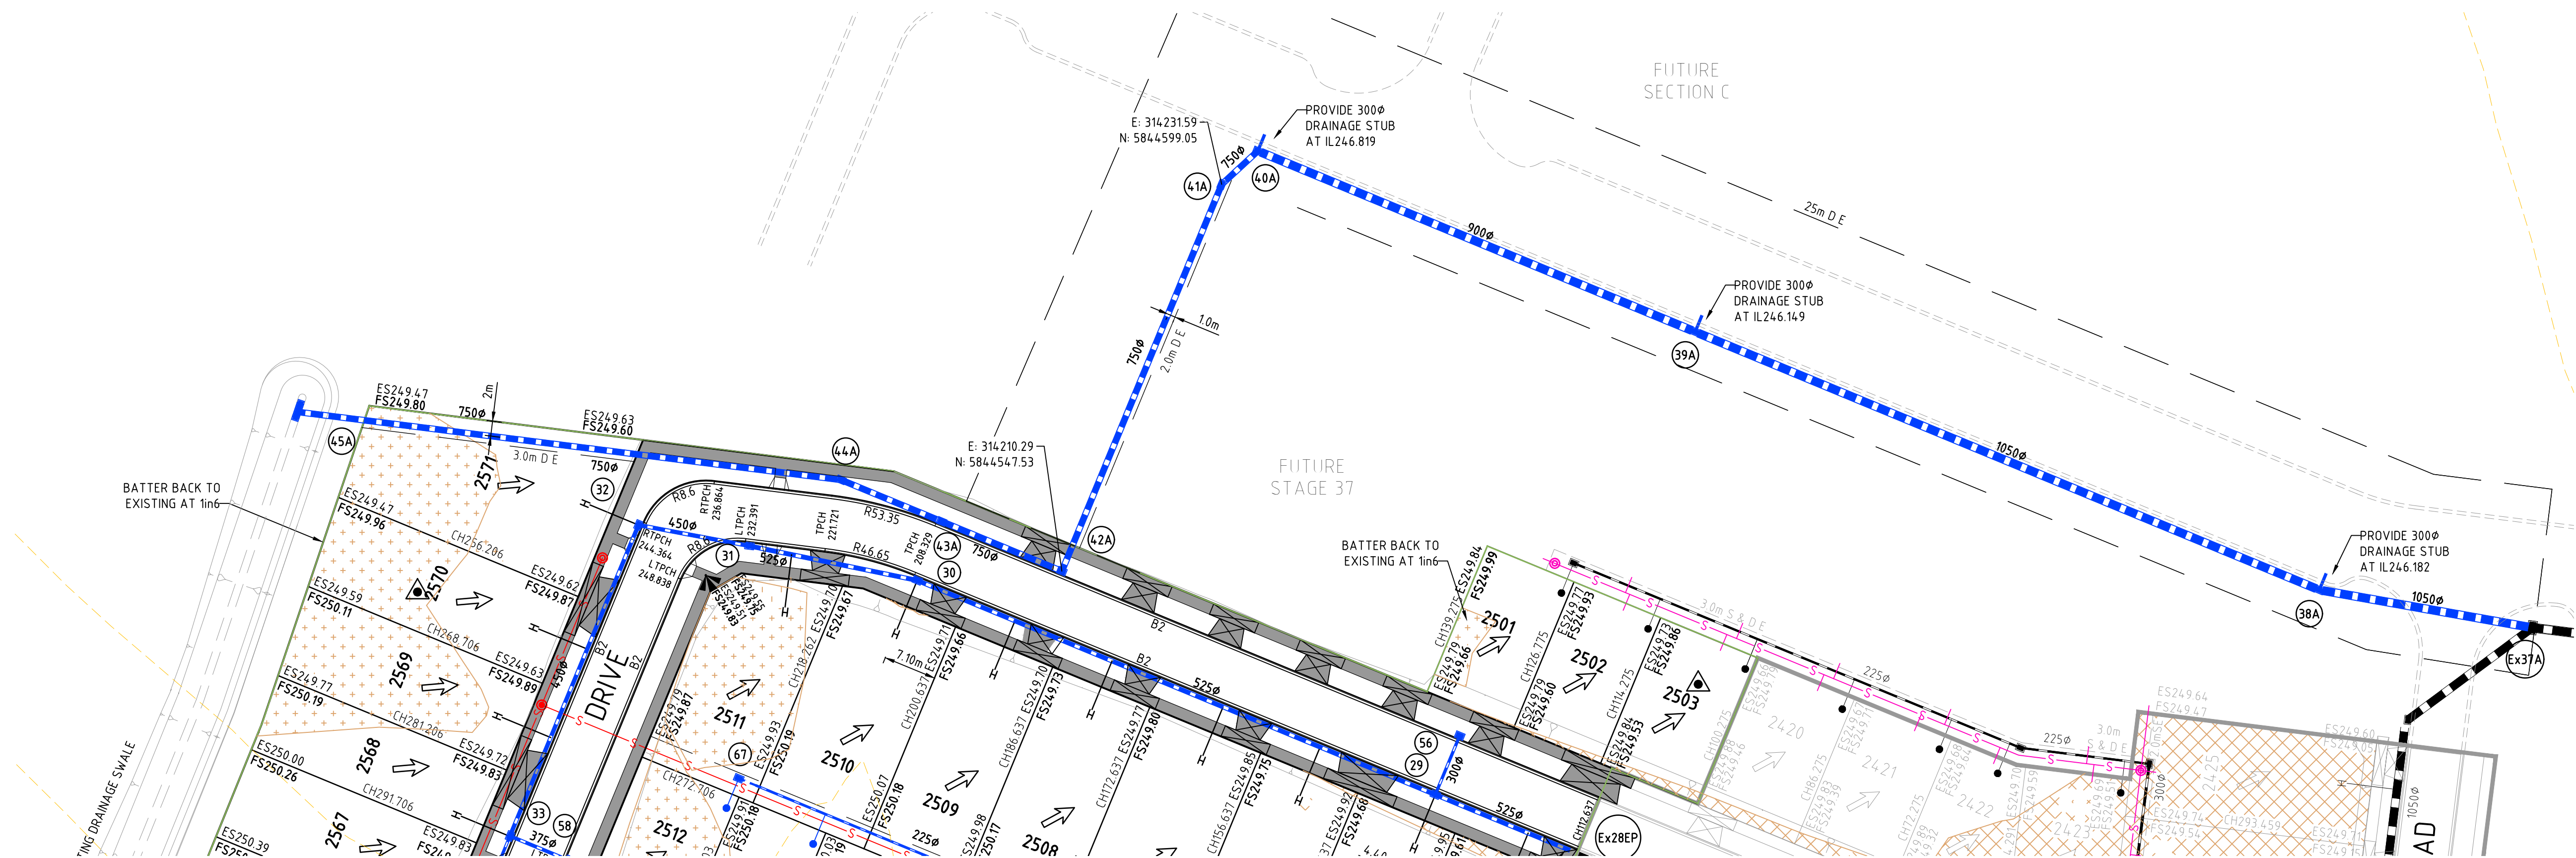

FOR CONTINUATION REFER TO P115-25-RD200

LEGEND - DETAIL

- LOT GRADE
- EXISTING SURFACE LEVEL
- FINISHED SURFACE LEVEL
- TOP OF BATTER LEVEL
- PERMANENT SURVEY MARK
- TEMPORARY BENCH MARK
- REMOVE EX TREE
- PROPOSED DRAINAGE
- EXISTING DRAINAGE
- TABLE DRAIN
- PROPERTY INLET
- HOUSE DRAIN
- SWD PIT NUMBERS
- EXISTING SEWER
- PROPOSED SEWER
- CUT >150mm DEPTH
- FILL >300mm DEPTH

WARNING

NO DRAINAGE WORKS SHALL COMMENCE UNTIL THE CONTRACTOR CONFIRMS INVERT LEVEL OF ALL EXISTING DRAINS

WARNING

BEWARE OF UNDERGROUND SERVICES
THE LOCATIONS OF UNDERGROUND SERVICES ARE APPROXIMATE ONLY AND THEIR EXACT POSITION SHOULD BE PROVEN ON SITE. NO GUARANTEE IS GIVEN THAT ALL EXISTING SERVICES ARE SHOWN. A MOC'S ENQUIRY ON 1100 MUST BE MADE BY THE CONTRACTOR PRIOR TO COMMENCEMENT OF WORKS.

H 1:500
@ A1

REV	DESCRIPTION	APPROVED	DATE
2	AS CONSTRUCTED ISSUE	JW	22.11.17
1	REVISED DRAINAGE & DRIVEWAY LOCATIONS	GR	05.07.17
0	FOR CONSTRUCTION	GR	05.04.17
A	COUNCIL COMMENTS	GR	09.03.17

DRAWN:	L. APAP
DESIGNED:	C.J.SANTOS
APPROVED:	G. ROMANCZ

CLIENT:

merrifield
MAB gpc

verve

Verve Projects Pty Ltd
Level 11 173 Burke Road
Glen Iris VIC 3146
T 03 8573 1500
verveprojects.com

COUNCIL:

HUME CITY COUNCIL

PROJECT:

MERRIFIELD LIVINGS - SECTION B
STAGE 25
MICKLEHAM

TITLE:

DETAIL PLAN - 3

ISSUE:

AS CONSTRUCTED

MELWAY REF:

366 D3/E4

PROJECT No:

P115-25

DWG No:

RD202

REVISION:

2