


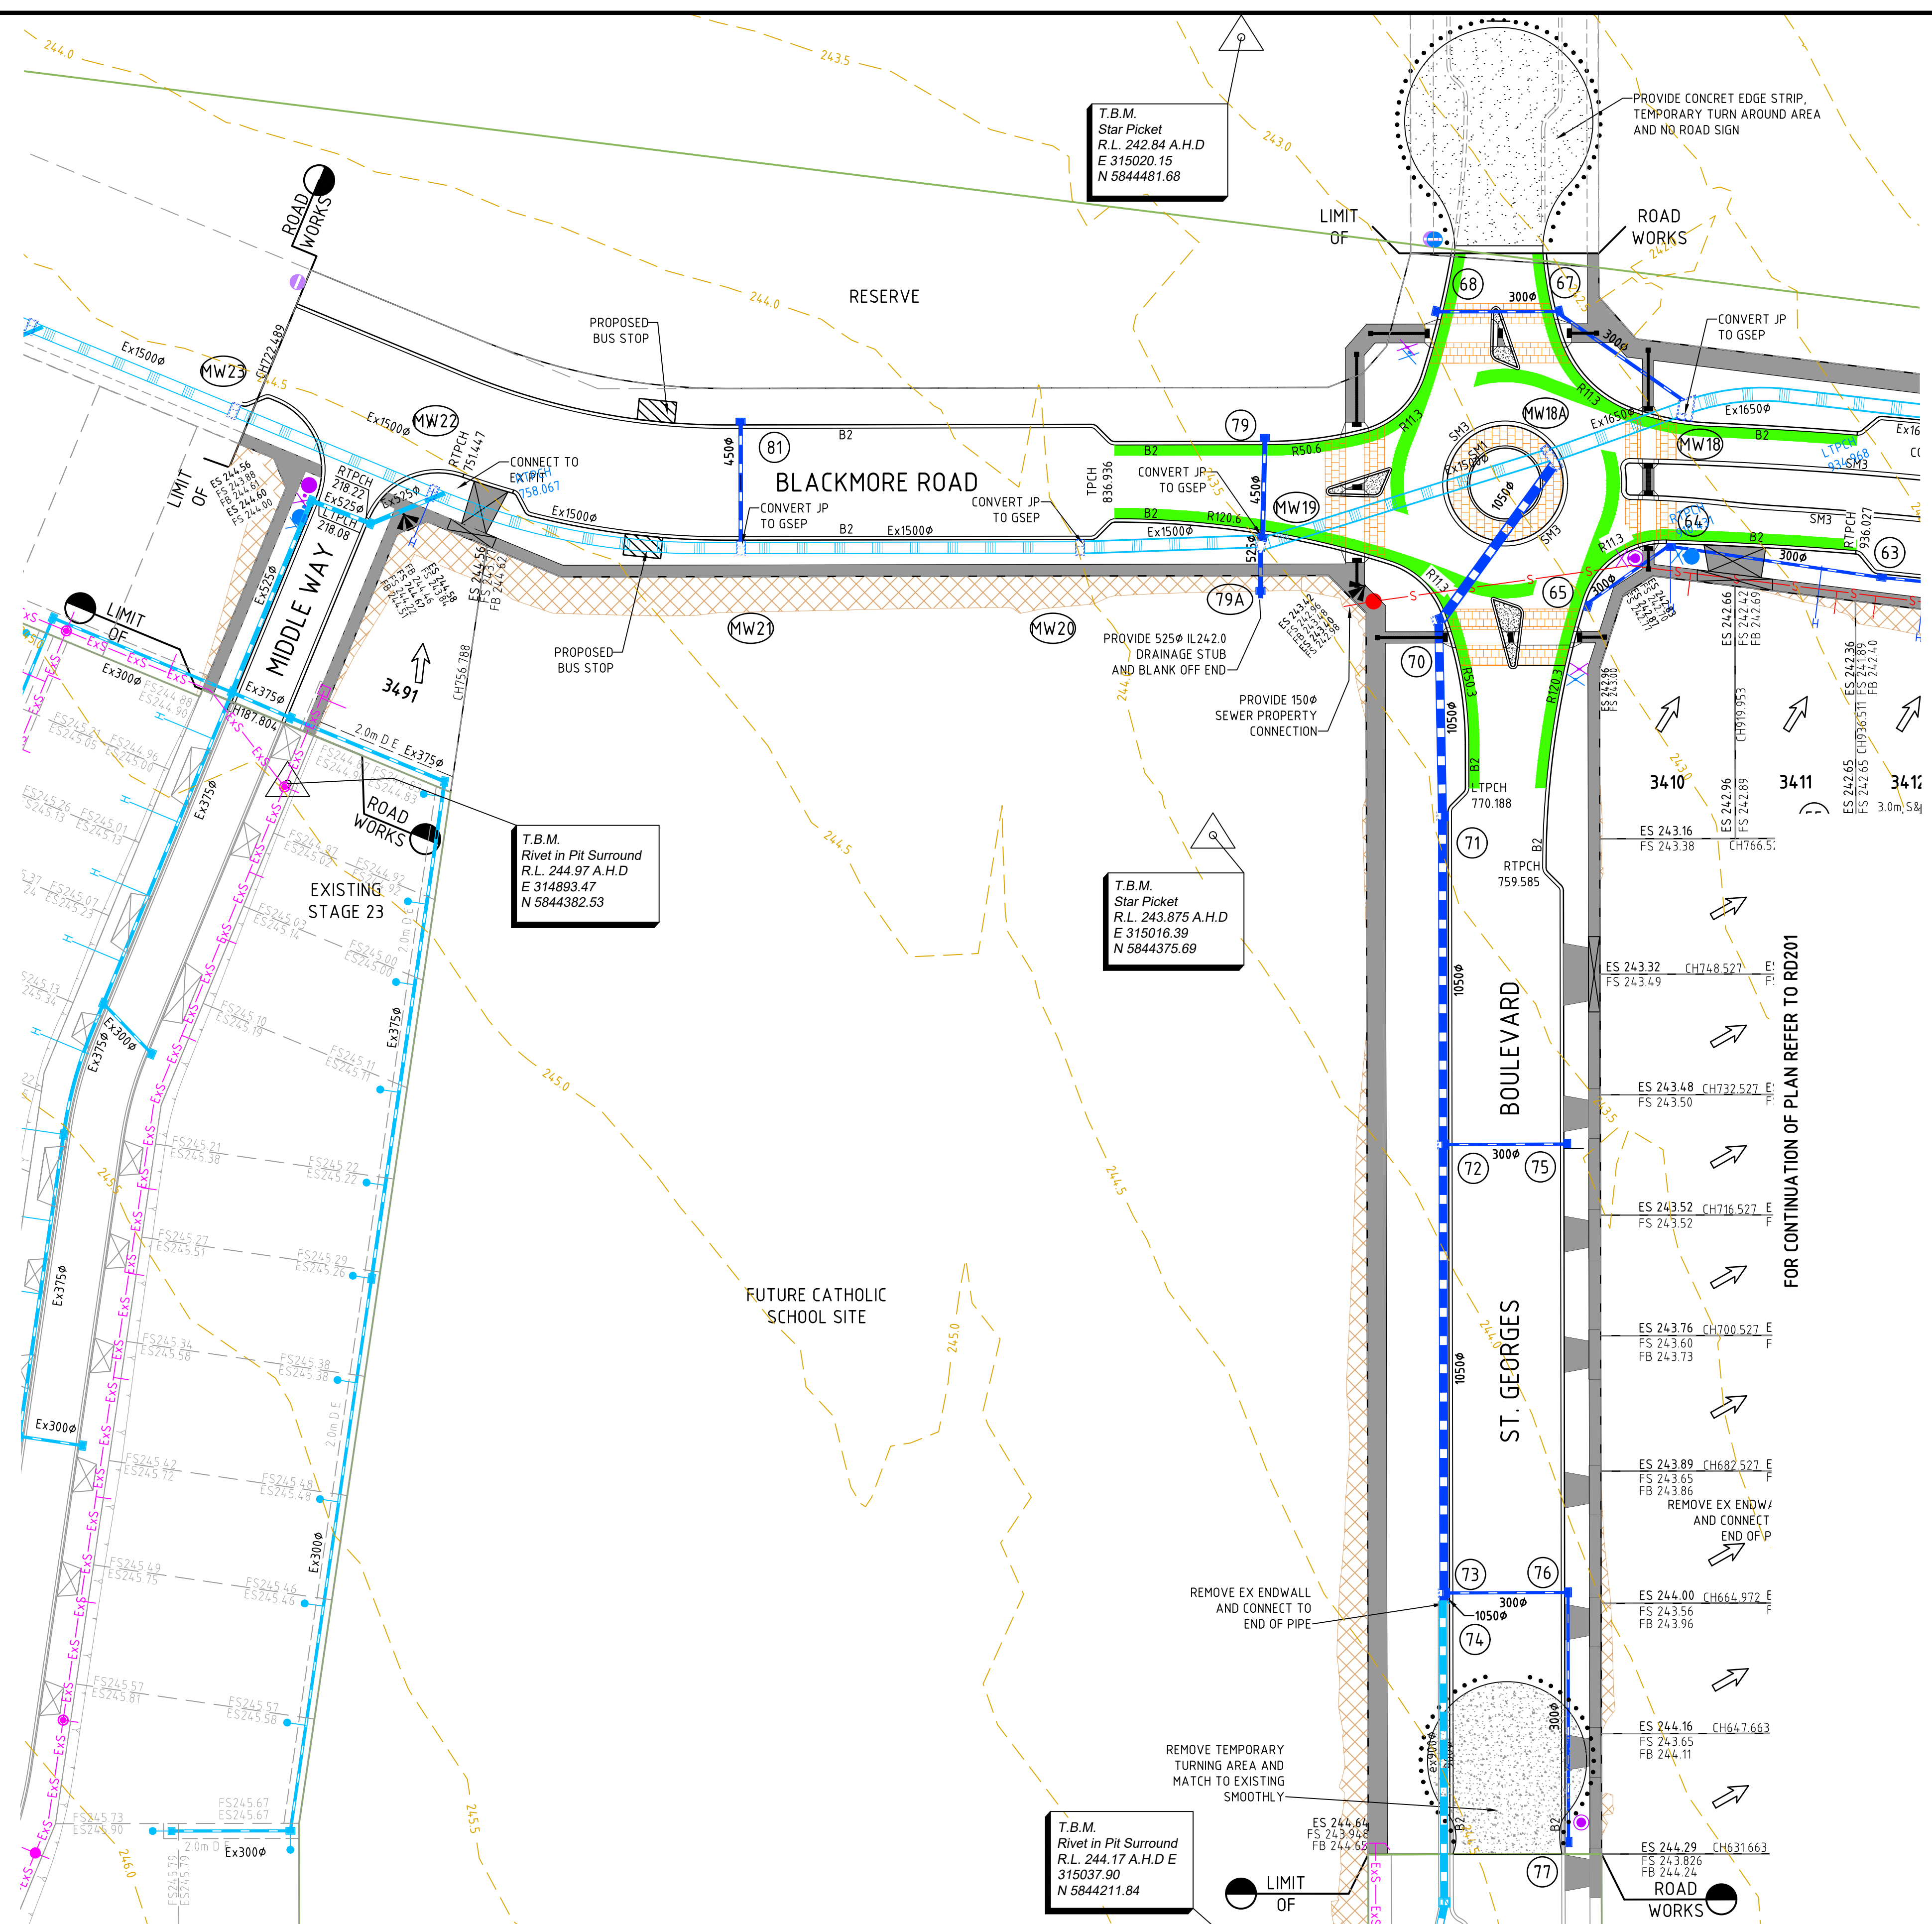

ES44.26

FS44.60

B44.60

PROPOSED DRAINAGE

MELBOURNE WATER DRAINAGE

EXISTING DRAINAGE

TABLE DRAIN

PROPERTY INLET

HOUSE DRAIN

SWD PIT NUMBERS

EXISTING SEWER

PROPOSED SEWER

CUT >150mm DEPTH

FILL >300mm DEPTH

ROUNDBOUT THRESHOLD TREATMENT

G15 EMERALD (AS2700 S1996) OR VICROADS APPROVED EQUIVALENT AS PER VICROADS CYCLE NTE No.14 2005)

LEGEND - DETAIL

LOT GRADE

EXISTING SURFACE LEVEL

FINISHED SURFACE LEVEL

TOP OF BATTER LEVEL

PERMANENT SURVEY MARK

TEMPORARY BENCH MARK

REMOVE EX TREE

EXISTING DRAINAGE
SWALES TO BE
LEVEL 1 FILLED

WARNING

BEWARE OF UNDERGROUND SERVICES

THE LOCATIONS OF UNDERGROUND SERVICES ARE APPROXIMATE ONLY AND THEIR EXACT POSITION SHOULD BE PROVEN ON SITE. NO GUARANTEE IS GIVEN THAT ALL EXISTING SERVICES ARE SHOWN. A MOC'S ENQUIRY ON 1100 MUST BE MADE BY THE CONTRACTOR PRIOR TO COMMENCEMENT OF WORKS.

WARNING

ANY DESIGN SURFACE LEVELS SHOWN ARE PRELIMINARY ONLY AND SUBJECT TO FINAL DETAIL DESIGN, DO NOT USE FOR CONSTRUCTION

4	AS CONSTRUCTED ISSUE	GR	19.09.18	DRAWN:
3	ROAD CHAINAGES REVISED	GR	31.01.18	T.CANAVAN
2	SEWER ALIGNMENT AMENDED	GR	08.12.17	DESIGNED:
1	CONSTRUCTION ISSUE	GR	14.11.17	D. HUDSON
0	CONSTRUCTION ISSUE	GR	22.09.17	APPROVED:
A	PRELIMINARY ISSUE	GR	30.06.17	G.ROMANCZ
REV	DESCRIPTION	APPROVED	DATE	

H 1 : 500

@ A1

CLIENT:

Level 1, 173 Burke Road, Glen Iris VIC 3146

Tel : 03 8573 1500 Fax: 03 8573 1555

verveprojects.com

CLIENT:

Level 1, 173 Burke Road, Glen Iris VIC 3146

Tel : 03 8573 1500 Fax: 03 8573 1555

verveprojects.com

COUNCIL:

HUME CITY COUNCIL

PROJECT:

MERRIFIELD LIVING - SECTION C

STAGE 34

MICKLEHAM

ISSUE:

AS CONSTRUCTED

TITLE:

DETAIL PLAN - 1

MELWAY REF:

366 E2

PROJECT No:


17017-34

DWG No:

RD200

REVISION:


4

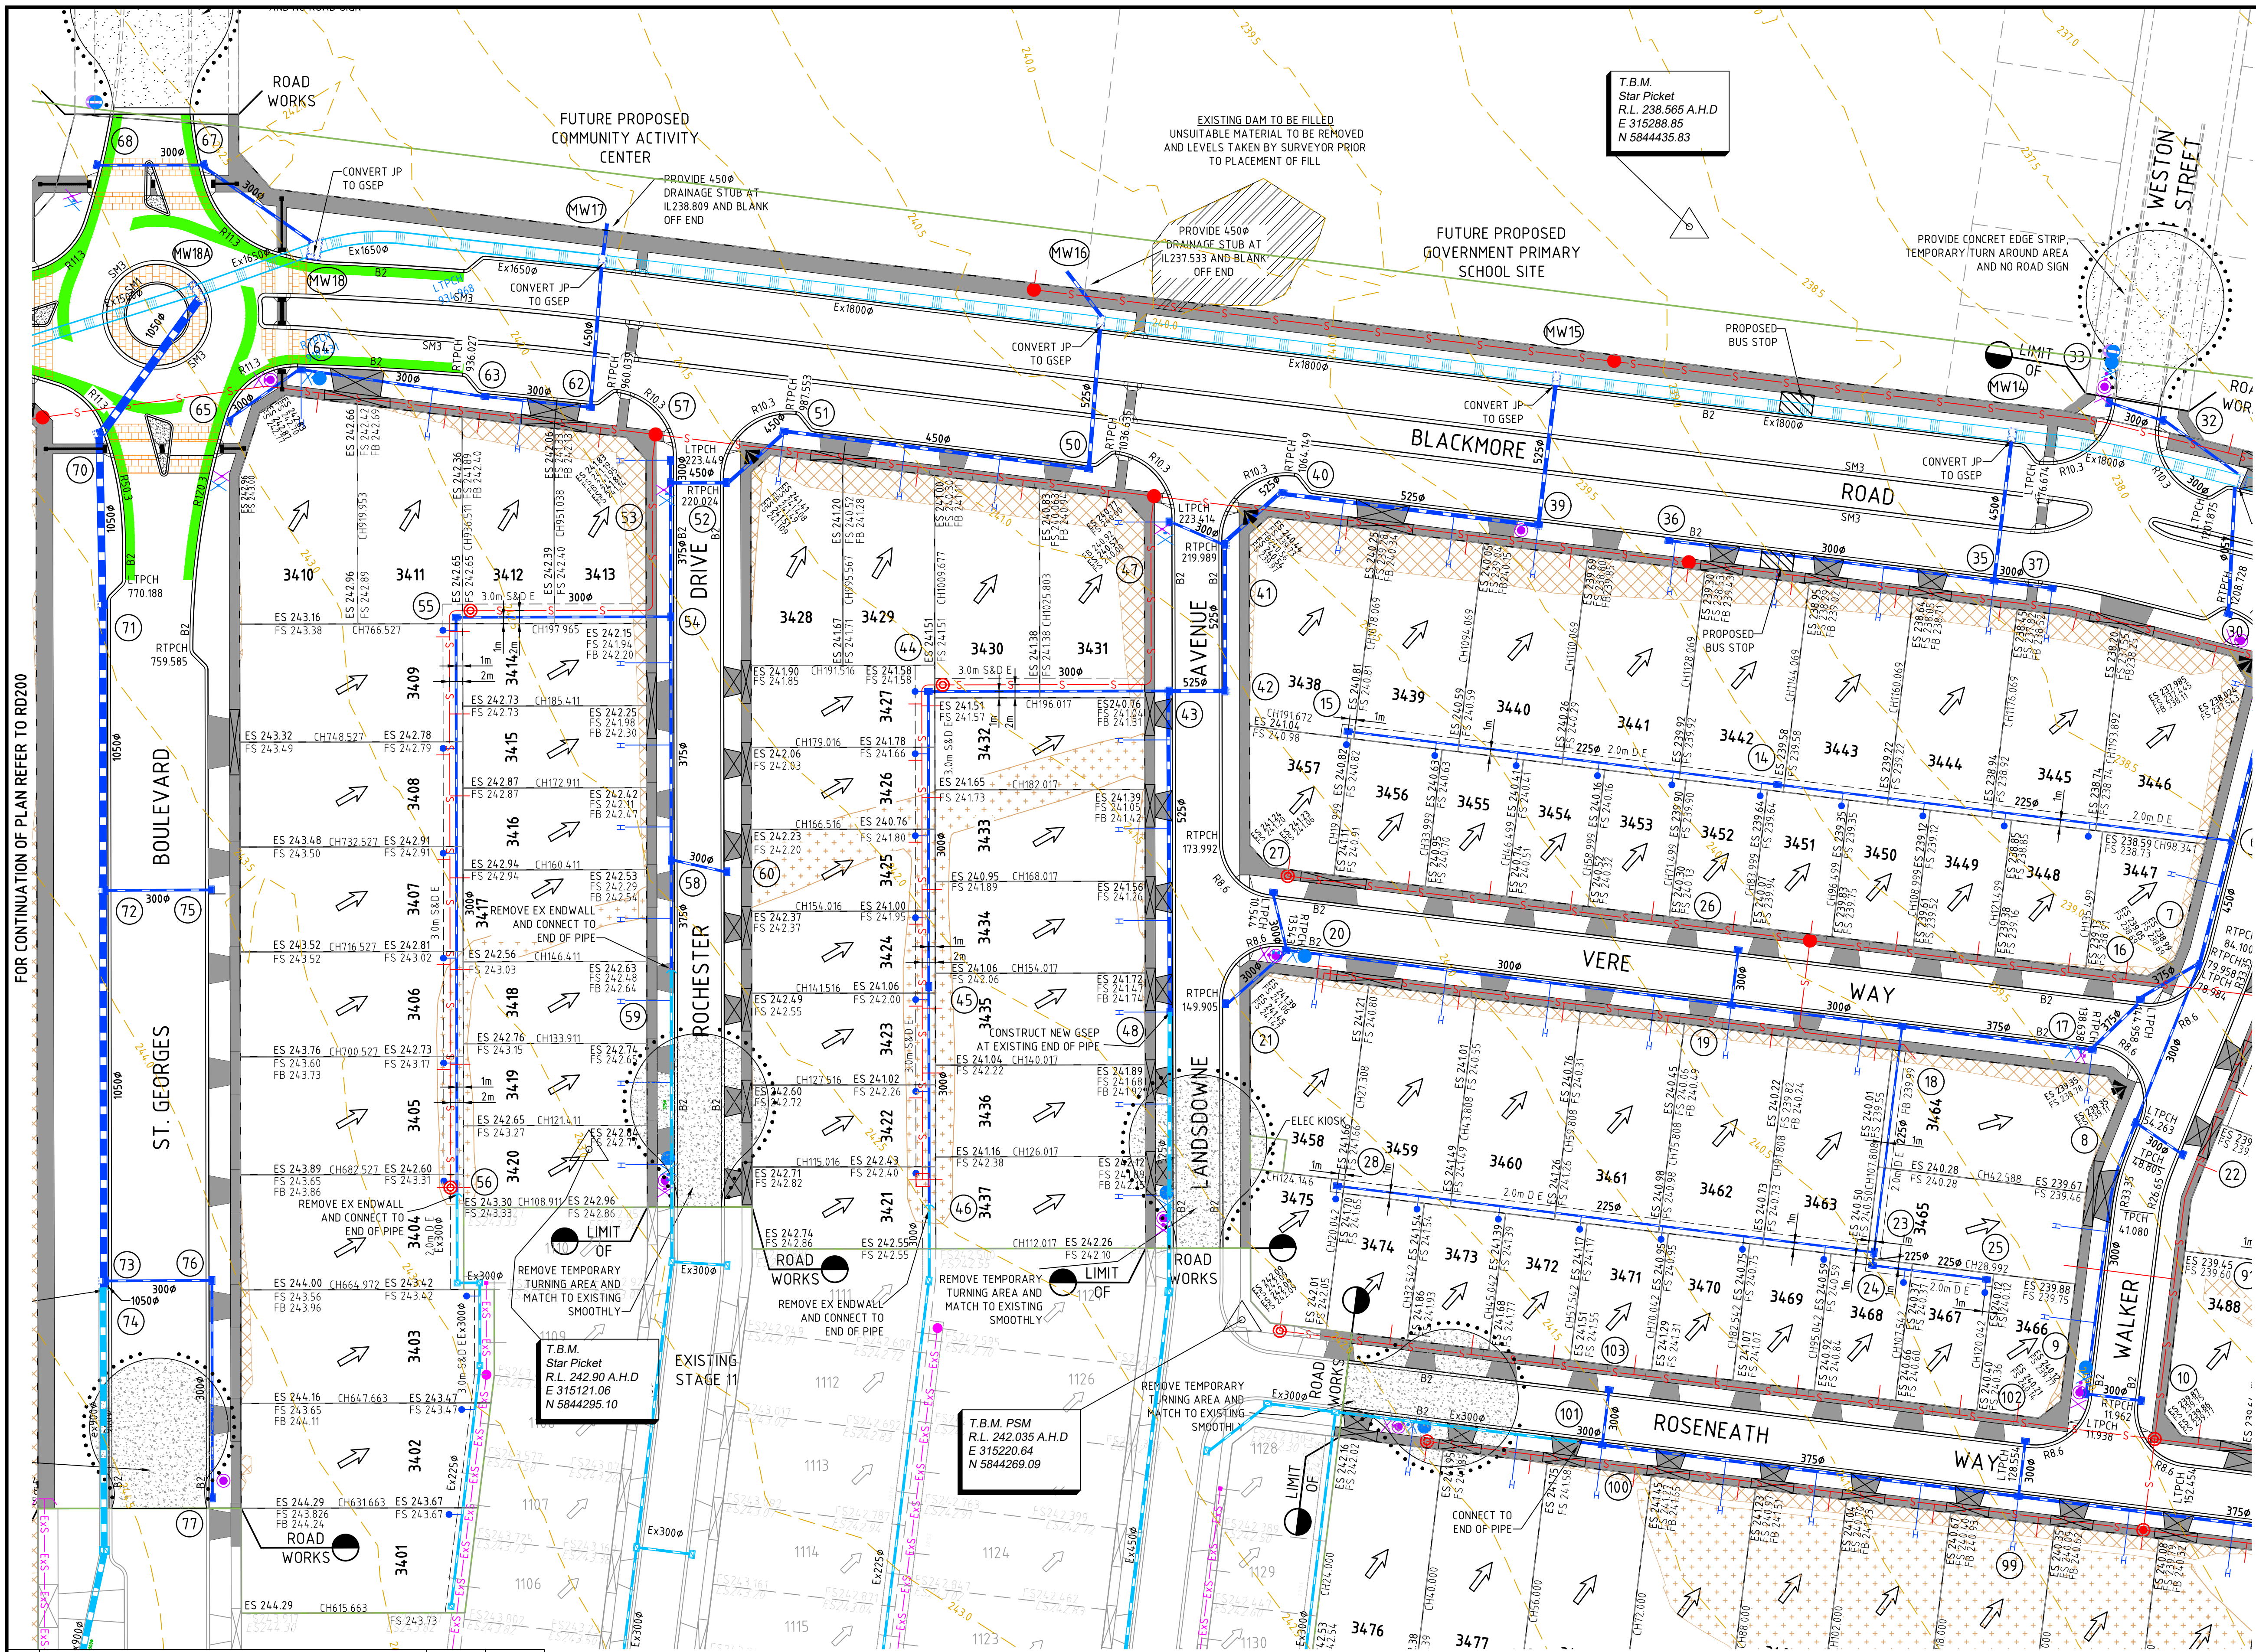

LEGEND - DETAIL

- LOT GRADE
- EXISTING SURFACE LEVEL
- FINISHED SURFACE LEVEL
- TOP OF BATTER LEVEL
- PERMANENT SURVEY MARK
- TEMPORARY BENCH MARK
- REMOVE EX TREE
- PROPOSED DRAINAGE
- MELBOURNE WATER DRAINAGE
- EXISTING DRAINAGE
- TABLE DRAIN
- PROPERTY INLET
- HOUSE DRAIN
- SWD PIT NUMBERS
- EXISTING SEWER
- PROPOSED SEWER
- CUT >150mm DEPTH
- FILL >300mm DEPTH
- ROUNDBOUT THRESHOLD TREATMENT
- G15 EMERALD (AS2700 S1996) OR VICROADS APPROVED EQUIVALENT AS PER VICROADS CYCLE NTE No.14 2005)

EXISTING DRAINAGE
SWALES TO BE
LEVEL 1 FILLED

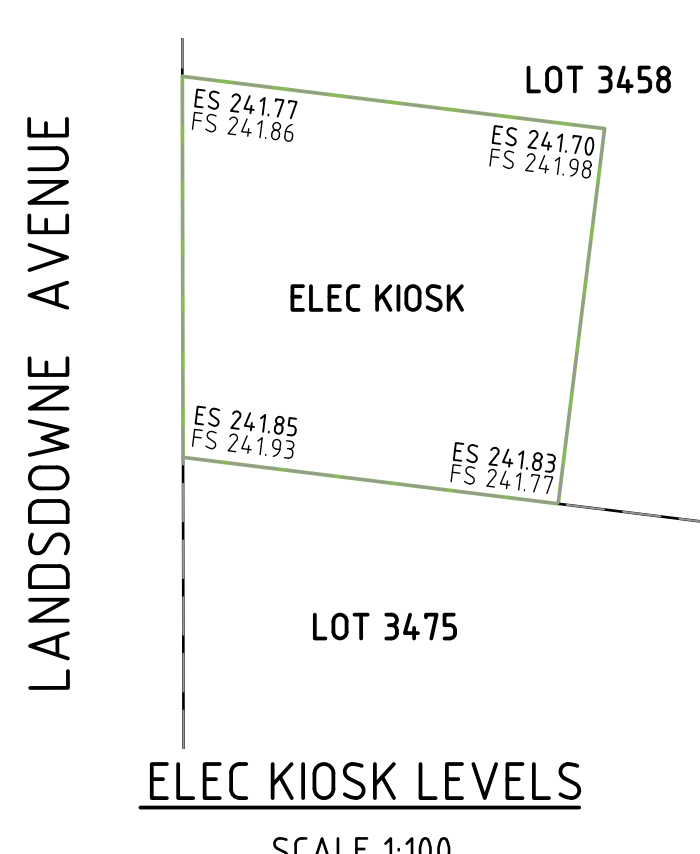

WARNING
BEWARE OF UNDERGROUND SERVICES
THE LOCATIONS OF UNDERGROUND SERVICES ARE APPROXIMATE ONLY AND THEIR EXACT POSITION SHOULD BE PROVEN ON SITE. NO GUARANTEE IS GIVEN THAT ALL EXISTING SERVICES ARE SHOWN. A MOC'S ENQUIRY ON 1100 MUST BE MADE BY THE CONTRACTOR PRIOR TO COMMENCEMENT OF WORKS.

WARNING
ANY DESIGN SURFACE LEVELS SHOWN ARE PRELIMINARY ONLY AND SUBJECT TO FINAL DETAIL DESIGN, DO NOT USE FOR CONSTRUCTION

5	AS CONSTRUCTED ISSUE	GR	19.09.18
4	FINISH SURFACE LEVELS ON LOTS 3428 AND 3431 REVISED	GR	02.02.18
3	SEWER ALIGNMENT AMENDED	GR	08.12.17
2	CONSTRUCTION ISSUE	GR	27.11.17
1	CONSTRUCTION ISSUE	GR	14.11.17
0	CONSTRUCTION ISSUE	GR	22.09.17
A	PRELIMINARY ISSUE	GR	30.06.17
REV	DESCRIPTION	APPROVED	DATE

FOR CONTINUATION OF PLAN REFER TO RD202

H 1:500
@ A1

0 5 10 20 30 40

CLIENT:

merrifield
MAB **GPC**

verve
Level 1, 173 Burke Road, Glen Iris VIC 3146
Tel : 03 8573 1500 Fax: 03 8573 1555
verveprojects.com

COUNCIL:

HUME CITY COUNCIL

PROJECT:

MERRIFIELD LIVING - SECTION C
STAGE 34
MICKLEHAM

ISSUE:

AS CONSTRUCTED

MELWAY REF:

366 E2

PROJECT No:

17017-34


DWG No:

RD201

REVISION:

5

T.CANAVAN	DESIGNED:	G.ROMANCZ	APPROVED:
D. HUDSON	DESIGNED:	G.ROMANCZ	APPROVED:
T.B.M. Star Picket R.L. 242.90 A.H.D E 31521.06 N 5844295.10	DESIGNED:	G.ROMANCZ	APPROVED:
T.B.M. PSM R.L. 242.035 A.H.D E 315220.64 N 5844269.09	DESIGNED:	G.ROMANCZ	APPROVED:
T.B.M. Star Picket R.L. 238.565 A.H.D E 315288.85 N 5844435.83	DESIGNED:	G.ROMANCZ	APPROVED:

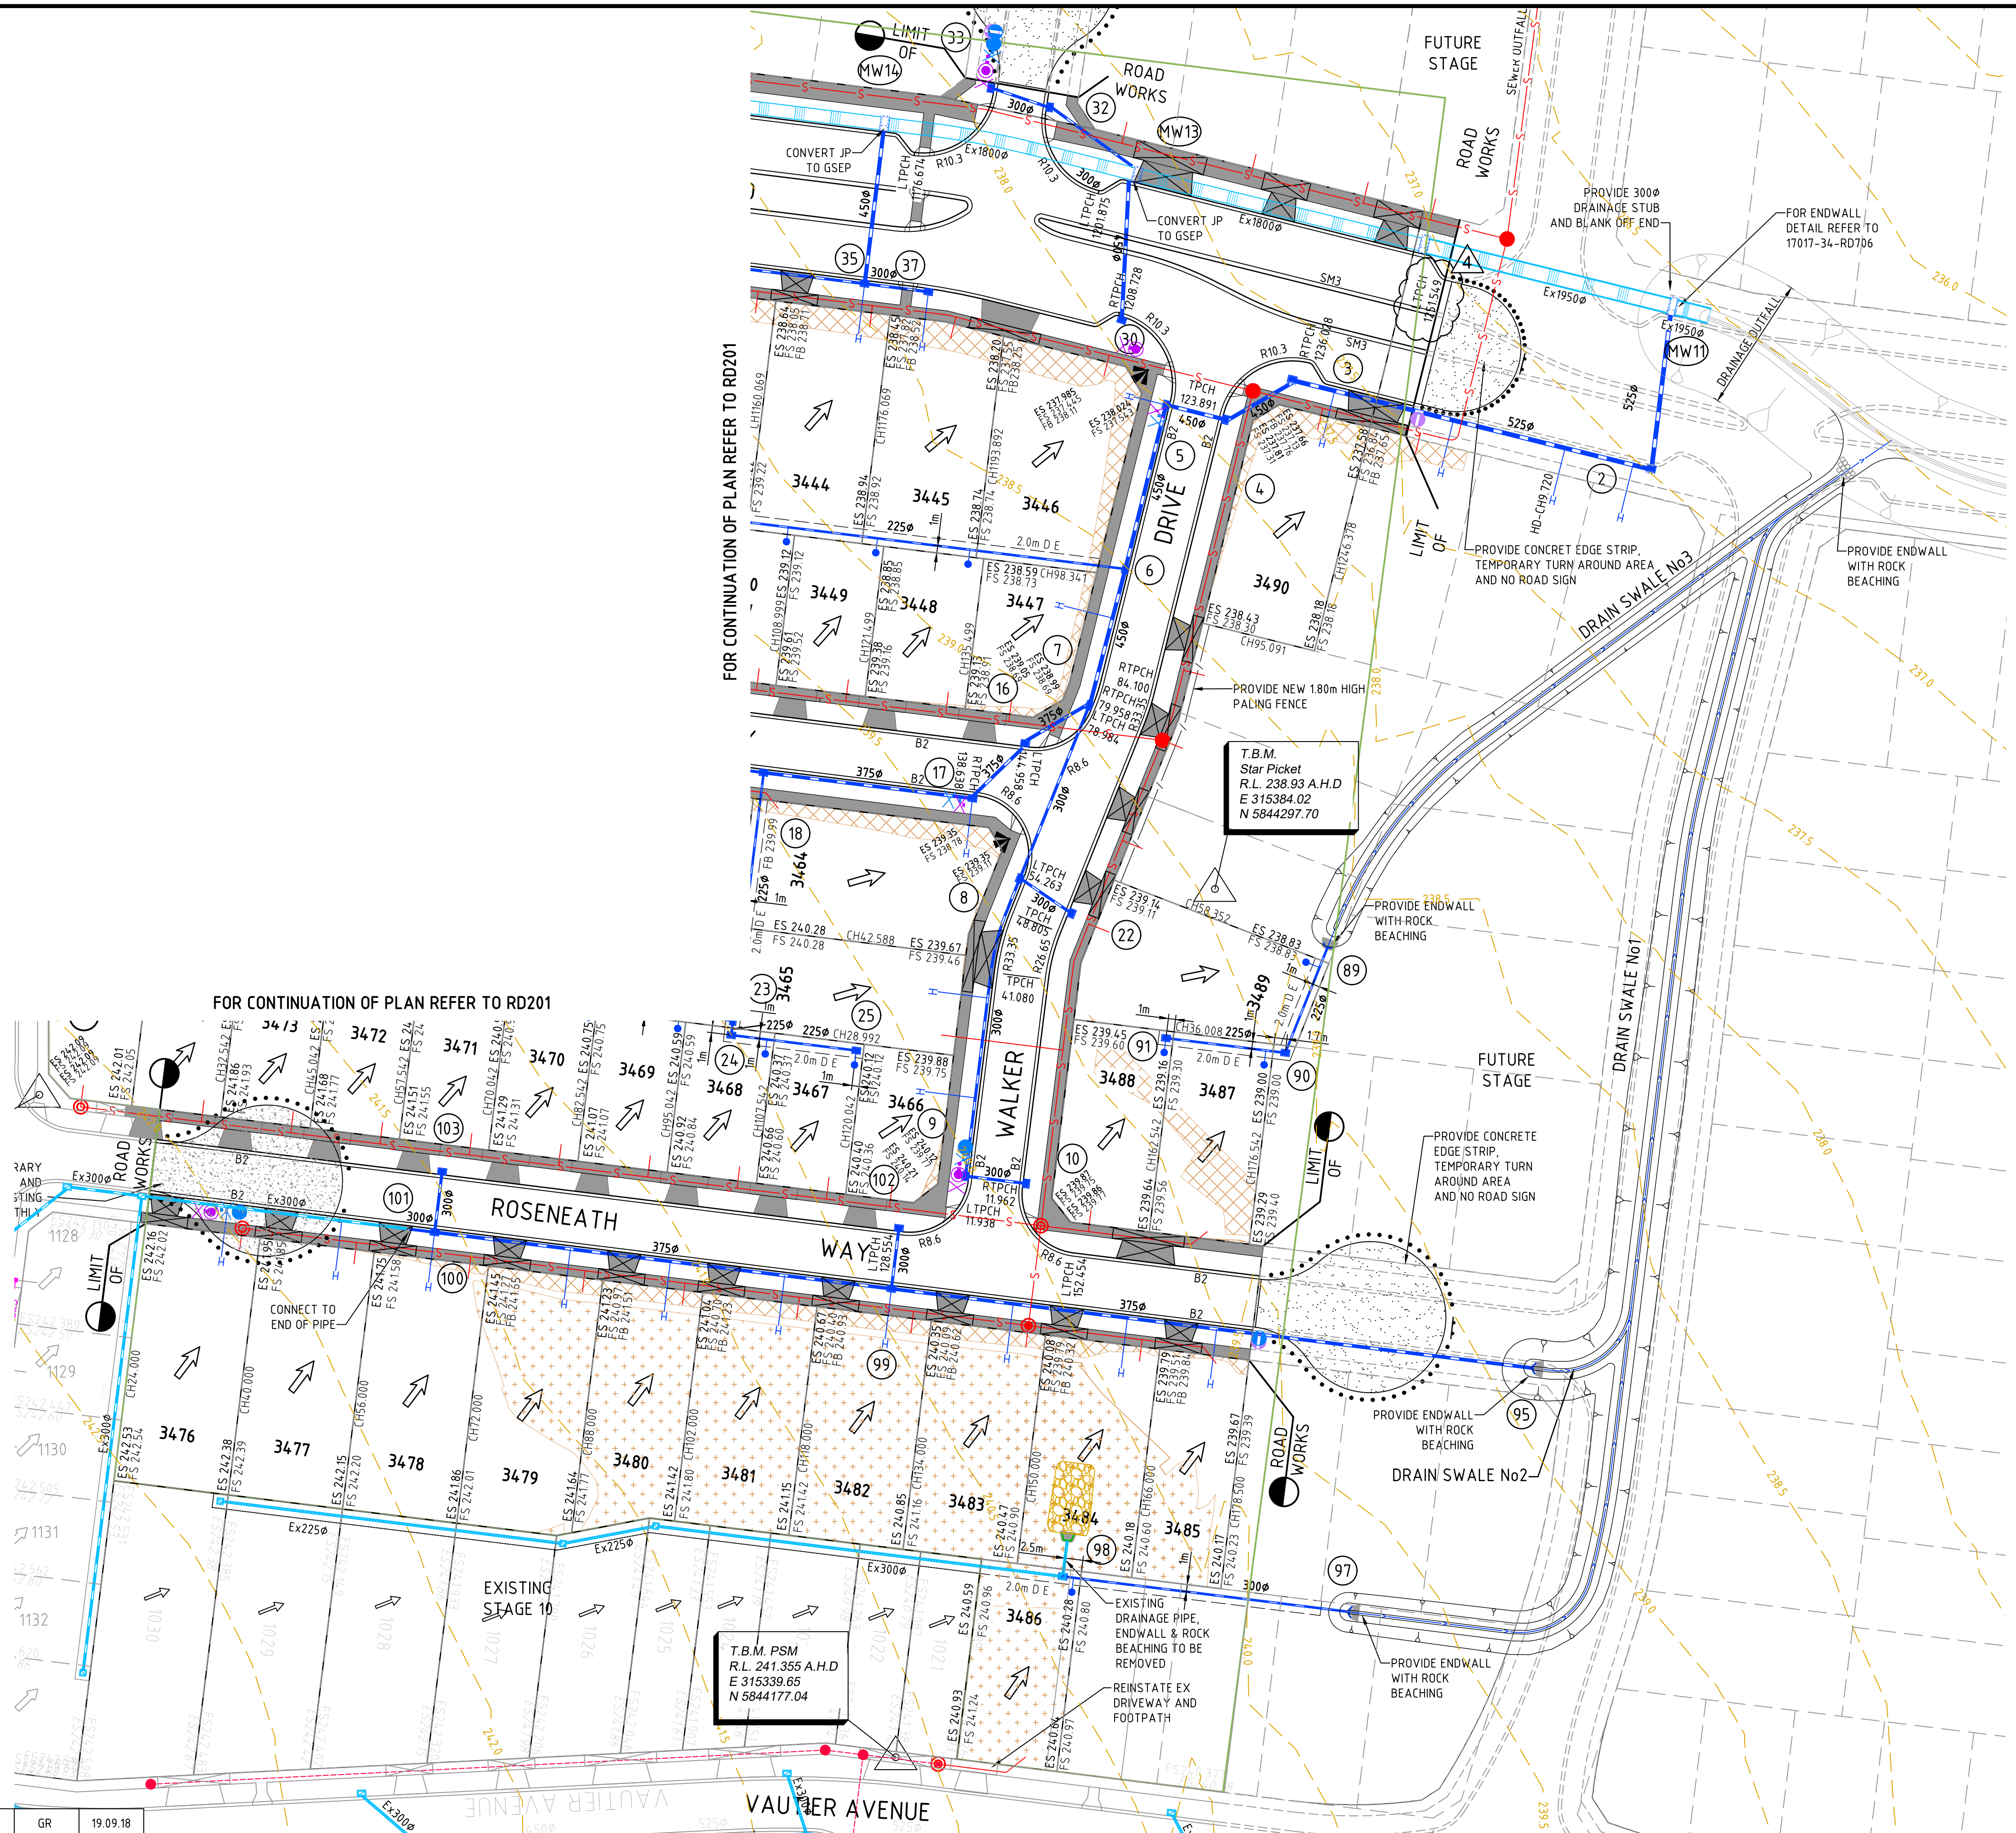

LEGEND - DETAIL

- LOT GRADE
- EXISTING SURFACE LEVEL
- FINISHED SURFACE LEVEL
- TOP OF BATTER LEVEL
- PERMANENT SURVEY MARK
- TEMPORARY BENCH MARK
- REMOVE EX TREE
- PROPOSED DRAINAGE
- MELBOURNE WATER DRAINAGE
- EXISTING DRAINAGE
- TABLE DRAIN
- PROPERTY INLET
- HOUSE DRAIN
- SWD PIT NUMBERS
- EXISTING SEWER
- PROPOSED SEWER
- CUT >150mm DEPTH
- FILL >300mm DEPTH

EXISTING DRAINAGE
SWALES TO BE
LEVEL 1 FILLED


WARNING
BEWARE OF UNDERGROUND SERVICES
THE LOCATIONS OF UNDERGROUND SERVICES ARE APPROXIMATE ONLY AND THEIR EXACT POSITION SHOULD BE PROVEN ON SITE. NO GUARANTEE IS GIVEN THAT ALL EXISTING SERVICES ARE SHOWN. A MOC'S ENQUIRY ON 1100 MUST BE MADE BY THE CONTRACTOR PRIOR TO COMMENCEMENT OF WORKS.

WARNING
ANY DESIGN SURFACE LEVELS SHOWN ARE PRELIMINARY ONLY AND SUBJECT TO FINAL DETAIL DESIGN, DO NOT USE FOR CONSTRUCTION

5	AS CONSTRUCTED ISSUE	GR	19.09.18
4	ROAD CHAINAGE REVISED	GR	31.01.18
3	SEWER ALIGNMENT AMENDED	GR	08.12.17
2	CONSTRUCTION ISSUE	GR	27.11.17
1	CONSTRUCTION ISSUE	GR	14.11.17
0	CONSTRUCTION ISSUE	GR	22.09.17
A	PRELIMINARY ISSUE	GR	30.06.17
REV	DESCRIPTION	APPROVED	DATE

DRAWN:
DESIGNED:
APPROVED:

T.CANAVAN
D. HUDSON
G.ROMANCZ

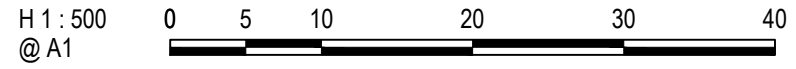

CLIENT:



verve
Level 1, 173 Burke Road, Glen Iris VIC 3146
Tel : 03 8573 1500 Fax: 03 8573 1555
verveprojects.com

COUNCIL:

HUME CITY COUNCIL
PROJECT: MERRIFIELD LIVING - SECTION C
STAGE 34
MICKLEHAM
ISSUE: **AS CONSTRUCTED**

TITLE:

DETAIL PLAN - 3
MELWAY REF: 366 E2
PROJECT No: 17017-34
DWG No: RD202
REVISION: 5