


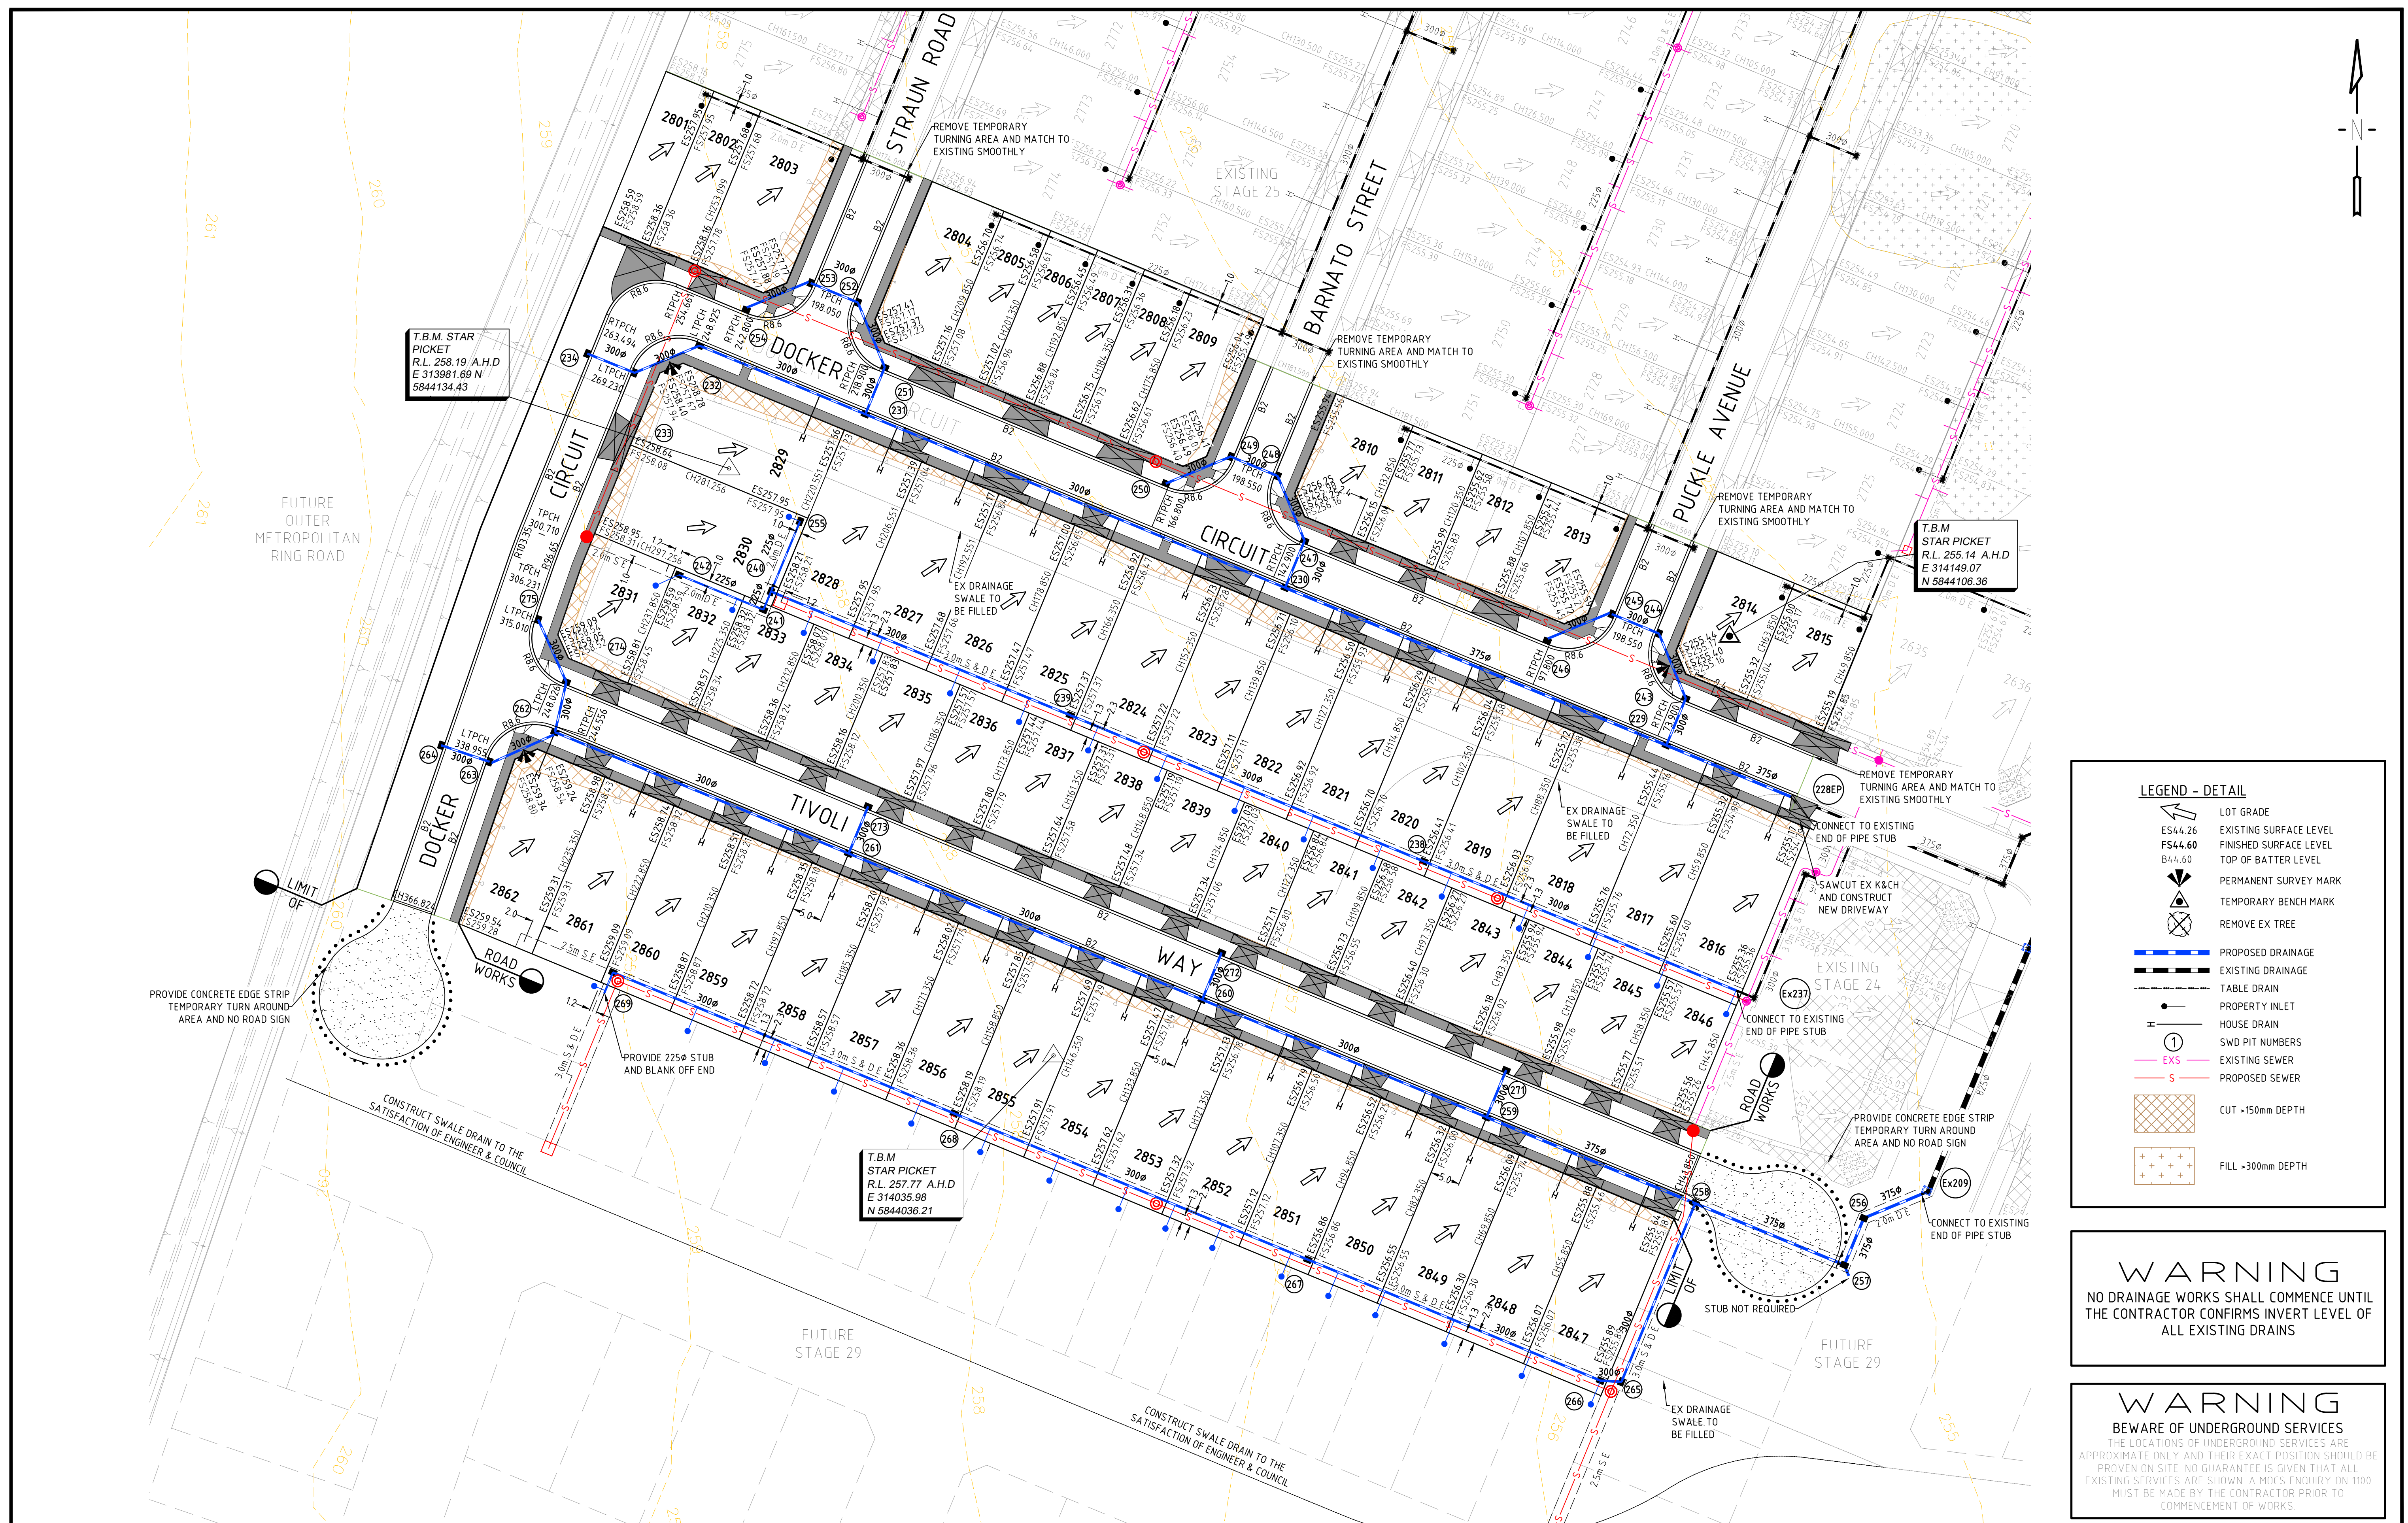

				DRAWN: L. APAP	H 1 : 500 @ A1 0 5 10 20 30 40	merrifield MABGPC verve Verve Projects Pty Ltd Level 1 173 Burke Road Glen Iris VIC 3146 T 03 8573 1500 verveprojects.com	Council Seal Quantity 950 0001 1 of 1 sheets Issue Issue 1: As Constructed New: As Constructed Revised: As Constructed	COUNCIL: HUMER CITY COUNCIL				
				DESIGNED: C.J.SANTOS				PROJECT: MERRIFIELD LIVINGS - SECTION B STAGE 28 MICKLEHAM				
				APPROVED: G. ROMAN CZ				TITLE: DETAIL PLAN				
1	AS CONSTRUCTED ISSUE	JW	21.10.17									
0	CONSTRUCTION ISSUE	GR	21.04.17									
A	PRELIMINARY ISSUE	GR	23.12.12									
REV	DESCRIPTION	APPROVED	DATE									