


PRIOR TO COMMENCEMENT OF WORKS THE CONTRACTOR IS TO ENSURE THE TBM'S USED CLOSE AGAINST AT LEAST TWO OTHER TBM'S. THE CONTRACTOR IS TO NOTIFY THE SUPERINTENDENT OF ANY TBM'S THAT HAVE BEEN DISTURBED

T.B.M. NO.	EASTING (M)	NORTHING (M)	A.H.D LEVEL (M)	DESCRIPTION	TBM DATE OF SURVEY
10	314459.61	5844496.44	247.70	RIVET IN PIT SURROUND	Sep-18
14	315720.87	5844308.23	236.39	STAR PICKET	Sep-18
27	315523.21	5844778.97	234.695	RIVET IN PIT SURROUND	Jun-19
30	315745.00	5844623.67	232.795	STAR PICKET	Jun-19

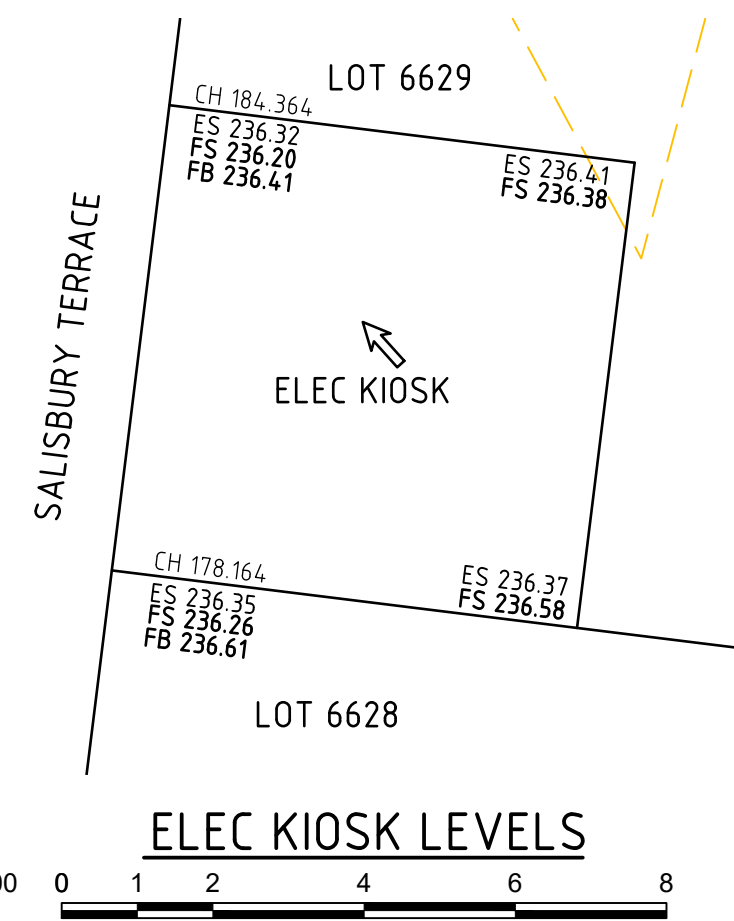


LEGEND - DETAIL PLAN	
	LOT GRADE
	EXISTING CONTOURS
	EXISTING SURFACE LEVEL
	FINISHED SURFACE LEVEL
	TOP OF BATTER LEVEL
	TOP OF WALL SURFACE LEVEL
	BOTTOM OF WALL SURFACE LEVEL
	KERB AND TYPE
	PROPOSED VEHICLE CROSSING AND FOOTPATH
	ARC RADIUS AT LIP OF KERB
	CHAINAGE DERIVED FROM ROAD CENTRE
	PROPOSED FENCE
	PROPOSED STAGE BOUNDARY
	PROPOSED RETAINING WALL
	BOLLARDS
	LIMIT OF ROAD WORKS
	STREET SIGN
	NO ROAD SIGN
	PERMANENT SURVEY MARK
	TEMPORARY BENCH MARK AND REF. NO.
	REMOVE EXISTING TREE
	PROPOSED BATTER
	TACTILE MARKERS (TGS1's)
	EASEMENT LINE AND TYPE
	PROPOSED COUNCIL DRAINAGE PIT, HAUNCH, PIPE AND DIAMETER
	PROPOSED MAIN DRAINAGE PIT, HAUNCH, PIPE AND DIAMETER
	DRAINAGE PROPERTY INLET CONNECTION
	DRAINAGE HOUSE DRAIN CONNECTION
	DRAINAGE PIT NUMBERS
	PROPOSED SEWER, MAINTENANCE STRUCTURE AND PROPERTY CONNECTION
	PROPOSED MAINTENANCE HOLE
	PROPOSED MAINTENANCE CHAMBER
	PROPOSED MAINTENANCE SHAFT
	PROPOSED INSPECTION SHAFT
	PROPOSED GAS CHECK
	PROPOSED SEWER PIPE STUB
	EXISTING COUNCIL DRAINAGE PIPE, PIT
	EXISTING MAIN DRAINAGE PIPE, PIT
	EXISTING SEWER, MAINTENANCE STRUCTURE AND PROPERTY CONNECTION
	CUT >150mm DEPTH
	FILL >200mm DEPTH
	ROUNDABOUT THRESHOLD TREATMENT
	G15 EMERALD (AS2700 S1996) OR VICROADS APPROVED EQUIVALENT AS PER VICROADS CYCLE NTE No.14 2005

HOUSE DRAINS/PROPERTY INLETS FOR FUTURE LOTS HAVE BEEN SET TO LOW SIDE OF LOT AT TIME OF DOCUMENTATION. CHAINAGES SHOWN FOR HOUSE DRAINS IN FUTURE LOTS ARE TAKEN FROM CENTRE OF DOWNSTREAM PIT TO HOUSE DRAIN, DENOTED HD CH.

EXISTING OPEN CHANNELS TO BE LEVEL 1 FILLED AS PER GEOTECHNICAL ADVICE / SUPERINTENDENTS INSTRUCTION

WARNING
BWARE OF UNDERGROUND SERVICES
THE LOCATIONS OF UNDERGROUND SERVICES ARE APPROXIMATE ONLY AND THEIR EXACT POSITION SHOULD BE PROVEN ON SITE. NO GUARANTEE IS GIVEN THAT ALL EXISTING SERVICES ARE SHOWN. A DBYD ENQUIRY ON 1100 MUST BE MADE BY THE CONTRACTOR PRIOR TO COMMENCEMENT OF WORKS.

WARNING
ANY DESIGN SURFACE LEVELS SHOWN ARE PRELIMINARY ONLY AND SUBJECT TO FINAL DETAIL DESIGN, DO NOT USE FOR CONSTRUCTION

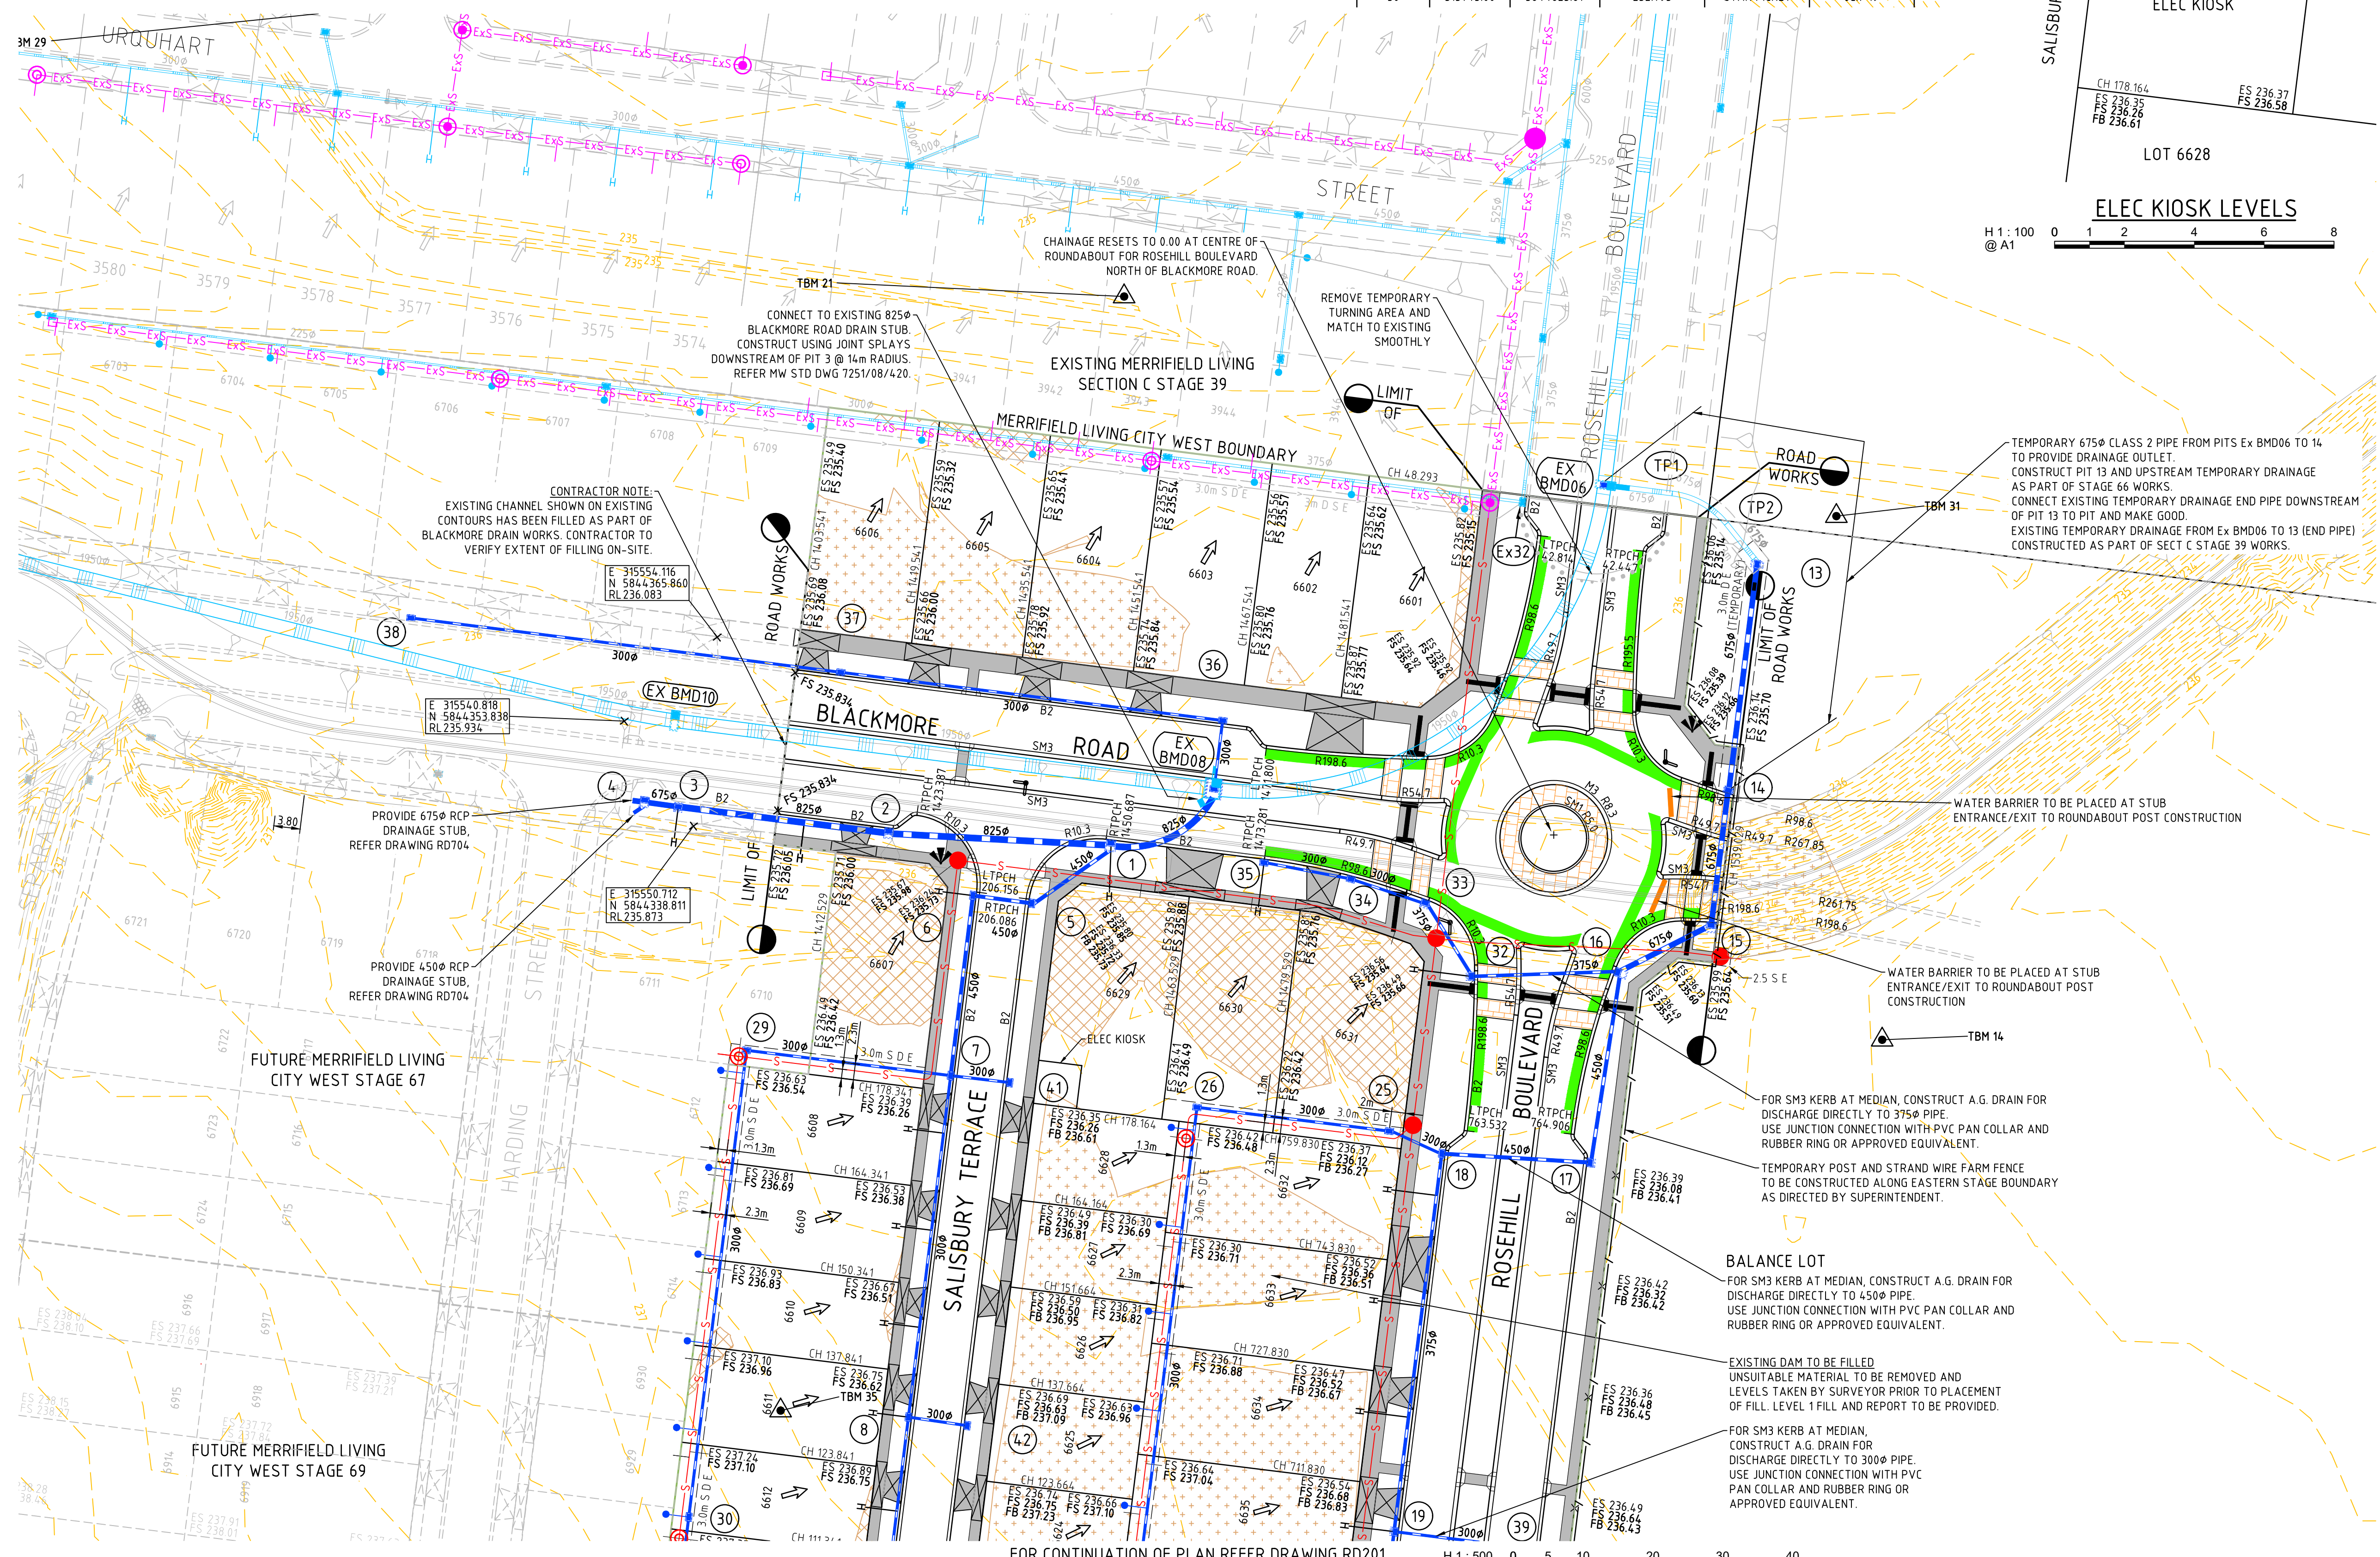

FOR CONTINUATION OF PLAN REFER DRAWING RD201

CAD FILE: \\PMP01\REDIRECT\FILES\LINCOLN WHITE\PICTURES\NEW FOLDER (3)\17030-66-RD200-RD201.DWG
PLOT DATE: 24/11/2020 11:05:53 AM

1	AS CONSTRUCTED ISSUE	G.R.	19.11.20	DRAWN:	P.CAMILLERI
0	CONSTRUCTION ISSUE	G.R.	19.02.20	DESIGNED:	LAPAP
D	COUNCIL COMMENTS	G.R.	21.08.19	APPROVED:	G.ROMANCZ
C	COUNCIL COMMENTS	G.R.	25.06.19		
B	PRELIMINARY ISSUE: DOCUMENTATION OF REVISED STAGE 66	G.R.	29.04.19		
A	PRELIMINARY ISSUE	G.R.	14.12.18		
REV	DESCRIPTION	APPROVED	DATE		

CLIENT:

merrifield

MAB **GPC**

verve


Level 1, 173 Burke Road, Glen Iris VIC 3146

Tel : 03 8573 1500

verveprojects.com

COUNCIL:	HUME CITY COUNCIL	TITLE:	MERRIFIELD LIVING - CITY WEST STAGE 66 MICKLEHAM
PROJECT:	MERRIFIELD LIVING - CITY WEST STAGE 66 MICKLEHAM	ISSUE:	AS CONSTRUCTED
MELWAY REF:	366 F2	PROJECT No:	17030-66
DWG No:	RD200	REVISION:	1

CAD FILE: \\VPMF01\REDIR\FILES\LINCOLN\WHITE\PICTURES\NEW FOLDER (31\17030-66-RD200-RD201.DWG
PLOT DATE: 24/11/2020 10:42:42 AM

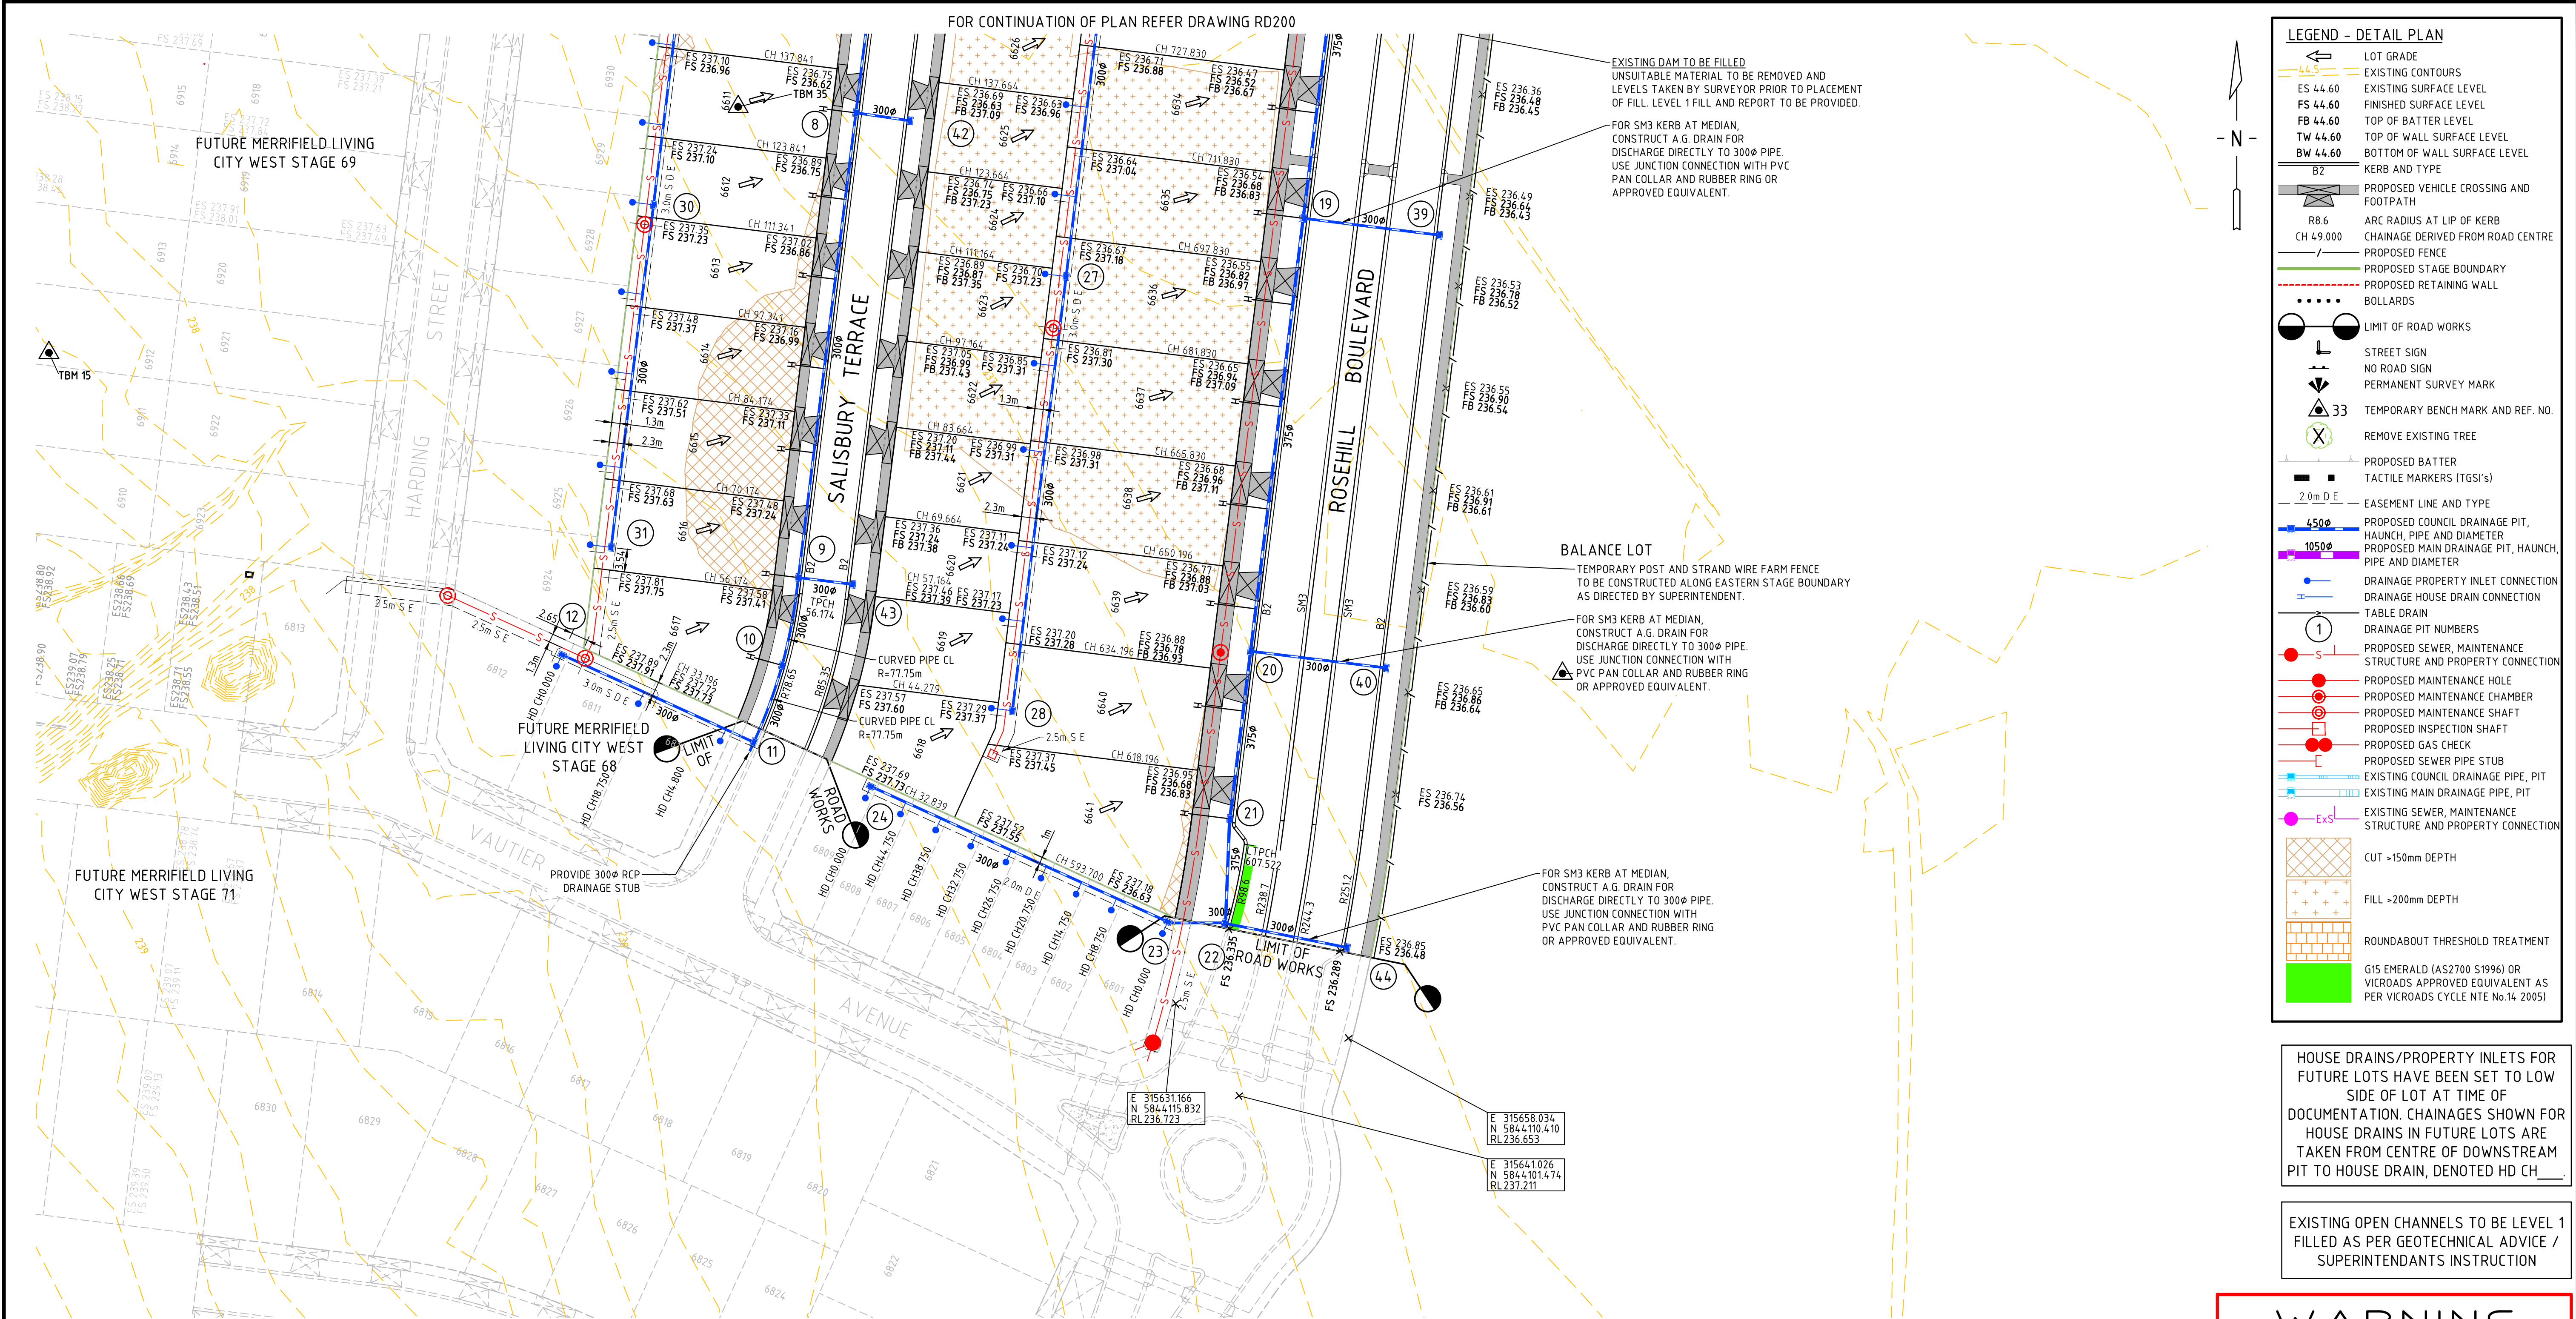

LEGEND - DETAIL PLAN

- LOT GRADE
- EXISTING CONTOURS
- ES 44.60 EXISTING SURFACE LEVEL
- FS 44.60 FINISHED SURFACE LEVEL
- FB 44.60 TOP OF BATTER LEVEL
- TW 44.60 TOP OF WALL SURFACE LEVEL
- BW 44.60 BOTTOM OF WALL SURFACE LEVEL
- B2 KERB AND TYPE
- PROPOSED VEHICLE CROSSING AND FOOTPATH
- R8.6 ARC RADIUS AT LIP OF KERB
- CH 49.000 CHAINAGE DERIVED FROM ROAD CENTRE
- PROPOSED FENCE
- PROPOSED STAGE BOUNDARY
- PROPOSED RETAINING WALL
- BOLLARDS
- LIMIT OF ROAD WORKS
- STREET SIGN
- NO ROAD SIGN
- PERMANENT SURVEY MARK
- TEMPORARY BENCH MARK AND REF. NO.
- 33 REMOVE EXISTING TREE
- PROPOSED BATTER
- TACTILE MARKERS (TGS's)
- 2.0m D.E.
- EASEMENT LINE AND TYPE
- PROPOSED COUNCIL DRAINAGE PIT, HAUNCH, PIPE AND DIAMETER
- PROPOSED MAIN DRAINAGE PIT, HAUNCH, PIPE AND DIAMETER
- DRAINAGE PROPERTY INLET CONNECTION
- DRAINAGE HOUSE DRAIN CONNECTION
- TABLE DRAIN
- DRAINAGE PIT NUMBERS
- PROPOSED SEWER, MAINTENANCE STRUCTURE AND PROPERTY CONNECTION
- PROPOSED MAINTENANCE HOLE
- PROPOSED MAINTENANCE CHAMBER
- PROPOSED MAINTENANCE SHAFT
- PROPOSED INSPECTION SHAFT
- PROPOSED GAS CHECK
- PROPOSED SEWER PIPE STUB
- EXISTING COUNCIL DRAINAGE PIPE, PIT
- EXISTING MAIN DRAINAGE PIPE, PIT
- EXISTING SEWER, MAINTENANCE STRUCTURE AND PROPERTY CONNECTION
- CUT >150mm DEPTH
- FILL >200mm DEPTH
- ROUNDBOAT THRESHOLD TREATMENT
- G15 EMERALD (AS2700 S1996) OR VICROADS APPROVED EQUIVALENT AS PER VICROADS CYCLE NTE No.14 2005)

HOUSE DRAINS/PROPERTY INLETS FOR FUTURE LOTS HAVE BEEN SET TO LOW SIDE OF LOT AT TIME OF DOCUMENTATION. CHAINAGES SHOWN FOR HOUSE DRAINS IN FUTURE LOTS ARE TAKEN FROM CENTRE OF DOWNSTREAM PIT TO HOUSE DRAIN, DENOTED HD CH.

EXISTING OPEN CHANNELS TO BE LEVEL 1 FILLED AS PER GEOTECHNICAL ADVICE / SUPERINTENDANTS INSTRUCTION

PRIOR TO COMMENCEMENT OF WORKS THE CONTRACTOR IS TO ENSURE THE TBM'S USED CLOSE AGAINST AT LEAST TWO OTHER TBM'S. THE CONTRACTOR IS TO NOTIFY THE SUPERINTENDENT OF ANY TBM'S THAT HAVE BEEN DISTURBED

T.B.M. NO.	EASTING (M)	NORTHING (M)	A.H.D. LEVEL (M)	DESCRIPTION	TBM DATE OF SURVEY
12	314459.61	5844496.44	247.70	RIVET IN PIT SURROUND	Sep-18
14	315720.87	5844308.23	236.39	STAR PICKET SURROUND	Sep-18
27	315523.21	5844778.97	234.695	RIVET IN PIT SURROUND	Jun-19
30	315745.00	5844623.67	232.795	STAR PICKET	Jun-19

WARNING


BWARE OF UNDERGROUND SERVICES

THE LOCATIONS OF UNDERGROUND SERVICES ARE APPROXIMATE ONLY AND THEIR EXACT POSITION SHOULD BE PROVEN ON SITE. NO GUARANTEE IS GIVEN THAT ALL EXISTING SERVICES ARE SHOWN. A DBYD ENQUIRY ON 1100 MUST BE MADE BY THE CONTRACTOR PRIOR TO COMMENCEMENT OF WORKS.

WARNING

ANY DESIGN SURFACE LEVELS SHOWN ARE PRELIMINARY ONLY AND SUBJECT TO FINAL DETAIL DESIGN, DO NOT USE FOR CONSTRUCTION

1	AS CONSTRUCTED ISSUE	G.R.	19.11.20	DRAWN:	P.CAMILLERI
0	CONSTRUCTION ISSUE	G.R.	19.02.20	DESIGNED:	LAPAP
D	COUNCIL COMMENTS	G.R.	21.08.19	APPROVED:	G.ROMANCZ
C	COUNCIL COMMENTS	G.R.	25.06.19		
B	PRELIMINARY ISSUE: DOCUMENTATION OF REVISED STAGE 66	G.R.	29.04.19		
A	PRELIMINARY ISSUE	G.R.	14.12.18		
REV	DESCRIPTION	APPROVED	DATE		

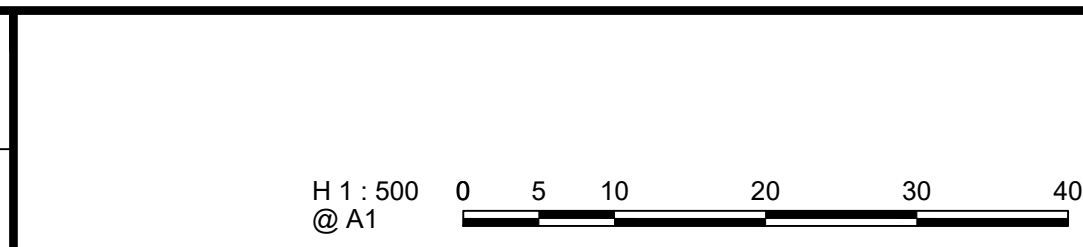

CLIENT:

merrifield

MAB **GPC**

Level 1, 173 Burke Road, Glen Iris VIC 3146
Tel : 03 8573 1500
verveprojects.com

COUNCIL:

HUME CITY COUNCIL

PROJECT:

MERRIFIELD LIVING - CITY WEST
STAGE 66
MICKLEHAM

ISSUE:

AS CONSTRUCTED

TITLE:

DETAIL PLAN - 2

MELWAY REF: 366 F2

PROJECT No: 17030-66

DWG No: RD201

REVISION: 1