


D:\2025\ENERGY_DATA\TEMP\2025\ENERGY\2025\ENERGY\SERVER\SERVICE\6598\170028482-EF0F-40EC-8319-7C90803BCE2E\17030-71-RD200.DWG
CADD FILE: 30 Jul 2021 10:03:47
PLOT DATE: 30 Jul 2021 10:03:47

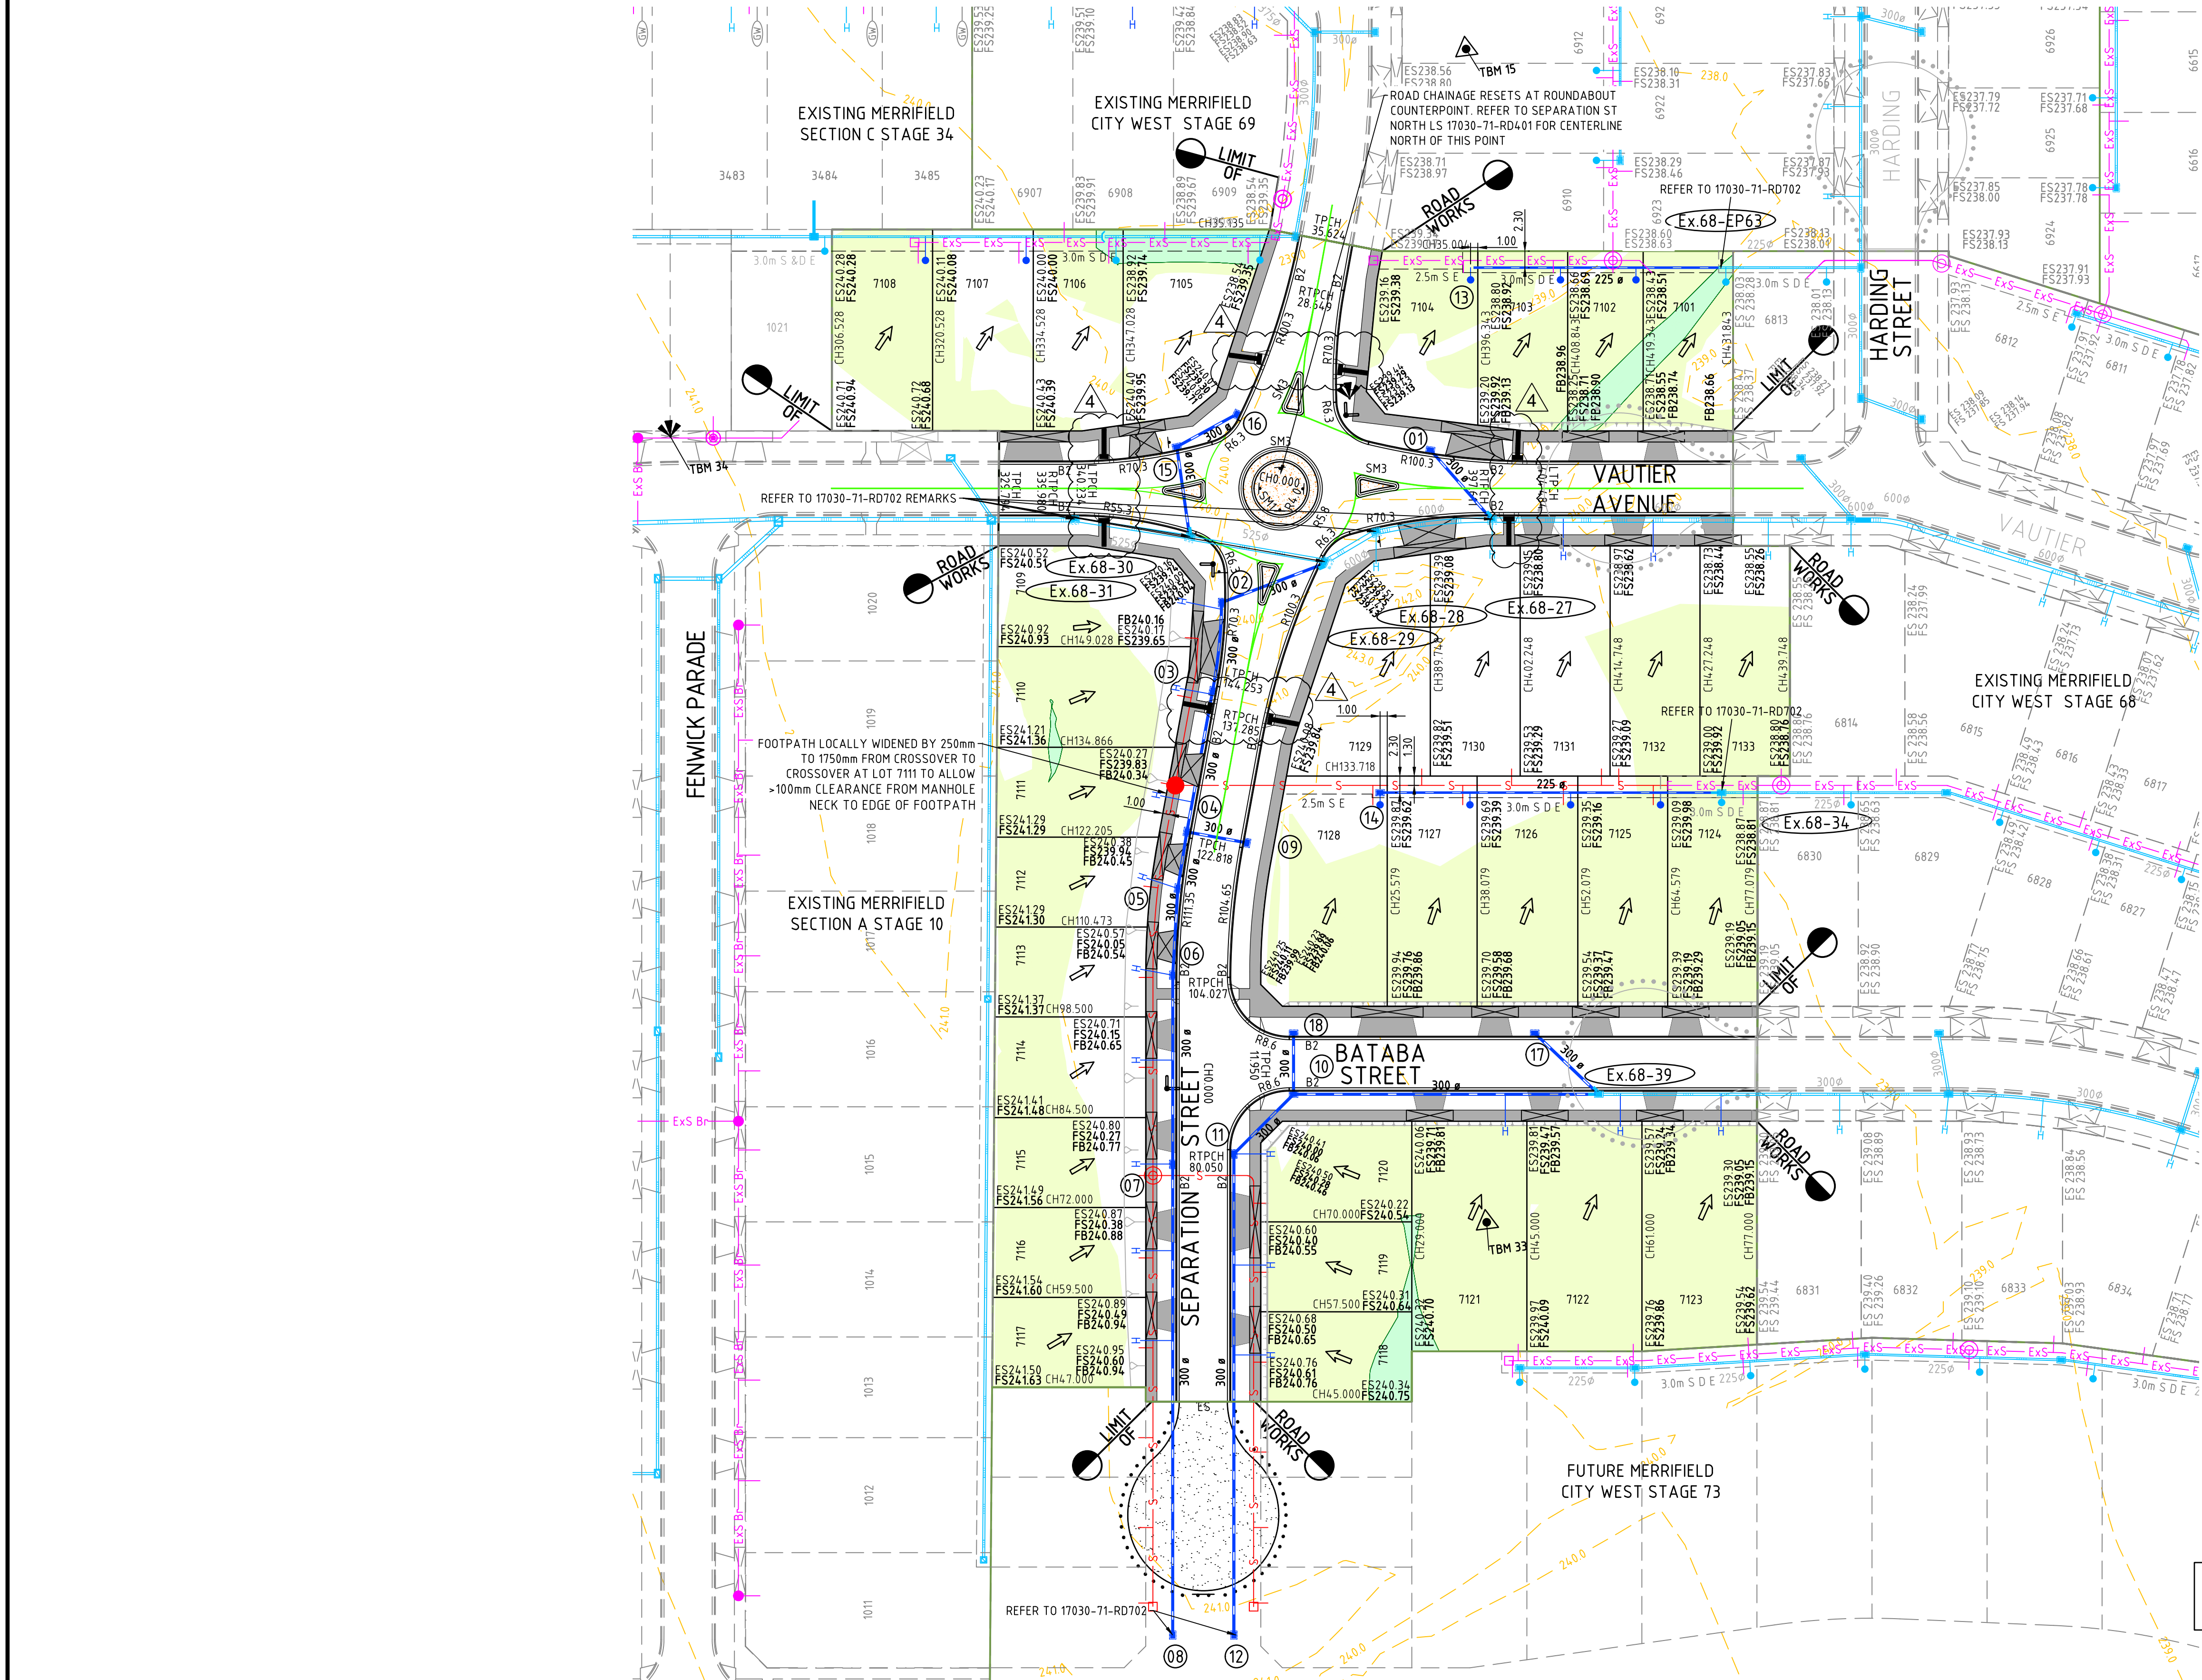

LEGEND - DETAIL PLAN

- LOT GRADE
- EXISTING CONTOURS
- ES 44.60 EXISTING SURFACE LEVEL
- FS 44.60 FINISHED SURFACE LEVEL
- FB 44.60 TOP OF BATTER LEVEL
- B2 KERB AND TYPE
- PROPOSED VEHICLE CROSSING AND FOOTPATH
- W=3.0m IN REFERENCE WITH EDCM501
- R8.6 ARC RADIUS AT LIP OF KERB
- CH 49.000 CHAINAGE DERIVED FROM ROAD CENTRE
- PROPOSED FENCE
- PROPOSED STAGE BOUNDARY
- BOLLARDS
- LIMIT OF ROAD WORKS
- STREET SIGN
- NO ROAD SIGN
- PERMANENT SURVEY MARK
- 33 TEMPORARY BENCH MARK AND REF. NO.
- PROPOSED BATTER
- TACTILE MARKERS (TGS's)
- 2.0m D.E. EASEMENT LINE AND TYPE
- 450mm PROPOSED COUNCIL DRAINAGE PIT, HAUNCH, PIPE AND DIAMETER
- DRAINAGE PROPERTY INLET CONNECTION
- DRAINAGE HOUSE DRAIN CONNECTION
- EX DRAINAGE HOUSE DRAIN CONNECTION
- TABLE DRAIN
- DRAINAGE PIT NUMBERS
- PROPOSED SEWER, MAINTENANCE STRUCTURE AND PROPERTY CONNECTION
- PROPOSED MAINTENANCE HOLE
- PROPOSED MAINTENANCE CHAMBER
- PROPOSED MAINTENANCE SHAFT
- PROPOSED INSPECTION SHAFT
- PROPOSED GAS CHECK
- PROPOSED SEWER PIPE STUB
- EXISTING COUNCIL DRAINAGE PIPE, PIT
- EXISTING MAIN DRAINAGE PIPE, PIT
- EXISTING SEWER, MAINTENANCE STRUCTURE AND PROPERTY CONNECTION
- FLL 0-300mm DEPTH
- FILL >300mm DEPTH

WARNING

BEWARE OF UNDERGROUND SERVICES

THE LOCATIONS OF UNDERGROUND SERVICES ARE APPROXIMATE ONLY AND THEIR EXACT POSITION SHOULD BE PROVEN ON SITE. NO GUARANTEE IS GIVEN THAT ALL EXISTING SERVICES ARE SHOWN. A DBYD ENQUIRY ON 1100 MUST BE MADE BY THE CONTRACTOR PRIOR TO COMMENCEMENT OF WORKS.

WARNING


ANY DESIGN SURFACE LEVELS SHOWN ARE PRELIMINARY ONLY AND SUBJECT TO FINAL DETAIL DESIGN, DO NOT USE FOR CONSTRUCTION

T.B.M. NO.	EASTING (M)	NORTHING (M)	A.H.D LEVEL (M)	DESCRIPTION	TBM DATE OF SURVEY
15	315456.08	5844216.94	238.365	STAR PICKET	Jun-19
33	315438.90	5844054.67	240.03	STAR PICKET	Jun-19
34	315339.65	5844177.04	241.355	BRASS PLAQUE (PSM)	Jun-19

PRIOR TO COMMENCEMENT OF WORKS THE CONTRACTOR IS TO ENSURE THE TBM'S USED CLOSE AGAINST AT LEAST TWO OTHER TBM'S. THE CONTRACTOR IS TO NOTIFY THE SUPERINTENDENT OF ANY TBM'S THAT HAVE BEEN DISTURBED

4	AS CONSTRUCTED	L.W.	30.06.21	DRAWN:	S.KAYA
3	CONSTRUCTION ISSUE - TGS1 ADDED	J.Z.	10.06.21	DESIGNED:	LAPAP
2	CONSTRUCTION ISSUE - MODIFIED BATTERS ON SEPERATION ST	G.R.	27.04.21	APPROVED:	G.ROMANCZ
1	CONSTRUCTION ISSUE - REVISED KERB RADIUS AND LOT LEVELS	G.R.	23.04.21		
0	CONSTRUCTION ISSUE	G.R.	15.04.21		
B	PRELIMINARY ISSUE	G.R.	05.03.21		
REV	DESCRIPTION	APPROVED	DATE		

H 1 : 500
@ A1

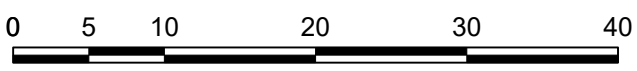

CLIENT:



verve
Ground Floor, 207-213 Waverley Road,
Malvern East VIC 3145
TEL : 03 8573 1500 verveprojects.com

COUNCIL:

HUME CITY COUNCIL

PROJECT:

MERRIFIELD LIVING - CITY WEST
STAGE 71
MICKLEHAM

TITLE:

DETAIL PLAN

ISSUE:

AS CONSTRUCTED

MELWAY REF:

366 F2

PROJECT No:

17030-71

DWG No:

RD200

REVISION:

4