

LEGEND - DETAIL PLAN


←	LOT GRADE
—	EXISTING CONTOURS
E 44.60	EXISTING SURFACE LEVEL
F 44.60	FINISHED SURFACE LEVEL
B 44.60	TOP OF BATTER LEVEL
TW 44.60	TOP OF WALL SURFACE LEVEL
BW 44.60	BOTTOM OF WALL SURFACE LEVEL
B2	KERB AND TYPE
—	PROPOSED VEHICLE CROSSING AND FOOTPATH
—	PROPOSED HEAVY DUTY VEHICLE CROSSING
R8.6	ARC RADIUS AT LIP OF KERB
CH 49.000	CHAINAGE DERIVED FROM ROAD CENTRE
—	PROPOSED FENCE
—	PROPOSED STAGE BOUNDARY
—	PROPOSED RETAINING WALL
—	BOLLARDS
—	LIMIT OF ROAD WORKS
—	STREET SIGN
—	NO ROAD SIGN
—	PERMANENT SURVEY MARK
—	PROPOSED BATTER
—	TACTILE MARKERS (TGSIs)
—	EASEMENT LINE AND TYPE
—	PROPOSED COUNCIL DRAINAGE PIT, HAUNCH, PIPE AND DIAMETER
—	PROPOSED MELBOURNE WATER OWNED MAIN DRAINAGE PIT, HAUNCH AND PIPE
—	PROPERTY INLET (EASEMENT DRAIN)
—	PROPERTY INLET (STREET DRAIN)
—	PROPERTY INLET (PART A)
—	PROPERTY INLET (PART B)
—	TABLE DRAIN
01-11	DRAINAGE PIT NUMBERS
—	PROPOSED SEWER, MAINTENANCE STRUCTURE AND PROPERTY CONNECTION
—	PROPOSED MAINTENANCE HOLE
—	PROPOSED MAINTENANCE CHAMBER
—	PROPOSED MAINTENANCE SHAFT
—	PROPOSED INSPECTION SHAFT
—	PROPOSED GAS CHECK
—	PROPOSED SEWER PIPE STUB
—	EXISTING COUNCIL DRAINAGE PIPE, PIT
—	EXISTING MAIN DRAINAGE PIPE, PIT
—	EXISTING SEWER, MAINTENANCE STRUCTURE AND PROPERTY CONNECTION
—	FILL 0-300mm DEPTH
—	FILL >300mm DEPTH
—	EXPOSED AGGREGATE INFILL REFER DRAWING 17040-54-RD112 FOR DETAILS
—	BUS STOP
33	TEMPORARY BENCH MARK AND REF. NO.
—	EXISTING TREE TO BE REMOVED

WARNING
BEWARE OF UNDERGROUND SERVICES

THE LOCATIONS OF UNDERGROUND SERVICES ARE APPROXIMATE ONLY AND THEIR EXACT POSITION SHOULD BE PROVEN ON SITE. NO GUARANTEE IS GIVEN THAT ALL EXISTING SERVICES ARE SHOWN. IT IS THE CONTRACTOR'S RESPONSIBILITY TO CONFIRM THE PHYSICAL LOCATION OF ALL EXISTING SERVICES PRIOR TO COMMENCEMENT OF ANY WORKS.

WARNING
ANY DESIGN SURFACE LEVELS SHOWN ARE PRELIMINARY ONLY AND SUBJECT TO FINAL DETAIL DESIGN, DO NOT USE FOR CONSTRUCTION

METAL MECHANICALLY FIXED TACTILE MARKERS ARE TO BE UTILISED FOR ALL TACTILE GROUND SURFACE INDICATORS (TGSIs) UNLESS NOTED OTHERWISE. TGSIs TO BE IN ACCORDANCE WITH AS/NZS 1428.4.1:2009

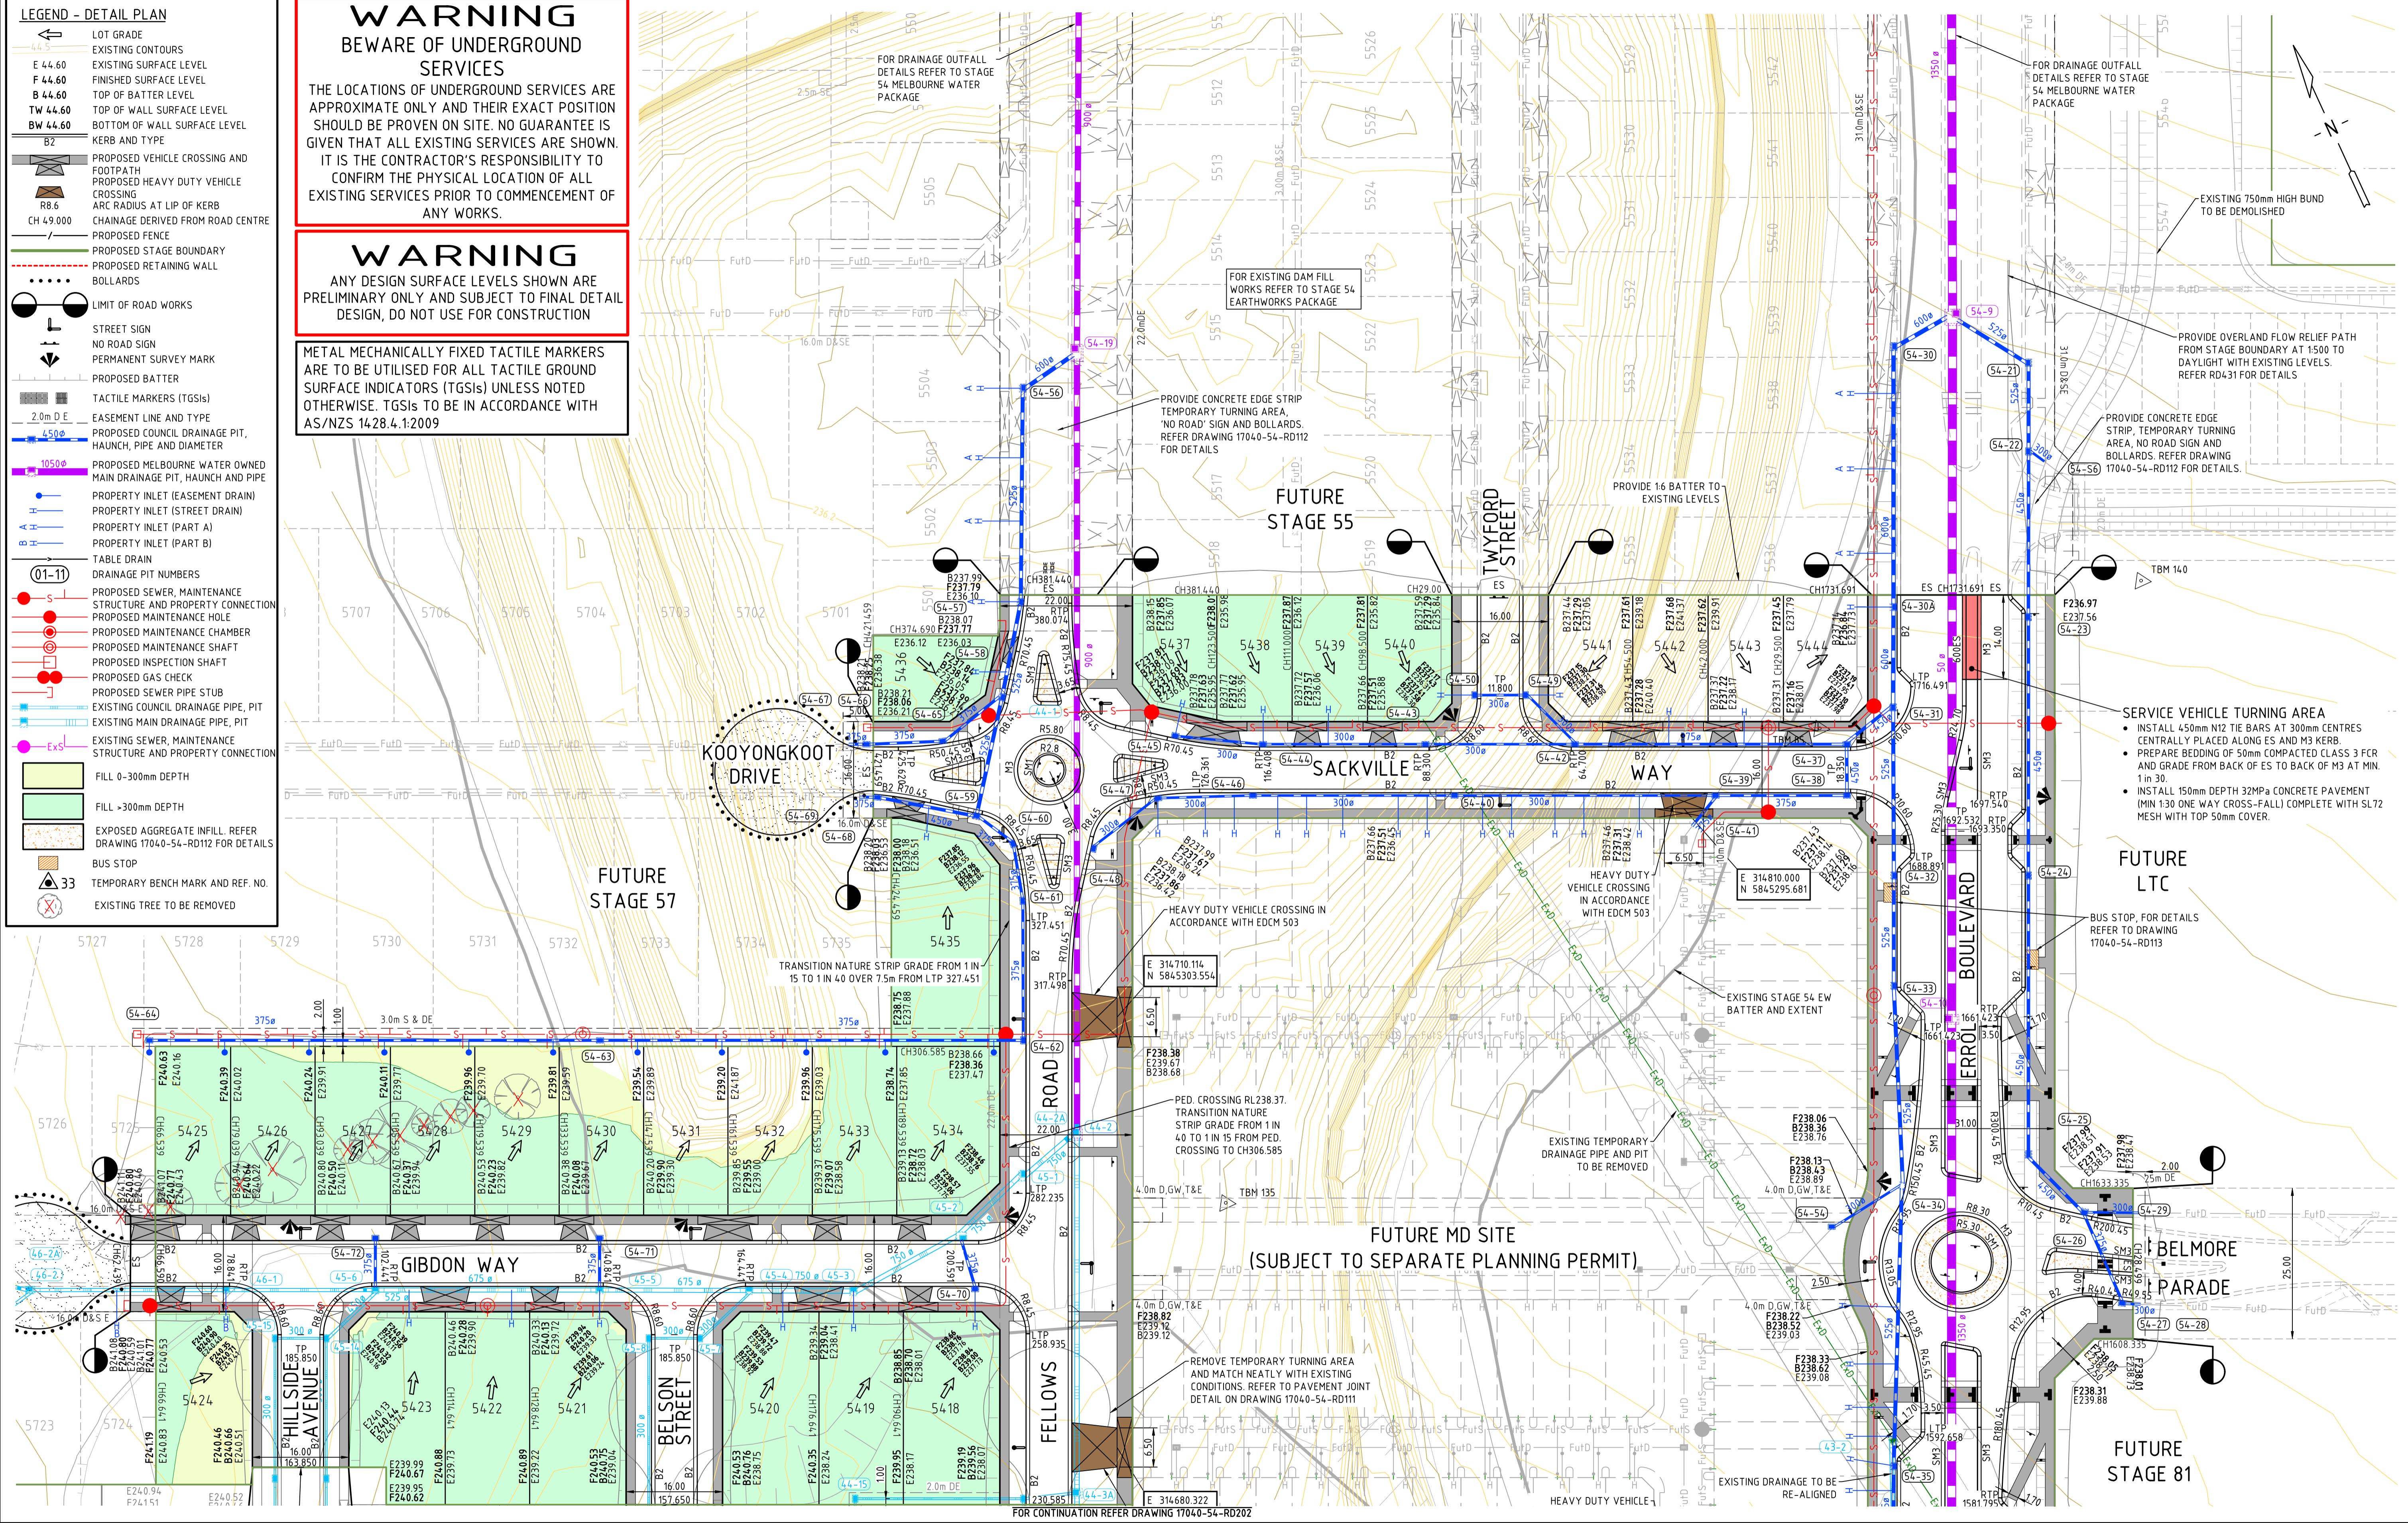

6	AS CONSTRUCTED	JJ	4.10.24
5	EASEMENT UPDATES	JJ	27.06.24
4	TGSIs UPDATED	JJ	16.04.24
3	CONSTRUCTION ISSUE	JJ	25.3.24
2	CONSTRUCTION ISSUE	JJ	15.12.23
1	COUNCIL COMMENTS	JJ	03.11.23
REV	DESCRIPTION	APPROVED	DATE

DRAWN: R.MONTGOMERY
DESIGNED: Q.PETERSON
VERIFIED: D.HUDSON
APPROVED: J.JOYCE

H 1:500 @ A1

CLIENT: **merrifield** **verve**

Ground Floor, 207-213 Waverley Road, Malvern East VIC 3145
TEL : 03 8573 1500 verveprojects.com
© Verve Projects Pty Ltd.

COUNCIL: HUME CITY COUNCIL


PROJECT: MERRIFIELD LIVING - SECTION D
STAGE 54
MICKLEHAM

TITLE: DETAIL PLAN SHEET 1

ISSUE: **AS CONSTRUCTED**

MELWAY REF: 366 F1 PROJECT No: 17040-54 DWG No: RD201 REVISION: 6

CAD FILE: F:\AS\ENERGY\1205\ENERGY\SERVERSERVICE\9512\300CT860-1D04-4F49-B1F1-477AB5B6326\17040-54-RD201-RD202.DWG
PLOT DATE: Fri Oct 4 16:33:07 2024

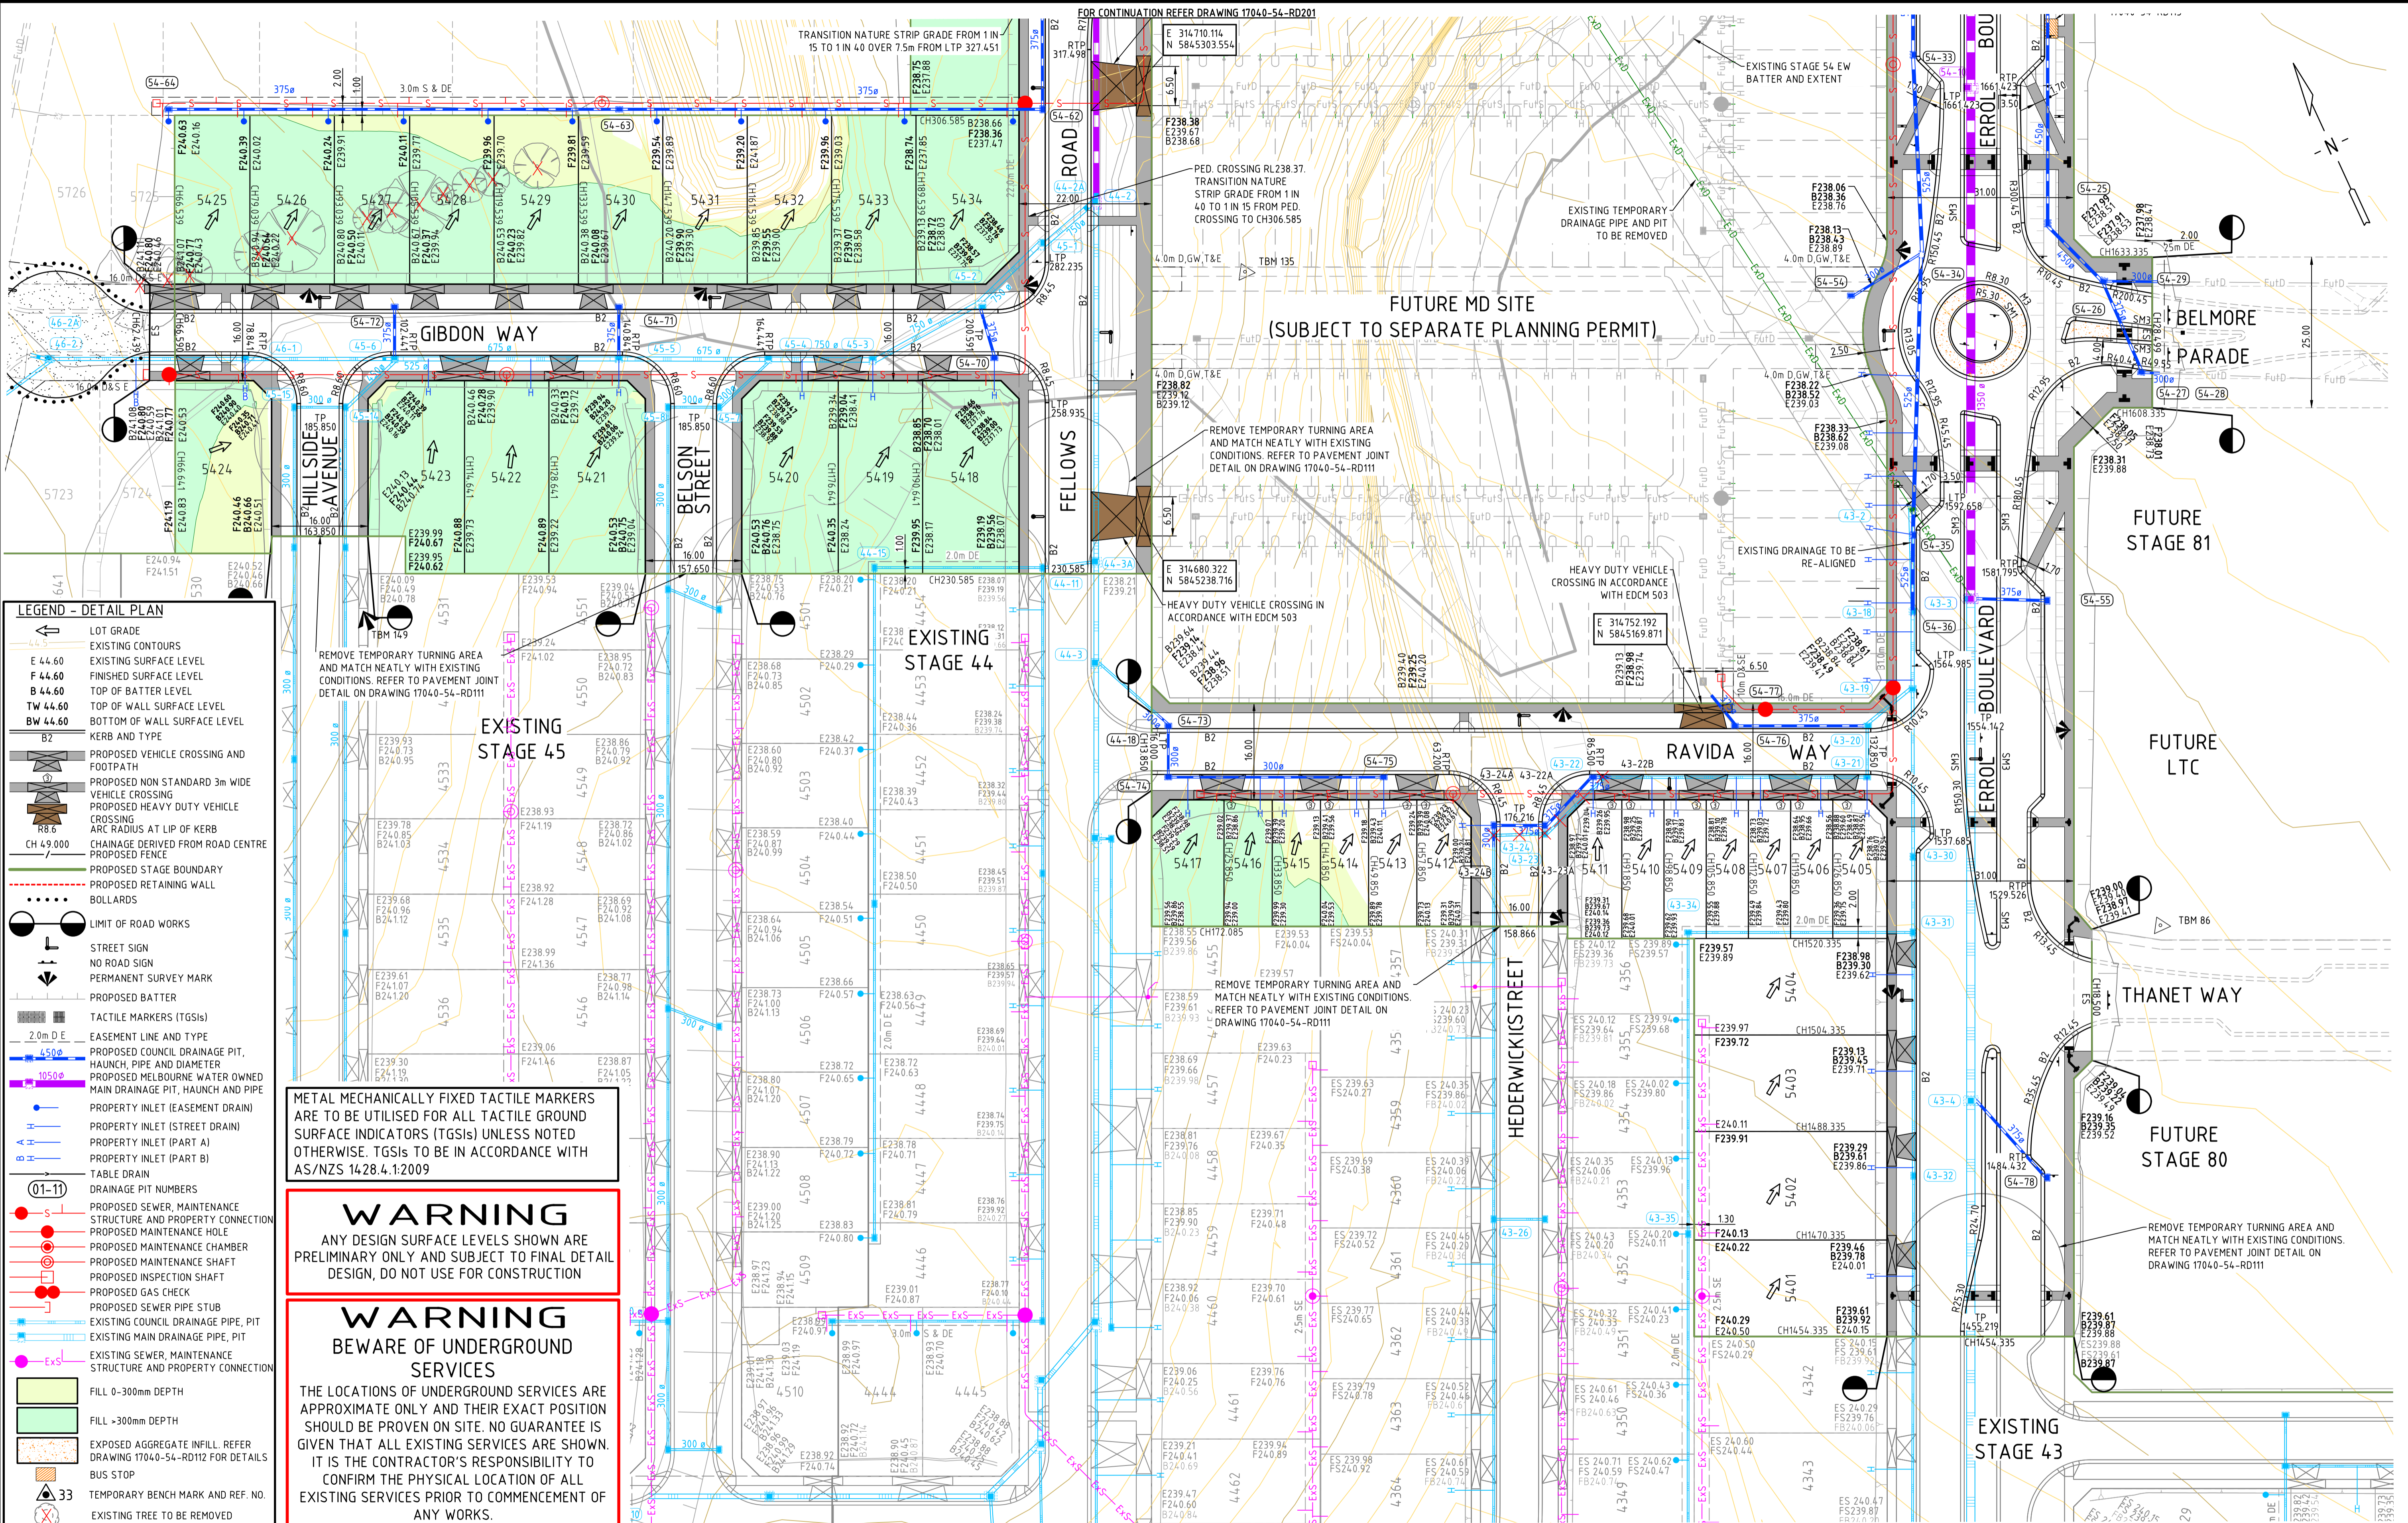

LEGEND - DETAIL PLAN


- LOT GRADE
- EXISTING CONTOURS
- EXISTING SURFACE LEVEL
- FINISHED SURFACE LEVEL
- TOP OF BATTER LEVEL
- TOP OF WALL SURFACE LEVEL
- BOTTOM OF WALL SURFACE LEVEL
- KERB AND TYPE
- PROPOSED VEHICLE CROSSING AND FOOTPATH
- PROPOSED NON STANDARD 3m WIDE VEHICLE CROSSING
- PROPOSED HEAVY DUTY VEHICLE CROSSING
- ARC RADIUS AT LIP OF KERB
- CHAINAGE DERIVED FROM ROAD CENTRE
- PROPOSED FENCE
- PROPOSED STAGE BOUNDARY
- PROPOSED RETAINING WALL
- BOLLARDS
- LIMIT OF ROAD WORKS
- STREET SIGN
- NO ROAD SIGN
- PERMANENT SURVEY MARK
- PROPOSED BATTER
- TACTILE MARKERS (TGSIs)
- EASEMENT LINE AND TYPE
- PROPOSED COUNCIL DRAINAGE PIT, HAUNCH, PIPE AND DIAMETER
- PROPOSED MELBOURNE WATER OWNED MAIN DRAINAGE PIT, HAUNCH AND PIPE
- PROPERTY INLET (EASEMENT DRAIN)
- PROPERTY INLET (STREET DRAIN)
- PROPERTY INLET (PART A)
- PROPERTY INLET (PART B)
- TABLE DRAIN
- DRAINAGE PIT NUMBERS
- PROPOSED SEWER, MAINTENANCE STRUCTURE AND PROPERTY CONNECTION
- PROPOSED MAINTENANCE HOLE
- PROPOSED MAINTENANCE CHAMBER
- PROPOSED MAINTENANCE SHAFT
- PROPOSED INSPECTION SHAFT
- PROPOSED GAS CHECK
- PROPOSED SEWER PIPE STUB
- EXISTING COUNCIL DRAINAGE PIPE, PIT
- EXISTING MAIN DRAINAGE PIPE, PIT
- EXISTING SEWER, MAINTENANCE STRUCTURE AND PROPERTY CONNECTION
- FILL 0-300mm DEPTH
- FILL >300mm DEPTH
- EXPOSED AGGREGATE INFILL. REFER DRAWING 17040-54-RD12 FOR DETAILS
- BUS STOP
- TEMPORARY BENCH MARK AND REF. NO.
- EXISTING TREE TO BE REMOVED

METAL MECHANICALLY FIXED TACTILE MARKERS ARE TO BE UTILISED FOR ALL TACTILE GROUND SURFACE INDICATORS (TGSIs) UNLESS NOTED OTHERWISE. TGSIs TO BE IN ACCORDANCE WITH AS/NZS 1428.4:1:2009

WARNING
ANY DESIGN SURFACE LEVELS SHOWN ARE PRELIMINARY ONLY AND SUBJECT TO FINAL DETAIL DESIGN, DO NOT USE FOR CONSTRUCTION

WARNING
BEWARE OF UNDERGROUND SERVICES
THE LOCATIONS OF UNDERGROUND SERVICES ARE APPROXIMATE ONLY AND THEIR EXACT POSITION SHOULD BE PROVEN ON SITE. NO GUARANTEE IS GIVEN THAT ALL EXISTING SERVICES ARE SHOWN. IT IS THE CONTRACTOR'S RESPONSIBILITY TO CONFIRM THE PHYSICAL LOCATION OF ALL EXISTING SERVICES PRIOR TO COMMENCEMENT OF ANY WORKS.

6	AS CONSTRUCTED	J.J.	4.10.24	DRAWN:	R.MONTGOMERY
5	EASEMENT UPDATES	J.J.	27.06.24	DESIGNED:	Q.PETERSON
4	TGSIs UPDATED	J.J.	16.04.24	VERIFIED:	D.HUDSON
3	CONSTRUCTION ISSUE	J.J.	25.3.24	APPROVED:	J.JOYCE
2	CONSTRUCTION ISSUE	J.J.	15.12.23		
1	COUNCIL COMMENTS	J.J.	03.11.23		
REV	DESCRIPTION	APPROVED	DATE		

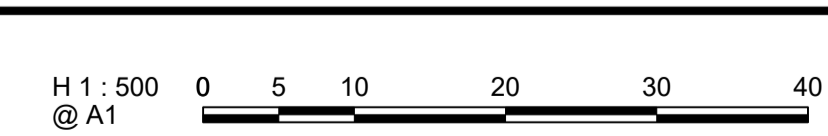

CLIENT:	merrifield
	MAB GPC
	verve
	Ground Floor, 207-213 Waverley Road, Malvern East VIC 3145
	TEL : 03 8573 1500 verveprojects.com
	© Verve Projects Pty Ltd.

COUNCIL:	HUME CITY COUNCIL
PROJECT:	MERRIFIELD LIVING - SECTION D STAGE 54 MICKLEHAM
ISSUE:	AS CONSTRUCTED
MELWAY REF:	366 F1
PROJECT No:	17040-54
DWG No:	RD202
REVISION:	6

TITLE:	DETAIL PLAN SHEET 2
--------	---------------------

SERVICE OFFSET TABLE													
STREET NAME	ROAD RESERVE WIDTH	GAS		RECYCLED WATER		DRINKING WATER		ELECTRICITY		TELCO		SEWER	
		OFFSET	SIDE	OFFSET	SIDE	OFFSET	SIDE	OFFSET	SIDE	OFFSET	SIDE	OFFSET	SIDE
GIBDON WAY	16.00m	2.05m	NORTH	2.50m	NORTH	3.00m	NORTH	2.30m	SOUTH	1.00m	NORTH	2.30m	SOUTH
HILLSIDE AVENUE	16.00m	2.00m	WEST	2.50m	WEST	3.00m	WEST	2.40m	EAST	1.85m	EAST	2.40m	SOUTH
BELSON STREET	16.00m	2.00m	WEST	2.50m	WEST	3.00m	WEST	2.50m	EAST	1.85m	EAST	2.50m	SOUTH
FELLOWS ROAD	22.00m	2.85m	EAST	3.30m	EAST	3.80m	EAST	2.70m	WEST (ADJ. LOT 5418)	2.00m	WEST (ADJ. LOT 5418)	2.30m	WEST (ADJ. LOT 5434 & 5436)
KOYONGKOOT DRIVE	16.00m	1.90m	NORTH	2.35m	NORTH	2.85m	NORTH	2.10m	SOUTH	1.00m	SOUTH	2.10m	NORTH
SACKVILLE WAY	16.00m	1.90m	SOUTH	2.35m	SOUTH	2.85m	SOUTH	2.40m	NORTH	1.85m	NORTH	2.40m	NORTH
HEDERWICK STREET	16.00m	2.10m	WEST	2.55m	WEST	3.05m	WEST	2.60m	EAST	1.85m	EAST	2.60m	EAST
TWYFORD STREET	16.00m	2.10m	EAST	2.55m	EAST	3.05m	EAST	2.60m	WEST	1.85m	WEST	2.60m	WEST
ERROL BOULEVARD	31.00m	2.05m	WEST	2.50m	WEST	3.00m	WEST	3.35m	EAST	2.85m	EAST	3.35m	WEST (NORTH OF RAVIDA WAY)
THANET WAY	20.00m	1.90m	SOUTH	2.35m	SOUTH	2.85m	SOUTH	2.60m	NORTH	1.85m	NORTH	2.60m	NORTH
BELMORE PARADE	25.00m	1.90m	NORTH	2.35m	NORTH	2.85m	NORTH	3.80m	SOUTH	2.85m	SOUTH	3.80m	SOUTH
RAVIDA WAY	16.00m	2.00m	NORTH	2.50m	NORTH	3.00m	NORTH	2.50m	SOUTH	1.85m	SOUTH	2.50m	NORTH (OPPOSITE LOTS 5405-5408)


NOTE: OFFSETS FOR ELECTRICITY AND TELCO ARE INDICATIVE ONLY. REFER TO APPROVED ELECTRICAL AND TELCO PLANS FOR FINAL INSTALLATION OFFSETS.

LEGEND - SERVICES PLAN

- LOT GRADE
- KERB
- PROPOSED VEHICLE CROSSING AND FOOTPATH
- PROPOSED STAGE BOUNDARY
- PROPOSED RETAINING WALL
- BOLLARDS
- LIMIT OF ROAD WORKS
- EASEMENT LINE AND TYPE
- PROPOSED GAS
- PROPOSED NON-DRINKING WATER
- PROPOSED DRINKING WATER
- PROPOSED ELECTRICITY
- PROPOSED TELCO
- PROPOSED GAS AND WATER CONDUIT
- PROPOSED GAS CONDUIT
- PROPOSED WATER CONDUIT
- PROPOSED COUNCIL DRAINAGE PIT AND DRAINAGE PIPE
- PROPOSED MELBOURNE WATER OWNED MAIN DRAINAGE PIT AND HAUNCH
- PROPERTY INLET (EASEMENT DRAIN)
- PROPERTY INLET (STREET DRAIN)
- PROPERTY INLET (PART A). CHAINAGES SHOWN ARE FROM DOWNSTREAM DRAINAGE PIT
- PROPERTY INLET (PART B)
- TABLE DRAIN
- PROPOSED SEWER, MAINTENANCE STRUCTURE AND PROPERTY CONNECTION
- PROPOSED MAINTENANCE HOLE
- PROPOSED MAINTENANCE CHAMBER
- PROPOSED MAINTENANCE SHAFT
- PROPOSED INSPECTION SHAFT
- PROPOSED GAS CHECK
- PROPOSED SEWER PIPE STUB
- EXISTING GAS
- EXISTING NON-DRINKING WATER
- EXISTING DRINKING WATER
- EXISTING ELECTRICITY
- EXISTING TELCO
- EXISTING OVERHEAD ELECTRICITY
- EXISTING OPTIC FIBRE
- EXISTING GAS AND WATER CONDUIT
- EXISTING TEMPORARY DRAINAGE PIPE AND PIT TO BE REMOVED

WARNING
BEWARE OF UNDERGROUND SERVICES

THE LOCATIONS OF UNDERGROUND SERVICES ARE APPROXIMATE ONLY AND THEIR EXACT POSITION SHOULD BE PROVEN ON SITE. NO GUARANTEE IS GIVEN THAT ALL EXISTING SERVICES ARE SHOWN. IT IS THE CONTRACTOR'S RESPONSIBILITY TO CONFIRM THE PHYSICAL LOCATION OF ALL EXISTING SERVICES PRIOR TO COMMENCEMENT OF ANY WORKS.

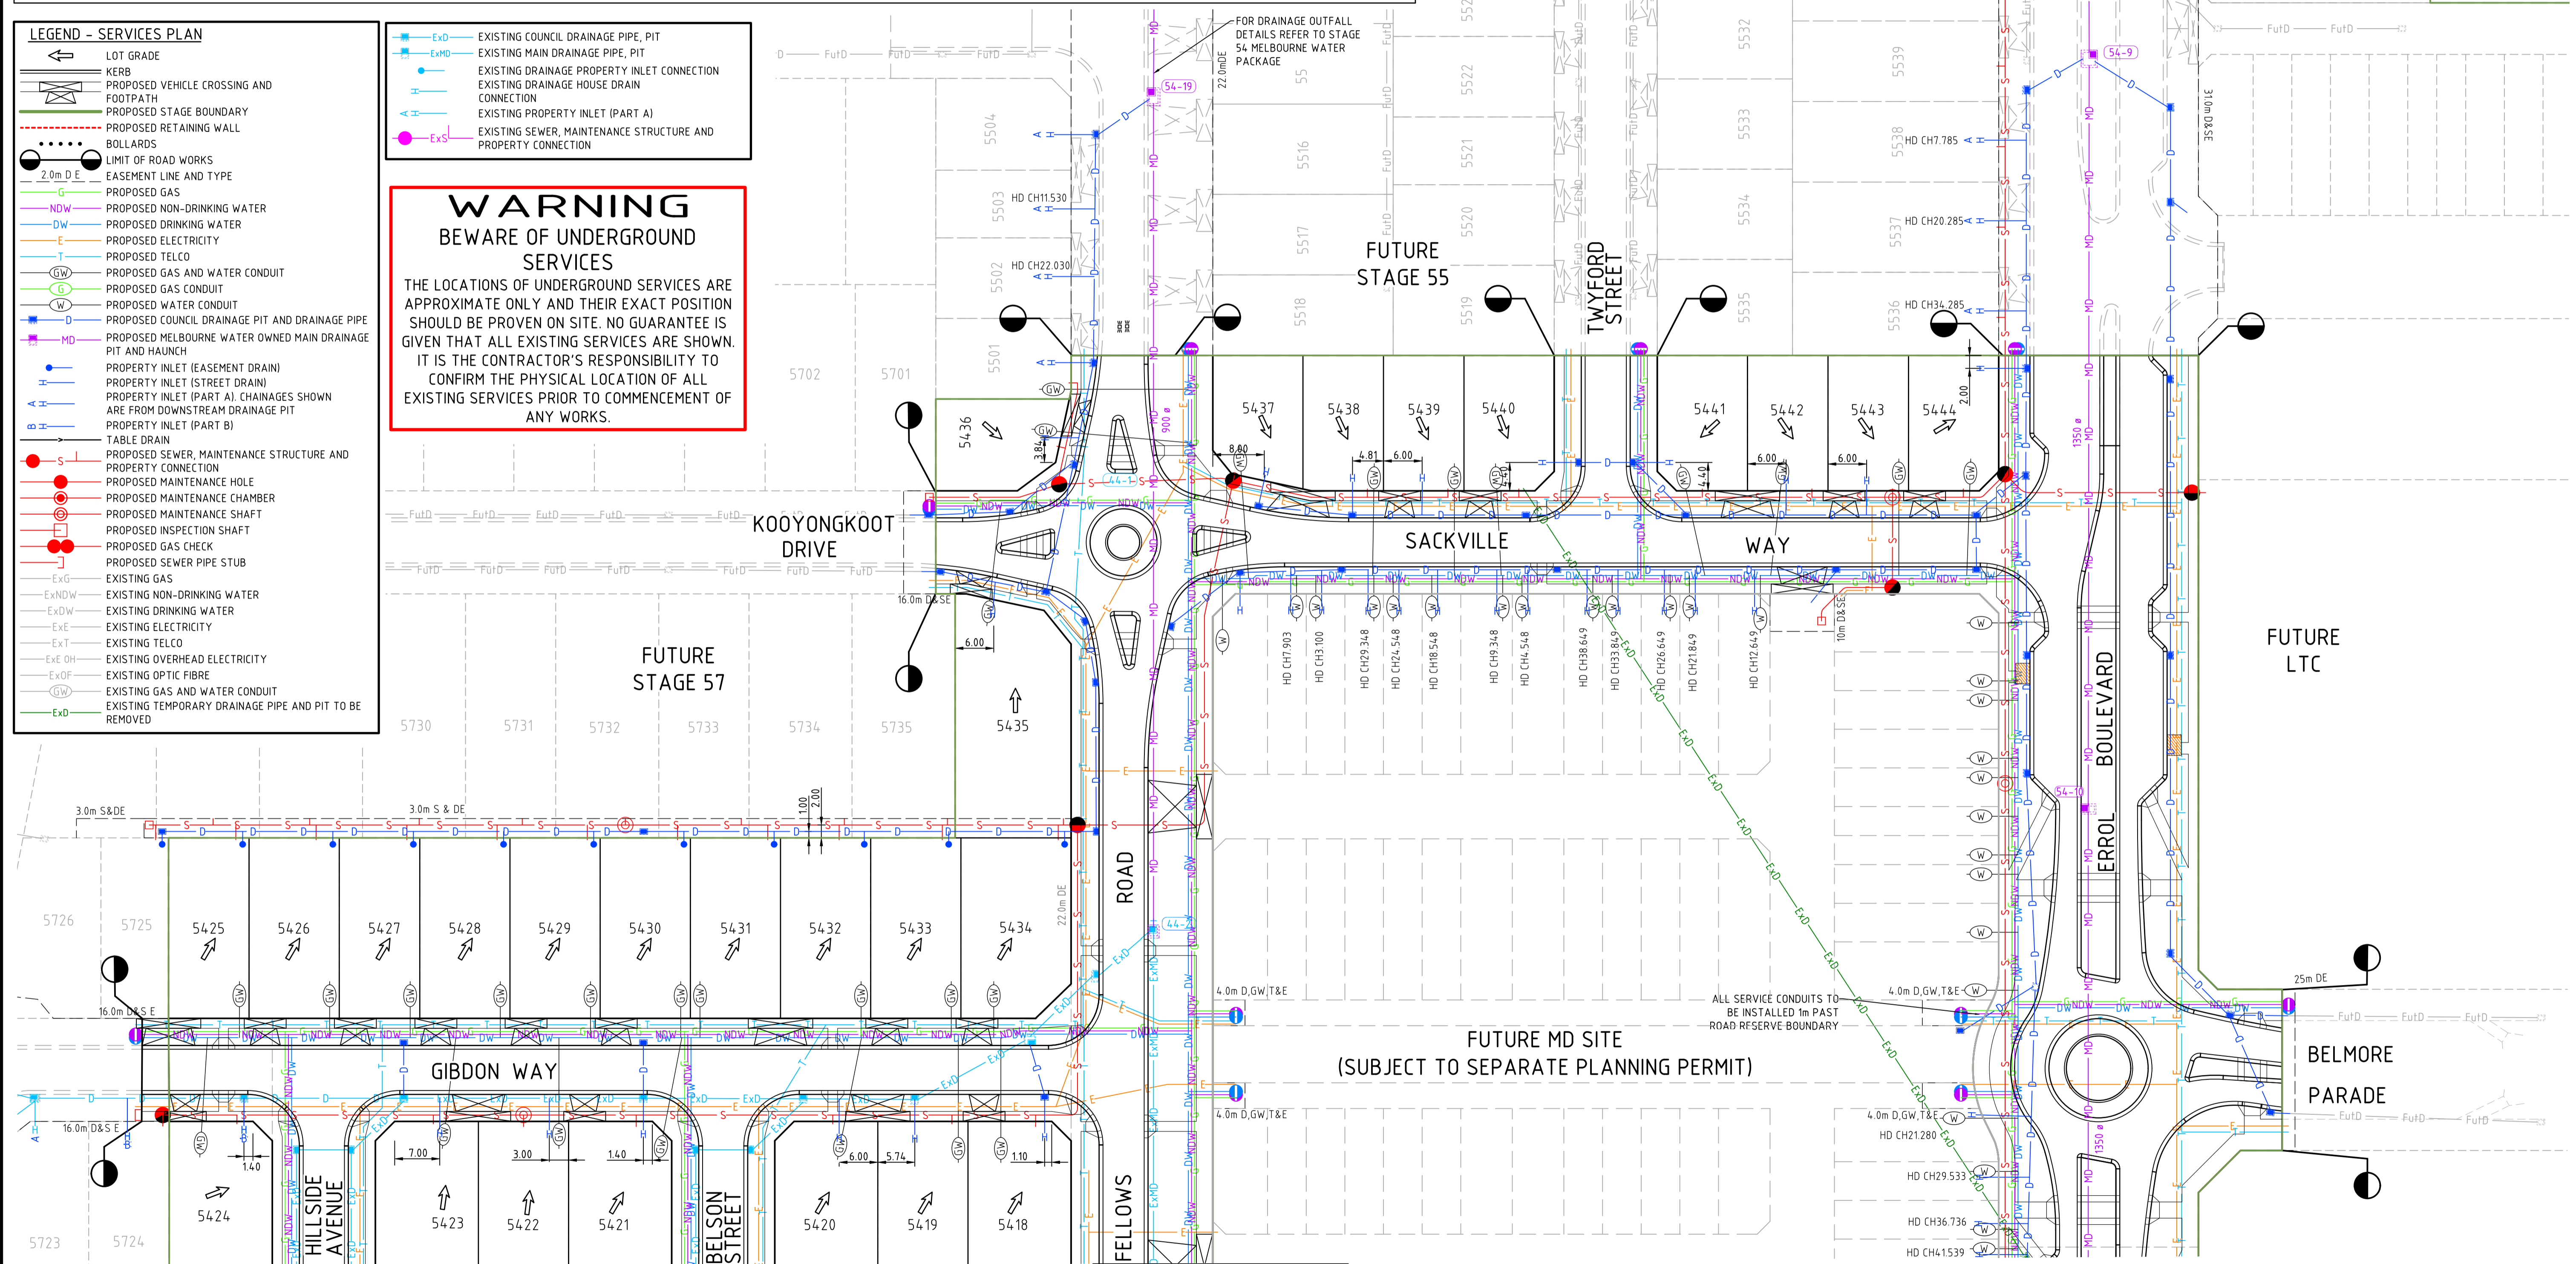

6	AS CONSTRUCTED	J.J.	4.10.24	DRAWN:	R.MONTGOMERY
5	EASEMENT UPDATES	J.J.	27.06.24	DESIGNED:	Q.PETERSON
4	CONSTRUCTION ISSUE	J.J.	03.05.24	VERIFIED:	D.HUDSON
3	CONSTRUCTION ISSUE	J.J.	25.3.24	APPROVED:	J.JOYCE
2	CONSTRUCTION ISSUE	J.J.	15.12.23		
1	COUNCIL COMMENTS	J.J.	03.11.23		
REV	DESCRIPTION	APPROVED	DATE		

H 1 : 500 @ A1

NOTES:
1. CHAINAGES SHOWN FOR HOUSE DRAINS IN FUTURE LOTS ARE TAKEN FROM CENTRE OF DOWNSTREAM PIT TO HOUSE DRAIN, DENOTED HD CH
2. COORDINATES PROVIDED AT ROAD RESERVE BOUNDARY FOR ROAD CROSSING CONDUITS SERVICING FUTURE LOTS.

CLIENT: **merrifield** **MAB** **gpc**

verve
Ground Floor, 207-213 Waverley Road, Malvern East VIC 3145
TEL : 03 8573 1500 verveprojects.com
© Verve Projects Pty Ltd.

COUNCIL: HUME CITY COUNCIL


PROJECT: MERRIFIELD LIVING - SECTION D STAGE 54 MICKLEHAM

TITLE: SERVICES PLAN SHEET 1

ISSUE: **AS CONSTRUCTED**

MELWAY REF: 366 F1 PROJECT No: 17040-54 DWG No: RD301 REVISION: 6

CAD FILE: F:\SYNERGY\TEMP\17040-54\RD301-AS CONSTRUCTED.DWG
PLOT DATE: Fri Oct 4 11:07:16 2024

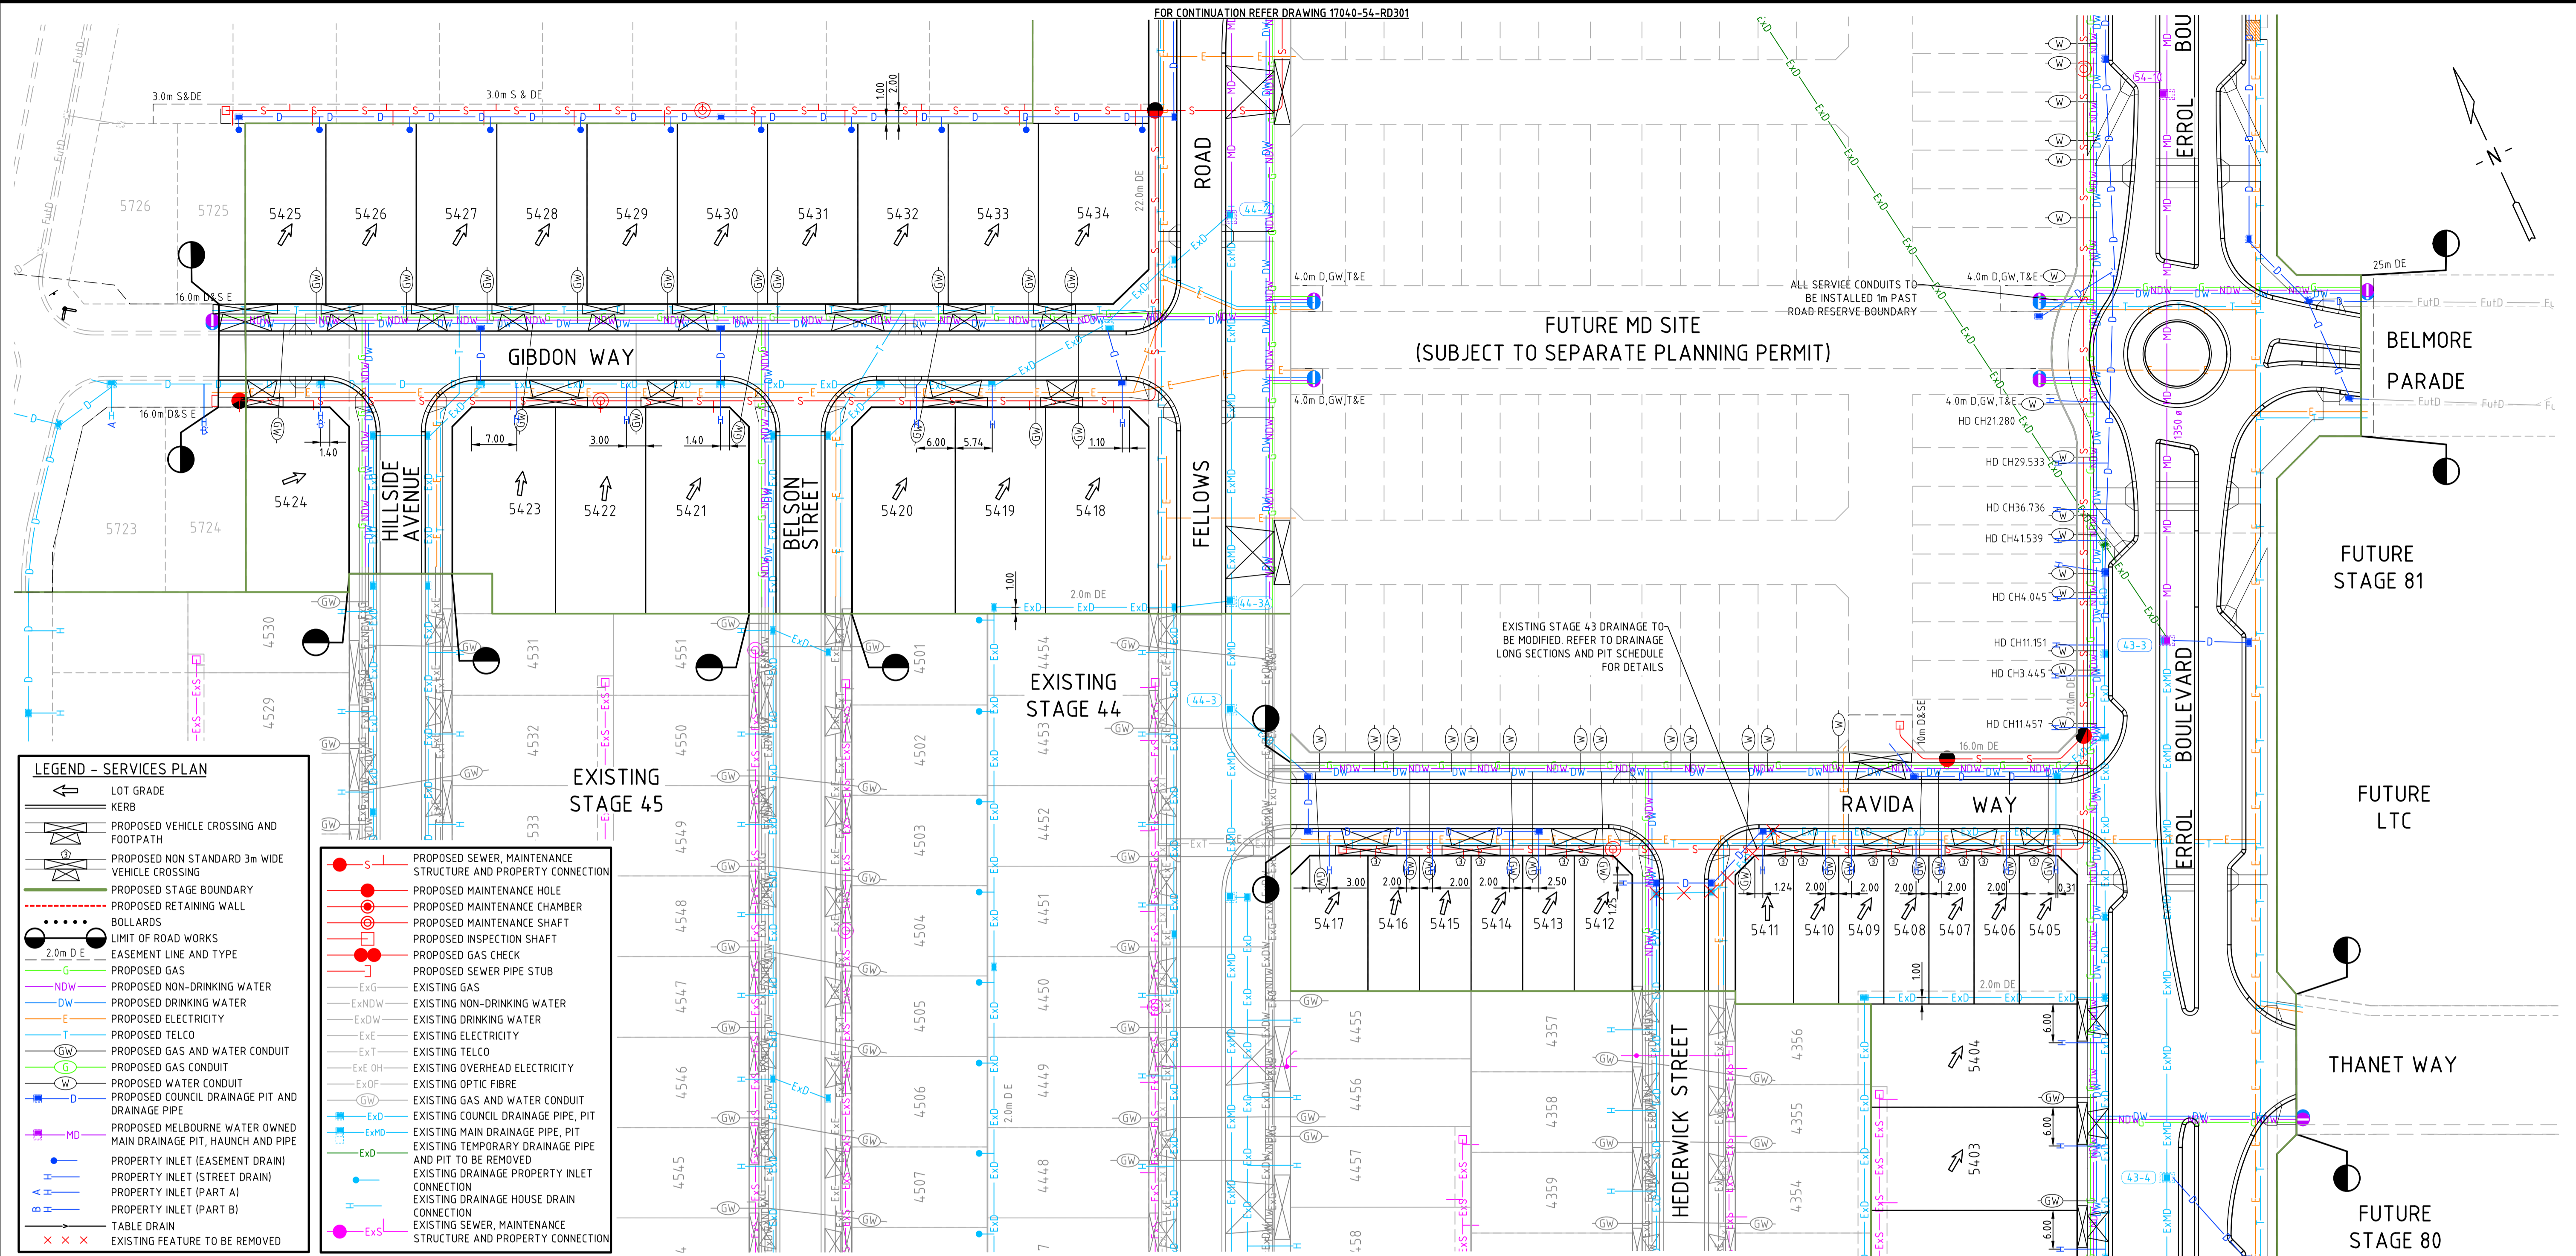

LEGEND - SERVICES PLAN

- LOT GRADE
- KERB
- PROPOSED VEHICLE CROSSING AND FOOTPATH
- PROPOSED NON STANDARD 3m WIDE VEHICLE CROSSING
- PROPOSED STAGE BOUNDARY
- PROPOSED RETAINING WALL
- BOLLARDS
- LIMIT OF ROAD WORKS
- EASEMENT LINE AND TYPE
- PROPOSED GAS
- PROPOSED NON-DRINKING WATER
- PROPOSED DRINKING WATER
- PROPOSED ELECTRICITY
- PROPOSED TELCO
- PROPOSED GAS AND WATER CONDUIT
- PROPOSED WATER CONDUIT
- PROPOSED GAS CONDUIT
- PROPOSED WATER CONDUIT
- PROPOSED COUNCIL DRAINAGE PIT AND DRAINAGE PIPE
- PROPOSED MELBOURNE WATER OWNED MAIN DRAINAGE PIT, HAUNCH AND PIPE
- PROPERTY INLET (EASEMENT DRAIN)
- PROPERTY INLET (STREET DRAIN)
- PROPERTY INLET (PART A)
- PROPERTY INLET (PART B)
- TABLE DRAIN
- EXISTING FEATURE TO BE REMOVED

- PROPOSED SEWER, MAINTENANCE STRUCTURE AND PROPERTY CONNECTION
- PROPOSED MAINTENANCE HOLE
- PROPOSED MAINTENANCE CHAMBER
- PROPOSED MAINTENANCE SHAFT
- PROPOSED INSPECTION SHAFT
- PROPOSED GAS CHECK
- PROPOSED SEWER PIPE STUB
- EXISTING GAS
- EXISTING NON-DRINKING WATER
- EXISTING DRINKING WATER
- EXISTING ELECTRICITY
- EXISTING TELCO
- EXISTING OVERHEAD ELECTRICITY
- EXISTING OPTIC FIBRE
- EXISTING GAS AND WATER CONDUIT
- EXISTING COUNCIL DRAINAGE PIPE, PIT
- EXISTING MAIN DRAINAGE PIPE, PIT
- EXISTING TEMPORARY DRAINAGE PIPE AND PIT TO BE REMOVED
- EXISTING DRAINAGE PROPERTY INLET CONNECTION
- EXISTING DRAINAGE HOUSE DRAIN CONNECTION
- EXISTING SEWER, MAINTENANCE STRUCTURE AND PROPERTY CONNECTION

SERVICE OFFSET TABLE


STREET NAME	ROAD RESERVE WIDTH	GAS		RECYCLED WATER		DRINKING WATER		ELECTRICITY		TELCO		SEWER	
		OFFSET	SIDE	OFFSET	SIDE	OFFSET	SIDE	OFFSET	SIDE	OFFSET	SIDE	OFFSET	SIDE
GIBDON WAY	16.00m	2.05m	NORTH	2.50m	NORTH	3.00m	WEST	2.40m	EAST	1.00m	NORTH	1.00m	SOUTH
HILLSIDE AVENUE	16.00m	2.00m	WEST	2.50m	WEST	3.00m	WEST	2.40m	EAST	1.85m	EAST		
BELSON STREET	16.00m	2.00m	WEST	2.50m	WEST	3.00m	WEST	2.50m	EAST	1.85m	EAST		
FELLOWS ROAD	22.00m	2.85m	EAST	3.30m	EAST	3.80m	EAST	2.70m 2.30m 4.60m	WEST (ADJ. LOT 5418) WEST (ADJ. LOTS 5434-3435) EAST (NORTH OF SACKVILLE WAY)	2.00m 1.85m 2.00m	WEST (ADJ. LOT 5418) WEST (ADJ. LOTS 5434-3435) WEST (NORTH OF SACKVILLE WAY)	1.00m 1.30m	WEST (ADJ. LOT 5434 & 5436) EAST (ADJ. FUTURE MD SITE)
KOYOONKOOT DRIVE	16.00m	1.90m	NORTH	2.35m	NORTH	2.85m	NORTH	2.10m	SOUTH	1.00m	SOUTH	1.00m	NORTH
SACKVILLE WAY	16.00m	1.90m	SOUTH	2.35m	SOUTH	2.85m	SOUTH	2.40m	NORTH	1.85m	NORTH	1.00m	SOUTH (OPPOSITE LOTS 5437, 5438, 5443)
HEDERWICK STREET	16.00m	2.10m	WEST	2.55m	WEST	3.05m	WEST	2.60m	EAST	1.85m	EAST		
TWYFORD STREET	16.00m	2.10m	EAST	2.55m	EAST	3.05m	EAST	2.60m	WEST	1.85m	WEST		
ERROL BOULEVARD	31.00m	2.05m	WEST	2.50m	WEST	3.00m	WEST	3.35m	EAST	2.85m	EAST	1.00m	WEST (NORTH OF RAVIDA WAY)
THANET WAY	20.00m	1.90m	SOUTH	2.35m	SOUTH	2.85m	SOUTH	2.60m	NORTH	1.85m	NORTH		
BELMORE PARADE	25.00m	1.90m	NORTH	2.35m	NORTH	2.85m	NORTH	3.80m	SOUTH	2.85m	SOUTH		
RAVIDA WAY	16.00m	2.00m	NORTH	2.50m	NORTH	3.00m	NORTH	2.50m	SOUTH	1.85m	SOUTH	1.00m	NORTH (OPPOSITE LOTS 5405-5408) SOUTH

NOTE: OFFSETS FOR ELECTRICITY AND TELCO ARE INDICATIVE ONLY. REFER TO APPROVED ELECTRICAL AND TELCO PLANS FOR FINAL INSTALLATION OFFSETS.

WARNING
BEWARE OF UNDERGROUND SERVICES

THE LOCATIONS OF UNDERGROUND SERVICES ARE APPROXIMATE ONLY AND THEIR EXACT POSITION SHOULD BE PROVEN ON SITE. NO GUARANTEE IS GIVEN THAT ALL EXISTING SERVICES ARE SHOWN. IT IS THE CONTRACTOR'S RESPONSIBILITY TO CONFIRM THE PHYSICAL LOCATION OF ALL EXISTING SERVICES PRIOR TO COMMENCEMENT OF ANY WORKS.

6	AS CONSTRUCTED	J.J.	4.10.24	DRAWN:	R.MONTGOMERY
5	EASEMENT UPDATES	J.J.	27.06.24	DESIGNED:	Q.PETERSON
4	CONSTRUCTION ISSUE	J.J.	03.05.24	VERIFIED:	D.HUDSON
3	CONSTRUCTION ISSUE	J.J.	25.3.24	APPROVED:	J.JOYCE
2	CONSTRUCTION ISSUE	J.J.	15.12.23		
1	COUNCIL COMMENTS	J.J.	03.11.23		
REV	DESCRIPTION	APPROVED	DATE		

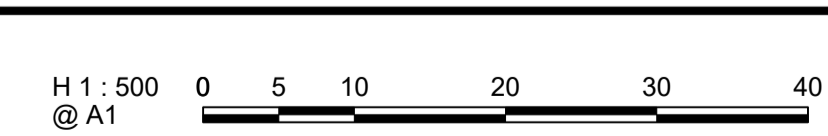

CLIENT:

merrifield

MAB GPC

verve

Ground Floor, 207-213 Waverley Road,
Malvern East VIC 3145
TEL : 03 8573 1500 verveprojects.com
© Verve Projects Pty Ltd.

COUNCIL: HUME CITY COUNCIL

PROJECT: MERRIFIELD LIVING - SECTION D
STAGE 54
MICKLEHAM

TITLE: SERVICES PLAN
SHEET 2

ISSUE: **AS CONSTRUCTED**

MELWAY REF: 366 F1

PROJECT No: 17040-54

DWG No: RD302

REVISION: 6

CAD FILE: F:\SYNERGY\TEMP\17040-54\RD302.DWG
 PLOT DATE: Fri Oct 4 11:07:33 2024
 F:\SYNERGY\TEMP\17040-54\RD302.DWG
 F:\SYNERGY\TEMP\17040-54\RD302.DWG
 F:\SYNERGY\TEMP\17040-54\RD302.DWG