


CAD FILE: F:\SYNERGY\TEMP\120SYNERGY\SERVICES\17040-55-RD301.DWG
PLOT DATE: Mon Feb 3 22:03:30 2025

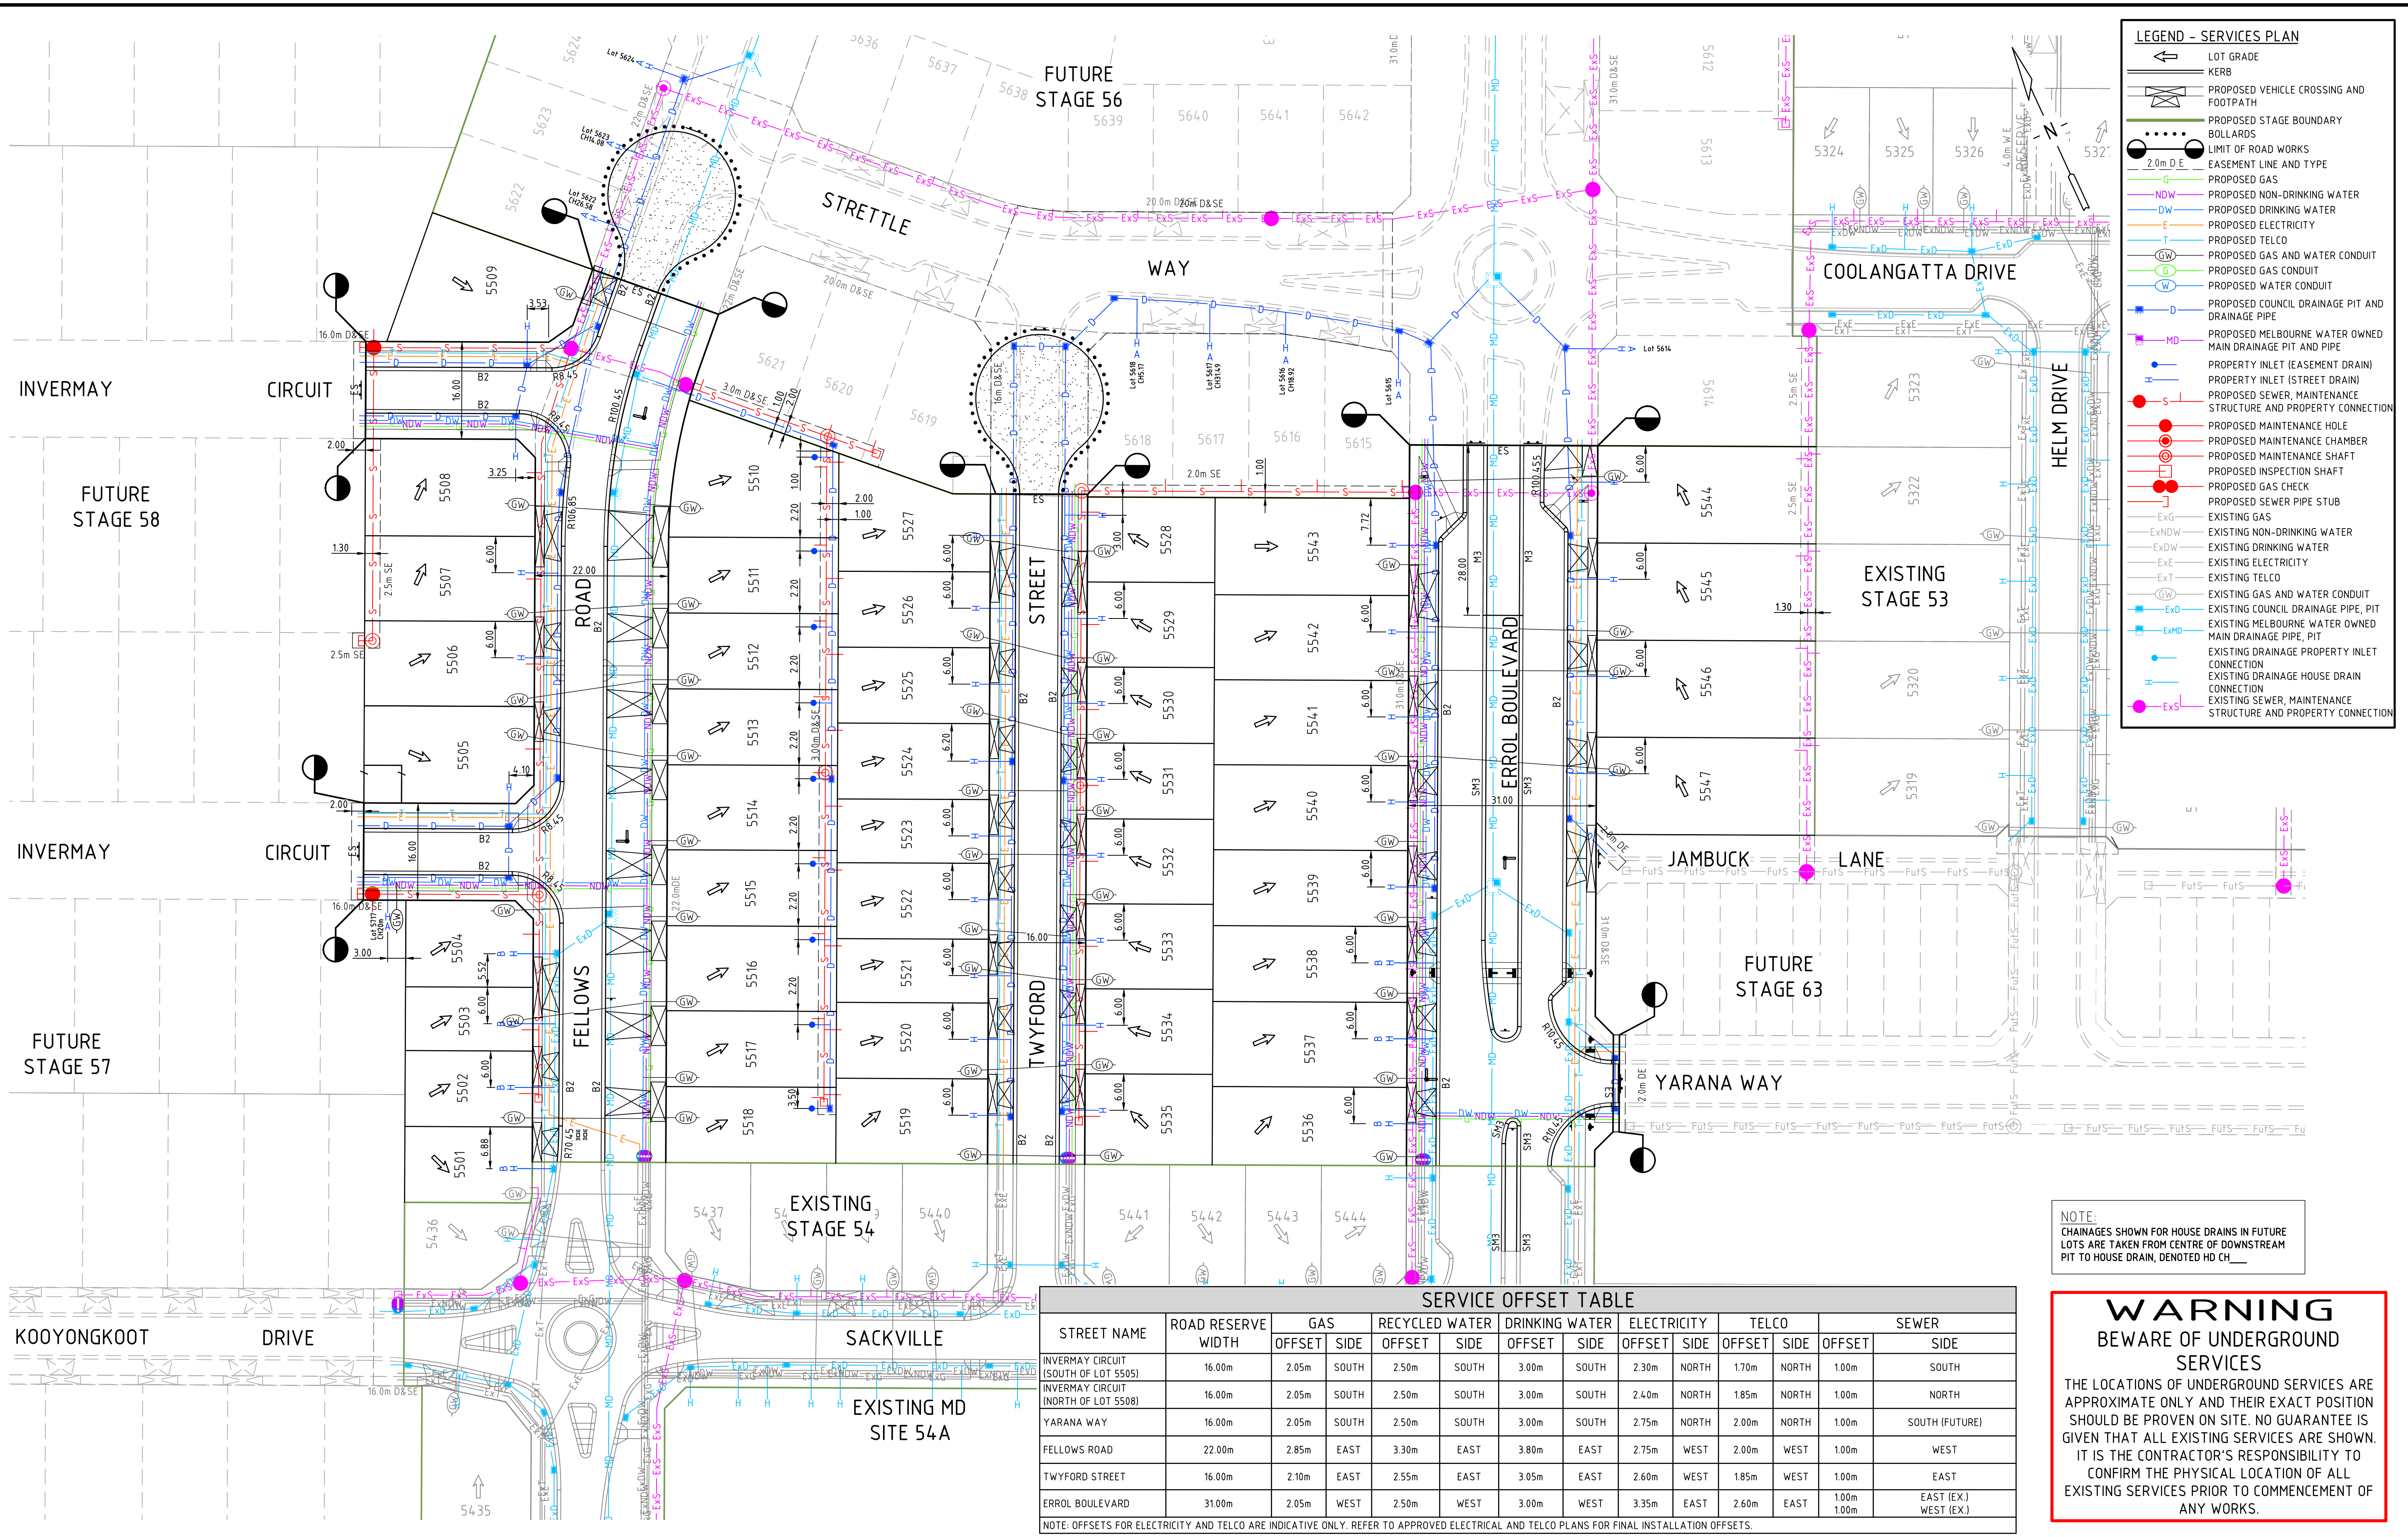

NOTE:
CHAINAGES SHOWN FOR HOUSE DRAINS IN FUTURE LOTS ARE TAKEN FROM CENTRE OF DOWNSTREAM PIT TO HOUSE DRAIN, DENOTED HD CH.

WARNING
BEWARE OF UNDERGROUND SERVICES
THE LOCATIONS OF UNDERGROUND SERVICES ARE APPROXIMATE ONLY AND THEIR EXACT POSITION SHOULD BE PROVEN ON SITE. NO GUARANTEE IS GIVEN THAT ALL EXISTING SERVICES ARE SHOWN. IT IS THE CONTRACTOR'S RESPONSIBILITY TO CONFIRM THE PHYSICAL LOCATION OF ALL EXISTING SERVICES PRIOR TO COMMENCEMENT OF ANY WORKS.

				DRAWN: R.MONTGOMERY
4	AS CONSTRUCTED	M.T	04.02.25	
3	ELEC AND TELCO OFFSETS & EASEMENT UPDATES	J.J	28.02.24	DESIGNED: A.ARABO
2	LOT 5521 GW CONDUIT MOVED	J.J	18.11.23	VERIFIED: S.BUGOSS
1	COUNCIL COMMENTS	J.J	14.11.23	
0	CONSTRUCTION ISSUE	J.J	27.09.23	APPROVED: J.JOYCE
REV	DESCRIPTION	APPROVED	DATE	



CLIENT:
merrifield
MAB gpc
Ground Floor, 207-213 Waverley Road,
Malvern East VIC 3145
TEL : 03 8573 1500 verveprojects.com
© Verve Projects Pty Ltd.

COUNCIL: HUME CITY COUNCIL	TITLE: SERVICES PLAN
PROJECT: MERRIFIELD LIVING - SECTION D STAGE 55 MICKLEHAM	
ISSUE: AS CONSTRUCTED	
MELWAY REF: 366 D1	PROJECT No: 17040-55
DWG No: RD301	REVISION: 4