



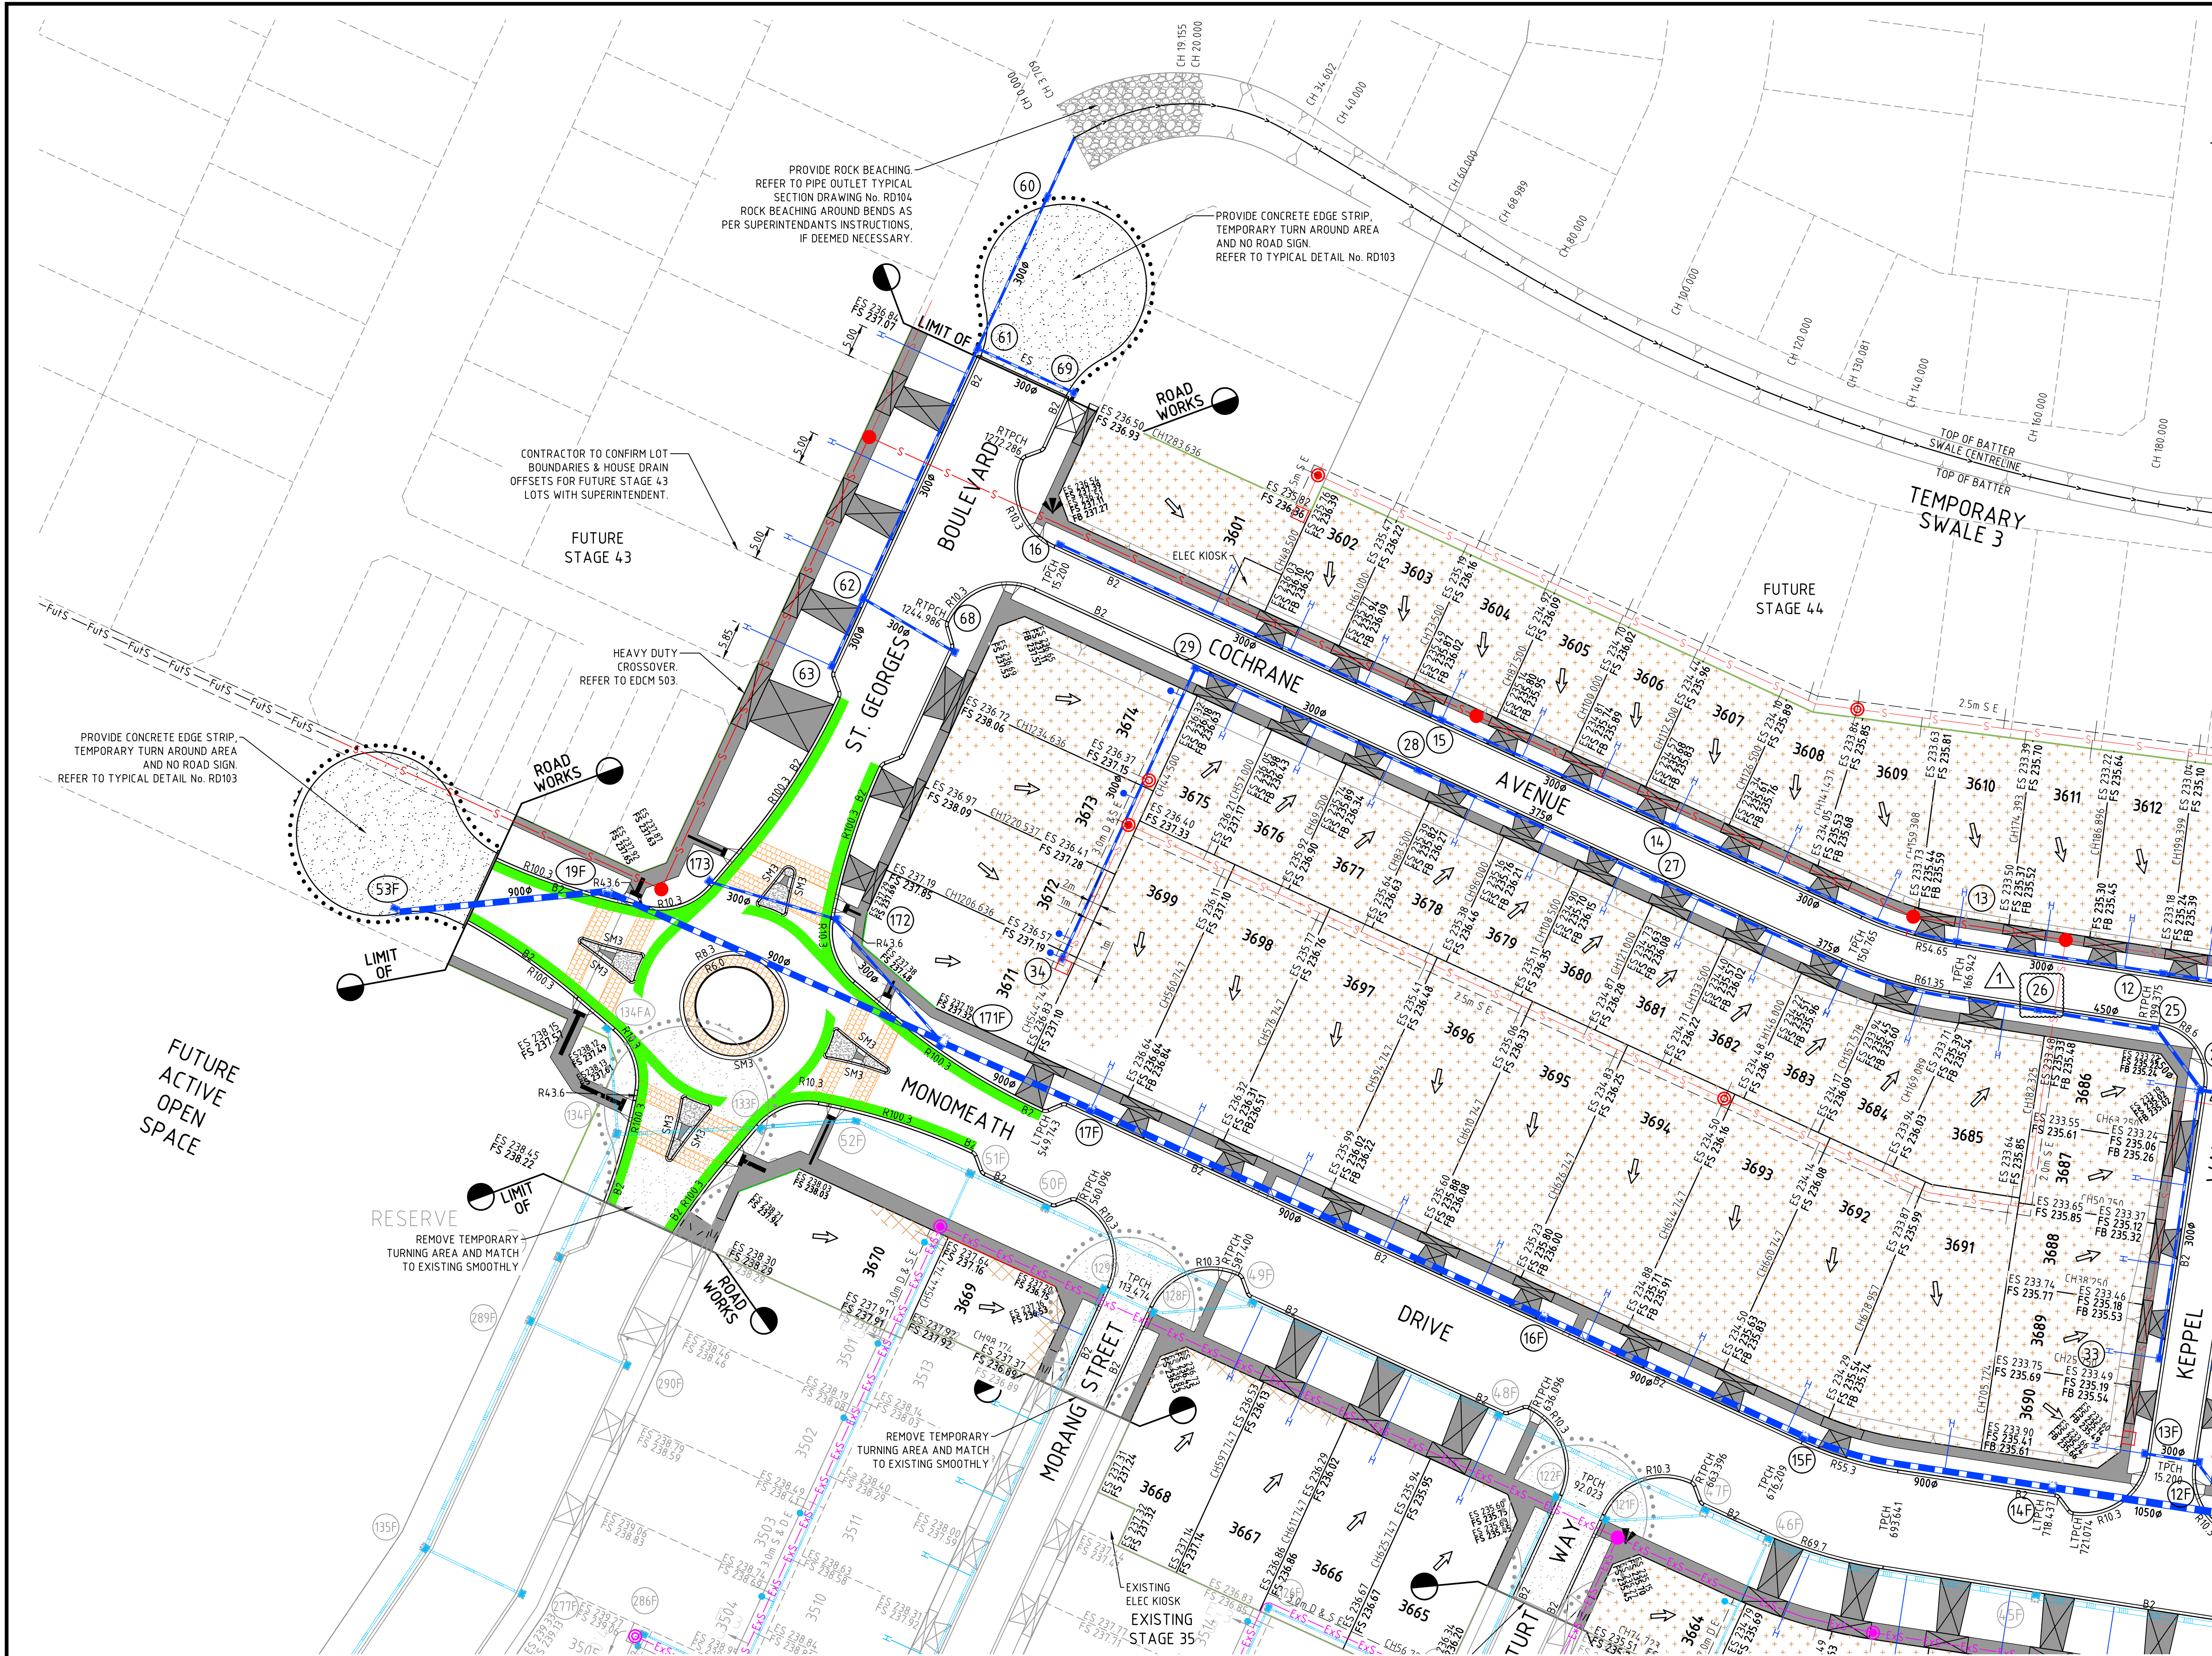

LEGEND - DETAIL

- ES44.26 LOT GRADE
- FS44.60 EXISTING SURFACE LEVEL
- FB44.60 FINISHED SURFACE LEVEL
- TOP OF BATTER
- PERMANENT SURVEY MARK
- TEMPORARY BENCH MARK
- REMOVE EX TREE
- PROPOSED DRAINAGE
- EXISTING DRAINAGE
- TABLE DRAIN
- PROPERTY INLET
- HOUSE DRAIN
- SWD PIT NUMBERS
- EXISTING SEWER
- PROPOSED SEWER
- CUT >150mm DEPTH
- FILL >300mm DEPTH
- ROUNDABOUT THRESHOLD TREATMENT
- G15 EMERALD (AS2700 S1996) OR VICROADS APPROVED EQUIVALENT AS PER VICROADS CYCLE NTE No.14 2005)

FOR CONTINUATION OF PLAN REFER DRAWING RD201

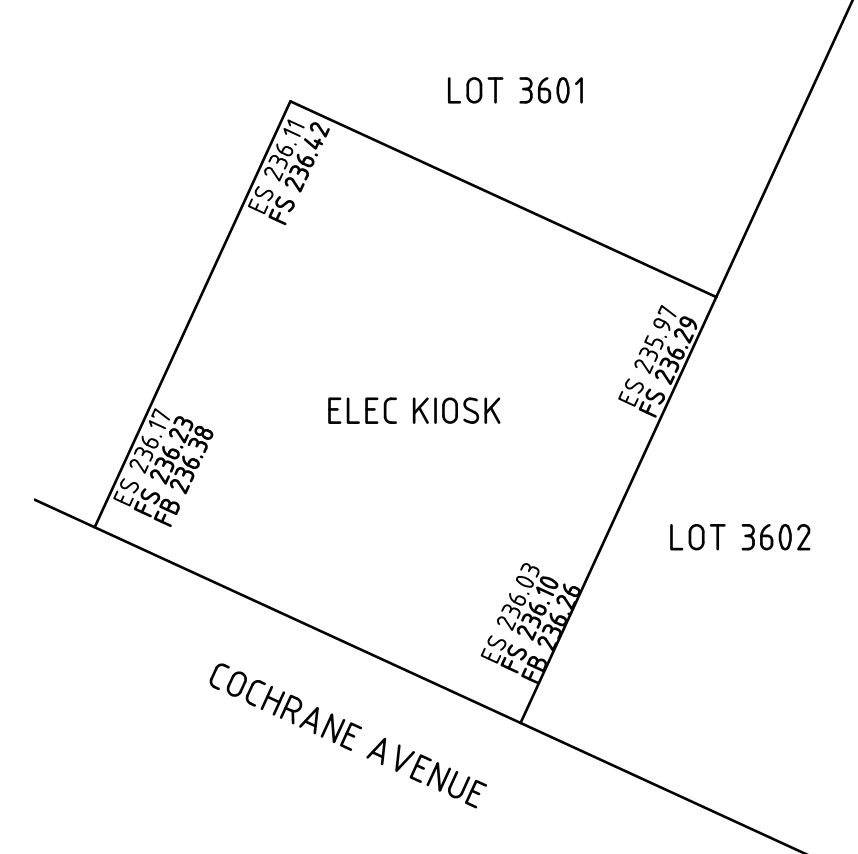

ELEC KIOSK LEVELS



WARNING


BEWARE OF UNDERGROUND SERVICES

THE LOCATIONS OF UNDERGROUND SERVICES ARE APPROXIMATE ONLY AND THEIR EXACT POSITION SHOULD BE PROVEN ON SITE. NO GUARANTEE IS GIVEN THAT ALL EXISTING SERVICES ARE SHOWN. A DBYD ENQUIRY ON 1100 MUST BE MADE BY THE CONTRACTOR PRIOR TO COMMENCEMENT OF WORKS.

WARNING

ANY DESIGN SURFACE LEVELS SHOWN ARE PRELIMINARY ONLY AND SUBJECT TO FINAL DETAIL DESIGN, DO NOT USE FOR CONSTRUCTION

DRAWN:		P.CAMILLERI	
DESIGNED:		LAPAP	
APPROVED:		G.ROMANCZ	
1	PIT 26 LOCATION REVISED	G.R	01.05.18
0	FOR CONSTRUCTION	G.R	27.03.18
A	PRELIMINARY ISSUE	G.R	20.10.17
REV	DESCRIPTION	APPROVED	DATE

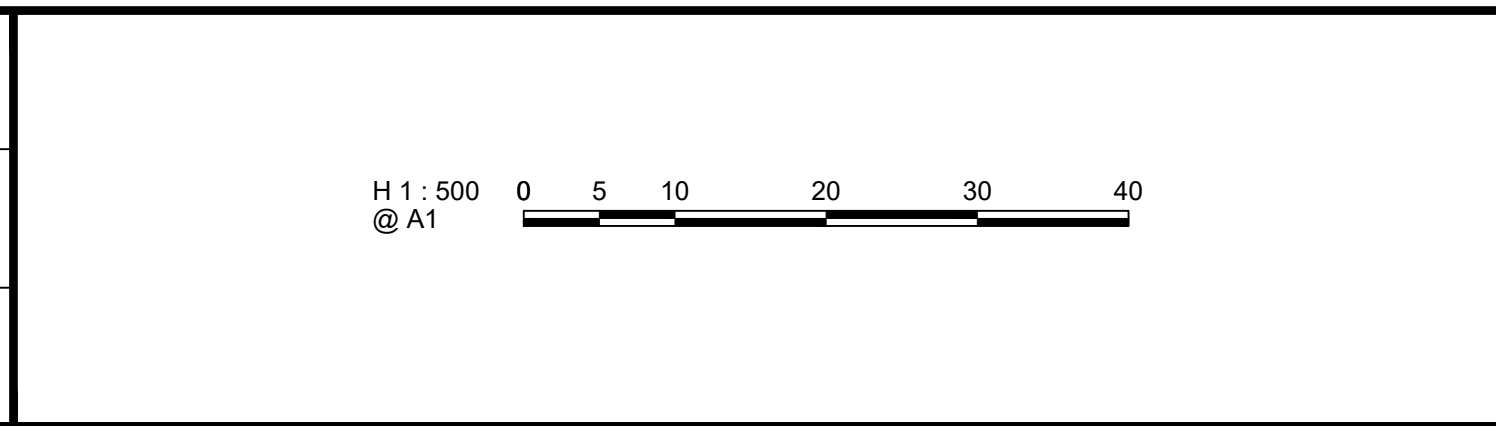

CLIENT:

merrifield

MAB **GPC**

verve

Level 1, 173 Burke Road, Glen Iris VIC 3146
Tel : 03 8573 1500 Fax: 03 8573 1555
verveprojects.com

COUNCIL:

HUME CITY COUNCIL

PROJECT:

MERRIFIELD LIVING - SECTION C
STAGE 36
MICKLEHAM

TITLE:

DETAIL PLAN - 1

ISSUE:

CONSTRUCTION

MELWAY REF:

366 F1

PROJECT No:

17017-36


DWG No:

RD200

REVISION:

1

CAD FILE: D:\WORK\VEVE PROJECTS\17017-36\17017-36-RD200-202.DWG
PLOT DATE: 1/05/2018 11:52 PM

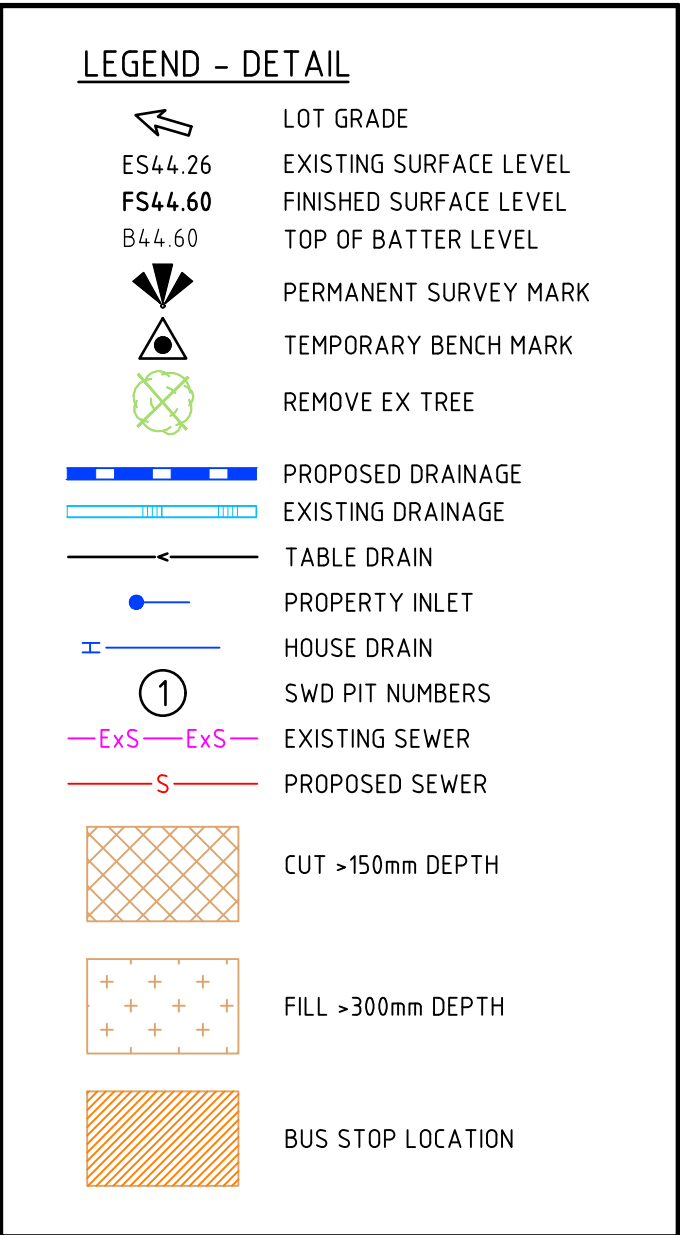

THE LOCATIONS OF UNDERGROUND SERVICES ARE APPROXIMATE ONLY AND THEIR EXACT POSITION SHOULD BE PROVEN ON SITE. NO GUARANTEE IS GIVEN THAT ALL EXISTING SERVICES ARE SHOWN. A DBYD ENQUIRY ON 1100 MUST BE MADE BY THE CONTRACTOR PRIOR TO COMMENCEMENT OF WORKS.

TITLE:			
DETAIL PLAN - 2			
MELWAY REF:	PROJECT No:	DWG No:	REVISION
366 F1	17017-36	RD201	1

27.03.2018 12:30 PM BRI L					DRAWN: P.CAMILLERI
	1	PIT 26 LOCATION REVISED	G.R	01.05.18	DESIGNED: LAPAP
	0	FOR CONSTRUCTION	G.R	27.03.18	
	B	ISSUED TO TFW FOR CERTIFICATION	G.R	16.03.18	APPROVED: G.ROMANCZ
	A	PRELIMINARY ISSUE	G.R	20.10.17	
	REV	DESCRIPTION	APPROVED	DATE	

DRAWN:	P.CAMILLERI
DESIGNED:	L.APAP
APPROVED:	G.ROMANCZ

H 1 : 500
@ A1



verve

Level 1, 173 Burke Road, Glen Iris VIC 3146
Tel : 03 8573 1500 Fax: 03 8573 1555
verveprojects.com

Certified System
Quality
ISO 9001
SAN GLOBAL

This drawing has been produced by
serve Projects ISO 9001 certified system.
© Verve Projects Pty Ltd.

COUNCIL

PROJECT

ISSUE:

HUME CITY COUNCIL

MERRIFIELD LIVING - SECTION C
STAGE 36
MICKLEHAM

CONSTRUCTION

TITEL:

DETAIL PLAN - 2

MELWAY REF:
366 F1


PROJECT No: 17017-36

DWG No:	REVISION
RD201	1

D FILE: V:\00 PROJECTS\17017 MERRIFIELD SECTION C__ENGINEERING\STAGE 36\CAD\17017-36-RD200-202.DWG
 OT DATE: 2/05/2018 1:33:01 PM

LEGEND - DETAIL

- LOT GRADE
- EXISTING SURFACE LEVEL
- FINISHED SURFACE LEVEL
- TOP OF BATTER LEVEL
- PERMANENT SURVEY MARK
- TEMPORARY BENCH MARK
- REMOVE EX TREE
- PROPOSED DRAINAGE
- EXISTING DRAINAGE
- TABLE DRAIN
- PROPERTY INLET
- HOUSE DRAIN
- SWD PIT NUMBERS
- EXISTING SEWER
- PROPOSED SEWER
- CUT >150mm DEPTH
- FILL >300mm DEPTH
- BUS STOP LOCATION

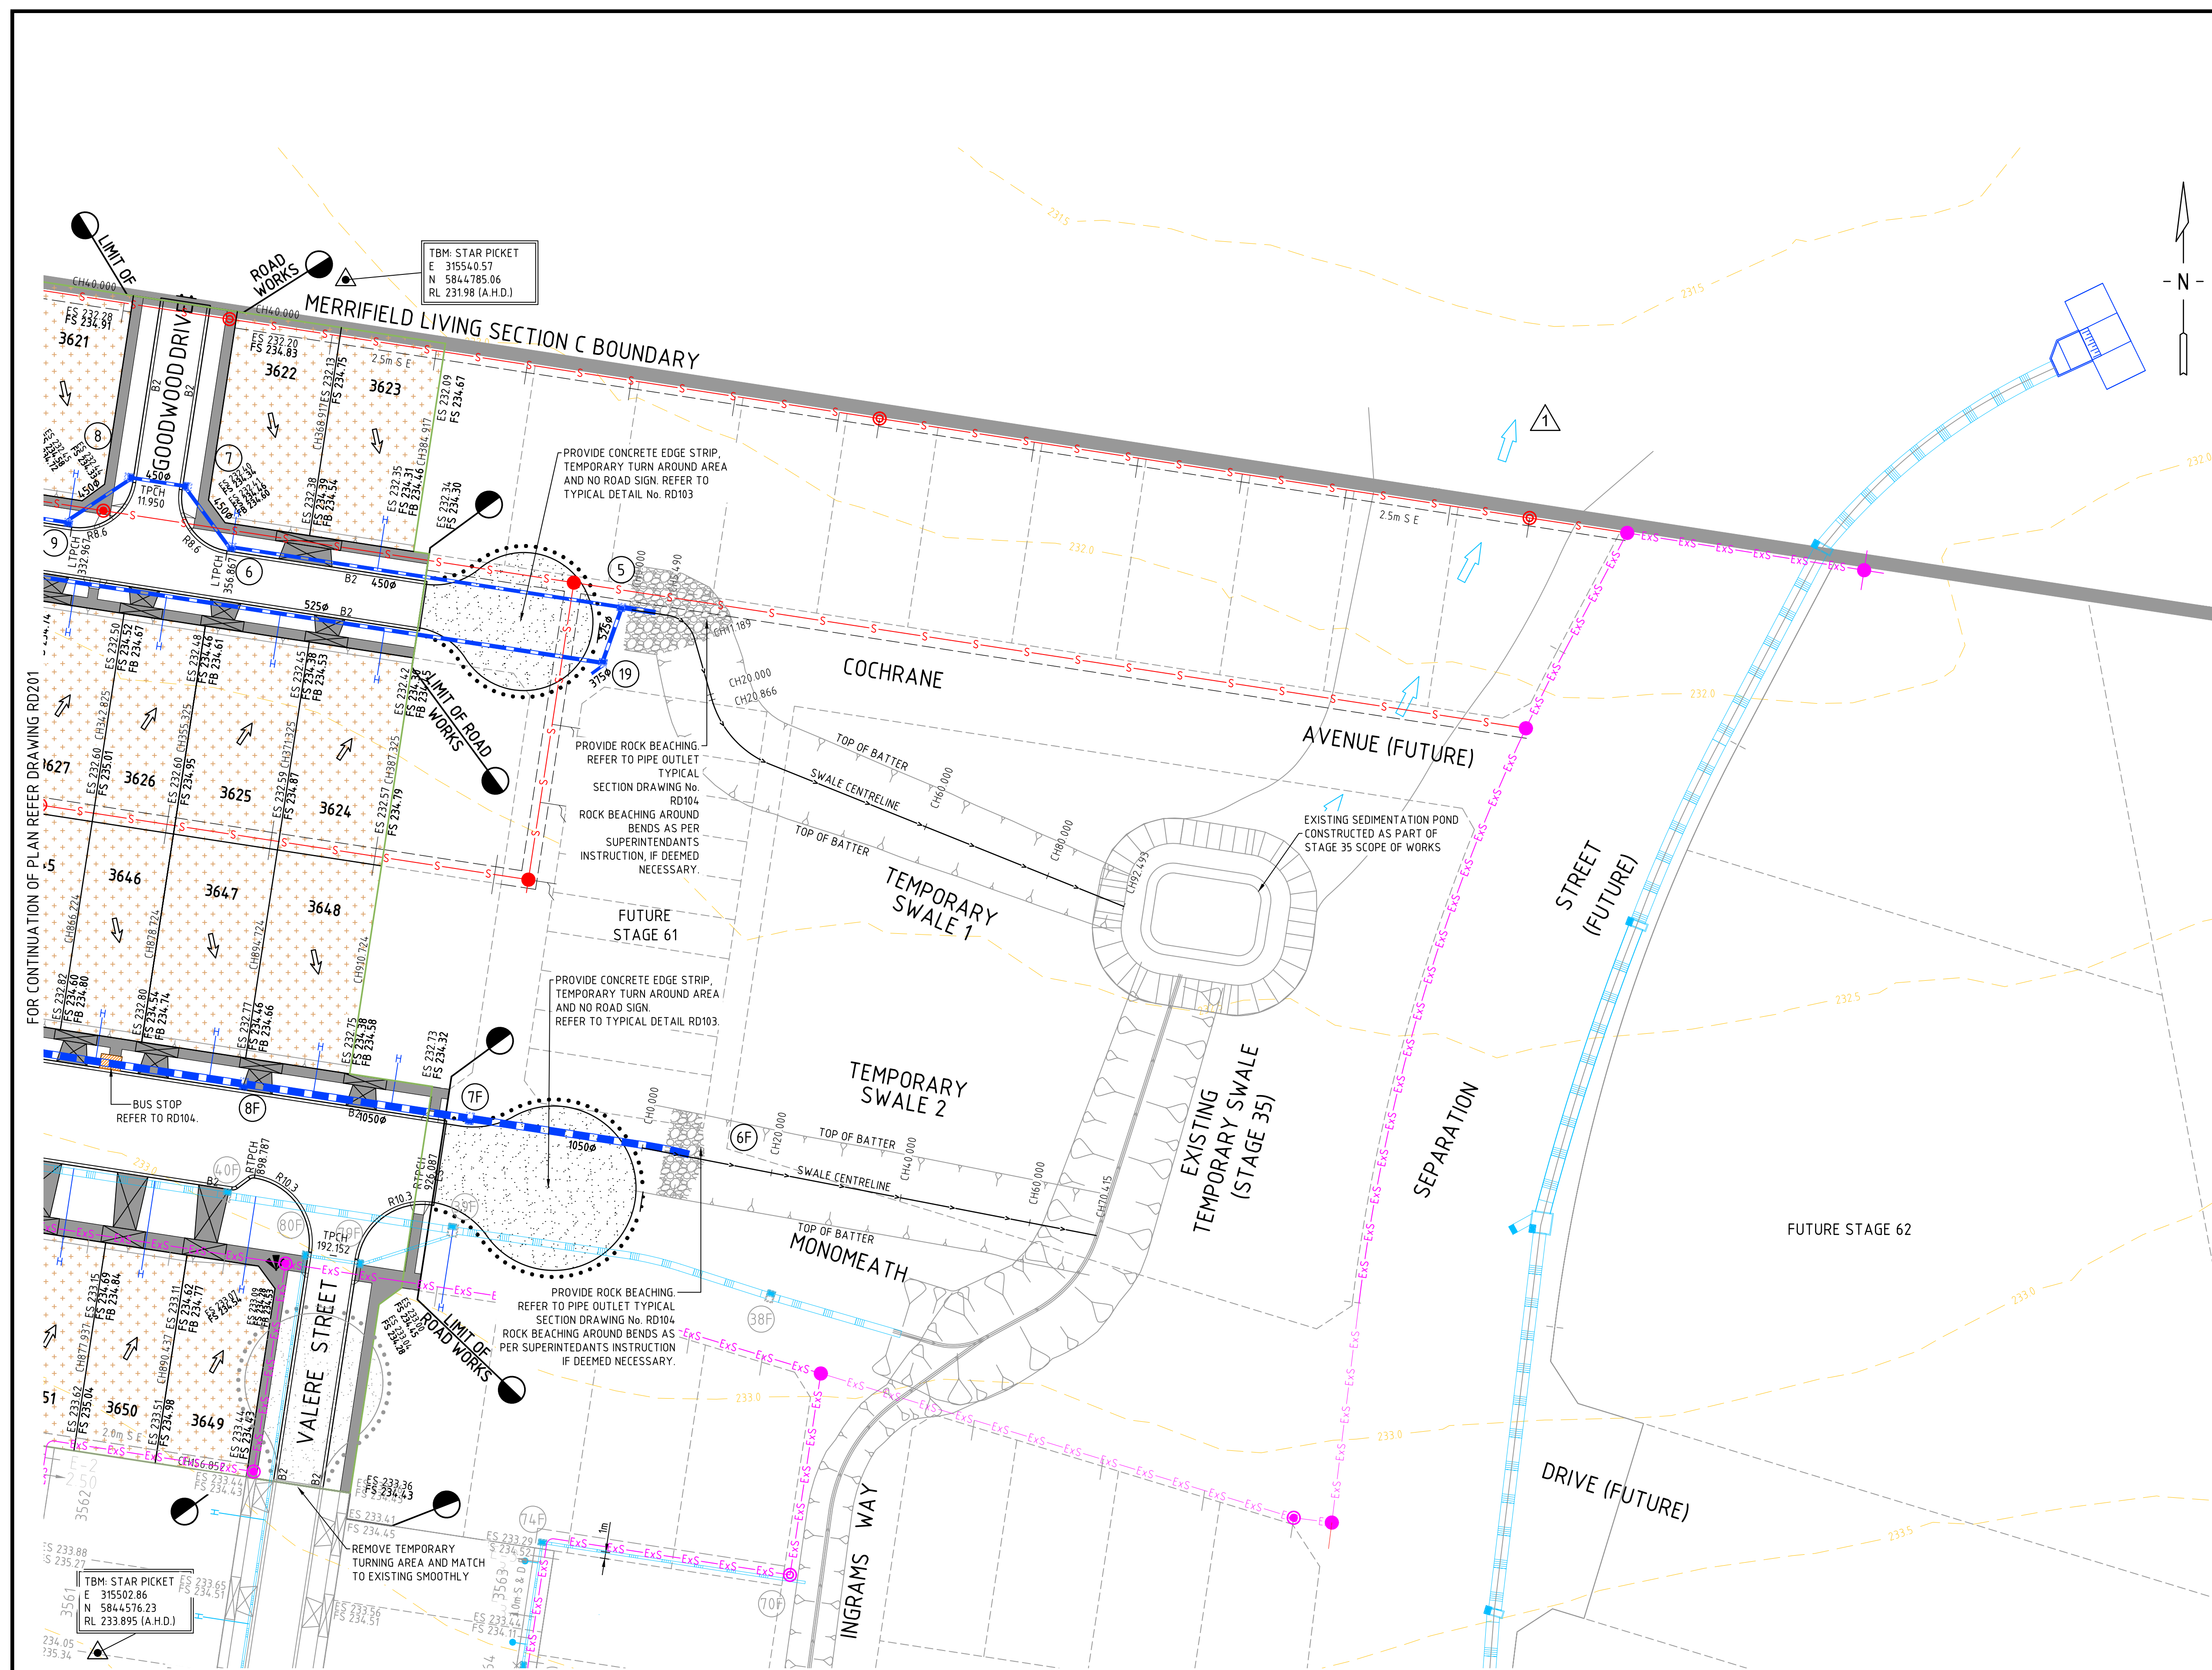

WARNING
BEWARE OF UNDERGROUND SERVICES

THE LOCATIONS OF UNDERGROUND SERVICES ARE APPROXIMATE ONLY AND THEIR EXACT POSITION SHOULD BE PROVEN ON SITE. NO GUARANTEE IS GIVEN THAT ALL EXISTING SERVICES ARE SHOWN. A DBYD ENQUIRY ON 1100 MUST BE MADE BY THE CONTRACTOR PRIOR TO COMMENCEMENT OF WORKS.

WARNING
ANY DESIGN SURFACE LEVELS SHOWN ARE PRELIMINARY ONLY AND SUBJECT TO FINAL DETAIL DESIGN, DO NOT USE FOR CONSTRUCTION

V:\00 PROJECTS\17017 MERRIFIELD SECTION C - ENGINEERING\STAGE 36\CAD\17017-36-RD200-202.DWG
PLOT DATE: 3/04/2018 10:22:15 AM

0	FOR CONSTRUCTION	G.R	27.03.18
A	PRELIMINARY ISSUE	G.R	20.10.17
REV	DESCRIPTION	APPROVED	DATE

DRAWN: P.CAMILLERI
DESIGNED: LAPAP
APPROVED: G.ROMANCZ

H 1 : 500
@ A1

0 5 10 20 30 40

CLIENT:

merrifield
MAB gpc

Level 1, 173 Burke Road, Glen Iris VIC 3146
Tel : 03 8573 1500 Fax: 03 8573 1555
verveprojects.com

COUNCIL: HUME CITY COUNCIL
PROJECT: MERRIFIELD LIVING - SECTION C
STAGE 36
MICKLEHAM
ISSUE: CONSTRUCTION

TITLE: DETAIL PLAN - 3

MELWAY REF: 366 F1
PROJECT No: 17017-36
DWG No: RD202
REVISION: 0