

LEVEL ONE COMPLIANCE REPORT

PREPARED BY:
PROTEST ENGINEERING

PREPARED FOR:
Western Civil Pty Ltd
Merrifield Residential
Stage 1 & 2
PTP/11232
24 January 2024



Western Civil Pty Ltd
2/7 Geehi Way,
Ravenhall, VIC, 3023

Project Number: PTP/11232
Letter Number: PTP/11232 – 0001 - Rev0
Project Name: Merrifield Residential Stage 1 & 2

Attention: Daniel Sirillas
Report on Level 1 Inspection & Testing
Merrifield Residential Stage 1 & 2

1. Introduction

This report summarises the results of inspection and testing provided by Protest Engineering (Protest) for the bulk earthworks as part of the residential project Merrifield Residential Stage 1 & 2 located in Mickleham undertaken between 1 February 2023 and 20 February 2023. The works were undertaken at the request of Western Civil Pty Ltd.

The scope of inspection and testing undertaken was in general accordance with AS3798-2007 *Guidelines on Earthworks for Commercial and Residential Developments*. As part of the inspection and testing undertaken, Protest provided Level 1 supervision in accordance with *Section 8.2 of AS3798-2007 Guidelines on Earthworks for commercial and residential developments*.

2. Earthworks Activities

Foundation preparation observed by Protest on 1 February 2023 comprising of the removal of topsoil and vegetation across the fill areas exposing the underlying natural materials.

Filling operations comprised the placement and compaction of onsite materials believed to be sourced from site cuts and road boxings. Materials typically comprised of grey-brown silty clays considered to be of medium plasticity. The material used as fill was moisture conditioned during placement and blended to achieve a suitable moisture content for compaction. Filling materials were placed onsite in uniform layers not exceeding 200 mm thick and compacted with a pad foot roller.

Field density testing was carried out at regular intervals throughout earthworks by using a nuclear densometer in accordance with the test method outlined in AS1289.5.8.1. The relative compaction was then determined by comparing the recorded field density with the laboratory maximum dry density (standard compaction) outlined in test method AS1289.5.1.1.

Fill material placed was tested at a suitable frequency in accordance with AS3798-2007 *Table 8.1- frequency of field density tests* and the results indicate that the compacted material achieved the minimum density requirement outlined in AS3798-2007 *Table 5.1 - minimum relative compaction*. A total of twelve (12) field density ratio tests were carried out across the site during filling operations and a summary of the test results are presented in Table 1.

Table 1: Summary of Density Testing

Item	Compaction	Moisture Variation
No. of tests	12	12
Mean	100.2%	0.4% (Dry of OMC ⁽¹⁾)

(Notes: ⁽¹⁾ Optimum Moisture Content)

3. Comments

Based on the results of the inspections and field density testing whilst Protest was onsite, it is considered that the filling works completed at the residential project Merrifield Residential Stage 1 & 2 located in Mickleham undertaken between 1 February 2023 and 20 February 2023 has been constructed in accordance with AS3798-2007 *Guidelines on Earthworks for Commercial and Residential Developments*. Protest believes consideration should be given to the following:

- I. This report only certifies the bulk earthworks activities supervised by Protest between 1 February 2023 and 20 February 2023. Protest does not take responsibility for any other earthwork activities that have occurred before or after these dates.
- II. The installation of services or any activities that may cause disruption of the compacted filling.
- III. The suitability of the filled land to support the proposed structures; and
- IV. Any variation in filling depth or extent of areas that is not noted within this report or on the individual test report sheets.

4. Constraints

Protest has prepared this report for the bulk earthworks at the residential project Merrifield Residential Stage 1 & 2 located in Mickleham undertaken between 1 February 2023 and 20 February 2023. This report was produced for the sole use of Western Civil Pty Ltd. It should not be used by or depended upon for other projects or purposes on the same or other site or by a third party. In the preparation of this report Protest has relied upon information provided by the client and/or their agents.

The results provided in this report are indicative of the subsurface conditions on the site only at the specific sampling or testing locations, and then only to the depths investigated along with the time the work was carried out. It is known that subsurface conditions can suddenly change due to irregular geological processes and because of human influences. Such changes may occur after Protest field testing has been completed.

Certain ground conditions and the materials behaviour observed or contained at the test locations may alter from those which may be encountered elsewhere on the site. Should variations in subsurface conditions be encountered, then additional advice should be sought from Protest and, if required, amendments made; and

Protest cannot be held responsible for interpretations or conclusions made by others unless they are supported by an expressed statement, interpretation, outcome, or conclusion given in this report.

We trust that the above information is suitable for your present requirements. Should you have any queries, please do not hesitate to contact the undersigned.

Regards,

Protest Engineering



Cameron Axon

Laboratory Manager - Melbourne

p | 0419 094 927

e | cameron.axon@protestengineering.com

Reviewed By



Blake Thomas

Practice Director

p | 0478 967 023


e | blake.thomas@protestengineering.com

PROTEST
ENGINEERING

GEOTECHNICAL // TESTING SERVICES // STRUCTURAL

Attachment 1

Site Plan

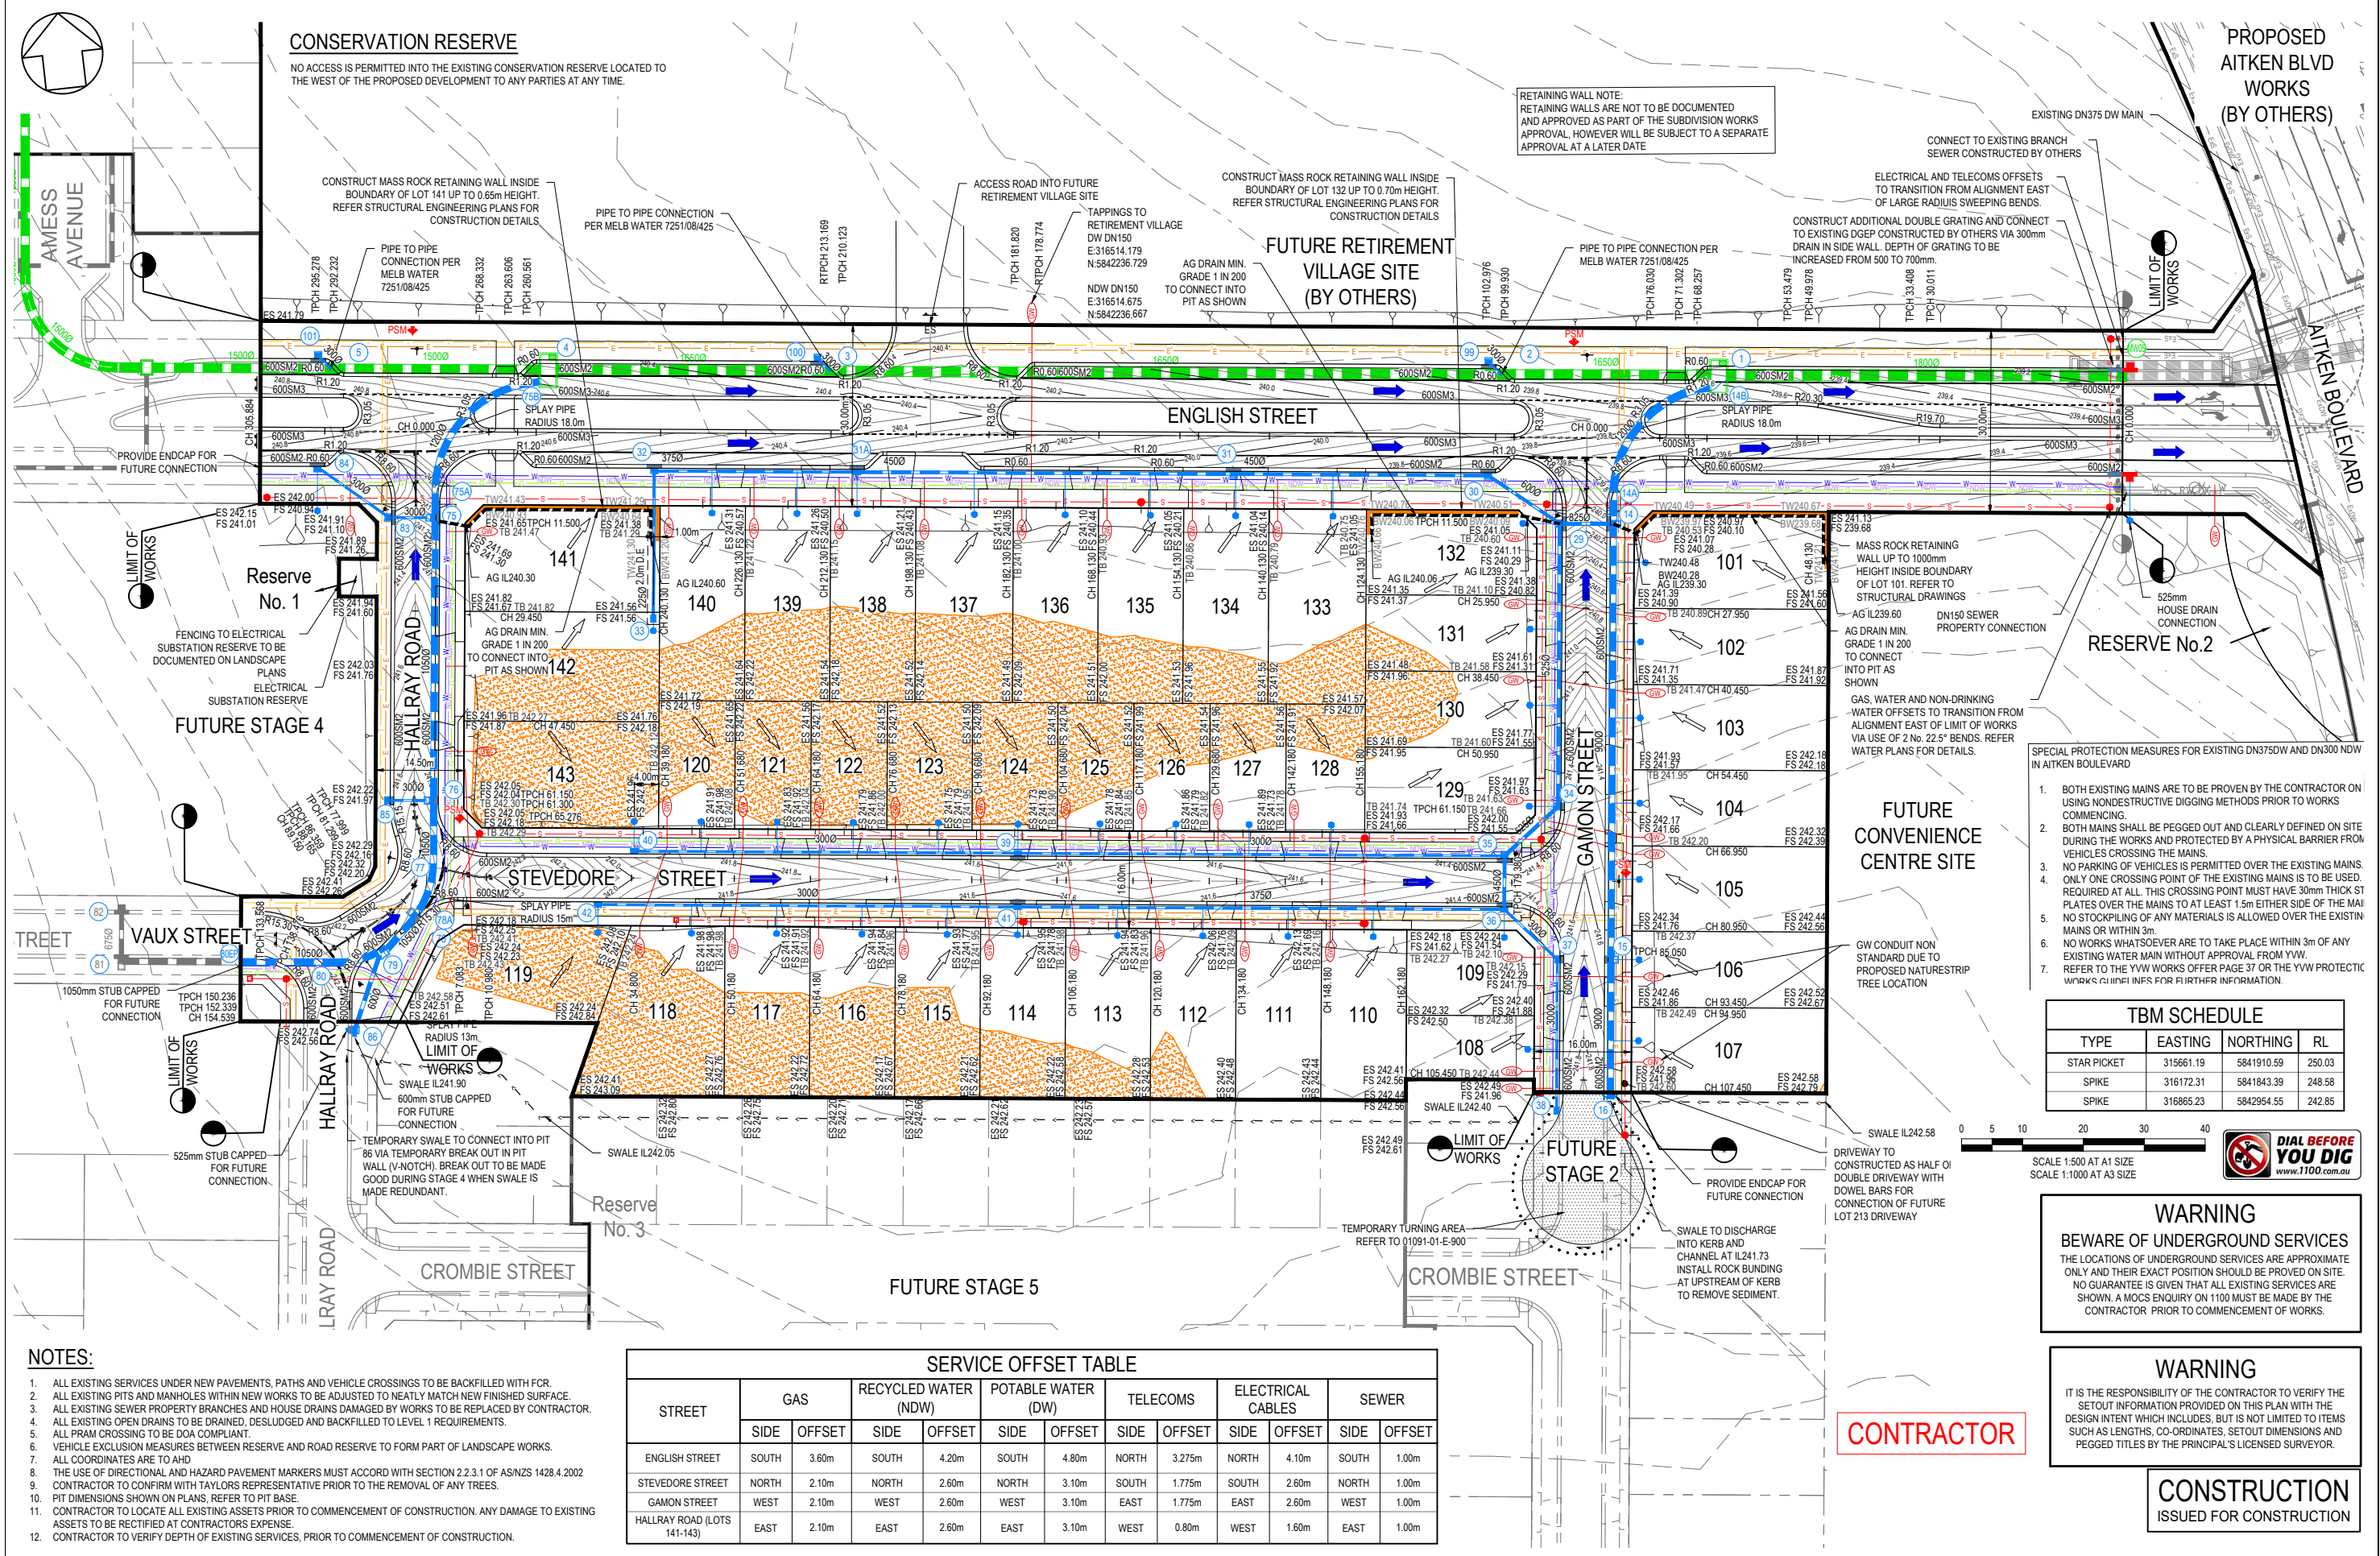

CONSERVATION RESERVE
NO ACCESS IS PERMITTED INTO THE EXISTING CONSERVATION RESERVE LOCATED TO THE WEST OF THE PROPOSED DEVELOPMENT TO ANY PARTIES AT ANY TIME.

RETAINING WALL NOTE:
RETAINING WALLS ARE NOT TO BE DOCUMENTED AND APPROVED AS PART OF THE SUBDIVISION WORKS APPROVAL, HOWEVER WILL BE SUBJECT TO A SEPARATE APPROVAL AT A LATER DATE

PROPOSED AITKEN BLVD WORKS (BY OTHERS)

FUTURE RETIREMENT VILLAGE SITE (BY OTHERS)

CONNECT TO EXISTING BRANCH SEWER CONSTRUCTED BY OTHERS

ELECTRICAL AND TELECOMS OFFSETS TO TRANSITION FROM ALIGNMENT EAST OF LARGE RADIUS SWEEPING BENDS.

CONSTRUCT ADDITIONAL DOUBLE GRATING AND CONNECT TO EXISTING DGEF CONSTRUCTED BY OTHERS VIA 300mm DRAIN IN SIDE WALL. DEPTH OF GRATING TO BE INCREASED FROM 500 TO 700mm.

MASS ROCK RETAINING WALL UP TO 1000mm HEIGHT INSIDE BOUNDARY OF LOT 101. REFER TO STRUCTURAL DRAWINGS


AG IL239.60
AG DRAIN MIN. GRADE 1 IN 200 TO CONNECT INTO PIT AS SHOWN

GAS, WATER AND NON-DRINKING WATER OFFSETS TO TRANSITION FROM ALIGNMENT EAST OF LIMIT OF WORKS VIA USE OF 2 No. 22.5" BENDS. REFER WATER PLANS FOR DETAILS.

SPECIAL PROTECTION MEASURES FOR EXISTING DN375DW AND DN300 NDW IN AITKEN BOULEVARD

- BOTH EXISTING MAINS ARE TO BE PROVEN BY THE CONTRACTOR ON USING NON-DESTRUCTIVE DIGGING METHODS PRIOR TO WORKS COMMENCING
- BOTH MAINS SHALL BE PEGGED OUT AND CLEARLY DEFINED ON SITE DURING THE WORKS AND PROTECTED BY A PHYSICAL BARRIER FROM VEHICLES CROSSING THE MAINS.
- NO PARKING OF VEHICLES IS PERMITTED OVER THE EXISTING MAINS.
- ONLY ONE CROSSING POINT OF THE EXISTING MAINS IS TO BE USED. REQUIRED AT ALL. THIS CROSSING POINT MUST HAVE 30mm THICK ST PLATES OVER THE MAINS TO AT LEAST 1.5m EITHER SIDE OF THE MAINS OR WITHIN 3m.
- NO WORKS WHATSOEVER ARE TO TAKE PLACE WITHIN 3m OF ANY EXISTING WATER MAIN WITHOUT APPROVAL FROM YVW.
- REFER TO THE YVW WORKS OFFER PAGE 37 OR THE YVW PROTECTIVE WORKS (P) WORKS FOR FURTHER INFORMATION.

TBM SCHEDULE			
TYPE	EASTING	NORTHING	RL
STAR PICKET	315661.19	5841910.59	250.03
SPIKE	316172.31	5841843.39	248.58
SPIKE	316865.23	5842954.55	242.85

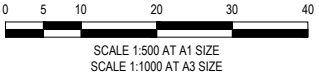

WARNING
BEWARE OF UNDERGROUND SERVICES
THE LOCATIONS OF UNDERGROUND SERVICES ARE APPROXIMATE ONLY AND THEIR EXACT POSITION SHOULD BE PROVED ON SITE. NO GUARANTEE IS GIVEN THAT ALL EXISTING SERVICES ARE SHOWN. A MOCS ENQUIRY ON 1100 MUST BE MADE BY THE CONTRACTOR PRIOR TO COMMENCEMENT OF WORKS.

WARNING
IT IS THE RESPONSIBILITY OF THE CONTRACTOR TO VERIFY THE SETOUT INFORMATION PROVIDED ON THIS PLAN WITH THE DESIGN INTENT WHICH INCLUDES, BUT IS NOT LIMITED TO ITEMS SUCH AS LENGTHS, CO-ORDINATES, SETOUT DIMENSIONS AND PEGGED TITLES BY THE PRINCIPAL'S LICENSED SURVEYOR.

CONSTRUCTION
ISSUED FOR CONSTRUCTION

CONTRACTOR

- NOTES:**
- ALL EXISTING SERVICES UNDER NEW PAVEMENTS, PATHS AND VEHICLE CROSSINGS TO BE BACKFILLED WITH FCR.
 - ALL EXISTING PITS AND MANHOLES WITHIN NEW WORKS TO BE ADJUSTED TO NEATLY MATCH NEW FINISHED SURFACE.
 - ALL EXISTING SEWER PROPERTY BRANCHES AND HOUSE DRAINS DAMAGED BY WORKS TO BE REPLACED BY CONTRACTOR.
 - ALL EXISTING OPEN DRAINS TO BE DRAINED, DESLUDGED AND BACKFILLED TO LEVEL 1 REQUIREMENTS.
 - ALL PRAM CROSSING TO BE DOA COMPLIANT.
 - VEHICLE EXCLUSION MEASURES BETWEEN RESERVE AND ROAD RESERVE TO FORM PART OF LANDSCAPE WORKS.
 - ALL COORDINATES ARE TO AHD
 - THE USE OF DIRECTIONAL AND HAZARD PAVEMENT MARKERS MUST ACCORD WITH SECTION 2.2.3.1 OF AS/NZS 1428.4:2002
 - CONTRACTOR TO CONFIRM WITH TAYLORS REPRESENTATIVE PRIOR TO THE REMOVAL OF ANY TREES.
 - PIT DIMENSIONS SHOWN ON PLANS. REFER TO PIT BASE.
 - CONTRACTOR TO LOCATE ALL EXISTING ASSETS PRIOR TO COMMENCEMENT OF CONSTRUCTION. ANY DAMAGE TO EXISTING ASSETS TO BE RECTIFIED AT CONTRACTORS EXPENSE.
 - CONTRACTOR TO VERIFY DEPTH OF EXISTING SERVICES, PRIOR TO COMMENCEMENT OF CONSTRUCTION.

STREET	GAS		RECYCLED WATER (NDW)		POTABLE WATER (DW)		TELECOMS		ELECTRICAL CABLES		SEWER	
	SIDE	OFFSET	SIDE	OFFSET	SIDE	OFFSET	SIDE	OFFSET	SIDE	OFFSET	SIDE	OFFSET
ENGLISH STREET	SOUTH	3.60m	SOUTH	4.20m	SOUTH	4.80m	NORTH	3.275m	NORTH	4.10m	SOUTH	1.00m
STEVEDORE STREET	NORTH	2.10m	NORTH	2.60m	NORTH	3.10m	SOUTH	1.775m	SOUTH	2.60m	NORTH	1.00m
GAMON STREET	WEST	2.10m	WEST	2.60m	WEST	3.10m	EAST	1.775m	EAST	2.60m	WEST	1.00m
HALLRAY ROAD (LOTS 141-143)	EAST	2.10m	EAST	2.60m	EAST	3.10m	WEST	0.80m	WEST	1.60m	EAST	1.00m

VER	DATE	REVISION	APPD.
0	20/12/2022	ISSUED FOR CONSTRUCTION	SJP

EXISTING		PROPOSED		FILLING ON LOTS DEEPER THAN 200mm	
EXISTING GAS MAIN	E _{EG}	PROPOSED GAS MAIN	G	TGSI (TACTILE GROUND SURFACE INDICATORS)	TGSI
EXISTING WATER MAIN	E _{EW}	PROPOSED WATER MAIN	W	EXISTING SURFACE LEVEL	ESS1.260
EXISTING ELECTRICITY CABLE	E _{EC}	PROPOSED ELECTRICITY CABLE	E	FINISHED SURFACE LEVEL	FSF1.046
EXISTING TELCO CABLE & PIT	E _{ET}	PROPOSED TELCO CABLE	T	FINISHED SURFACE BATTER	TBS1.296
EXISTING SEWER MAIN & M.H.	E _{ES}	PROPOSED SEWER MAIN & M.H.	S	TOP OF WALL FINISHED SURFACE LEVEL	TW025.33
EXISTING DRAIN & PIT	E _{ED}	PROPOSED DRAIN, PIT & PROPERTY PILE	D	BOTTOM OF WALL FINISHED SURFACE LEVEL	BW024.25
PROPOSED GAS & WATER CONDUIT	C _{GW}	STREET NAME SIGN	P.S.M.		

TAYLORS
Urban Development | Infrastructure
8/270 Ferntree Gully Road, Notting Hill, Victoria, 3168
Tel: 61 3 9501 2800 | Web: taylors.com.au


DESIGNED: SJP AUTHORIZED: JOY DRAFTED: LAJ
CHECKED: ROK AUTH. DATE: 01/07/2022 CAD REF: 01091-01-E-108

HUME CITY COUNCIL
225 - 285 DONNYBROOK ROAD, MICKLEHAM
MERRIFIELD RESIDENTIAL, STAGE 1

SCALE 1:500 @ A1
VERSION 0
SHEET 9 OF 38
DRAWING No. 01091-01-E-108

DETAIL LAYOUT PLAN

REFER RIGHT FOR CONTINUATION

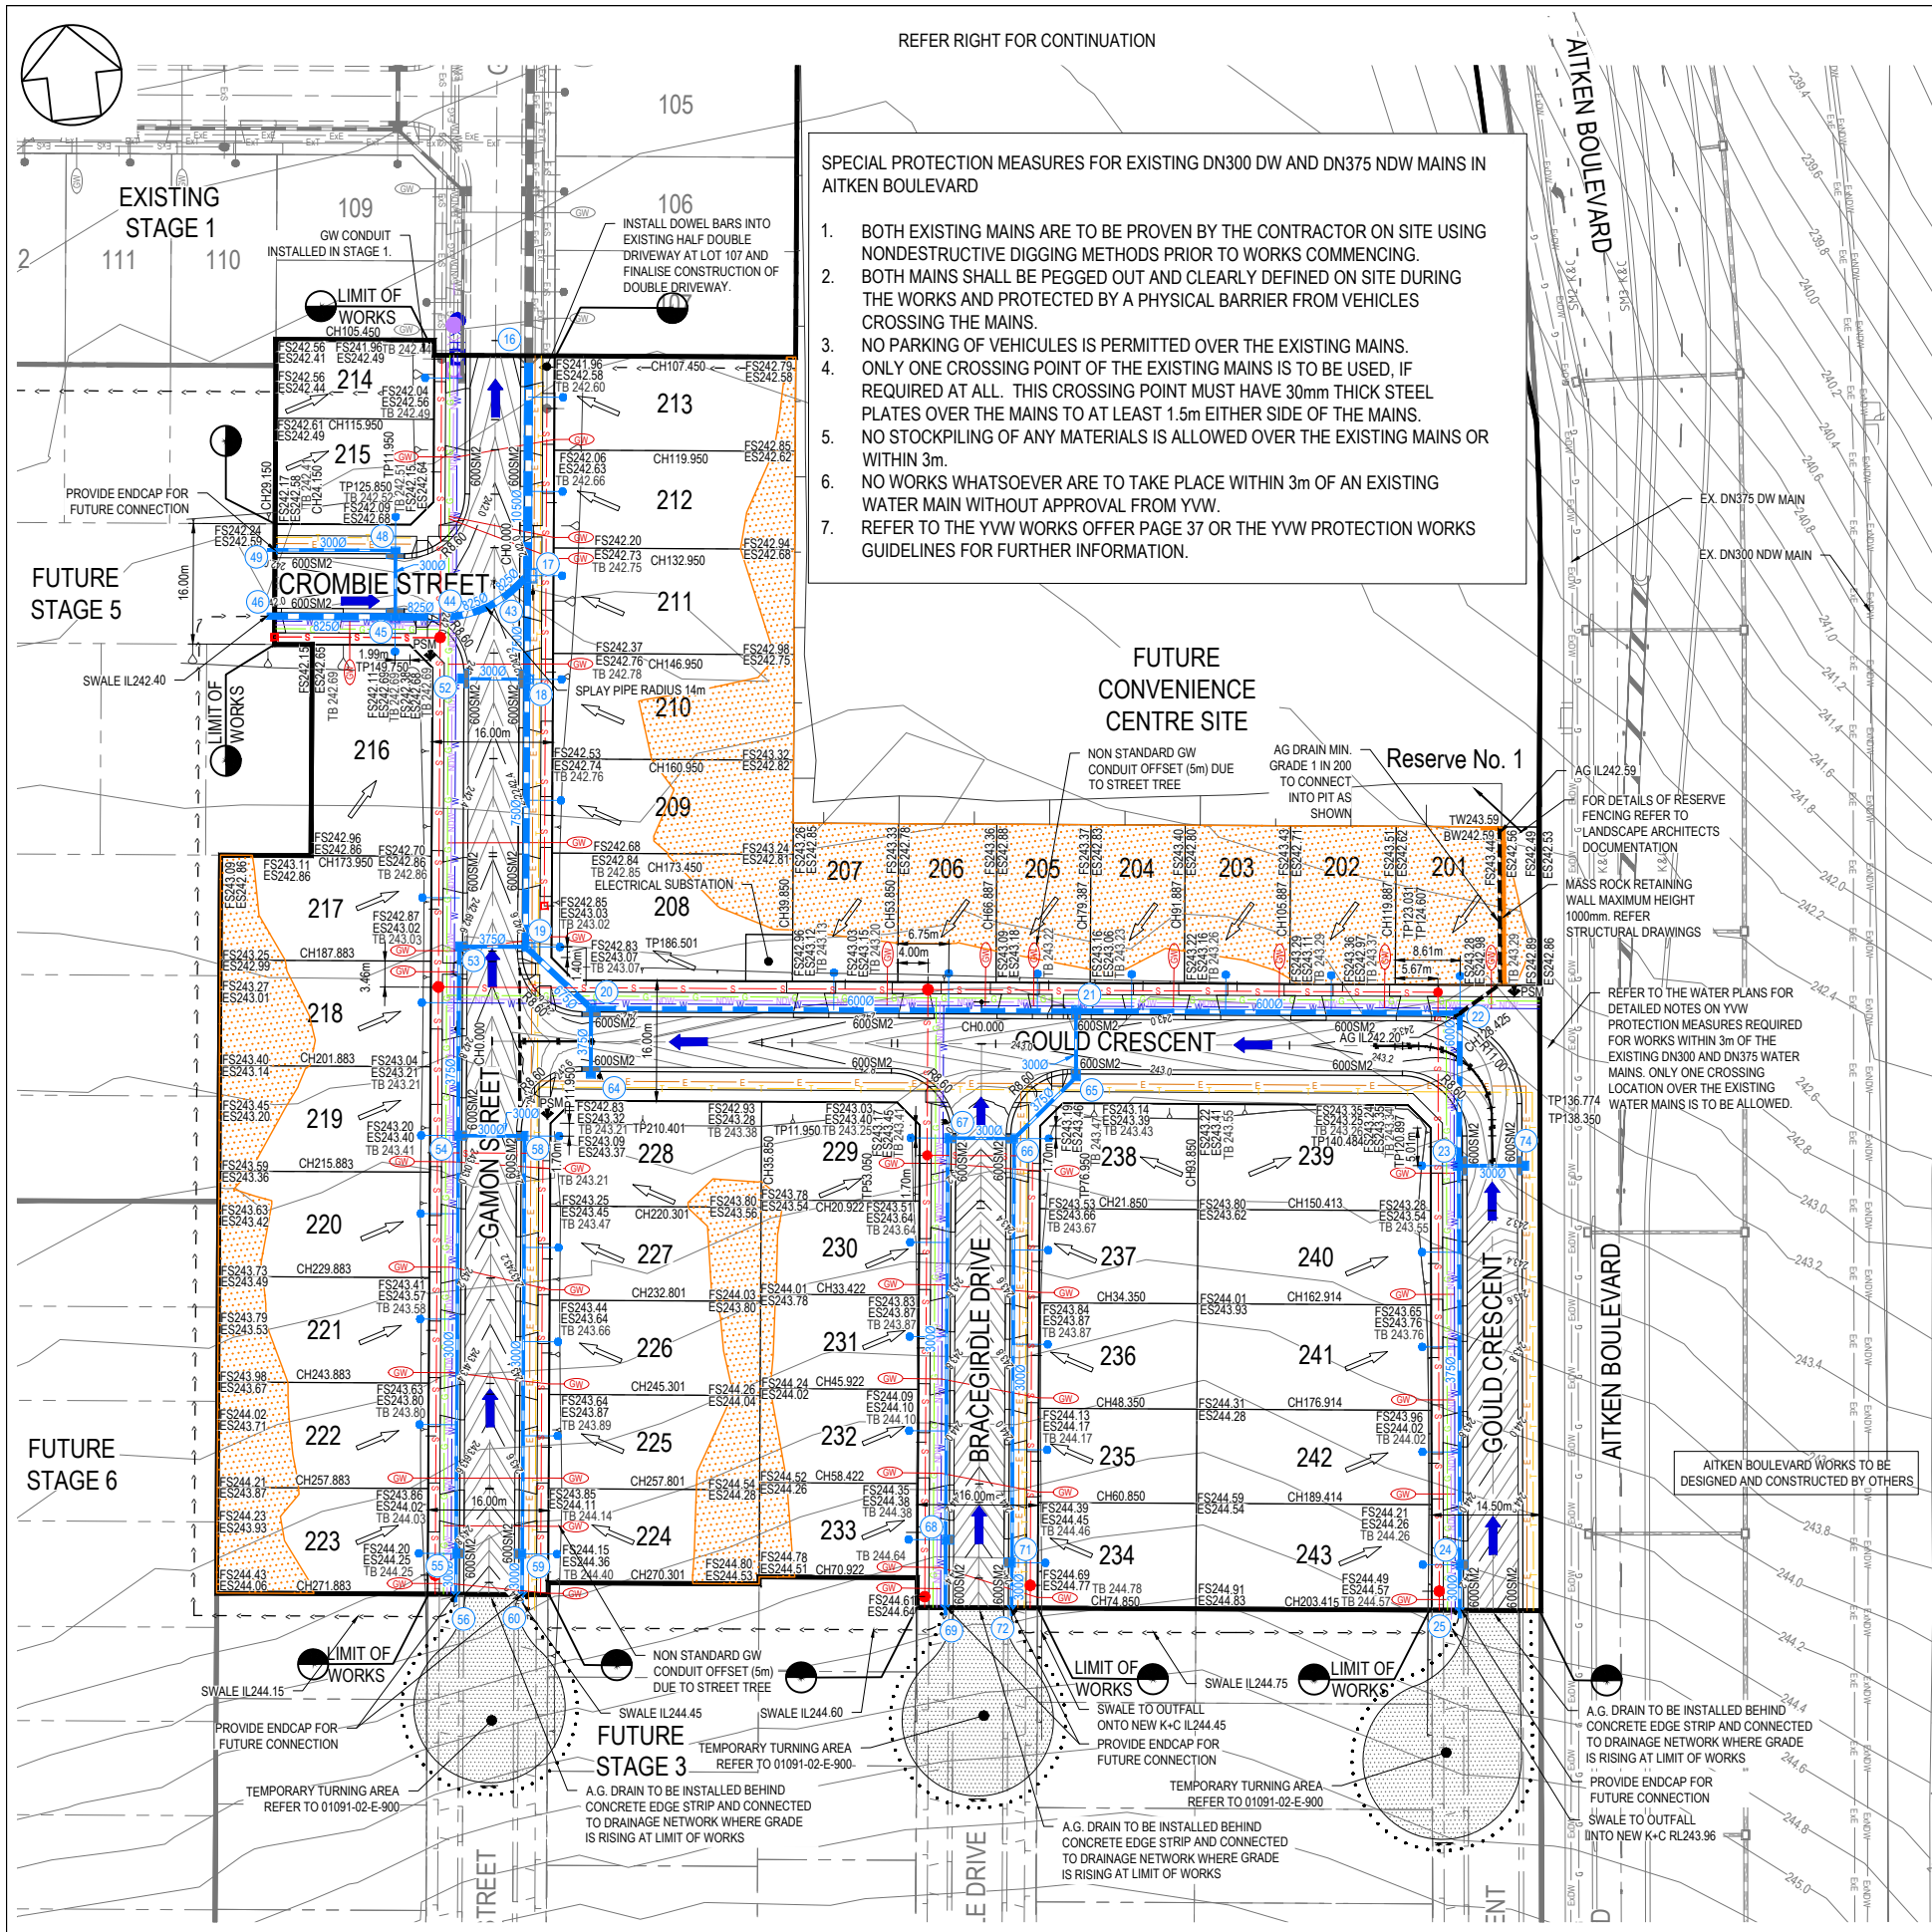

SPECIAL PROTECTION MEASURES FOR EXISTING DN300 DW AND DN375 NDW MAINS IN AITKEN BOULEVARD

- BOTH EXISTING MAINS ARE TO BE PROVEN BY THE CONTRACTOR ON SITE USING NONDESTRUCTIVE DIGGING METHODS PRIOR TO WORKS COMMENCING.
- BOTH MAINS SHALL BE PEGGED OUT AND CLEARLY DEFINED ON SITE DURING THE WORKS AND PROTECTED BY A PHYSICAL BARRIER FROM VEHICLES CROSSING THE MAINS.
- NO PARKING OF VEHICLES IS PERMITTED OVER THE EXISTING MAINS. ONLY ONE CROSSING POINT OF THE EXISTING MAINS IS TO BE USED, IF REQUIRED AT ALL. THIS CROSSING POINT MUST HAVE 30mm THICK STEEL PLATES OVER THE MAINS TO AT LEAST 1.5m EITHER SIDE OF THE MAINS.
- NO STOCKPILING OF ANY MATERIALS IS ALLOWED OVER THE EXISTING MAINS OR WITHIN 3m.
- NO WORKS WHATSOEVER ARE TO TAKE PLACE WITHIN 3m OF AN EXISTING WATER MAIN WITHOUT APPROVAL FROM YVW.
- REFER TO THE YVW WORKS OFFER PAGE 37 OR THE YVW PROTECTION WORKS GUIDELINES FOR FURTHER INFORMATION.

CONSERVATION RESERVE


NO ACCESS IS PERMITTED INTO THE EXISTING CONSERVATION RESERVE LOCATED TO THE WEST OF THE PROPOSED DEVELOPMENT TO ANY PARTIES AT ANY TIME.

NOTES:

- ALL EXISTING SERVICES UNDER NEW PAVEMENTS, PATHS AND VEHICLE CROSSINGS TO BE BACKFILLED WITH FC9.
- ALL EXISTING PITS AND MANHOLES WITHIN NEW WORKS TO BE ADJUSTED TO NEATLY MATCH NEW FINISHED SURFACE.
- ALL EXISTING SEWER PROPERTY BRANCHES AND HOUSE DRAINS DAMAGED BY WORKS TO BE REPLACED BY CONTRACTOR.
- ALL EXISTING OPEN DRAINS TO BE DRAINED, DESLUDGED AND BACKFILLED TO LEVEL 1 REQUIREMENTS.
- ALL PRAM CROSSING TO BE DOA COMPLIANT.
- VEHICLE EXCLUSION MEASURES BETWEEN RESERVE AND ROAD RESERVE TO FORM PART OF LANDSCAPE WORKS.
- ALL COORDINATES ARE TO AHD.
- THE USE OF DIRECTIONAL AND HAZARD PAVEMENT MARKERS MUST ACCORD WITH SECTION 2.2.3.1 OF AS/NZS 1428.4:2002.
- CONTRACTOR TO CONFIRM WITH TAYLORS REPRESENTATIVE PRIOR TO THE REMOVAL OF ANY TREES.
- PIT DIMENSIONS SHOWN ON PLANS. REFER TO PIT BASE.
- CONTRACTOR TO LOCATE ALL EXISTING ASSETS PRIOR TO COMMENCEMENT OF CONSTRUCTION. ANY DAMAGE TO EXISTING ASSETS TO BE RECTIFIED AT CONTRACTORS EXPENSE.
- CONTRACTOR TO VERIFY DEPTH OF EXISTING SERVICES, PRIOR TO COMMENCEMENT OF CONSTRUCTION.

TBM SCHEDULE

TYPE	EASTING	NORTHING	RL
STAR PICKET	316661.19	5841910.59	250.03
SPIKE	316172.31	5841843.39	248.58
SPIKE	316865.23	5842954.55	242.85

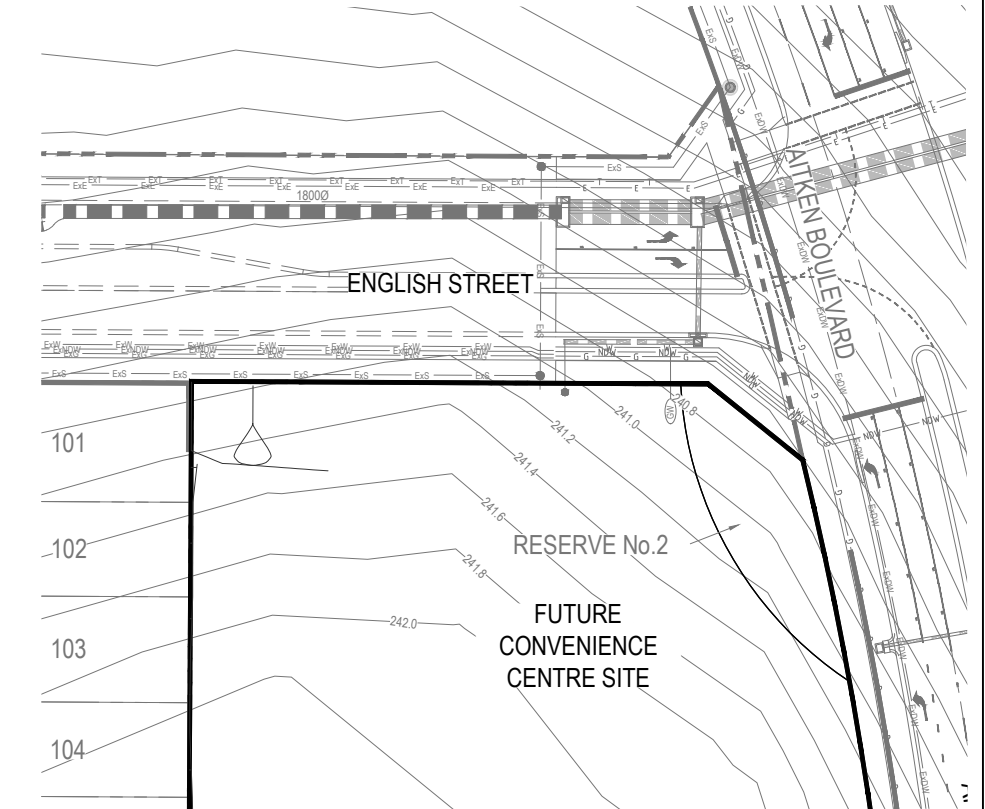


RETAINING WALL NOTE:
RETAINING WALLS ARE NOT TO BE DOCUMENTED AND APPROVED AS PART OF THE SUBDIVISIONAL WORKS APPROVAL, HOWEVER WILL BE SUBJECT TO A SEPARATE APPROVAL AT A LATER DATE.

WARNING
BEWARE OF UNDERGROUND SERVICES
THE LOCATIONS OF UNDERGROUND SERVICES ARE APPROXIMATE ONLY AND THEIR EXACT POSITION SHOULD BE PROVED ON SITE. NO GUARANTEE IS GIVEN THAT ALL EXISTING SERVICES ARE SHOWN. A MOCS ENQUIRY ON 1100 MUST BE MADE BY THE CONTRACTOR PRIOR TO COMMENCEMENT OF WORKS.

WARNING
IT IS THE RESPONSIBILITY OF THE CONTRACTOR TO VERIFY THE SETOUT INFORMATION PROVIDED ON THIS PLAN WITH THE DESIGN INTENT WHICH INCLUDES, BUT IS NOT LIMITED TO ITEMS SUCH AS LENGTHS, CO-ORDINATES, SETOUT DIMENSIONS AND PEGGED TITLES BY THE PRINCIPAL'S LICENSED SURVEYOR.

CONTRACTOR

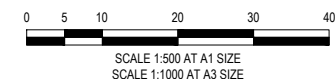

CONSTRUCTION
ISSUED FOR CONSTRUCTION

VER	DATE	REVISION	APPD.
0	20/12/2022	ISSUED FOR CONSTRUCTION	SJP

EXISTING GAS MAIN	EXISTING WATER MAIN	EXISTING ELECTRICITY CABLE	EXISTING TELCO CABLE & PIT	EXISTING SEWER MAIN & M.H.	EXISTING DRAIN & PIT	PROPOSED GAS & WATER CONDUIT
— Eg	— Ew	— Ee	— Et	— Es	— Ed	— Cw

PROPOSED GAS MAIN	PROPOSED WATER MAIN	PROPOSED ELECTRICITY CABLE	PROPOSED TELCO CABLE	PROPOSED SEWER MAIN & M.H.	PROPOSED DRAIN, PIT & PROPERTY SET	STREET NAME SIGN
— G	— W	— E	— T	— S	— D	— S

P.S.M.	FILLING ON LOTS DEEPER THAN 200mm	EXISTING SURFACE LEVEL	FINISHED SURFACE LEVEL	FINISHED SURFACE BATTER
— P	— F	— E	— F	— B

TAYLORS
Urban Development | Infrastructure
8/270 Ferntree Gully Road, Notting Hill, Victoria, 3186
Tel: 61 3 9501 2800 | Web: taylors.com.au

DESIGNED: EST	AUTHORISED: JOY	DRAFTED: PGV
CHECKED: SJP	AUTH. DATE: 27/06/2022	CAD REF: 01091-02-E-107

HUME CITY COUNCIL
225 - 285 DONNYBROOK ROAD, MICKLEHAM
MERRIFIELD RESIDENTIAL, STAGE 2
DETAIL LAYOUT PLAN



SCALE 1:500 @ A1
VERSION 0
SHEET 8 OF 26
DRAWING No. 01091-02-E-107


PROTEST
ENGINEERING

GEOTECHNICAL // TESTING SERVICES // STRUCTURAL

Attachment 2
Density Reports

Dry Density / Moisture Ratio Report

Client :	WESTERN CIVIL PTY LTD			Report Number :	SR/PTP/11232 - 1/1	
Client Address :	Geehi Way/2/7, Ravenhall, 3023, VIC			Report Date :	13/02/2023	
Project Name :	Merrifield Residential Stage 1 & 2			Test Request :	-	
Project Number :	PTP/11232			Page 1 of 1		
Location :	Mickleham					
Test Methods :	AS1289.5.4.1, AS1289.5.8.1, AS1289.2.1.1, AS1289.5.1.1,					
Sample Number :	S/179675	S/179676	S/179677			
Date Tested :	2/02/2023	2/02/2023	2/02/2023			
Material Source :	Onsite	Onsite	Onsite			
For use as :	Residential Fill	Residential Fill	Residential Fill			
Test / Layer Depths :	175 / 200	175 / 200	175 / 200			
Sampling Method :	AS1289.1.2.1 - cl6.4b	AS1289.1.2.1 - cl6.4b	AS1289.1.2.1 - cl6.4b			
Time :	13:15	15:22	15:29			
Lot Number :	Stage 1	Stage 1	Stage 1			
Location 1 :	E: 316505	E: 316481	E: 316453			
Location 2 :	N: 5842169	N: 5842175	N: 5842173			
Location 3 :	Lift 1	Lift 1	Lift 1			
Location 4 :	See Plans	See Plans	See Plans			
Test Fraction (mm) :	< 19mm	< 19mm	< 19mm			
Oversize Wet :	0%	0%	0%			
Oversize Dry :	0%	0%	0%			
Oversize Density - Dry (t/m ³) :	-	-	-			
Assigned MDR (Yes/No) :	No	No	No			
MDR Sample Number :	S/179675	S/179676	S/179677			
MDR Test Date :	10/02/2023	10/02/2023	10/02/2023			
Soil Description :	Silty Clay. Medium Plasticity, Brown-Grey	Silty Clay. Medium Plasticity, Brown-Grey	Silty Clay. Medium Plasticity, Brown-Grey			
MDR Test Results						
MDD (t/m ³) :	1.61	1.44	1.52			
OMC :	22.0%	27.0%	27.0%			
ADJ MDD (t/m ³) :	-	-	-			
ADJ OMC :	-	-	-			
Moisture Test Results						
Field Moisture Content :	21.0%	26.5%	28.0%			
Moisture Specification :	±2% of OMC	±2% of OMC	±2% of OMC			
Variation from OMC :	1.0% Dry of OMC	0.5% Dry of OMC	1.0% Wet of OMC			
Relative Moisture Ratio (Q250) :	-	-	-			
Moisture Ratio :	95.0%	98.0%	103.5%			
Density Test Results						
Field Dry Density (t/m ³) :	1.56	1.46	1.51			
Density Specification :	95%	95%	95%			
Dry Density Ratio :	97.0%	101.5%	99.5%			
-						
-						
Soil Particle Density (APD) t/m ³ :						
Soil Particle Density (APD) Date :						
Remarks :						
 Accredited for Compliance with ISO / IEC 17025 - Testing Protest Engineering (Melbourne) Accreditation Number - 20511 Base Laboratory Site Number - 24492 - Melbourne Base Laboratory Address - 2/22 Keon Park Parade, Thomastown, VIC, 3076				APPROVED SIGNATORY  Cameron Axon - Signatory		

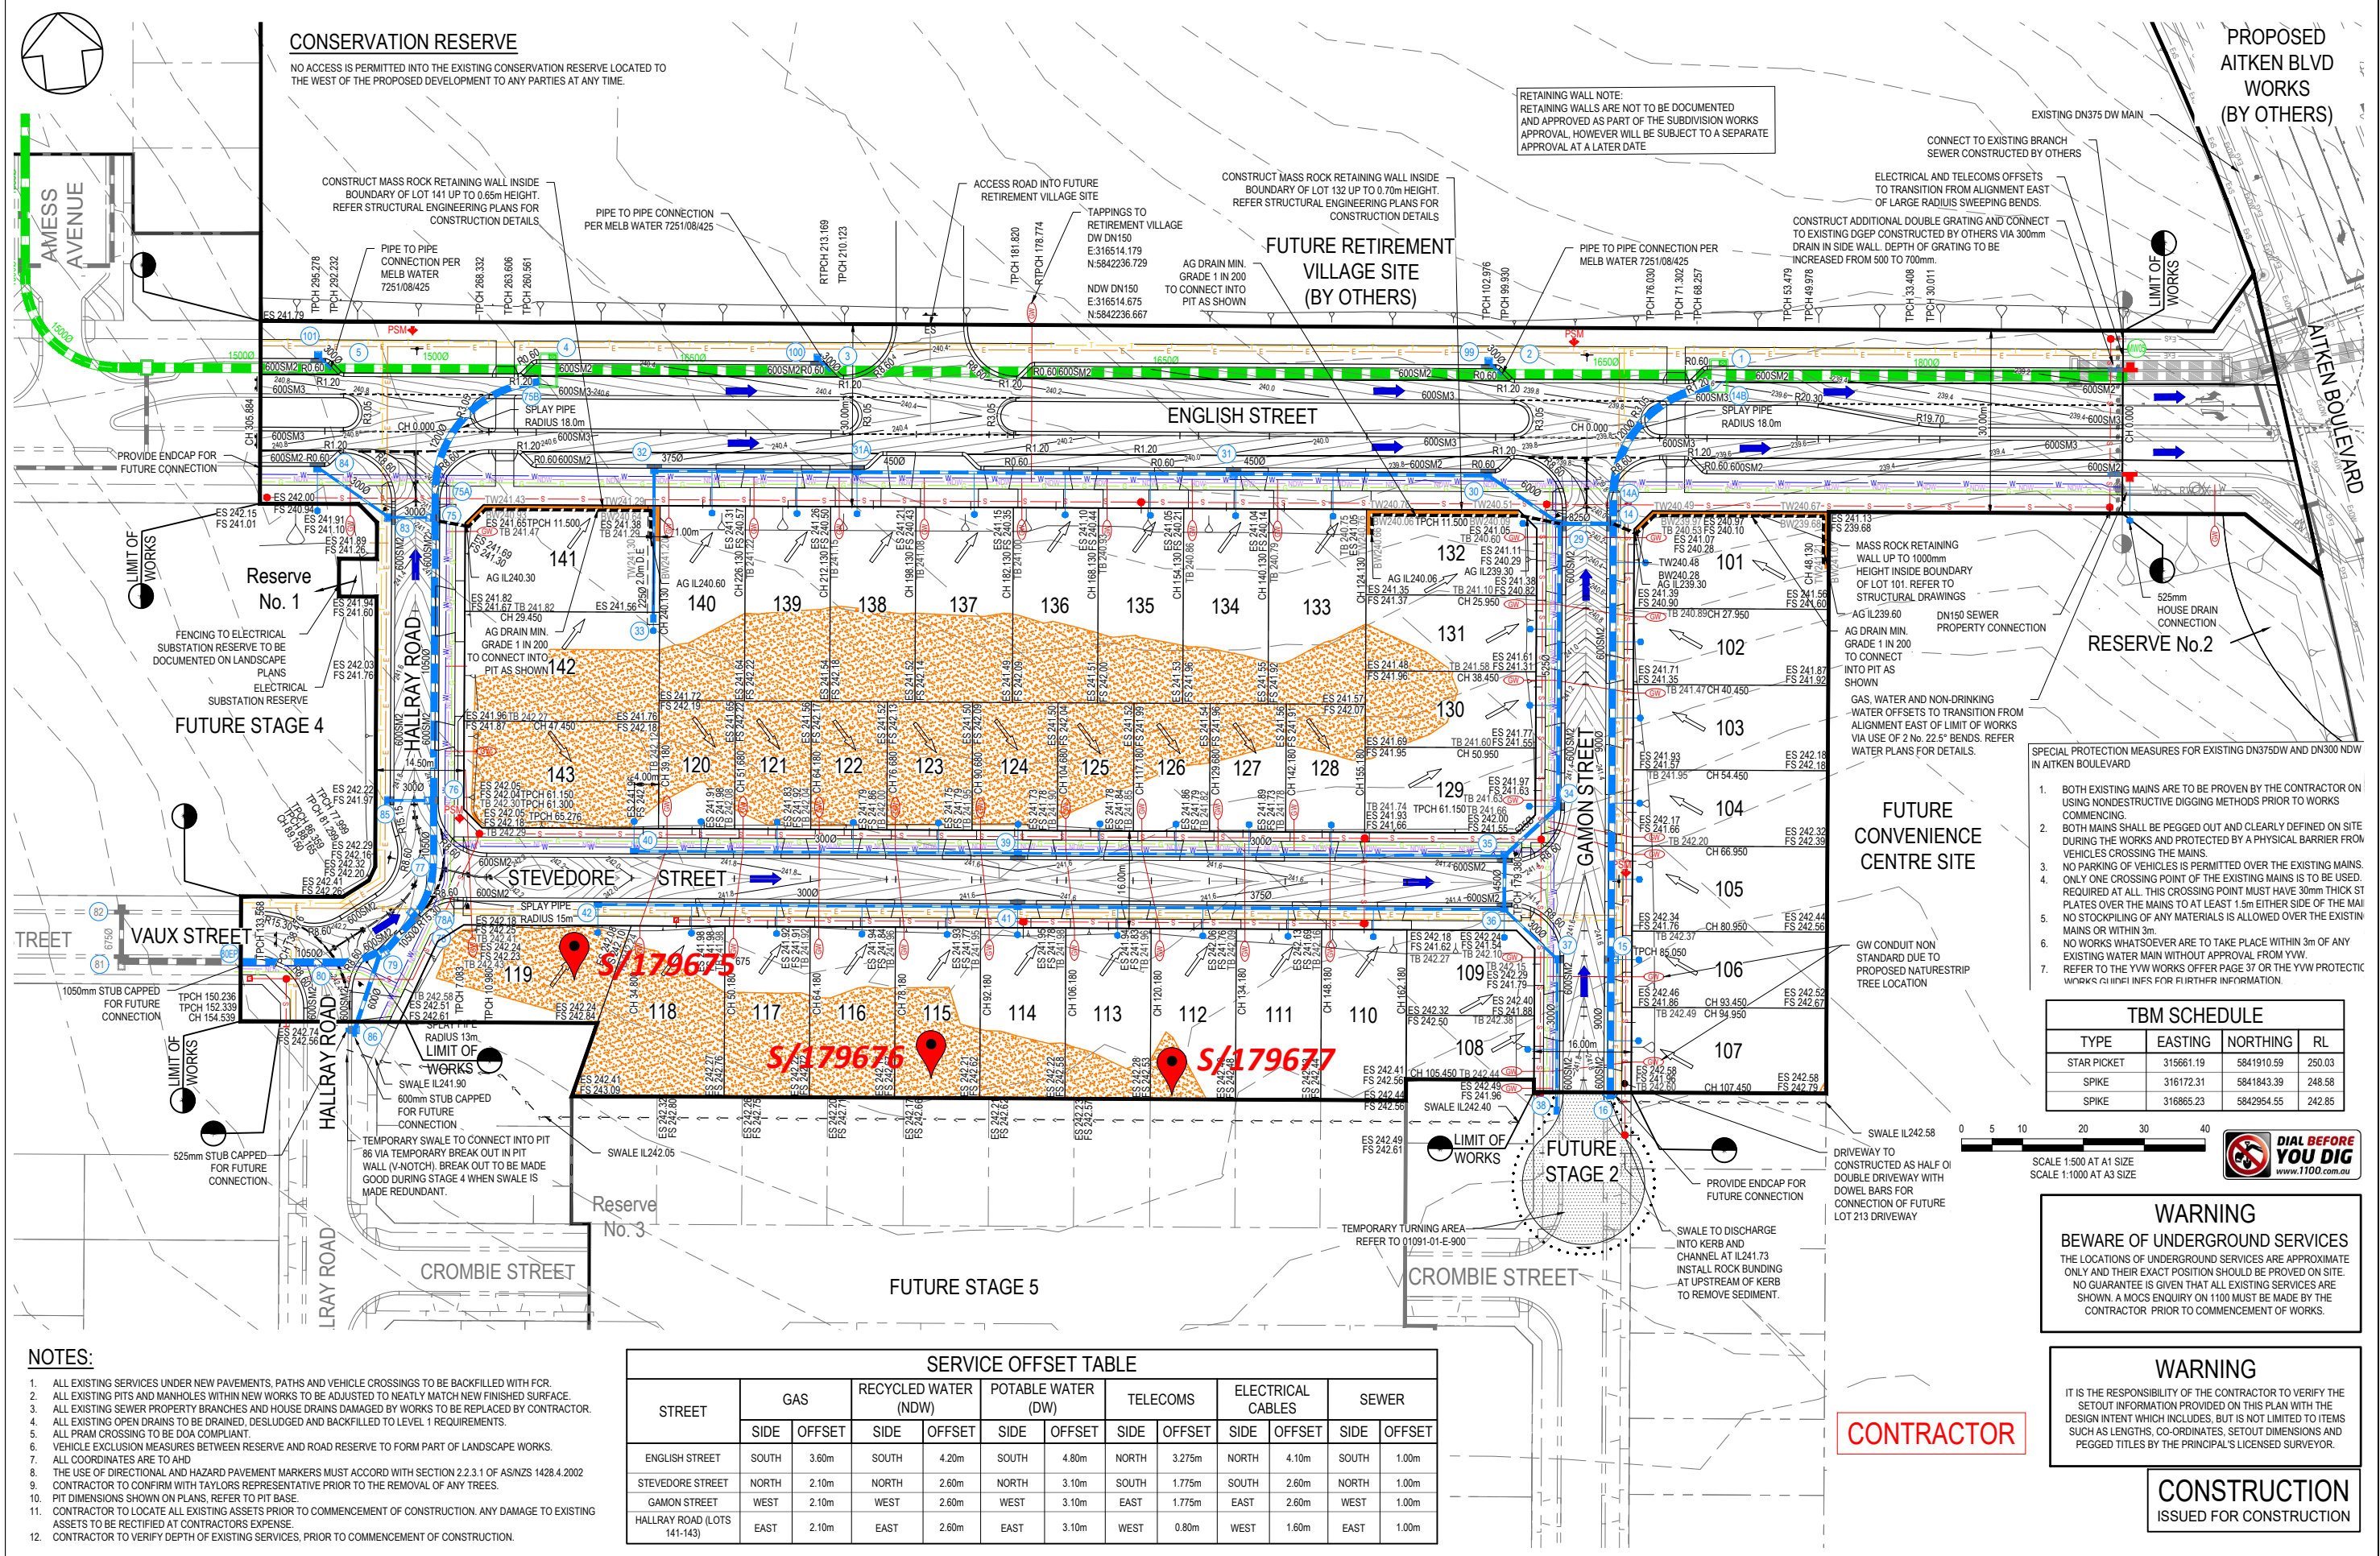

CONSERVATION RESERVE
NO ACCESS IS PERMITTED INTO THE EXISTING CONSERVATION RESERVE LOCATED TO THE WEST OF THE PROPOSED DEVELOPMENT TO ANY PARTIES AT ANY TIME.

RETAINING WALL NOTE:
RETAINING WALLS ARE NOT TO BE DOCUMENTED AND APPROVED AS PART OF THE SUBDIVISION WORKS APPROVAL, HOWEVER WILL BE SUBJECT TO A SEPARATE APPROVAL AT A LATER DATE

PROPOSED AITKEN BLVD WORKS (BY OTHERS)

FUTURE RETIREMENT VILLAGE SITE (BY OTHERS)

CONNECT TO EXISTING BRANCH SEWER CONSTRUCTED BY OTHERS

ELECTRICAL AND TELECOMS OFFSETS TO TRANSITION FROM ALIGNMENT EAST OF LARGE RADIUS SWEEPING BENDS.

CONSTRUCT ADDITIONAL DOUBLE GRATING AND CONNECT TO EXISTING DGEF CONSTRUCTED BY OTHERS VIA 300mm DRAIN IN SIDE WALL. DEPTH OF GRATING TO BE INCREASED FROM 500 TO 700mm.

MASS ROCK RETAINING WALL UP TO 1000mm HEIGHT INSIDE BOUNDARY OF LOT 101. REFER TO STRUCTURAL DRAWINGS


AG IL239.60
AG DRAIN MIN. GRADE 1 IN 200 TO CONNECT INTO PIT AS SHOWN

GAS, WATER AND NON-DRINKING WATER OFFSETS TO TRANSITION FROM ALIGNMENT EAST OF LIMIT OF WORKS VIA USE OF 2 No. 22.5° BENDS. REFER WATER PLANS FOR DETAILS.

SPECIAL PROTECTION MEASURES FOR EXISTING DN375DW AND DN300 NDW IN AITKEN BOULEVARD

- BOTH EXISTING MAINS ARE TO BE PROVEN BY THE CONTRACTOR ON USING NONDESTRUCTIVE DIGGING METHODS PRIOR TO WORKS COMMENCING
- BOTH MAINS SHALL BE PEGGED OUT AND CLEARLY DEFINED ON SITE DURING THE WORKS AND PROTECTED BY A PHYSICAL BARRIER FROM VEHICLES CROSSING THE MAINS.
- NO PARKING OF VEHICLES IS PERMITTED OVER THE EXISTING MAINS.
- ONLY ONE CROSSING POINT OF THE EXISTING MAINS IS TO BE USED. REQUIRED AT ALL. THIS CROSSING POINT MUST HAVE 30mm THICK ST PLATES OVER THE MAINS TO AT LEAST 1.5m EITHER SIDE OF THE MAINS OR WITHIN 3m.
- NO STOCKPILING OF ANY MATERIALS IS ALLOWED OVER THE EXISTING MAINS OR WITHIN 3m.
- NO WORKS WHATSOEVER ARE TO TAKE PLACE WITHIN 3m OF ANY EXISTING WATER MAIN WITHOUT APPROVAL FROM YVW.
- REFER TO THE YVW WORKS OFFER PAGE 37 OR THE YVW PROTECTIVE WORKS (PI) INF PLANES FOR FURTHER INFORMATION.

TYPE	EASTING	NORTHING	RL
STAR PICKET	315661.19	5841910.59	250.03
SPIKE	316172.31	5841843.39	248.58
SPIKE	316865.23	5842954.55	242.85

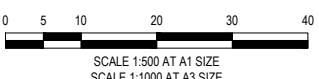

WARNING
BEWARE OF UNDERGROUND SERVICES
THE LOCATIONS OF UNDERGROUND SERVICES ARE APPROXIMATE ONLY AND THEIR EXACT POSITION SHOULD BE PROVED ON SITE. NO GUARANTEE IS GIVEN THAT ALL EXISTING SERVICES ARE SHOWN. A MOCS ENQUIRY ON 1100 MUST BE MADE BY THE CONTRACTOR PRIOR TO COMMENCEMENT OF WORKS.

WARNING
IT IS THE RESPONSIBILITY OF THE CONTRACTOR TO VERIFY THE SETOUT INFORMATION PROVIDED ON THIS PLAN WITH THE DESIGN INTENT WHICH INCLUDES, BUT IS NOT LIMITED TO ITEMS SUCH AS LENGTHS, CO-ORDINATES, SETOUT DIMENSIONS AND PEGGED TITLES BY THE PRINCIPAL'S LICENSED SURVEYOR.

CONSTRUCTION
ISSUED FOR CONSTRUCTION

CONTRACTOR

- NOTES:**
- ALL EXISTING SERVICES UNDER NEW PAVEMENTS, PATHS AND VEHICLE CROSSINGS TO BE BACKFILLED WITH FCR.
 - ALL EXISTING PITS AND MANHOLES WITHIN NEW WORKS TO BE ADJUSTED TO NEATLY MATCH NEW FINISHED SURFACE.
 - ALL EXISTING SEWER PROPERTY BRANCHES AND HOUSE DRAINS DAMAGED BY WORKS TO BE REPLACED BY CONTRACTOR.
 - ALL EXISTING OPEN DRAINS TO BE DRAINED, DESLUDGED AND BACKFILLED TO LEVEL 1 REQUIREMENTS.
 - ALL PRAM CROSSING TO BE DOA COMPLIANT.
 - VEHICLE EXCLUSION MEASURES BETWEEN RESERVE AND ROAD RESERVE TO FORM PART OF LANDSCAPE WORKS.
 - ALL COORDINATES ARE TO AHD
 - THE USE OF DIRECTIONAL AND HAZARD PAVEMENT MARKERS MUST ACCORD WITH SECTION 2.2.3.1 OF AS/NZS 1428.4:2002
 - CONTRACTOR TO CONFIRM WITH TAYLORS REPRESENTATIVE PRIOR TO THE REMOVAL OF ANY TREES.
 - PIT DIMENSIONS SHOWN ON PLANS. REFER TO PIT BASE.
 - CONTRACTOR TO LOCATE ALL EXISTING ASSETS PRIOR TO COMMENCEMENT OF CONSTRUCTION. ANY DAMAGE TO EXISTING ASSETS TO BE RECTIFIED AT CONTRACTORS EXPENSE.
 - CONTRACTOR TO VERIFY DEPTH OF EXISTING SERVICES, PRIOR TO COMMENCEMENT OF CONSTRUCTION.

STREET	GAS		RECYCLED WATER (NDW)		POTABLE WATER (DW)		TELECOMS		ELECTRICAL CABLES		SEWER	
	SIDE	OFFSET	SIDE	OFFSET	SIDE	OFFSET	SIDE	OFFSET	SIDE	OFFSET	SIDE	OFFSET
ENGLISH STREET	SOUTH	3.60m	SOUTH	4.20m	SOUTH	4.80m	NORTH	3.275m	NORTH	4.10m	SOUTH	1.00m
STEVEDORE STREET	NORTH	2.10m	NORTH	2.60m	NORTH	3.10m	SOUTH	1.775m	SOUTH	2.60m	NORTH	1.00m
GAMON STREET	WEST	2.10m	WEST	2.60m	WEST	3.10m	EAST	1.775m	EAST	2.60m	WEST	1.00m
HALLRAY ROAD (LOTS 141-143)	EAST	2.10m	EAST	2.60m	EAST	3.10m	WEST	0.80m	WEST	1.60m	EAST	1.00m

VER	DATE	REVISION	APPD.
0	20/12/2022	ISSUED FOR CONSTRUCTION	SJP

EXISTING		PROPOSED		FILLING ON LOTS DEEPER THAN 200mm	
EXISTING GAS MAIN	EiG	PROPOSED GAS MAIN	G	TGSI (TACTILE GROUND SURFACE INDICATORS)	
EXISTING WATER MAIN	EiW	PROPOSED WATER MAIN	W	EXISTING SURFACE LEVEL	ESS1.260
EXISTING ELECTRICITY CABLE	EiE	PROPOSED ELECTRICITY CABLE	E	FINISHED SURFACE LEVEL	FSS1.046
EXISTING TELCO CABLE & PIT	EiT	PROPOSED TELCO CABLE	T	FINISHED SURFACE BATTER	TBS1.296
EXISTING SEWER MAIN & M.H.	EiS	PROPOSED SEWER MAIN & M.H.	S	TOP OF WALL FINISHED SURFACE LEVEL	TW025.33
EXISTING DRAIN & PIT	EiD	PROPOSED DRAIN PIT & PROPERTY PIT	D	BOTTOM OF WALL FINISHED SURFACE LEVEL	BW024.25
PROPOSED GAS & WATER CONDUIT	CW	STREET NAME SIGN	P.S.M.		



TAYLORS
Urban Development | Infrastructure
8/270 Ferntree Gully Road, Notting Hill, Victoria, 3168
Tel: 61 3 9501 2800 | Web: taylors.com.au


DESIGNED: SJP AUTHORIZED: JOY DRAFTED: LAJ
CHECKED: ROK AUTH. DATE: 01/07/2022 CAD REF: 01091-01-E-108

HUME CITY COUNCIL
225 - 285 DONNYBROOK ROAD, MICKLEHAM
MERRIFIELD RESIDENTIAL, STAGE 1
DETAIL LAYOUT PLAN

SCALE 1:500 @ A1
VERSION 0
SHEET 9 OF 38
DRAWING No. 01091-01-E-108

Dry Density / Moisture Ratio Report

Client :	WESTERN CIVIL PTY LTD			Report Number :	SR/PTP/11232 - 2/1	
Client Address :	Geehi Way/2/7, Ravenhall, 3023, VIC			Report Date :	13/02/2023	
Project Name :	Merrifield Residential Stage 1 & 2			Test Request :	-	
Project Number :	PTP/11232			Page 1 of 1		
Location :	Mickleham					
Test Methods :	AS1289.5.4.1, AS1289.5.8.1, AS1289.2.1.1, AS1289.5.1.1,					
Sample Number :	S/179783	S/179784	S/179785			
Date Tested :	3/02/2023	3/02/2023	3/02/2023			
Material Source :	Onsite	Onsite	Onsite			
For use as :	Residential Fill	Residential Fill	Residential Fill			
Test / Layer Depths :	175 / 200	175 / 200	175 / 200			
Sampling Method :	AS1289.1.2.1 - cl6.4b	AS1289.1.2.1 - cl6.4b	AS1289.1.2.1 - cl6.4b			
Time :	08:35	08:42	08:49			
Lot Number :	Stage 1	Stage 1	Stage 1			
Location 1 :	E: 316474	E: 314461	E: 316453			
Location 2 :	N: 5842169	N: 5842176	N: 5842175			
Location 3 :	Finish Level	Finish Level	Finish Level			
Location 4 :	-	-	-			
Test Fraction (mm) :	< 19mm	< 19mm	< 19mm			
Oversize Wet :	0%	0%	0%			
Oversize Dry :	0%	0%	0%			
Oversize Density - Dry (t/m ³) :	-	-	-			
Assigned MDR (Yes/No) :	No	No	No			
MDR Sample Number :	S/179783	S/179784	S/179785			
MDR Test Date :	10/02/2023	10/02/2023	10/02/2023			
Soil Description :	Silty Clay, Medium Plasticity, Grey-Brown	Silty Clay, Medium Plasticity, Grey-Brown	Silty Clay, Medium Plasticity, Grey-Brown			
MDR Test Results						
MDD (t/m ³) :	1.51	1.52	1.49			
OMC :	25.0%	26.0%	24.5%			
ADJ MDD (t/m ³) :	-	-	-			
ADJ OMC :	-	-	-			
Moisture Test Results						
Field Moisture Content :	25.0%	27.5%	26.0%			
Moisture Specification :	±2% of OMC	±2% of OMC	±2% of OMC			
Variation from OMC :	0.0% Dry of OMC	1.0% Wet of OMC	1.0% Wet of OMC			
Relative Moisture Ratio (Q250) :	-	-	-			
Moisture Ratio :	99.0%	104.5%	105.0%			
Density Test Results						
Field Dry Density (t/m ³) :	1.50	1.57	1.53			
Density Specification :	95%	95%	95%			
Dry Density Ratio :	99.5%	103.5%	103.0%			
-						
-						
Soil Particle Density (APD) t/m ³ :						
Soil Particle Density (APD) Date :						
Remarks :						
 Accredited for Compliance with ISO / IEC 17025 - Testing Protest Engineering (Melbourne) Accreditation Number - 20511 Base Laboratory Site Number - 24492 - Melbourne Base Laboratory Address - 2/22 Keon Park Parade, Thomastown, VIC, 3076				APPROVED SIGNATORY  Cameron Axon - Signatory		

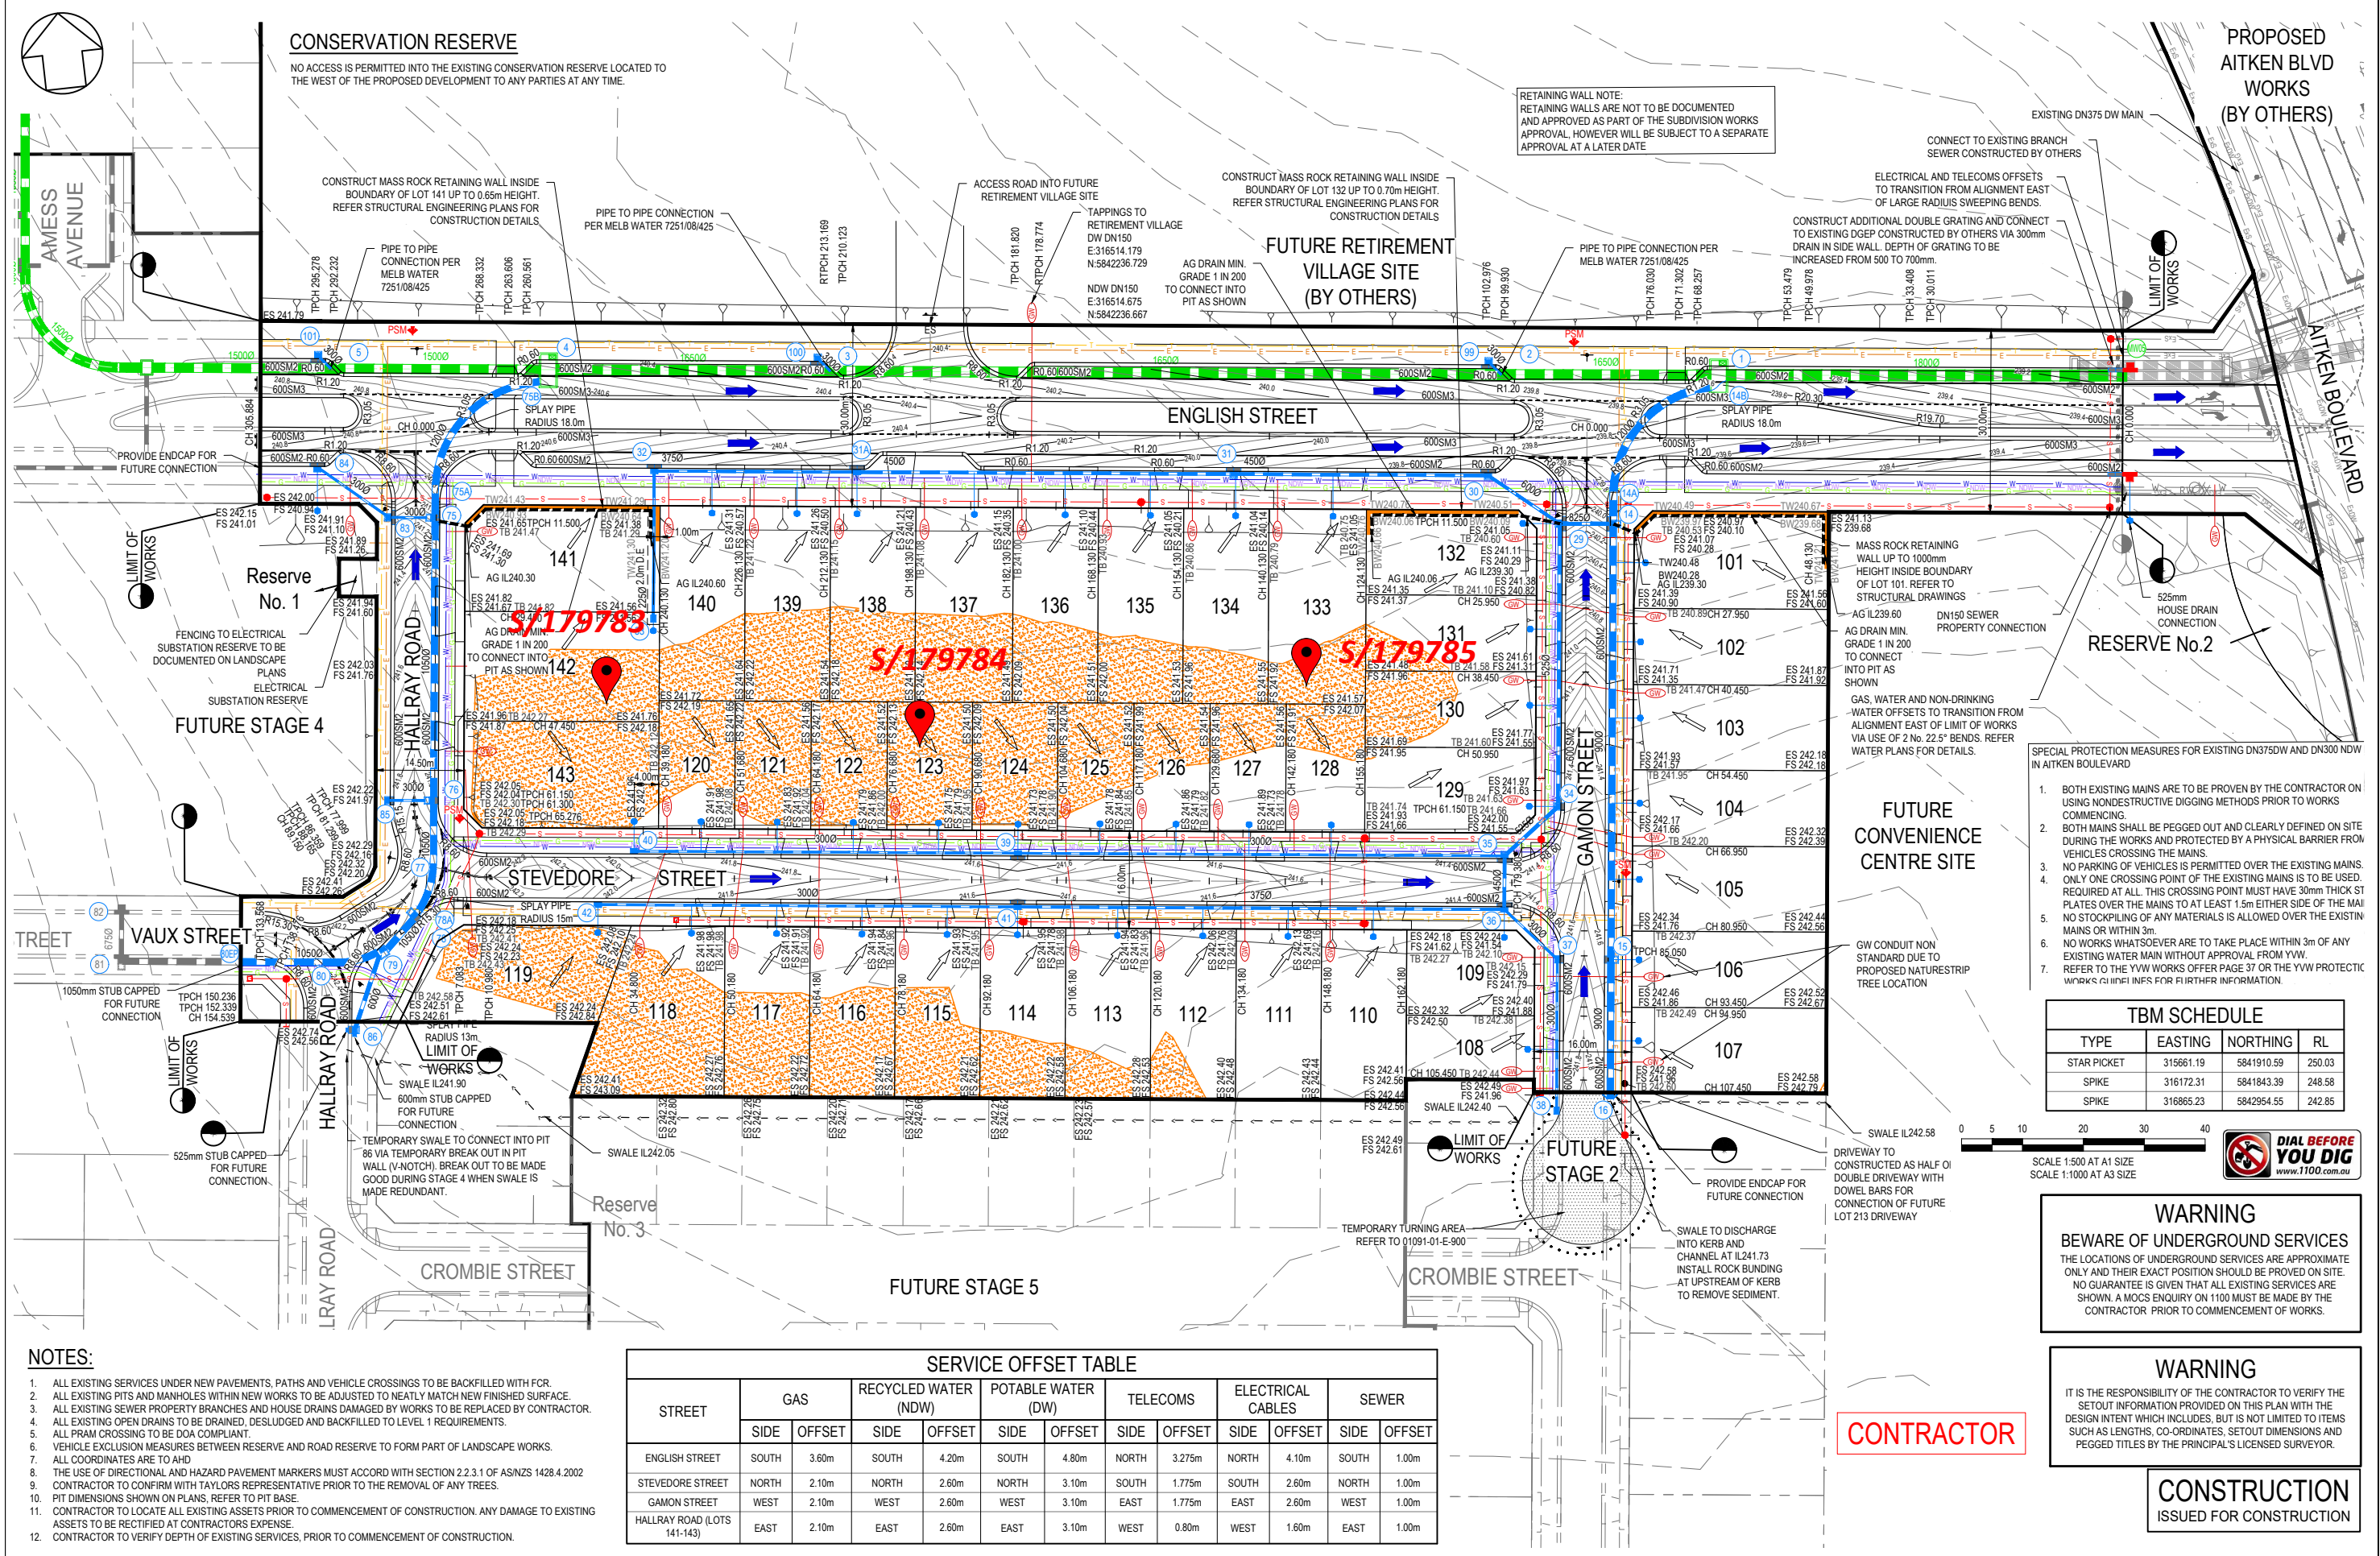

CONSERVATION RESERVE

NO ACCESS IS PERMITTED INTO THE EXISTING CONSERVATION RESERVE LOCATED TO THE WEST OF THE PROPOSED DEVELOPMENT TO ANY PARTIES AT ANY TIME.

RETAINING WALL NOTE:
RETAINING WALLS ARE NOT TO BE DOCUMENTED AND APPROVED AS PART OF THE SUBDIVISION WORKS APPROVAL, HOWEVER WILL BE SUBJECT TO A SEPARATE APPROVAL AT A LATER DATE

PROPOSED AITKEN BLVD WORKS (BY OTHERS)

FUTURE RETIREMENT VILLAGE SITE (BY OTHERS)

CONNECT TO EXISTING BRANCH SEWER CONSTRUCTED BY OTHERS

ELECTRICAL AND TELECOMS OFFSETS TO TRANSITION FROM ALIGNMENT EAST OF LARGE RADIUS SWEEPING BENDS.

CONSTRUCT MASS ROCK RETAINING WALL INSIDE BOUNDARY OF LOT 141 UP TO 0.65m HEIGHT. REFER STRUCTURAL ENGINEERING PLANS FOR CONSTRUCTION DETAILS.

ACCESS ROAD INTO FUTURE RETIREMENT VILLAGE SITE

CONSTRUCT MASS ROCK RETAINING WALL INSIDE BOUNDARY OF LOT 132 UP TO 0.70m HEIGHT. REFER STRUCTURAL ENGINEERING PLANS FOR CONSTRUCTION DETAILS.

TAPPINGS TO RETIREMENT VILLAGE DW DN150 E:316514.179 N:5842236.729 NDW DN150 E:316514.675 N:5842236.667

AG DRAIN MIN. GRADE 1 IN 200 TO CONNECT INTO PIT AS SHOWN

PIPE TO PIPE CONNECTION PER MELB WATER 7251/08/425

CONSTRUCT ADDITIONAL DOUBLE GRATING AND CONNECT TO EXISTING DGEF CONSTRUCTED BY OTHERS VIA 300mm DRAIN IN SIDE WALL. DEPTH OF GRATING TO BE INCREASED FROM 500 TO 700mm.

EXISTING DN375 DW MAIN

LIMIT OF WORKS

AITKEN BOULEVARD

ENGLISH STREET

Reserve No. 1

FUTURE STAGE 4

VAUX STREET

HALLRAY ROAD

LIMIT OF WORKS

RESERVE No. 3

CROMBIE STREET

HALLRAY ROAD

RESERVE No. 2

FUTURE STAGE 5

CROMBIE STREET

STEVEDORE STREET

GAMON STREET

FUTURE STAGE 2

PROVIDE END CAP FOR FUTURE CONNECTION

SWALE IL242.58

DRIVEWAY TO CONSTRUCT AS HALF OF DOUBLE DRIVEWAY WITH DOWEL BARS FOR CONNECTION OF FUTURE LOT 213 DRIVEWAY

SWALE TO DISCHARGE INTO KERB AND CHANNEL AT IL241.73. INSTALL ROCK BUNDING AT UPSTREAM OF KERB TO REMOVE SEDIMENT.

TEMPORARY TURNING AREA REFER TO 01091-01-E-900

TEMPORARY SWALE TO CONNECT INTO PIT 86 VIA TEMPORARY BREAK OUT IN PIT WALL (V-NOTCH). BREAK OUT TO BE MADE GOOD DURING STAGE 4 WHEN SWALE IS MADE REDUNDANT.

600mm STUB CAPPED FOR FUTURE CONNECTION

SWALE IL241.90

RADIUS 13m

LIMIT OF WORKS

525mm STUB CAPPED FOR FUTURE CONNECTION

1050mm STUB CAPPED FOR FUTURE CONNECTION

TPCH 152.339

TPCH 154.539

TPCH 150.236






Dry Density / Moisture Ratio Report

Client :	WESTERN CIVIL PTY LTD			Report Number :	SR/PTP/11232 - 3/1	
Client Address :	Geehi Way/2/7, Ravenhall, 3023, VIC			Report Date :	14/02/2023	
Project Name :	Merrifield Residential Stage 1 & 2			Test Request :	-	
Project Number :	PTP/11232			Page 1 of 1		
Location :	Mickleham					
Test Methods :	AS1289.5.4.1, AS1289.5.8.1, AS1289.2.1.1, AS1289.5.1.1,					
Sample Number :	S/180382	S/180383	S/180384			
Date Tested :	7/02/2023	7/02/2023	7/02/2023			
Material Source :	Onsite	Onsite	Onsite			
For use as :	General Fill	General Fill	General Fill			
Test / Layer Depths :	175 / 200	175 / 200	175 / 200			
Sampling Method :	AS1289.1.2.1 - cl6.4b	AS1289.1.2.1 - cl6.4b	AS1289.1.2.1 - cl6.4b			
Time :	14:35	14:45	14:55			
Lot Number :	Stage 1	Stage 1	Stage 1			
Location 1 :	E: 316492	E: 316469	E: 316417			
Location 2 :	N: 5842120	N: 5842121	N: 5842134			
Location 3 :	Lift 1	Lift 2	Lift 2			
Location 4 :	See Plans	See Plans	See Plans			
Test Fraction (mm) :	< 19mm	< 19mm	< 19mm			
Oversize Wet :	0%	0%	0%			
Oversize Dry :	0%	0%	0%			
Oversize Density - Dry (t/m ³) :	-	-	-			
Assigned MDR (Yes/No) :	No	No	No			
MDR Sample Number :	S/180382	S/180383	S/180384			
MDR Test Date :	13/02/2023	13/02/2023	13/02/2023			
Soil Description :	Silty Clay, Medium to High Plasticity, Brown	Silty Clay, Medium to High Plasticity, Brown	Silty Clay, Medium to High Plasticity, Brown			
MDR Test Results						
MDD (t/m ³) :	1.52	1.49	1.49			
OMC :	25.5%	24.5%	25.5%			
ADJ MDD (t/m ³) :	-	-	-			
ADJ OMC :	-	-	-			
Moisture Test Results						
Field Moisture Content :	25.0%	24.0%	23.5%			
Moisture Specification :	±2% of OMC	±2% of OMC	±2% of OMC			
Variation from OMC :	1.0% Dry of OMC	0.5% Dry of OMC	2.0% Dry of OMC			
Relative Moisture Ratio (Q250) :	-	-	-			
Moisture Ratio :	97.0%	98.5%	92.0%			
Density Test Results						
Field Dry Density (t/m ³) :	1.52	1.54	1.47			
Density Specification :	95%	95%	95%			
Dry Density Ratio :	99.5%	103.5%	98.5%			
-						
Soil Particle Density (APD) t/m ³ :						
Soil Particle Density (APD) Date :						
Remarks :						
 Accredited for Compliance with ISO / IEC 17025 - Testing Protest Engineering (Melbourne) Accreditation Number - 20511 Base Laboratory Site Number - 24492 - Melbourne Base Laboratory Address - 2/22 Keon Park Parade, Thomastown, VIC, 3076				APPROVED SIGNATORY  Cameron Axon - Signatory		

REFER RIGHT FOR CONTINUATION

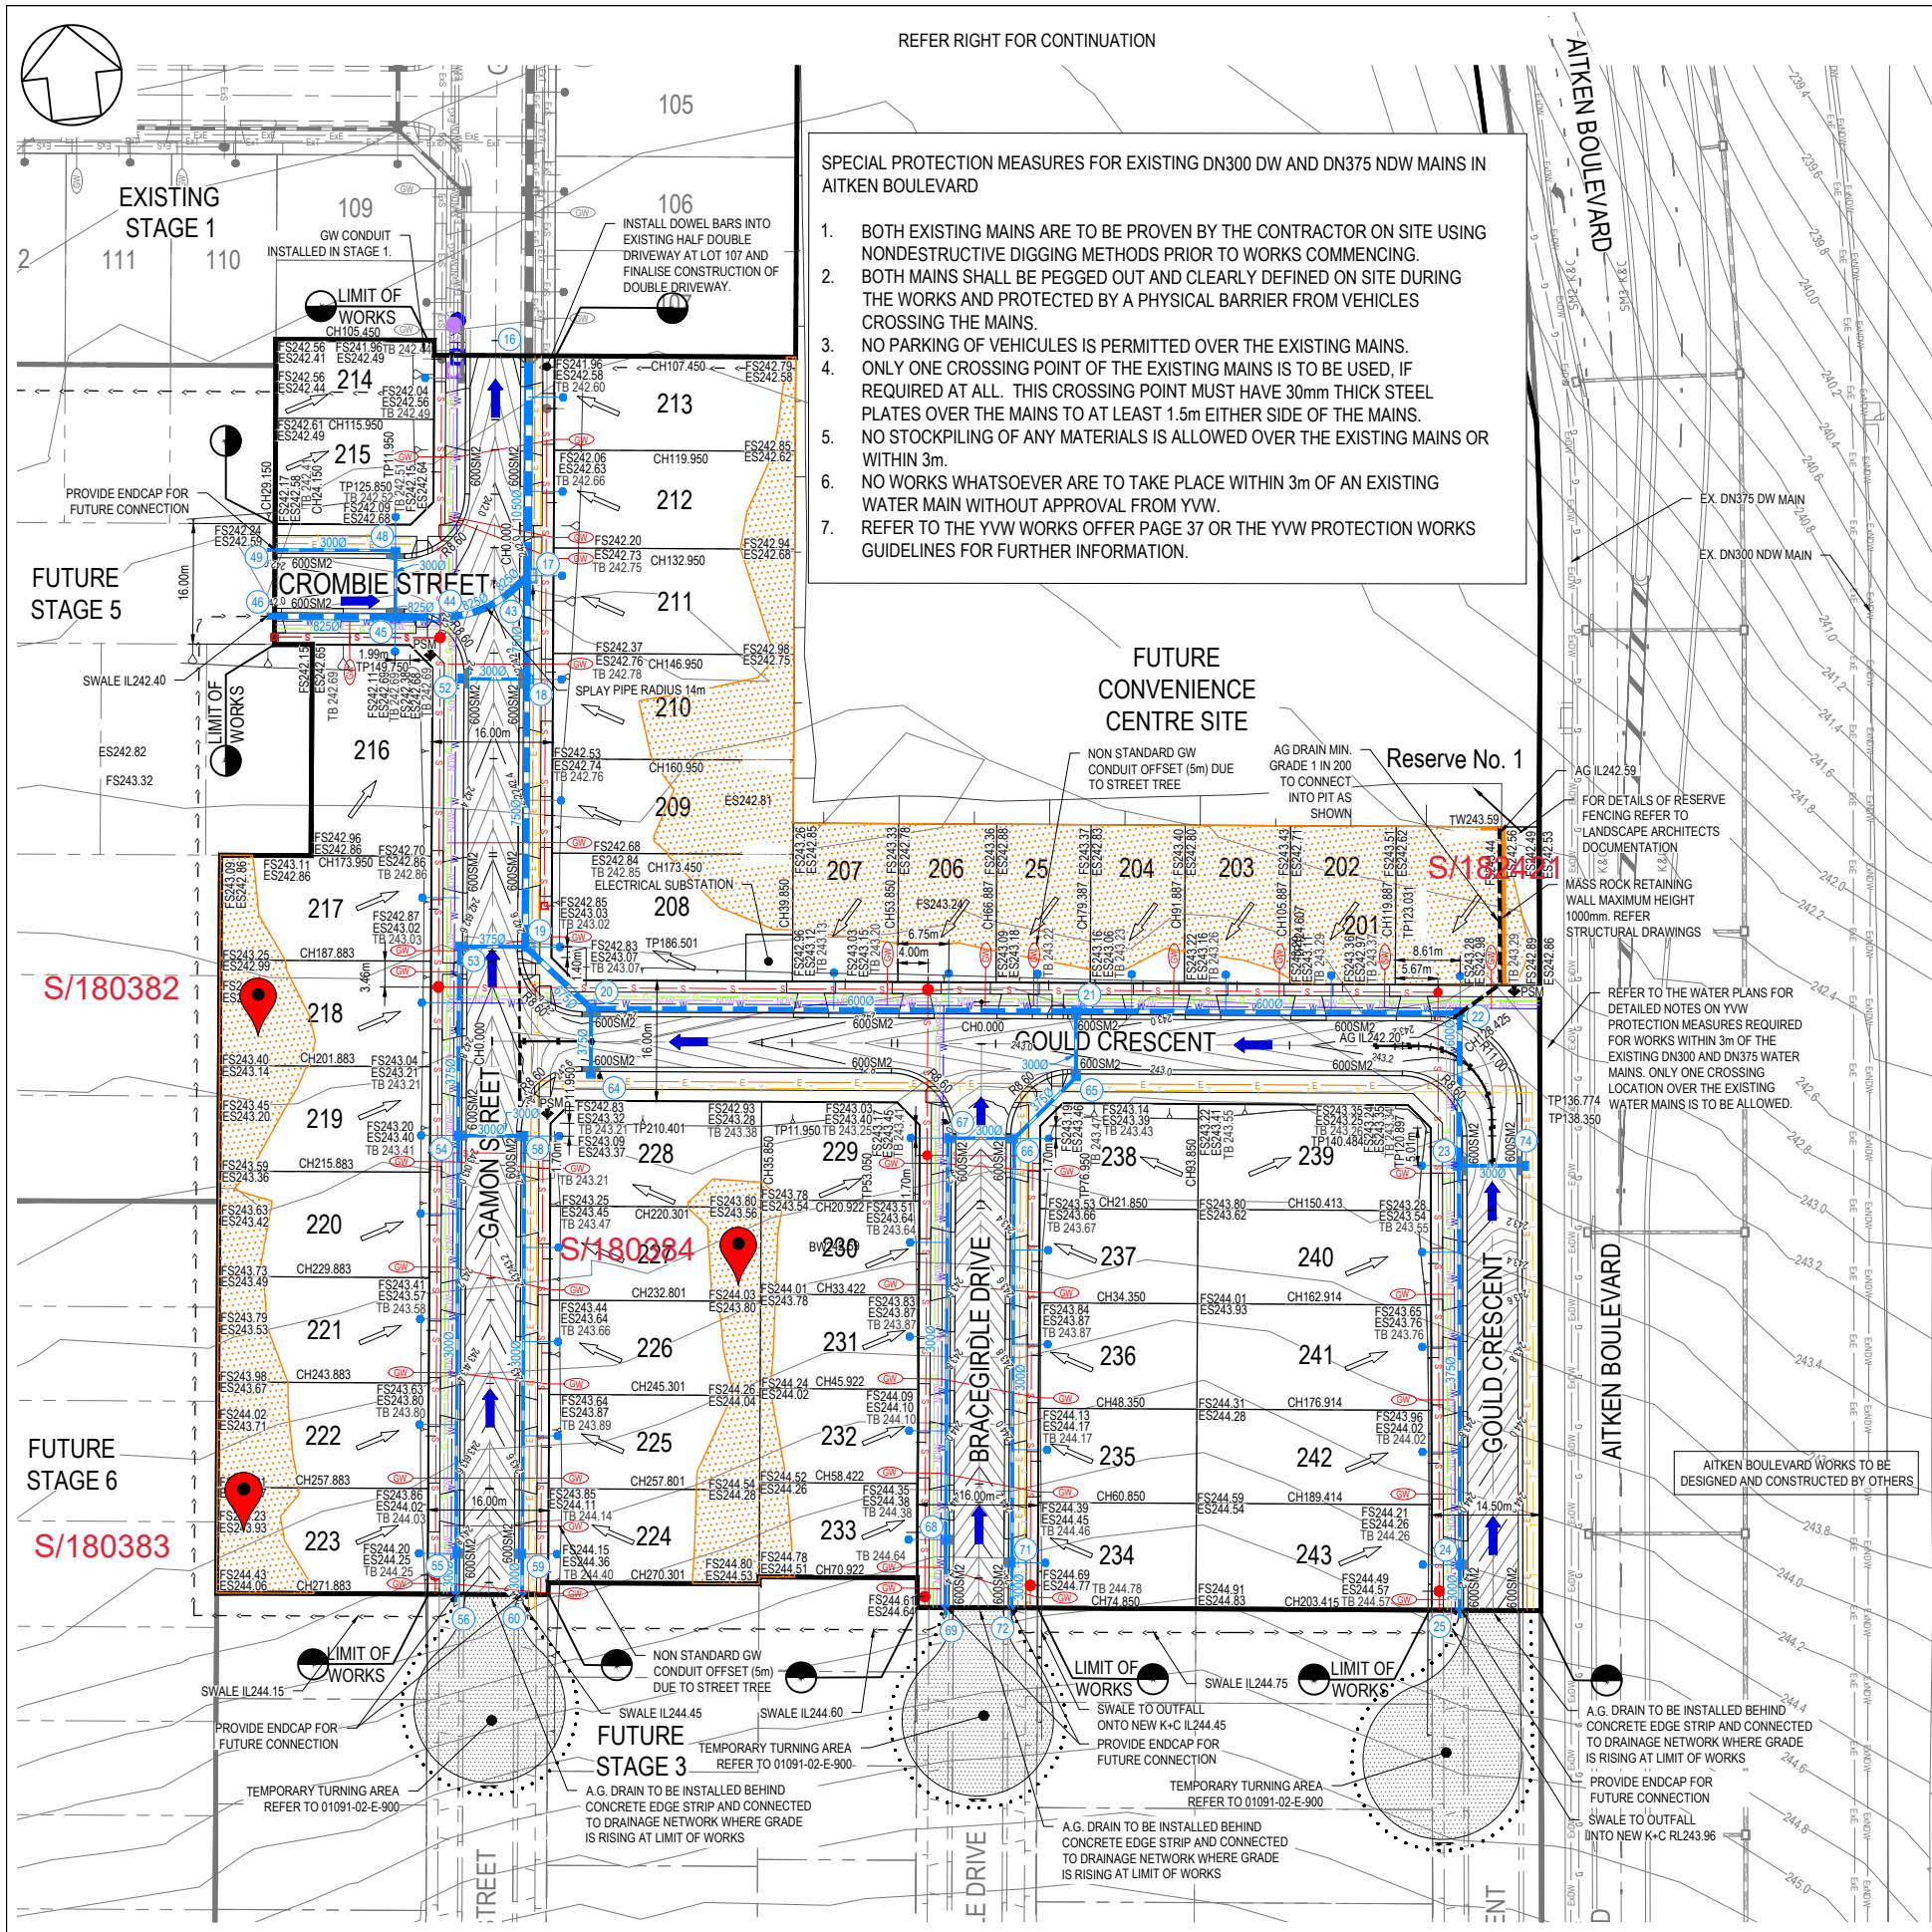

SPECIAL PROTECTION MEASURES FOR EXISTING DN300 DW AND DN375 NDW MAINS IN AITKEN BOULEVARD

- BOTH EXISTING MAINS ARE TO BE PROVEN BY THE CONTRACTOR ON SITE USING NONDESTRUCTIVE DIGGING METHODS PRIOR TO WORKS COMMENCING.
- BOTH MAINS SHALL BE PEGGED OUT AND CLEARLY DEFINED ON SITE DURING THE WORKS AND PROTECTED BY A PHYSICAL BARRIER FROM VEHICLES CROSSING THE MAINS.
- NO PARKING OF VEHICLES IS PERMITTED OVER THE EXISTING MAINS. ONLY ONE CROSSING POINT OF THE EXISTING MAINS IS TO BE USED, IF REQUIRED AT ALL. THIS CROSSING POINT MUST HAVE 30mm THICK STEEL PLATES OVER THE MAINS TO AT LEAST 1.5m EITHER SIDE OF THE MAINS.
- NO STOCKPILING OF ANY MATERIALS IS ALLOWED OVER THE EXISTING MAINS OR WITHIN 3m.
- NO WORKS WHATSOEVER ARE TO TAKE PLACE WITHIN 3m OF AN EXISTING WATER MAIN WITHOUT APPROVAL FROM YVW.
- REFER TO THE YVW WORKS OFFER PAGE 37 OR THE YVW PROTECTION WORKS GUIDELINES FOR FURTHER INFORMATION.


CONSERVATION RESERVE

NO ACCESS IS PERMITTED INTO THE EXISTING CONSERVATION RESERVE LOCATED TO THE WEST OF THE PROPOSED DEVELOPMENT TO ANY PARTIES AT ANY TIME.

NOTES:

- ALL EXISTING SERVICES UNDER NEW PAVEMENTS, PATHS AND VEHICLE CROSSINGS TO BE BACKFILLED WITH FC9.
- ALL EXISTING PITS AND MANHOLES WITHIN NEW WORKS TO BE ADJUSTED TO NEATLY MATCH NEW FINISHED SURFACE.
- ALL EXISTING SEWER PROPERTY BRANCHES AND HOUSE DRAINS DAMAGED BY WORKS TO BE REPLACED BY CONTRACTOR.
- ALL EXISTING OPEN DRAINS TO BE DRAINED, DESLUDGED AND BACKFILLED TO LEVEL 1 REQUIREMENTS.
- ALL PRAM CROSSING TO BE DOA COMPLIANT.
- VEHICLE EXCLUSION MEASURES BETWEEN RESERVE AND ROAD RESERVE TO FORM PART OF LANDSCAPE WORKS.
- ALL COORDINATES ARE TO AHD.
- THE USE OF DIRECTIONAL AND HAZARD PAVEMENT MARKERS MUST ACCORD WITH SECTION 2.2.3.1 OF AS/NZS 1428.4:2002.
- CONTRACTOR TO CONFIRM WITH TAYLORS REPRESENTATIVE PRIOR TO THE REMOVAL OF ANY TREES.
- PIT DIMENSIONS SHOWN ON PLANS. REFER TO PIT BASE.
- CONTRACTOR TO LOCATE ALL EXISTING ASSETS PRIOR TO COMMENCEMENT OF CONSTRUCTION. ANY DAMAGE TO EXISTING ASSETS TO BE RECTIFIED AT CONTRACTORS EXPENSE.
- CONTRACTOR TO VERIFY DEPTH OF EXISTING SERVICES, PRIOR TO COMMENCEMENT OF CONSTRUCTION.

TBM SCHEDULE			
TYPE	EASTING	NORTHING	RL
STAR PICKET	316661.19	5841910.59	250.03
SPIKE	316172.31	5841843.39	248.58
SPIKE	316865.23	5842954.55	242.85

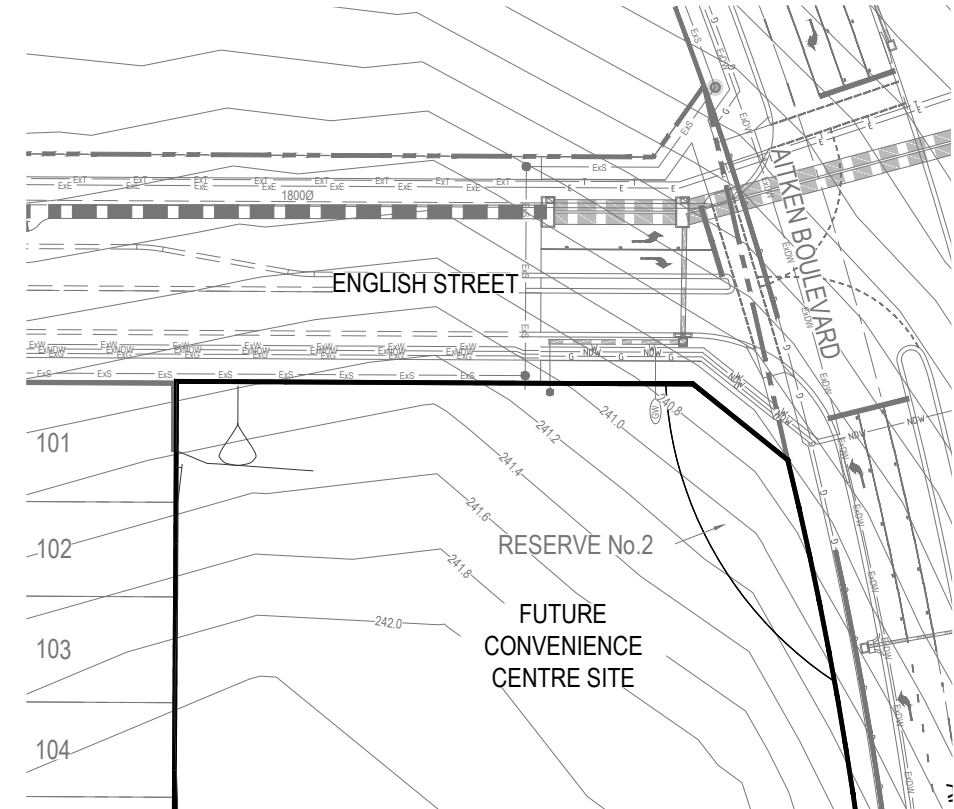


RETAINING WALL NOTE: RETAINING WALLS ARE NOT TO BE DOCUMENTED AND APPROVED AS PART OF THE SUBDIVISIONAL WORKS APPROVAL, HOWEVER WILL BE SUBJECT TO A SEPARATE APPROVAL AT A LATER DATE.

REFER LEFT FOR CONTINUATION

WARNING
 BEWARE OF UNDERGROUND SERVICES
 THE LOCATIONS OF UNDERGROUND SERVICES ARE APPROXIMATE ONLY AND THEIR EXACT POSITION SHOULD BE PROVED ON SITE. NO GUARANTEE IS GIVEN THAT ALL EXISTING SERVICES ARE SHOWN. A MOCS ENQUIRY ON 1100 MUST BE MADE BY THE CONTRACTOR PRIOR TO COMMENCEMENT OF WORKS.

WARNING
 IT IS THE RESPONSIBILITY OF THE CONTRACTOR TO VERIFY THE SETOUT INFORMATION PROVIDED ON THIS PLAN WITH THE DESIGN INTENT WHICH INCLUDES, BUT IS NOT LIMITED TO ITEMS SUCH AS LENGTHS, CO-ORDINATES, SETOUT DIMENSIONS AND PEGGED TITLES BY THE PRINCIPAL'S LICENSED SURVEYOR.

CONTRACTOR

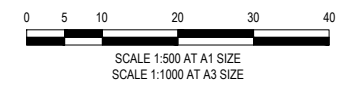

CONSTRUCTION
ISSUED FOR CONSTRUCTION

VER	DATE	REVISION	APPD.
0	20/12/2022	ISSUED FOR CONSTRUCTION	SJP

EXISTING		PROPOSED		P.S.M.	
EXISTING GAS MAIN	— Eg	PROPOSED GAS MAIN	— W	FILLING ON LOTS DEEPER THAN 200mm	—
EXISTING WATER MAIN	— Ew	PROPOSED WATER MAIN	— W	EXISTING SURFACE LEVEL	— SS1 260
EXISTING ELECTRICITY CABLE	— E	PROPOSED ELECTRICITY CABLE	— E	FINISHED SURFACE LEVEL	— FS1 046
EXISTING TELCO CABLE & PIT	— Et	PROPOSED TELCO CABLE	— T	FINISHED SURFACE BATTER	— TB1 296
EXISTING SEWER MAIN & M.H.	— Es	PROPOSED SEWER MAIN & M.H.	— S	PROPOSED DRAIN PIT & PROPERTY SET	—
EXISTING DRAIN & PIT	— Ed	PROPOSED DRAIN PIT & PROPERTY SET	—	STREET NAME SIGN	—
PROPOSED GAS & WATER CONDUIT	— Cw				



TAYLORS
 Urban Development | Infrastructure
 8/270 Ferntree Gully Road, Notting Hill, Victoria, 3168
 Tel: 61 3 9501 2800 | Web: taylors.com.au

DESIGNED: EST AUTHORIZED: JOY DRAFTED: PGV
 CHECKED: SJP AUTH. DATE: 27/06/2022 CAD REF: 01091-02-E-107


HUME CITY COUNCIL
 225 - 285 DONNYBROOK ROAD, MICKLEHAM
 MERRIFIELD RESIDENTIAL, STAGE 2
 DETAIL LAYOUT PLAN

SCALE 1:500 @ A1
 VERSION 0
 SHEET 8 OF 26
 DRAWING No. 01091-02-E-107

Dry Density / Moisture Ratio Report

Client :	WESTERN CIVIL PTY LTD			Report Number :	SR/PTP/11232 - 4/1	
Client Address :	Geehi Way/2/7, Ravenhall, 3023, VIC			Report Date :	28/02/2023	
Project Name :	Merrifield Residential Stage 1 & 2			Test Request :	-	
Project Number :	PTP/11232			Page 1 of 1		
Location :	Mickleham					
Test Methods :	AS1289.5.4.1, AS1289.5.8.1, AS1289.2.1.1, AS1289.5.1.1,					
Sample Number :	S/182421	S/182422	S/182423			
Date Tested :	20/02/2023	20/02/2023	20/02/2023			
Material Source :	Onsite	Onsite	Onsite			
For use as :	Residential Fill	Residential Fill	Residential Fill			
Test / Layer Depths :	175 / 200	175 / 200	175 / 200			
Sampling Method :	AS1289.1.2.1 - cl6.4b	AS1289.1.2.1 - cl6.4b	AS1289.1.2.1 - cl6.4b			
Time :	14:35	14:42	14:49			
Lot Number :	Housing Lot	Housing Lot	Housing Lot			
Location 1 :	E: 316555	E: 316554	E: 316557			
Location 2 :	N: 5841991	N: 5841971	N: 5841957			
Location 3 :	Lift 1	Lift 1	Lift 1			
Location 4 :	See Plans	See Plans	See Plans			
Test Fraction (mm) :	< 19mm	< 19mm	< 19mm			
Oversize Wet :	0%	0%	0%			
Oversize Dry :	0%	0%	0%			
Oversize Density - Dry (t/m ³) :	-	-	-			
Assigned MDR (Yes/No) :	No	No	No			
MDR Sample Number :	S/182421	S/182422	S/182423			
MDR Test Date :	24/02/2023	24/02/2023	24/02/2023			
Soil Description :	Silty Clay, Medium Plasticity, Grey	Silty Clay, Medium Plasticity, Grey	Silty Clay, Medium Plasticity, Grey			
MDR Test Results						
MDD (t/m ³) :	1.52	1.56	1.57			
OMC :	23.5%	24.0%	23.0%			
ADI MDD (t/m ³) :	-	-	-			
ADI OMC :	-	-	-			
Moisture Test Results						
Field Moisture Content :	23.0%	22.5%	21.5%			
Moisture Specification :	±2% of OMC	±2% of OMC	±2% of OMC			
Variation from OMC :	0.5% Dry of OMC	1.5% Dry of OMC	1.0% Dry of OMC			
Relative Moisture Ratio (Q250) :	-	-	-			
Moisture Ratio :	99.0%	94.5%	95.0%			
Density Test Results						
Field Dry Density (t/m ³) :	1.52	1.54	1.55			
Density Specification :	95%	95%	95%			
Dry Density Ratio :	100.0%	98.5%	98.5%			
-						
Soil Particle Density (APD) t/m ³ :						
Soil Particle Density (APD) Date :						
Remarks :						
 Accredited for Compliance with ISO/ IEC 17025 - Testing Protest Engineering (Melbourne) Accreditation Number - 20511 Base Laboratory Site Number - 24492 - Melbourne Base Laboratory Address - 2/22 Keon Park Parade, Thomastown, VIC, 3076				APPROVED SIGNATORY  Cameron Axon - Signatory		

REFER RIGHT FOR CONTINUATION

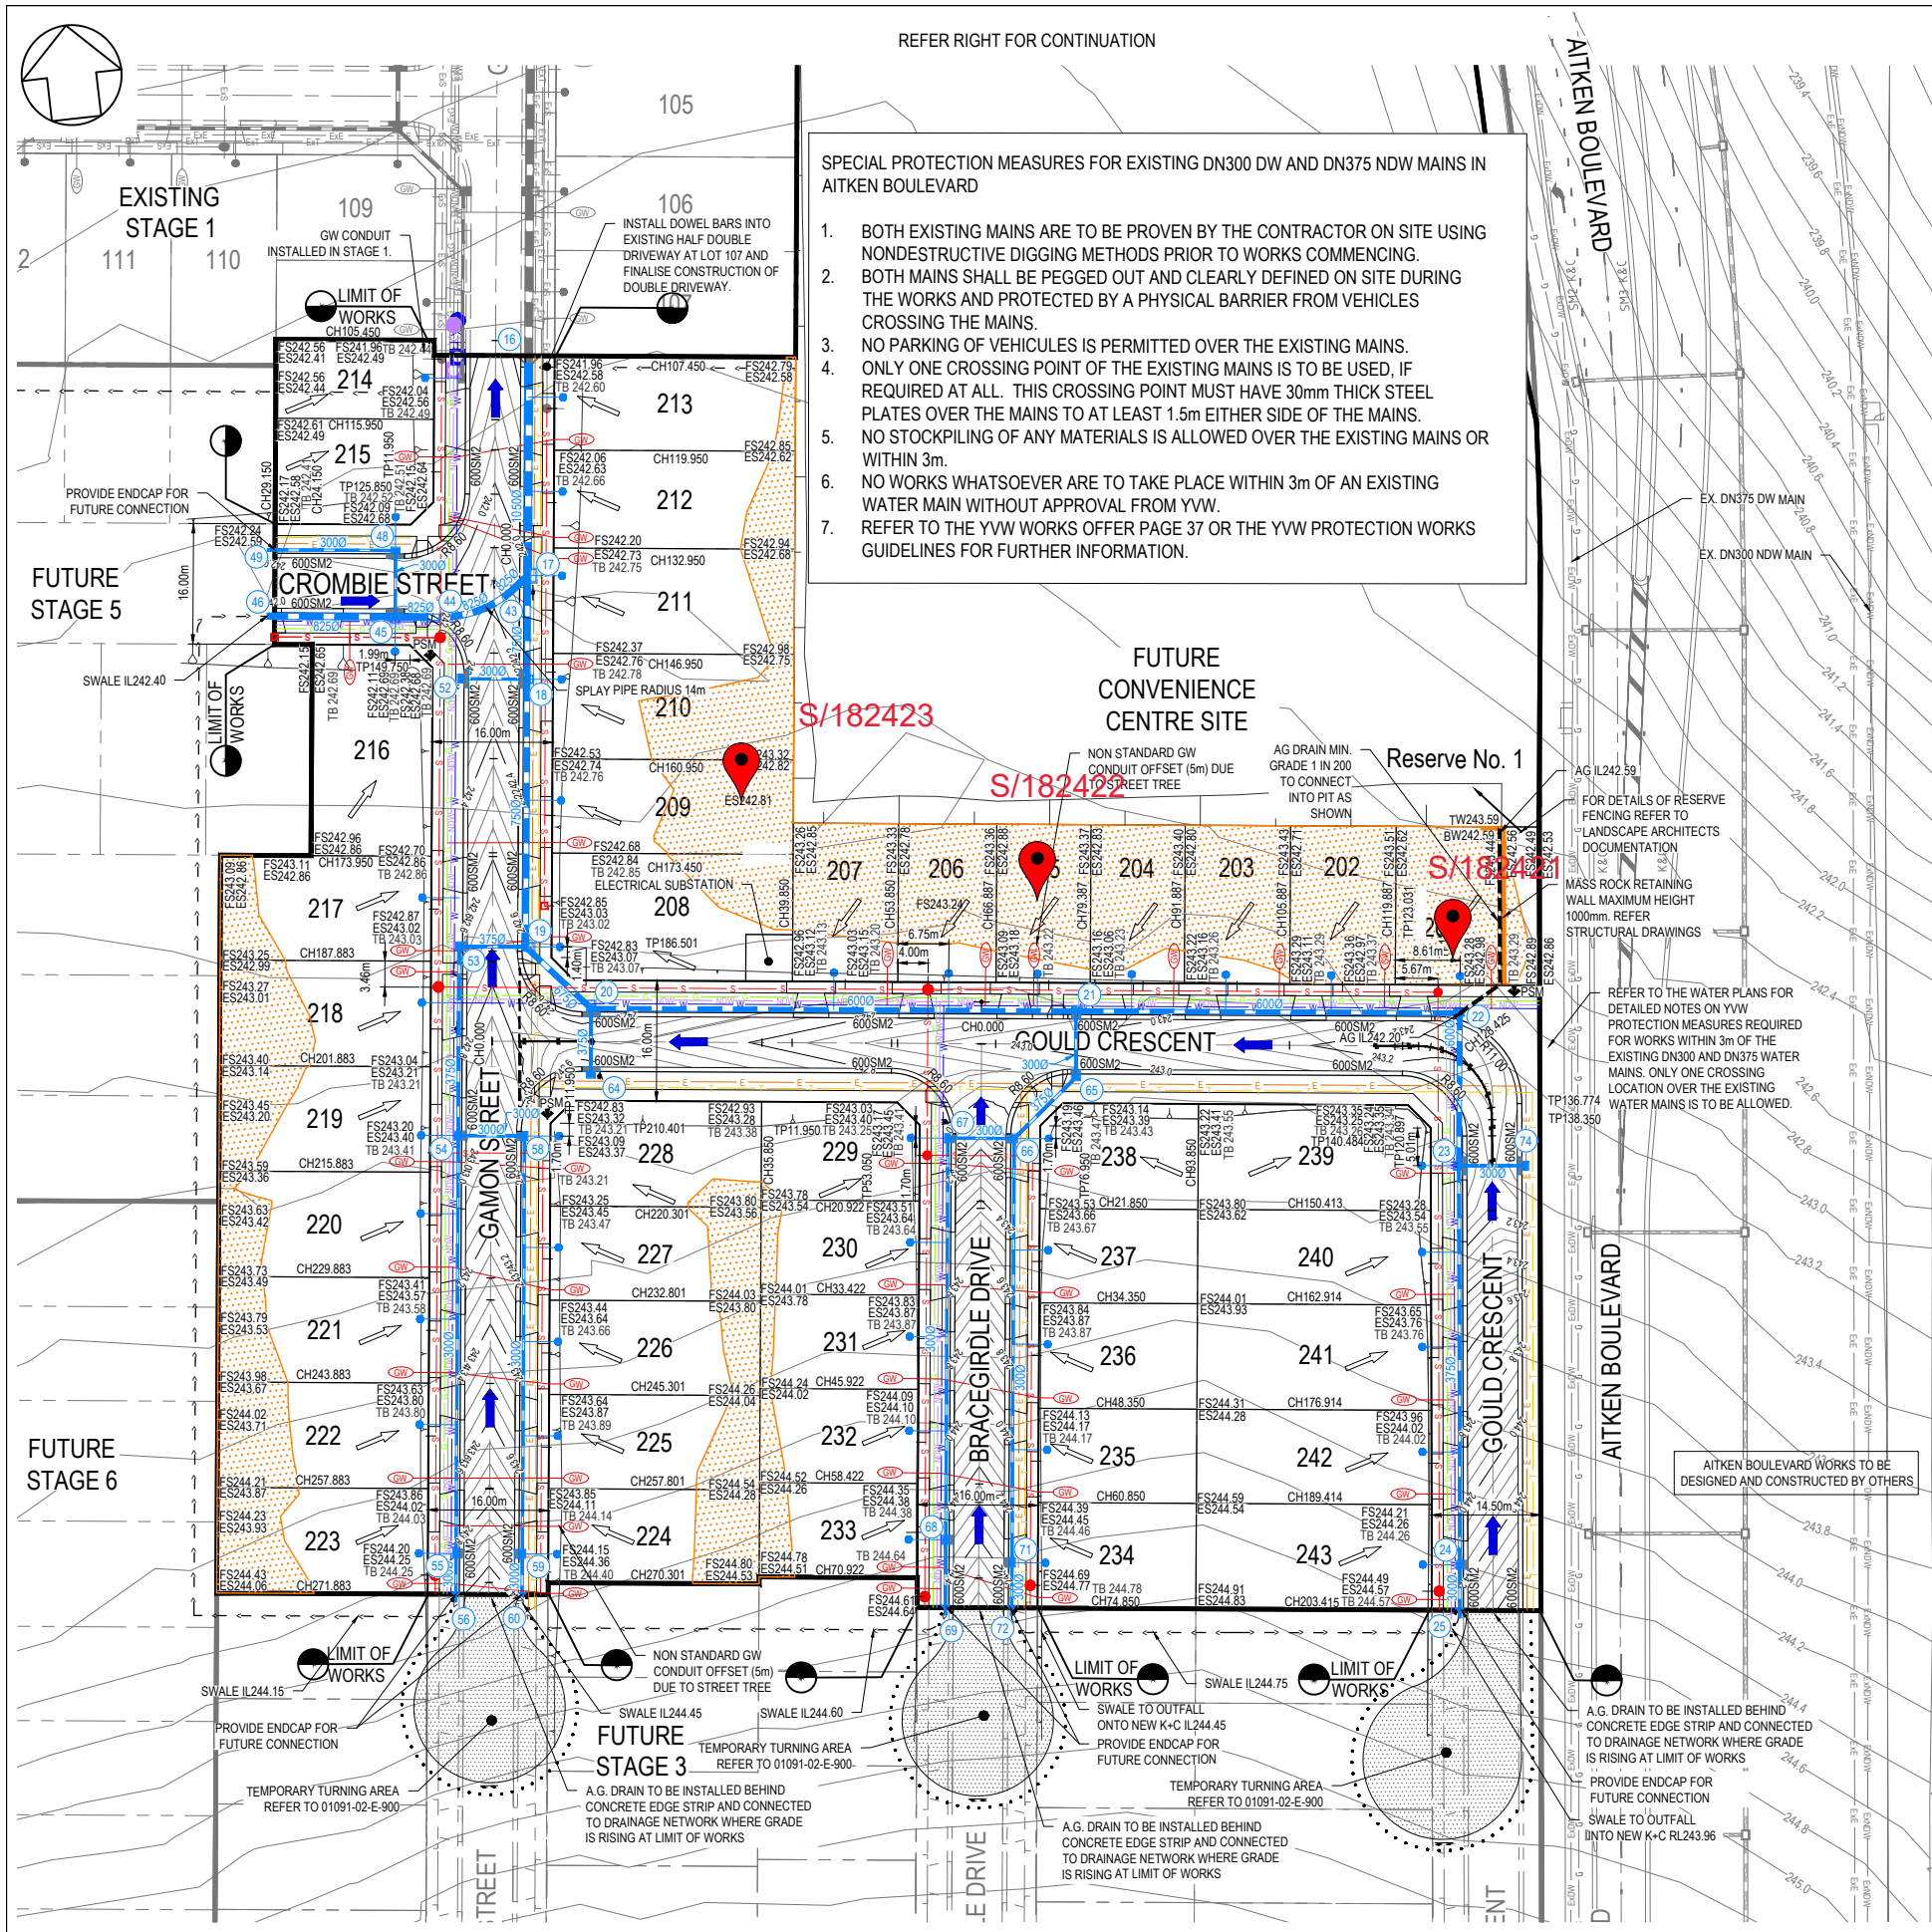

SPECIAL PROTECTION MEASURES FOR EXISTING DN300 DW AND DN375 NDW MAINS IN AITKEN BOULEVARD

- BOTH EXISTING MAINS ARE TO BE PROVEN BY THE CONTRACTOR ON SITE USING NONDESTRUCTIVE DIGGING METHODS PRIOR TO WORKS COMMENCING.
- BOTH MAINS SHALL BE PEGGED OUT AND CLEARLY DEFINED ON SITE DURING THE WORKS AND PROTECTED BY A PHYSICAL BARRIER FROM VEHICLES CROSSING THE MAINS.
- NO PARKING OF VEHICLES IS PERMITTED OVER THE EXISTING MAINS. ONLY ONE CROSSING POINT OF THE EXISTING MAINS IS TO BE USED, IF REQUIRED AT ALL. THIS CROSSING POINT MUST HAVE 30mm THICK STEEL PLATES OVER THE MAINS TO AT LEAST 1.5m EITHER SIDE OF THE MAINS.
- NO STOCKPILING OF ANY MATERIALS IS ALLOWED OVER THE EXISTING MAINS OR WITHIN 3m.
- NO WORKS WHATSOEVER ARE TO TAKE PLACE WITHIN 3m OF AN EXISTING WATER MAIN WITHOUT APPROVAL FROM YVW.
- REFER TO THE YVW WORKS OFFER PAGE 37 OR THE YVW PROTECTION WORKS GUIDELINES FOR FURTHER INFORMATION.

CONSERVATION RESERVE


NO ACCESS IS PERMITTED INTO THE EXISTING CONSERVATION RESERVE LOCATED TO THE WEST OF THE PROPOSED DEVELOPMENT TO ANY PARTIES AT ANY TIME.

NOTES:

- ALL EXISTING SERVICES UNDER NEW PAVEMENTS, PATHS AND VEHICLE CROSSINGS TO BE BACKFILLED WITH FC9.
- ALL EXISTING PITS AND MANHOLES WITHIN NEW WORKS TO BE ADJUSTED TO NEATLY MATCH NEW FINISHED SURFACE.
- ALL EXISTING SEWER PROPERTY BRANCHES AND HOUSE DRAINS DAMAGED BY WORKS TO BE REPLACED BY CONTRACTOR.
- ALL EXISTING OPEN DRAINS TO BE DRAINED, DESLUDGED AND BACKFILLED TO LEVEL 1 REQUIREMENTS.
- ALL PRAM CROSSING TO BE DOA COMPLIANT.
- VEHICLE EXCLUSION MEASURES BETWEEN RESERVE AND ROAD RESERVE TO FORM PART OF LANDSCAPE WORKS.
- ALL COORDINATES ARE TO AHD.
- THE USE OF DIRECTIONAL AND HAZARD PAVEMENT MARKERS MUST ACCORD WITH SECTION 2.2.3.1 OF AS/NZS 1428.4:2002.
- CONTRACTOR TO CONFIRM WITH TAYLORS REPRESENTATIVE PRIOR TO THE REMOVAL OF ANY TREES.
- PIT DIMENSIONS SHOWN ON PLANS. REFER TO PIT BASE.
- CONTRACTOR TO LOCATE ALL EXISTING ASSETS PRIOR TO COMMENCEMENT OF CONSTRUCTION. ANY DAMAGE TO EXISTING ASSETS TO BE RECTIFIED AT CONTRACTORS EXPENSE.
- CONTRACTOR TO VERIFY DEPTH OF EXISTING SERVICES, PRIOR TO COMMENCEMENT OF CONSTRUCTION.

TBM SCHEDULE

TYPE	EASTING	NORTHING	RL
STAR PICKET	316661.19	5841910.59	250.03
SPIKE	316172.31	5841843.39	248.58
SPIKE	316865.23	5842954.55	242.85

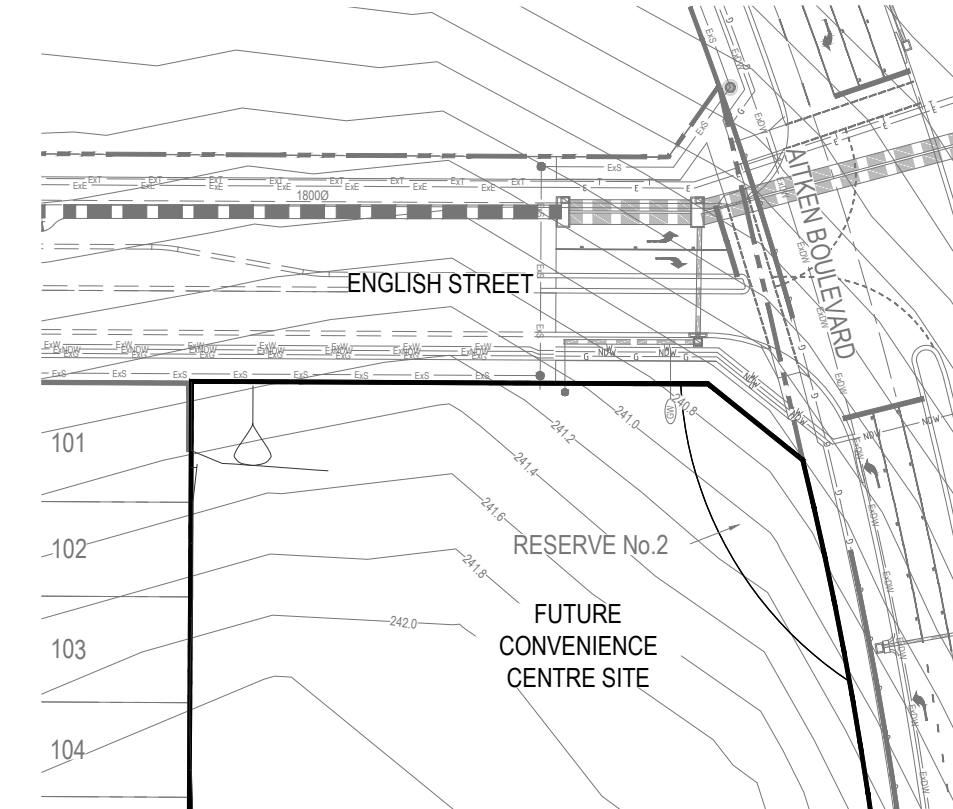

RETAINING WALL NOTE:
RETAINING WALLS ARE NOT TO BE DOCUMENTED AND APPROVED AS PART OF THE SUBDIVISIONAL WORKS APPROVAL, HOWEVER WILL BE SUBJECT TO A SEPARATE APPROVAL AT A LATER DATE.


REFER LEFT FOR CONTINUATION



WARNING
BWARE OF UNDERGROUND SERVICES
THE LOCATIONS OF UNDERGROUND SERVICES ARE APPROXIMATE ONLY AND THEIR EXACT POSITION SHOULD BE PROVED ON SITE. NO GUARANTEE IS GIVEN THAT ALL EXISTING SERVICES ARE SHOWN. A MOCS ENQUIRY ON 1100 MUST BE MADE BY THE CONTRACTOR PRIOR TO COMMENCEMENT OF WORKS.

WARNING
IT IS THE RESPONSIBILITY OF THE CONTRACTOR TO VERIFY THE SETOUT INFORMATION PROVIDED ON THIS PLAN WITH THE DESIGN INTENT WHICH INCLUDES, BUT IS NOT LIMITED TO ITEMS SUCH AS LENGTHS, CO-ORDINATES, SETOUT DIMENSIONS AND PEGGED TITLES BY THE PRINCIPAL'S LICENSED SURVEYOR.

CONTRACTOR

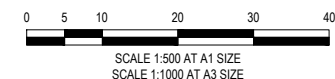

CONSTRUCTION
ISSUED FOR CONSTRUCTION

VER	DATE	REVISION	APPD.
0	20/12/2022	ISSUED FOR CONSTRUCTION	SJP

EXISTING GAS MAIN	EXISTING WATER MAIN	EXISTING ELECTRICITY CABLE	EXISTING TELCO CABLE & PIT	EXISTING SEWER MAIN & M.H.	EXISTING DRAIN & PIT	PROPOSED GAS & WATER CONDUIT
— Eg	— Ew	— Ee	— Et	— Es	— Ed	— Cw

PROPOSED GAS MAIN	PROPOSED WATER MAIN	PROPOSED ELECTRICITY CABLE	PROPOSED TELCO CABLE	PROPOSED SEWER MAIN & M.H.	PROPOSED DRAIN, PIT & PROPERTY SET	STREET NAME SIGN
— Pg	— Pw	— Pe	— Pt	— Ps	— Pd	— Pn

P.S.M.	FILLING ON LOTS DEEPER THAN 200mm	EXISTING SURFACE LEVEL	FINISHED SURFACE LEVEL	FINISHED SURFACE BATTER
— P	— F	— E	— T	— B

TAYLORS
Urban Development | Infrastructure
8/270 Ferntree Gully Road, Notting Hill, Victoria, 3186
Tel: 61 3 9501 2800 | Web: taylors.com.au

DESIGNED: EST AUTHORIZED: JOY DRAFTED: PGV
CHECKED: SJP AUTH. DATE: 27/06/2022 CAD REF: 01091-02-E-107

HUME CITY COUNCIL
225 - 285 DONNYBROOK ROAD, MICKLEHAM
MERRIFIELD RESIDENTIAL, STAGE 2
DETAIL LAYOUT PLAN

SCALE 1:500 @ A1
VERSION 0
SHEET 8 OF 26
DRAWING No. 01091-02-E-107