
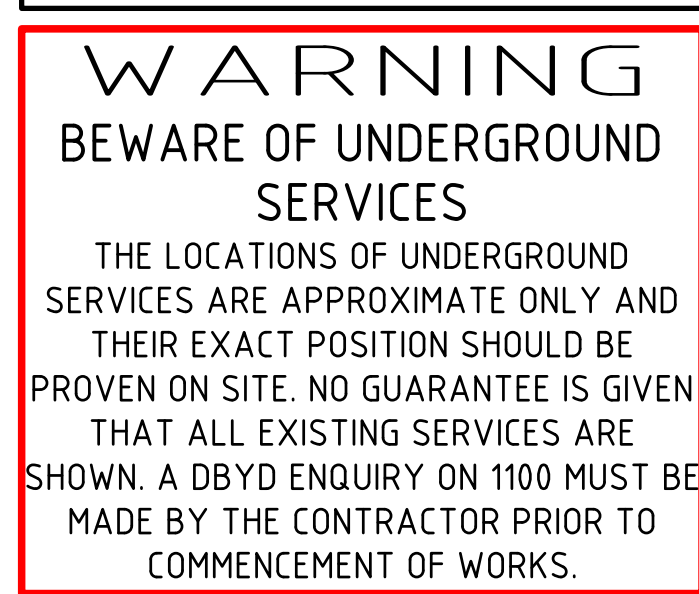



DRAWN:	S.SHRESTHA
DESIGNED:	P.MASEMANN
APPROVED:	G.ROMANCZ

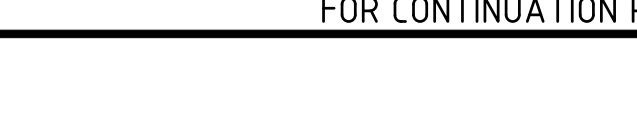


Ground Floor, 207-213 Waverley Road,
Malvern East VIC 3145
TEL : 03 8573 1500 verveprojects.com
© Verve Projects Pty Ltd.

COUNCIL:					HUME CITY COUNCIL					
PROJECT:					TITLE:					
MERRIFIELD LIVING - SECTION E					DETAIL PLAN					
STAGE 47					SHEET 2					
MICKLEHAM										
ISSUE:		CONSTRUCTION		MELWAY REF: 366 F1		PROJECT No: 17040-47		DWG No: RD202		REVISION: 2

CAD FILE: F:\SYNERGY\TEMP\1205\ENERGY\SERVERSERVICE\1205\ENERGY\17040-47-RD302\DWG
PLOT DATE: Tue Sep 27 23:54:42 2022

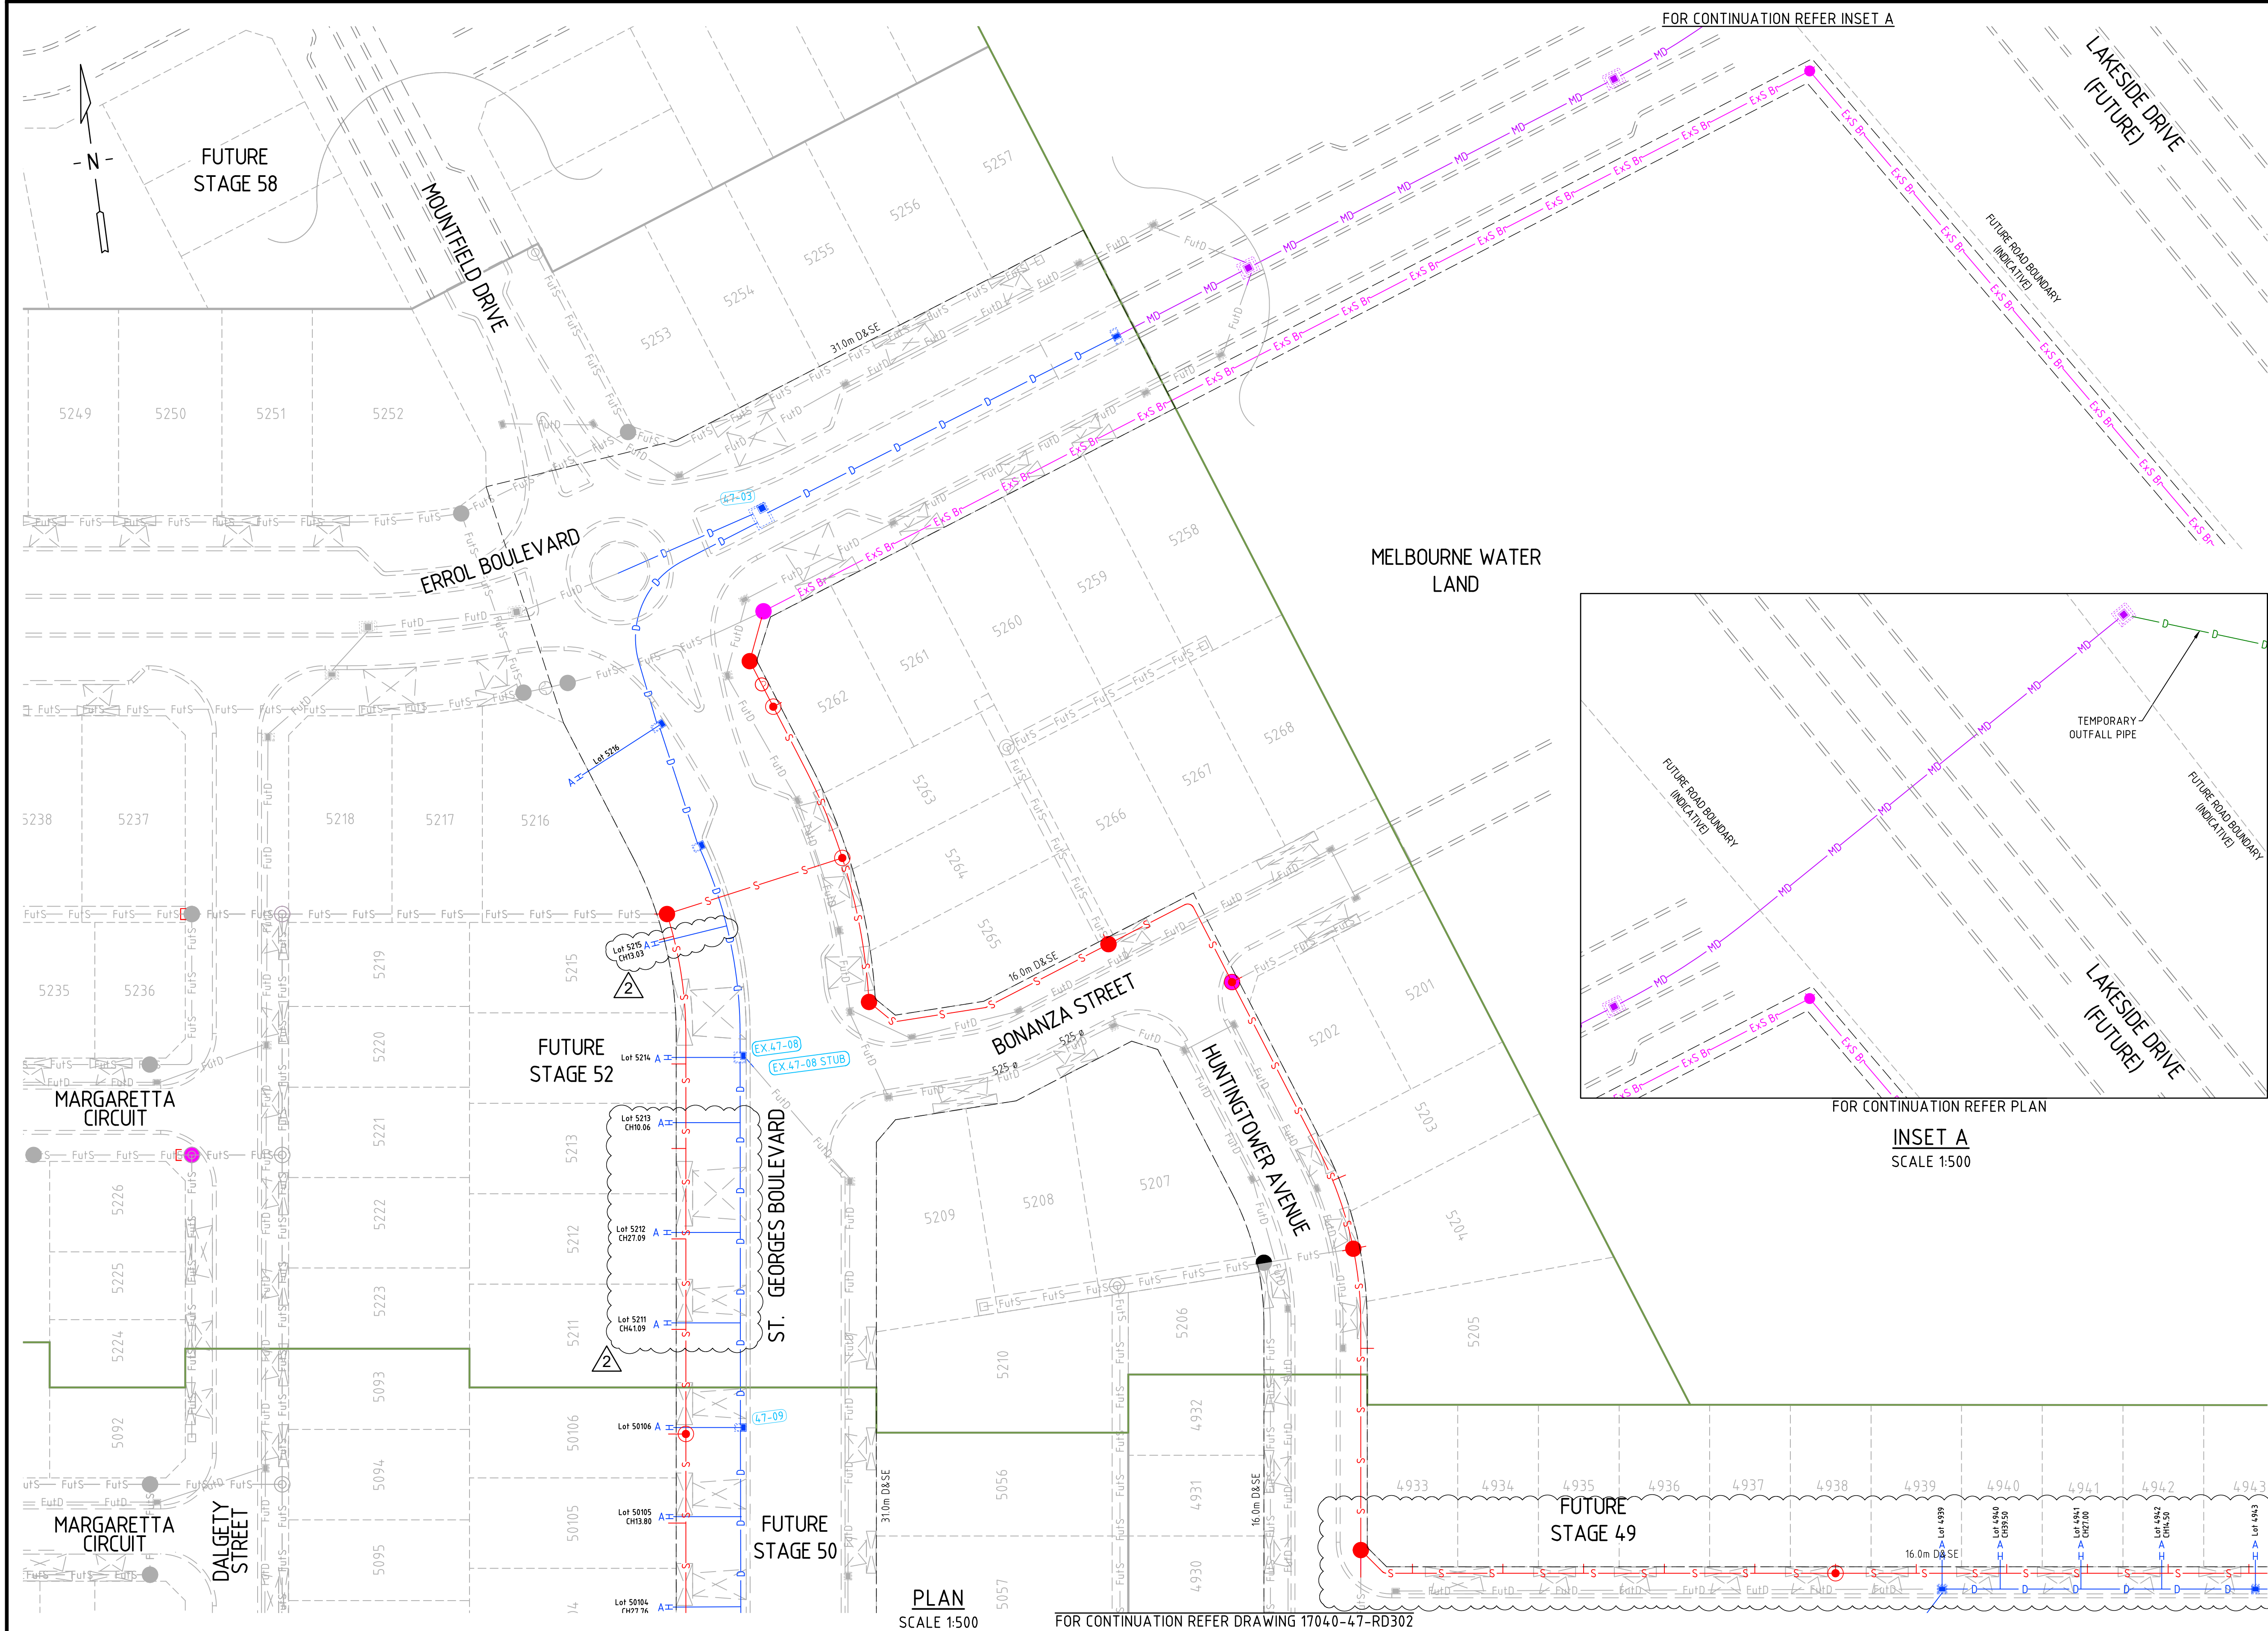

LEGEND - SERVICES PLAN

LOT GRADE

KERB

PROPOSED VEHICLE CROSSING AND FOOTPATH

PROPOSED STAGE BOUNDARY

PROPOSED FENCE

BOLLARDS

LIMIT OF ROAD WORKS

EASEMENT LINE AND TYPE

PROPOSED GAS

PROPOSED NON-DRINKING WATER

PROPOSED DRINKING WATER

PROPOSED ELECTRICITY

PROPOSED TELCO

PROPOSED GAS AND WATER CONDUIT

PROPOSED GAS CONDUIT

PROPOSED WATER CONDUIT

PROPOSED COUNCIL DRAINAGE PIT AND DRAINAGE PIPE

PROPOSED MAIN DRAINAGE PIT AND PIPE

PROPERTY INLET (EASEMENT DRAIN)

PROPERTY INLET (STREET DRAIN)

PROPERTY INLET (PART A-REFER RD112)

PROPERTY INLET (PART B-REFER RD112)

TABLE DRAIN

PROPOSED SEWER, MAINTENANCE STRUCTURE AND PROPERTY CONNECTION

PROPOSED MAINTENANCE HOLE

PROPOSED MAINTENANCE CHAMBER

PROPOSED MAINTENANCE SHAFT

PROPOSED INSPECTION SHAFT

PROPOSED GAS CHECK

PROPOSED SEWER PIPE STUB

EXISTING GAS

EXISTING NON-DRINKING WATER

EXISTING DRINKING WATER

EXISTING ELECTRICITY

EXISTING TELCO

EXISTING OVERHEAD ELECTRICITY

EXISTING OPTIC FIBRE

EXISTING GAS AND WATER CONDUIT

FUTURE COUNCIL DRAINAGE PIPE, PIT

FUTURE SEWER, MAINTENANCE STRUCTURE AND PROPERTY CONNECTION

EXISTING COUNCIL DRAINAGE PIPE, PIT

EXISTING MAIN DRAINAGE PIPE, PIT

EXISTING DRAINAGE PROPERTY INLET CONNECTION

EXISTING DRAINAGE HOUSE DRAIN CONNECTION


EXISTING SEWER, MAINTENANCE STRUCTURE AND PROPERTY CONNECTION

ELECTRIC LIGHT POLE

WARNING

BEWARE OF UNDERGROUND SERVICES

THE LOCATIONS OF UNDERGROUND SERVICES ARE APPROXIMATE ONLY AND THEIR EXACT POSITION SHOULD BE PROVEN ON SITE. NO GUARANTEE IS GIVEN THAT ALL EXISTING SERVICES ARE SHOWN. A DBYD ENQUIRY ON 1100 MUST BE MADE BY THE CONTRACTOR PRIOR TO COMMENCEMENT OF WORKS.

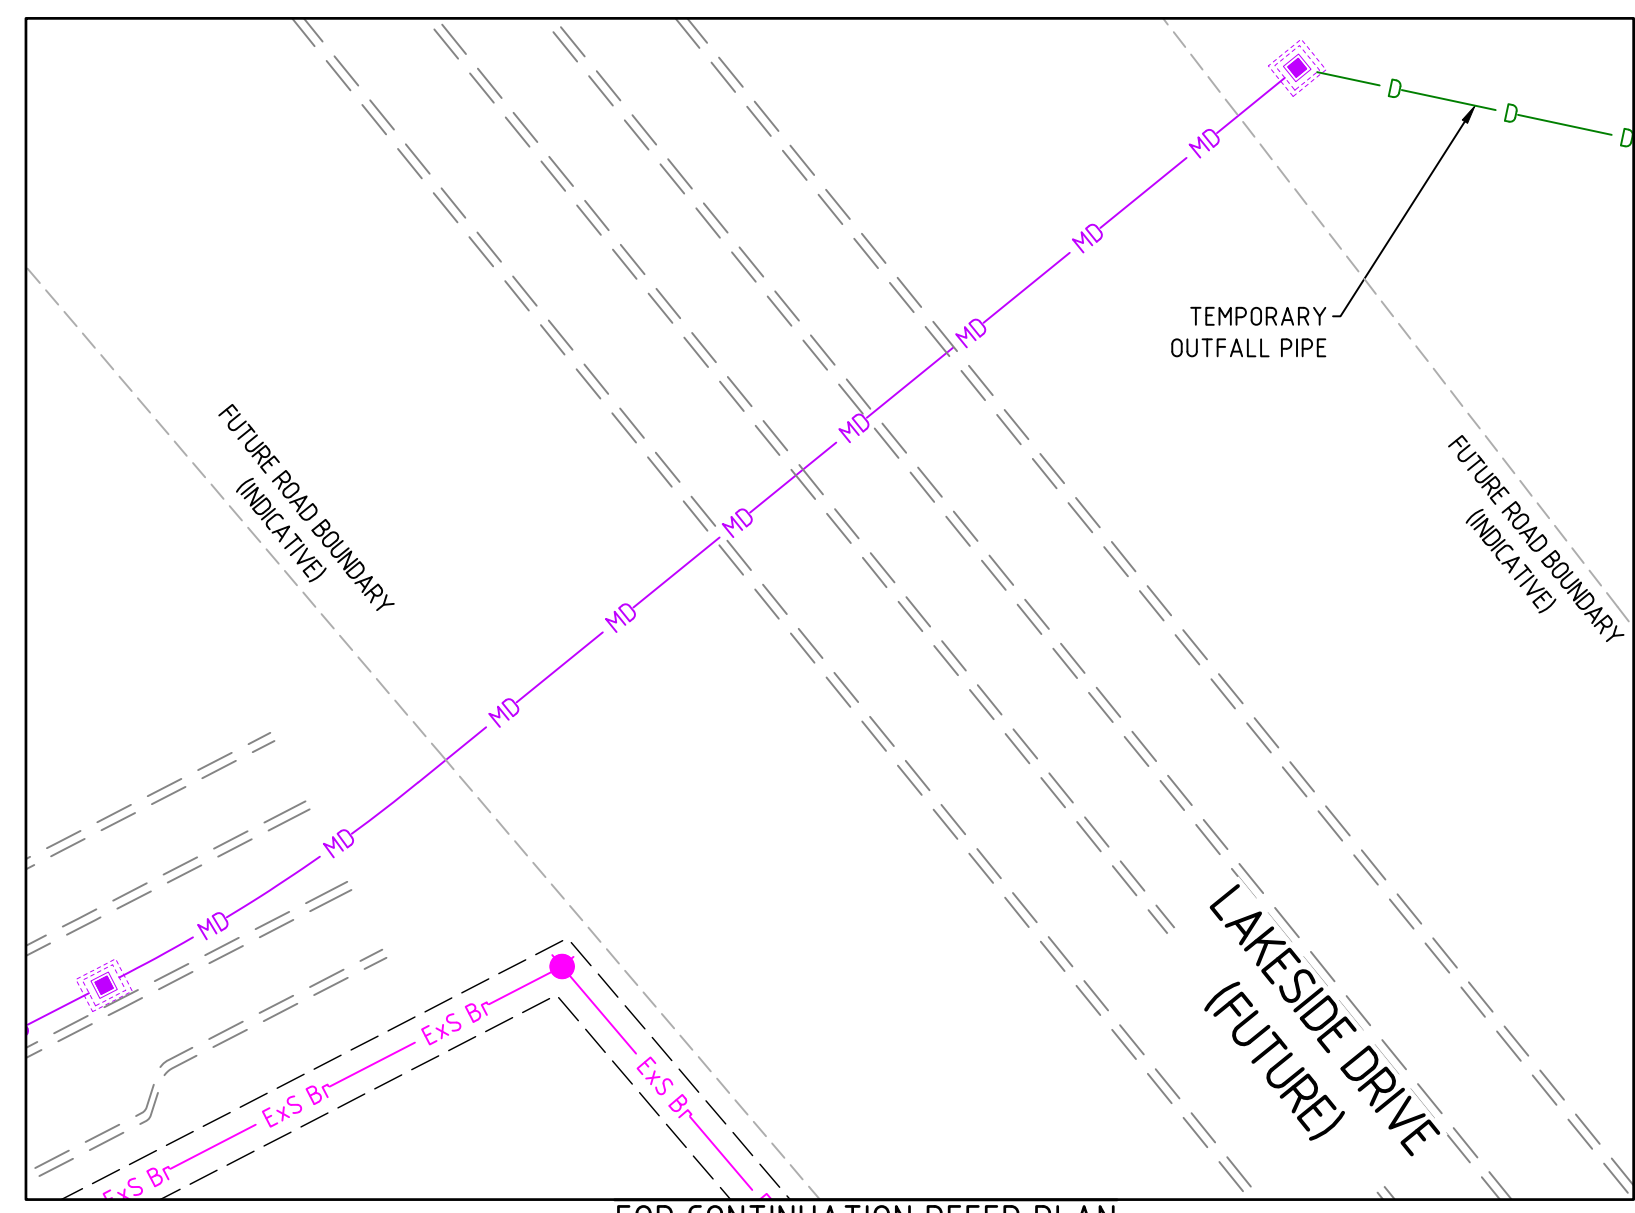

REV	DESCRIPTION	APPROVED	DATE
2	HOUSE DRAIN PROPERTY CONNECTIONS & SEWER UPDATED	G.R	26.09.22
1	UPDATED DRAINAGE PIT 47-03 INCOMING PIPE CONFIGURATION	G.R	20.07.22
0	CONSTRUCTION ISSUE	G.R	18.07.22

DRAWN:
S.SHRESTHA

DESIGNED:
P.MASEMANN

APPROVED:
G.ROMANCZ

H 1 : 500
@ A1

Ground Floor, 207-213 Waverley Road,
Malvern East VIC 3145
TEL : 03 8573 1500 verveprojects.com
© Verve Projects Pty Ltd.

COUNCIL:
HUME CITY COUNCIL

PROJECT:
MERRIFIELD LIVING - SECTION E
STAGE 47
MICKLEHAM

ISSUE:
CONSTRUCTION

TITLE:
SERVICES PLAN
SHEET 1


MELWAY REF:
366 F1

PROJECT No:
17040-47

DWG No:
RD301

REVISION:
2

CAD FILE: F:\SYNERGY\TEMP\120SYNERGY\SERVICES\120SYNERGY\17040-47-RD301-RD303.DWG
PLOT DATE: Tue Sep 27 23:51:59 2022

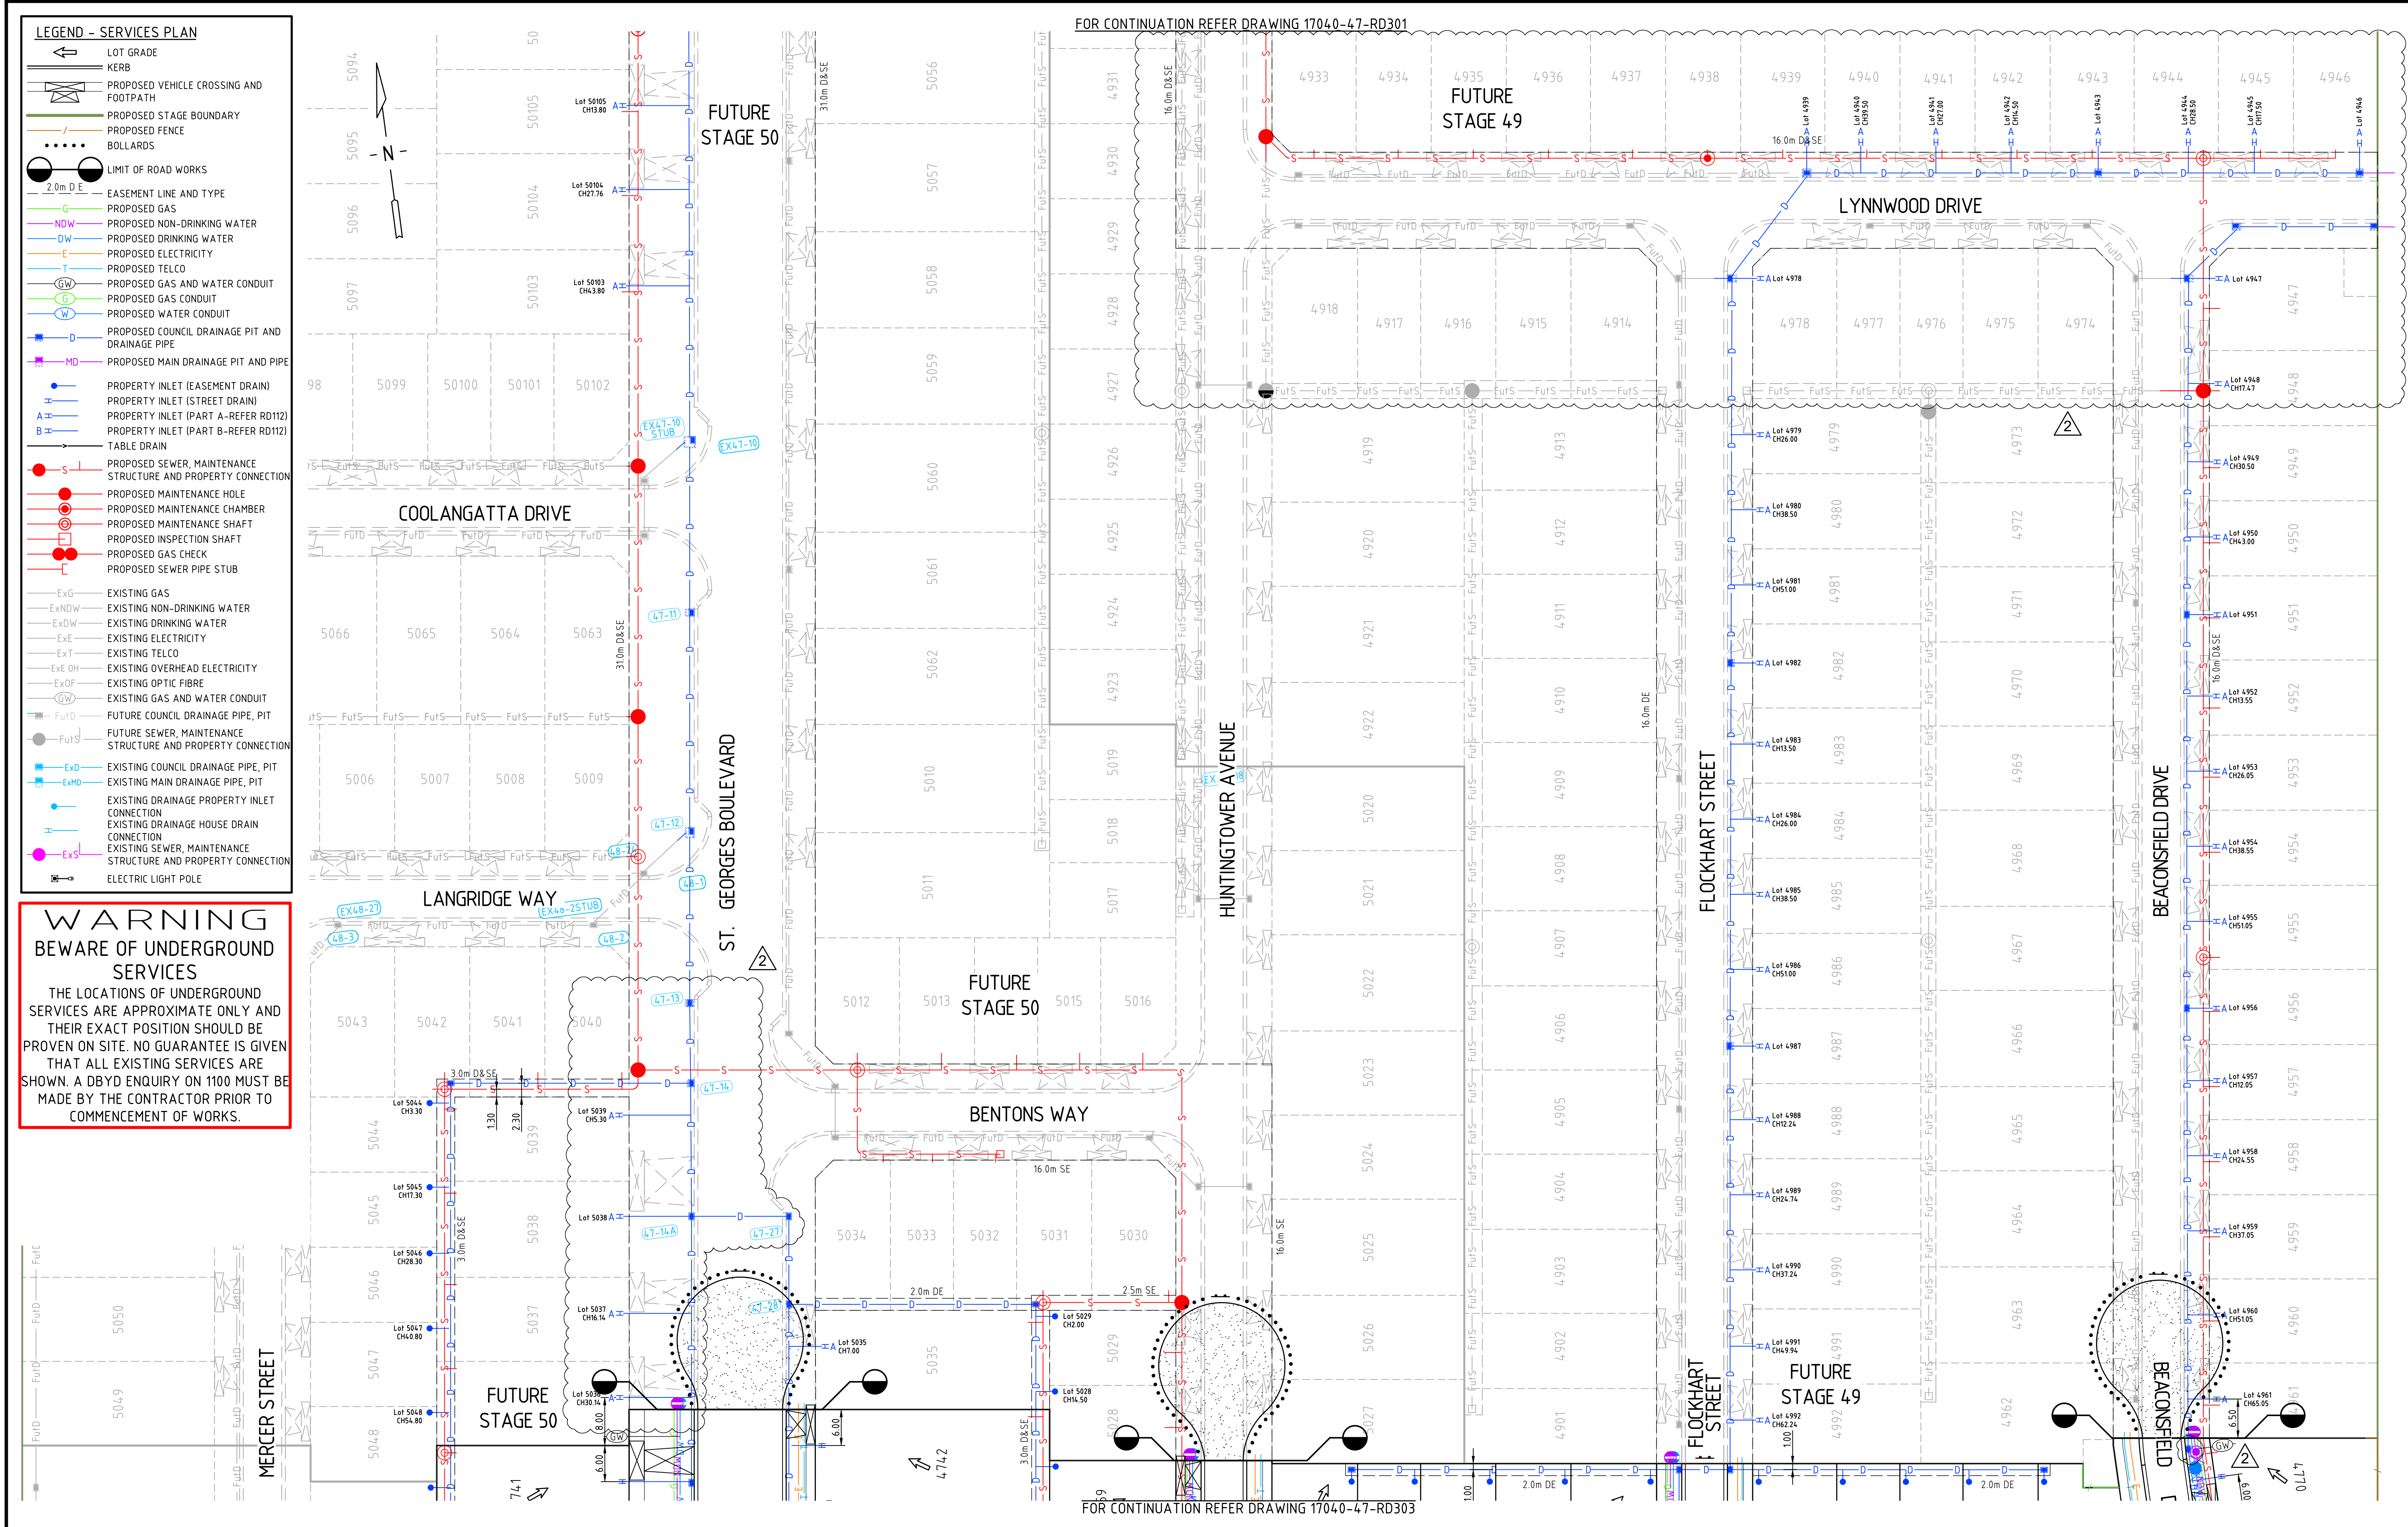


LEGEND - SERVICES PLAN

- LOT GRADE
- KERB
- PROPOSED VEHICLE CROSSING AND FOOTPATH
- PROPOSED STAGE BOUNDARY
- PROPOSED FENCE
- BOLLARDS
- LIMIT OF ROAD WORKS
- 2.0m DE
- EASEMENT LINE AND TYPE
- PROPOSED GAS
- PROPOSED NON-DRINKING WATER
- PROPOSED DRINKING WATER
- PROPOSED ELECTRICITY
- PROPOSED TELCO
- PROPOSED GAS AND WATER CONDUIT
- PROPOSED GAS CONDUIT
- PROPOSED WATER CONDUIT
- PROPOSED COUNCIL DRAINAGE PIT AND DRAINAGE PIPE
- PROPOSED MAIN DRAINAGE PIT AND PIPE
- PROPERTY INLET (EASEMENT DRAIN)
- PROPERTY INLET (STREET DRAIN)
- PROPERTY INLET (PART A-REFER RD112)
- PROPERTY INLET (PART B-REFER RD112)
- TABLE DRAIN
- PROPOSED SEWER, MAINTENANCE STRUCTURE AND PROPERTY CONNECTION
- PROPOSED MAINTENANCE HOLE
- PROPOSED MAINTENANCE CHAMBER
- PROPOSED MAINTENANCE SHAFT
- PROPOSED INSPECTION SHAFT
- PROPOSED GAS CHECK
- PROPOSED SEWER PIPE STUB
- EXISTING GAS
- EXISTING NON-DRINKING WATER
- EXISTING DRINKING WATER
- EXISTING ELECTRICITY
- EXISTING TELCO
- EXISTING OVERHEAD ELECTRICITY
- EXISTING OPTIC FIBRE
- EXISTING GAS AND WATER CONDUIT
- FUTURE COUNCIL DRAINAGE PIPE, PIT
- FUTURE SEWER, MAINTENANCE STRUCTURE AND PROPERTY CONNECTION
- EXISTING COUNCIL DRAINAGE PIPE, PIT
- EXISTING MAIN DRAINAGE PIPE, PIT
- EXISTING DRAINAGE PROPERTY INLET CONNECTION
- EXISTING DRAINAGE HOUSE DRAIN CONNECTION
- EXISTING SEWER, MAINTENANCE STRUCTURE AND PROPERTY CONNECTION
- ELECTRIC LIGHT POLE

WARNING
BEWARE OF UNDERGROUND SERVICES
THE LOCATIONS OF UNDERGROUND SERVICES ARE APPROXIMATE ONLY AND THEIR EXACT POSITION SHOULD BE PROVEN ON SITE. NO GUARANTEE IS GIVEN THAT ALL EXISTING SERVICES ARE SHOWN. A DBYD ENQUIRY ON 1100 MUST BE MADE BY THE CONTRACTOR PRIOR TO COMMENCEMENT OF WORKS.

2	DRAINAGE & SEWER UPDATED	G.R	26.09.22	S.SHRESTHA	DESIGNED:
1	LOT 4759 REAR DRAINAGE PROPERTY CONNECTION ADDED	G.R	20.07.22	P.MASEMANN	DESIGNED:
0	CONSTRUCTION ISSUE	G.R	18.07.22	G.ROMANCZ	APPROVED:
REV	DESCRIPTION	APPROVED	DATE		

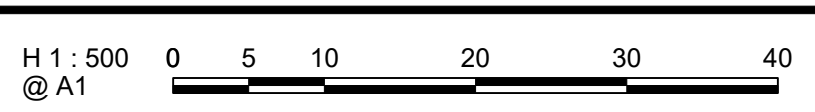

CLIENT:

merrifield

MAB gpc

verve

Ground Floor, 207-213 Waverley Road,
Malvern East VIC 3145
TEL : 03 8573 1500 verveprojects.com
© Verve Projects Pty Ltd.

COUNCIL: HUME CITY COUNCIL

PROJECT: MERRIFIELD LIVING - SECTION E
STAGE 47
MICKLEHAM

ISSUE: **CONSTRUCTION**

MELWAY REF: 366 F1

PROJECT No: 17040-47

DWG No: RD302

REVISION: 2

TITLE: SERVICES PLAN
SHEET 2

