

# **Merrifield Estate - Stage 50, Mickleham**

## **Level 1 Inspection & Testing Report**

Reference: 1120 0343-1



### **Prepared for:**

BMD Urban

May 2023



**A&Y ASSOCIATES**  
GEOTECHNICAL ENGINEERING CONSULTANTS

# Document Control Record

Prepared by:

**A&Y Associates Pty Ltd**

ABN 92 614 244 665

5/16 Network Drive

Truganina, VIC 3029

**T:** (03) 8754 8325

**E:** info@ayassociates.com.au

**W:** www.ayassociates.com.au

## Document control

<b>Report title</b>		Level 1 Inspection & Testing			
<b>Project reference number</b>		1120 0343-1			
<b>Client</b>		BMD Urban			
<b>Contact name</b>		Alyssa Willder			
<b>Contact number</b>		0400 207 600			
<b>Contact e-mail</b>		Alyssa.Willder@bmd.com.au			
<b>Revision</b>	<b>Date</b>	<b>Descriptions/Status</b>	<b>Author</b>	<b>Reviewer</b>	<b>Approver</b>
0	10/05/2023	First Issue	Y Balkis	A Tan	A Tan

## Approver



Alvin Tan

(BE Civil and Infrastructure), MIEAust

Senior Geotechnical Engineer

E: alvin@ayassociates.com.au | M: 0449 288 338



ENGINEERS  
AUSTRALIA  
Professional Engineer  
MEMBER

---

## **Disclaimer**

The findings and conclusions contained in this report are made based on site conditions that existed at the time this work was conducted. The conclusions present in this report are relevant to the conditions of the site and the state of legislation currently enacted as at the date of this report.

Findings and conclusions are made assuming that the soil, groundwater, geological and chemical conditions detailed within this report are accurate and remain applicable to the site at the time of writing. No other warranties are made or intended.

A&Y Associates (A&Y) Pty Ltd has used a degree of skill and care ordinarily exercised by reputable members of our profession practicing in the same or similar locality.

A&Y does not make any representation or warranty that the conclusions in this report will be applicable in the future as there may be changes in the condition of the site, applicable legislation or other factors that would affect the conclusions contained in this report.

This report has been prepared exclusively for use by our client. This report cannot be reproduced without the written authorisation of A&Y and then can only be reproduced in its entirety.

## **Applicability**

This report has been prepared for the benefit for our client with respect to the particular brief given to us and it may not be relied upon in other contexts or for any other purpose without our prior review and agreement.

No responsibility for this report will be taken by A&Y if it is altered in any way, or not reproduced in full.

---

## Contents

<b>1</b>	<b>Introduction.....</b>	<b>3</b>
<b>2</b>	<b>Project Summary .....</b>	<b>3</b>
<b>3</b>	<b>Project Specifications .....</b>	<b>4</b>
<b>4</b>	<b>Subgrade Assessment .....</b>	<b>5</b>
<b>5</b>	<b>Earthworks .....</b>	<b>5</b>
<b>6</b>	<b>Fill Material .....</b>	<b>5</b>
<b>7</b>	<b>Testing.....</b>	<b>6</b>
<b>8</b>	<b>Finished Surface Levels.....</b>	<b>6</b>
<b>9</b>	<b>Exclusion .....</b>	<b>6</b>
<b>10</b>	<b>Conclusion .....</b>	<b>7</b>
	<b>Appendix A - Site Plan .....</b>	<b>8</b>
	<b>Appendix B – Test Locations .....</b>	<b>10</b>
	<b>Appendix C – Test Results Summary .....</b>	<b>12</b>
	<b>Appendix D – NATA Test Results .....</b>	<b>17</b>



---

## 1 Introduction

This report presents the results of the Level 1 Inspection and Testing for the construction of the fill platforms located in Merrifield Estate - Stage 50, Mickleham.

## 2 Project Summary

It is understood that BMD Urban require the fill platforms within Stage 50 to be constructed under Level 1 Inspection and Testing undertaken by a Geotechnical Inspection and Testing Authority (GITA).

Level 1 Inspection and Testing, as defined in AS3798-2007 "Guidelines on Earthworks for Commercial and Residential Development," provides for full time inspection of the construction of controlled fill and field and laboratory testing in accordance with AS1289 "Methods of Testing Soils for Engineering Purposes".

The Level 1 inspection was undertaken by a Geotechnician from A&Y Associates over a period of **37 working days** from the **12<sup>th</sup> May 2022 to 10<sup>th</sup> March 2023**.

This report is applicable for fill placed by BMD Urban in Merrifield Estate - Stage 50, Mickleham, as shown in Appendix A – Site Plan.

---

### 3 Project Specifications

The supervision and inspections were performed based on AS3798, the specifications provided in the geotechnical report (ref: "Geotechnical Site Investigation, Merrifield Living – Section E&G Donnybrook Road, Mickleham"; Report No. G4719.1 REVAB, by Ground Science Pty Ltd, Dated 19/05/2022) and the drawing (ref: Merrifield Living – Section E Bulk Earthworks – Stage 49-53, Project No. 17040-49, Drawing No. EW101 - REV0 by Verve Projects Pty Ltd, Dated 02/03/2022) for the construction works in Merrifield Estate – Stage 49, Mickleham. A short summary of the requirements is provided below:

- Material to be used for fill construction shall satisfy the requirements of AS3798-2007 "Guidelines on Earthworks for Commercial and Residential Developments". Material used shall be free of:
  - Organic soils, such as topsoils, severely root affected subsoil and peat;
  - Contaminated soils;
  - Materials which undergo volume change or loss of strength when disturbed and exposed to moisture;
  - Silts, or materials that have deleterious engineering properties of silt;
  - Fill that contains wood, metal, plastic, boulders, or other deleterious material, in sufficient proportions to affect the required performance of fill;
  - The maximum particle size of any rocks or other lump, within the layer, has not exceeded two-thirds (2/3) of the compacted layer thickness.
- Compaction to achieve a dry density ratio of at least 95% Standard, as the project was classified as **Residential**.

---

## 4 Subgrade Assessment

The subgrade was assessed by A&Y Associates following the topsoil removal and before any fill was placed. The subgrade assessment was undertaken on the **24<sup>th</sup> of March 2022** as mentioned in report **1120 0343-1 (SS11)**.

The exposed subgrade material was found comprised silty clay. No wet or soft patches were found during the inspection. No evidence of deleterious material was found during the inspection.

## 5 Earthworks

The earthworks for this project included stripping of topsoil, removing of tree roots, proof rolling the subgrade and placement and compaction of fill to construct engineered platforms.

Based on design plans and site inspection, it appears that the fill thickness placed is approximately 200mm – 2000mm. The fill layers or thickness nominated in this report are provided as a guide on the amounts of fill placed and do not necessarily reflect an accurate survey of the fill levels.

## 6 Fill Material

The fill material used for the platform consisted of imported material. The imported material was predominantly comprising of Silty Clay with gravel.

---

## 7 Testing

Field density testing was undertaken on the compacted fill at a frequency of a minimum of 3 tests per lot (AS3798 Table 8.1).

Tests were performed using a Nuclear Density Gauge for field density determination as per AS 1289.5.8.1. Testing was completed at a minimum rate of 3 field density tests per day's production based on the minimum requirements of AS 3798-2007 and taken from each layer of fill placed.

A total of 111 field density tests were performed during the earthworks. All of the test results met the specified compaction requirement of 95% Standard Compaction.

The locations of the 111 field density tests are shown in Appendix B – Test Locations. A summary of the test results obtained from the field density testing is presented in Appendix C – Test Results Summary. The laboratory test reports of the field density tests are presented in Appendix D – NATA Test Results.

## 8 Finished Surface Levels

It should be noted that even though the final fill layer meets the specification requirements, over time, the material may be subject to adverse weather conditions resulting in either surface softening or drying and cracking. The top 150mm – 200mm of the fill will deteriorate with time and should be considered by the foundation engineer.

## 9 Exclusion

A&Y Associates was not involved in monitoring and testing the following works and as such are not included in the Level 1 report.

- Any trenches excavated and backfilled on site for the installation of underground services such as sewers, electrical conduits, water mains etc.
- Footpaths in front of the lots that may be excavated and filled after the Level 1 supervision conducted by A&Y Associates.
- Uncontrolled fill and topsoil that may have been placed as part of the landscaping of the site following the completion of the engineered fill construction.

---

## **10 Conclusion**

On the completion of the earthworks and after analysing the materials used, it has been concluded that the filling procedure conducted by BMD Urban appears to be consistent with the requirements of AS 3798 in regards to the placement of fill materials on a project under Level 1 Supervision and in accordance with the project specification as provided to A&Y Associates.

---


## **Appendix A - Site Plan**




---

## **Appendix B – Test Locations**



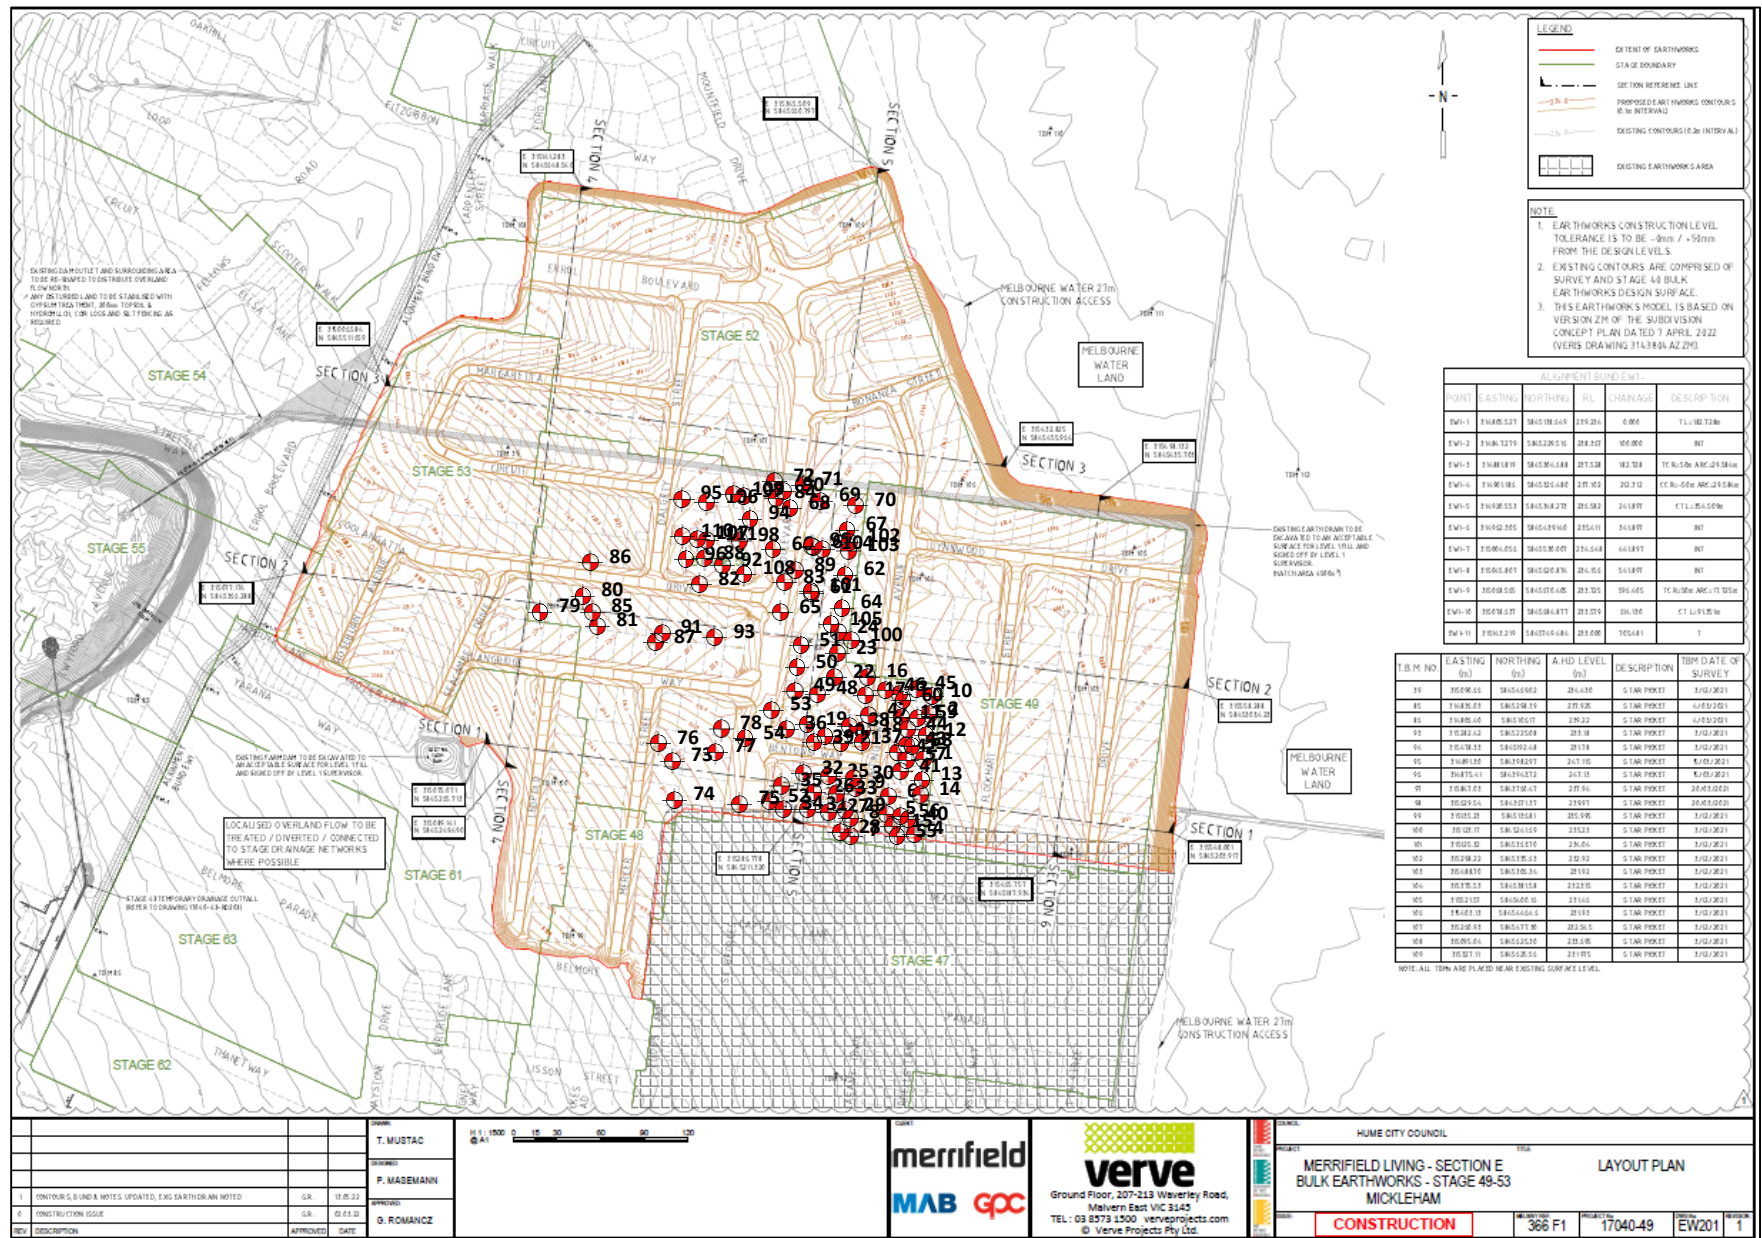

<b>PROJECT:</b> Project : Merrifield Estate - Stage 50 (Level1)	<b>CLIENT:</b> Client : BMD Urban	<b>SITE PLAN SKETCH—NOT TO SCALE</b>	 <b>A&amp;Y ASSOCIATES</b> GEOTECHNICAL ENGINEERING CONSULTANTS
<b>LOCATION:</b> Location : Mickleham	<b>PROJECT No:</b> Project No : 1120 0343-1		

---

## **Appendix C – Test Results Summary**

Project No		1120 0343-1			Client	BMD Urban				
Project Name		Merrifield - Stage 50 (Level 1)			Specification			Density Ratio ≥ 95% of Peak Wet Density		
Location		Mickleham, VIC								
Test No	Retest of Test	Date	Location	Layer	Oversize	Density Ratio	Moisture Ratio	Moisture Variation	Pass / Fail	Retest
#	#		Lot #	#	%	%	%	%		Pass / Fail
1	-	12/5/2022	-	1	3.5	99.0	108.5	1.5	Pass	-
2	-	12/5/2022	-	1	4.2	98.5	99.0	-0.5	Pass	-
3	-	12/5/2022	-	1	5.1	97.5	95.0	-0.5	Pass	-
4	-	13/05/2022	-	1	4.8	98.5	94.5	-1.0	Pass	-
5	-	13/05/2022	-	1	5.5	96.0	111.5	1.5	Pass	-
6	-	13/05/2022	-	1	5.5	101.0	107.5	1.5	Pass	-
7	-	16/05/2022	-	1	5.9	99.0	109.5	1.5	Pass	-
8	-	16/05/2022	-	1	5.2	96.0	109.0	1.5	Pass	-
9	-	16/05/2022	-	1	3.2	97.0	95.5	-1.0	Pass	-
10	-	17/05/2022	-	2	5.5	99.0	107.5	1.5	Pass	-
11	-	17/05/2022	-	2	5.8	101.5	96.5	-0.5	Pass	-
12	-	17/05/2022	-	2	3.5	96.0	108.0	2.0	Pass	-
13	-	18/05/2022	-	2	4.9	95.5	99.0	-0.5	Pass	-
14	-	18/05/2022	-	2	3.2	95.0	99.0	-0.5	Pass	-
15	-	18/05/2022	-	2	4.6	95.5	107.5	1.5	Pass	-
16	-	19/05/2022	-	1	3.0	97.5	108.5	2.0	Pass	-
17	-	19/05/2022	-	1	4.5	98.0	109.0	1.5	Pass	-
18	-	19/05/2022	-	1	5.3	98.0	98.5	-0.5	Pass	-
19	-	20/05/2022	-	1	3.1	97.0	108.0	1.5	Pass	-
20	-	20/05/2022	-	1	3.3	98.0	99.0	-0.5	Pass	-
21	-	20/05/2022	-	1	4.1	96.0	106.5	1.5	Pass	-
22	-	23/05/2022	-	2	3.0	97.0	96.0	-1.0	Pass	-
23	-	23/05/2022	-	2	5.1	98.0	99.0	-0.5	Pass	-
24	-	23/05/2022	-	2	4.6	98.0	108.0	1.5	Pass	-
25	-	24/05/2022	-	1	5.3	97.0	108.5	2.0	Pass	-

\*\* Negative (-) value indicates that the field moisture content is drier than the optimum moisture content (OMC)

\*\* Positive (+) value indicates that the field moisture content is wetter than the optimum moisture content (OMC)

26	-	24/05/2022	-	1	5.3	98.0	99.0	-0.5	Pass	-
27	-	24/05/2022	-	1	4.7	97.0	109.5	1.5	Pass	-
28	-	25/05/2022	-	2	5.5	97.0	108.0	1.5	Pass	-
29	-	25/05/2022	-	2	3.9	98.0	96.5	-0.5	Pass	-
30	-	25/05/2022	-	2	3.2	95.5	109.0	1.5	Pass	-
31	-	26/05/2022	-	2	4.3	97.0	110.5	2.0	Pass	-
32	-	26/05/2022	-	2	5.7	98.0	97.0	-0.5	Pass	-
33	-	26/05/2022	-	2	5.9	95.5	109.0	1.5	Pass	-
34	-	27/05/2022	-	2	3.5	100.5	109.5	1.5	Pass	-
35	-	27/05/2022	-	2	3.0	98.0	109.5	2.0	Pass	-
36	-	27/05/2022	-	2	4.1	97.5	106.5	1.5	Pass	-
37	-	28/05/2022	-	2	3.5	97.0	108.0	1.5	Pass	-
38	-	28/05/2022	-	2	3.0	96.0	109.0	2.0	Pass	-
39	-	28/05/2022	-	2	4.1	100.0	108.0	1.5	Pass	-
40	-	9/6/2022	-	3	2.0	97.5	109.5	2.0	Pass	-
41	-	9/6/2022	-	3	2.5	95.0	99.5	-0.5	Pass	-
42	-	9/6/2022	-	3	2.1	97.0	107.5	1.5	Pass	-
43	-	10/6/2022	-	3	3.5	98.0	107.0	2.0	Pass	-
44	-	10/6/2022	-	3	3.8	96.5	107.5	1.5	Pass	-
45	-	10/6/2022	-	3	4.1	100.5	98.5	-0.5	Pass	-
46	-	15/06/2022	-	3	3.8	98.5	95.5	-1.0	Pass	-
47	-	15/06/2022	-	3	3.1	96.5	107.0	1.5	Pass	-
48	-	15/06/2022	-	3	3.0	97.5	108.5	2.0	Pass	-
49	-	20/06/2022	-	3	2.5	98.0	110.5	1.5	Pass	-
50	-	20/06/2022	-	3	2.9	98.0	96.5	-0.5	Pass	-
51	-	20/06/2022	-	3	3.8	98.0	108.5	1.5	Pass	-
52	-	23/06/2022	-	1	3.8	98.0	98.0	-0.5	Pass	-
53	-	23/06/2022	-	1	3.5	96.5	110.5	1.5	Pass	-
54	-	23/06/2022	-	1	4.8	98.0	97.5	-0.5	Pass	-
55	-	27/06/2022	-	4	3.8	98.0	113.5	2.0	Pass	-
56	-	27/06/2022	-	4	2.0	98.5	96.0	-0.5	Pass	-

\*\* Negative (-) value indicates that the field moisture content is drier than the optimum moisture content (OMC)

\*\* Positive (+) value indicates that the field moisture content is wetter than the optimum moisture content (OMC)

57	-	27/06/2022	-	4	4.3	96.5	109.5	1.5	Pass	-
58	-	28/06/2022	-	4	4.8	98.5	96.5	-0.5	Pass	-
59	-	28/06/2022	-	4	3.6	98.5	109.5	1.5	Pass	-
60	-	28/06/2022	-	4	4.1	99.0	109.5	1.5	Pass	-
61	-	29/06/2022	-	1	4.5	97.0	99.0	-0.5	Pass	-
62	-	29/06/2022	-	1	3.0	97.0	108.0	1.5	Pass	-
63	-	29/06/2022	-	1	3.8	97.5	107.5	1.5	Pass	-
64	-	30/06/2022	-	2	1.8	97.0	106.0	1.5	Pass	-
65	-	30/06/2022	-	2	2.1	97.0	109.5	2.0	Pass	-
66	-	30/06/2022	-	2	4.2	97.5	96.5	-0.5	Pass	-
67	-	1/7/2022	-	1	4.0	97.0	97.5	-0.5	Pass	-
68	-	1/7/2022	-	1	2.8	96.5	108.0	1.5	Pass	-
69	-	1/7/2022	-	1	3.1	97.5	108.5	2.0	Pass	-
70	-	4/7/2022	-	2	2.9	97.0	107.0	1.5	Pass	-
71	-	4/7/2022	-	2	3.4	96.5	96.0	-0.5	Pass	-
72	-	4/7/2022	-	2	4.6	97.5	96.5	-0.5	Pass	-
73	-	6/9/2022	-	1	0.0	98.0	97.0	-0.5	Pass	-
74	-	6/9/2022	-	1	0.0	95.5	107.5	2.0	Pass	-
75	-	6/9/2022	-	1	0.0	96.0	108.5	2.0	Pass	-
76	-	7/9/2022	-	1	0.0	96.5	97.5	-0.5	Pass	-
77	-	7/9/2022	-	1	0.0	98.5	97.5	-0.5	Pass	-
78	-	7/9/2022	-	1	0.0	100.0	109.0	2.0	Pass	-
79	-	5/10/2022	-	1	0.0	98.5	107.0	1.5	Pass	-
80	-	5/10/2022	-	1	0.0	98.5	99.0	-0.5	Pass	-
81	-	5/10/2022	-	1	0.0	98.5	96.0	-1.0	Pass	-
82	-	11/1/2023	-	5	3.0	97.0	110.0	2.0	Pass	-
83	-	11/1/2023	-	5	0.0	97.0	107.0	1.5	Pass	-
84	-	11/1/2023	-	5	0.0	98.0	96.5	-0.5	Pass	-
85	-	12/1/2023	-	4	4.6	97.0	110.5	2.0	Pass	-
86	-	12/1/2023	-	4	2.0	97.0	98.0	-0.5	Pass	-
87	-	12/1/2023	-	4	3.8	95.5	106.5	1.5	Pass	-

\*\* Negative (-) value indicates that the field moisture content is drier than the optimum moisture content (OMC)

\*\* Positive (+) value indicates that the field moisture content is wetter than the optimum moisture content (OMC)

88	-	13/01/2023	-	6	5.0	98.5	98.5	-0.5	Pass	-
89	-	13/01/2023	-	6	2.0	97.5	96.5	-0.5	Pass	-
90	-	13/01/2023	-	6	3.5	99.5	96.0	-0.5	Pass	-
91	-	31/01/2023	-	5	4.2	97.5	96.5	-0.5	Pass	-
92	-	31/01/2023	-	7	6.1	96.0	95.0	-0.5	Pass	-
93	-	31/01/2023	-	7	3.1	97.5	109.0	1.5	Pass	-
94	-	1/2/2023	-	7	0.0	96.5	109.5	2.0	Pass	-
95	-	1/2/2023	-	7	0.0	96.0	108.5	2.0	Pass	-
96	-	1/2/2023	-	7	0.0	96.0	107.0	1.5	Pass	-
97	-	2/2/2023	-	8	0.0	98.0	107.0	1.5	Pass	-
98	-	2/2/2023	-	8	3.8	95.5	97.0	-0.5	Pass	-
99	-	2/2/2023	-	9	4.5	96.0	96.5	-0.5	Pass	-
100	-	24/02/2023	-	FSL	2.9	96.0	98.5	-0.5	Pass	-
101	-	24/02/2023	-	FSL	0.0	97.0	107.5	2.0	Pass	-
102	-	24/02/2023	-	FSL	4.1	97.5	97.0	-0.5	Pass	-
103	-	27/02/2023	-	FSL	0.0	97.0	98.5	-0.5	Pass	-
104	-	27/02/2023	-	FSL	0.0	98.5	108.5	2.0	Pass	-
105	-	27/02/2023	-	FSL	0.0	96.0	108.0	2.0	Pass	-
106	-	7/3/2023	-	6	0.0	97.0	108.5	2.0	Pass	-
107	-	7/3/2023	-	6	4.6	96.0	99.0	-0.5	Pass	-
108	-	7/3/2023	-	6	5.2	97.5	98.5	-0.5	Pass	-
109	-	10/3/2023	-	7	3.2	96.5	111.0	2.0	Pass	-
110	-	10/3/2023	-	7	2.9	96.0	109.5	1.5	Pass	-
111	-	10/3/2023	-	7	4.9	97.5	97.0	-0.5	Pass	-

\*\* Negative (-) value indicates that the field moisture content is drier than the optimum moisture content (OMC)

\*\* Positive (+) value indicates that the field moisture content is wetter than the optimum moisture content (OMC)

---

## **Appendix D – NATA Test Results**

## Field Density Test Results AS1289.5.7.1

A & Y Associates Pty Ltd  
5/16 Network Drive  
Truganina VIC 3029  
PH: 0400 413 531  
info@ayassociates.com.au

<b>Client:</b>	BMD Urban			<b>Job No:</b>	BMD2324	
<b>Project:</b>	Merrifield Estate - Stage 50 (Level 1)			<b>Report:</b>	1	
<b>Location:</b>	Mickleham					

Sample No	1	2	3			
Date Tested	12/05/2022	12/05/2022	12/05/2022			
Time Tested	AM	AM	PM			

Test Location	Refer to Plan	Refer to Plan	Refer to Plan			
Level/Layer	1	1	1			
Layer Thickness	mm 200	mm 200	mm 200			
Test Depth	mm 175	mm 175	mm 175			
Field Wet Density	t/m <sup>3</sup> 1.89	t/m <sup>3</sup> 1.98	t/m <sup>3</sup> 1.99			
Field Moisture Content	% 23.3	% 20.8	% 19.5			
Material:	Imported Clay	Imported Clay	Imported Clay			

Oversize Material	WET, %	3.5	4.2	5.1		
Sieve Size	mm	19	19	19		
Peak Converted Wet Density	t/m <sup>3</sup>	1.90	2.00	2.04		
Optimum Moisture Content	%	21.5	21	20.5		

<b>Moisture Ratio</b>	%	108.5	99	95		
<b>Moisture Variation</b>	%	1.5	-0.5	-0.5		
<b>from OMC</b>		Wetter	Drier	Drier		
<b>Density Ratio</b>	%	99.0	98.5	97.5		

<b>Specification:</b>	95% STD	<b>Test Selection:</b>	N/A
<b>Notes:</b>	Ref : 1120 0343-1 (SI01)		
<b>Test Method</b>	AS1289 5.8.1, 5.7.1, 2.1.1, 1.1	<b>Sampling Method:</b>	AS 1289 1.2.1 6.4(b)



NATA Accredited Laboratory No. 20172  
Accreditation for compliance with ISO/IEC 17025 - Testing  
The results of tests, calibrations and/or measurements included  
in this document, are traceable to Australian / National Standards

Approved Signatory:




David Burns  
05/07/2022

Date:





Test Location

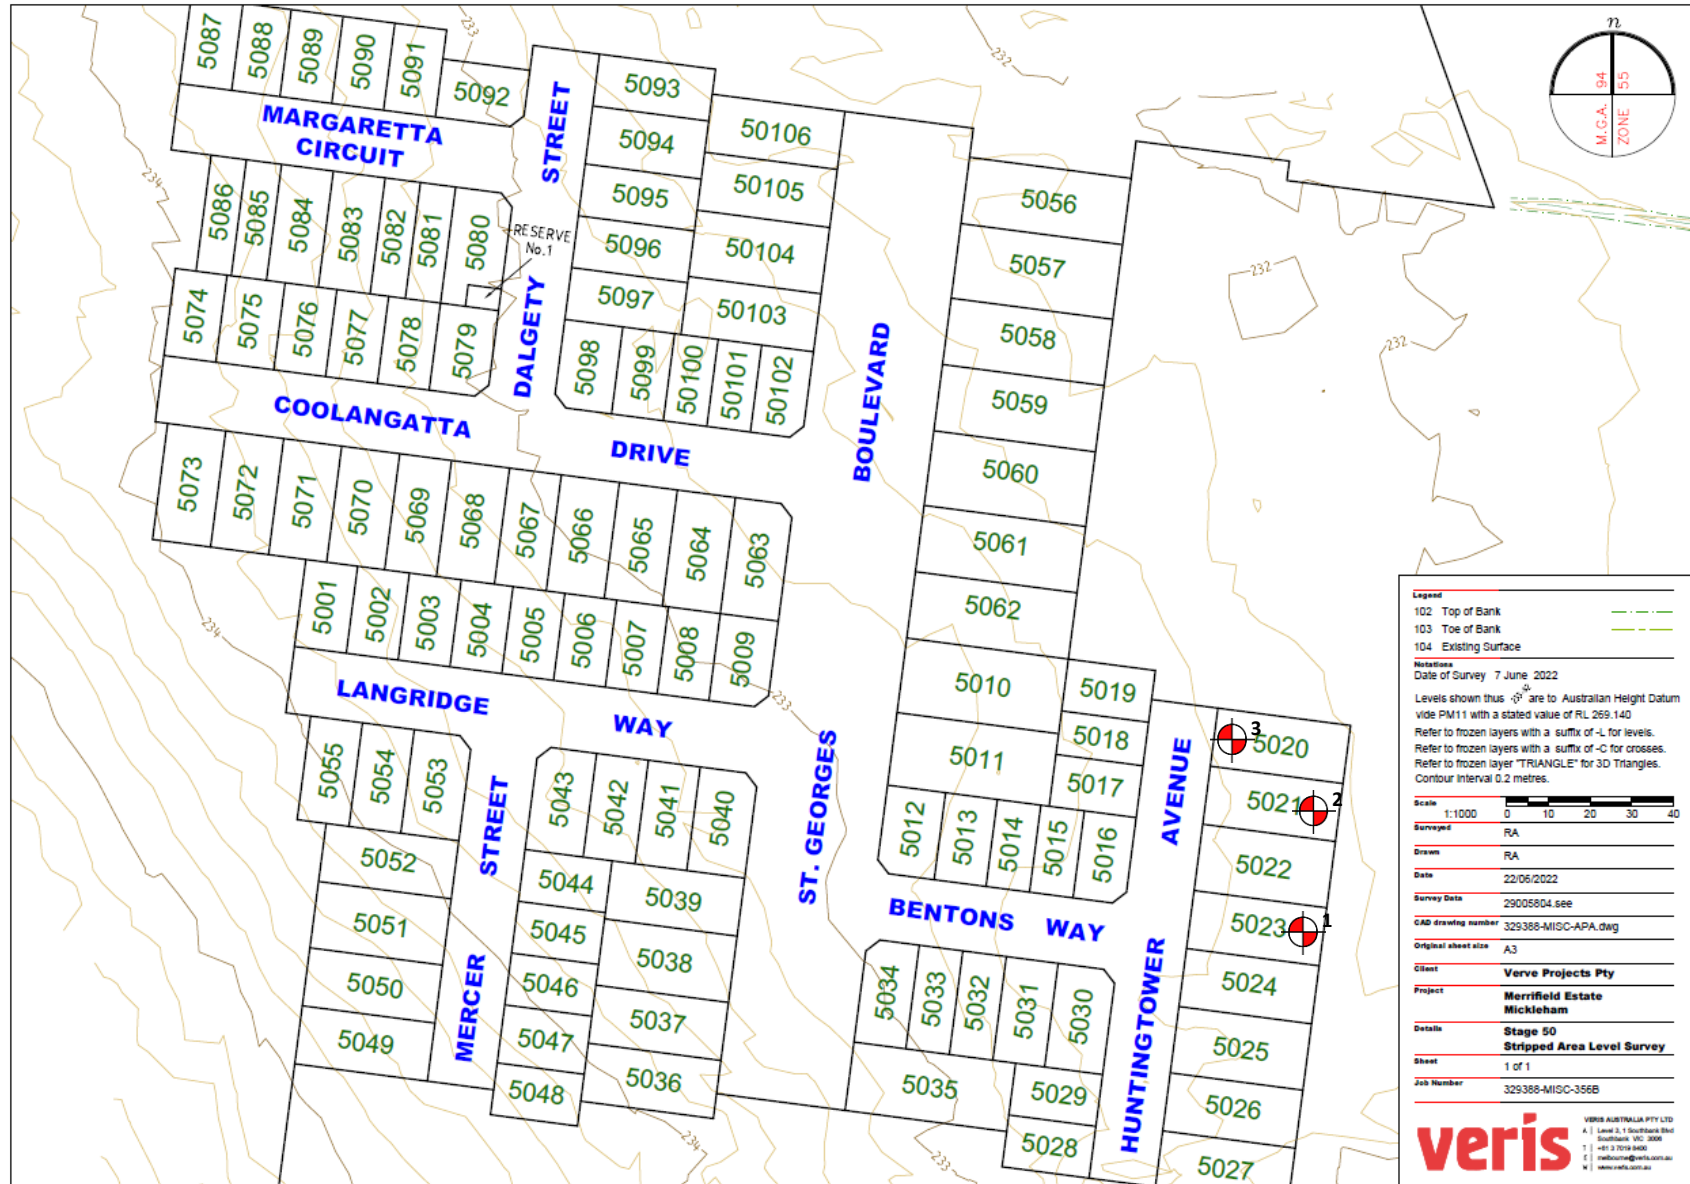

<b>PROJECT:</b> Merrifield Estate – Stage 50 (Level 1)	<b>CLIENT:</b> BMD Urban	<b>DATE:</b> 12/05/2022
<b>LOCATION:</b> Mickleham	<b>PROJECT No:</b> 1120 0343-1 (SI01)	<b>SITE PLAN SKETCH—NOT TO SCALE</b>



**A&Y ASSOCIATES**  
GEOTECHNICAL ENGINEERING CONSULTANTS

## Field Density Test Results AS1289.5.7.1

A & Y Associates Pty Ltd  
5/16 Network Drive  
Truganina VIC 3029  
PH: 0400 413 531  
info@ayassociates.com.au

<b>Client:</b>	BMD Urban			<b>Job No:</b>	BMD2324	
<b>Project:</b>	Merrifield Estate - Stage 50 (Level 1)			<b>Report:</b>	2	
<b>Location:</b>	Mickleham					

Sample No	4	5	6			
Date Tested	13/05/2022	13/05/2022	13/05/2022			
Time Tested	AM	AM	PM			

Test Location	Refer to Plan	Refer to Plan	Refer to Plan			
Level/Layer	1	1	1			
Layer Thickness	mm 200	mm 200	mm 200			
Test Depth	mm 175	mm 175	mm 175			
Field Wet Density	t/m <sup>3</sup> 1.88	t/m <sup>3</sup> 1.92	t/m <sup>3</sup> 2.00			
Field Moisture Content	% 18.4	% 17.3	% 19.4			
Material:	Imported Clay	Imported Clay	Imported Clay			

Oversize Material	WET, % 4.8	WET, % 5.5	WET, % 5.5			
Sieve Size	mm 19	mm 19	mm 19			
Peak Converted Wet Density	t/m <sup>3</sup> 1.89	t/m <sup>3</sup> 1.99	t/m <sup>3</sup> 2.08			
Optimum Moisture Content	% 19.5	% 15.5	% 18			



  

<b>Moisture Ratio</b>	% 94.5	% 111.5	% 107.5			
<b>Moisture Variation</b>	% -1.0	% 1.5	% 1.5			
<b>from OMC</b>	Drier	Wetter	Wetter			
<b>Density Ratio</b>	% 98.5	% 96.0	% 101.0			


<b>Specification:</b>	95% STD	<b>Test Selection:</b>	N/A
<b>Notes:</b>	Ref : 1120 0343-1 (SI02)		
<b>Test Method</b>	AS1289 5.8.1, 5.7.1, 2.1.1, 1.1	<b>Sampling Method:</b>	AS 1289 1.2.1 6.4(b)

 <b>NATA</b> WORLD RECOGNISED ACCREDITATION	NATA Accredited Laboratory No. 20172	Approved Signatory:    David Burns  Date: 05/07/2022
	Accreditation for compliance with ISO/IEC 17025 - Testing	
	The results of tests, calibrations and/or measurements included in this document, are traceable to Australian / National Standards	



Test Location

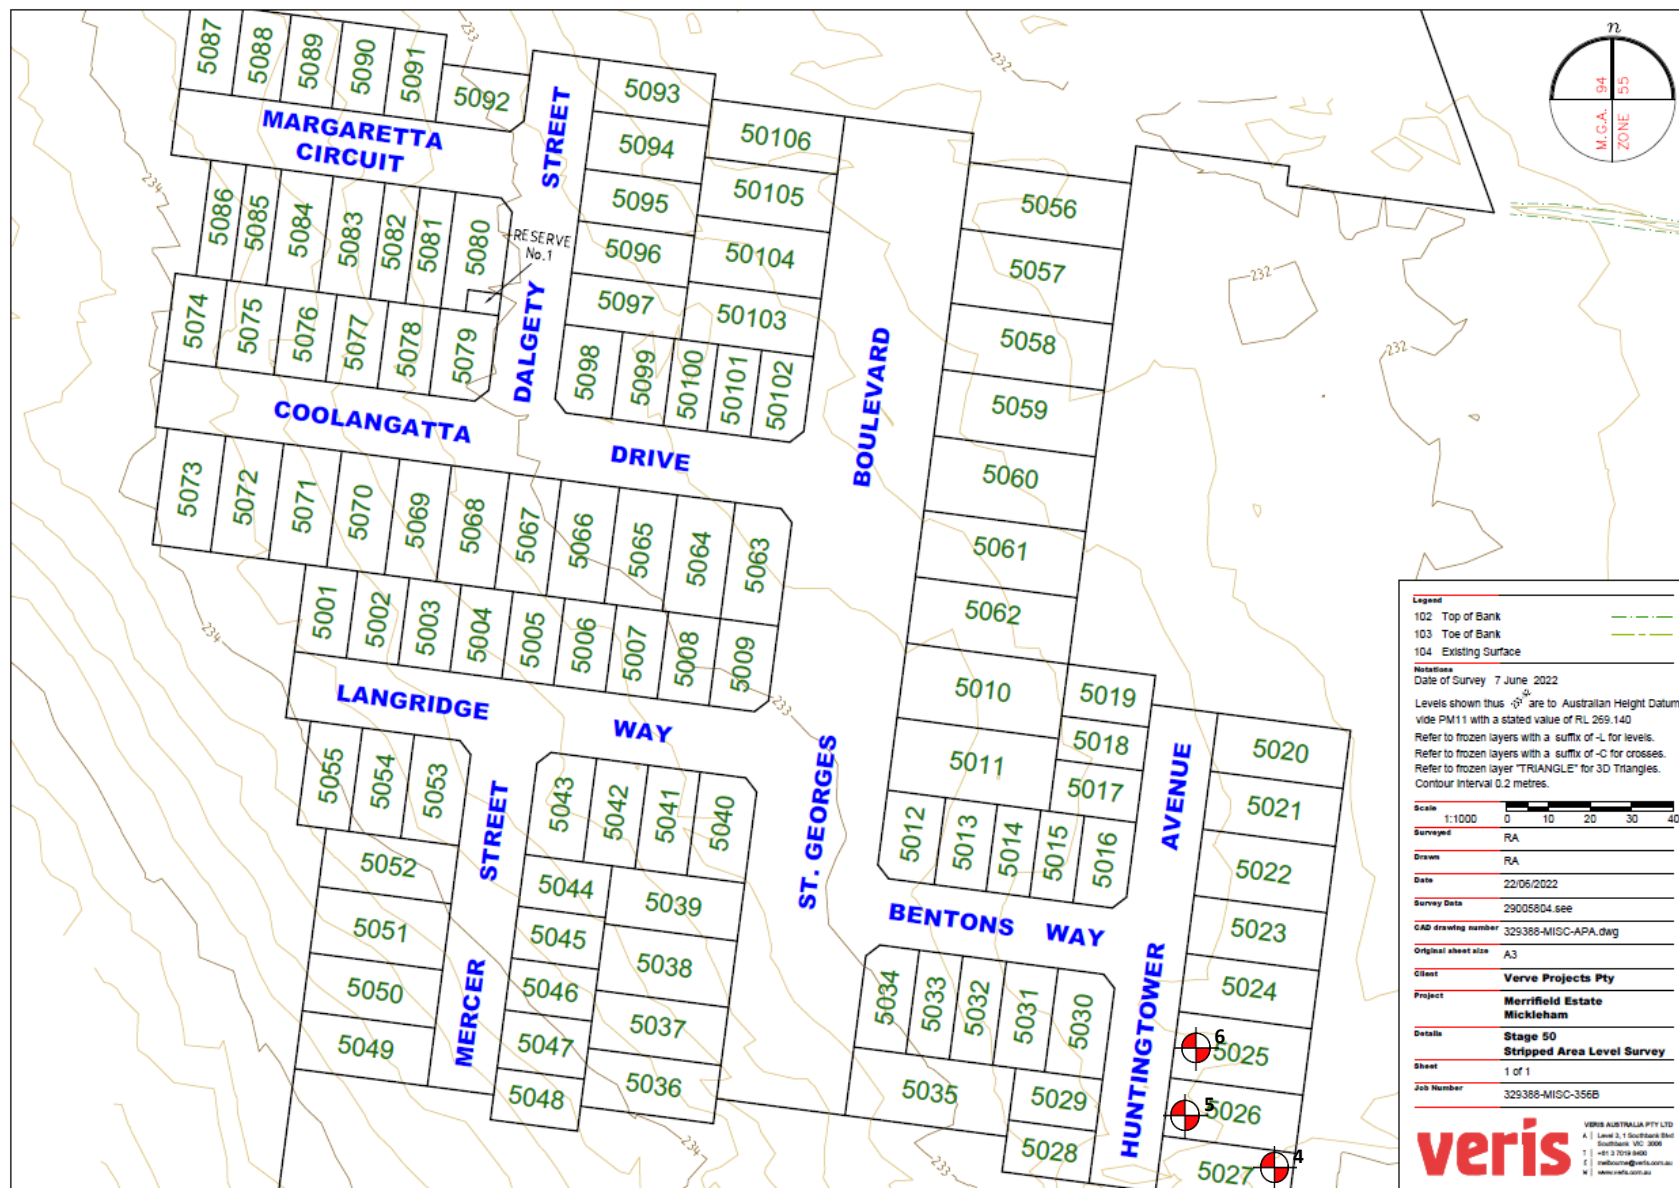

PROJECT:  
Merrifield Estate – Stage 50 (Level 1)

CLIENT:  
BMD Urban

DATE:  
13/05/2022

LOCATION:  
Mickleham

PROJECT No:  
1120 0343-1 (SI02)

SITE PLAN SKETCH—NOT TO SCALE



**A&Y ASSOCIATES**  
GEOTECHNICAL ENGINEERING CONSULTANTS

## Field Density Test Results AS1289.5.7.1

A & Y Associates Pty Ltd  
5/16 Network Drive  
Truganina VIC 3029  
PH: 0400 413 531  
info@ayassociates.com.au

<b>Client:</b>	BMD Urban			<b>Job No:</b>	BMD2324	
<b>Project:</b>	Merrifield Estate - Stage 50 (Level 1)			<b>Report:</b>	3	
<b>Location:</b>	Mickleham					
Sample No	7	8	9			
Date Tested	16/05/2022	16/05/2022	16/05/2022			
Time Tested	AM	AM	AM			
Test Location	Refer to Plan	Refer to Plan	Refer to Plan			
Level/Layer	1	1	1			
Layer Thickness	mm 200	mm 200	mm 200			
Test Depth	mm 175	mm 175	mm 175			
Field Wet Density	t/m <sup>3</sup> 1.94	t/m <sup>3</sup> 1.90	t/m <sup>3</sup> 1.82			
Field Moisture Content	% 19.2	% 21.3	% 24.4			
Material:	Imported Clay	Imported Clay	Imported Clay			
Oversize Material	WET, % 5.9	WET, % 5.2	WET, % 3.2			
Sieve Size	mm 19	mm 19	mm 19			
Peak Converted Wet Density	t/m <sup>3</sup> 1.95	t/m <sup>3</sup> 1.96	t/m <sup>3</sup> 1.86			
Optimum Moisture Content	% 17.5	% 19.5	% 25.5			
<b>Moisture Ratio</b>	% 109.5	% 109	% 95.5			
<b>Moisture Variation</b>	% 1.5	% 1.5	% -1.0			
<b>from OMC</b>	Wetter	Wetter	Drier			
<b>Density Ratio</b>	% 99.0	% 96.0	% 97.0			

<b>Specification:</b>	95% STD	<b>Test Selection:</b>	N/A
<b>Notes:</b>	Ref : 1120 0343-1 (SI03)		
<b>Test Method</b>	AS1289 5.8.1, 5.7.1, 2.1.1, 1.1	<b>Sampling Method:</b>	AS 1289 1.2.1 6.4(b)



NATA Accredited Laboratory No. 20172  
Accreditation for compliance with ISO/IEC 17025 - Testing  
The results of tests, calibrations and/or measurements included  
in this document, are traceable to Australian / National Standards

Approved Signatory:




David Burns  
Date: 05/07/2022





Test Location

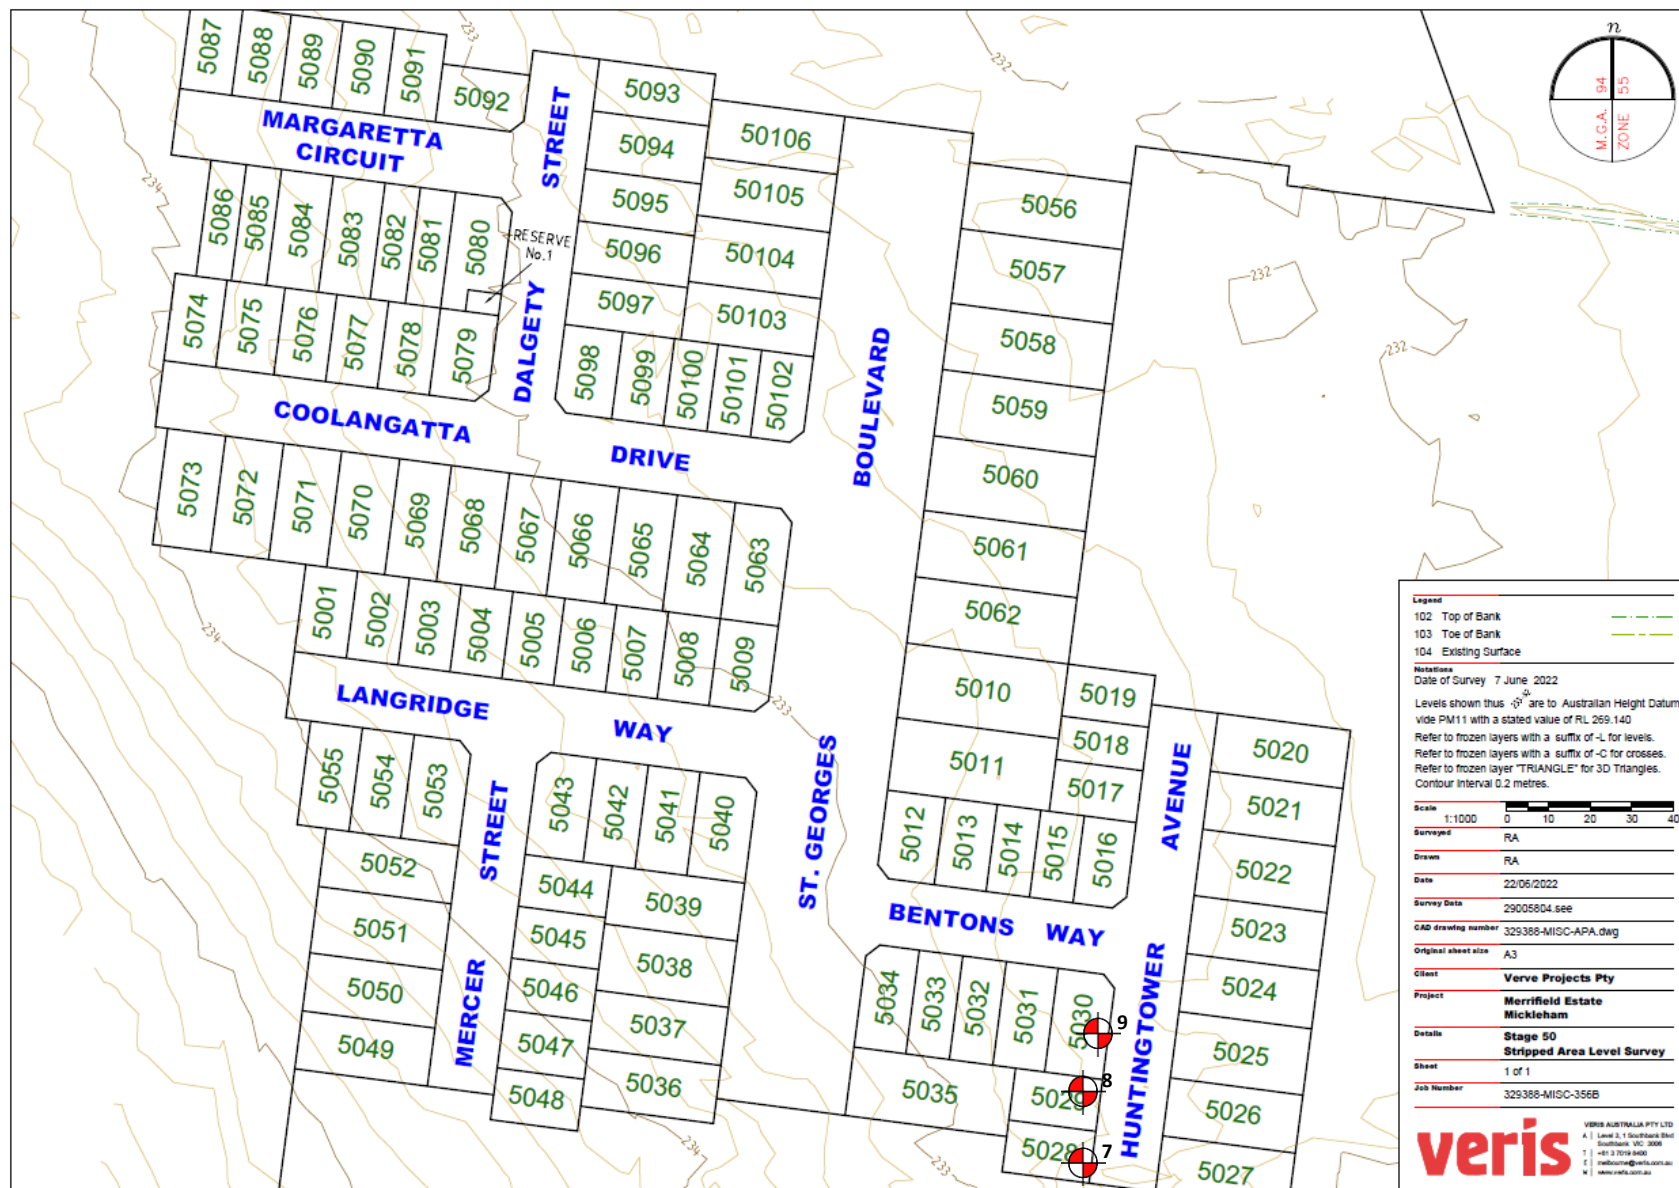

<b>PROJECT:</b> Merrifield Estate – Stage 50 (Level 1)	<b>CLIENT:</b> BMD Urban	<b>DATE:</b> 16/05/2022
<b>LOCATION:</b> Mickleham	<b>PROJECT No:</b> 1120 0343-1 (SI03)	<b>SITE PLAN SKETCH—NOT TO SCALE</b>



**A&Y ASSOCIATES**  
GEOTECHNICAL ENGINEERING CONSULTANTS

## Field Density Test Results AS1289.5.7.1

A & Y Associates Pty Ltd  
5/16 Network Drive  
Truganina VIC 3029  
PH: 0400 413 531  
info@ayassociates.com.au

<b>Client:</b>	BMD Urban			<b>Job No:</b>	BMD2324		
<b>Project:</b>	Merrifield Estate - Stage 50 (Level 1)			<b>Report:</b>	4		
<b>Location:</b>	Mickleham						

Sample No	10	11	12			
Date Tested	17/05/2022	17/05/2022	17/05/2022			
Time Tested	AM	AM	AM			

Test Location	Refer to Plan	Refer to Plan	Refer to Plan			
Level/Layer	Layer 2	Layer 2	Layer 2			
Layer Thickness	mm 200	mm 200	mm 200			
Test Depth	mm 175	mm 175	mm 175			
Field Wet Density	t/m <sup>3</sup> 1.94	t/m <sup>3</sup> 1.97	t/m <sup>3</sup> 1.83			
Field Moisture Content	% 22.1	% 20.7	% 24.3			
Material:	Imported Clay	Imported Clay	Imported Clay			

Oversize Material	WET, % 5.5	WET, % 5.8	WET, % 3.5			
Sieve Size	mm 19	mm 19	mm 19			
Peak Converted Wet Density	t/m <sup>3</sup> 1.94	t/m <sup>3</sup> 1.93	t/m <sup>3</sup> 1.90			
Optimum Moisture Content	% 20.5	% 21.5	% 22.5			



  

<b>Moisture Ratio</b>	% 107.5	% 96.5	% 108			
<b>Moisture Variation</b>	% 1.5	% -0.5	% 2.0			
<b>from OMC</b>	Wetter	Drier	Wetter			
<b>Density Ratio</b>	% 99.0	% 101.5	% 96.0			


<b>Specification:</b>	95% STD	<b>Test Selection:</b>	N/A
<b>Notes:</b>	Ref : 1120 0343-1 (SI04)		
<b>Test Method</b>	AS1289 5.8.1, 5.7.1, 2.1.1, 1.1	<b>Sampling Method:</b>	AS 1289 1.2.1 6.4(b)

 <b>NATA</b> WORLD RECOGNISED ACCREDITATION	NATA Accredited Laboratory No. 20172	Approved Signatory:   Date: 06/07/2022
	Accreditation for compliance with ISO/IEC 17025 - Testing	
	The results of tests, calibrations and/or measurements included in this document, are traceable to Australian / National Standards	



Test Location

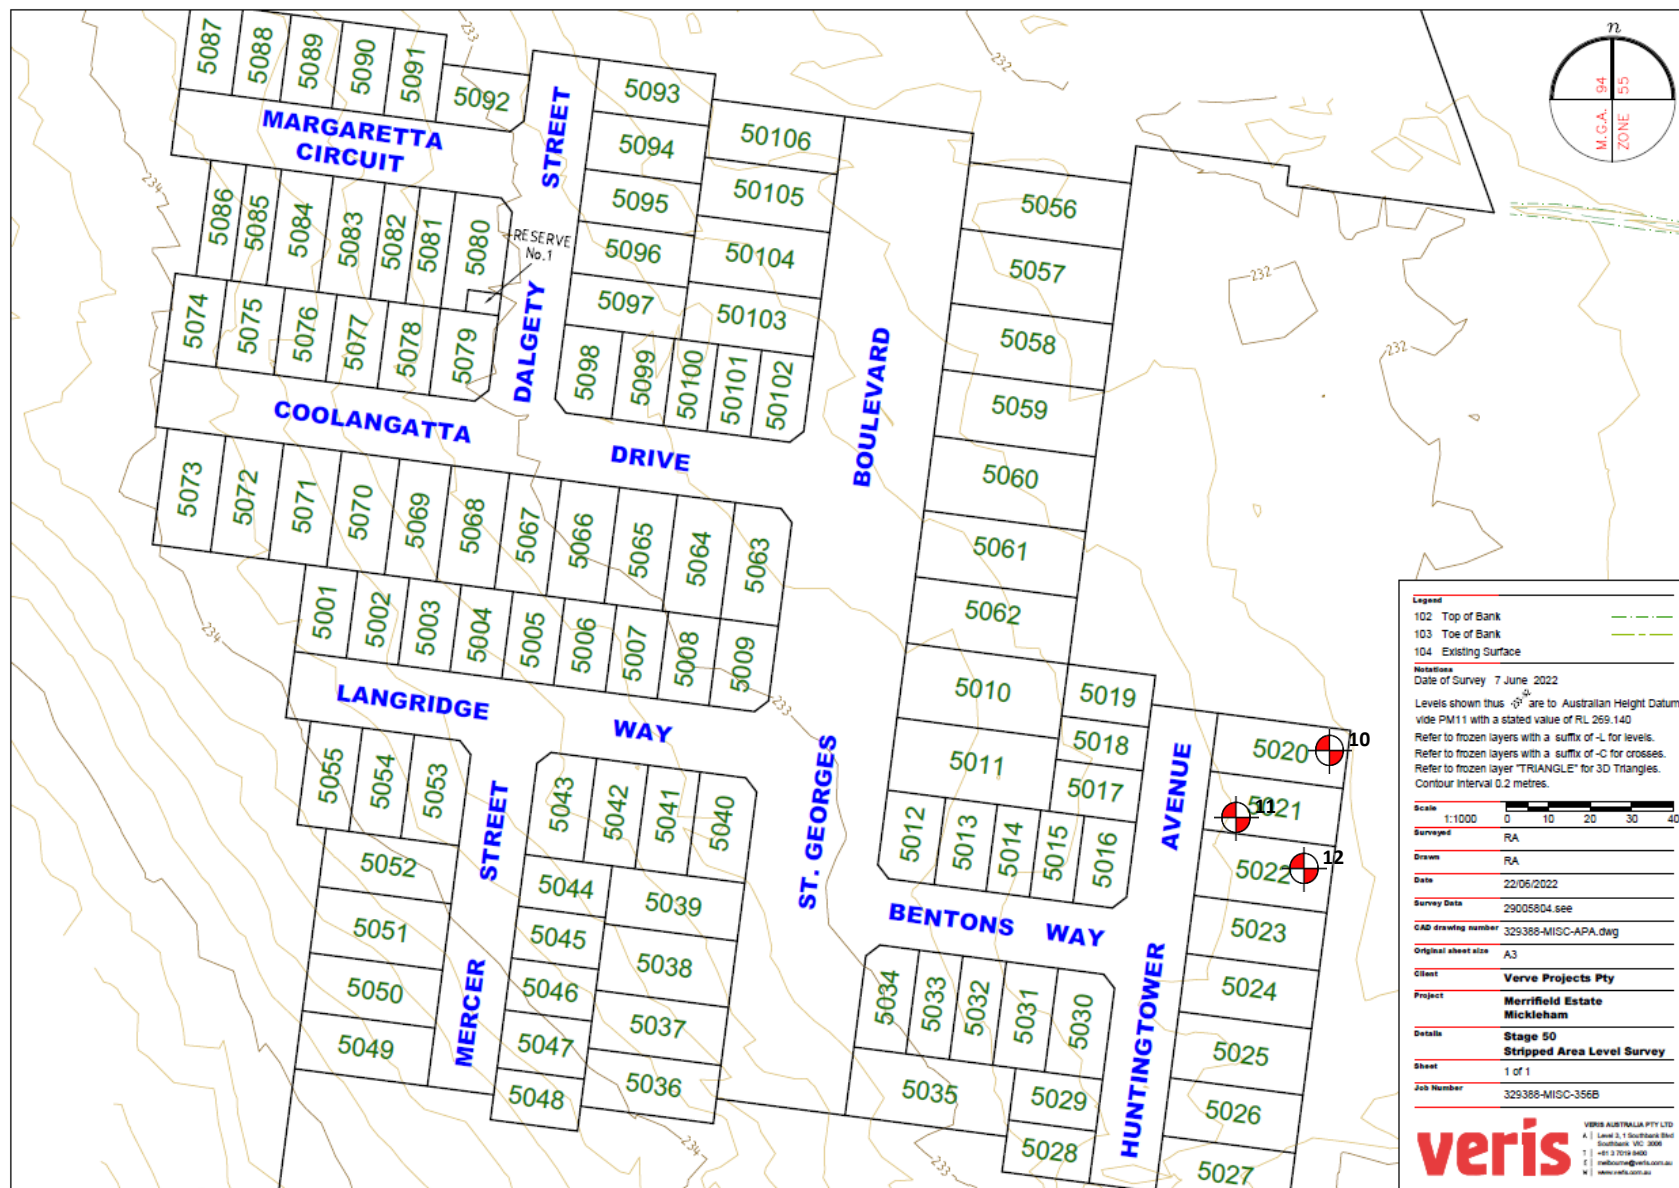

PROJECT:

Merrifield Estate – Stage 50 (Level 1)

CLIENT:

BMD Urban

DATE:

16/05/2022

LOCATION:

Mickleham

PROJECT No:

1120 0343-1 (SI04)

SITE PLAN SKETCH—NOT TO SCALE



**A&Y ASSOCIATES**  
GEOTECHNICAL ENGINEERING CONSULTANTS

## Field Density Test Results AS1289.5.7.1

A & Y Associates Pty Ltd  
5/16 Network Drive  
Truganina VIC 3029  
PH: 0400 413 531  
info@ayassociates.com.au

<b>Client:</b>	BMD Urban			<b>Job No:</b>	BMD2324	
<b>Project:</b>	Merrifield Estate - Stage 50 (Level 1)			<b>Report:</b>	5	
<b>Location:</b>	Mickleham					
Sample No	13	14	15			
Date Tested	18/05/2022	18/05/2022	18/05/2022			
Time Tested	AM	AM	AM			
Test Location	Refer to Plan	Refer to Plan	Refer to Plan			
Level/Layer	Layer 2	Layer 2	Layer 2			
Layer Thickness	mm 200	mm 200	mm 200			
Test Depth	mm 175	mm 175	mm 175			
Field Wet Density	t/m <sup>3</sup> 1.92	t/m <sup>3</sup> 1.84	t/m <sup>3</sup> 1.88			
Field Moisture Content	% 19.3	% 24.8	% 23.1			
Material:	Imported Clay	Imported Clay	Imported Clay			
Oversize Material	WET, % 4.9	WET, % 3.2	WET, % 4.6			
Sieve Size	mm 19	mm 19	mm 19			
Peak Converted Wet Density	t/m <sup>3</sup> 2.00	t/m <sup>3</sup> 1.92	t/m <sup>3</sup> 1.96			
Optimum Moisture Content	% 19.5	% 25	% 21.5			
<b>Moisture Ratio</b>	% 99	% 99	% 107.5			
<b>Moisture Variation from OMC</b>	% -0.5 Drier	% -0.5 Drier	% 1.5 Wetter			
<b>Density Ratio</b>	% 95.5	% 95.0	% 95.5			

<b>Specification:</b>	95% STD	<b>Test Selection:</b>	N/A
<b>Notes:</b>	Ref : 1120 0343-1 (SI05)		
<b>Test Method</b>	AS1289 5.8.1, 5.7.1, 2.1.1, 1.1	<b>Sampling Method:</b>	AS 1289 1.2.1 6.4(b)



NATA Accredited Laboratory No. 20172  
Accreditation for compliance with ISO/IEC 17025 - Testing  
The results of tests, calibrations and/or measurements included  
in this document, are traceable to Australian / National Standards

Approved Signatory:




David Burns  
Date: 06/07/2022





Test Location

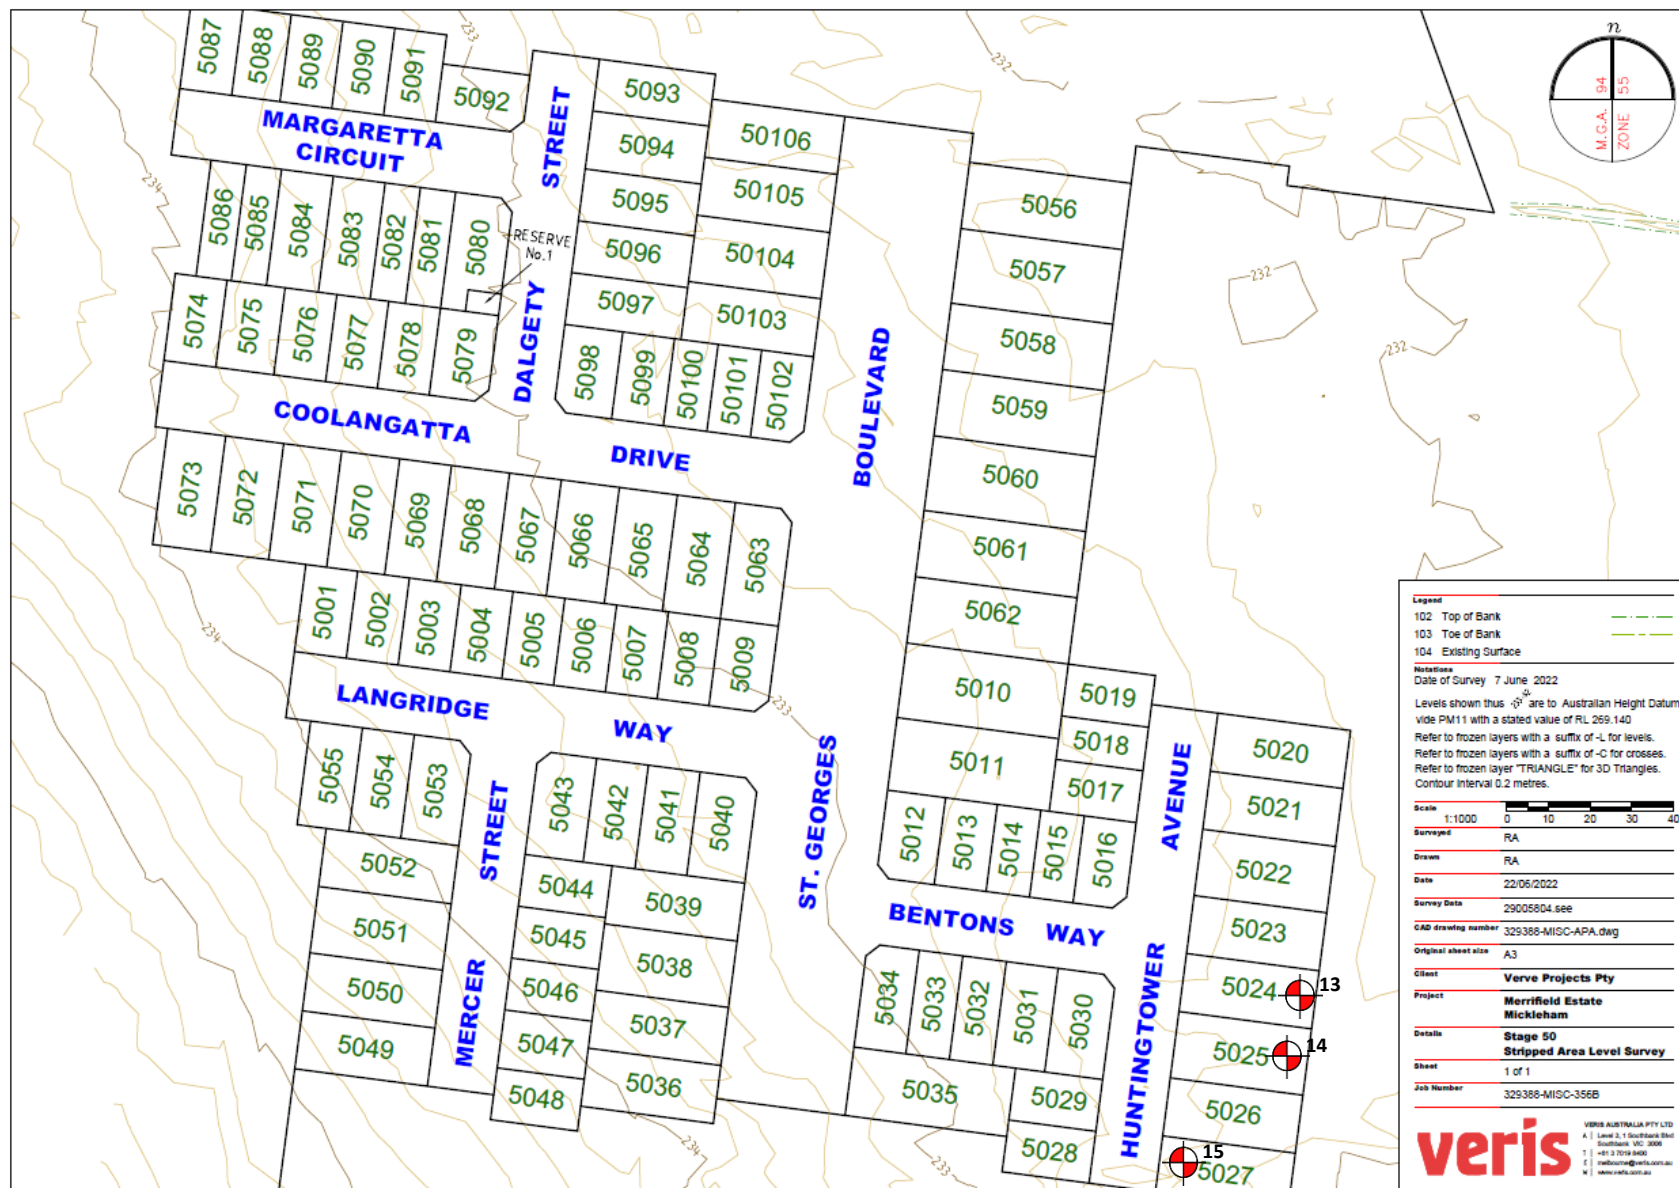

PROJECT:

Merrifield Estate – Stage 50 (Level 1)

CLIENT:

BMD Urban

DATE:

18/05/2022

LOCATION:

Mickleham

PROJECT No:

1120 0343-1 (SI05)

SITE PLAN SKETCH—NOT TO SCALE



**A&Y ASSOCIATES**  
GEOTECHNICAL ENGINEERING CONSULTANTS

## Field Density Test Results AS1289.5.7.1

A & Y Associates Pty Ltd  
5/16 Network Drive  
Truganina VIC 3029  
PH: 0400 413 531  
info@ayassociates.com.au

<b>Client:</b>	BMD Urban			<b>Job No:</b>	BMD2324	
<b>Project:</b>	Merrifield Estate - Stage 50 (Level 1)			<b>Report:</b>	6	
<b>Location:</b>	Mickleham					

Sample No	16	17	18			
Date Tested	19/05/2022	19/05/2022	19/05/2022			
Time Tested	AM	AM	AM			

Test Location	Refer to Plan	Refer to Plan	Refer to Plan			
Level/Layer	Layer 1	Layer 1	Layer 1			
Layer Thickness	mm 200	mm 200	mm 200			
Test Depth	mm 175	mm 175	mm 175			
Field Wet Density	t/m <sup>3</sup> 1.85	t/m <sup>3</sup> 1.92	t/m <sup>3</sup> 1.94			
Field Moisture Content	% 24.4	% 22.4	% 20.7			
Material:	Imported Clay	Imported Clay	Imported Clay			

Oversize Material	WET, % 3.0	WET, % 4.5	WET, % 5.3			
Sieve Size	mm 19	mm 19	mm 19			
Peak Converted Wet Density	t/m <sup>3</sup> 1.89	t/m <sup>3</sup> 1.94	t/m <sup>3</sup> 1.96			
Optimum Moisture Content	% 22.5	% 20.5	% 21			

<b>Moisture Ratio</b>	% 108.5	% 109	% 98.5			
<b>Moisture Variation</b>	% 2.0	% 1.5	% -0.5			
<b>from OMC</b>	Wetter	Wetter	Drier			
<b>Density Ratio</b>	% 97.5	% 98.0	% 98.0			

<b>Specification:</b>	95% STD	<b>Test Selection:</b>	N/A
<b>Notes:</b>	Ref : 1120 0343-1 (SI06)		
<b>Test Method</b>	AS1289 5.8.1, 5.7.1, 2.1.1, 1.1	<b>Sampling Method:</b>	AS 1289 1.2.1 6.4(b)



NATA Accredited Laboratory No. 20172  
Accreditation for compliance with ISO/IEC 17025 - Testing  
The results of tests, calibrations and/or measurements included  
in this document, are traceable to Australian / National Standards


Approved Signatory:



David Burns  
Date: 06/07/2022



Test Location

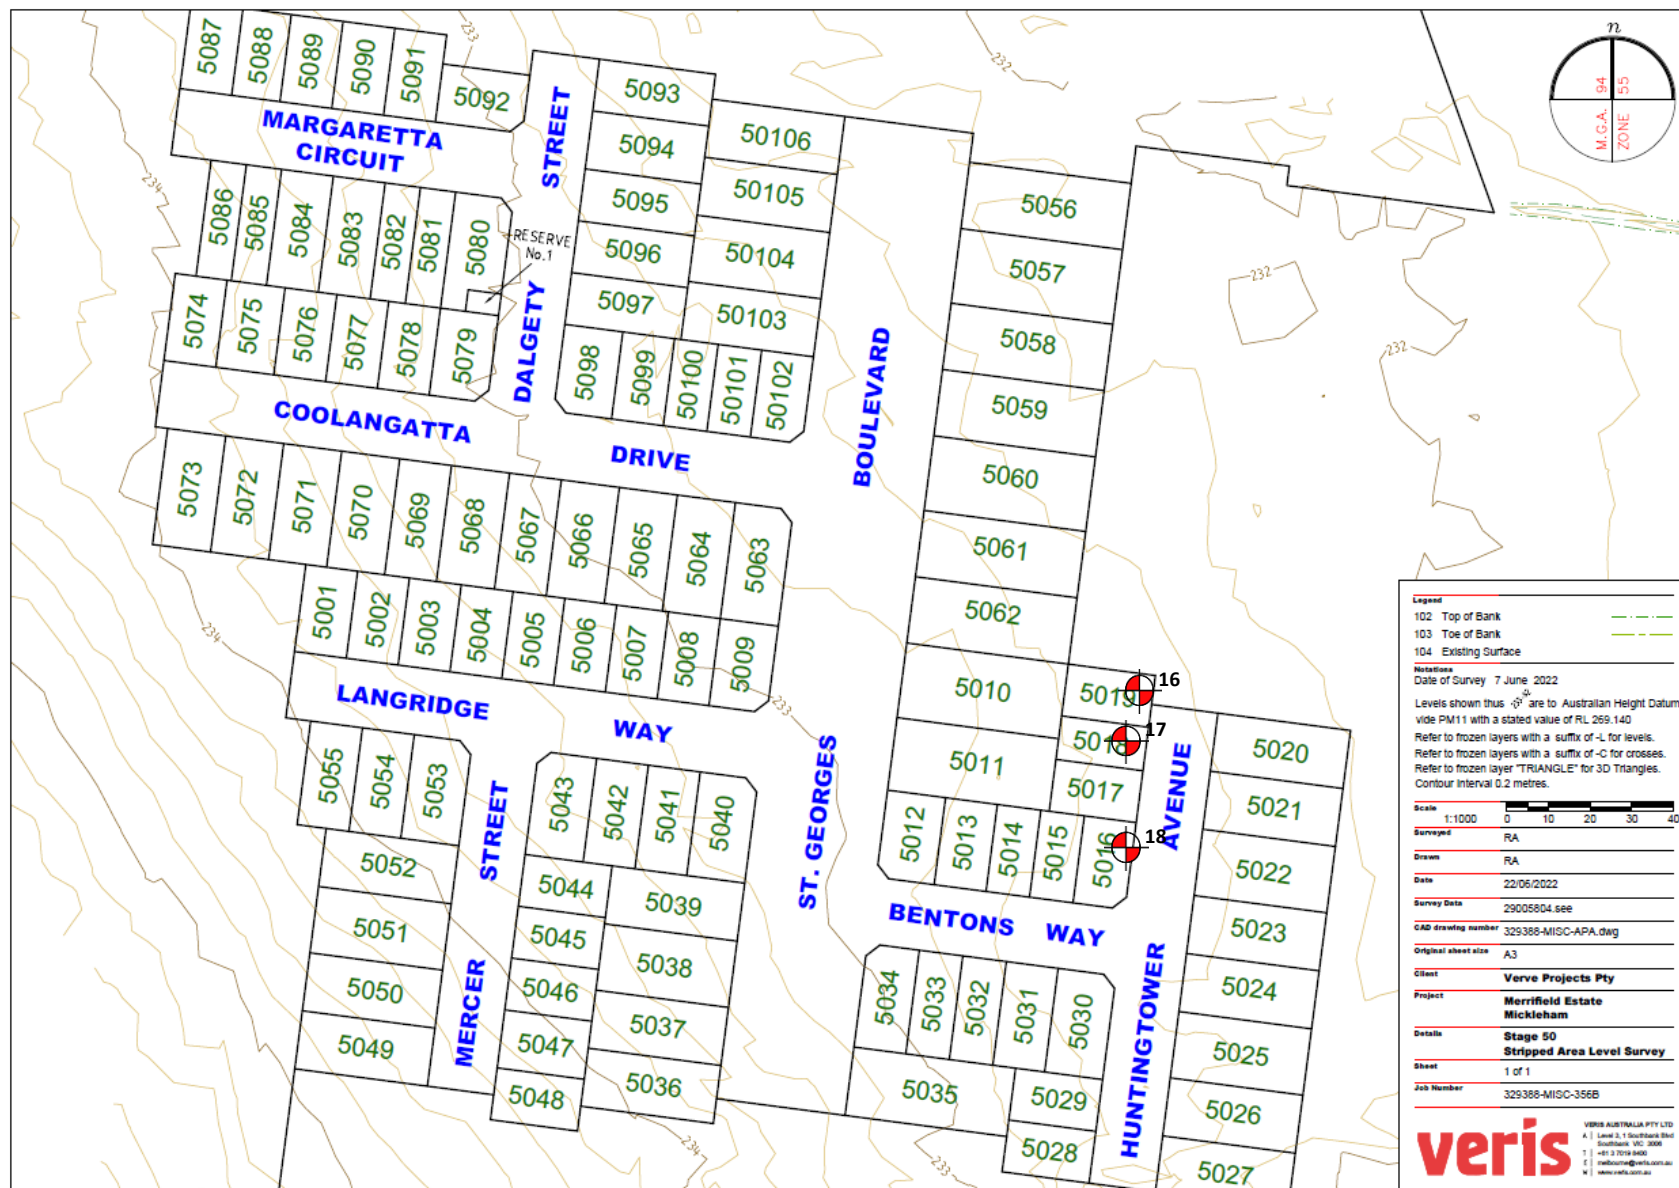

PROJECT: Merrifield Estate – Stage 50 (Level 1)	CLIENT: BMD Urban	DATE: 19/05/2022
LOCATION: Mickleham	PROJECT No: 1120 0343-1 (SI06)	SITE PLAN SKETCH—NOT TO SCALE



**A&Y ASSOCIATES**  
GEOTECHNICAL ENGINEERING CONSULTANTS

## Field Density Test Results AS1289.5.7.1

A & Y Associates Pty Ltd  
5/16 Network Drive  
Truganina VIC 3029  
PH: 0400 413 531  
info@ayassociates.com.au

<b>Client:</b>	BMD Urban			<b>Job No:</b>	BMD2324	
<b>Project:</b>	Merrifield Estate - Stage 50 (Level 1)			<b>Report:</b>	7	
<b>Location:</b>	Mickleham					

Sample No	19	20	21			
Date Tested	20/05/2022	20/05/2022	20/05/2022			
Time Tested	AM	AM	AM			

Test Location	Refer to Plan	Refer to Plan	Refer to Plan			
Level/Layer	Layer 1	Layer 1	Layer 1			
Layer Thickness	mm 200	mm 200	mm 200			
Test Depth	mm 175	mm 175	mm 175			
Field Wet Density	t/m <sup>3</sup> 1.85	t/m <sup>3</sup> 1.84	t/m <sup>3</sup> 1.92			
Field Moisture Content	% 23.8	% 24.3	% 22.4			
Material:	Imported Clay	Imported Clay	Imported Clay			

Oversize Material	WET, %	3.1	3.3	4.1		
Sieve Size	mm	19	19	19		
Peak Converted Wet Density	t/m <sup>3</sup>	1.89	1.86	1.99		
Optimum Moisture Content	%	22	24.5	21		

<b>Moisture Ratio</b>	%	108	99	106.5		
<b>Moisture Variation</b>	%	1.5	-0.5	1.5		
<b>from OMC</b>		Wetter	Drier	Wetter		
<b>Density Ratio</b>	%	97.0	98.0	96.0		

<b>Specification:</b>	95% STD	<b>Test Selection:</b>	N/A
<b>Notes:</b>	Ref : 1120 0343-1 (SI07)		
<b>Test Method</b>	AS1289 5.8.1, 5.7.1, 2.1.1, 1.1	<b>Sampling Method:</b>	AS 1289 1.2.1 6.4(b)



NATA Accredited Laboratory No. 20172  
Accreditation for compliance with ISO/IEC 17025 - Testing  
The results of tests, calibrations and/or measurements included  
in this document, are traceable to Australian / National Standards

Approved Signatory:




David Burns  
Date: 06/07/2022





Test Location

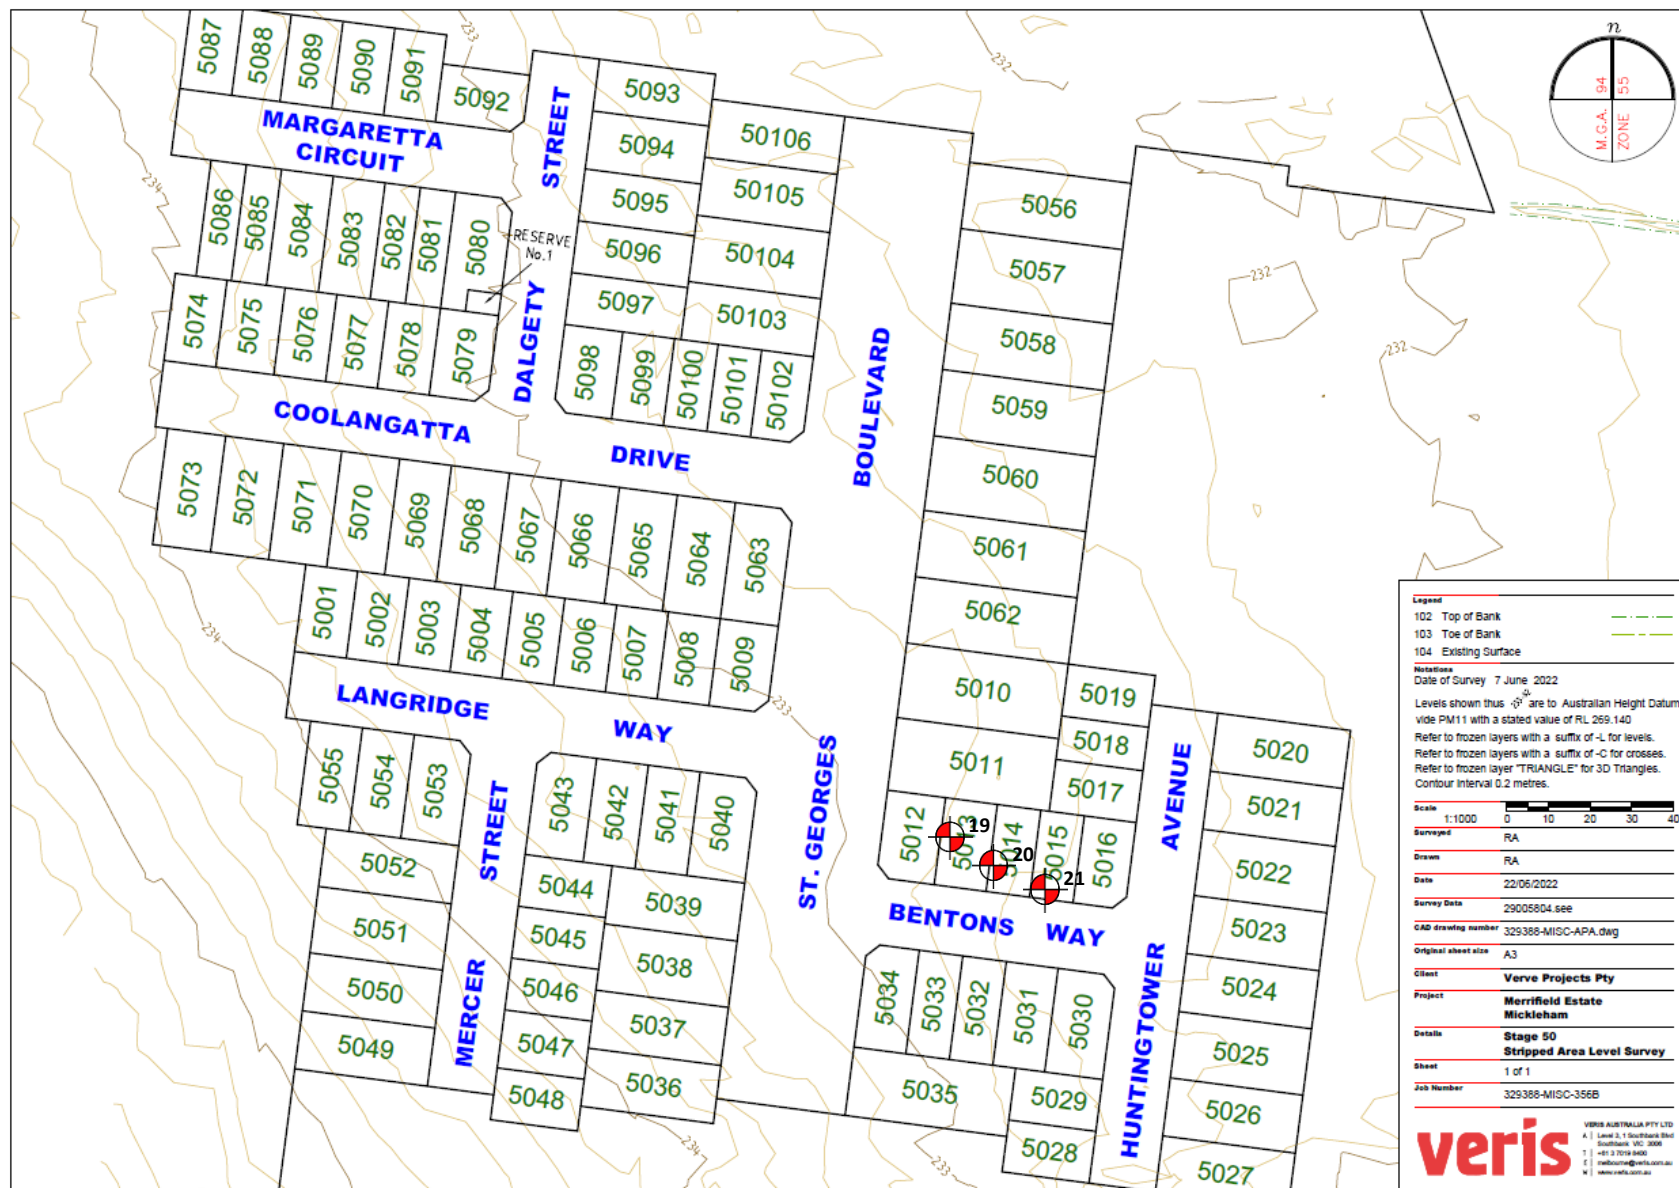

PROJECT: Merrifield Estate – Stage 50 (Level 1)	CLIENT: BMD Urban	DATE: 20/05/2022
LOCATION: Mickleham	PROJECT No: 1120 0343-1 (S107)	SITE PLAN SKETCH—NOT TO SCALE



**A&Y ASSOCIATES**  
GEOTECHNICAL ENGINEERING CONSULTANTS

## Field Density Test Results AS1289.5.7.1

A & Y Associates Pty Ltd  
5/16 Network Drive  
Truganina VIC 3029  
PH: 0400 413 531  
info@ayassociates.com.au

<b>Client:</b>	BMD Urban			<b>Job No:</b>	BMD2324	
<b>Project:</b>	Merrifield Estate - Stage 50 (Level 1)			<b>Report:</b>	8	
<b>Location:</b>	Mickleham					

Sample No	22	23	24			
Date Tested	23/05/2022	23/05/2022	23/05/2022			
Time Tested	AM	AM	AM			

Test Location	Refer to Plan	Refer to Plan	Refer to Plan			
Level/Layer	Layer 2	Layer 2	Layer 2			
Layer Thickness	mm 200	mm 200	mm 200			
Test Depth	mm 175	mm 175	mm 175			
Field Wet Density	t/m <sup>3</sup> 1.89	t/m <sup>3</sup> 1.94	t/m <sup>3</sup> 1.91			
Field Moisture Content	% 23.5	% 21.8	% 20.0			
Material:	Imported Clay	Imported Clay	Imported Clay			

Oversize Material	WET, %	3.0	5.1	4.6		
Sieve Size	mm	19	19	19		
Peak Converted Wet Density	t/m <sup>3</sup>	1.94	1.96	1.94		
Optimum Moisture Content	%	24.5	22	18.5		



  

<b>Moisture Ratio</b>	%	96	99	108		
<b>Moisture Variation from OMC</b>	%	-1.0 Drier	-0.5 Drier	1.5 Wetter		
<b>Density Ratio</b>	%	97.0	98.0	98.0		


<b>Specification:</b>	95% STD	<b>Test Selection:</b>	N/A
<b>Notes:</b>	Ref : 1120 0343-1 (SI08)		
<b>Test Method</b>	AS1289 5.8.1, 5.7.1, 2.1.1, 1.1	<b>Sampling Method:</b>	AS 1289 1.2.1 6.4(b)

 <b>NATA</b> WORLD RECOGNISED ACCREDITATION	NATA Accredited Laboratory No. 20172	Approved Signatory:   Date: 06/07/2022
	Accreditation for compliance with ISO/IEC 17025 - Testing	
	The results of tests, calibrations and/or measurements included in this document, are traceable to Australian / National Standards	



Test Location

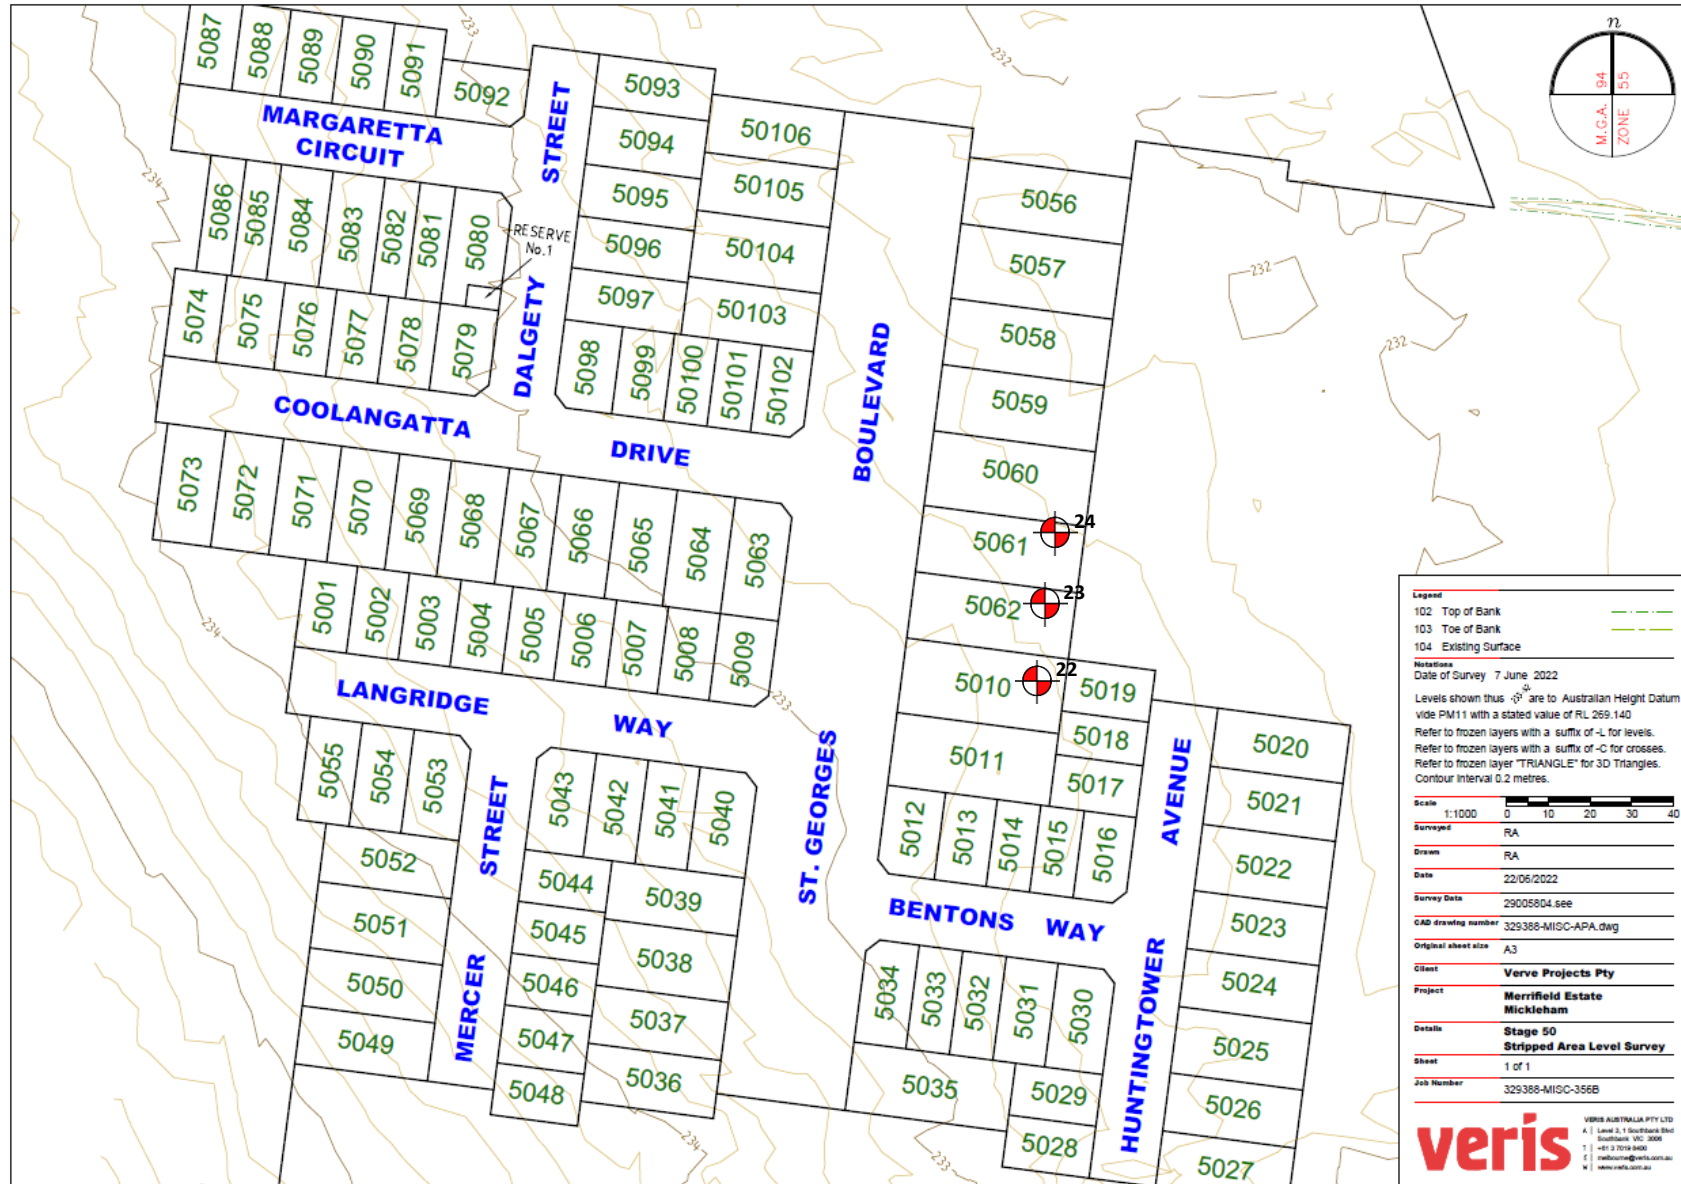

PROJECT: Merrifield Estate – Stage 50 (Level 1)	CLIENT: BMD Urban	DATE: 23/05/2022
LOCATION: Mickleham	PROJECT No: 1120 0343-1 (SI08)	SITE PLAN SKETCH—NOT TO SCALE



**A&Y ASSOCIATES**  
GEOTECHNICAL ENGINEERING CONSULTANTS

## Field Density Test Results AS1289.5.7.1

A & Y Associates Pty Ltd  
5/16 Network Drive  
Truganina VIC 3029  
PH: 0400 413 531  
info@ayassociates.com.au

<b>Client:</b>	BMD Urban			<b>Job No:</b>	BMD2324	
<b>Project:</b>	Merrifield Estate - Stage 50 (Level 1)			<b>Report:</b>	9	
<b>Location:</b>	Mickleham					

Sample No	25	26	27			
Date Tested	24/05/2022	24/05/2022	24/05/2022			
Time Tested	AM	AM	AM			

Test Location	Refer to Plan	Refer to Plan	Refer to Plan			
Level/Layer	Layer 1	Layer 1	Layer 1			
Layer Thickness	mm 200	mm 200	mm 200			
Test Depth	mm 175	mm 175	mm 175			
Field Wet Density	t/m <sup>3</sup> 1.94	t/m <sup>3</sup> 1.97	t/m <sup>3</sup> 1.89			
Field Moisture Content	% 23.9	% 22.8	% 21.3			
Material:	Imported Clay	Imported Clay	Imported Clay			

Oversize Material	WET, % 5.3	WET, % 5.3	WET, % 4.7			
Sieve Size	mm 19	mm 19	mm 19			
Peak Converted Wet Density	t/m <sup>3</sup> 1.98	t/m <sup>3</sup> 1.99	t/m <sup>3</sup> 1.93			
Optimum Moisture Content	% 22	% 23	% 19.5			

<b>Moisture Ratio</b>	% 108.5	% 99	% 109.5			
<b>Moisture Variation</b>	% 2.0	% -0.5	% 1.5			
<b>from OMC</b>	Wetter	Drier	Wetter			
<b>Density Ratio</b>	% 97.0	% 98.0	% 97.0			

<b>Specification:</b>	95% STD	<b>Test Selection:</b>	N/A
<b>Notes:</b>	Ref : 1120 0343-1 (SI09)		
<b>Test Method</b>	AS1289 5.8.1, 5.7.1, 2.1.1, 1.1	<b>Sampling Method:</b>	AS 1289 1.2.1 6.4(b)



NATA Accredited Laboratory No. 20172  
Accreditation for compliance with ISO/IEC 17025 - Testing  
The results of tests, calibrations and/or measurements included  
in this document, are traceable to Australian / National Standards

Approved Signatory:




David Burns  
Date: 22/07/2022





Test Location

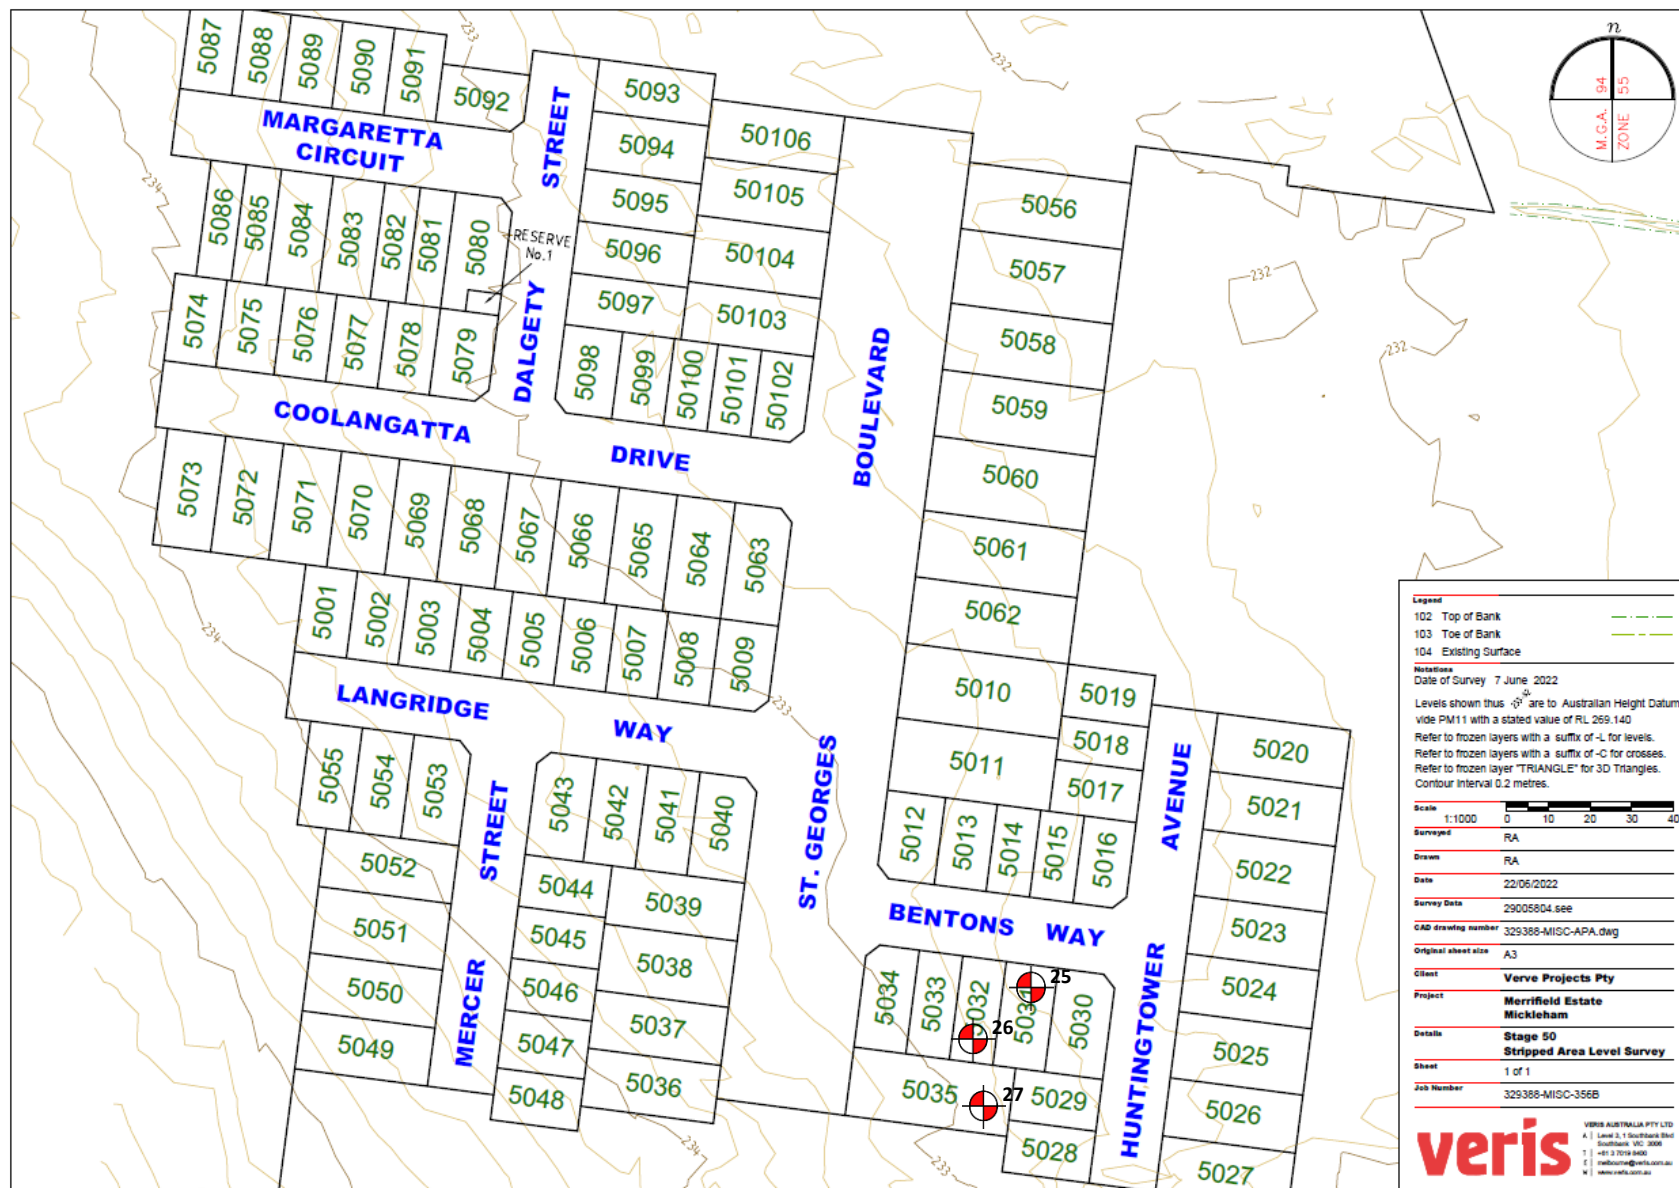

PROJECT:  
Merrifield Estate – Stage 50 (Level 1)

CLIENT:  
BMD Urban

DATE:  
24/05/2022

LOCATION:  
Mickleham

PROJECT No:  
1120 0343-1 (SI09)

SITE PLAN SKETCH—NOT TO SCALE



**A&Y ASSOCIATES**  
GEOTECHNICAL ENGINEERING CONSULTANTS

## Field Density Test Results AS1289.5.7.1

A & Y Associates Pty Ltd  
5/16 Network Drive  
Truganina VIC 3029  
PH: 0400 413 531  
info@ayassociates.com.au

<b>Client:</b>	BMD Urban			<b>Job No:</b>	BMD2324	
<b>Project:</b>	Merrifield Estate - Stage 50 (Level 1)			<b>Report:</b>	10	
<b>Location:</b>	Mickleham					
Sample No	28	29	30			
Date Tested	25/05/2022	25/05/2022	25/05/2022			
Time Tested	AM	AM	AM			
Test Location	Refer to Plan	Refer to Plan	Refer to Plan			
Level/Layer	Layer 2	Layer 2	Layer 2			
Layer Thickness	mm 200	mm 200	mm 200			
Test Depth	mm 175	mm 175	mm 175			
Field Wet Density	t/m <sup>3</sup> 1.90	t/m <sup>3</sup> 1.88	t/m <sup>3</sup> 1.93			
Field Moisture Content	% 22.1	% 23.1	% 21.8			
Material:	Imported Clay	Imported Clay	Imported Clay			
Oversize Material	WET, % 5.5	WET, % 3.9	WET, % 3.2			
Sieve Size	mm 19	mm 19	mm 19			
Peak Converted Wet Density	t/m <sup>3</sup> 1.95	t/m <sup>3</sup> 1.91	t/m <sup>3</sup> 2.01			
Optimum Moisture Content	% 20.5	% 24	% 20			
<b>Moisture Ratio</b>	% 108	% 96.5	% 109			
<b>Moisture Variation</b>	% 1.5	% -0.5	% 1.5			
<b>from OMC</b>	Wetter	Drier	Wetter			
<b>Density Ratio</b>	% 97.0	% 98.0	% 95.5			

<b>Specification:</b>	95% STD	<b>Test Selection:</b>	N/A
<b>Notes:</b>	Ref : 1120 0343-1 (SI10)		
<b>Test Method</b>	AS1289 5.8.1, 5.7.1, 2.1.1, 1.1	<b>Sampling Method:</b>	AS 1289 1.2.1 6.4(b)



NATA Accredited Laboratory No. 20172  
Accreditation for compliance with ISO/IEC 17025 - Testing  
The results of tests, calibrations and/or measurements included  
in this document, are traceable to Australian / National Standards

Approved Signatory:




David Burns  
22/07/2022

Date:



Test Location

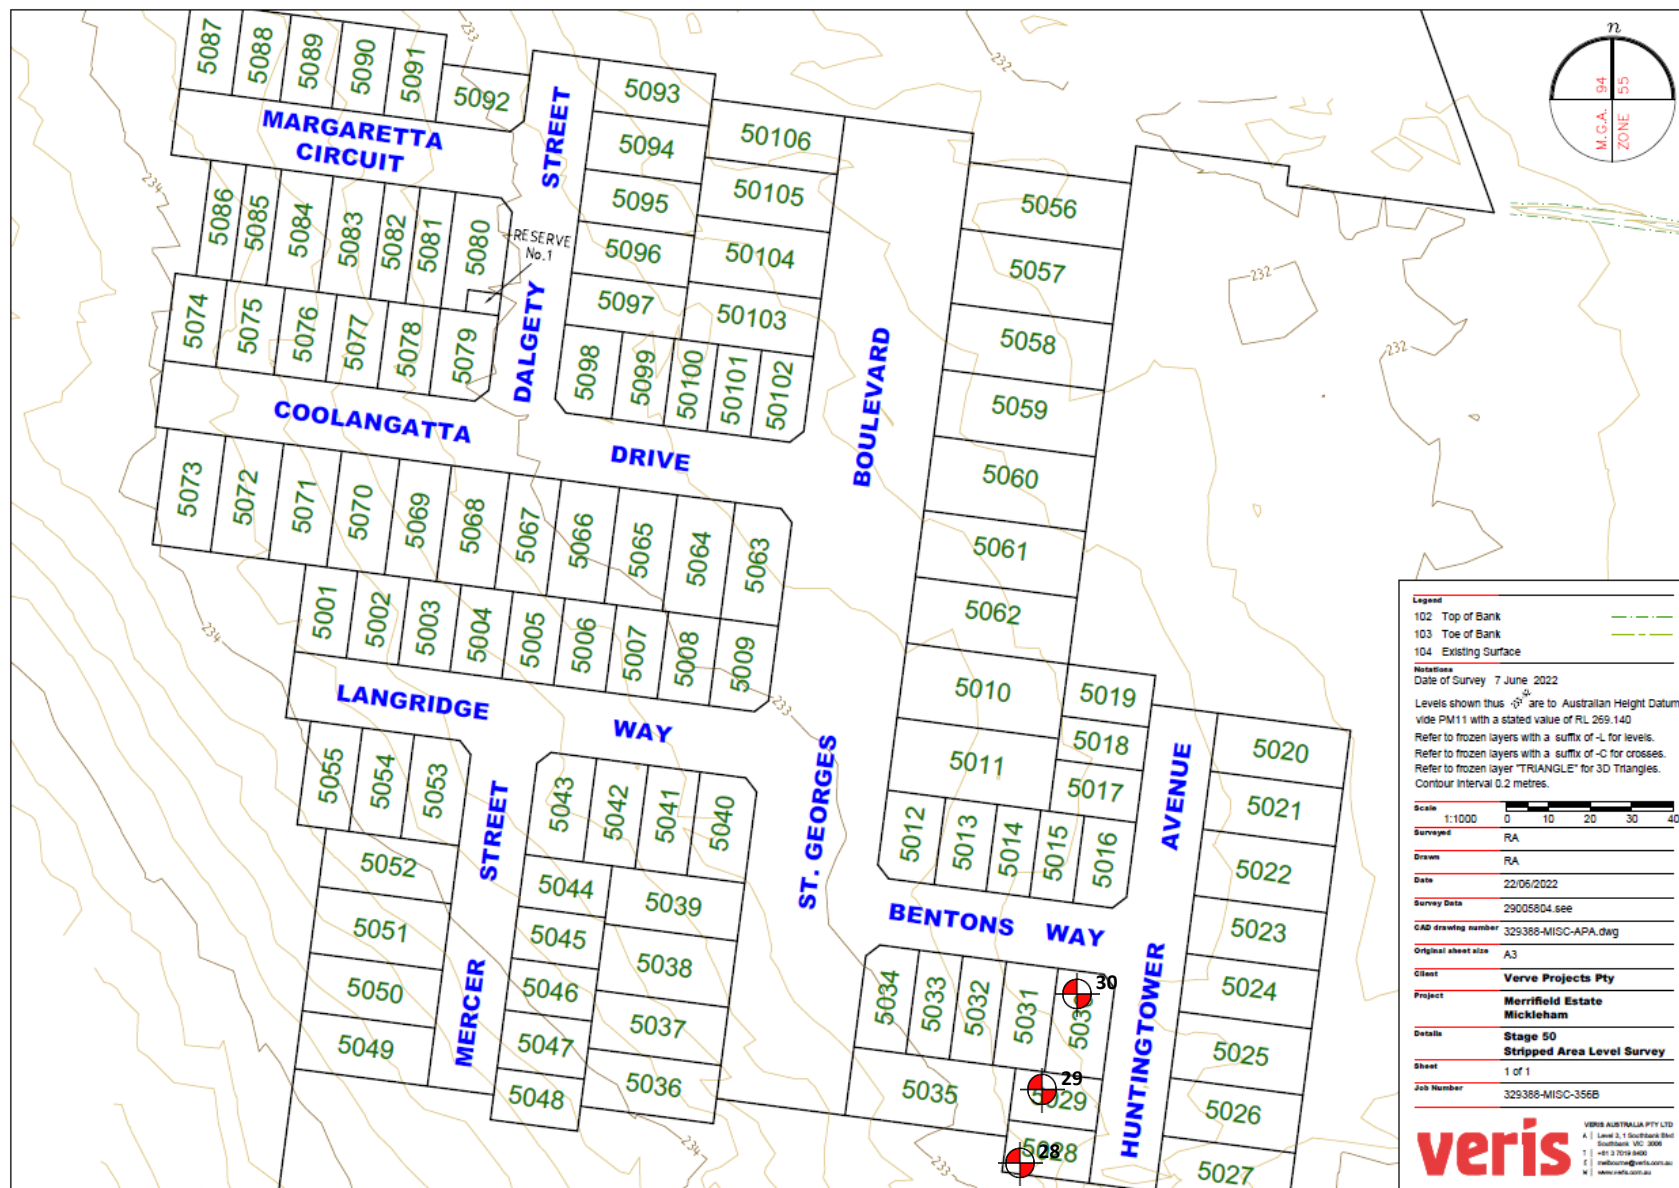

PROJECT:

Merrifield Estate – Stage 50 (Level 1)

CLIENT:

BMD Urban

DATE:

25/05/2022

LOCATION:

Mickleham

PROJECT No:

1120 0343-1 (SI10)

SITE PLAN SKETCH—NOT TO SCALE



**A&Y ASSOCIATES**  
GEOTECHNICAL ENGINEERING CONSULTANTS

## Field Density Test Results AS1289.5.7.1

A & Y Associates Pty Ltd  
5/16 Network Drive  
Truganina VIC 3029  
PH: 0400 413 531  
info@ayassociates.com.au

<b>Client:</b>	BMD Urban			<b>Job No:</b>	BMD2324	
<b>Project:</b>	Merrifield Estate - Stage 50 (Level 1)			<b>Report:</b>	11	
<b>Location:</b>	Mickleham					
Sample No	31	32	33			
Date Tested	26/05/2022	26/05/2022	26/05/2022			
Time Tested	AM	AM	AM			
Test Location	Refer to Plan	Refer to Plan	Refer to Plan			
Level/Layer	Layer 2	Layer 2	Layer 2			
Layer Thickness	mm 200	mm 200	mm 200			
Test Depth	mm 175	mm 175	mm 175			
Field Wet Density	t/m <sup>3</sup> 1.91	t/m <sup>3</sup> 1.93	t/m <sup>3</sup> 1.97			
Field Moisture Content	% 19.9	% 18.9	% 18.0			
Material:	Imported Clay	Imported Clay	Imported Clay			
Oversize Material	WET, % 4.3	WET, % 5.7	WET, % 5.9			
Sieve Size	mm 19	mm 19	mm 19			
Peak Converted Wet Density	t/m <sup>3</sup> 1.95	t/m <sup>3</sup> 1.96	t/m <sup>3</sup> 2.06			
Optimum Moisture Content	% 18	% 19.5	% 16.5			
<b>Moisture Ratio</b>	% 110.5	% 97	% 109			
<b>Moisture Variation</b>	% 2.0	% -0.5	% 1.5			
<b>from OMC</b>	Wetter	Drier	Wetter			
<b>Density Ratio</b>	% 97.0	% 98.0	% 95.5			

<b>Specification:</b>	95% STD	<b>Test Selection:</b>	N/A
<b>Notes:</b>	Ref : 1120 0343-1 (SI11)		
<b>Test Method</b>	AS1289 5.8.1, 5.7.1, 2.1.1, 1.1	<b>Sampling Method:</b>	AS 1289 1.2.1 6.4(b)



NATA Accredited Laboratory No. 20172  
Accreditation for compliance with ISO/IEC 17025 - Testing  
The results of tests, calibrations and/or measurements included  
in this document, are traceable to Australian / National Standards

Approved Signatory:




David Burns  
22/07/2022

Date:





Test Location

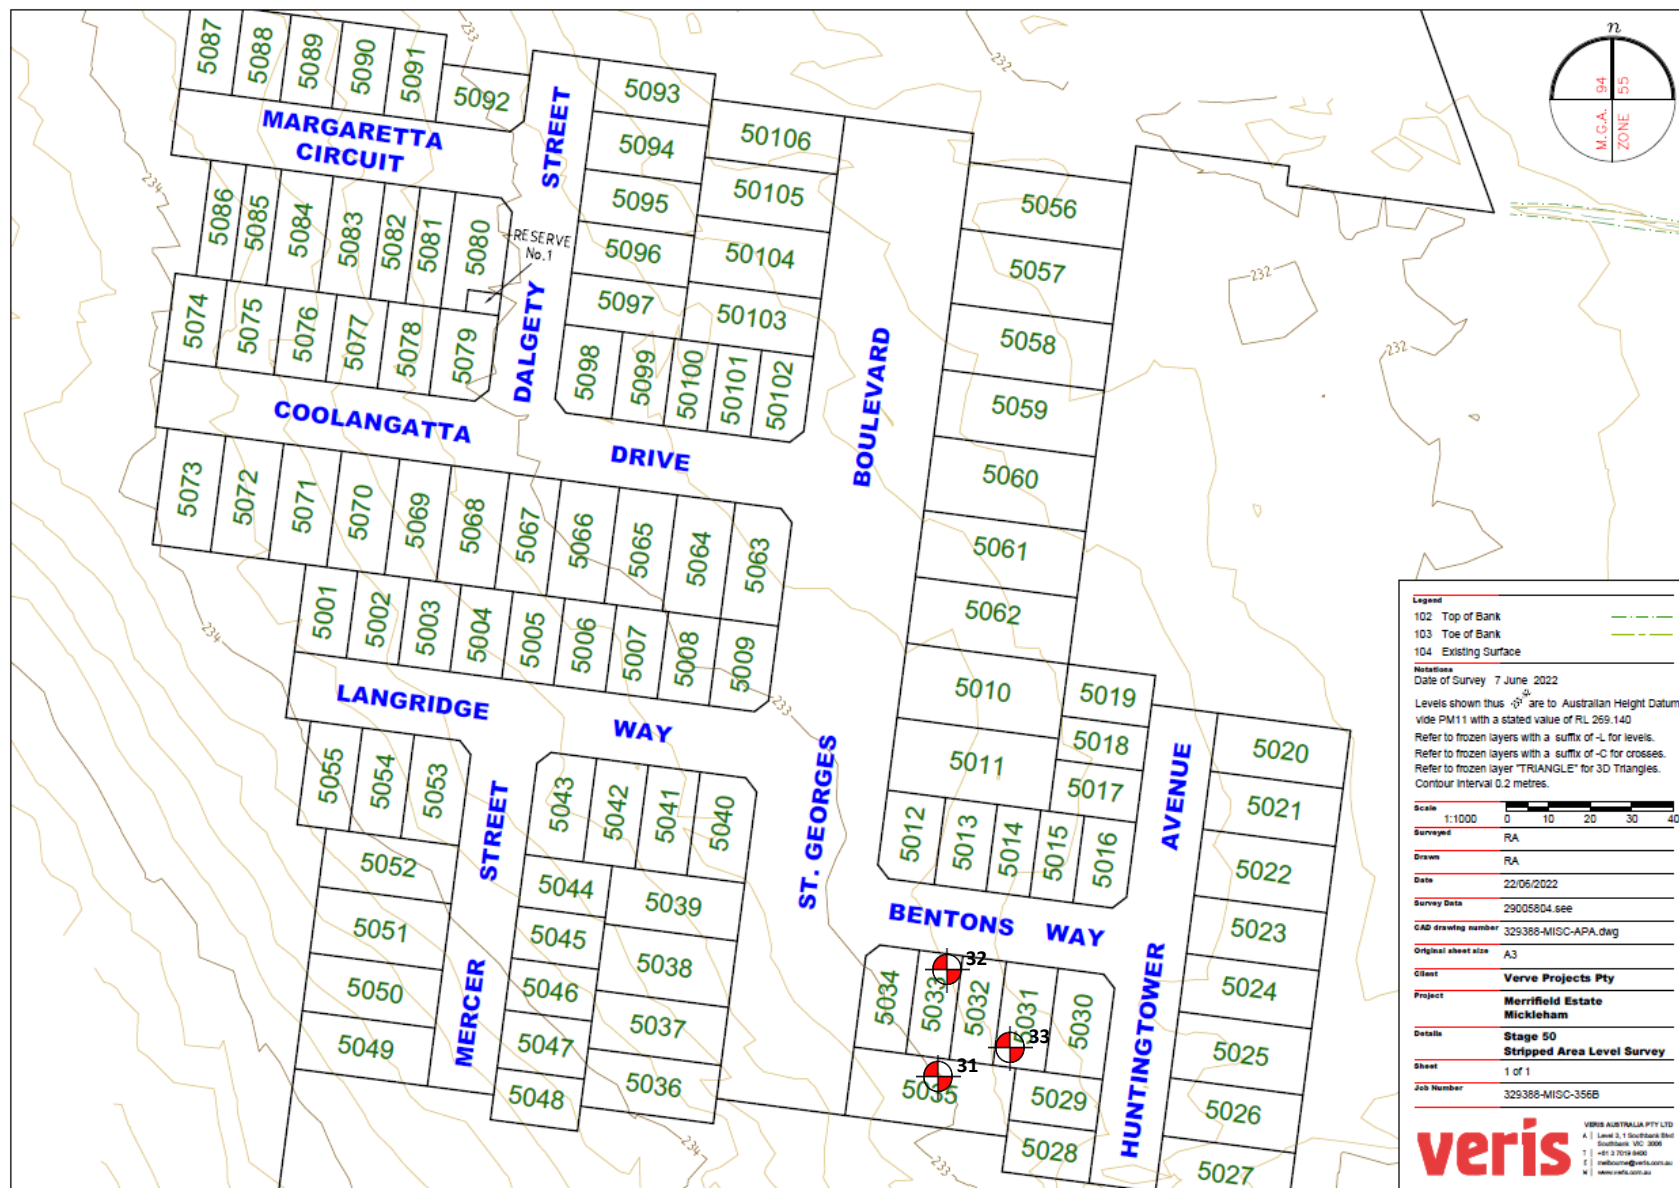

**PROJECT:**  
Merrifield Estate – Stage 50 (Level 1)

**LOCATION:**  
Mickleham

**CLIENT:**  
BMD Urban

**PROJECT No:**  
1120 0343-1 (SI11)

**DATE:**  
26/05/2022

**SITE PLAN SKETCH—NOT TO SCALE**



**A&Y ASSOCIATES**  
GEOTECHNICAL ENGINEERING CONSULTANTS

## Field Density Test Results AS1289.5.7.1

A & Y Associates Pty Ltd  
5/16 Network Drive  
Truganina VIC 3029  
PH: 0400 413 531  
info@ayassociates.com.au

<b>Client:</b>	BMD Urban			<b>Job No:</b>	BMD2324	
<b>Project:</b>	Merrifield Estate - Stage 50 (Level 1)			<b>Report:</b>	12	
<b>Location:</b>	Mickleham					

Sample No	34	35	36			
Date Tested	27/05/2022	27/05/2022	27/05/2022			
Time Tested	AM	AM	AM			

Test Location	Refer to Plan	Refer to Plan	Refer to Plan			
Level/Layer	Layer 2	Layer 2	Layer 2			
Layer Thickness	mm 200	mm 200	mm 200			
Test Depth	mm 175	mm 175	mm 175			
Field Wet Density	t/m <sup>3</sup> 1.97	t/m <sup>3</sup> 1.96	t/m <sup>3</sup> 1.90			
Field Moisture Content	% 22.5	% 24.1	% 23.4			
Material:	Imported Clay	Imported Clay	Imported Clay			

Oversize Material	WET, % 3.5	WET, % 3.0	WET, % 4.1			
Sieve Size	mm 19	mm 19	mm 19			
Peak Converted Wet Density	t/m <sup>3</sup> 1.95	t/m <sup>3</sup> 1.99	t/m <sup>3</sup> 1.94			
Optimum Moisture Content	% 20.5	% 22	% 22			



  

<b>Moisture Ratio</b>	% 109.5	% 109.5	% 106.5			
<b>Moisture Variation</b>	% 1.5	% 2.0	% 1.5			
<b>from OMC</b>	Wetter	Wetter	Wetter			
<b>Density Ratio</b>	% 100.5	% 98.0	% 97.5			


<b>Specification:</b>	95% STD	<b>Test Selection:</b>	N/A
<b>Notes:</b>	Ref : 1120 0343-1 (SI12)		
<b>Test Method</b>	AS1289 5.8.1, 5.7.1, 2.1.1, 1.1	<b>Sampling Method:</b>	AS 1289 1.2.1 6.4(b)

 <b>NATA</b> WORLD RECOGNISED ACCREDITATION	NATA Accredited Laboratory No. 20172	Approved Signatory:   Date: 29/07/2022
	Accreditation for compliance with ISO/IEC 17025 - Testing	
	The results of tests, calibrations and/or measurements included in this document, are traceable to Australian / National Standards	



Test Location

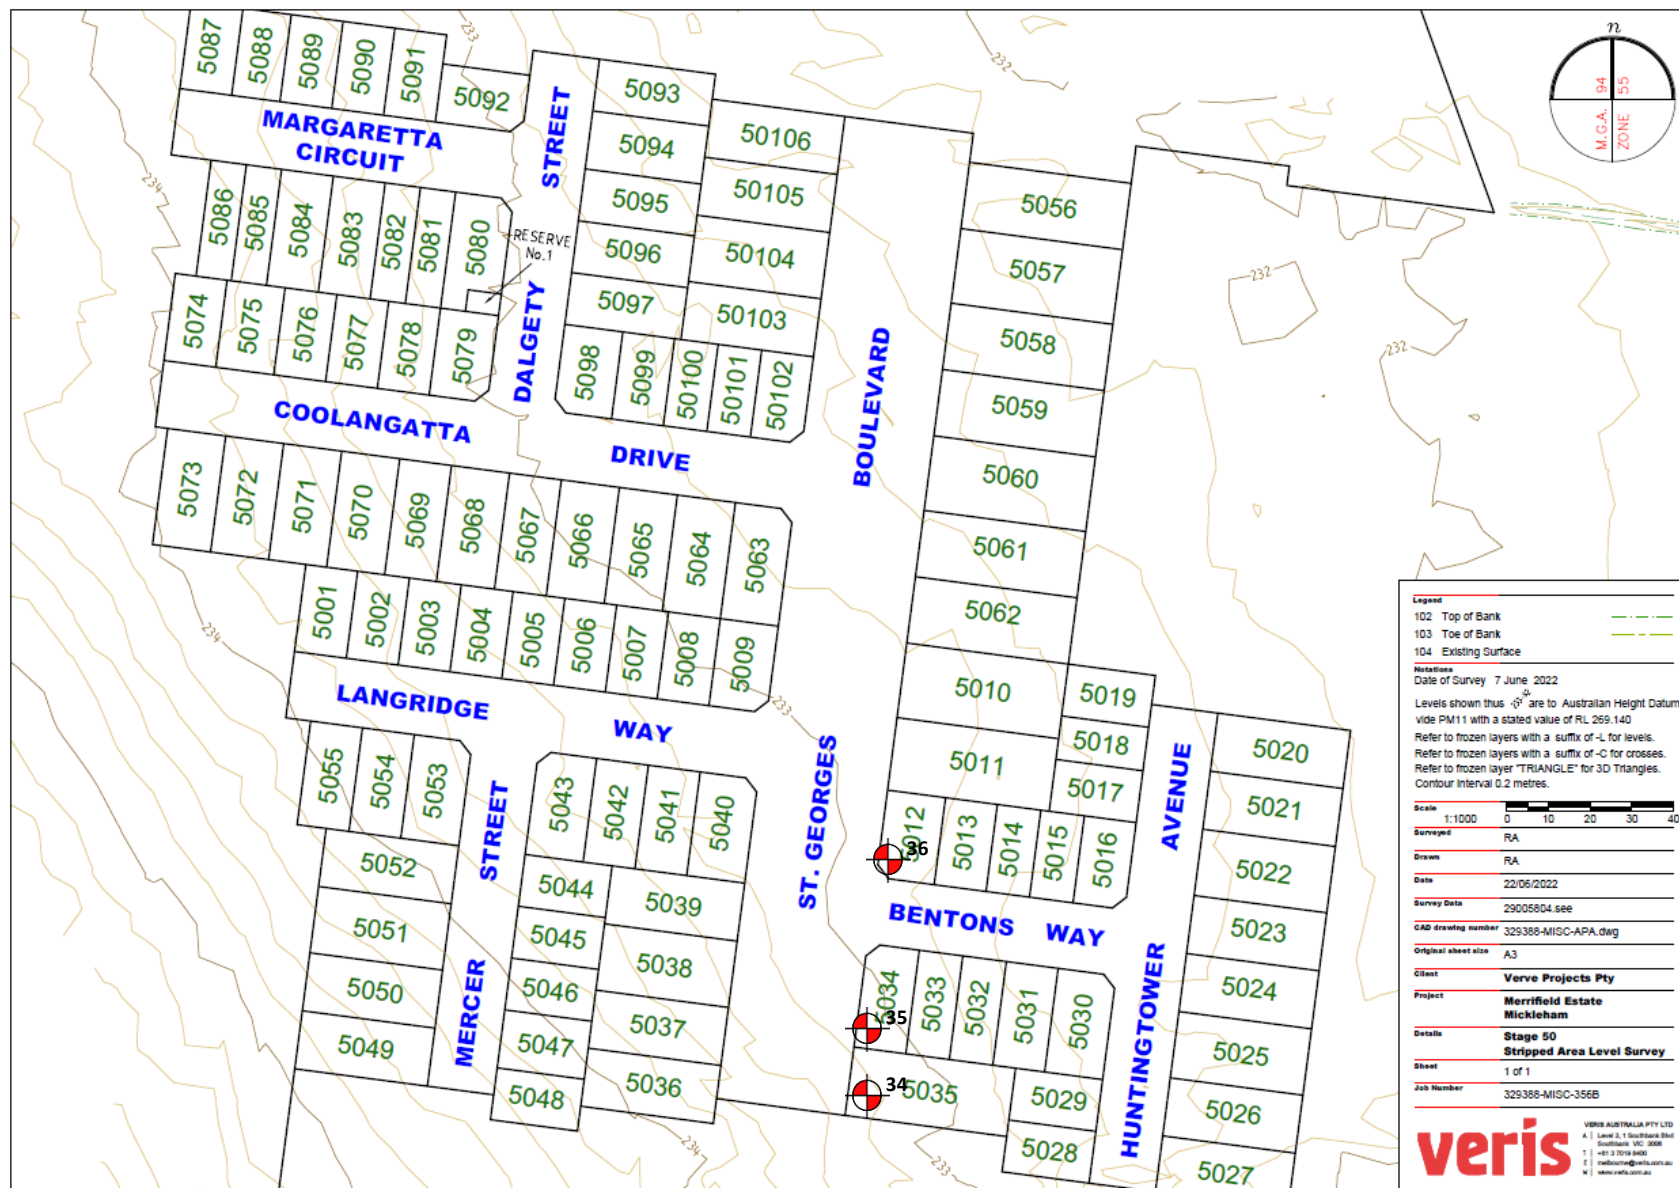

**Legend**

- 102 Top of Bank
- 103 Toe of Bank
- 104 Existing Surface

**Notes**

Date of Survey 7 June 2022

Levels shown thus '92' are to Australian Height Datum vide PM11 with a stated value of RL 269.140

Refer to frozen layers with a suffix of -L for levels.

Refer to frozen layers with a suffix of -C for crosses.

Refer to frozen layer "TRIANGLE" for 3D Triangles.

Contour interval 0.2 metres.

**Scale**

1:1000

0 10 20 30 40

**Surveyed** RA

**Drawn** RA

**Date** 22/06/2022

**Survey Data** 29005804.ssee

**CAD drawing number** 329388-MISC-APA.dwg

**Original sheet size** A3

**Client** Verve Projects Pty

**Project** Merrifield Estate Mickleham


**Details** Stage 50 Stripped Area Level Survey

**Sheet** 1 of 1

**Job Number** 329388-MISC-356B

**veris**

VERIS AUSTRALIA PTY LTD  
A | Level 2, 1 Southbank Blvd  
Southbank, VIC 3006  
T | +61 3 7019 8400  
E | info@veris.com.au  
W | www.veris.com.au

PROJECT: Merrifield Estate – Stage 50 (Level 1)	CLIENT: BMD Urban	DATE: 27/05/2022	 <b>A&amp;Y ASSOCIATES</b> GEOTECHNICAL ENGINEERING CONSULTANTS
LOCATION: Mickleham	PROJECT No: 1120 0343-1 (SI12)	SITE PLAN SKETCH—NOT TO SCALE	



## Field Density Test Results AS1289.5.7.1

A & Y Associates Pty Ltd  
5/16 Network Drive  
Truganina VIC 3029  
PH: 0400 413 531  
info@ayassociates.com.au

<b>Client:</b>	BMD Urban			<b>Job No:</b>	BMD2324	
<b>Project:</b>	Merrifield Estate - Stage 50 (Level 1)			<b>Report:</b>	13	
<b>Location:</b>	Mickleham					

Sample No	37	38	39			
Date Tested	28/05/2022	28/05/2022	28/05/2022			
Time Tested	AM	AM	AM			

Test Location	Refer to Plan	Refer to Plan	Refer to Plan			
Level/Layer	Layer 2	Layer 2	Layer 2			
Layer Thickness	mm 200	mm 200	mm 200			
Test Depth	mm 175	mm 175	mm 175			
Field Wet Density	t/m <sup>3</sup> 1.90	t/m <sup>3</sup> 1.92	t/m <sup>3</sup> 1.95			
Field Moisture Content	% 21.6	% 22.3	% 20.5			
Material:	Imported Clay	Imported Clay	Imported Clay			

Oversize Material	WET, %	3.5	3.0	4.1		
Sieve Size	mm	19	19	19		
Peak Converted Wet Density	t/m <sup>3</sup>	1.95	1.99	1.94		
Optimum Moisture Content	%	20	20.5	19		



  

<b>Moisture Ratio</b>	%	108	109	108		
<b>Moisture Variation</b>	%	1.5	2.0	1.5		
<b>from OMC</b>		Wetter	Wetter	Wetter		
<b>Density Ratio</b>	%	97.0	96.0	100.0		


<b>Specification:</b>	95% STD	<b>Test Selection:</b>	N/A
<b>Notes:</b>	Ref : 1120 0343-1 (SI13)		
<b>Test Method</b>	AS1289 5.8.1, 5.7.1, 2.1.1, 1.1	<b>Sampling Method:</b>	AS 1289 1.2.1 6.4(b)

 <b>NATA</b> WORLD RECOGNISED ACCREDITATION	NATA Accredited Laboratory No. 20172	Approved Signatory:    David Burns  Date: 29/07/2022
	Accreditation for compliance with ISO/IEC 17025 - Testing	
	The results of tests, calibrations and/or measurements included	
	in this document, are traceable to Australian / National Standards	



Test Location

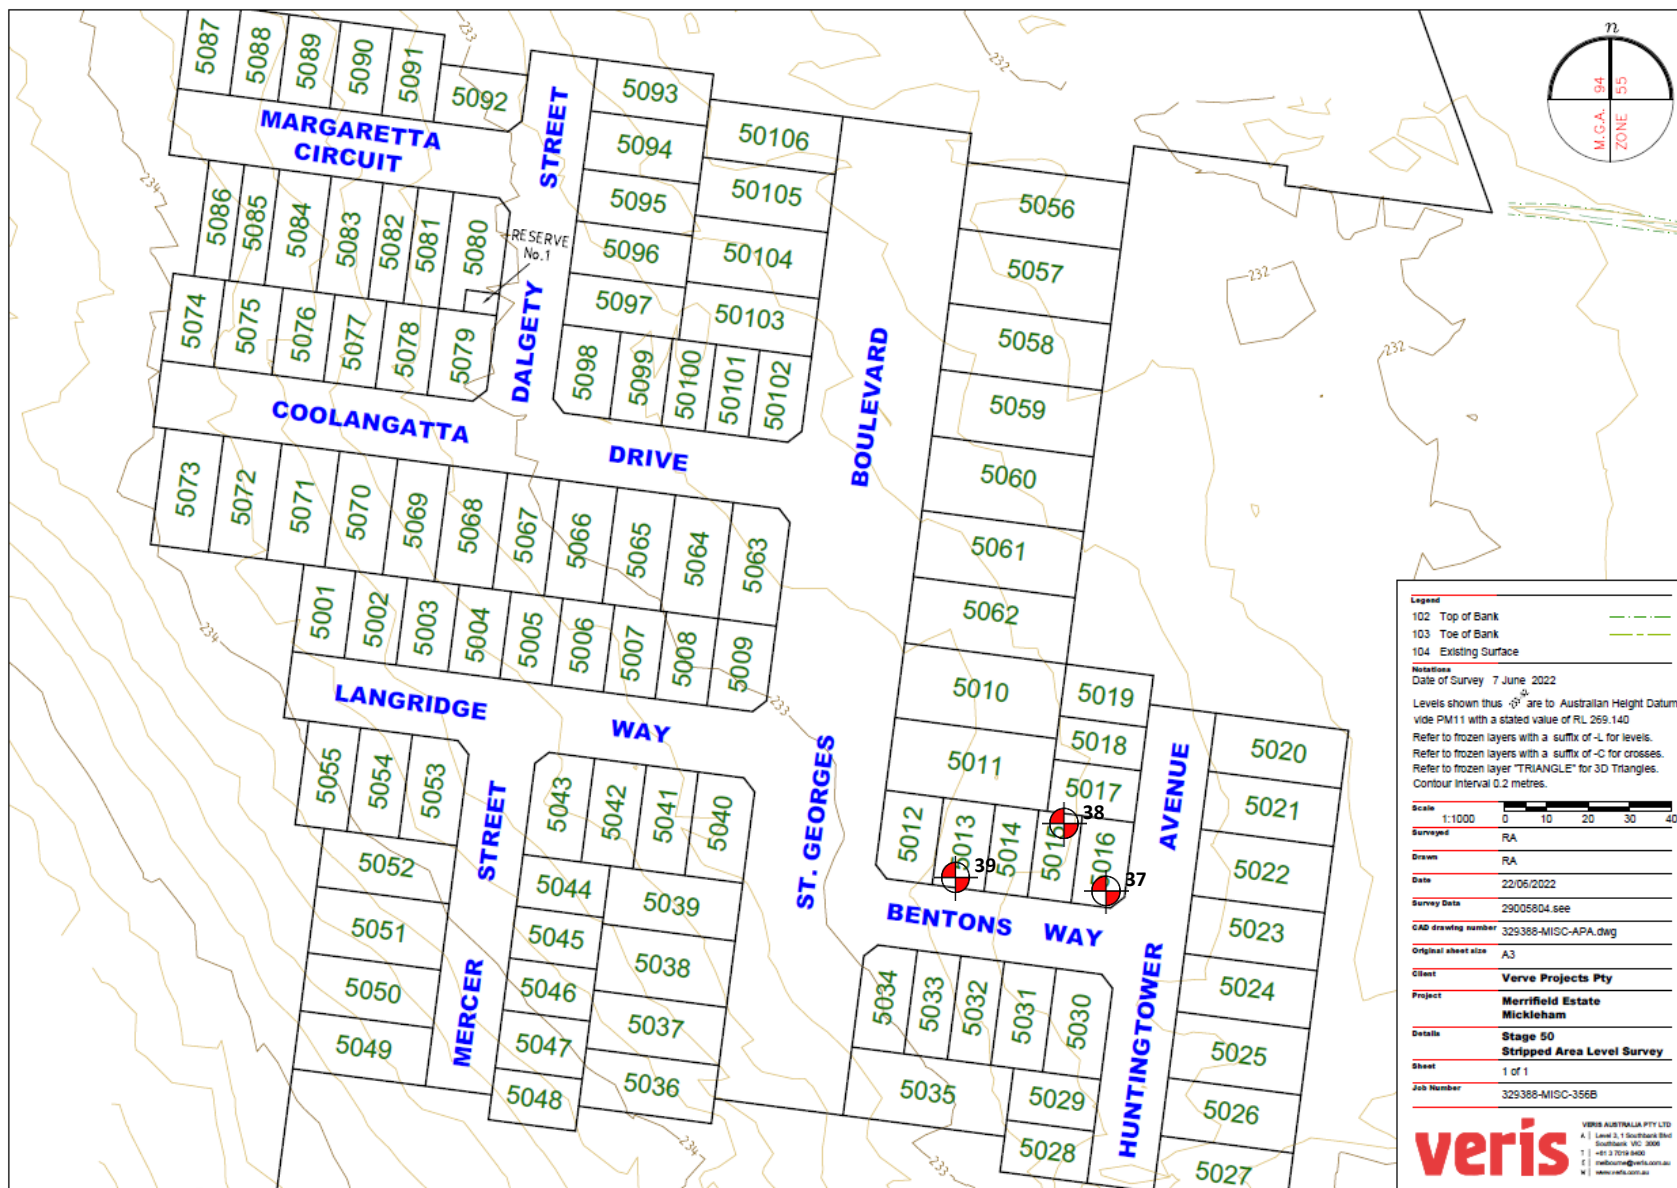

**Legend**

- 102 Top of Bank
- 103 Toe of Bank
- 104 Existing Surface

**Notes**

Date of Survey 7 June 2022

Levels shown thus '38' are to Australian Height Datum vide PM11 with a stated value of RL 269.140

Refer to frozen layers with a suffix of -L for levels.

Refer to frozen layers with a suffix of -C for crosses.

Refer to frozen layer "TRIANGLE" for 3D Triangles.

Contour interval 0.2 metres.

**Scale** 1:1000

**Surveyed** RA

**Drawn** RA

**Date** 22/06/2022

**Survey Data** 29005804.see

**CAD drawing number** 329388-MISC-APA.dwg

**Original sheet size** A3

**Client** Verve Projects Pty

**Project** Merrifield Estate Mickleham

**Details** Stage 50 Stripped Area Level Survey

**Sheet** 1 of 1

**Job Number** 329388-MISC-356B

**veris**

VERIS AUSTRALIA PTY LTD  
A | Level 2, 1 Southbank Blvd  
Southbank, VIC 3006  
T | +61 3 7019 8400  
E | info@veris.com.au  
W | www.veris.com.au

PROJECT: Merrifield Estate – Stage 50 (Level 1)	CLIENT: BMD Urban	DATE: 28/05/2022
LOCATION: Mickleham	PROJECT No: 1120 0343-1 (SI13)	SITE PLAN SKETCH—NOT TO SCALE



**A&Y ASSOCIATES**  
GEOTECHNICAL ENGINEERING CONSULTANTS

## Field Density Test Results AS1289.5.7.1

A & Y Associates Pty Ltd  
5/16 Network Drive  
Truganina VIC 3029  
PH: 0400 413 531  
info@ayassociates.com.au

<b>Client:</b>	BMD Urban			<b>Job No:</b>	BMD2324	
<b>Project:</b>	Merrifield Estate - Stage 50 (Level 1)			<b>Report:</b>	14	
<b>Location:</b>	Mickleham					

Sample No	40	41	42			
Date Tested	09/06/2022	09/06/2022	09/06/2022			
Time Tested	AM	AM	AM			

Test Location	Refer to Plan	Refer to Plan	Refer to Plan			
Level/Layer	Layer 3	Layer 3	Layer 3			
Layer Thickness	mm 200	mm 200	mm 200			
Test Depth	mm 175	mm 175	mm 175			
Field Wet Density	t/m <sup>3</sup> 1.81	t/m <sup>3</sup> 1.84	t/m <sup>3</sup> 1.82			
Field Moisture Content	% 23.5	% 23.9	% 24.2			
Material:	Imported Clay	Imported Clay	Imported Clay			

Oversize Material	WET, %	2.0	2.5	2.1		
Sieve Size	mm	19	19	19		
Peak Converted Wet Density	t/m <sup>3</sup>	1.85	1.92	1.86		
Optimum Moisture Content	%	21.5	24	22.5		



  

<b>Moisture Ratio</b>	%	109.5	99.5	107.5		
<b>Moisture Variation</b>	%	2.0	-0.5	1.5		
<b>from OMC</b>		Wetter	Drier	Wetter		
<b>Density Ratio</b>	%	97.5	95.0	97.0		


<b>Specification:</b>	95% STD	<b>Test Selection:</b>	N/A
<b>Notes:</b>	Ref : 1120 0343-1 (SI14)		
<b>Test Method</b>	AS1289 5.8.1, 5.7.1, 2.1.1, 1.1	<b>Sampling Method:</b>	AS 1289 1.2.1 6.4(b)

 <b>NATA</b> WORLD RECOGNISED ACCREDITATION	NATA Accredited Laboratory No. 20172	Approved Signatory:   Date: 29/07/2022
	Accreditation for compliance with ISO/IEC 17025 - Testing	
	The results of tests, calibrations and/or measurements included in this document, are traceable to Australian / National Standards	



Test Location

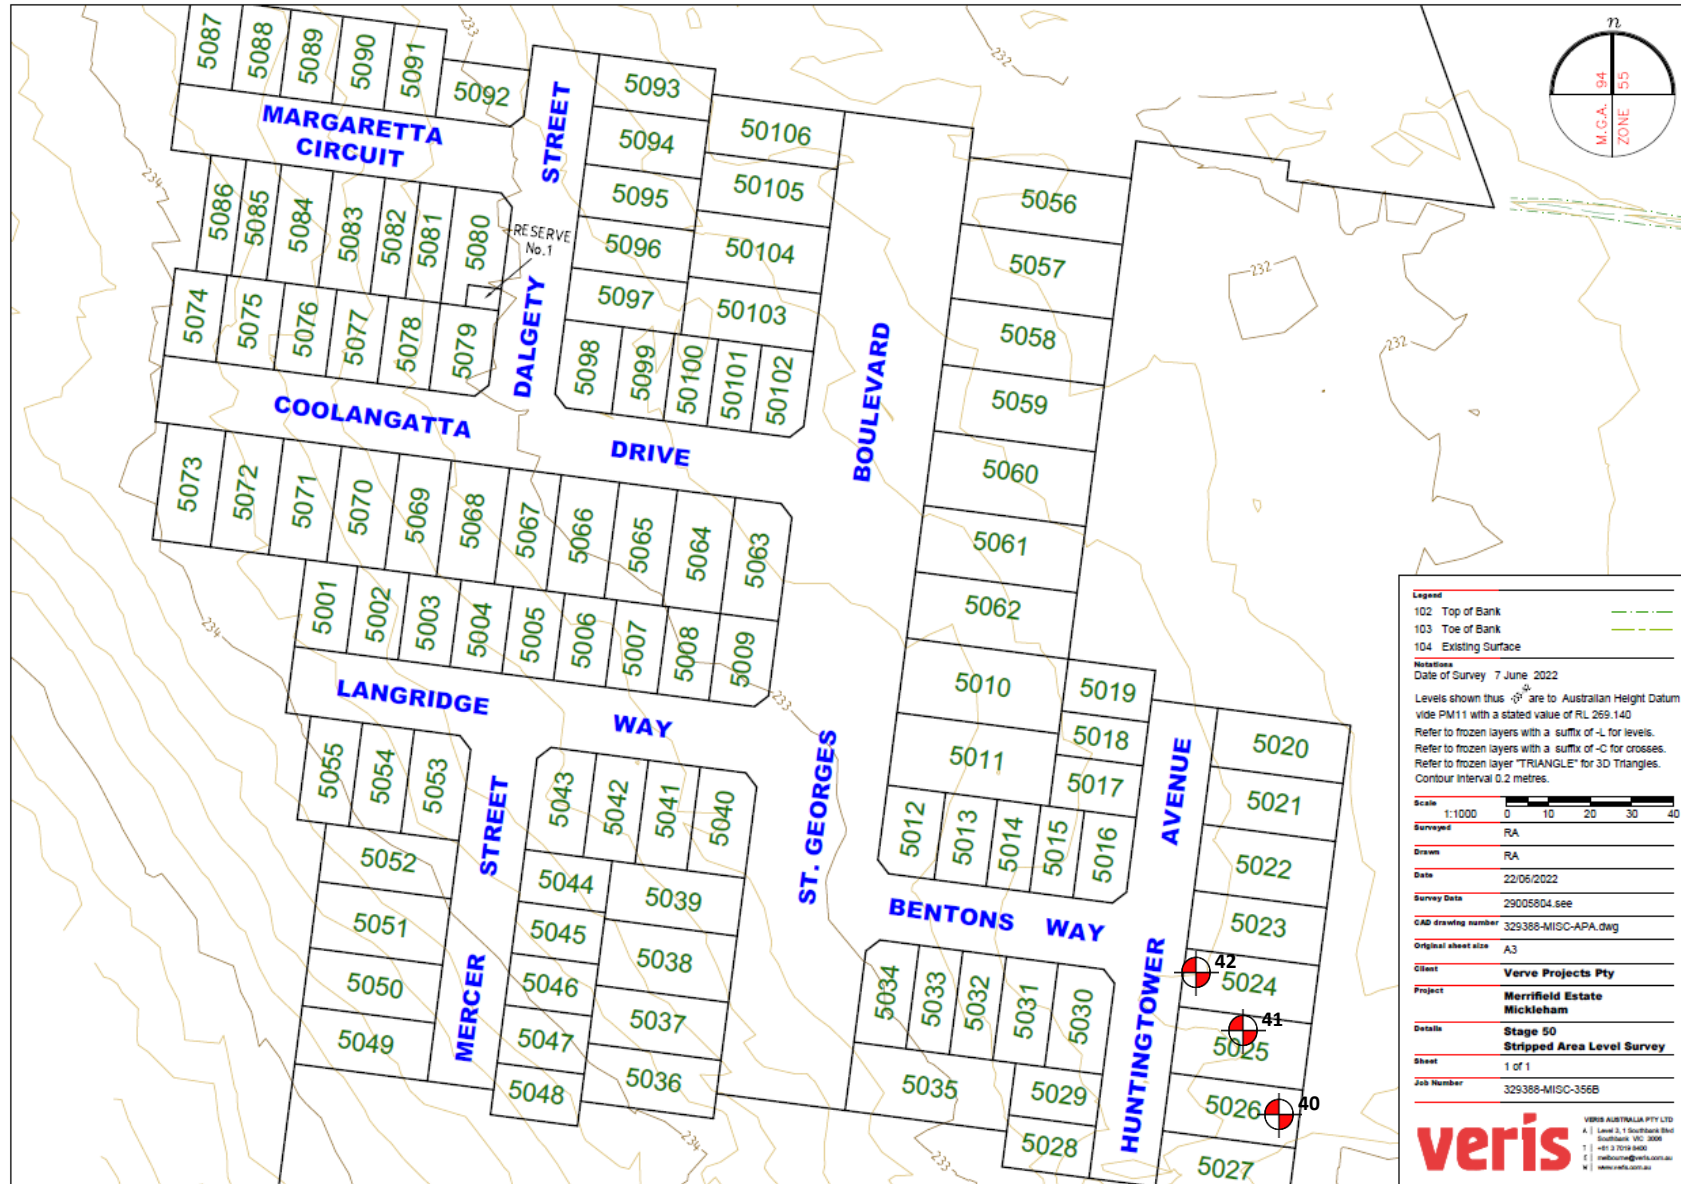

**Legend**

- 102 Top of Bank
- 103 Toe of Bank
- 104 Existing Surface

**Notations**

Date of Survey 7 June 2022

Levels shown thus '92' are to Australian Height Datum vide PM11 with a stated value of RL 269.140

Refer to frozen layers with a suffix of -L for levels.

Refer to frozen layers with a suffix of -C for crosses.

Refer to frozen layer "TRIANGLE" for 3D Triangles.

Contour interval 0.2 metres.

**Scale** 1:1000

**Surveyed** RA

**Drawn** RA

**Date** 22/06/2022

**Survey Data** 29005804.see

**CAD drawing number** 329388-MISC-APA.dwg

**Original sheet size** A3

**Client** Verve Projects Pty

**Project** Merrifield Estate Mickleham

**Details** Stage 50 Stripped Area Level Survey

**Sheet** 1 of 1

**Job Number** 329388-MISC-356B

**veris**

VERIS AUSTRALIA PTY LTD  
A | Level 2, 1 Southbank Blvd  
Southbank, VIC 3006  
T | +61 3 7019 8400  
E | info@veris.com.au  
W | www.veris.com.au

PROJECT: Merrifield Estate – Stage 50 (Level 1)	CLIENT: BMD Urban	DATE: 09/06/2022
LOCATION: Mickleham	PROJECT No: 1120 0343-1 (SI14)	SITE PLAN SKETCH—NOT TO SCALE



**A&Y ASSOCIATES**  
GEOTECHNICAL ENGINEERING CONSULTANTS

## Field Density Test Results AS1289.5.7.1

A & Y Associates Pty Ltd  
5/16 Network Drive  
Truganina VIC 3029  
PH: 0400 413 531  
info@ayassociates.com.au

<b>Client:</b>	BMD Urban			<b>Job No:</b>	BMD2324	
<b>Project:</b>	Merrifield Estate - Stage 50 (Level 1)			<b>Report:</b>	15	
<b>Location:</b>	Mickleham					

Sample No	43	44	45			
Date Tested	10/06/2022	10/06/2022	10/06/2022			
Time Tested	AM	AM	AM			

Test Location	Refer to Plan	Refer to Plan	Refer to Plan			
Level/Layer	Layer 3	Layer 3	Layer 3			
Layer Thickness	mm 200	mm 200	mm 200			
Test Depth	mm 175	mm 175	mm 175			
Field Wet Density	t/m <sup>3</sup> 1.91	t/m <sup>3</sup> 1.92	t/m <sup>3</sup> 1.95			
Field Moisture Content	% 28.4	% 27.4	% 23.6			
Material:	Imported Clay	Imported Clay	Imported Clay			

Oversize Material	WET, %	3.5	3.8	4.1		
Sieve Size	mm	19	19	19		
Peak Converted Wet Density	t/m <sup>3</sup>	1.93	1.98	1.93		
Optimum Moisture Content	%	26.5	25.5	24		

<b>Moisture Ratio</b>	%	107	107.5	98.5		
<b>Moisture Variation</b>	%	2.0	1.5	-0.5		
<b>from OMC</b>		Wetter	Wetter	Drier		
<b>Density Ratio</b>	%	98.0	96.5	100.5		

<b>Specification:</b>	95% STD	<b>Test Selection:</b>	N/A
<b>Notes:</b>	Ref : 1120 0343-1 (SI15)		
<b>Test Method</b>	AS1289 5.8.1, 5.7.1, 2.1.1, 1.1	<b>Sampling Method:</b>	AS 1289 1.2.1 6.4(b)



NATA Accredited Laboratory No. 20172  
Accreditation for compliance with ISO/IEC 17025 - Testing  
The results of tests, calibrations and/or measurements included  
in this document, are traceable to Australian / National Standards

Approved Signatory:




David Burns  
29/07/2022

Date:





Test Location

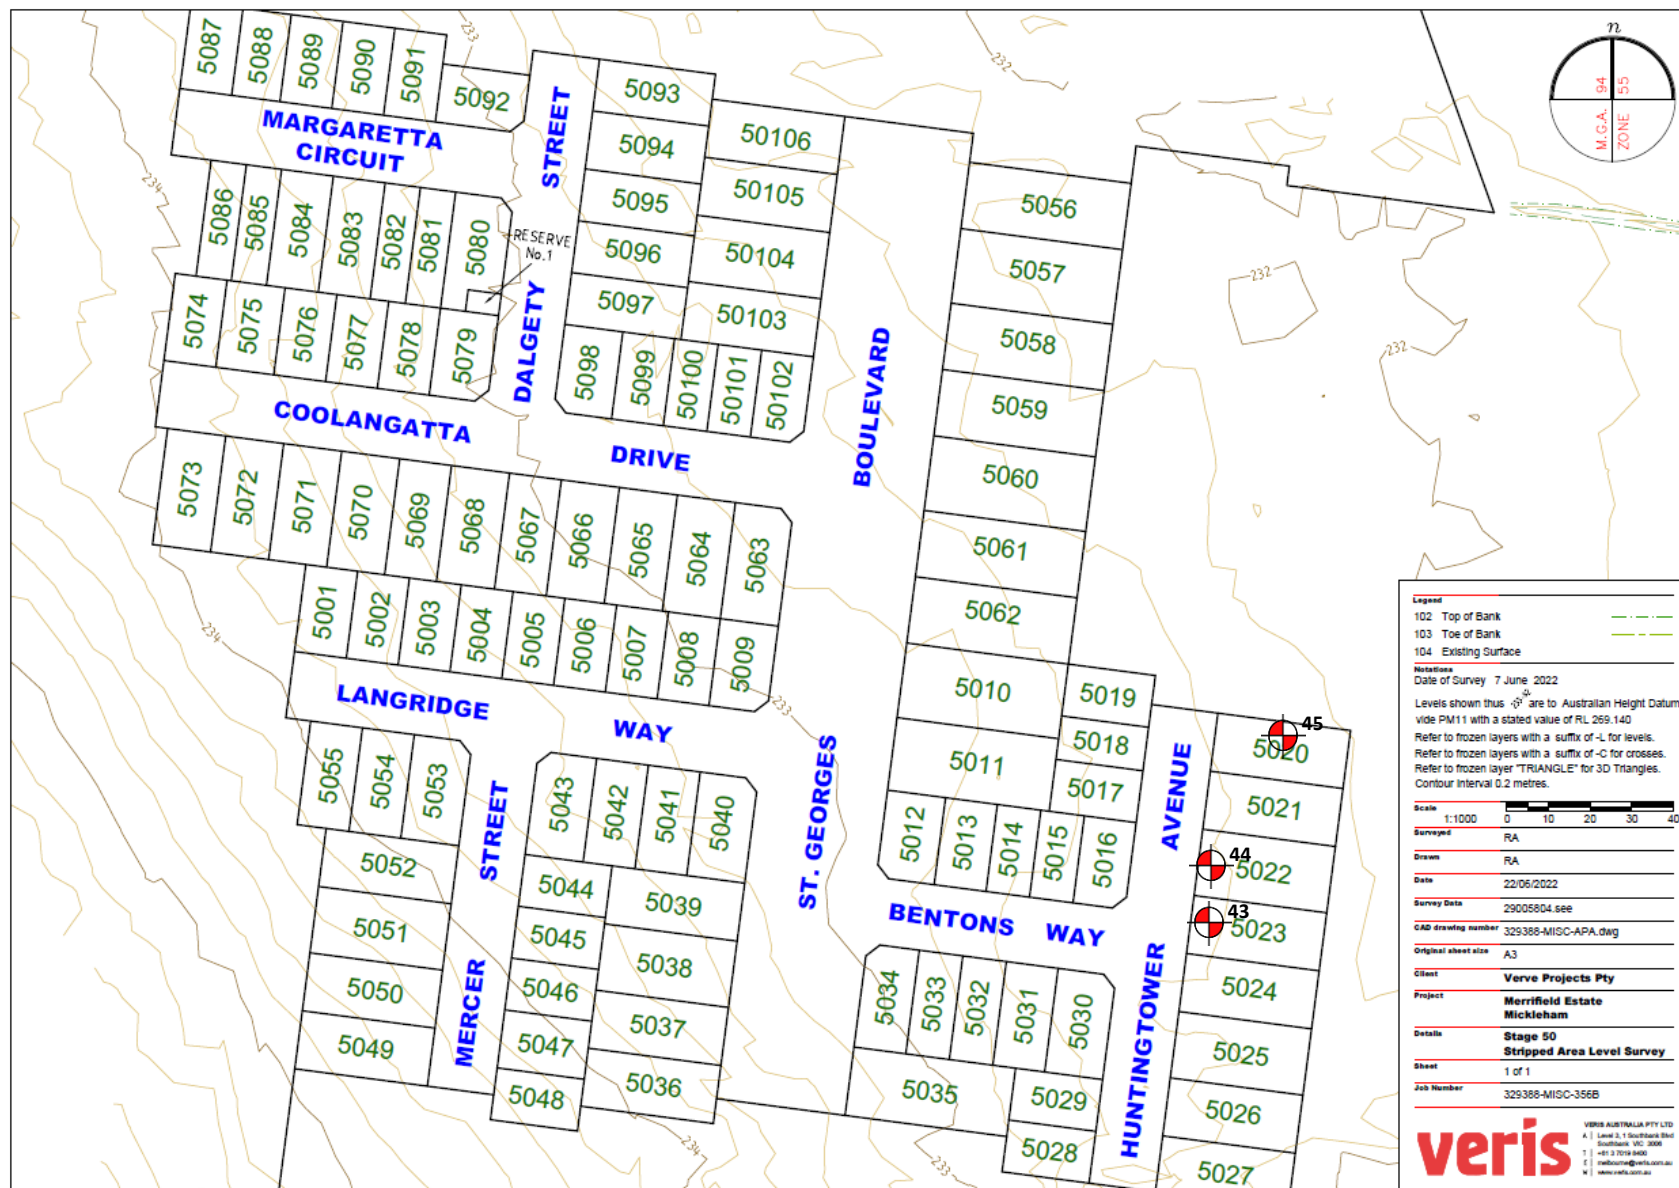

**PROJECT:**  
Merrifield Estate – Stage 50 (Level 1)

**LOCATION:**  
Mickleham

**CLIENT:**  
BMD Urban

**PROJECT No:**  
1120 0343-1 (SI15)

**DATE:**  
10/06/2022

**SITE PLAN SKETCH—NOT TO SCALE**



**A&Y ASSOCIATES**  
GEOTECHNICAL ENGINEERING CONSULTANTS



## Field Density Test Results AS1289.5.7.1

A & Y Associates Pty Ltd  
5/16 Network Drive  
Truganina VIC 3029  
PH: 0400 413 531  
info@ayassociates.com.au

<b>Client:</b>	BMD Urban			<b>Job No:</b>	BMD2324	
<b>Project:</b>	Merrifield Estate - Stage 50 (Level 1)			<b>Report:</b>	16	
<b>Location:</b>	Mickleham					

Sample No	46	47	48			
Date Tested	15/06/2022	15/06/2022	15/06/2022			
Time Tested	AM	AM	AM			

Test Location	Refer to Plan	Refer to Plan	Refer to Plan			
Level/Layer	Layer 3	Layer 3	Layer 3			
Layer Thickness	mm 200	mm 200	mm 200			
Test Depth	mm 175	mm 175	mm 175			
Field Wet Density	t/m <sup>3</sup> 1.94	t/m <sup>3</sup> 1.84	t/m <sup>3</sup> 1.82			
Field Moisture Content	% 22.5	% 24.6	% 23.9			
Material:	Imported Clay	Imported Clay	Imported Clay			

Oversize Material	WET, %	3.8	3.1	3.0		
Sieve Size	mm	19	19	19		
Peak Converted Wet Density	t/m <sup>3</sup>	1.96	1.89	1.86		
Optimum Moisture Content	%	23.5	23	22		



  

<b>Moisture Ratio</b>	%	95.5	107	108.5		
<b>Moisture Variation</b>	%	-1.0	1.5	2.0		
<b>from OMC</b>		Drier	Wetter	Wetter		
<b>Density Ratio</b>	%	98.5	96.5	97.5		


<b>Specification:</b>	95% STD	<b>Test Selection:</b>	N/A
<b>Notes:</b>	Ref : 1120 0343-1 (SI16)		
<b>Test Method</b>	AS1289 5.8.1, 5.7.1, 2.1.1, 1.1	<b>Sampling Method:</b>	AS 1289 1.2.1 6.4(b)

 <b>NATA</b> WORLD RECOGNISED ACCREDITATION	NATA Accredited Laboratory No. 20172	Approved Signatory:   Date: 29/07/2022
	Accreditation for compliance with ISO/IEC 17025 - Testing	
	The results of tests, calibrations and/or measurements included	
	in this document, are traceable to Australian / National Standards	



Test Location

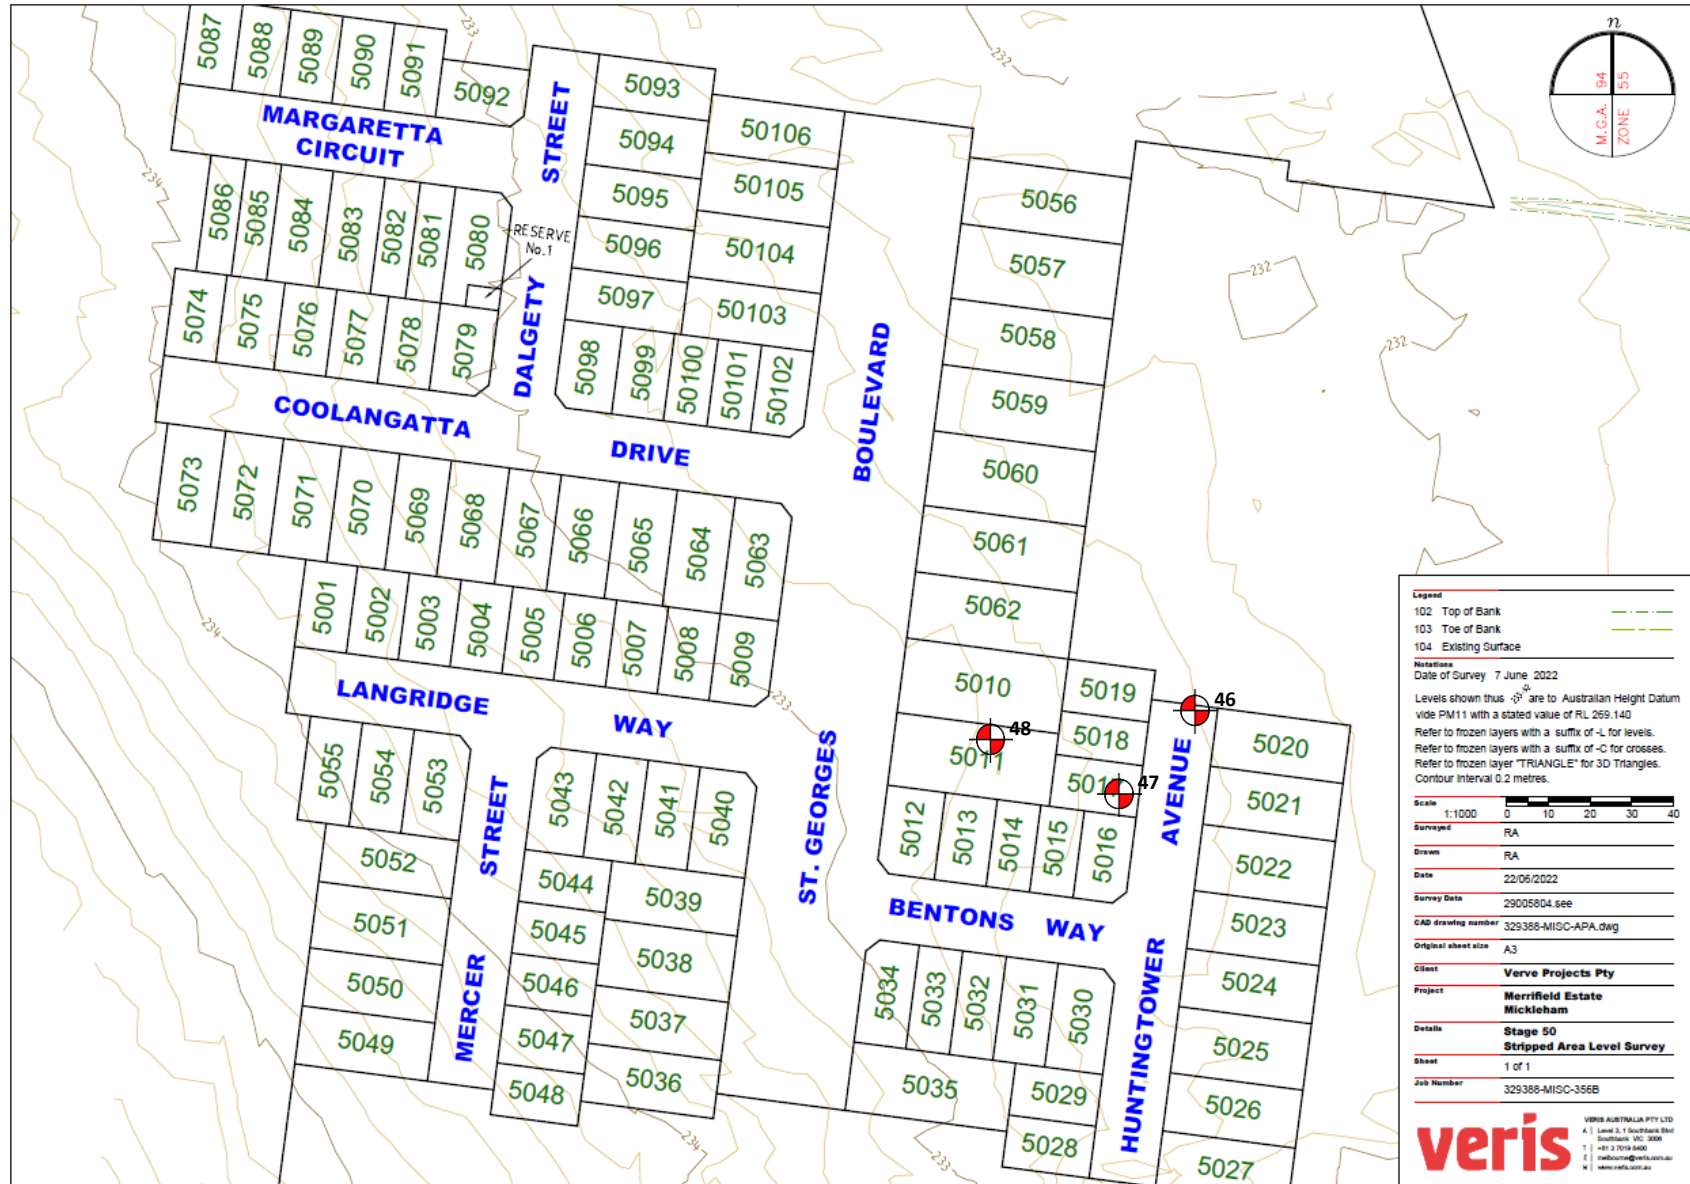

<b>PROJECT:</b> Merrifield Estate – Stage 50 (Level 1)	<b>CLIENT:</b> BMD Urban	<b>DATE:</b> 15/06/2022
<b>LOCATION:</b> Mickleham	<b>PROJECT No:</b> 1120 0343-1 (SI16)	<b>SITE PLAN SKETCH—NOT TO SCALE</b>



**A&Y ASSOCIATES**  
GEOTECHNICAL ENGINEERING CONSULTANTS

## Field Density Test Results AS1289.5.7.1

A & Y Associates Pty Ltd  
5/16 Network Drive  
Truganina VIC 3029  
PH: 0400 413 531  
info@ayassociates.com.au

<b>Client:</b>	BMD Urban			<b>Job No:</b>	BMD2324	
<b>Project:</b>	Merrifield Estate - Stage 50 (Level 1)			<b>Report:</b>	17	
<b>Location:</b>	Mickleham					

Sample No	49	50	51			
Date Tested	20/06/2022	20/06/2022	20/06/2022			
Time Tested	PM	PM	PM			

Test Location	Refer to Plan	Refer to Plan	Refer to Plan			
Level/Layer	Layer 3	Layer 3	Layer 3			
Layer Thickness	mm 200	mm 200	mm 200			
Test Depth	mm 175	mm 175	mm 175			
Field Wet Density	t/m <sup>3</sup> 1.91	t/m <sup>3</sup> 1.82	t/m <sup>3</sup> 1.80			
Field Moisture Content	% 19.9	% 24.1	% 20.1			
Material:	Imported Clay	Imported Clay	Imported Clay			

Oversize Material	WET, %	2.5	2.9	3.8		
Sieve Size	mm	19	19	19		
Peak Converted Wet Density	t/m <sup>3</sup>	1.94	1.84	1.82		
Optimum Moisture Content	%	18	25	18.5		



  

<b>Moisture Ratio</b>	%	110.5	96.5	108.5		
<b>Moisture Variation</b>	%	1.5	-0.5	1.5		
<b>from OMC</b>		Wetter	Drier	Wetter		
<b>Density Ratio</b>	%	98.0	98.0	98.0		


<b>Specification:</b>	95% STD	<b>Test Selection:</b>	N/A
<b>Notes:</b>	Ref : 1120 0343-1 (SI17)		
<b>Test Method</b>	AS1289 5.8.1, 5.7.1, 2.1.1, 1.1	<b>Sampling Method:</b>	AS 1289 1.2.1 6.4(b)

 <b>NATA</b> WORLD RECOGNISED ACCREDITATION	NATA Accredited Laboratory No. 20172	Approved Signatory:    David Burns  Date: 29/07/2022
	Accreditation for compliance with ISO/IEC 17025 - Testing	
	The results of tests, calibrations and/or measurements included in this document, are traceable to Australian / National Standards	



Test Location

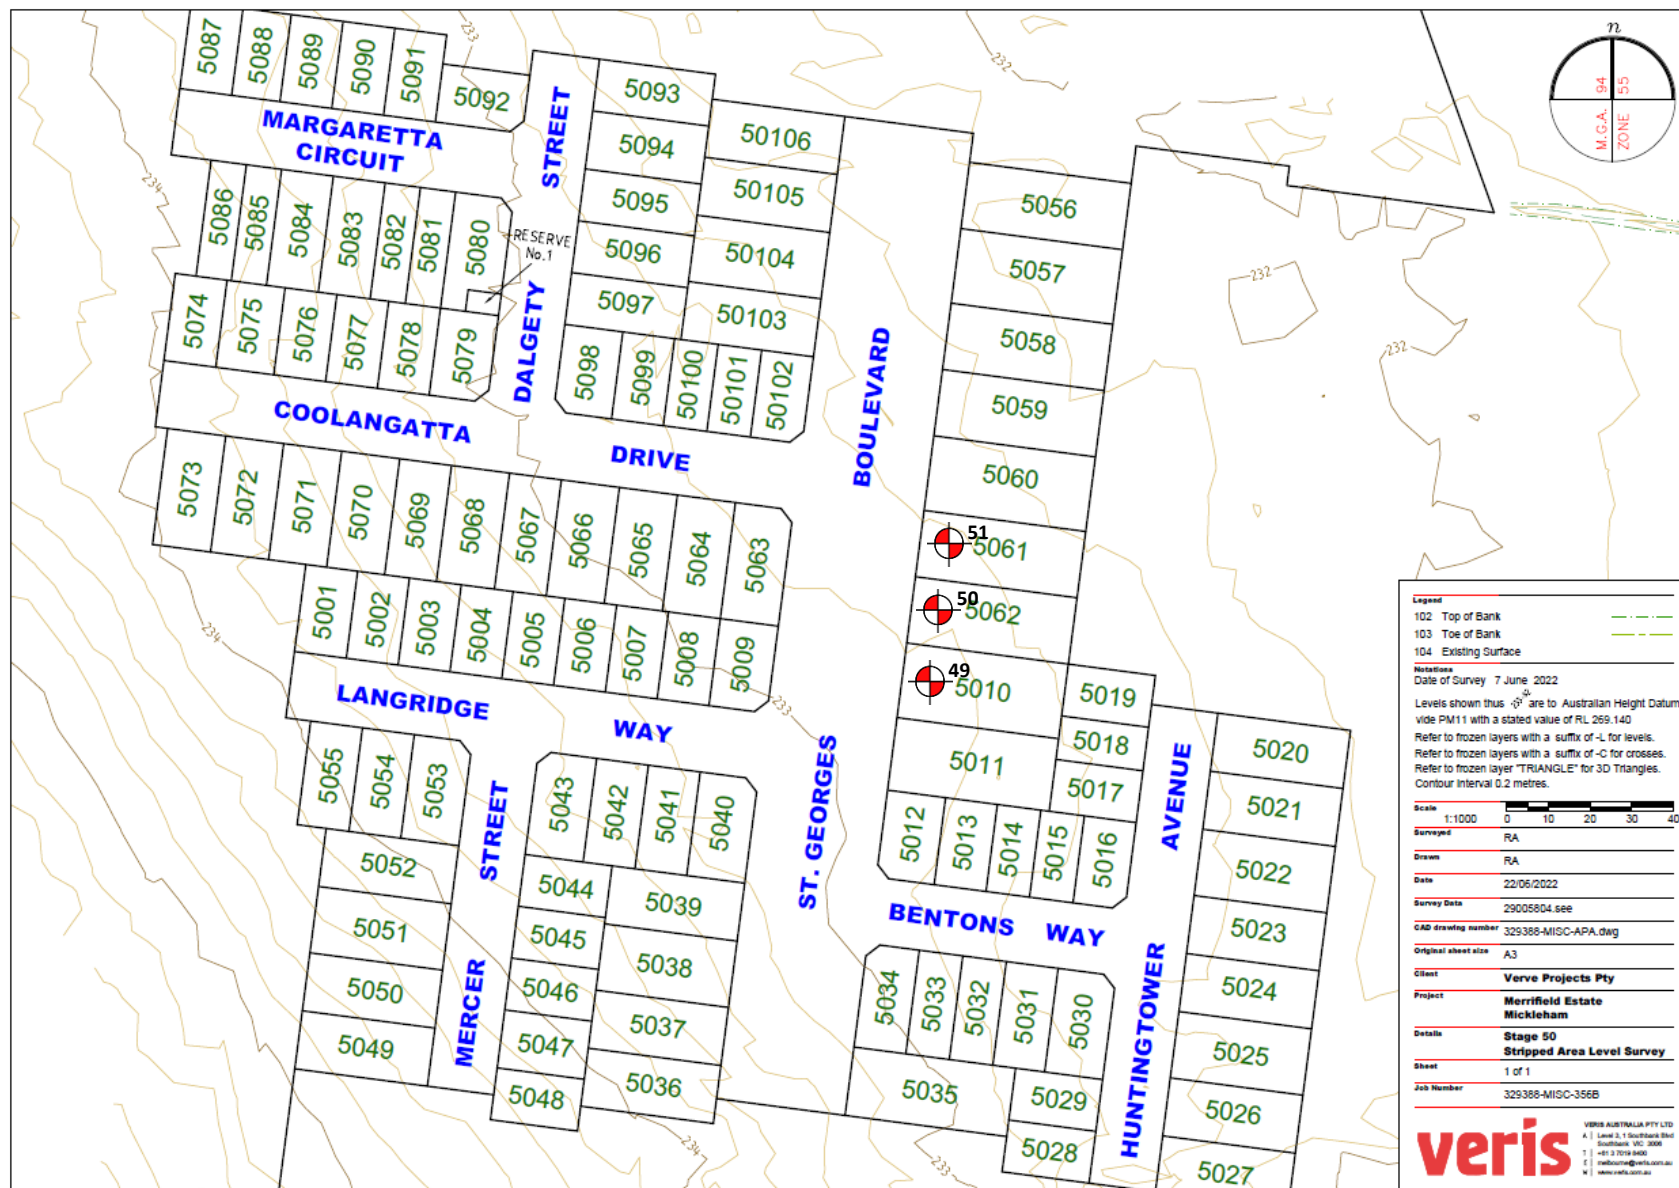

PROJECT:

Merrifield Estate – Stage 50 (Level 1)

CLIENT:

BMD Urban

DATE:

20/06/2022

LOCATION:

Mickleham

PROJECT No:

1120 0343-1 (SI17)

SITE PLAN SKETCH—NOT TO SCALE



**A&Y ASSOCIATES**  
GEOTECHNICAL ENGINEERING CONSULTANTS

## Field Density Test Results AS1289.5.7.1

A & Y Associates Pty Ltd  
5/16 Network Drive  
Truganina VIC 3029  
PH: 0400 413 531  
info@ayassociates.com.au

<b>Client:</b>	BMD Urban			<b>Job No:</b>	BMD2324	
<b>Project:</b>	Merrifield Estate - Stage 50 (Level 1)			<b>Report:</b>	18	
<b>Location:</b>	Mickleham					

Sample No	52	53	54			
Date Tested	23/06/2022	23/06/2022	23/06/2022			
Time Tested	AM	AM	AM			

Test Location	Refer to Plan	Refer to Plan	Refer to Plan			
Level/Layer	Layer 1	Layer 1	Layer 1			
Layer Thickness	mm 200	mm 200	mm 200			
Test Depth	mm 175	mm 175	mm 175			
Field Wet Density	t/m <sup>3</sup> 1.90	t/m <sup>3</sup> 1.92	t/m <sup>3</sup> 1.95			
Field Moisture Content	% 22.0	% 21.5	% 21.0			
Material:	Imported Clay	Imported Clay	Imported Clay			

Oversize Material	WET, % 3.8	WET, % 3.5	WET, % 4.8			
Sieve Size	mm 19	mm 19	mm 19			
Peak Converted Wet Density	t/m <sup>3</sup> 1.93	t/m <sup>3</sup> 1.98	t/m <sup>3</sup> 1.98			
Optimum Moisture Content	% 22.5	% 19.5	% 21.5			



  

<b>Moisture Ratio</b>	% 98	% 110.5	% 97.5			
<b>Moisture Variation</b>	% -0.5	% 1.5	% -0.5			
<b>from OMC</b>	Drier	Wetter	Drier			
<b>Density Ratio</b>	% 98.0	% 96.5	% 98.0			

<b>Specification:</b>	95% STD	<b>Test Selection:</b>	N/A
<b>Notes:</b>	Ref : 1120 0343-1 (SI18)		
<b>Test Method</b>	AS1289 5.8.1, 5.7.1, 2.1.1, 1.1	<b>Sampling Method:</b>	AS 1289 1.2.1 6.4(b)


  

 <b>NATA</b> WORLD RECOGNISED ACCREDITATION	NATA Accredited Laboratory No. 20172	Approved Signatory:   Date: 29/07/2022
	Accreditation for compliance with ISO/IEC 17025 - Testing	
	The results of tests, calibrations and/or measurements included in this document, are traceable to Australian / National Standards	





Test Location

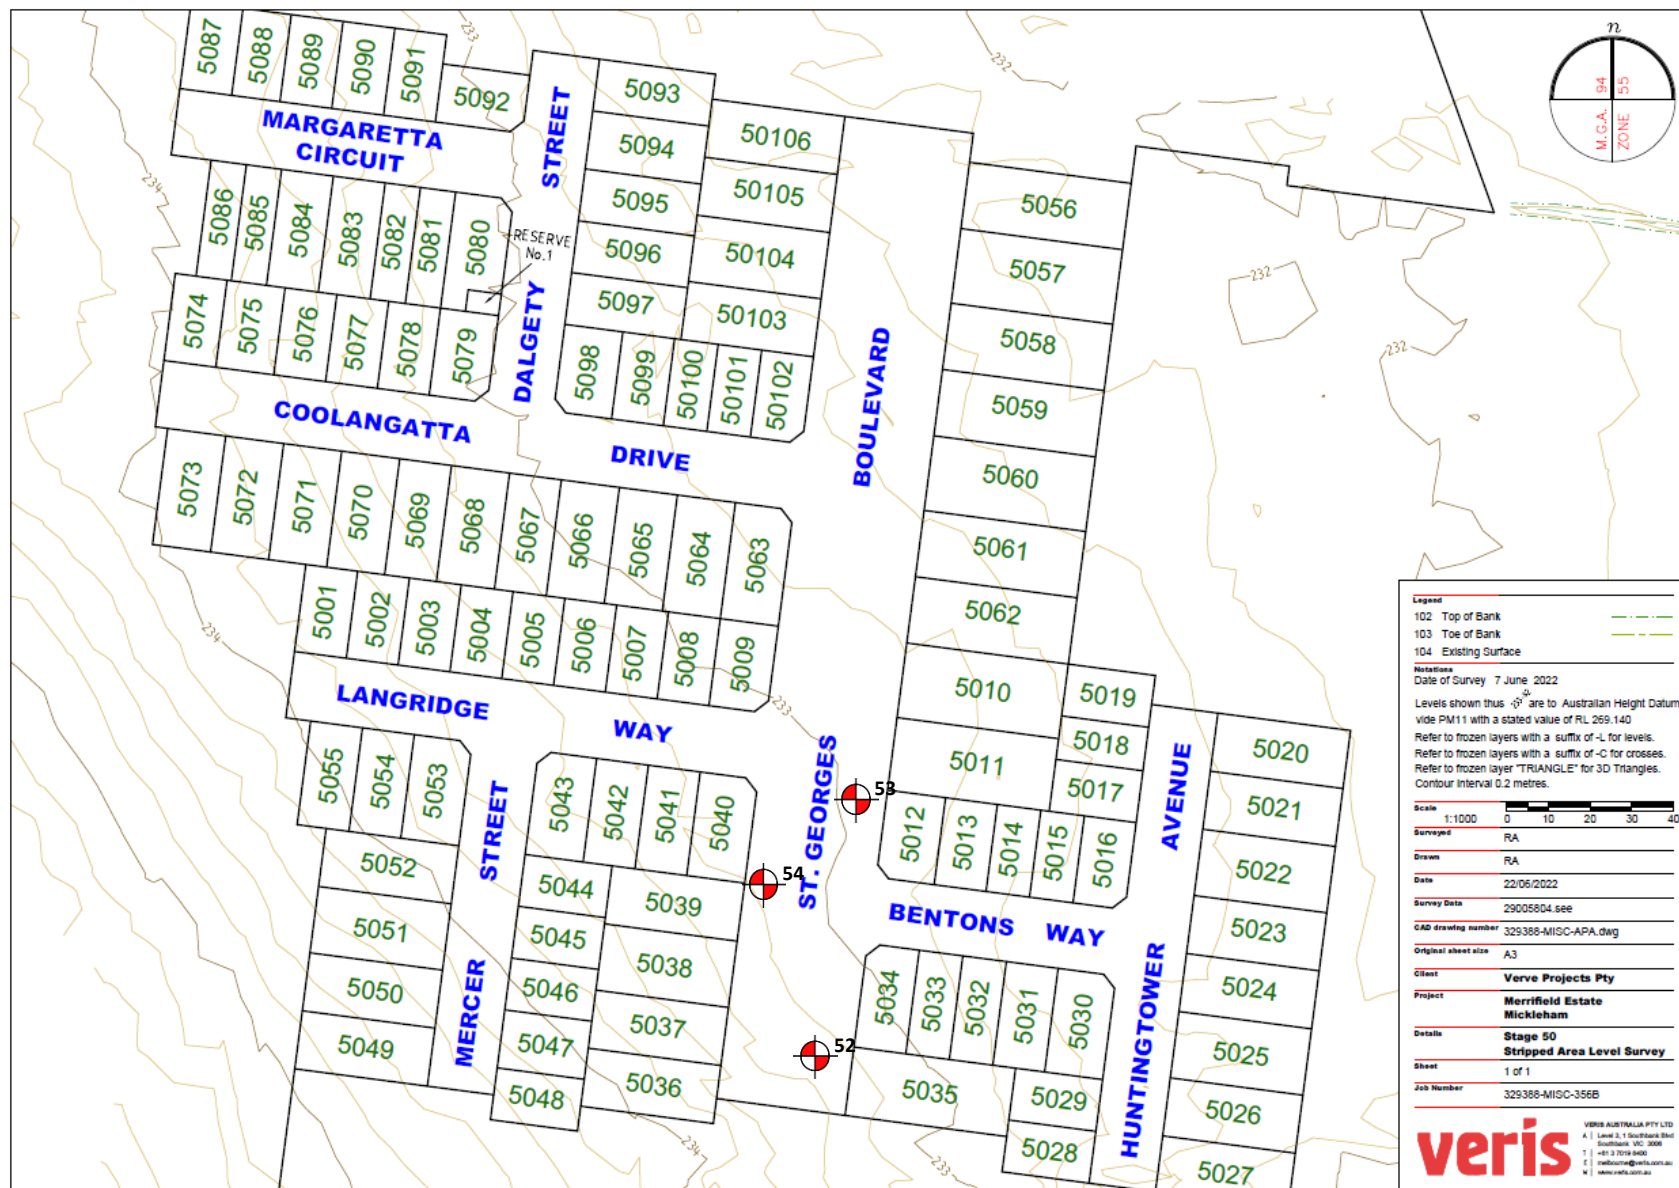

PROJECT: Merrifield Estate – Stage 50 (Level 1)	CLIENT: BMD Urban	DATE: 23/06/2022
LOCATION: Mickleham	PROJECT No: 1120 0343-1 (SI18)	SITE PLAN SKETCH—NOT TO SCALE



**A&Y ASSOCIATES**  
GEOTECHNICAL ENGINEERING CONSULTANTS



## Field Density Test Results AS1289.5.7.1

A & Y Associates Pty Ltd  
5/16 Network Drive  
Truganina VIC 3029  
PH: 0400 413 531  
info@ayassociates.com.au

<b>Client:</b>	BMD Urban			<b>Job No:</b>	BMD2324	
<b>Project:</b>	Merrifield Estate - Stage 50 (Level 1)			<b>Report:</b>	19	
<b>Location:</b>	Mickleham					

Sample No	55	56	57			
Date Tested	27/06/2022	27/06/2022	27/06/2022			
Time Tested	AM	AM	AM			

Test Location	Refer to Plan	Refer to Plan	Refer to Plan			
Level/Layer	Layer 4	Layer 4	Layer 4			
Layer Thickness	mm 200	mm 200	mm 200			
Test Depth	mm 175	mm 175	mm 175			
Field Wet Density	t/m <sup>3</sup> 1.91	t/m <sup>3</sup> 1.85	t/m <sup>3</sup> 1.84			
Field Moisture Content	% 18.1	% 20.1	% 21.4			
Material:	Imported Clay	Imported Clay	Imported Clay			

Oversize Material	WET, %	3.8	2.0	4.3		
Sieve Size	mm	19	19	19		
Peak Converted Wet Density	t/m <sup>3</sup>	1.94	1.87	1.89		
Optimum Moisture Content	%	16	21	19.5		



  

<b>Moisture Ratio</b>	%	113.5	96	109.5		
<b>Moisture Variation</b>	%	2.0	-0.5	1.5		
<b>from OMC</b>		Wetter	Drier	Wetter		
<b>Density Ratio</b>	%	98.0	98.5	96.5		


<b>Specification:</b>	95% STD	<b>Test Selection:</b>	N/A
<b>Notes:</b>	Ref : 1120 0343-1 (SI19)		
<b>Test Method</b>	AS1289 5.8.1, 5.7.1, 2.1.1, 1.1	<b>Sampling Method:</b>	AS 1289 1.2.1 6.4(b)

 <b>NATA</b> WORLD RECOGNISED ACCREDITATION	NATA Accredited Laboratory No. 20172	Approved Signatory:   Date: 29/07/2022
	Accreditation for compliance with ISO/IEC 17025 - Testing	
	The results of tests, calibrations and/or measurements included	
	in this document, are traceable to Australian / National Standards	



Test Location

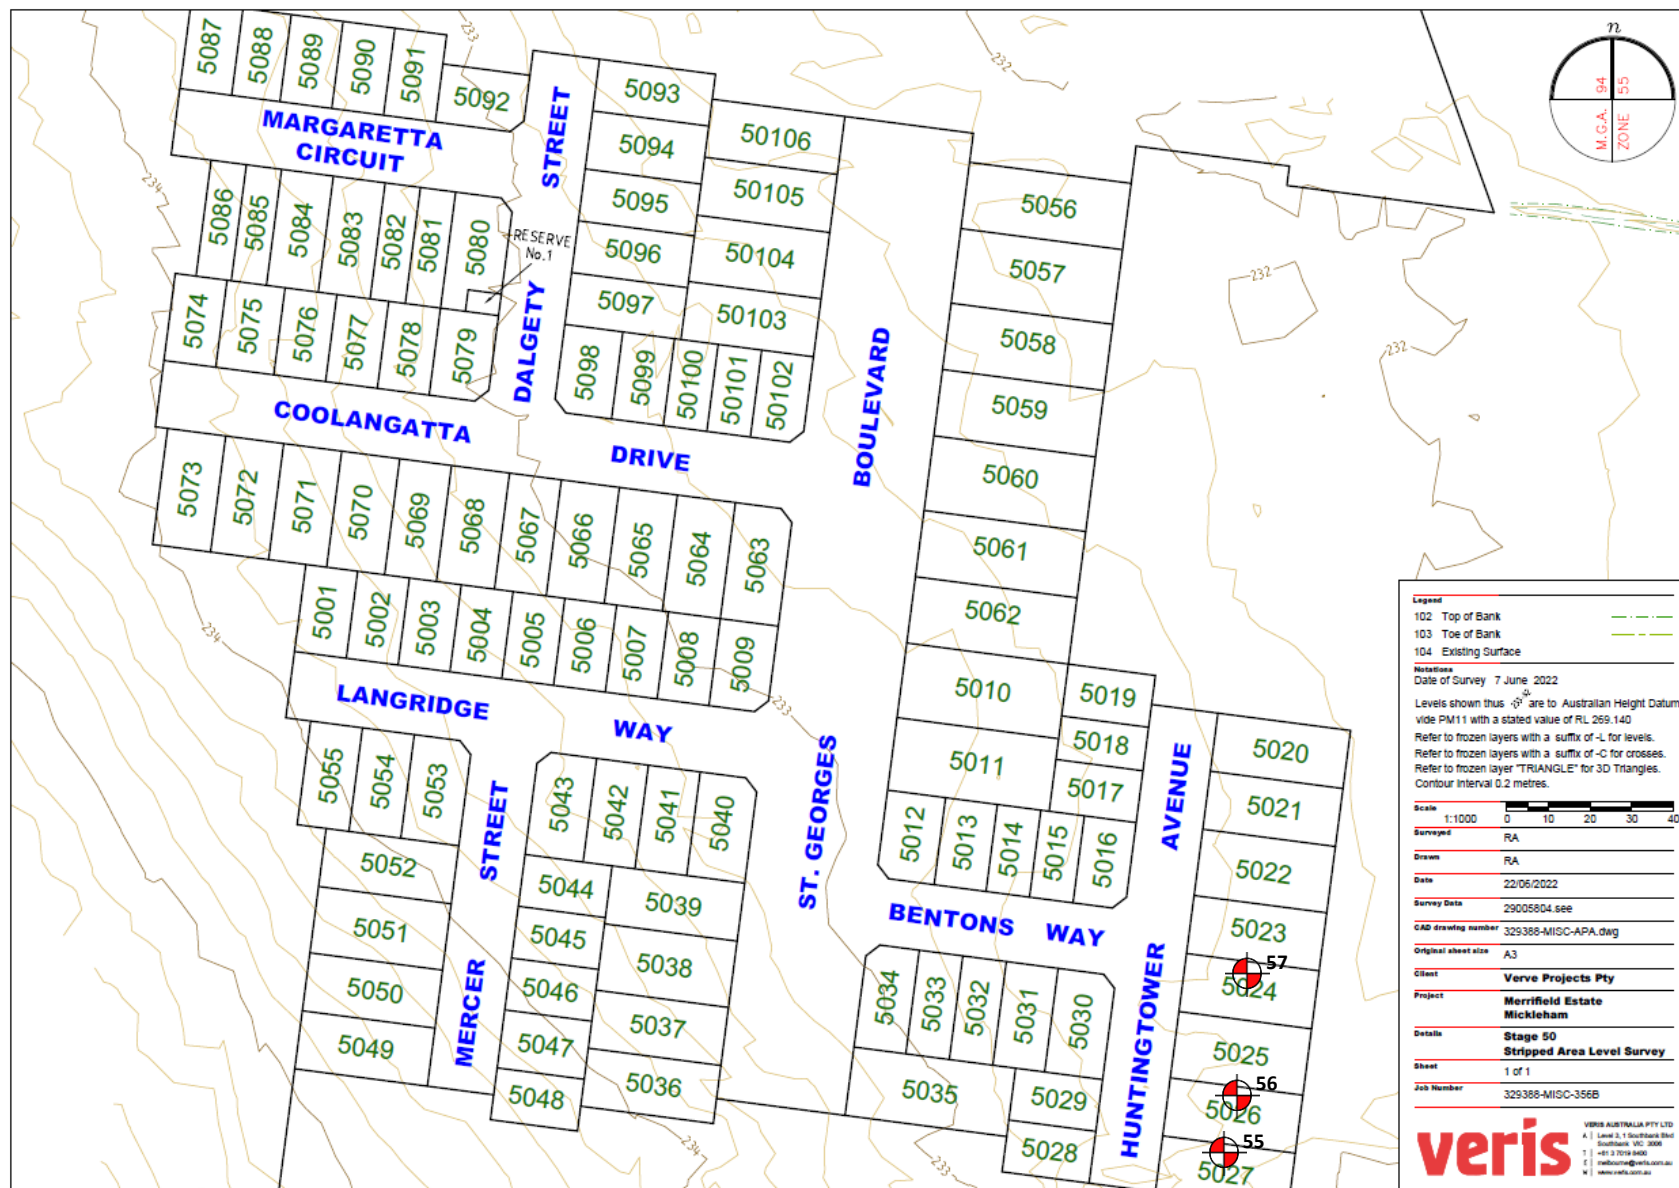

<b>Legend</b>	
102 Top of Bank	---
103 Toe of Bank	---
104 Existing Surface	---
<b>Notations</b>	
Date of Survey 7 June 2022	
Levels shown thus '92' are to Australian Height Datum vide PM11 with a stated value of RL 269.140	
Refer to frozen layers with a suffix of -L for levels.	
Refer to frozen layers with a suffix of -C for crosses.	
Refer to frozen layer "TRIANGLE" for 3D Triangles.	
Contour interval 0.2 metres.	
<b>Scale</b>	1:1000 0 10 20 30 40
<b>Surveyed</b>	RA
<b>Drawn</b>	RA
<b>Date</b>	22/06/2022
<b>Survey Data</b>	29005804.ssee
<b>CAD drawing number</b>	329388-MISC-APA.dwg
<b>Original sheet size</b>	A3
<b>Client</b>	Verve Projects Pty
<b>Project</b>	Merrifield Estate Mickleham
<b>Details</b>	Stage 50 Stripped Area Level Survey
<b>Sheet</b>	1 of 1
<b>Job Number</b>	329388-MISC-356B
<b>veris</b>	
VERIS AUSTRALIA PTY LTD A   Level 2, 1 Southbank Blvd Southbank, VIC 3006 T   +61 3 7019 8400 E   info@veris.com.au W   www.veris.com.au	

<b>PROJECT:</b> Merrifield Estate – Stage 50 (Level 1)	<b>CLIENT:</b> BMD Urban	<b>DATE:</b> 27/06/2022
<b>LOCATION:</b> Mickleham	<b>PROJECT No:</b> 1120 0343-1 (SI19)	<b>SITE PLAN SKETCH—NOT TO SCALE</b>



**A&Y ASSOCIATES**  
GEOTECHNICAL ENGINEERING CONSULTANTS

## Field Density Test Results AS1289.5.7.1

A & Y Associates Pty Ltd  
5/16 Network Drive  
Truganina VIC 3029  
PH: 0400 413 531  
info@ayassociates.com.au

<b>Client:</b>	BMD Urban			<b>Job No:</b>	BMD2324	
<b>Project:</b>	Merrifield Estate - Stage 50 (Level 1)			<b>Report:</b>	20	
<b>Location:</b>	Mickleham					

Sample No	58	59	60			
Date Tested	28/06/2022	28/06/2022	28/06/2022			
Time Tested	AM	AM	AM			

Test Location	Refer to Plan	Refer to Plan	Refer to Plan			
Level/Layer	Layer 4	Layer 4	Layer 4			
Layer Thickness	mm 200	mm 200	mm 200			
Test Depth	mm 175	mm 175	mm 175			
Field Wet Density	t/m <sup>3</sup> 1.95	t/m <sup>3</sup> 1.93	t/m <sup>3</sup> 1.94			
Field Moisture Content	% 18.3	% 19.2	% 19.7			
Material:	Imported Clay	Imported Clay	Imported Clay			

Oversize Material	WET, % 4.8	WET, % 3.6	WET, % 4.1			
Sieve Size	mm 19	mm 19	mm 19			
Peak Converted Wet Density	t/m <sup>3</sup> 1.96	t/m <sup>3</sup> 1.95	t/m <sup>3</sup> 1.95			
Optimum Moisture Content	% 19	% 17.5	% 18			

<b>Moisture Ratio</b>	% 96.5	% 109.5	% 109.5			
<b>Moisture Variation</b>	% -0.5	% 1.5	% 1.5			
<b>from OMC</b>	Drier	Wetter	Wetter			
<b>Density Ratio</b>	% 98.5	% 98.5	% 99.0			

<b>Specification:</b>	95% STD	<b>Test Selection:</b>	N/A
<b>Notes:</b>	Ref : 1120 0343-1 (SI20)		
<b>Test Method</b>	AS1289 5.8.1, 5.7.1, 2.1.1, 1.1	<b>Sampling Method:</b>	AS 1289 1.2.1 6.4(b)



NATA Accredited Laboratory No. 20172  
Accreditation for compliance with ISO/IEC 17025 - Testing  
The results of tests, calibrations and/or measurements included  
in this document, are traceable to Australian / National Standards

Approved Signatory:




David Burns  
29/07/2022

Date:



Test Location

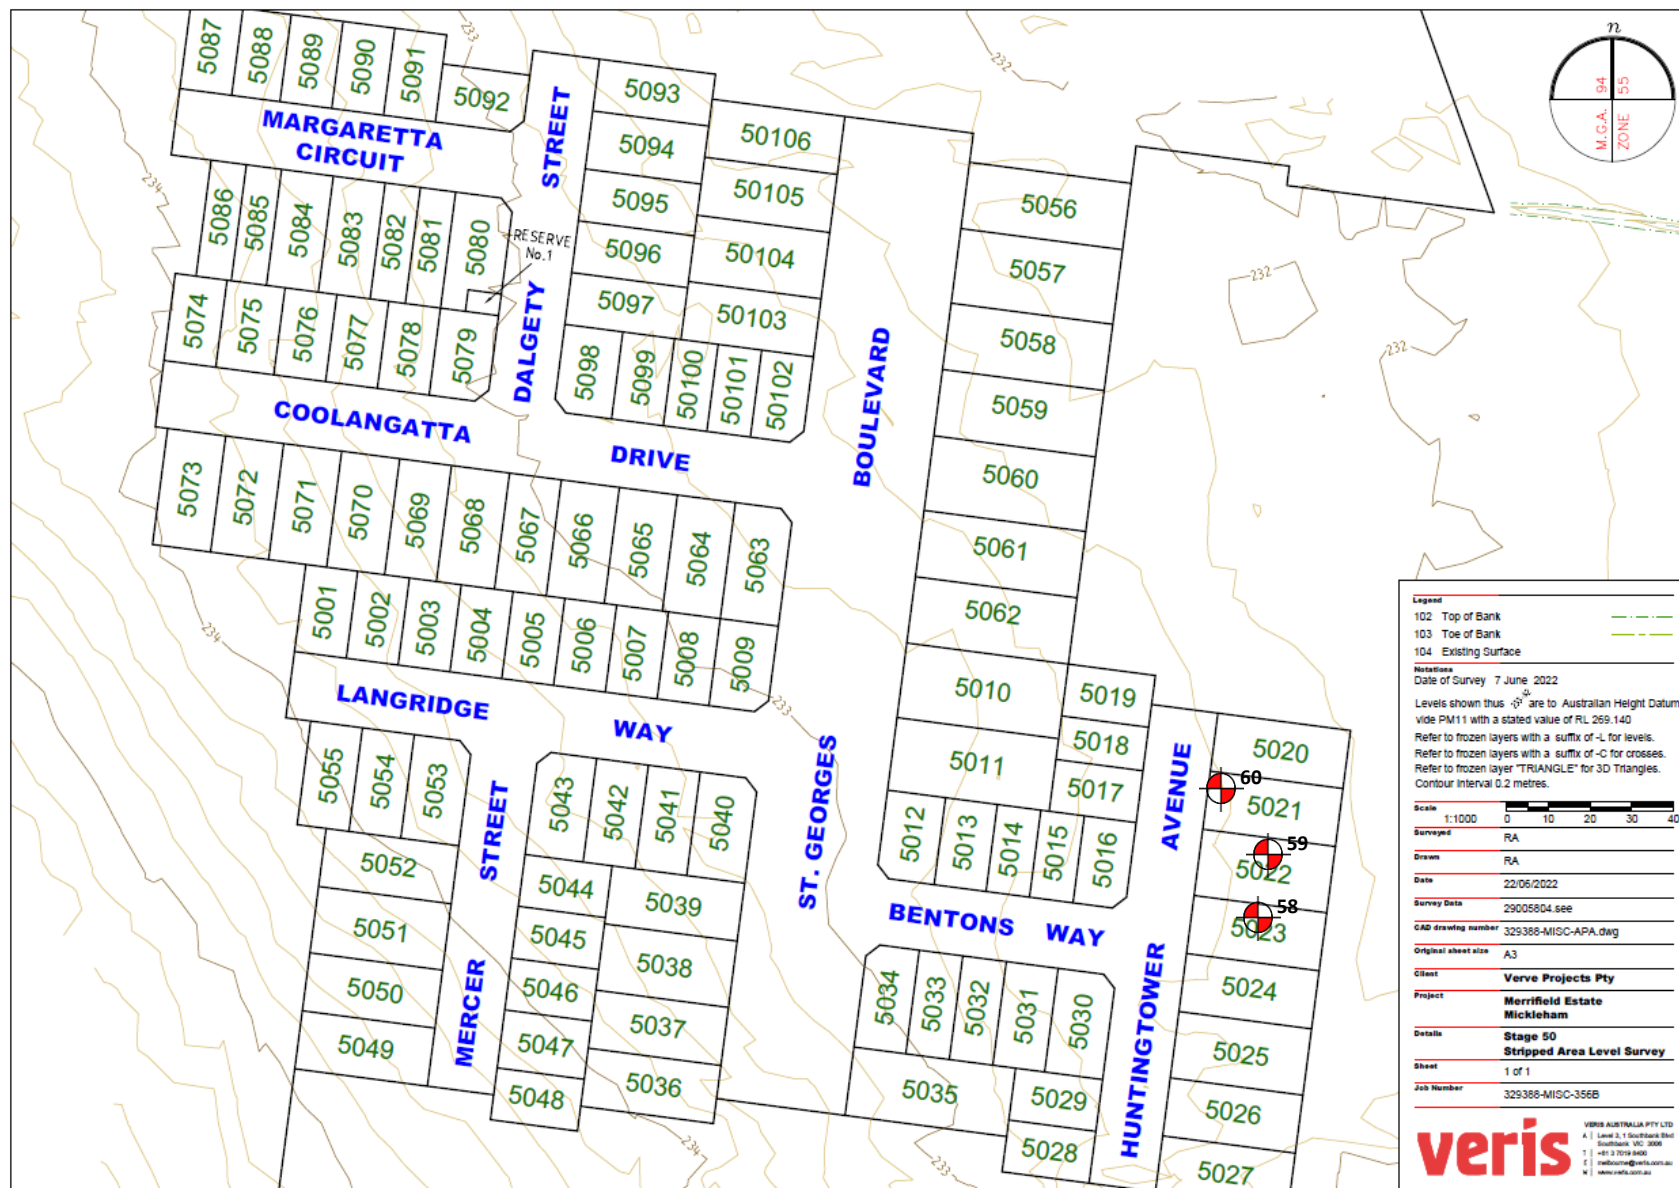

PROJECT:

Merrifield Estate – Stage 50 (Level 1)

CLIENT:

BMD Urban

DATE:

28/06/2022

LOCATION:

Mickleham

PROJECT No:

1120 0343-1 (SI20)

SITE PLAN SKETCH—NOT TO SCALE



**A&Y ASSOCIATES**  
GEOTECHNICAL ENGINEERING CONSULTANTS

## Field Density Test Results AS1289.5.7.1

A & Y Associates Pty Ltd  
5/16 Network Drive  
Truganina VIC 3029  
PH: 0400 413 531  
info@ayassociates.com.au

<b>Client:</b>	BMD Urban			<b>Job No:</b>	BMD2324	
<b>Project:</b>	Merrifield Estate - Stage 50 (Level 1)			<b>Report:</b>	21	
<b>Location:</b>	Mickleham					

Sample No	61	62	63			
Date Tested	29/06/2022	29/06/2022	29/06/2022			
Time Tested	AM	AM	AM			

Test Location	Refer to Plan	Refer to Plan	Refer to Plan			
Level/Layer	Layer 1	Layer 1	Layer 1			
Layer Thickness	mm 200	mm 200	mm 200			
Test Depth	mm 175	mm 175	mm 175			
Field Wet Density	t/m <sup>3</sup> 1.94	t/m <sup>3</sup> 1.82	t/m <sup>3</sup> 1.89			
Field Moisture Content	% 22.3	% 24.3	% 23.1			
Material:	Imported Clay	Imported Clay	Imported Clay			

Oversize Material	WET, % 4.5	WET, % 3.0	WET, % 3.8			
Sieve Size	mm 19	mm 19	mm 19			
Peak Converted Wet Density	t/m <sup>3</sup> 1.99	t/m <sup>3</sup> 1.87	t/m <sup>3</sup> 1.93			
Optimum Moisture Content	% 22.5	% 22.5	% 21.5			

<b>Moisture Ratio</b>	% 99	% 108	% 107.5			
<b>Moisture Variation</b>	% -0.5	% 1.5	% 1.5			
<b>from OMC</b>	Drier	Wetter	Wetter			
<b>Density Ratio</b>	% 97.0	% 97.0	% 97.5			

<b>Specification:</b>	95% STD	<b>Test Selection:</b>	N/A
<b>Notes:</b>	Ref : 1120 0343-1 (SI21)		
<b>Test Method</b>	AS1289 5.8.1, 5.7.1, 2.1.1, 1.1	<b>Sampling Method:</b>	AS 1289 1.2.1 6.4(b)



NATA Accredited Laboratory No. 20172  
Accreditation for compliance with ISO/IEC 17025 - Testing  
The results of tests, calibrations and/or measurements included  
in this document, are traceable to Australian / National Standards

Approved Signatory:




David Burns  
29/07/2022

Date:





Test Location

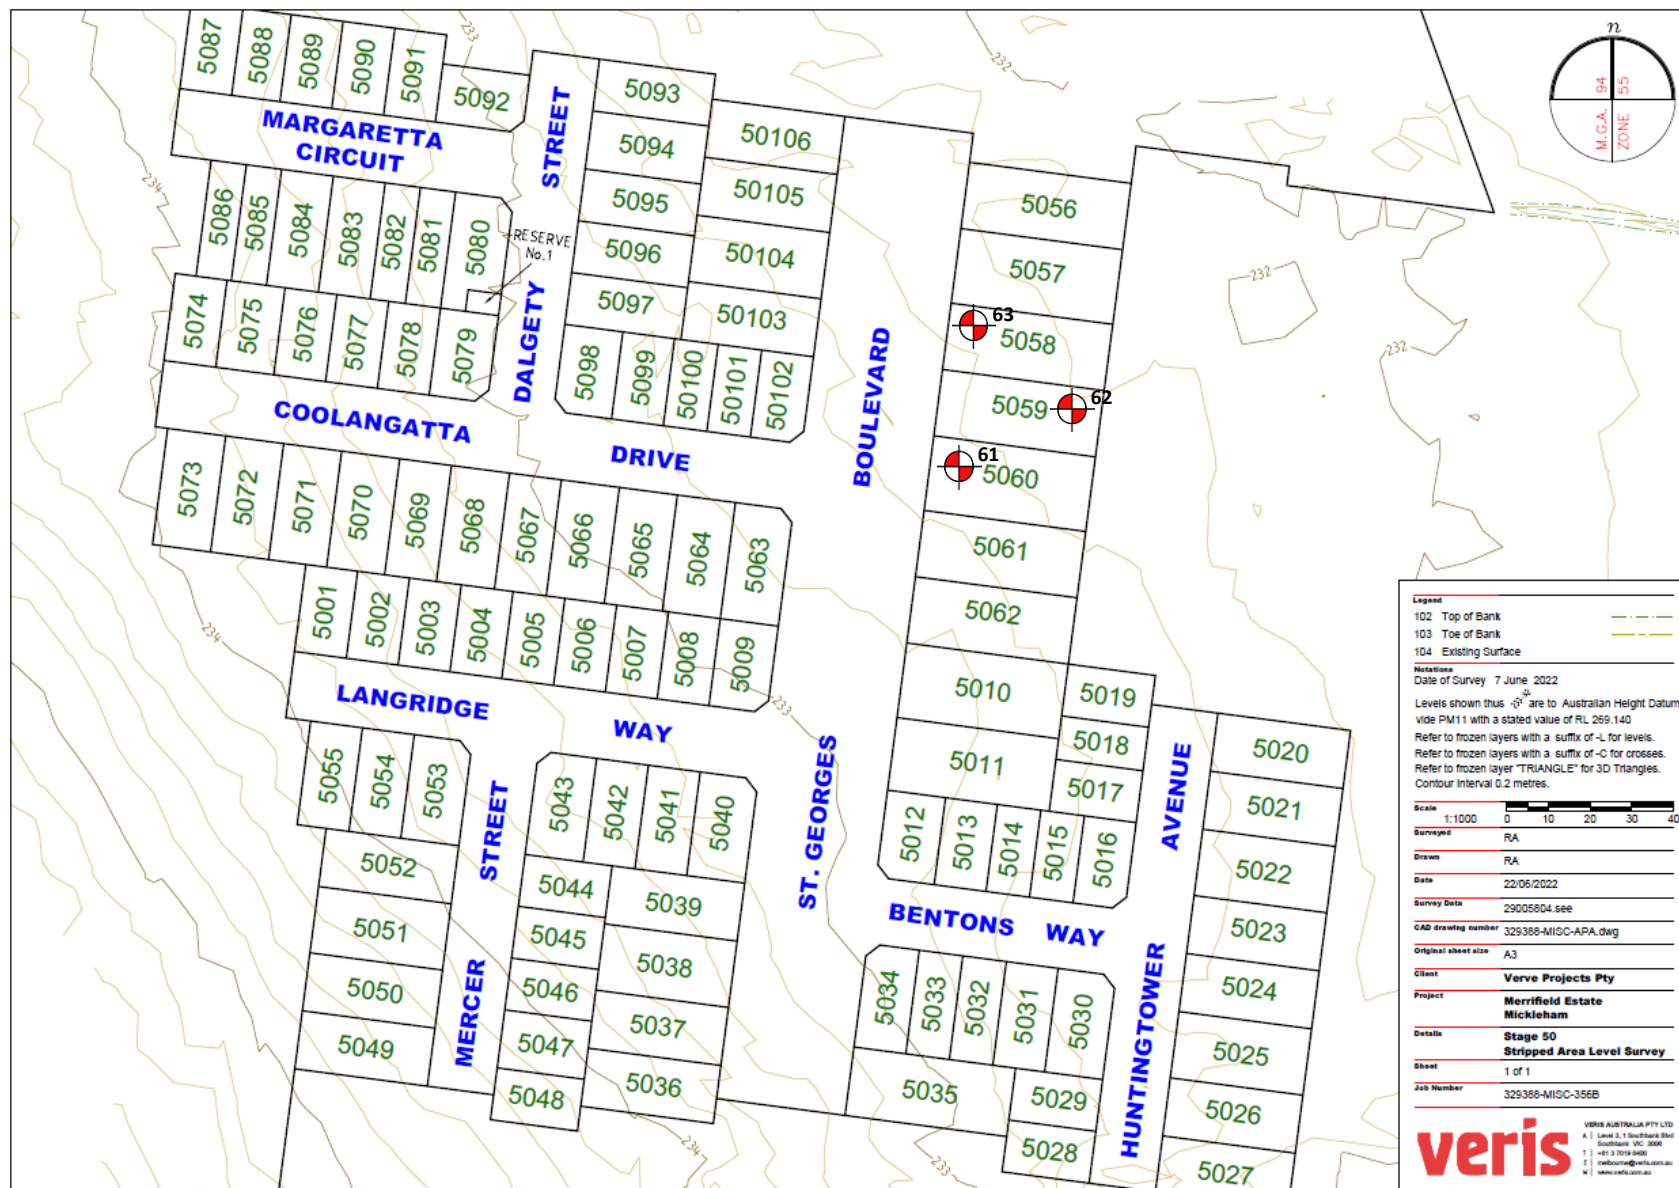

PROJECT:  
Merrifield Estate – Stage 50 (Level 1)

CLIENT:  
BMD Urban

DATE:  
29/06/2022

LOCATION:  
Mickleham

PROJECT No:  
1120 0343-1 (SI21)

SITE PLAN SKETCH—NOT TO SCALE



**A&Y ASSOCIATES**  
GEOTECHNICAL ENGINEERING CONSULTANTS



## Field Density Test Results AS1289.5.7.1

A & Y Associates Pty Ltd  
5/16 Network Drive  
Truganina VIC 3029  
PH: 0400 413 531  
info@ayassociates.com.au

<b>Client:</b>	BMD Urban			<b>Job No:</b>	BMD2324	
<b>Project:</b>	Merrifield Estate - Stage 50 (Level 1)			<b>Report:</b>	22	
<b>Location:</b>	Mickleham					
Sample No	64	65	66			
Date Tested	30/06/2022	30/06/2022	30/06/2022			
Time Tested	AM	AM	AM			
Test Location	Refer to Plan	Refer to Plan	Refer to Plan			
Level/Layer	Layer 2	Layer 2	Layer 2			
Layer Thickness	mm 200	mm 200	mm 200			
Test Depth	mm 175	mm 175	mm 175			
Field Wet Density	t/m <sup>3</sup> 1.84	t/m <sup>3</sup> 1.84	t/m <sup>3</sup> 1.94			
Field Moisture Content	% 24.4	% 24.6	% 22.2			
Material:	Imported Clay	Imported Clay	Imported Clay			
Oversize Material	WET, % 1.8	WET, % 2.1	WET, % 4.2			
Sieve Size	mm 19	mm 19	mm 19			
Peak Converted Wet Density	t/m <sup>3</sup> 1.89	t/m <sup>3</sup> 1.89	t/m <sup>3</sup> 1.97			
Optimum Moisture Content	% 23	% 22.5	% 23			
<b>Moisture Ratio</b>	% 106	% 109.5	% 96.5			
<b>Moisture Variation</b>	% 1.5	% 2.0	% -0.5			
<b>from OMC</b>	Wetter	Wetter	Drier			
<b>Density Ratio</b>	% 97.0	% 97.0	% 97.5			

<b>Specification:</b>	95% STD	<b>Test Selection:</b>	N/A
<b>Notes:</b>	Ref : 1120 0343-1 (SI22)		
<b>Test Method</b>	AS1289 5.8.1, 5.7.1, 2.1.1, 1.1	<b>Sampling Method:</b>	AS 1289 1.2.1 6.4(b)



NATA Accredited Laboratory No. 20172  
Accreditation for compliance with ISO/IEC 17025 - Testing  
The results of tests, calibrations and/or measurements included  
in this document, are traceable to Australian / National Standards

Approved Signatory:




David Burns  
29/07/2022

Date:



Test Location

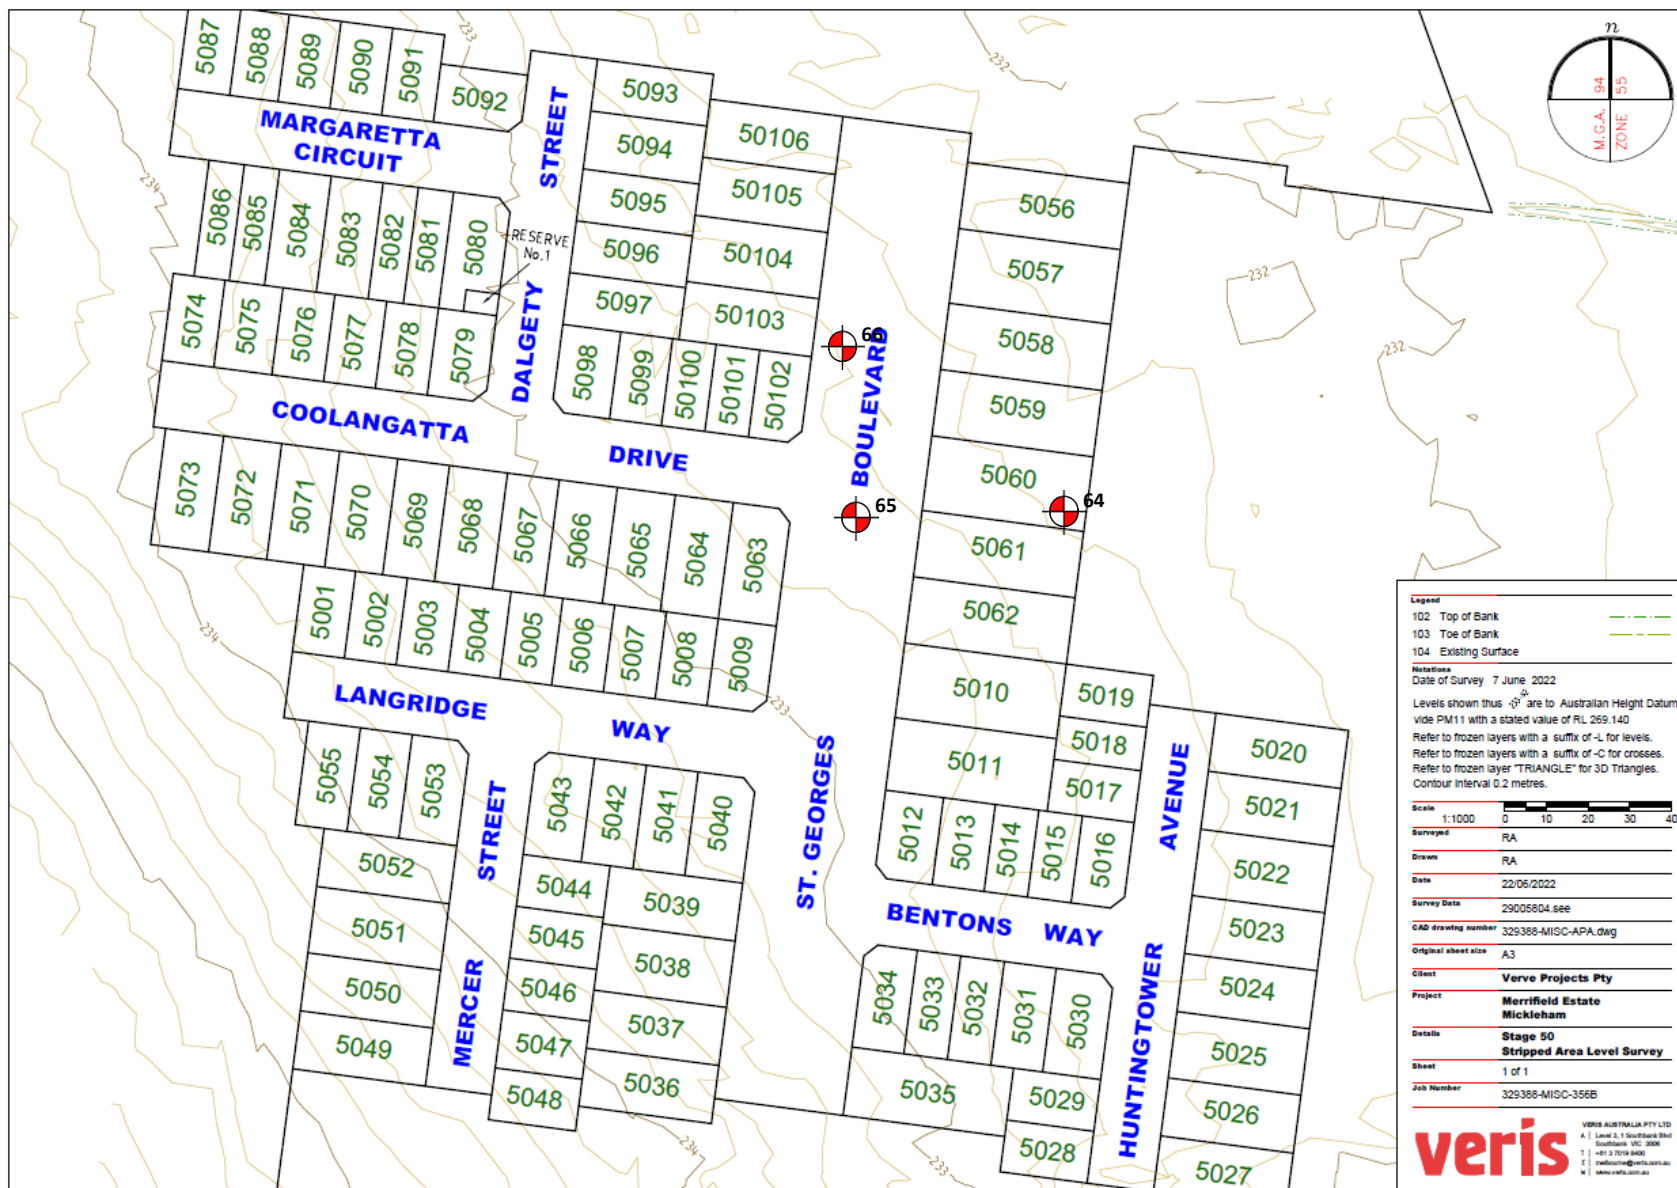

PROJECT:

Merrifield Estate – Stage 50 (Level 1)

CLIENT:

BMD Urban

DATE:

30/06/2022

LOCATION:

Mickleham

PROJECT No:

1120 0343-1 (SI22)

SITE PLAN SKETCH—NOT TO SCALE



**A&Y ASSOCIATES**  
GEOTECHNICAL ENGINEERING CONSULTANTS

## Field Density Test Results AS1289.5.7.1

A & Y Associates Pty Ltd  
5/16 Network Drive  
Truganina VIC 3029  
PH: 0400 413 531  
info@ayassociates.com.au

<b>Client:</b>	BMD Urban			<b>Job No:</b>	BMD2324	
<b>Project:</b>	Merrifield Estate - Stage 50 (Level 1)			<b>Report:</b>	23	
<b>Location:</b>	Mickleham					

Sample No	67	68	69			
Date Tested	01/07/2022	01/07/2022	01/07/2022			
Time Tested	AM	AM	AM			

Test Location	Refer to Plan	Refer to Plan	Refer to Plan			
Level/Layer	Layer 1	Layer 1	Layer 1			
Layer Thickness	mm 200	mm 200	mm 200			
Test Depth	mm 175	mm 175	mm 175			
Field Wet Density	t/m <sup>3</sup> 1.94	t/m <sup>3</sup> 1.81	t/m <sup>3</sup> 1.84			
Field Moisture Content	% 20.9	% 24.8	% 23.3			
Material:	Imported Clay	Imported Clay	Imported Clay			

Oversize Material	WET, %	4.0	2.8	3.1		
Sieve Size	mm	19	19	19		
Peak Converted Wet Density	t/m <sup>3</sup>	1.99	1.86	1.88		
Optimum Moisture Content	%	21.5	23	21.5		



  

<b>Moisture Ratio</b>	%	97.5	108	108.5		
<b>Moisture Variation</b>	%	-0.5	1.5	2.0		
<b>from OMC</b>		Drier	Wetter	Wetter		
<b>Density Ratio</b>	%	97.0	96.5	97.5		


<b>Specification:</b>	95% STD	<b>Test Selection:</b>	N/A
<b>Notes:</b>	Ref : 1120 0343-1 (SI23)		
<b>Test Method</b>	AS1289 5.8.1, 5.7.1, 2.1.1, 1.1	<b>Sampling Method:</b>	AS 1289 1.2.1 6.4(b)

 <b>NATA</b> WORLD RECOGNISED ACCREDITATION	NATA Accredited Laboratory No. 20172	Approved Signatory:    David Burns  Date: 29/07/2022
	Accreditation for compliance with ISO/IEC 17025 - Testing	
	The results of tests, calibrations and/or measurements included in this document, are traceable to Australian / National Standards	



Test Location

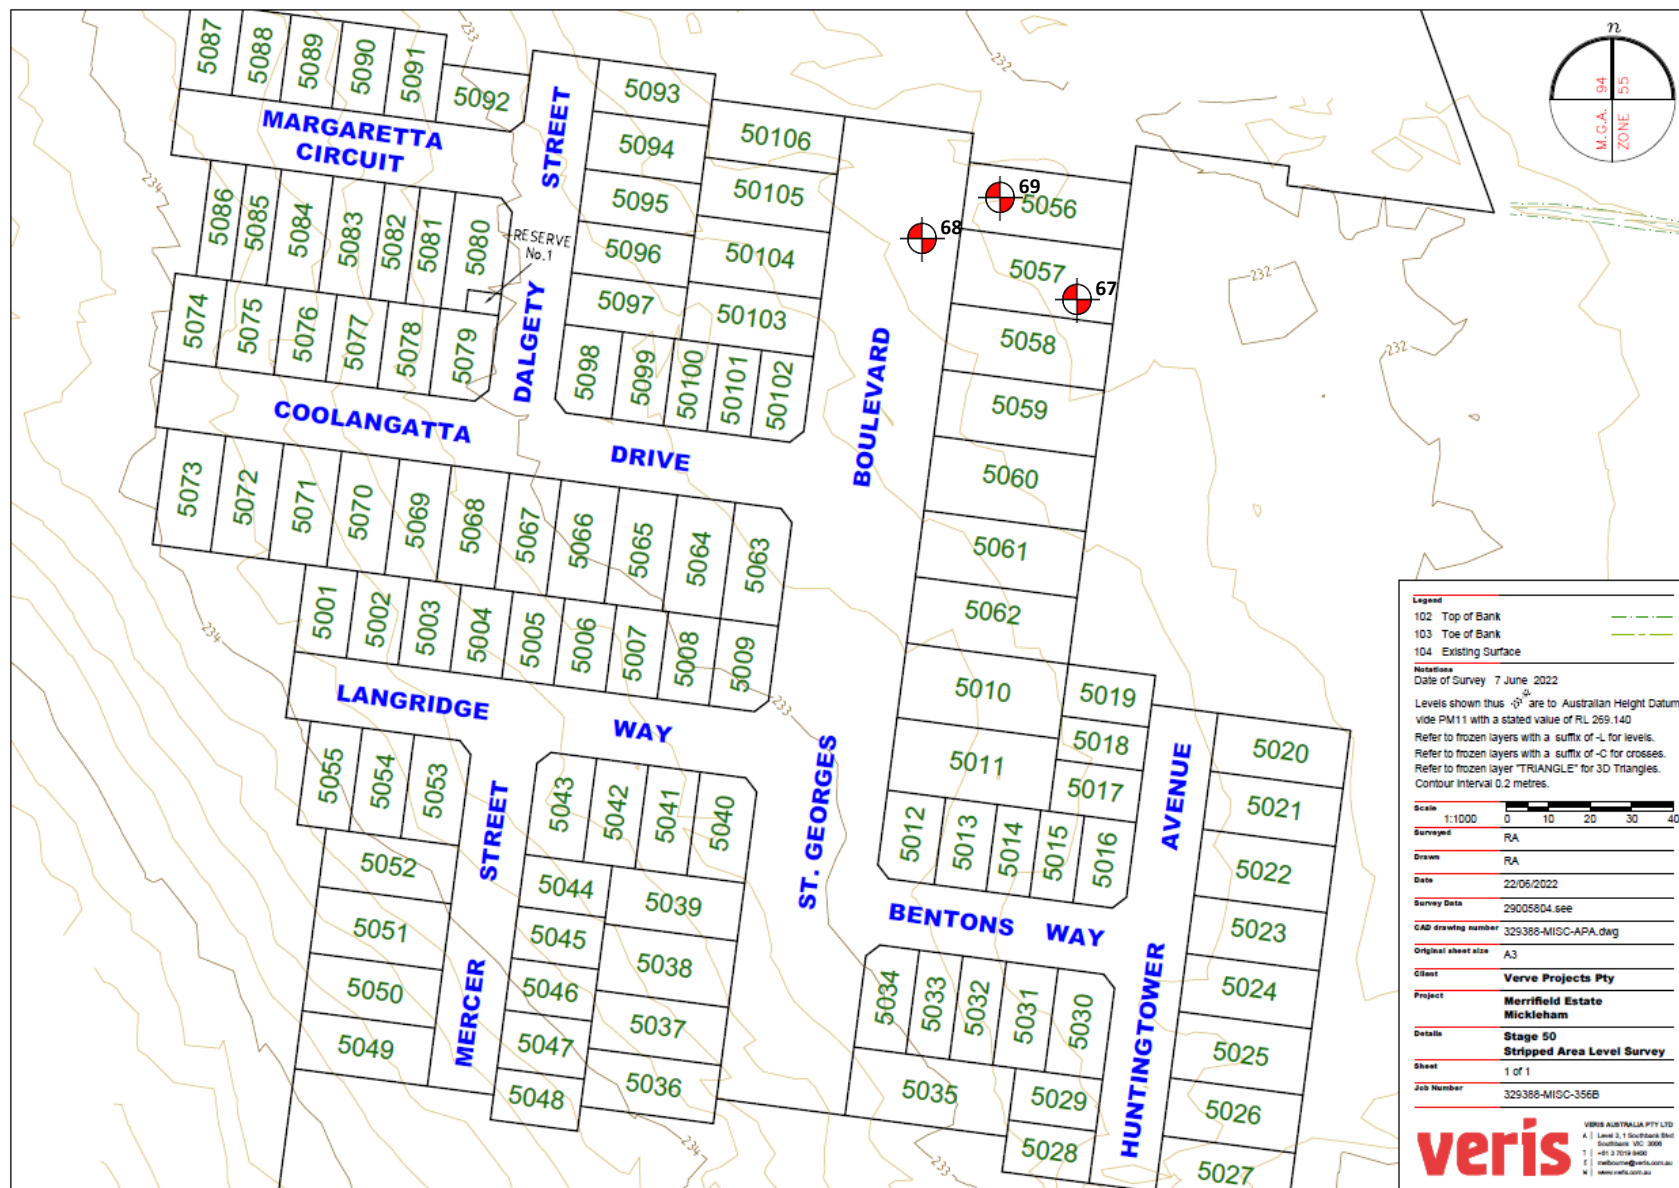

PROJECT:

Merrifield Estate – Stage 50 (Level 1)

CLIENT:

BMD Urban

DATE:

01/07/2022

LOCATION:

Mickleham

PROJECT No:

1120 0343-1 (SI23)

SITE PLAN SKETCH—NOT TO SCALE



**A&Y ASSOCIATES**  
GEOTECHNICAL ENGINEERING CONSULTANTS

## Field Density Test Results AS1289.5.7.1

A & Y Associates Pty Ltd  
5/16 Network Drive  
Truganina VIC 3029  
PH: 0400 413 531  
info@ayassociates.com.au

<b>Client:</b>	BMD Urban			<b>Job No:</b>	BMD2324		
<b>Project:</b>	Merrifield Estate - Stage 50 (Level 1)			<b>Report:</b>	24		
<b>Location:</b>	Mickleham						

Sample No	70	71	72			
Date Tested	04/07/2022	04/07/2022	04/07/2022			
Time Tested	AM	AM	AM			

Test Location	Refer to Plan	Refer to Plan	Refer to Plan			
Level/Layer	Layer 2	Layer 2	Layer 2			
Layer Thickness	mm 200	mm 200	mm 200			
Test Depth	mm 175	mm 175	mm 175			
Field Wet Density	t/m <sup>3</sup> 1.84	t/m <sup>3</sup> 1.89	t/m <sup>3</sup> 1.94			
Field Moisture Content	% 24.6	% 23.0	% 22.2			
Material:	Imported Clay	Imported Clay	Imported Clay			

Oversize Material	WET, %	2.9	3.4	4.6		
Sieve Size	mm	19	19	19		
Peak Converted Wet Density	t/m <sup>3</sup>	1.88	1.94	1.98		
Optimum Moisture Content	%	23	24	23		



  

<b>Moisture Ratio</b>	%	107	96	96.5		
<b>Moisture Variation</b>	%	1.5	-0.5	-0.5		
<b>from OMC</b>		Wetter	Drier	Drier		
<b>Density Ratio</b>	%	97.0	96.5	97.5		

<b>Specification:</b>	95% STD	<b>Test Selection:</b>	N/A
<b>Notes:</b>	Ref : 1120 0343-1 (SI24)		
<b>Test Method</b>	AS1289 5.8.1, 5.7.1, 2.1.1, 1.1	<b>Sampling Method:</b>	AS 1289 1.2.1 6.4(b)


  

 <b>NATA</b> WORLD RECOGNISED ACCREDITATION	NATA Accredited Laboratory No. 20172	Approved Signatory:    David Burns  Date: 29/07/2022
	Accreditation for compliance with ISO/IEC 17025 - Testing	
	The results of tests, calibrations and/or measurements included in this document, are traceable to Australian / National Standards	





Test Location

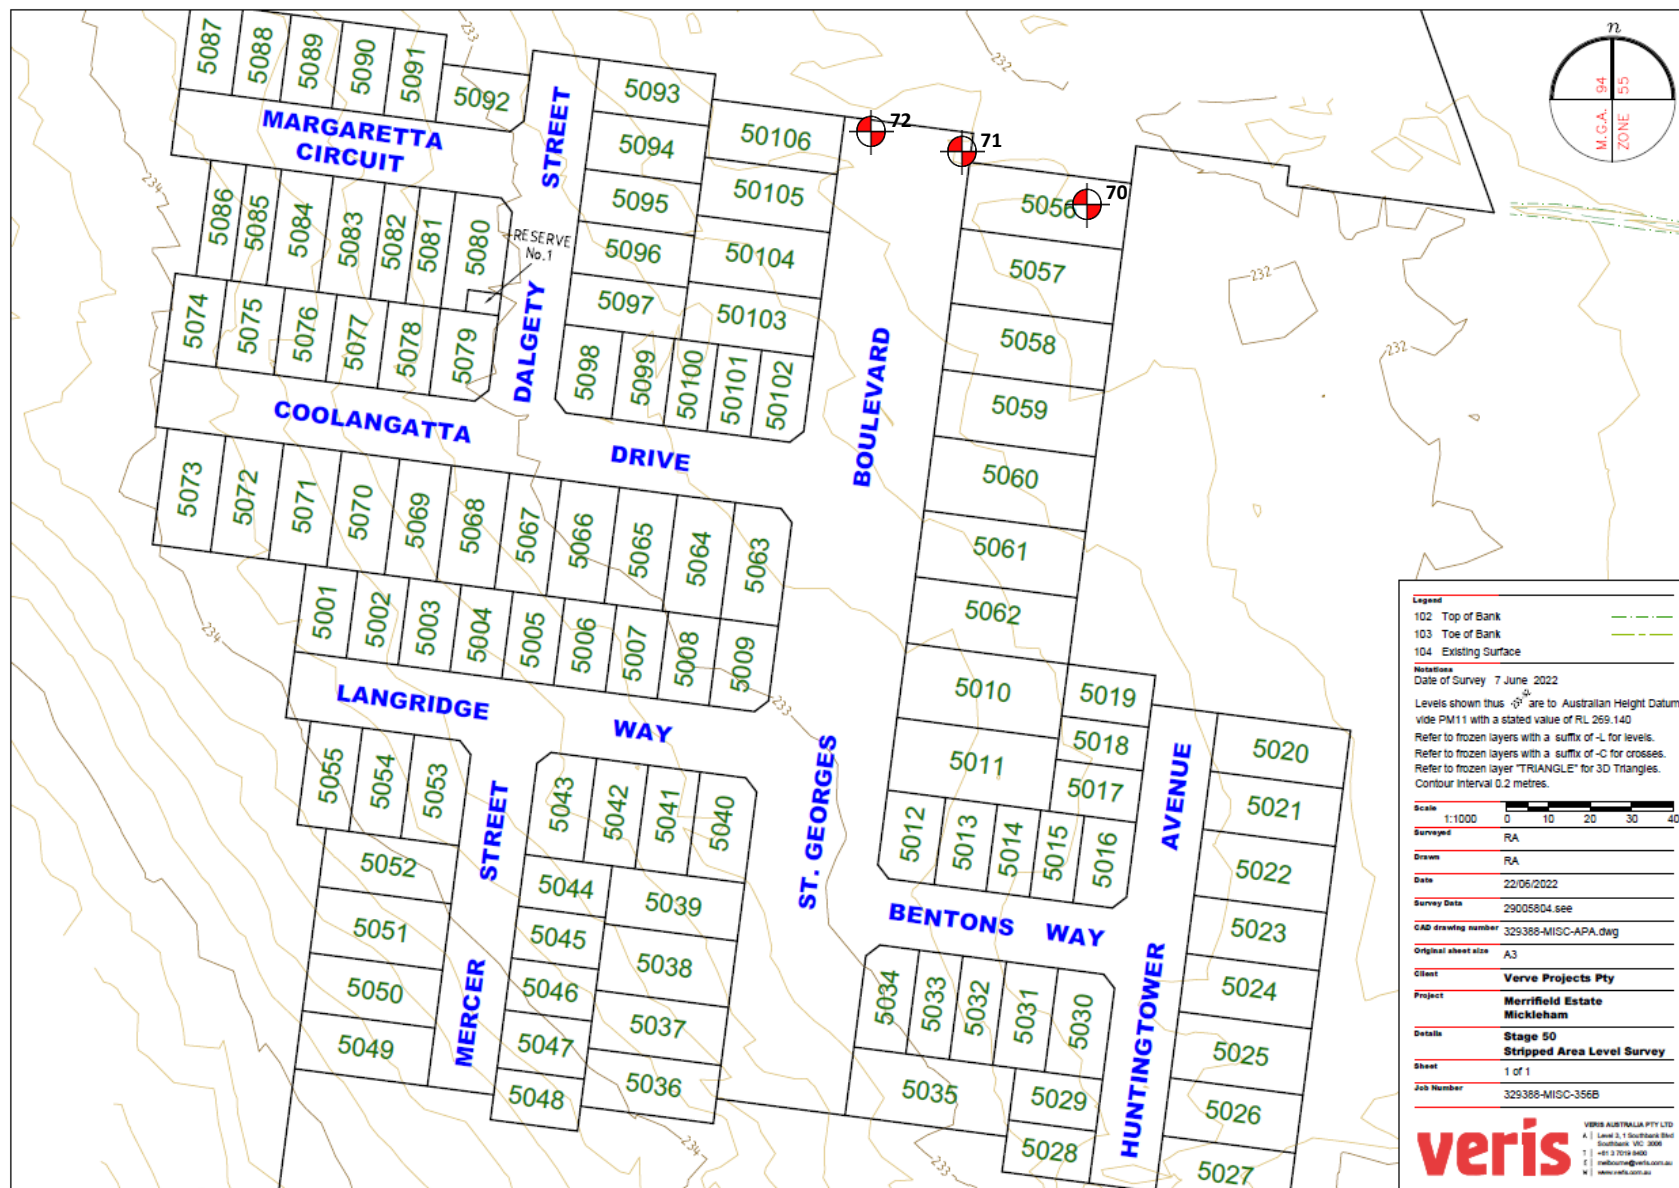

PROJECT:

Merrifield Estate – Stage 50 (Level 1)

CLIENT:

BMD Urban

DATE:

04/07/2022

LOCATION:

Mickleham

PROJECT No:

1120 0343-1 (SI24)

SITE PLAN SKETCH—NOT TO SCALE



**A&Y ASSOCIATES**  
GEOTECHNICAL ENGINEERING CONSULTANTS



## Field Density Test Results AS1289.5.7.1

A & Y Associates Pty Ltd  
5/16 Network Drive  
Truganina VIC 3029  
PH: 0400 413 531  
info@ayassociates.com.au

<b>Client:</b>	BMD Urban			<b>Job No:</b>	BMD2324	
<b>Project:</b>	Merrifield Estate - Stage 50 (Level 1)			<b>Report:</b>	25	
<b>Location:</b>	Mickleham					

Sample No	73	74	75			
Date Tested	06/09/2022	06/09/2022	06/09/2022			
Time Tested	AM	AM	AM			

Test Location	Refer to Plan	Refer to Plan	Refer to Plan			
Level/Layer	1	1	1			
Layer Thickness	mm 200	mm 200	mm 200			
Test Depth	mm 175	mm 175	mm 175			
Field Wet Density	t/m <sup>3</sup> 1.85	t/m <sup>3</sup> 1.81	t/m <sup>3</sup> 1.82			
Field Moisture Content	% 24.3	% 25.3	% 25.0			
Material:	Imported Clay Fill	Imported Clay Fill	Imported Clay Fill			

Oversize Material	WET, % 0.0	WET, % 0.0	WET, % 0.0			
Sieve Size	mm 19	mm 19	mm 19			
Peak Converted Wet Density	t/m <sup>3</sup> 1.88	t/m <sup>3</sup> 1.89	t/m <sup>3</sup> 1.89			
Optimum Moisture Content	% 25	% 23.5	% 23			



  



<b>Moisture Ratio</b>	% 97	% 107.5	% 108.5			
<b>Moisture Variation</b>	% -0.5	% 2.0	% 2.0			
<b>from OMC</b>	Drier	Wetter	Wetter			
<b>Density Ratio</b>	% 98.0	% 95.5	% 96.0			


  

<b>Specification:</b>	95% STD	<b>Test Selection:</b>	N/A
<b>Notes:</b>	Ref : 1120 0343-1 (SI25)		
<b>Test Method</b>	AS1289 5.8.1, 5.7.1, 2.1.1, 1.1	<b>Sampling Method:</b>	AS 1289 1.2.1 6.4(b)

 <b>NATA</b> WORLD RECOGNISED ACCREDITATION	NATA Accredited Laboratory No. 20172	Approved Signatory:    David Burns  Date: 13/10/2022
	Accreditation for compliance with ISO/IEC 17025 - Testing	
	The results of tests, calibrations and/or measurements included in this document, are traceable to Australian / National Standards	

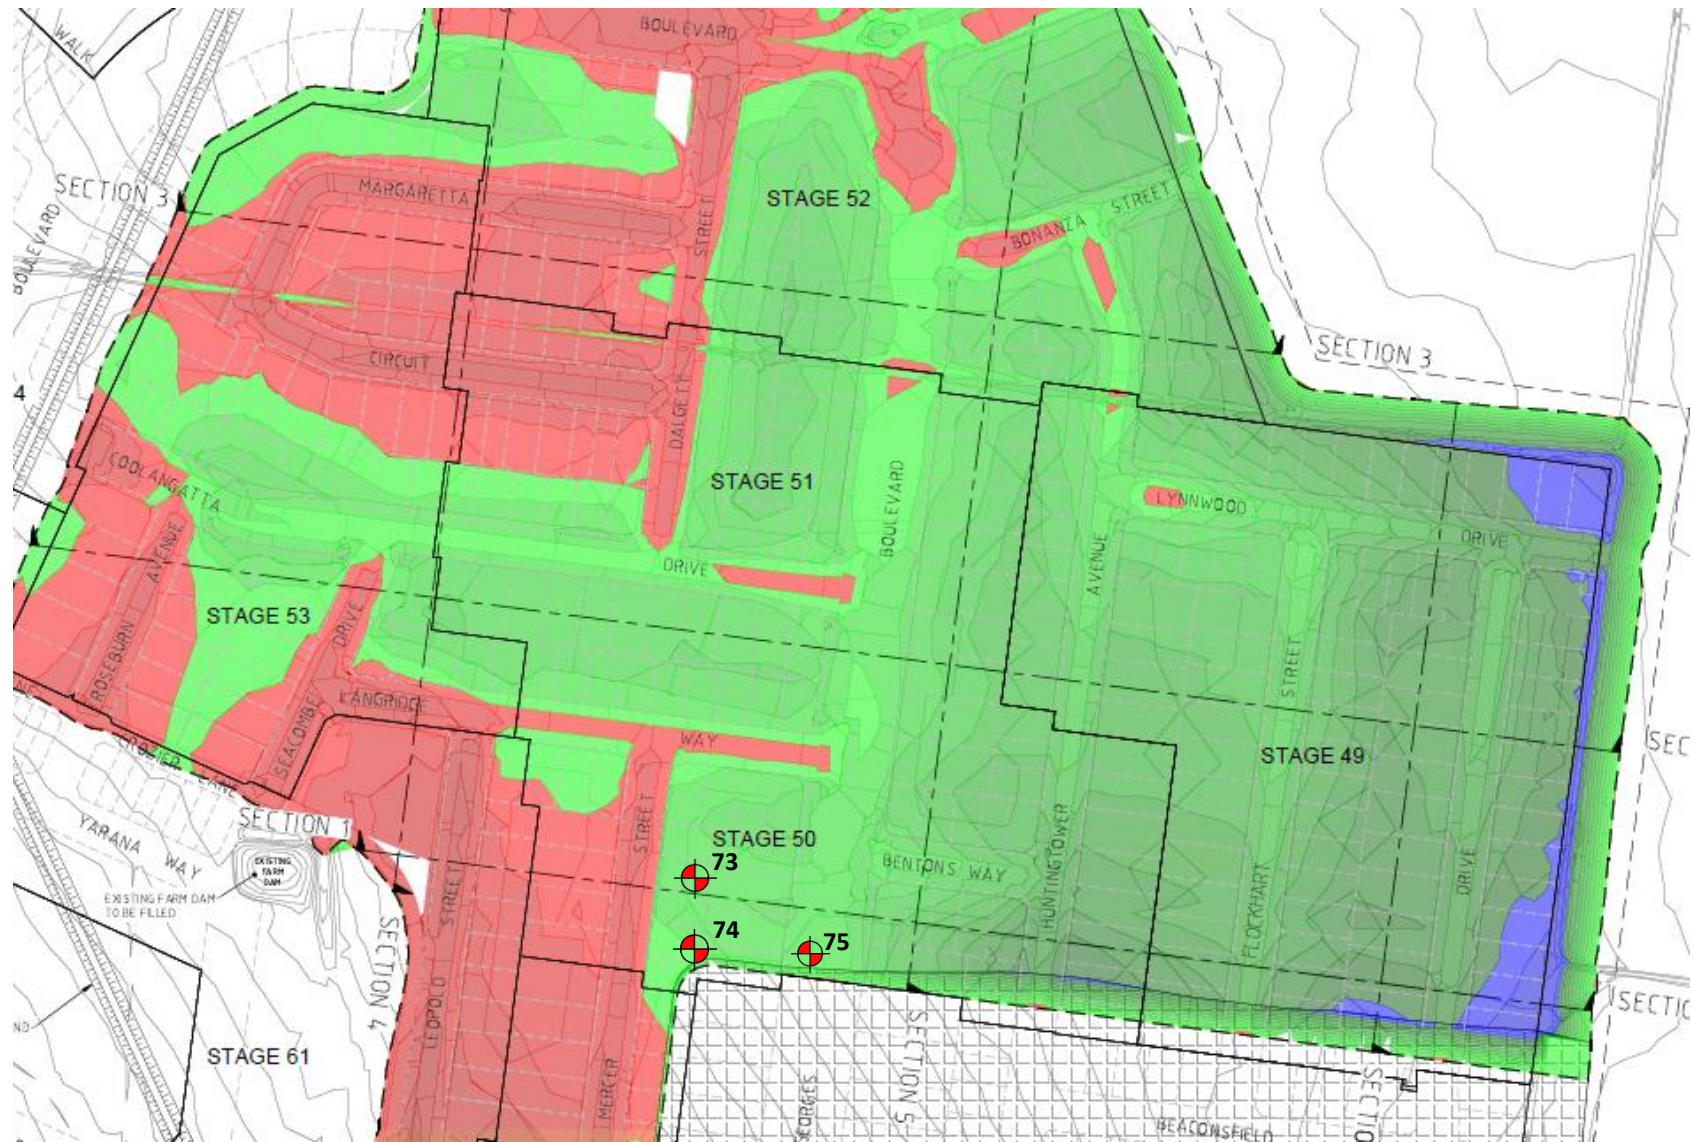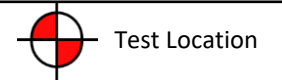

<b>PROJECT</b> Merrifield Estate - Stage 50 (Level 1)	<b>CLIENT:</b> BMD Urban	<b>DATE:</b> 06/09/2022	 <b>A&amp;Y ASSOCIATES</b> GEOTECHNICAL ENGINEERING CONSULTANTS
<b>LOCATION:</b> Mickleham	<b>Project No:</b> 1120 0343-1 (SI25)	<b>SITE PLAN SKETCH—NOT TO SCALE</b>	

## Field Density Test Results AS1289.5.7.1

A & Y Associates Pty Ltd  
5/16 Network Drive  
Truganina VIC 3029  
PH: 0400 413 531  
info@ayassociates.com.au

<b>Client:</b>	BMD Urban			<b>Job No:</b>	BMD2324	
<b>Project:</b>	Merrifield Estate - Stage 50 (Level 1)			<b>Report:</b>	26	
<b>Location:</b>	Mickleham					

Sample No	76	77	78			
Date Tested	07/09/2022	07/09/2022	07/09/2022			
Time Tested	AM	AM	AM			

Test Location	Refer to Plan	Refer to Plan	Refer to Plan			
Level/Layer	1	1	1			
Layer Thickness	mm 200	mm 200	mm 200			
Test Depth	mm 175	mm 175	mm 175			
Field Wet Density	t/m <sup>3</sup> 1.81	t/m <sup>3</sup> 1.82	t/m <sup>3</sup> 1.86			
Field Moisture Content	% 25.8	% 25.3	% 24.5			
Material:	Imported Clay Fill	Imported Clay Fill	Imported Clay Fill			

Oversize Material	WET, % 0.0	WET, % 0.0	WET, % 0.0			
Sieve Size	mm 19	mm 19	mm 19			
Peak Converted Wet Density	t/m <sup>3</sup> 1.88	t/m <sup>3</sup> 1.85	t/m <sup>3</sup> 1.86			
Optimum Moisture Content	% 26.5	% 26	% 22.5			

<b>Moisture Ratio</b>	% 97.5	% 97.5	% 109			
<b>Moisture Variation</b>	% -0.5	% -0.5	% 2.0			
<b>from OMC</b>	Drier	Drier	Wetter			
<b>Density Ratio</b>	% 96.5	% 98.5	% 100.0			

<b>Specification:</b>	95% STD	<b>Test Selection:</b>	N/A
<b>Notes:</b>	Ref : 1120 0343-1 (SI26)		
<b>Test Method</b>	AS1289 5.8.1, 5.7.1, 2.1.1, 1.1	<b>Sampling Method:</b>	AS 1289 1.2.1 6.4(b)



NATA Accredited Laboratory No. 20172  
Accreditation for compliance with ISO/IEC 17025 - Testing  
The results of tests, calibrations and/or measurements included  
in this document, are traceable to Australian / National Standards

Approved Signatory:




David Burns


Date: 13/10/2022





Test Location

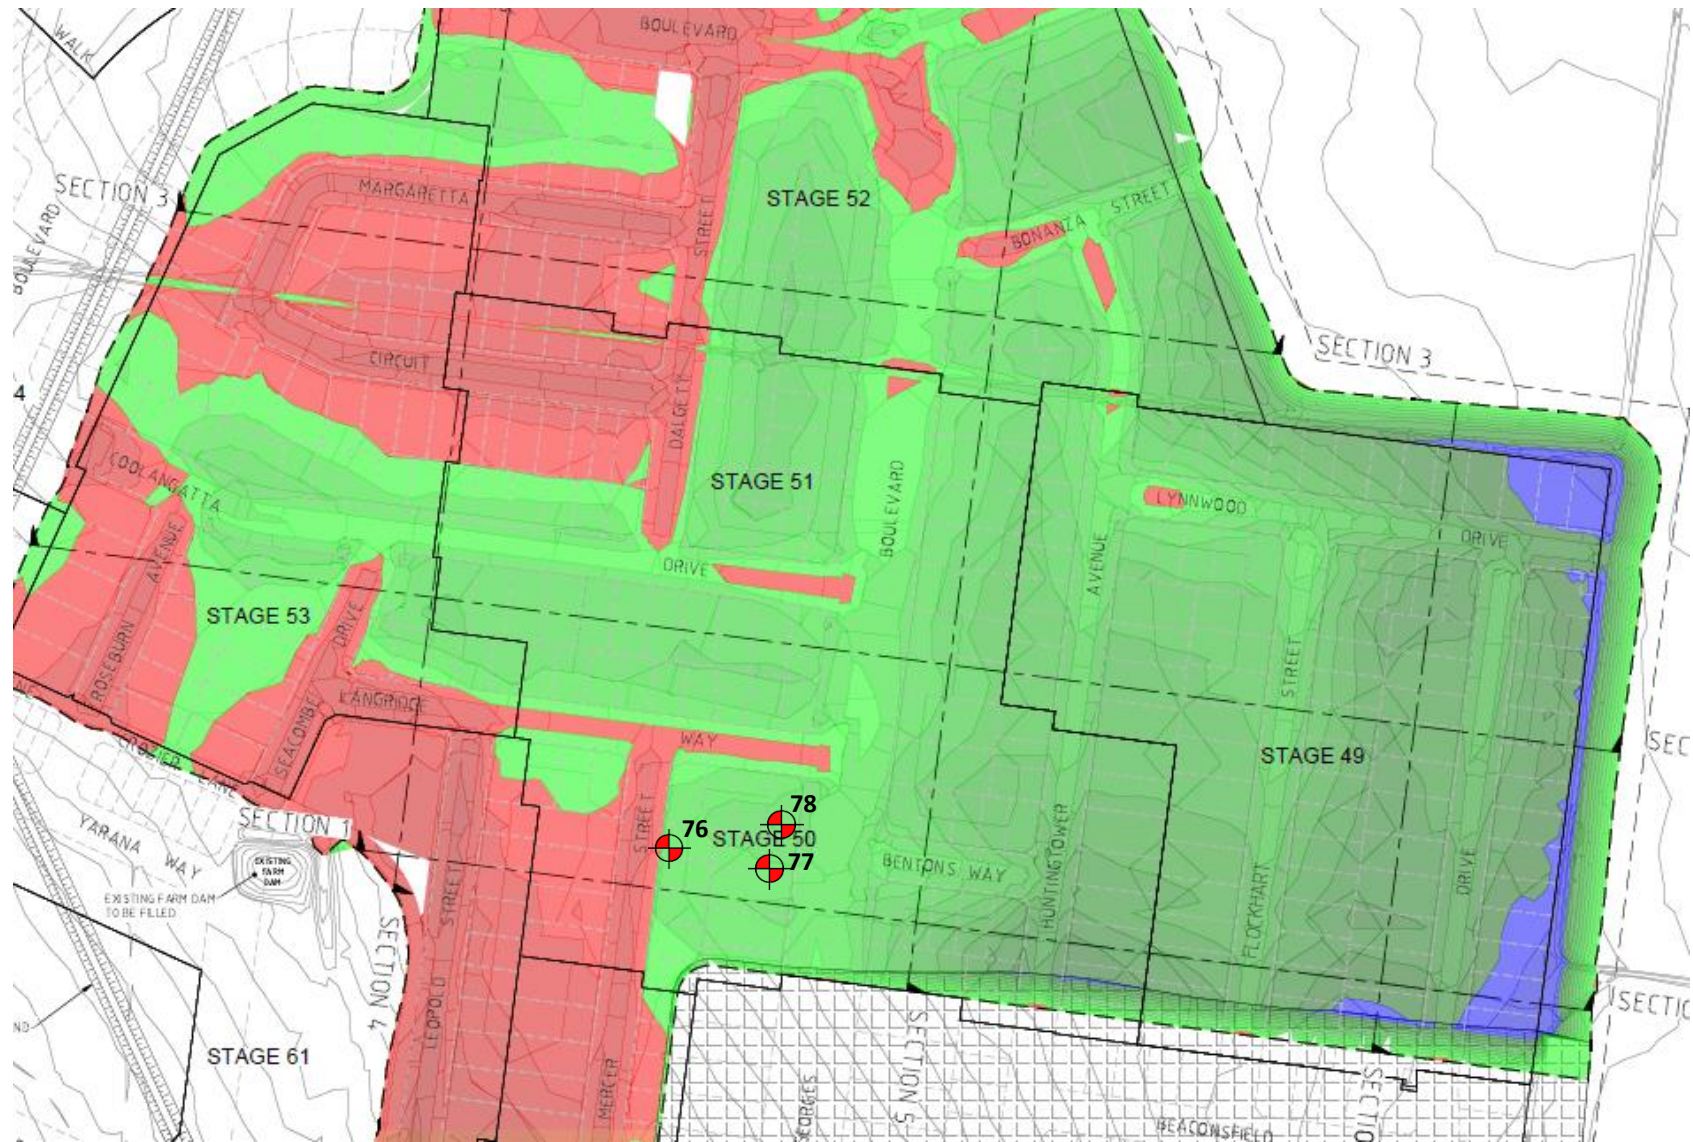

PROJECT Merrifield Estate - Stage 50 (Level 1)	CLIENT: BMD Urban	DATE: 07/09/2022	 <b>A&amp;Y ASSOCIATES</b> GEOTECHNICAL ENGINEERING CONSULTANTS
LOCATION: Mickleham	Project No: 1120 0343-1 (SI26)	SITE PLAN SKETCH—NOT TO SCALE	

## Field Density Test Results AS1289.5.7.1

A & Y Associates Pty Ltd  
5/16 Network Drive  
Truganina VIC 3029  
PH: 0400 413 531  
info@ayassociates.com.au

<b>Client:</b>	BMD Urban			<b>Job No:</b>	BMD2324	
<b>Project:</b>	Merrifield Estate - Stage 50 (Level 1)			<b>Report:</b>	27	
<b>Location:</b>	Mickleham					

Sample No	79	80	81			
Date Tested	05/10/2022	05/10/2022	05/10/2022			
Time Tested	AM	AM	AM			

Test Location	Refer to Plan	Refer to Plan	Refer to Plan			
Level/Layer	1	1	1			
Layer Thickness	mm 200	mm 200	mm 200			
Test Depth	mm 175	mm 175	mm 175			
Field Wet Density	t/m <sup>3</sup> 1.82	t/m <sup>3</sup> 1.84	t/m <sup>3</sup> 1.87			
Field Moisture Content	% 25.1	% 24.3	% 24.0			
Material:	Imported Clay	Imported Clay	Imported Clay			

Oversize Material	WET, %	0.0	0.0	0.0		
Sieve Size	mm	19	19	19		
Peak Converted Wet Density	t/m <sup>3</sup>	1.85	1.87	1.90		
Optimum Moisture Content	%	23.5	24.5	25		



  

<b>Moisture Ratio</b>	%	107	99	96		
<b>Moisture Variation</b>	%	1.5	-0.5	-1.0		
<b>from OMC</b>		Wetter	Drier	Drier		
<b>Density Ratio</b>	%	98.5	98.5	98.5		

<b>Specification:</b>	95% STD	<b>Test Selection:</b>	N/A
<b>Notes:</b>	Ref : 1120 0343-1 (SI27)		
<b>Test Method</b>	AS1289 5.8.1, 5.7.1, 2.1.1, 1.1	<b>Sampling Method:</b>	AS 1289 1.2.1 6.4(b)


 <b>NATA</b> WORLD RECOGNISED ACCREDITATION	NATA Accredited Laboratory No. 20172	Approved Signatory:    David Burns  Date: 13/10/2022
	Accreditation for compliance with ISO/IEC 17025 - Testing	
	The results of tests, calibrations and/or measurements included in this document, are traceable to Australian / National Standards	





Test Location



<b>PROJECT</b> Merrifield Estate – Stage 50 (Level 1)	<b>CLIENT:</b> BMD Urban	<b>DATE:</b> 05/10/2022	 <b>A&amp;Y ASSOCIATES</b> GEOTECHNICAL ENGINEERING CONSULTANTS
<b>LOCATION:</b> Mickleham	<b>Project No:</b> 1120 0343–1 (SI27)	<b>SITE PLAN SKETCH—NOT TO SCALE</b>	



## Field Density Test Results AS1289.5.7.1

A & Y Associates Pty Ltd  
5/16 Network Drive  
Truganina VIC 3029  
PH: 0400 413 531  
info@ayassociates.com.au

<b>Client:</b>	BMD Urban			<b>Job No:</b>	BMD2324	
<b>Project:</b>	Merrifield Estate - Stage 50 (Level 1)			<b>Report:</b>	28	
<b>Location:</b>	Mickleham					

Sample No	82	83	84			
Date Tested	11/01/2023	11/01/2023	11/01/2023			
Time Tested	PM	PM	PM			

Test Location	Refer to Plan	Refer to Plan	Refer to Plan			
Level/Layer	5	5	5			
Layer Thickness	mm 200	mm 200	mm 200			
Test Depth	mm 175	mm 175	mm 175			
Field Wet Density	t/m <sup>3</sup> 1.91	t/m <sup>3</sup> 1.83	t/m <sup>3</sup> 1.86			
Field Moisture Content	% 20.3	% 24.6	% 23.1			
Material:	Imported Clay Fill	Imported Clay Fill	Imported Clay Fill			

Oversize Material	WET, % 3.0	WET, % 0.0	WET, % 0.0			
Sieve Size	mm 19	mm 19	mm 19			
Peak Converted Wet Density	t/m <sup>3</sup> 1.96	t/m <sup>3</sup> 1.88	t/m <sup>3</sup> 1.90			
Optimum Moisture Content	% 18.5	% 23	% 24			



  

<b>Moisture Ratio</b>	% 110	% 107	% 96.5			
<b>Moisture Variation</b>	% 2.0	% 1.5	% -0.5			
<b>from OMC</b>	Wetter	Wetter	Drier			
<b>Density Ratio</b>	% 97.0	% 97.0	% 98.0			


<b>Specification:</b>	95% STD	<b>Test Selection:</b>	N/A
<b>Notes:</b>	Ref : 1120 0343-1 (SI28)		
<b>Test Method</b>	AS1289 5.8.1, 5.7.1, 2.1.1, 1.1	<b>Sampling Method:</b>	AS 1289 1.2.1 6.4(b)

 <b>NATA</b> WORLD RECOGNISED ACCREDITATION	NATA Accredited Laboratory No. 20172 Accreditation for compliance with ISO/IEC 17025 - Testing	Approved Signatory:  Date: 03/02/2023



Test Location

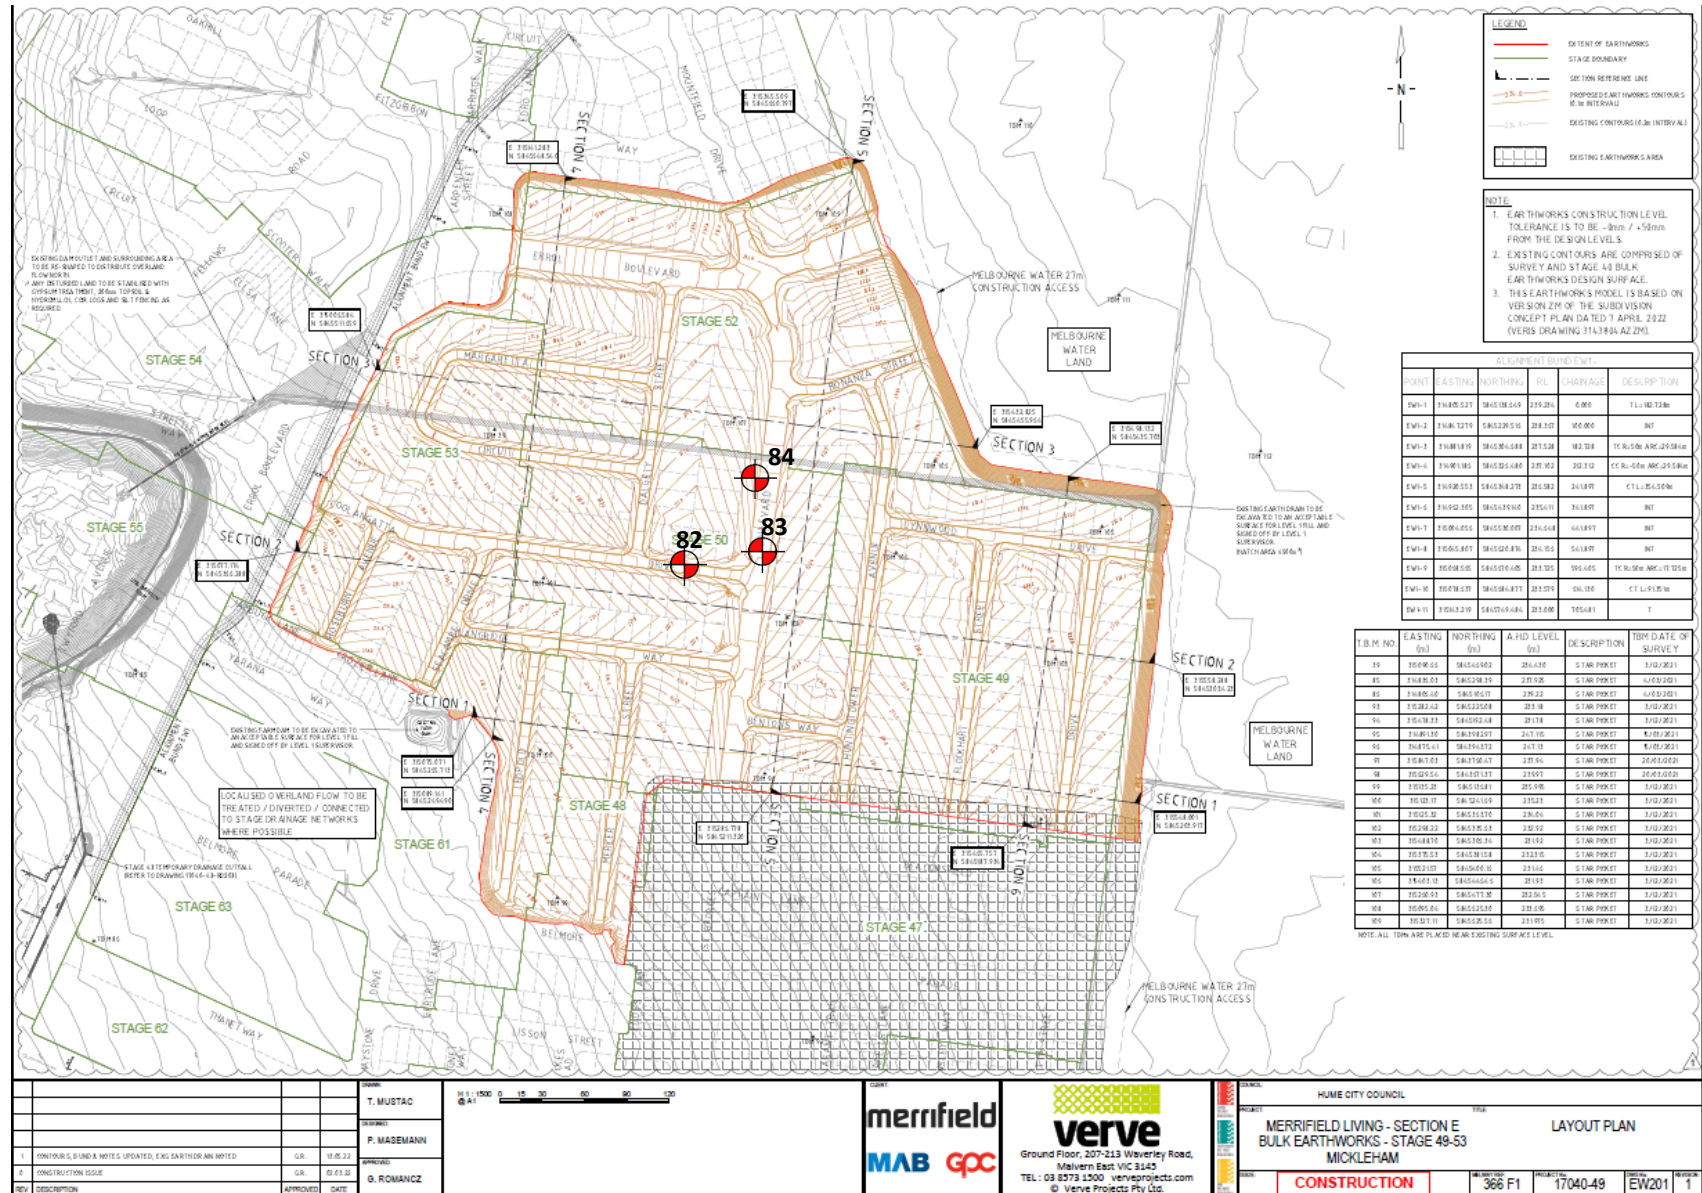

PROJECT Merrifield Estate – Stage 50 (Level 1)	CLIENT: BMD Urban	DATE: 11/01/2023
	Project No: 1120 0343–1 (SI28)	SITE PLAN SKETCH—NOT TO SCALE
LOCATION: Mickleham		

## Field Density Test Results AS1289.5.7.1

A & Y Associates Pty Ltd  
5/16 Network Drive  
Truganina VIC 3029  
PH: 0400 413 531  
info@ayassociates.com.au

<b>Client:</b>	BMD Urban			<b>Job No:</b>	BMD2324	
<b>Project:</b>	Merrifield Estate - Stage 50 (Level 1)			<b>Report:</b>	29	
<b>Location:</b>	Mickleham					

Sample No	85	86	87			
Date Tested	12/01/2023	12/01/2023	12/01/2023			
Time Tested	AM	AM	AM			

Test Location	Refer to Plan	Refer to Plan	Refer to Plan			
Level/Layer	4	4	4			
Layer Thickness	mm 200	mm 200	mm 200			
Test Depth	mm 175	mm 175	mm 175			
Field Wet Density	t/m <sup>3</sup> 1.92	t/m <sup>3</sup> 1.84	t/m <sup>3</sup> 1.87			
Field Moisture Content	% 19.3	% 24.0	% 23.4			
Material:	Imported Clay Fill	Imported Clay Fill	Imported Clay Fill			

Oversize Material	WET, % 4.6	WET, % 2.0	WET, % 3.8			
Sieve Size	mm 19	mm 19	mm 19			
Peak Converted Wet Density	t/m <sup>3</sup> 1.97	t/m <sup>3</sup> 1.89	t/m <sup>3</sup> 1.95			
Optimum Moisture Content	% 17.5	% 24.5	% 22			



  

<b>Moisture Ratio</b>	% 110.5	% 98	% 106.5			
<b>Moisture Variation</b>	% 2.0	% -0.5	% 1.5			
<b>from OMC</b>	Wetter	Drier	Wetter			
<b>Density Ratio</b>	% 97.0	% 97.0	% 95.5			

<b>Specification:</b>	95% STD	<b>Test Selection:</b>	N/A
<b>Notes:</b>	Ref : 1120 0343-1 (SI29)		
<b>Test Method</b>	AS1289 5.8.1, 5.7.1, 2.1.1, 1.1	<b>Sampling Method:</b>	AS 1289 1.2.1 6.4(b)


  


 <b>NATA</b> WORLD RECOGNISED ACCREDITATION	NATA Accredited Laboratory No. 20172 Accreditation for compliance with ISO/IEC 17025 - Testing	Approved Signatory:  Date: 03/02/2023





Test Location

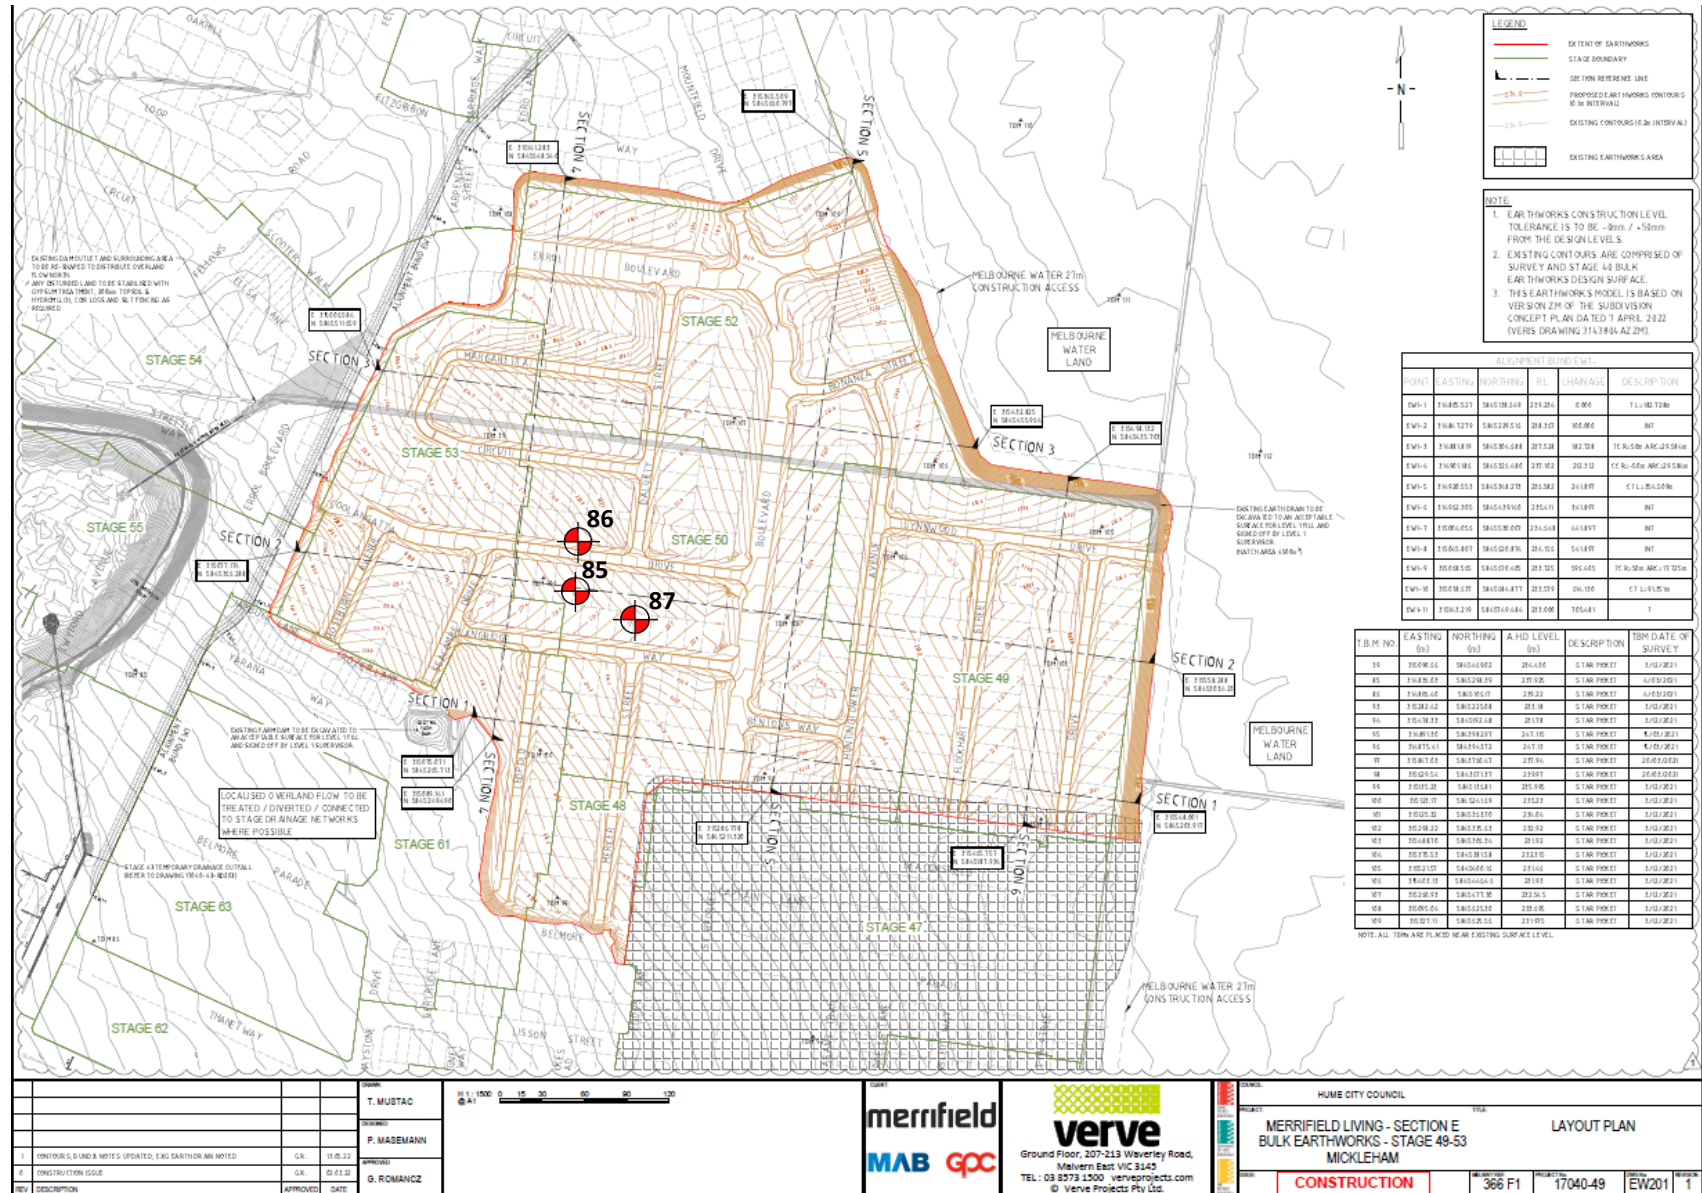

PROJECT Merrifield Estate – Stage 50 (Level 1)	CLIENT: BMD Urban	DATE: 12/01/2023	 <div>A&amp;Y ASSOCIATES GEOTECHNICAL ENGINEERING CONSULTANTS</div>
LOCATION: Mickleham	Project No: 1120 0343–1 (SI29)	SITE PLAN SKETCH—NOT TO SCALE	

## Field Density Test Results AS1289.5.7.1

A & Y Associates Pty Ltd  
5/16 Network Drive  
Truganina VIC 3029  
PH: 0400 413 531  
info@ayassociates.com.au

<b>Client:</b>	BMD Urban			<b>Job No:</b>	BMD2324	
<b>Project:</b>	Merrifield Estate - Stage 50 (Level 1)			<b>Report:</b>	30	
<b>Location:</b>	Mickleham					

Sample No	88	89	90			
Date Tested	13/01/2023	13/01/2023	13/01/2023			
Time Tested	AM	AM	AM			

Test Location	Refer to Plan	Refer to Plan	Refer to Plan			
Level/Layer	6	6	6			
Layer Thickness	mm 200	mm 200	mm 200			
Test Depth	mm 175	mm 175	mm 175			
Field Wet Density	t/m <sup>3</sup> 1.96	t/m <sup>3</sup> 1.85	t/m <sup>3</sup> 1.91			
Field Moisture Content	% 21.7	% 23.6	% 22.0			
Material:	Imported Clay Fill	Imported Clay Fill	Imported Clay Fill			

Oversize Material	WET, % 5.0	WET, % 2.0	WET, % 3.5			
Sieve Size	mm 19	mm 19	mm 19			
Peak Converted Wet Density	t/m <sup>3</sup> 1.97	t/m <sup>3</sup> 1.89	t/m <sup>3</sup> 1.91			
Optimum Moisture Content	% 22	% 24.5	% 23			



  

<b>Moisture Ratio</b>	% 98.5	% 96.5	% 96			
<b>Moisture Variation</b>	% -0.5	% -0.5	% -0.5			
<b>from OMC</b>	Drier	Drier	Drier			
<b>Density Ratio</b>	% 98.5	% 97.5	% 99.5			


<b>Specification:</b>	95% STD	<b>Test Selection:</b>	N/A
<b>Notes:</b>	Ref : 1120 0343-1 (SI30)		
<b>Test Method</b>	AS1289 5.8.1, 5.7.1, 2.1.1, 1.1	<b>Sampling Method:</b>	AS 1289 1.2.1 6.4(b)

 <b>NATA</b> WORLD RECOGNISED ACCREDITATION	NATA Accredited Laboratory No. 20172 Accreditation for compliance with ISO/IEC 17025 - Testing	Approved Signatory:  Date: 03/02/2023



Test Location

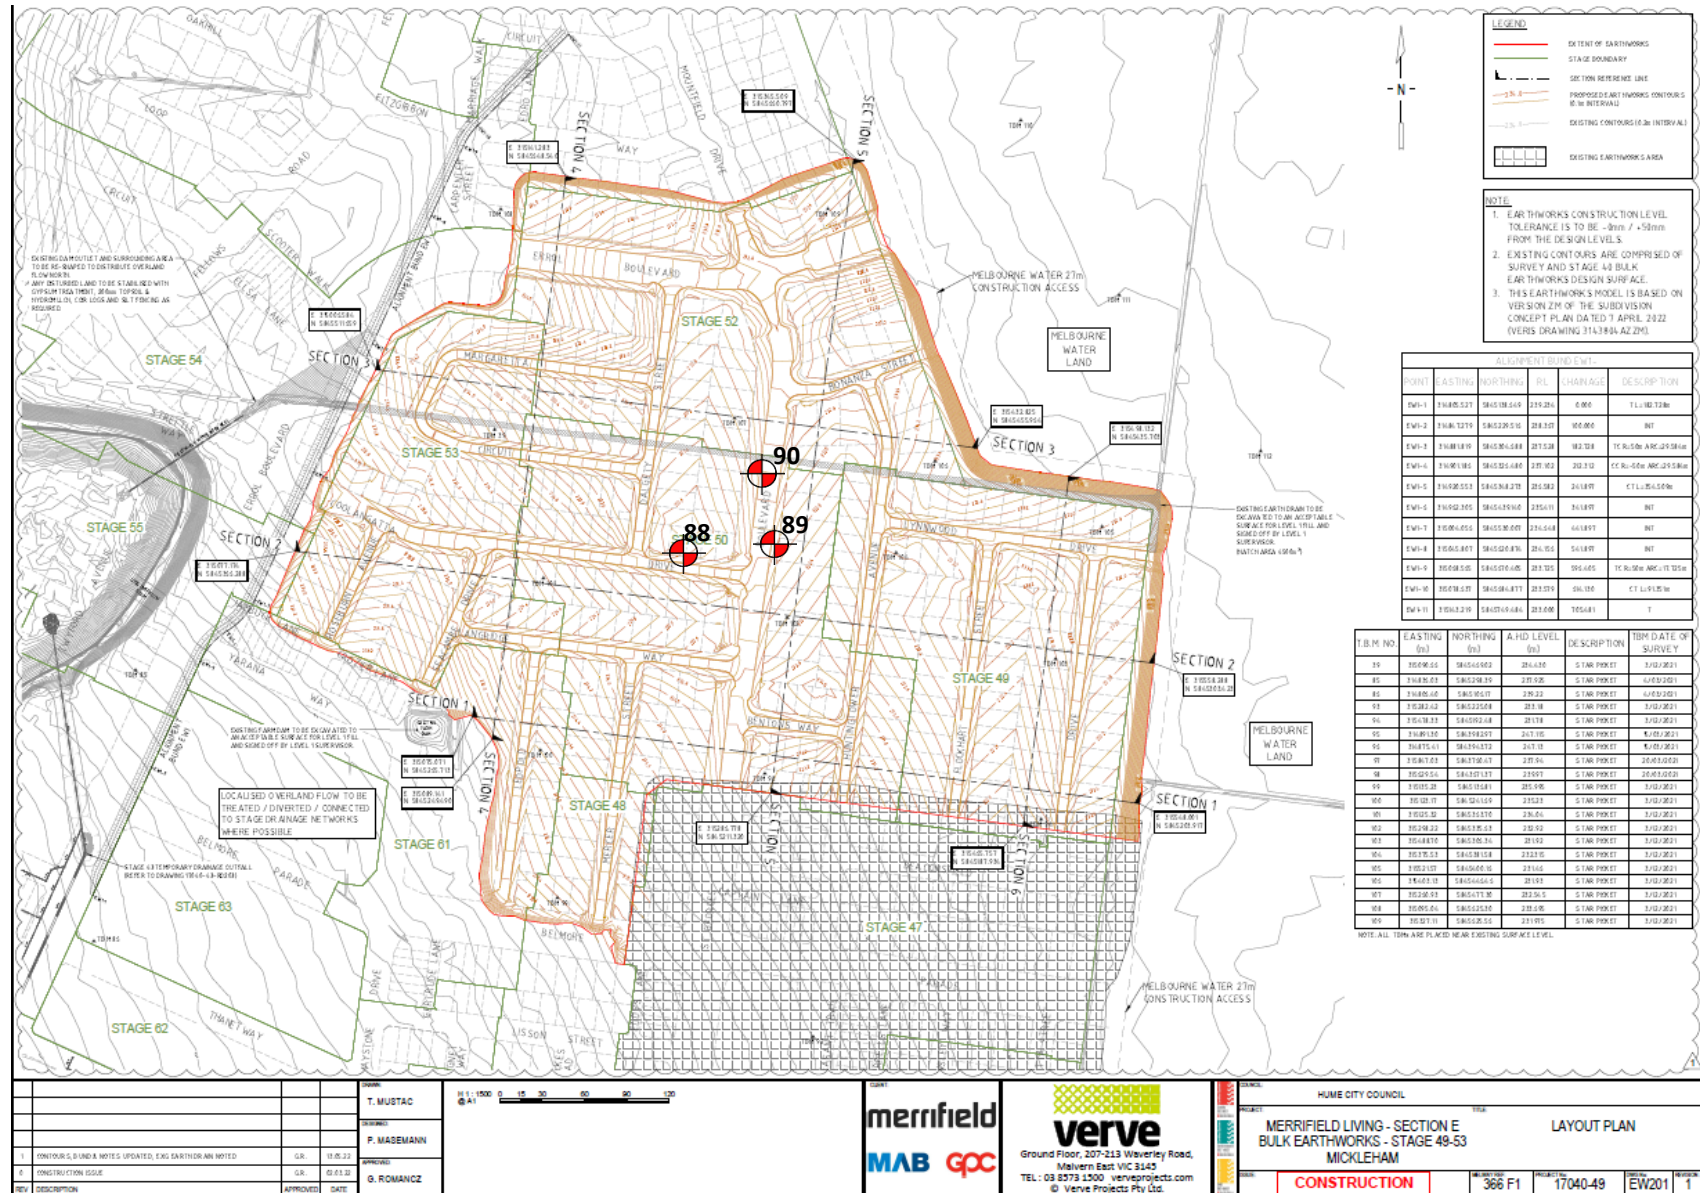

**PROJECT**  
Merrifield Estate – Stage 50 (Level 1)

**LOCATION:**  
Mickleham

**CLIENT:**  
BMD Urban

**Project No:**  
1120 0343–1 (SI30)

**DATE:**  
13/01/2023

**SITE PLAN SKETCH—NOT TO SCALE**





## Field Density Test Results AS1289.5.7.1

A & Y Associates Pty Ltd  
5/16 Network Drive  
Truganina VIC 3029  
PH: 0400 413 531  
info@ayassociates.com.au

<b>Client:</b>	BMD Urban			<b>Job No:</b>	BMD2324	
<b>Project:</b>	Merrifield Estate - Stage 50 (Level 1)			<b>Report:</b>	31	
<b>Location:</b>	Mickleham					
Sample No	91	92	93			
Date Tested	31/01/2023	31/01/2023	31/01/2023			
Time Tested	AM	AM	AM			
Test Location	Refer to Plan	Refer to Plan	Refer to Plan			
Level/Layer	5	7	7			
Layer Thickness	mm 200	200	200			
Test Depth	mm 175	175	175			
Field Wet Density	t/m <sup>3</sup> 1.95	2.00	1.90			
Field Moisture Content	% 20.8	19.5	19.7			
Material:	Imported Clay	Imported Clay	Imported Clay			
Oversize Material	WET, % 4.2	6.1	3.1			
Sieve Size	mm 19	19	19			
Peak Converted Wet Density	t/m <sup>3</sup> 1.98	2.07	1.95			
Optimum Moisture Content	% 21.5	20.5	18			
<b>Moisture Ratio</b>	% 96.5	95	109			
<b>Moisture Variation</b>	% -0.5	-0.5	1.5			
<b>from OMC</b>	Drier	Drier	Wetter			
<b>Density Ratio</b>	% 97.5	96.0	97.5			

<b>Specification:</b>	95% STD	<b>Test Selection:</b>	N/A
<b>Notes:</b>	Ref : 1120 0343-1 (SI31)		
<b>Test Method</b>	AS1289 5.8.1, 5.7.1, 2.1.1, 1.1	<b>Sampling Method:</b>	AS 1289 1.2.1 6.4(b)



NATA Accredited Laboratory No. 20172  
Accreditation for compliance with ISO/IEC 17025 - Testing


Approved Signatory:



David Burns  
20/02/2023

Date:



PROJECT Merrifield Estate – Stage 50 (Level 1)	CLIENT: BMD Urban	DATE: 31/01/2023	 <b>A&amp;Y ASSOCIATES</b> GEOTECHNICAL ENGINEERING CONSULTANTS
LOCATION: Mickleham	Project No: 1120 0343–1 (SI31)	SITE PLAN SKETCH—NOT TO SCALE	

## Field Density Test Results AS1289.5.7.1

A & Y Associates Pty Ltd  
5/16 Network Drive  
Truganina VIC 3029  
PH: 0400 413 531  
info@ayassociates.com.au

<b>Client:</b>	BMD Urban			<b>Job No:</b>	BMD2324	
<b>Project:</b>	Merrifield Estate - Stage 50 (Level 1)			<b>Report:</b>	32	
<b>Location:</b>	Mickleham					

Sample No	94	95	96			
Date Tested	01/02/2023	01/02/2023	01/02/2023			
Time Tested	PM	PM	PM			

Test Location	Refer to Plan	Refer to Plan	Refer to Plan			
Level/Layer	7	7	7			
Layer Thickness	mm 200	mm 200	mm 200			
Test Depth	mm 175	mm 175	mm 175			
Field Wet Density	t/m <sup>3</sup> 1.81	t/m <sup>3</sup> 1.80	t/m <sup>3</sup> 1.84			
Field Moisture Content	% 24.6	% 25.0	% 24.1			
Material:	Imported Clay Fill	Imported Clay Fill	Imported Clay Fill			

Oversize Material	WET, % 0.0	WET, % 0.0	WET, % 0.0			
Sieve Size	mm 19	mm 19	mm 19			
Peak Converted Wet Density	t/m <sup>3</sup> 1.87	t/m <sup>3</sup> 1.88	t/m <sup>3</sup> 1.91			
Optimum Moisture Content	% 22.5	% 23	% 22.5			



  

<b>Moisture Ratio</b>	% 109.5	% 108.5	% 107			
<b>Moisture Variation</b>	% 2.0	% 2.0	% 1.5			
<b>from OMC</b>	Wetter	Wetter	Wetter			
<b>Density Ratio</b>	% 96.5	% 96.0	% 96.0			

<b>Specification:</b>	95% STD	<b>Test Selection:</b>	N/A
<b>Notes:</b>	Ref : 1120 0343-1 (SI32)		
<b>Test Method</b>	AS1289 5.8.1, 5.7.1, 2.1.1, 1.1	<b>Sampling Method:</b>	AS 1289 1.2.1 6.4(b)


  

 <b>NATA</b> WORLD RECOGNISED ACCREDITATION	NATA Accredited Laboratory No. 20172 Accreditation for compliance with ISO/IEC 17025 - Testing	Approved Signatory:  Date: 16/02/2023





Test Location

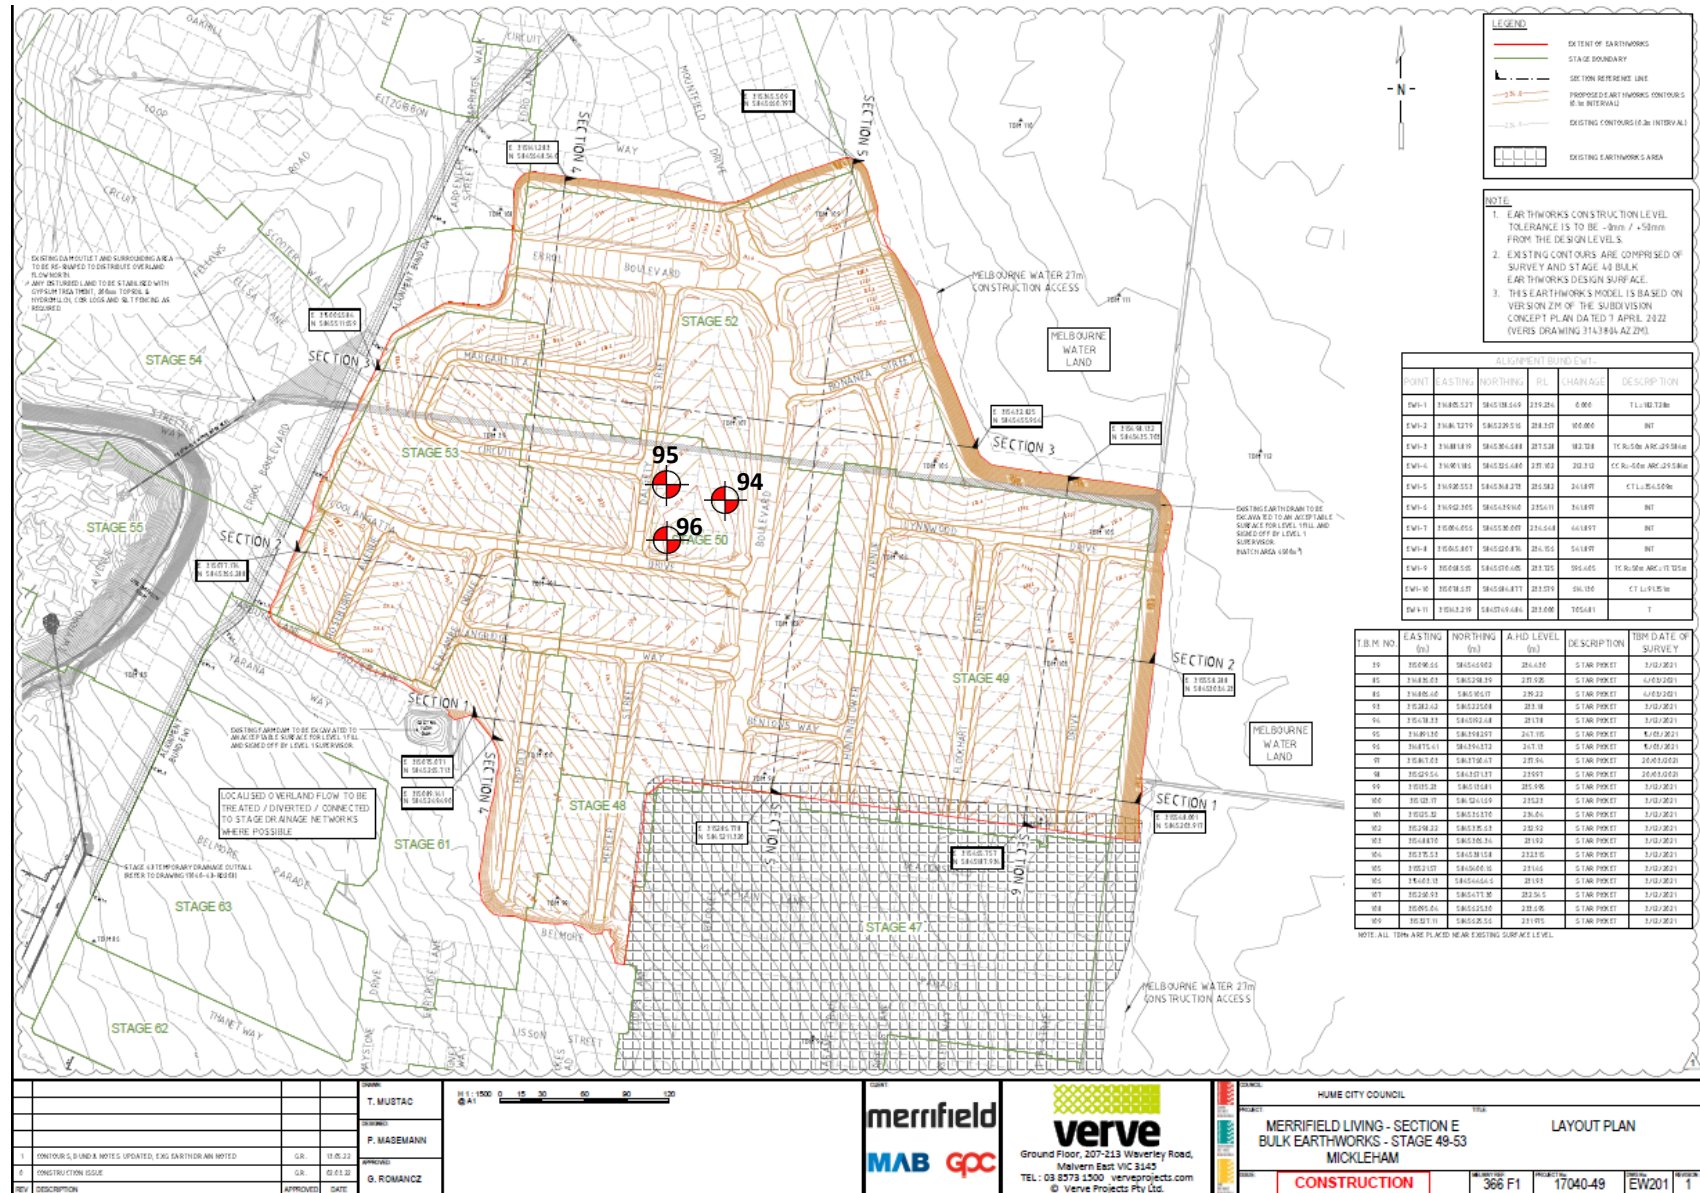

**PROJECT**  
Merrifield Estate – Stage 50 (Level 1)

**LOCATION:**  
Mickleham

**CLIENT:**  
BMD Urban

**Project No:**  
1120 0343–1 (SI32)

**DATE:**  
01/02/2023

**SITE PLAN SKETCH—NOT TO SCALE**



## Field Density Test Results AS1289.5.7.1

A & Y Associates Pty Ltd  
5/16 Network Drive  
Truganina VIC 3029  
PH: 0400 413 531  
info@ayassociates.com.au

<b>Client:</b>	BMD Urban			<b>Job No:</b>	BMD2324	
<b>Project:</b>	Merrifield Estate - Stage 50 (Level 1)			<b>Report:</b>	33	
<b>Location:</b>	Mickleham					

Sample No	97	98	99			
Date Tested	02/02/2023	02/02/2023	02/02/2023			
Time Tested	AM	AM	AM			

Test Location	Refer to Plan	Refer to Plan	Refer to Plan			
Level/Layer	8	8	9			
Layer Thickness	mm 200	mm 200	mm 200			
Test Depth	mm 175	mm 175	mm 175			
Field Wet Density	t/m <sup>3</sup> 1.82	t/m <sup>3</sup> 1.92	t/m <sup>3</sup> 1.96			
Field Moisture Content	% 25.2	% 23.8	% 23.2			
Material:	Imported Clay	Imported Clay	Imported Clay			

Oversize Material	WET, % 0.0	WET, % 3.8	WET, % 4.5			
Sieve Size	mm 19	mm 19	mm 19			
Peak Converted Wet Density	t/m <sup>3</sup> 1.85	t/m <sup>3</sup> 2.00	t/m <sup>3</sup> 2.04			
Optimum Moisture Content	% 23.5	% 24.5	% 24			



  

<b>Moisture Ratio</b>	% 107	% 97	% 96.5			
<b>Moisture Variation</b>	% 1.5	% -0.5	% -0.5			
<b>from OMC</b>	Wetter	Drier	Drier			
<b>Density Ratio</b>	% 98.0	% 95.5	% 96.0			


<b>Specification:</b>	95% STD	<b>Test Selection:</b>	N/A
<b>Notes:</b>	Ref : 1120 0343-1 (SI33)		
<b>Test Method</b>	AS1289 5.8.1, 5.7.1, 2.1.1, 1.1	<b>Sampling Method:</b>	AS 1289 1.2.1 6.4(b)

 <b>NATA</b> WORLD RECOGNISED ACCREDITATION	NATA Accredited Laboratory No. 20172 Accreditation for compliance with ISO/IEC 17025 - Testing	Approved Signatory:  Date: 20/02/2023
		David Burns



Test Location

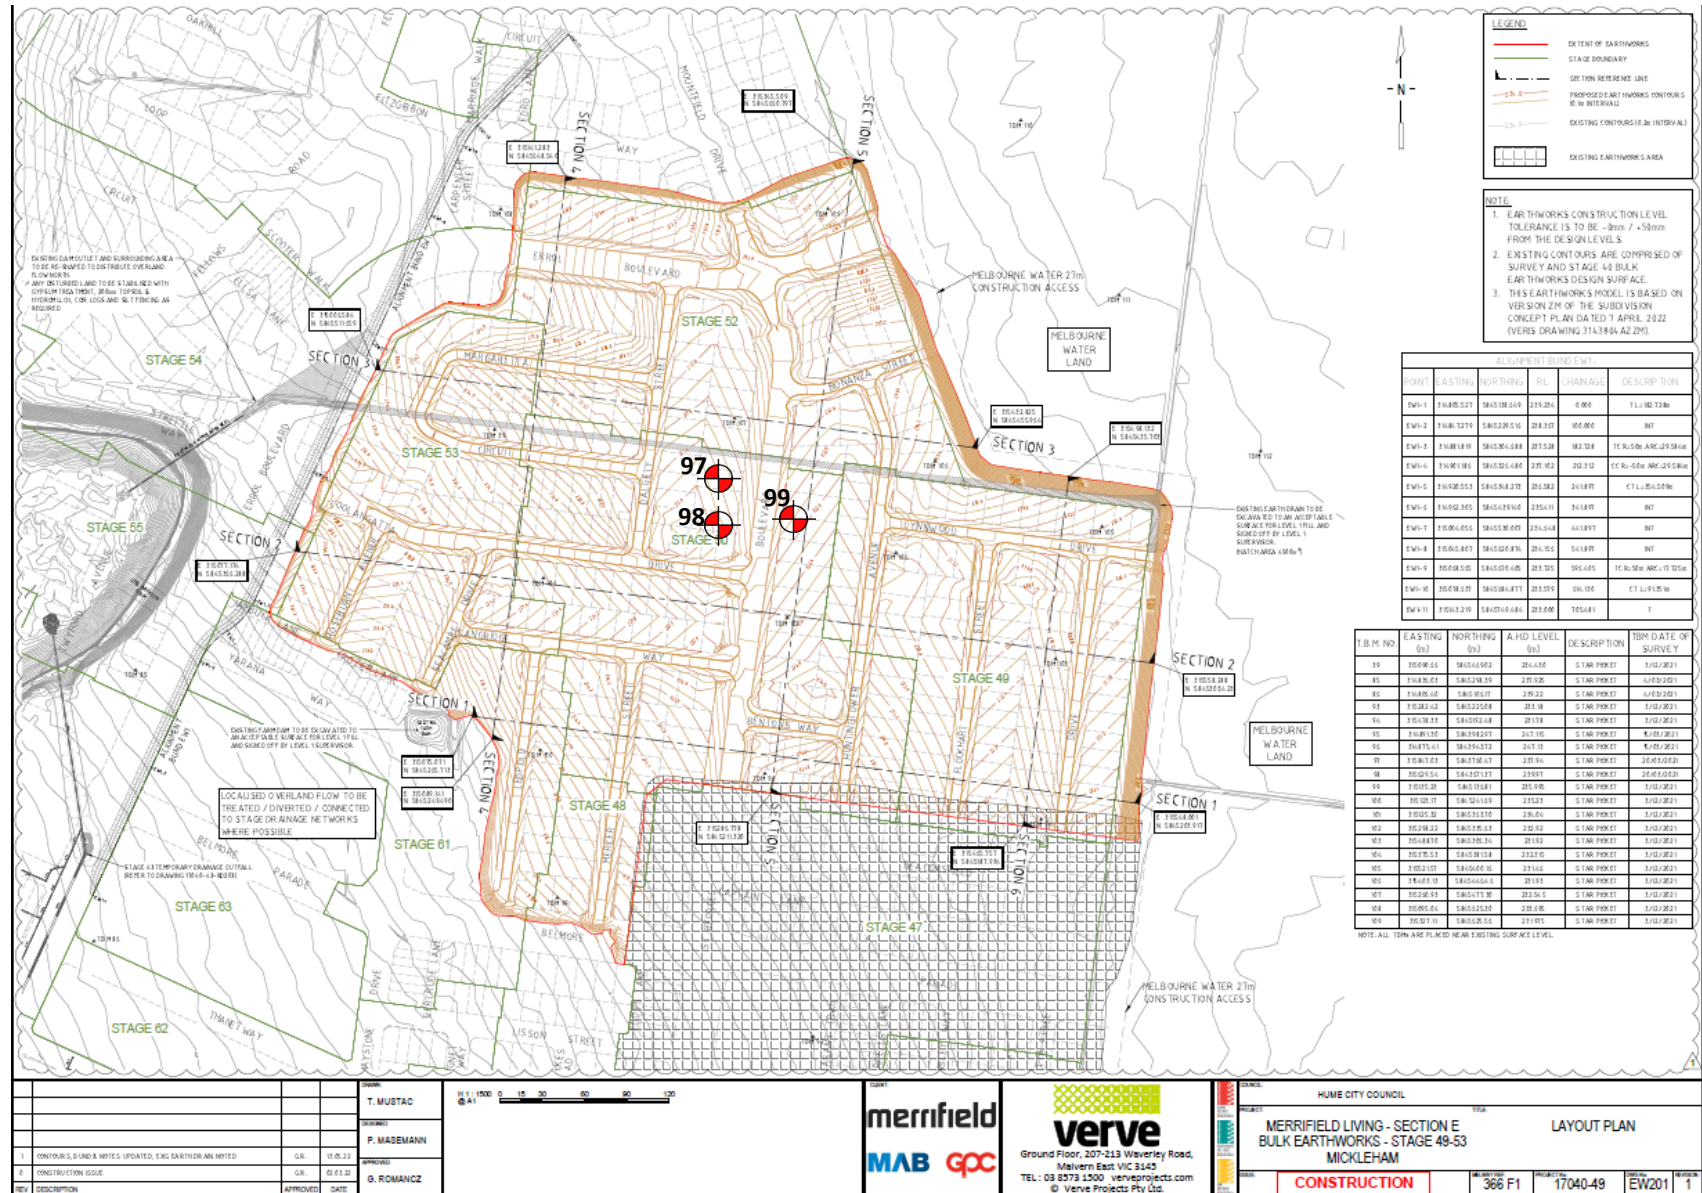

<b>PROJECT</b> Merrifield Estate – Stage 50 (Level 1)	<b>CLIENT:</b> BMD Urban	<b>DATE:</b> 02/02/2023
<b>LOCATION:</b> Mickleham	<b>Project No:</b> 1120 0343–1 (SI33)	<b>SITE PLAN SKETCH—NOT TO SCALE</b>



## Field Density Test Results AS1289.5.7.1

A & Y Associates Pty Ltd  
5/16 Network Drive  
Truganina VIC 3029  
PH: 0400 413 531  
info@ayassociates.com.au

<b>Client:</b>	BMD Urban			<b>Job No:</b>	BMD2324	
<b>Project:</b>	Merrifield Estate - Stage 50 (Level 1)			<b>Report:</b>	34	
<b>Location:</b>	Mickleham					

Sample No	100	101	102			
Date Tested	24/02/2023	24/02/2023	24/02/2023			
Time Tested	PM	PM	PM			

Test Location	Refer to Plan	Refer to Plan	Refer to Plan			
Level/Layer	FSL	FSL	FSL			
Layer Thickness	mm 200	mm 200	mm 200			
Test Depth	mm 175	mm 175	mm 175			
Field Wet Density	t/m <sup>3</sup> 1.92	t/m <sup>3</sup> 1.82	t/m <sup>3</sup> 1.93			
Field Moisture Content	% 23.2	% 24.7	% 22.8			
Material:	Imported Clay	Imported Clay	Imported Clay			

Oversize Material	WET, % 2.9	WET, % 0.0	WET, % 4.1			
Sieve Size	mm 19	mm 19	mm 19			
Peak Converted Wet Density	t/m <sup>3</sup> 1.99	t/m <sup>3</sup> 1.88	t/m <sup>3</sup> 1.97			
Optimum Moisture Content	% 23.5	% 23	% 23.5			

<b>Moisture Ratio</b>	% 98.5	% 107.5	% 97			
<b>Moisture Variation</b>	% -0.5	% 2.0	% -0.5			
<b>from OMC</b>	Drier	Wetter	Drier			
<b>Density Ratio</b>	% 96.0	% 97.0	% 97.5			

<b>Specification:</b>	95% STD	<b>Test Selection:</b>	N/A
<b>Notes:</b>	Ref : 1120 0343-1 (SI34)		
<b>Test Method</b>	AS1289 5.8.1, 5.7.1, 2.1.1, 1.1	<b>Sampling Method:</b>	AS 1289 1.2.1 6.4(b)



NATA Accredited Laboratory No. 20172  
Accreditation for compliance with ISO/IEC 17025 - Testing


Approved Signatory:



David Burns  
Date: 28/02/2023



Test Location

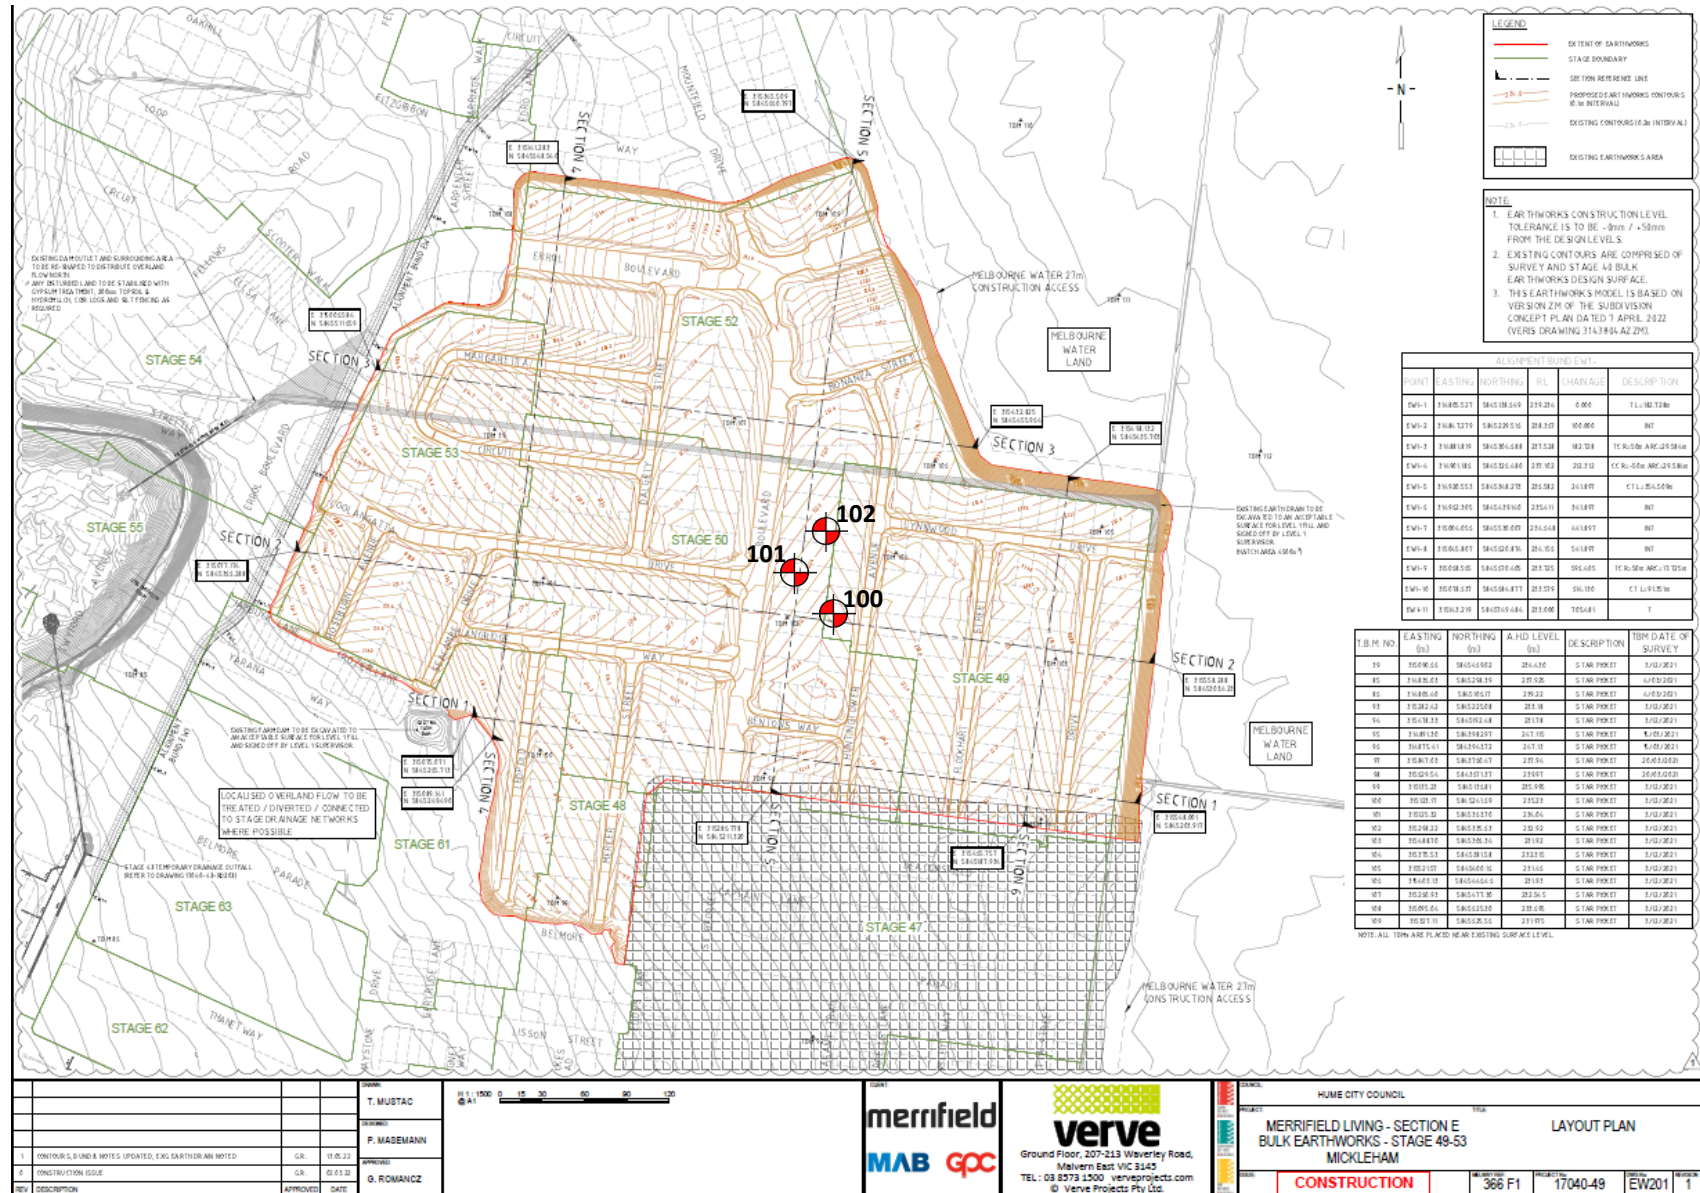

<b>PROJECT</b> Merrifield Estate – Stage 50 (Level 1)	<b>CLIENT:</b> BMD Urban	<b>DATE:</b> 24/02/2023
<b>LOCATION:</b> Mickleham	<b>Project No:</b> 1120 0343–1 (SI34)	<b>SITE PLAN SKETCH—NOT TO SCALE</b>

## Field Density Test Results AS1289.5.7.1

A & Y Associates Pty Ltd  
5/16 Network Drive  
Truganina VIC 3029  
PH: 0400 413 531  
info@ayassociates.com.au

<b>Client:</b>	BMD Urban			<b>Job No:</b>	BMD2324	
<b>Project:</b>	Merrifield Estate - Stage 50 (Level 1)			<b>Report:</b>	35	
<b>Location:</b>	Mickleham					

Sample No	103	104	105			
Date Tested	27/02/2023	27/02/2023	27/02/2023			
Time Tested	AM	AM	AM			

Test Location	Refer to Plan	Refer to Plan	Refer to Plan			
Level/Layer	FSL	FSL	FSL			
Layer Thickness	mm 200	mm 200	mm 200			
Test Depth	mm 175	mm 175	mm 175			
Field Wet Density	t/m <sup>3</sup> 1.90	t/m <sup>3</sup> 1.84	t/m <sup>3</sup> 1.86			
Field Moisture Content	% 23.1	% 24.4	% 23.8			
Material:	Imported Clay	Imported Clay	Imported Clay			

Oversize Material	WET, % 0.0	WET, % 0.0	WET, % 0.0			
Sieve Size	mm 19	mm 19	mm 19			
Peak Converted Wet Density	t/m <sup>3</sup> 1.96	t/m <sup>3</sup> 1.87	t/m <sup>3</sup> 1.94			
Optimum Moisture Content	% 23.5	% 22.5	% 22			



  

<b>Moisture Ratio</b>	% 98.5	% 108.5	% 108			
<b>Moisture Variation</b>	% -0.5	% 2.0	% 2.0			
<b>from OMC</b>	Drier	Wetter	Wetter			
<b>Density Ratio</b>	% 97.0	% 98.5	% 96.0			

<b>Specification:</b>	95% STD	<b>Test Selection:</b>	N/A
<b>Notes:</b>	Ref : 1120 0343-1 (SI35)		
<b>Test Method</b>	AS1289 5.8.1, 5.7.1, 2.1.1, 1.1	<b>Sampling Method:</b>	AS 1289 1.2.1 6.4(b)


  

 <b>NATA</b> WORLD RECOGNISED ACCREDITATION	NATA Accredited Laboratory No. 20172 Accreditation for compliance with ISO/IEC 17025 - Testing	Approved Signatory:  Date: 28/02/2023





Test Location

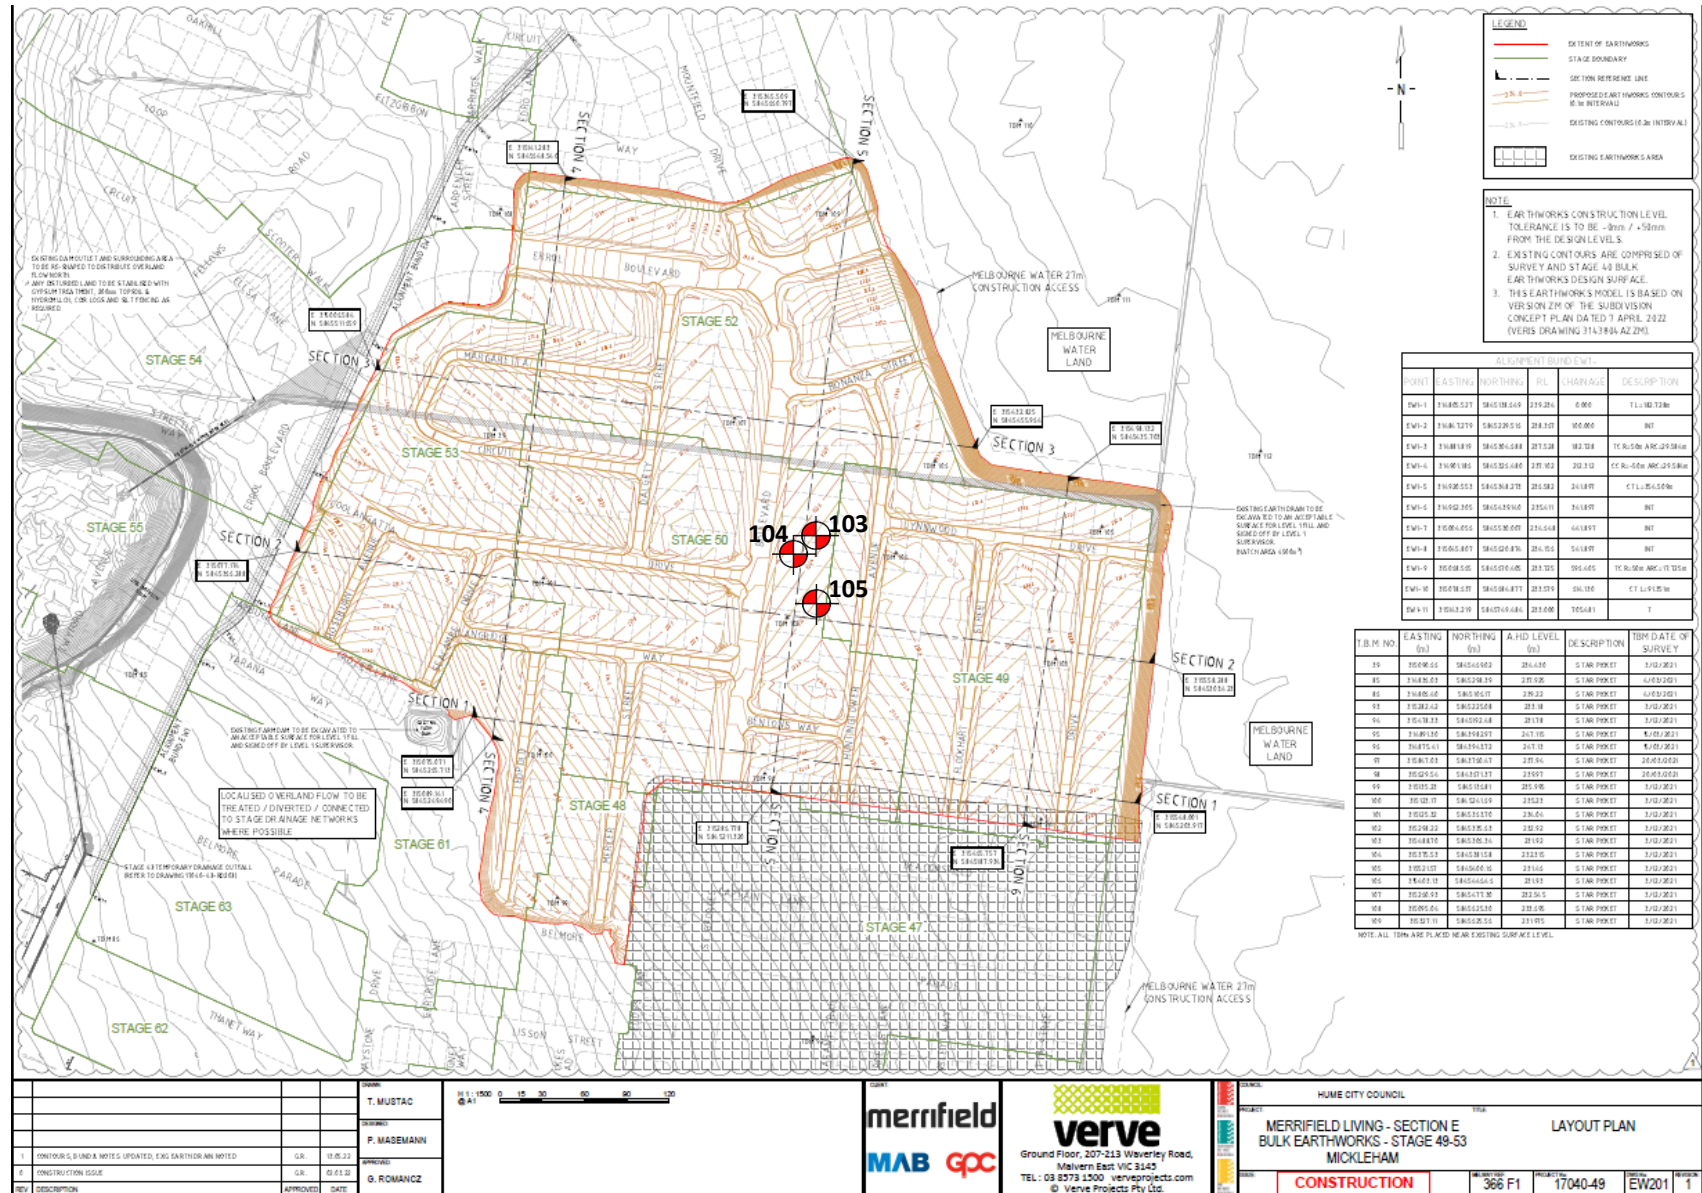

PROJECT Merrifield Estate – Stage 50 (Level 1)	CLIENT: BMD Urban	DATE: 27/02/2023	SITE PLAN SKETCH—NOT TO SCALE
LOCATION: Mickleham	Project No: 1120 0343–1 (SI35)		

## Field Density Test Results AS1289.5.7.1

A & Y Associates Pty Ltd  
5/16 Network Drive  
Truganina VIC 3029  
PH: 0400 413 531  
info@ayassociates.com.au

<b>Client:</b>	BMD Urban			<b>Job No:</b>	BMD2324	
<b>Project:</b>	Merrifield Estate - Stage 50 (Level 1)			<b>Report:</b>	36	
<b>Location:</b>	Mickleham					

Sample No	106	107	108			
Date Tested	07/03/2023	07/03/2023	07/03/2023			
Time Tested	PM	PM	PM			

Test Location	Refer to Plan	Refer to Plan	Refer to Plan			
Level/Layer	6	6	6			
Layer Thickness	mm 200	mm 200	mm 200			
Test Depth	mm 175	mm 175	mm 175			
Field Wet Density	t/m <sup>3</sup> 1.85	t/m <sup>3</sup> 1.94	t/m <sup>3</sup> 1.98			
Field Moisture Content	% 25.0	% 23.8	% 22.2			
Material:	Imported Clay	Imported Clay	Imported Clay			

Oversize Material	WET, % 0.0	WET, % 4.6	WET, % 5.2			
Sieve Size	mm 19	mm 19	mm 19			
Peak Converted Wet Density	t/m <sup>3</sup> 1.90	t/m <sup>3</sup> 2.00	t/m <sup>3</sup> 2.02			
Optimum Moisture Content	% 23	% 24	% 22.5			

<b>Moisture Ratio</b>	% 108.5	% 99	% 98.5			
<b>Moisture Variation</b>	% 2.0	% -0.5	% -0.5			
<b>from OMC</b>	Wetter	Drier	Drier			
<b>Density Ratio</b>	% 97.0	% 96.0	% 97.5			

<b>Specification:</b>	95% STD	<b>Test Selection:</b>	N/A
<b>Notes:</b>	Ref : 1120 0343-1 (SI36)		
<b>Test Method</b>	AS1289 5.8.1, 5.7.1, 2.1.1, 1.1	<b>Sampling Method:</b>	AS 1289 1.2.1 6.4(b)



NATA Accredited Laboratory No. 20172  
Accreditation for compliance with ISO/IEC 17025 - Testing


Approved Signatory:




David Burns  
Date: 30/03/2023



Test Location

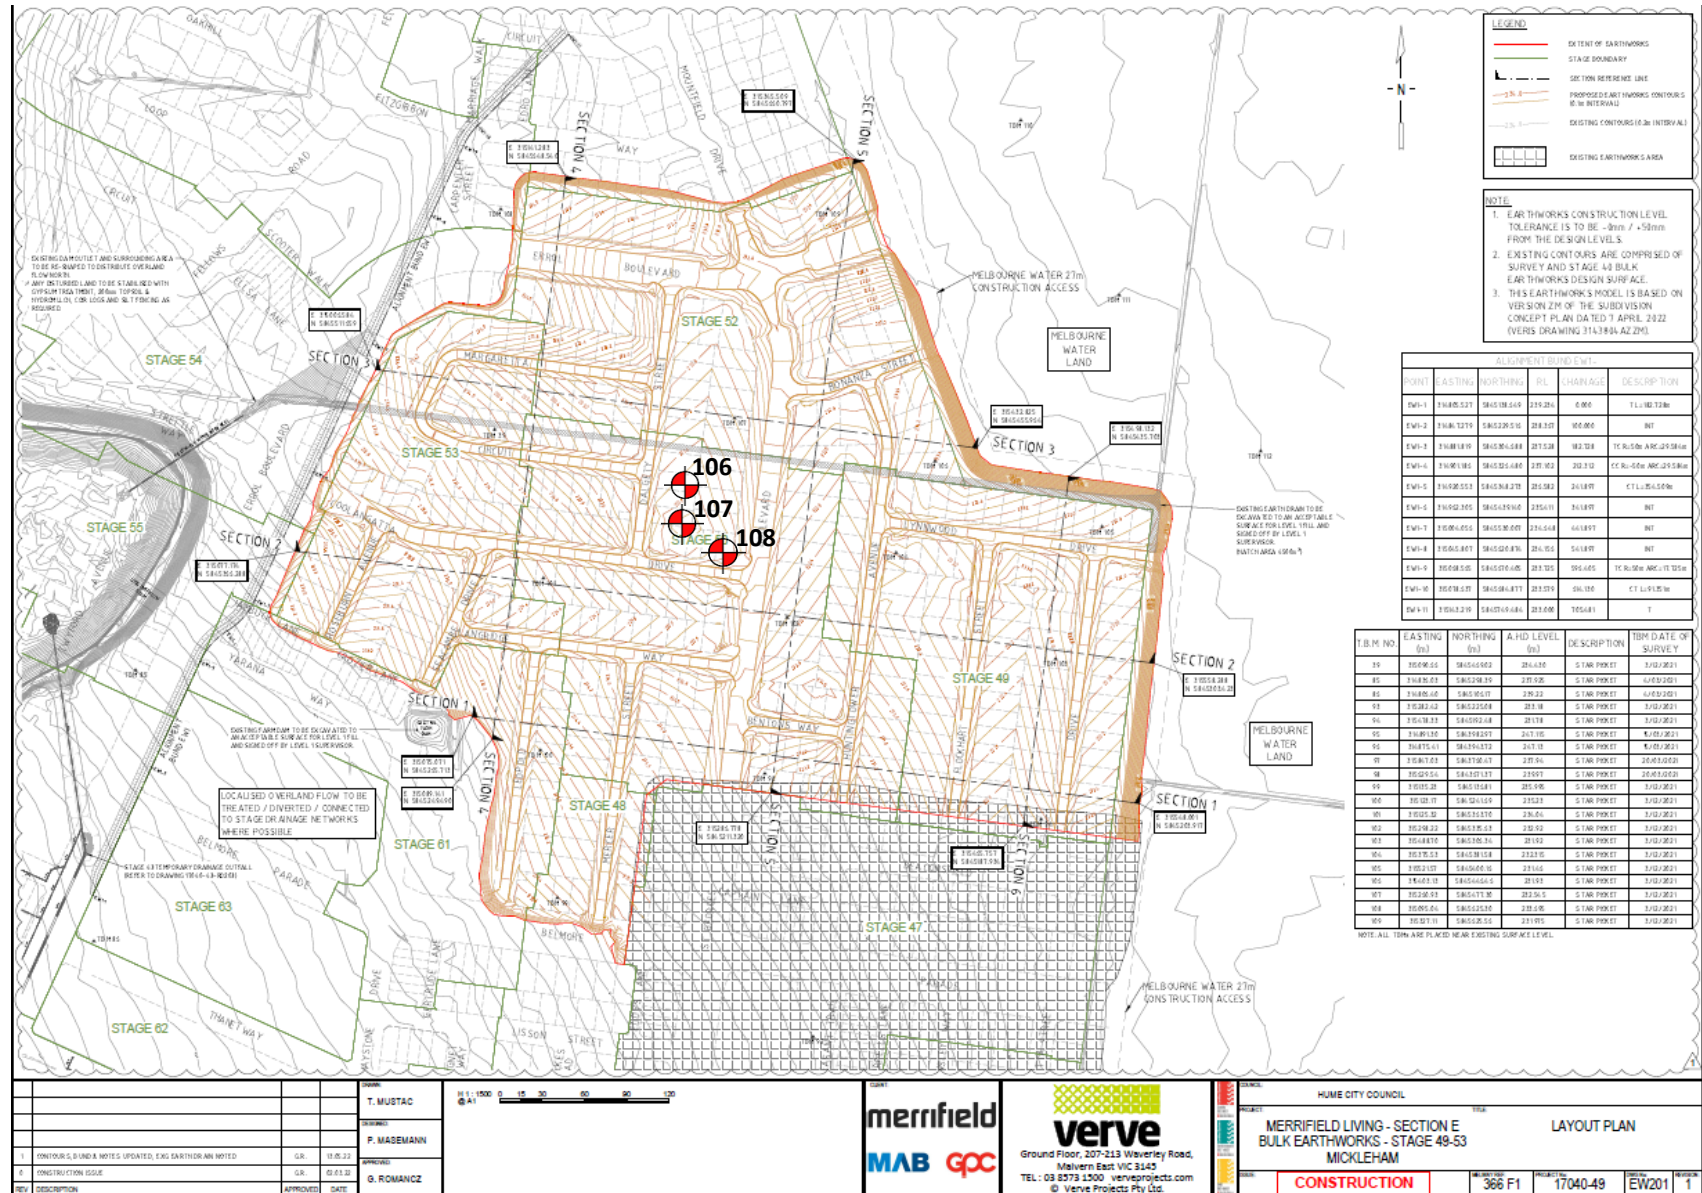

T. MUSTAC		MERRIFIELD		verve		HUME CITY COUNCIL	
G. ROMANOV				TEL: 03 8573 1500   verveprojects.com   © Verve Projects Pty Ltd.		LAYOUT PLAN	
						CONSTRUCTION	
						366 F1	
						17040-49	
						EW201	
						1	

PROJECT	CLIENT:	DATE:	 <div>A&amp;Y ASSOCIATES GEOTECHNICAL ENGINEERING CONSULTANTS</div>
Merrifield Estate – Stage 50 (Level 1)	BMD Urban	07/03/2023	
LOCATION:	Project No:	SITE PLAN SKETCH—NOT TO SCALE	
Mickleham	1120 0343–1 (SI36)		





## Field Density Test Results AS1289.5.7.1

A & Y Associates Pty Ltd  
5/16 Network Drive  
Truganina VIC 3029  
PH: 0400 413 531  
info@ayassociates.com.au

<b>Client:</b>	BMD Urban			<b>Job No:</b>	BMD2324	
<b>Project:</b>	Merrifield Estate - Stage 50 (Level 1)			<b>Report:</b>	37	
<b>Location:</b>	Mickleham					

Sample No	109	110	111			
Date Tested	10/03/2023	10/03/2023	10/03/2023			
Time Tested	PM	PM	PM			

Test Location	Refer to Plan	Refer to Plan	Refer to Plan			
Level/Layer	7	7	7			
Layer Thickness	mm 200	mm 200	mm 200			
Test Depth	mm 175	mm 175	mm 175			
Field Wet Density	t/m <sup>3</sup> 1.92	t/m <sup>3</sup> 1.91	t/m <sup>3</sup> 1.97			
Field Moisture Content	% 22.2	% 23.0	% 21.8			
Material:	Imported Clay	Imported Clay	Imported Clay			

Oversize Material	WET, % 3.2	WET, % 2.9	WET, % 4.9			
Sieve Size	mm 19	mm 19	mm 19			
Peak Converted Wet Density	t/m <sup>3</sup> 1.98	t/m <sup>3</sup> 1.97	t/m <sup>3</sup> 2.01			
Optimum Moisture Content	% 20	% 21	% 22.5			



  

<b>Moisture Ratio</b>	% 111	% 109.5	% 97			
<b>Moisture Variation</b>	% 2.0	% 1.5	% -0.5			
<b>from OMC</b>	Wetter	Wetter	Drier			
<b>Density Ratio</b>	% 96.5	% 96.0	% 97.5			


<b>Specification:</b>	95% STD	<b>Test Selection:</b>	N/A
<b>Notes:</b>	Ref : 1120 0343-1 (SI37)		
<b>Test Method</b>	AS1289 5.8.1, 5.7.1, 2.1.1, 1.1	<b>Sampling Method:</b>	AS 1289 1.2.1 6.4(b)


  

 <b>NATA</b> WORLD RECOGNISED ACCREDITATION	NATA Accredited Laboratory No. 20172 Accreditation for compliance with ISO/IEC 17025 - Testing	Approved Signatory:  Date: 30/03/2023



Test Location

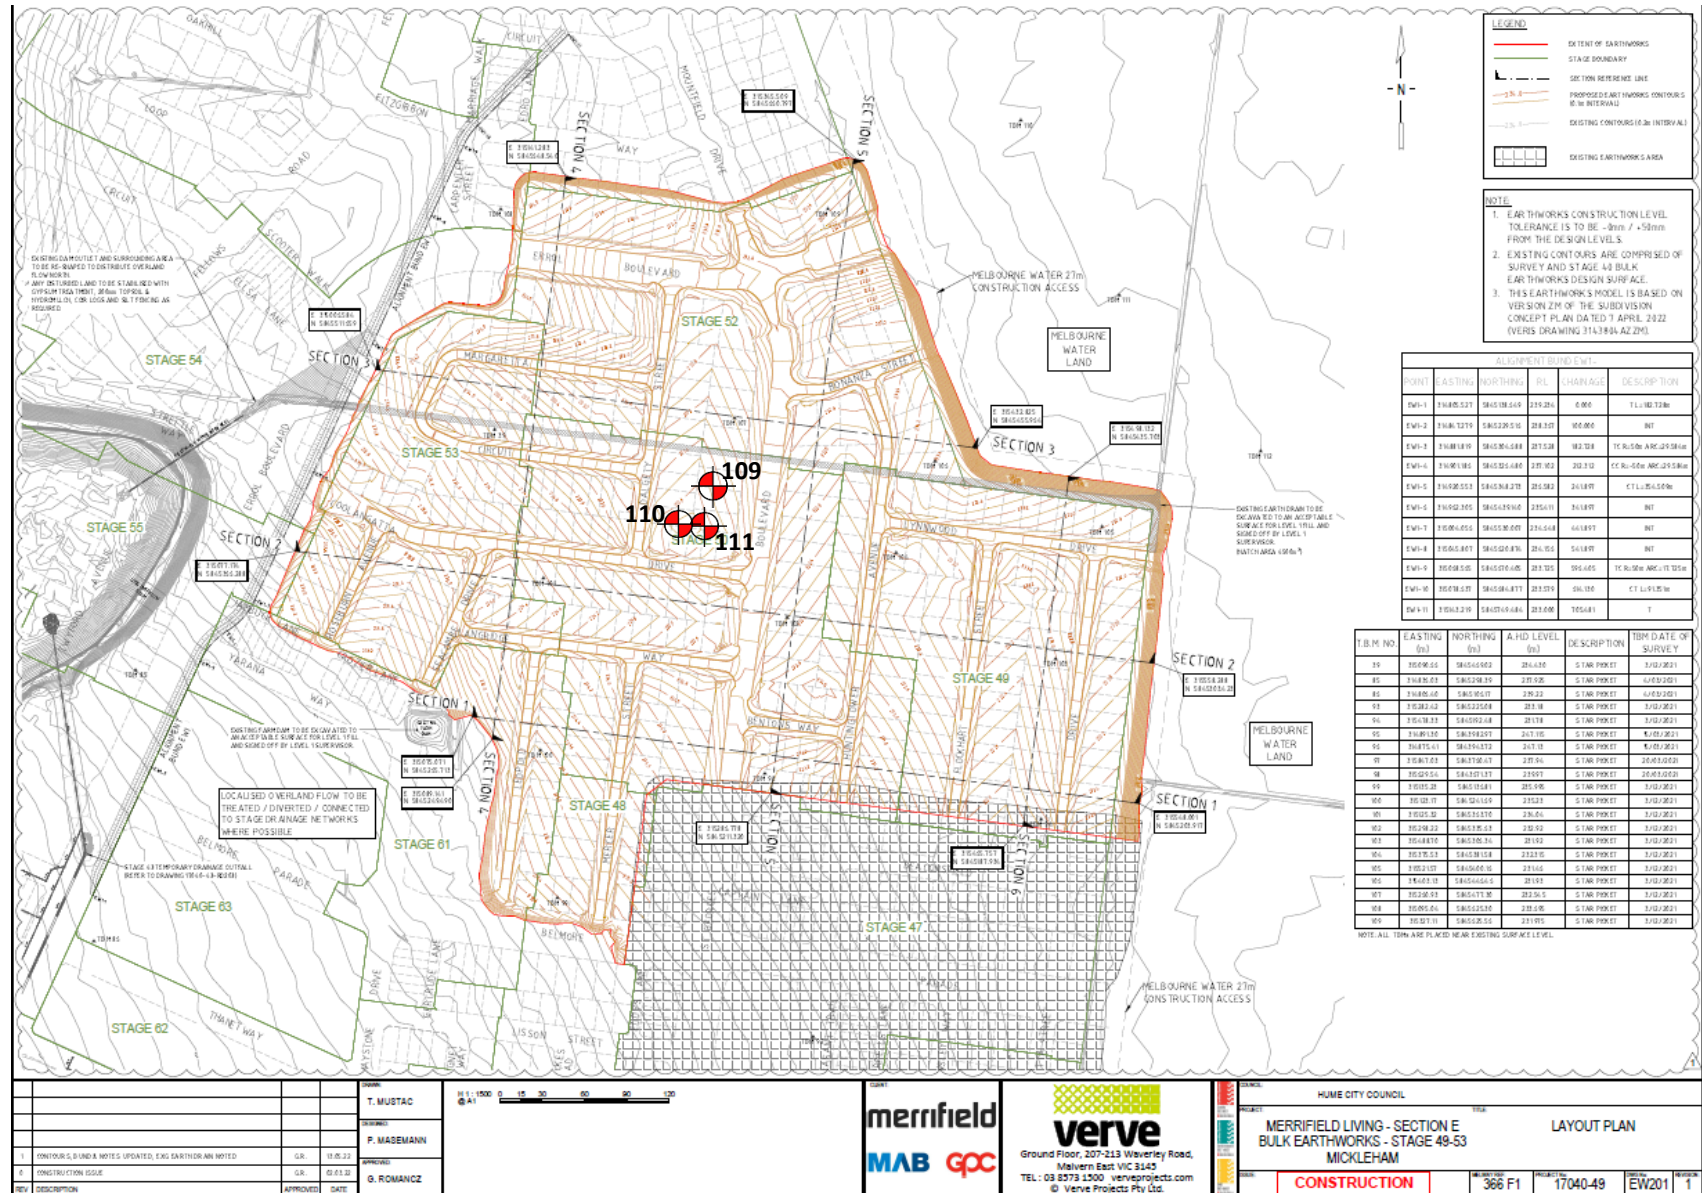

PROJECT Merrifield Estate – Stage 50 (Level 1)	CLIENT: BMD Urban	DATE: 10/03/2023	 <div>A&amp;Y ASSOCIATES GEOTECHNICAL ENGINEERING CONSULTANTS</div>
LOCATION: Mickleham	Project No: 1120 0343–1 (SI37)	SITE PLAN SKETCH—NOT TO SCALE	