

Merrifield Estate - Stage 52, Mickleham

Level 1 Inspection & Testing Report

Reference: 1120 0349-1



Prepared for:

BMD Urban

May 2023



A&Y ASSOCIATES
GEOTECHNICAL ENGINEERING CONSULTANTS

Document Control Record

Prepared by:

A&Y Associates Pty Ltd

ABN 92 614 244 665

5/16 Network Drive

Truganina, VIC 3029

T: (03) 8754 8325

E: info@ayassociates.com.au

W: www.ayassociates.com.au

Document control

| | | | | | |
|---------------------------------|-------------|------------------------------|---------------|-----------------|-----------------|
| Report title | | Level 1 Inspection & Testing | | | |
| Project reference number | | 1120 0349-1 | | | |
| Client | | BMD Urban | | | |
| Contact name | | Alyssa Willder | | | |
| Contact number | | 0400 207 600 | | | |
| Contact e-mail | | Alyssa.Willder@bmd.com.au | | | |
| Revision | Date | Descriptions/Status | Author | Reviewer | Approver |
| 0 | 12/05/2023 | First Issue | Y Balkis | A Tan | A Tan |

Approver



Alvin Tan

(BE Civil and Infrastructure), MIEAust

Senior Geotechnical Engineer

E: alvin@ayassociates.com.au | M: 0449 288 338



ENGINEERS
AUSTRALIA
Professional Engineer
MEMBER

Disclaimer

The findings and conclusions contained in this report are made based on site conditions that existed at the time this work was conducted. The conclusions present in this report are relevant to the conditions of the site and the state of legislation currently enacted as at the date of this report.

Findings and conclusions are made assuming that the soil, groundwater, geological and chemical conditions detailed within this report are accurate and remain applicable to the site at the time of writing. No other warranties are made or intended.

A&Y Associates (A&Y) Pty Ltd has used a degree of skill and care ordinarily exercised by reputable members of our profession practicing in the same or similar locality.

A&Y does not make any representation or warranty that the conclusions in this report will be applicable in the future as there may be changes in the condition of the site, applicable legislation or other factors that would affect the conclusions contained in this report.

This report has been prepared exclusively for use by our client. This report cannot be reproduced without the written authorisation of A&Y and then can only be reproduced in its entirety.

Applicability

This report has been prepared for the benefit for our client with respect to the particular brief given to us and it may not be relied upon in other contexts or for any other purpose without our prior review and agreement.

No responsibility for this report will be taken by A&Y if it is altered in any way, or not reproduced in full.

Contents

| | | |
|-----------|--|-----------|
| 1 | Introduction..... | 3 |
| 2 | Project Summary | 3 |
| 3 | Project Specifications..... | 4 |
| 4 | Subgrade Assessment..... | 5 |
| 5 | Earthworks | 5 |
| 6 | Fill Material | 5 |
| 7 | Testing..... | 6 |
| 8 | Finished Surface Levels | 6 |
| 9 | Exclusion | 6 |
| 10 | Conclusion | 7 |
| | Appendix A - Site Plan | 8 |
| | Appendix B – Test Locations | 10 |
| | Appendix C – Test Results Summary | 12 |
| | Appendix D – NATA Test Results | 16 |

1 Introduction

This report presents the results of the Level 1 Inspection and Testing for the construction of the fill platforms located in Merrifield Estate - Stage 52, Mickleham.

2 Project Summary

It is understood that BMD Urban require the fill platforms within Stage 52 to be constructed under Level 1 Inspection and Testing undertaken by a Geotechnical Inspection and Testing Authority (GITA).

Level 1 Inspection and Testing, as defined in AS3798-2007 "Guidelines on Earthworks for Commercial and Residential Development," provides for full time inspection of the construction of controlled fill and field and laboratory testing in accordance with AS1289 "Methods of Testing Soils for Engineering Purposes".

The Level 1 inspection was undertaken by a Geotechnician from A&Y Associates over **23 working days** from the **5th July 2022 to 20th March 2023**.

This report is applicable for fill placed by BMD Urban for Merrifield Estate - Stage 52, Mickleham, as shown in Appendix A – Site Plan.

3 Project Specifications

The supervision and inspections were performed based on AS3798, the specifications provided in the geotechnical report (ref: "Geotechnical Site Investigation, Merrifield Living – Section E&G Donnybrook Road, Mickleham"; Report No. G4719.1 REVAB, by Ground Science Pty Ltd, Dated 19/05/2022) and the drawing (ref: "Merrifield Living – Section D – Stage 52"; Project No. 17040-52, Drawing No. RD102 - REV0 by Verve Projects Pty Ltd, Dated 16/11/2022) for the construction works in Merrifield Estate – Stage 52, Mickleham. A short summary of the requirements outline in AS3798 is provided below:

- Material to be used for fill construction shall satisfy the requirements of AS3798-2007 "Guidelines on Earthworks for Commercial and Residential Developments". Material used shall be free of:
 - Organic soils, such as topsoils, severely root affected subsoil and peat;
 - Contaminated soils;
 - Materials which undergo volume change or loss of strength when disturbed and exposed to moisture;
 - Silts, or materials that have deleterious engineering properties of silt;
 - Fill that contains wood, metal, plastic, boulders, or other deleterious material, in sufficient proportions to affect the required performance of fill;
 - The maximum particle size of any rocks or other lump, within the layer, has not exceeded two-thirds (2/3) of the compacted layer thickness.
- Compaction to achieve a dry density ratio of at least 95% Standard, as the project was classified as **Residential**.

4 Subgrade Assessment

The subgrade was assessed by A&Y Associates following the topsoil removal and before any fill was placed. The subgrade assessment was undertaken on the **3rd of June 2022** as mentioned in report **1120 0349-1 (SSI1)**.

The exposed subgrade material was found comprised of silty clay. No wet or soft patches were found during the inspection. No evidence of deleterious material was found during the inspection.

5 Earthworks

The earthworks for this project included stripping of topsoil, removing of tree roots, proof rolling the subgrade and placement and compaction of fill to construct engineered platforms.

Based on design plans and site inspection, the fill thickness is approximately 200mm – 1600mm. The fill layers or thickness nominated in this report are provided as a guide on the amounts of fill placed and do not necessarily reflect an accurate survey of the fill levels.

6 Fill Material

The fill material used for the platform consisted of imported material. The imported material was predominantly comprised of Silty Clay with gravel.

7 Testing

Field density testing was undertaken on the compacted fill at a frequency of a minimum of 3 tests per lot (AS3798 Table 8.1).

Tests were performed using a Nuclear Density Gauge for field density determination as per AS 1289.5.8.1. Testing was completed at a minimum rate of 3 field density tests per day's production based on the minimum requirements of AS 3798-2007 and taken from each layer of fill placed.

A total of 69 field density tests were performed during the earthworks. All of the test results met the specified compaction requirement of 95% Standard Compaction.

The locations of the 69 field density tests are shown in Appendix B – Test Locations. A summary of the test results obtained from the field density testing is presented in Appendix C – Test Results Summary. The laboratory test reports of the field density tests are presented in Appendix D – NATA Test Results.

8 Finished Surface Levels

It should be noted that even though the final fill layer meets the specification requirements, over time, the material may be subject to adverse weather conditions resulting in either surface softening or drying and cracking. The top 150mm – 200mm of the fill will deteriorate with time and should be considered by the foundation engineer.

9 Exclusion

A&Y Associates was not involved in monitoring and testing the following works and as such are not included in the Level 1 report.


- Any trenches excavated and backfilled on site for the installation of underground services such as sewers, electrical conduits, water mains etc.
- Footpaths in front of the lots that may be excavated and filled after the Level 1 supervision conducted by A&Y Associates.
- Uncontrolled fill and topsoil that may have been placed as part of the landscaping of the site following the completion of the engineered fill construction.

10 Conclusion

On the completion of the earthworks and after analysing the materials used, it has been concluded that the filling procedure conducted by BMD Urban appears to be consistent with the requirements of AS 3798 in regards to the placement of fill materials on a project under Level 1 Supervision and in accordance with the project specification as provided to A&Y Associates.

Appendix A - Site Plan

Appendix B – Test Locations

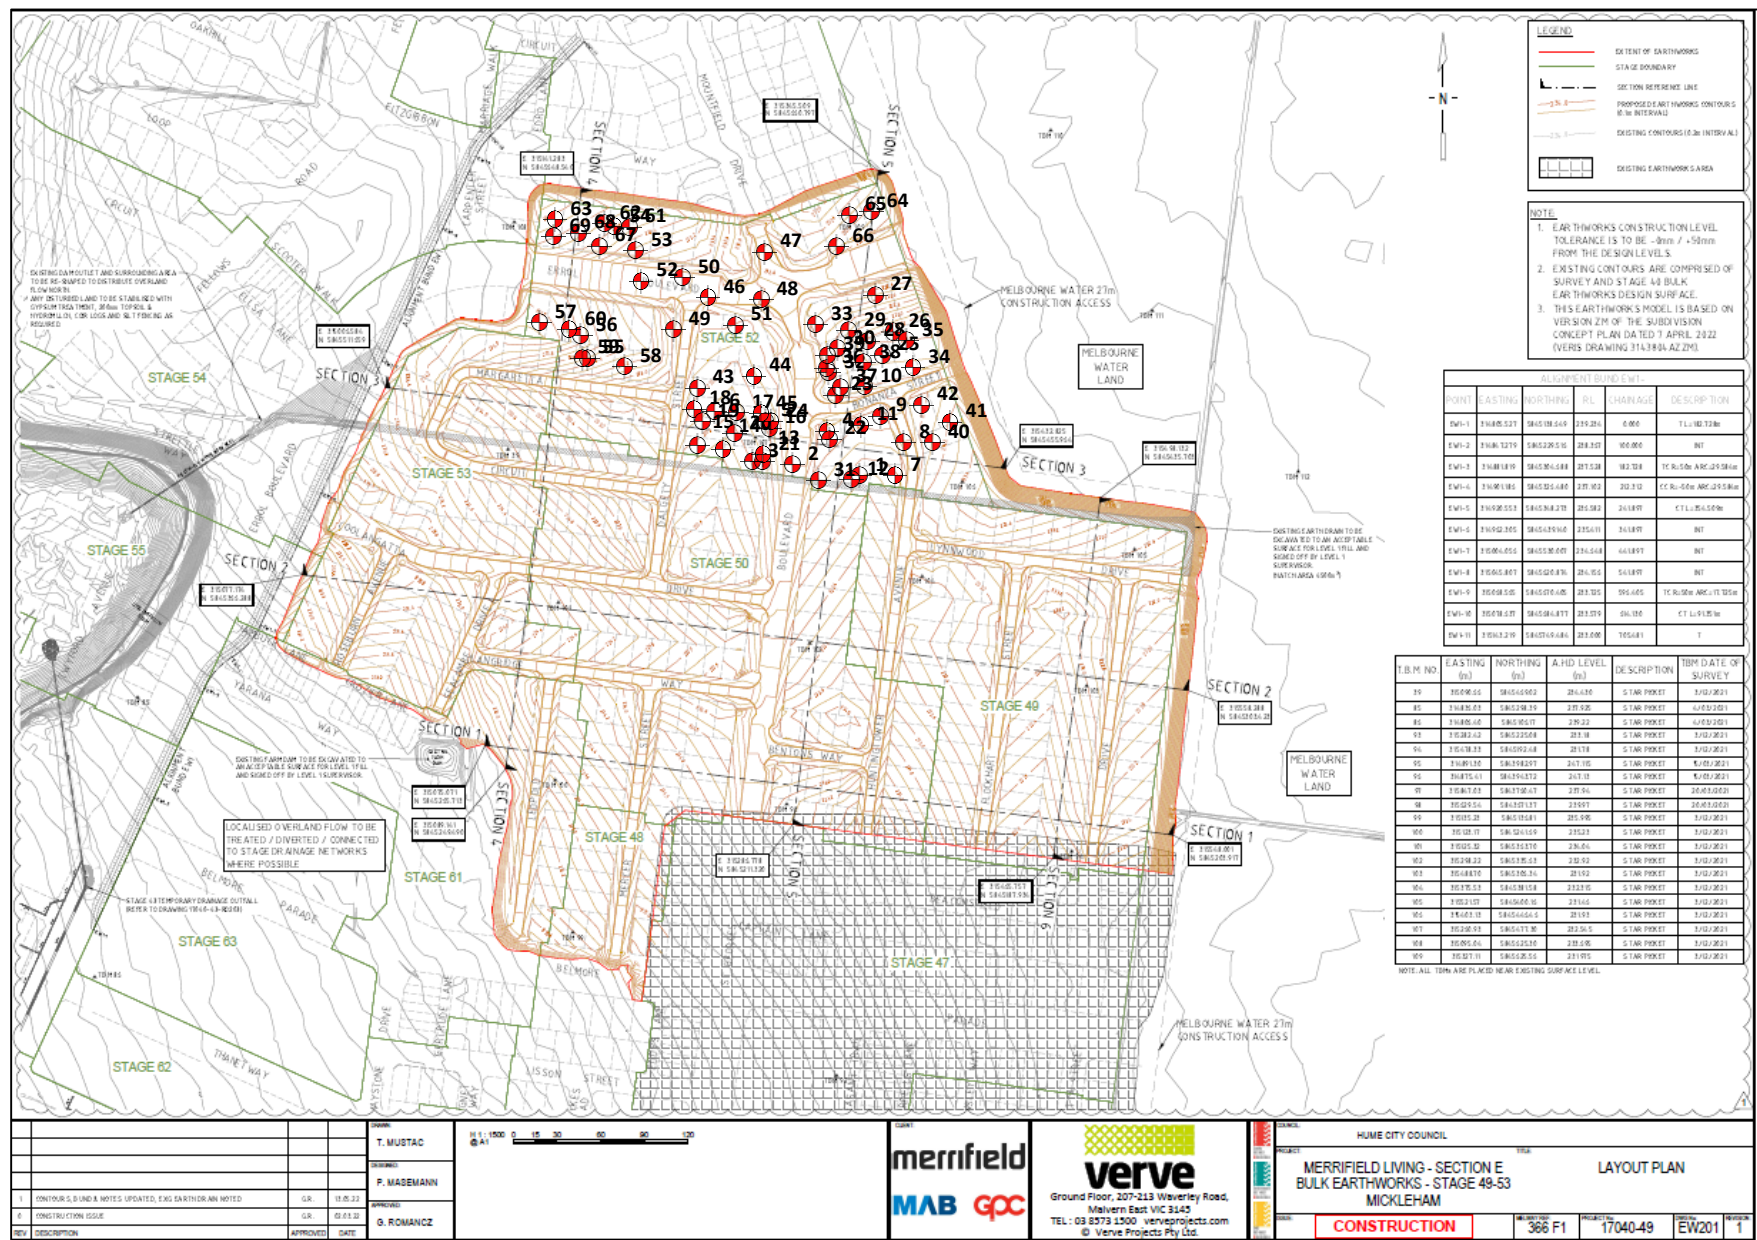

| | | |
|--|-----------------------------------|--------------------------------------|
| PROJECT: Merrifield Estate - Stage 52 (Level1) | CLIENT: BMD Urban | SITE PLAN SKETCH—NOT TO SCALE |
| LOCATION: Mickleham | PROJECT No: 1120 0349-1 | |



Appendix C – Test Results Summary

| Project No | | 1120 0349-1 | | | Client | BMD Urban | | | | |
|--------------|----------------|--|----------|-------|---------------|---------------|----------------|---|-------------|-------------|
| Project Name | | Merrifield Estate - Stage 52 - Level 1 | | | Specification | | | Density Ratio ≥ 95% of Peak Wet Density | | |
| Location | | Mickleham | | | | | | | | |
| Test No | Retest of Test | Date | Location | Layer | Oversize | Density Ratio | Moisture Ratio | Moisture Variation | Pass / Fail | Retest |
| # | # | | Lot # | # | % | % | % | % | | Pass / Fail |
| 1 | - | 5/7/2022 | - | 1 | 3.1 | 97.0 | 107.5 | 2.0 | Pass | - |
| 2 | - | 5/7/2022 | - | 1 | 2.5 | 96.5 | 96.5 | -1.0 | Pass | - |
| 3 | - | 5/7/2022 | - | 1 | 4.6 | 97.5 | 107.5 | 1.5 | Pass | - |
| 4 | - | 6/7/2022 | - | 1 | 2.3 | 97.0 | 107.0 | 1.5 | Pass | - |
| 5 | - | 6/7/2022 | - | 1 | 3.5 | 97.0 | 110.5 | 2.0 | Pass | - |
| 6 | - | 6/7/2022 | - | 1 | 4.1 | 97.5 | 96.5 | -0.5 | Pass | - |
| 7 | - | 7/7/2022 | - | 2 | 4.5 | 97.0 | 97.5 | -0.5 | Pass | - |
| 8 | - | 7/7/2022 | - | 2 | 2.1 | 97.0 | 107.0 | 1.5 | Pass | - |
| 9 | - | 7/7/2022 | - | 2 | 3.6 | 97.5 | 108.5 | 2.0 | Pass | - |
| 10 | - | 8/7/2022 | - | 2 | 2.8 | 97.0 | 108.5 | 1.5 | Pass | - |
| 11 | - | 8/7/2022 | - | 2 | 2.1 | 95.5 | 107.5 | 1.5 | Pass | - |
| 12 | - | 8/7/2022 | - | 2 | 2.6 | 98.0 | 109.5 | 2.0 | Pass | - |
| 13 | - | 1/9/2022 | - | 1 | 0.0 | 98.5 | 107.0 | 1.5 | Pass | - |
| 14 | - | 1/9/2022 | - | 1 | 0.0 | 98.0 | 107.5 | 1.5 | Pass | - |
| 15 | - | 1/9/2022 | - | 1 | 0.0 | 97.5 | 106.5 | 1.5 | Pass | - |
| 16 | - | 5/9/2022 | - | 1 | 0.0 | 98.5 | 108.0 | 1.5 | Pass | - |
| 17 | - | 5/9/2022 | - | 1 | 0.0 | 98.0 | 108.0 | 2.0 | Pass | - |
| 18 | - | 5/9/2022 | - | 1 | 0.0 | 97.5 | 107.0 | 1.5 | Pass | - |
| 19 | - | 3/10/2022 | - | 2 | 0.0 | 99.0 | 108.0 | 2.0 | Pass | - |
| 20 | - | 3/10/2022 | - | 2 | 0.0 | 99.0 | 96.5 | -1.0 | Pass | - |
| 21 | - | 3/10/2022 | - | 2 | 0.0 | 98.5 | 109.0 | 2.0 | Pass | - |
| 22 | - | 6/2/2023 | - | 3 | 4.0 | 97.0 | 108.0 | 1.5 | Pass | - |
| 23 | - | 6/2/2023 | - | 3 | 3.6 | 97.0 | 97.0 | -0.5 | Pass | - |
| 24 | - | 6/2/2023 | - | 3 | 2.4 | 98.0 | 99.0 | -0.5 | Pass | - |
| 25 | - | 7/2/2023 | - | 1 | 0.0 | 98.5 | 96.5 | -0.5 | Pass | - |

** Negative (-) value indicates that the field moisture content is drier than the optimum moisture content (OMC)

** Positive (+) value indicates that the field moisture content is wetter than the optimum moisture content (OMC)

| | | | | | | | | | | |
|----|---|------------|---|-----|-----|-------|-------|------|------|---|
| 26 | - | 7/2/2023 | - | 1 | 0.0 | 98.5 | 97.0 | -0.5 | Pass | - |
| 27 | - | 7/2/2023 | - | 1 | 0.0 | 98.5 | 97.5 | -0.5 | Pass | - |
| 28 | - | 8/2/2023 | - | 1 | 0.0 | 97.0 | 108.5 | 2.0 | Pass | - |
| 29 | - | 8/2/2023 | - | 1 | 4.6 | 95.5 | 103.0 | 0.5 | Pass | - |
| 30 | - | 8/2/2023 | - | 1 | 2.5 | 97.0 | 106.0 | 1.5 | Pass | - |
| 31 | - | 16/02/2023 | - | 3 | 3.6 | 97.0 | 107.5 | 1.5 | Pass | - |
| 32 | - | 16/02/2023 | - | 3 | 2.0 | 97.0 | 107.5 | 2.0 | Pass | - |
| 33 | - | 16/02/2023 | - | 3 | 5.2 | 95.5 | 107.0 | 1.5 | Pass | - |
| 34 | - | 20/02/2023 | - | 4 | 0.0 | 97.5 | 107.5 | 2.0 | Pass | - |
| 35 | - | 20/02/2023 | - | 5 | 3.1 | 96.0 | 97.0 | -0.5 | Pass | - |
| 36 | - | 20/02/2023 | - | 5 | 0.0 | 98.0 | 107.0 | 2.0 | Pass | - |
| 37 | - | 21/02/2023 | - | 6 | 2.1 | 98.5 | 98.0 | -0.5 | Pass | - |
| 38 | - | 21/02/2023 | - | 6 | 0.0 | 97.5 | 106.0 | 1.5 | Pass | - |
| 39 | - | 21/02/2023 | - | 6 | 4.2 | 97.5 | 96.5 | -1.0 | Pass | - |
| 40 | - | 22/02/2023 | - | FSL | 4.6 | 97.0 | 99.0 | -0.5 | Pass | - |
| 41 | - | 22/02/2023 | - | FSL | 0.0 | 97.5 | 108.0 | 2.0 | Pass | - |
| 42 | - | 22/02/2023 | - | FSL | 2.9 | 97.5 | 107.0 | 2.0 | Pass | - |
| 43 | - | 23/02/2023 | - | 4 | 0.0 | 100.0 | 98.0 | -0.5 | Pass | - |
| 44 | - | 23/02/2023 | - | 4 | 3.8 | 97.0 | 97.5 | -0.5 | Pass | - |
| 45 | - | 23/02/2023 | - | 4 | 2.5 | 97.5 | 107.5 | 1.5 | Pass | - |
| 46 | - | 28/02/2023 | - | 1 | 4.2 | 96.5 | 98.0 | -0.5 | Pass | - |
| 47 | - | 28/02/2023 | - | 1 | 2.6 | 98.0 | 96.0 | -0.5 | Pass | - |
| 48 | - | 28/02/2023 | - | 1 | 0.0 | 96.5 | 108.5 | 2.0 | Pass | - |
| 49 | - | 1/3/2023 | - | 2 | 0.0 | 97.0 | 108.0 | 2.0 | Pass | - |
| 50 | - | 1/3/2023 | - | 2 | 3.9 | 97.5 | 96.0 | -1.0 | Pass | - |
| 51 | - | 1/3/2023 | - | 2 | 0.0 | 98.5 | 98.5 | -0.5 | Pass | - |
| 52 | - | 2/3/2023 | - | 2 | 4.8 | 96.5 | 98.5 | -0.5 | Pass | - |
| 53 | - | 2/3/2023 | - | 2 | 2.1 | 98.0 | 98.5 | -0.5 | Pass | - |
| 54 | - | 2/3/2023 | - | 2 | 3.4 | 98.0 | 110.0 | 2.0 | Pass | - |
| 55 | - | 3/3/2023 | - | 2 | 4.2 | 96.5 | 108.0 | 1.5 | Pass | - |
| 56 | - | 3/3/2023 | - | 3 | 5.9 | 96.0 | 111.5 | 2.0 | Pass | - |

** Negative (-) value indicates that the field moisture content is drier than the optimum moisture content (OMC)

** Positive (+) value indicates that the field moisture content is wetter than the optimum moisture content (OMC)

| | | | | | | | | | | |
|----|---|------------|---|---|-----|------|-------|------|------|---|
| 57 | - | 3/3/2023 | - | 3 | 5.4 | 97.5 | 98.0 | -0.5 | Pass | - |
| 58 | - | 6/3/2023 | - | 4 | 4.2 | 96.5 | 96.5 | -0.5 | Pass | - |
| 59 | - | 6/3/2023 | - | 4 | 0.0 | 96.5 | 108.0 | 2.0 | Pass | - |
| 60 | - | 6/3/2023 | - | 4 | 0.0 | 98.0 | 108.0 | 2.0 | Pass | - |
| 61 | - | 8/3/2023 | - | 5 | 4.0 | 98.0 | 110.0 | 2.0 | Pass | - |
| 62 | - | 8/3/2023 | - | 5 | 6.5 | 96.0 | 97.0 | -0.5 | Pass | - |
| 63 | - | 8/3/2023 | - | 5 | 3.6 | 97.0 | 109.5 | 2.0 | Pass | - |
| 64 | - | 9/3/2023 | - | 6 | 5.7 | 97.5 | 97.5 | -0.5 | Pass | - |
| 65 | - | 9/3/2023 | - | 6 | 4.1 | 96.5 | 97.0 | -0.5 | Pass | - |
| 66 | - | 9/3/2023 | - | 6 | 3.6 | 97.0 | 108.0 | 2.0 | Pass | - |
| 67 | - | 20/03/2023 | - | 7 | 4.7 | 98.0 | 97.0 | -0.5 | Pass | - |
| 68 | - | 20/03/2023 | - | 7 | 2.2 | 98.5 | 97.0 | -0.5 | Pass | - |
| 69 | - | 20/03/2023 | - | 7 | 0.0 | 97.0 | 108.0 | 2.0 | Pass | - |

** Negative (-) value indicates that the field moisture content is drier than the optimum moisture content (OMC)

** Positive (+) value indicates that the field moisture content is wetter than the optimum moisture content (OMC)

Appendix D – NATA Test Results

Field Density Test Results AS1289.5.7.1

A & Y Associates Pty Ltd
5/16 Network Drive
Truganina VIC 3029
PH: 0400 413 531
info@ayassociates.com.au

| | | | | | | |
|------------------|--|--|--|----------------|---------|--|
| Client: | BMD Urban | | | Job No: | BMD2365 | |
| Project: | Merrifield Estate - Stage 52 (Level 1) | | | Report: | 1 | |
| Location: | Mickleham | | | | | |

| | | | | | | |
|-------------|-----------|-----------|-----------|--|--|--|
| Sample No | 1 | 2 | 3 | | | |
| Date Tested | 5/07/2022 | 5/07/2022 | 5/07/2022 | | | |
| Time Tested | AM | AM | AM | | | |

| | | | | | | |
|------------------------|-----------------------|-----------------------|-----------------------|--|--|--|
| Test Location | Refer to Plan | Refer to Plan | Refer to Plan | | | |
| Level/Layer | Layer 1 | Layer 1 | Layer 1 | | | |
| Layer Thickness | mm 200 | mm 200 | mm 200 | | | |
| Test Depth | mm 175 | mm 175 | mm 175 | | | |
| Field Wet Density | t/m ³ 1.82 | t/m ³ 1.84 | t/m ³ 1.92 | | | |
| Field Moisture Content | % 25.3 | % 22.2 | % 23.1 | | | |
| Material: | Imported Clay | Imported Clay | Imported Clay | | | |

| | | | | | | |
|----------------------------|------------------|------|------|------|--|--|
| Oversize Material | WET, % | 3.1 | 2.5 | 4.6 | | |
| Sieve Size | mm | 19 | 19 | 19 | | |
| Peak Converted Wet Density | t/m ³ | 1.87 | 1.89 | 1.95 | | |
| Optimum Moisture Content | % | 23.5 | 23 | 21.5 | | |

| | | | | | | |
|---------------------------|---|--------|-------|--------|--|--|
| Moisture Ratio | % | 107.5 | 96.5 | 107.5 | | |
| Moisture Variation | % | 2.0 | -1.0 | 1.5 | | |
| from OMC | | Wetter | Drier | Wetter | | |
| Density Ratio | % | 97.0 | 96.5 | 97.5 | | |

| | | | |
|-----------------------|---------------------------------|-------------------------|----------------------|
| Specification: | 95% STD | Test Selection: | N/A |
| Notes: | Ref : 1120 0349-1 (SI01) | | |
| Test Method | AS1289 5.8.1, 5.7.1, 2.1.1, 1.1 | Sampling Method: | AS 1289 1.2.1 6.4(b) |



NATA Accredited Laboratory No. 20172
Accreditation for compliance with ISO/IEC 17025 - Testing
The results of tests, calibrations and/or measurements included
in this document, are traceable to Australian / National Standards

Approved Signatory:





David Burns
28/07/2022

Date:



Test Location

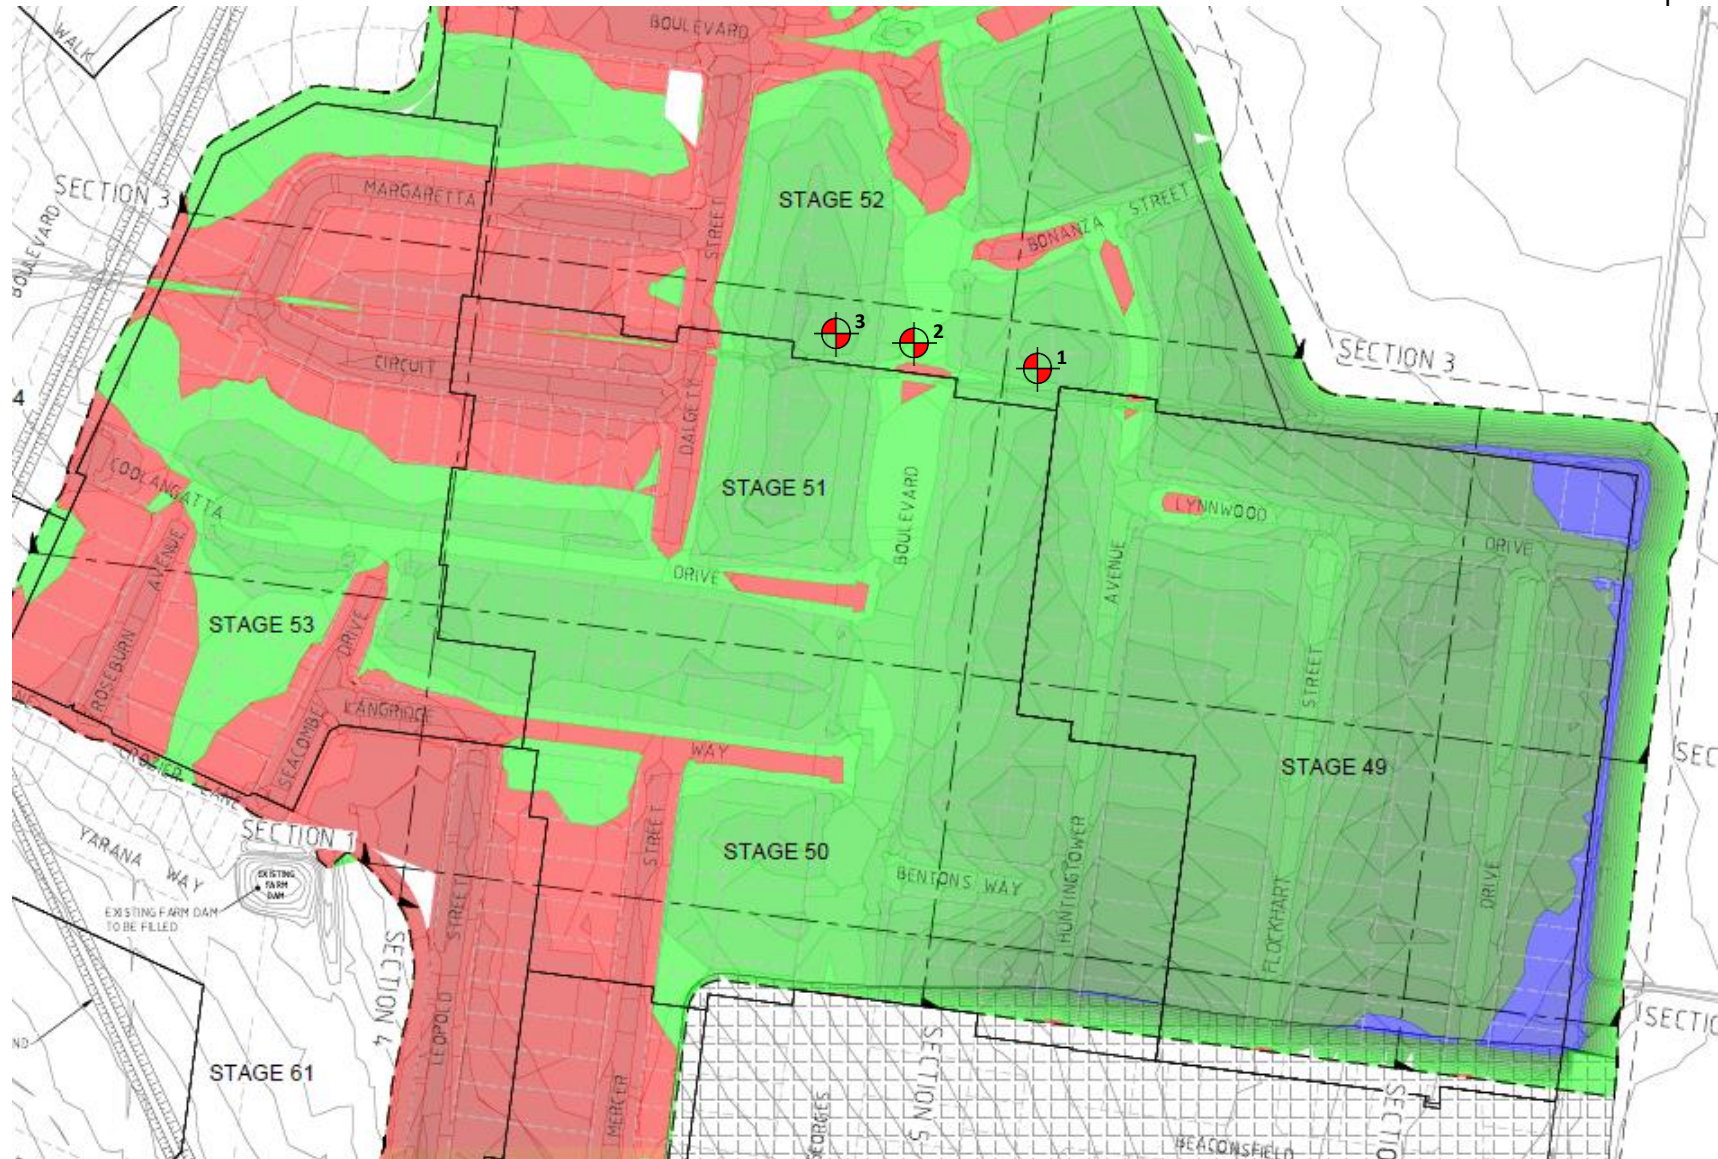

| | | | |
|--|-----------------------------------|-------------------------------|---|
| PROJECT: Merrifield Estate – Stage 52 (Level 1) | CLIENT: BMD Urban | DATE: 5/07/2022 |  A&Y ASSOCIATES GEOTECHNICAL ENGINEERING CONSULTANTS |
| LOCATION: Mickleham | PROJECT No: 1120 0349-1 (SI01) | SITE PLAN SKETCH—NOT TO SCALE | |



Field Density Test Results AS1289.5.7.1

| | | | | | | | |
|----------------------------|--|-----------------------|-----------------------|----------------|---------|--|--|
| Client: | BMD Urban | | | Job No: | BMD2365 | | |
| Project: | Merrifield Estate - Stage 52 (Level 1) | | | Report: | 2 | | |
| Location: | Mickleham | | | | | | |
| Sample No | 4 | 5 | 6 | | | | |
| Date Tested | 6/07/2022 | 6/07/2022 | 6/07/2022 | | | | |
| Time Tested | AM | AM | AM | | | | |
| Test Location | Refer to Plan | Refer to Plan | Refer to Plan | | | | |
| Level/Layer | Layer 1 | Layer 1 | Layer 1 | | | | |
| Layer Thickness | mm 200 | mm 200 | mm 200 | | | | |
| Test Depth | mm 175 | mm 175 | mm 175 | | | | |
| Field Wet Density | t/m ³ 1.83 | t/m ³ 1.90 | t/m ³ 1.92 | | | | |
| Field Moisture Content | % 23.5 | % 22.1 | % 21.2 | | | | |
| Material: | Imported Clay | Imported Clay | Imported Clay | | | | |
| Oversize Material | WET, % 2.3 | WET, % 3.5 | WET, % 4.1 | | | | |
| Sieve Size | mm 19 | mm 19 | mm 19 | | | | |
| Peak Converted Wet Density | t/m ³ 1.88 | t/m ³ 1.95 | t/m ³ 1.96 | | | | |
| Optimum Moisture Content | % 22 | % 20 | % 22 | | | | |
| Moisture Ratio | % 107 | % 110.5 | % 96.5 | | | | |
| Moisture Variation | % 1.5 | % 2.0 | % -0.5 | | | | |
| from OMC | Wetter | Wetter | Drier | | | | |
| Density Ratio | % 97.0 | % 97.0 | % 97.5 | | | | |

| | | | |
|-----------------------|---------------------------------|-------------------------|----------------------|
| Specification: | 95% STD | Test Selection: | N/A |
| Notes: | Ref : 1120 0349-1 (SI02) | | |
| Test Method | AS1289 5.8.1, 5.7.1, 2.1.1, 1.1 | Sampling Method: | AS 1289 1.2.1 6.4(b) |



NATA Accredited Laboratory No. 20172

Accreditation for compliance with ISO/IEC 17025 - Testing

The results of tests, calibrations and/or measurements included

in this document, are traceable to Australian / National Standards


Approved Signatory:


David Burns

Date: 28/07/2022



Test Location

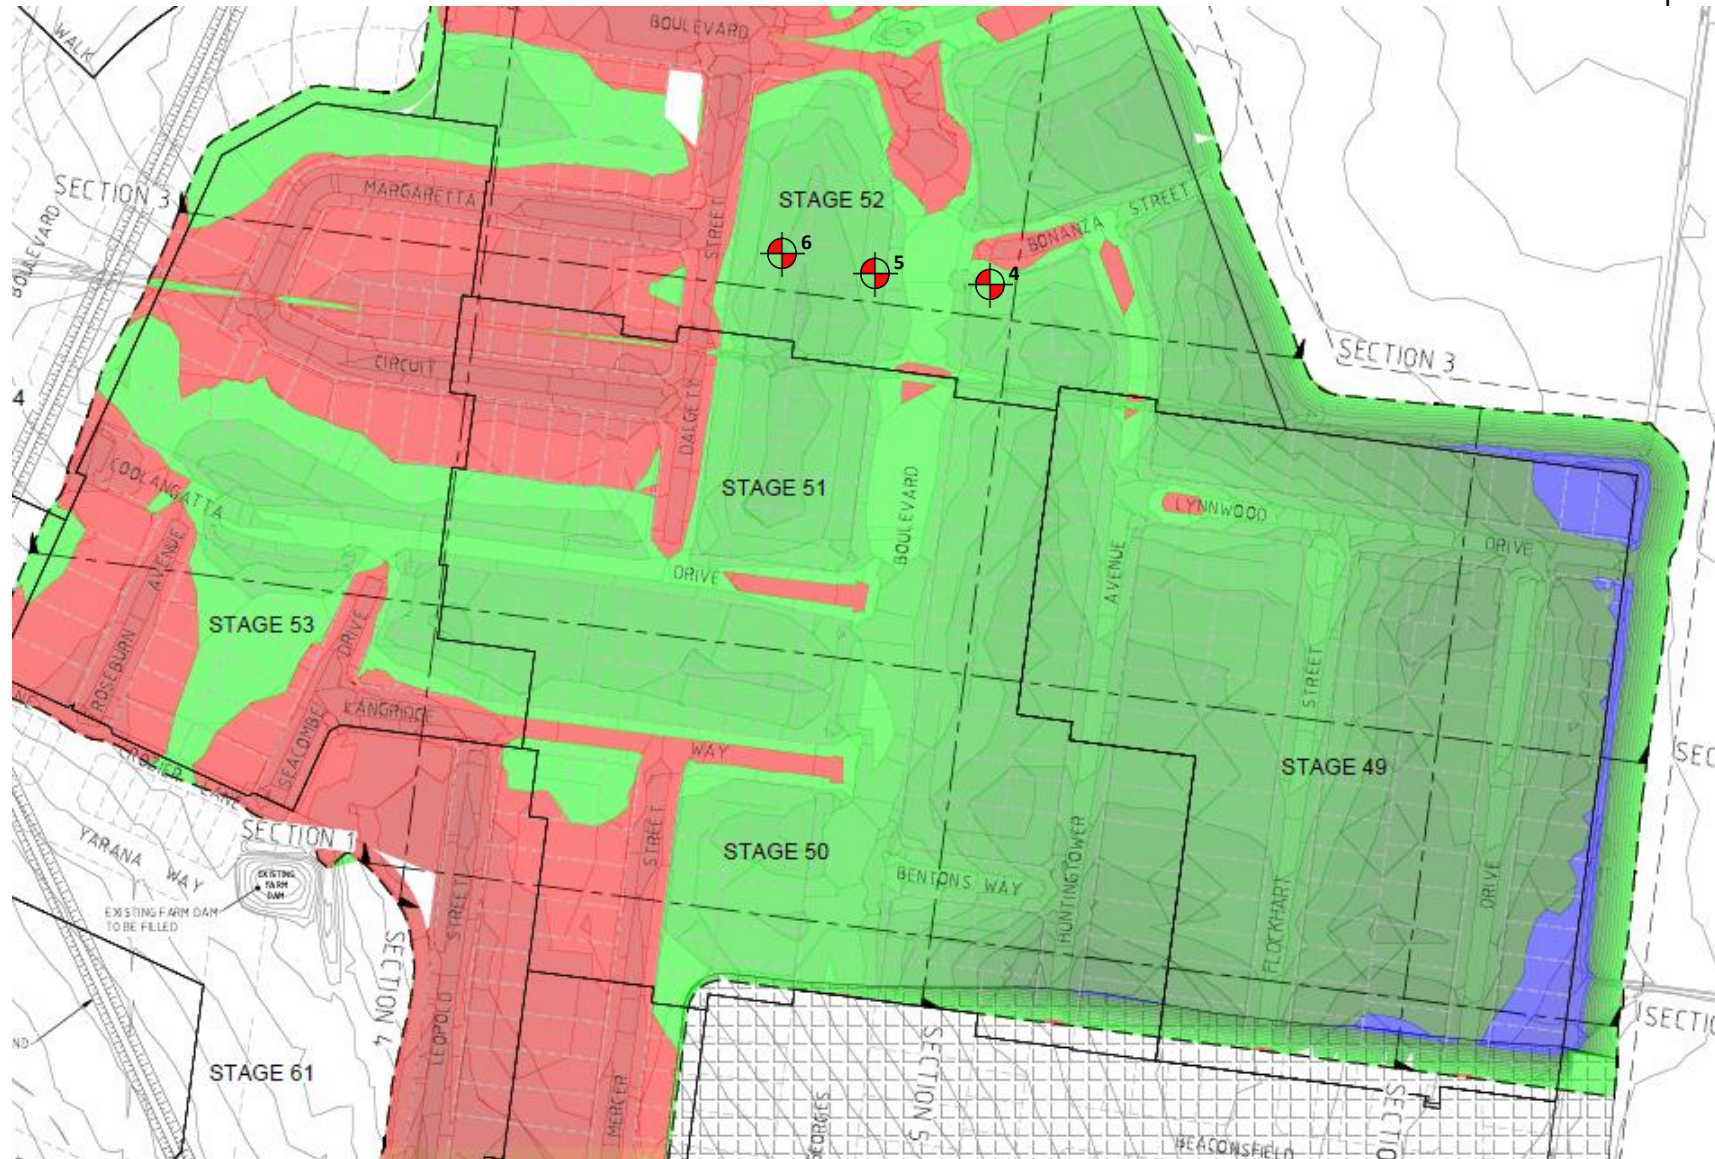

| | | | |
|--|-----------------------------------|-------------------------------|---|
| PROJECT: Merrifield Estate – Stage 52 (Level 1) | CLIENT: BMD Urban | DATE: 6/07/2022 |  A&Y ASSOCIATES GEOTECHNICAL ENGINEERING CONSULTANTS |
| LOCATION: Mickleham | PROJECT No: 1120 0349-1 (SI02) | SITE PLAN SKETCH—NOT TO SCALE | |

Field Density Test Results AS1289.5.7.1

A & Y Associates Pty Ltd
5/16 Network Drive
Truganina VIC 3029
PH: 0400 413 531
info@ayassociates.com.au

| | | | | | | | |
|------------------|--|--|--|----------------|---------|--|--|
| Client: | BMD Urban | | | Job No: | BMD2365 | | |
| Project: | Merrifield Estate - Stage 52 (Level 1) | | | Report: | 3 | | |
| Location: | Mickleham | | | | | | |

| | | | | | | |
|-------------|-----------|-----------|-----------|--|--|--|
| Sample No | 7 | 8 | 9 | | | |
| Date Tested | 7/07/2022 | 7/07/2022 | 7/07/2022 | | | |
| Time Tested | AM | AM | AM | | | |

| | | | | | | |
|------------------------|-----------------------|-----------------------|-----------------------|--|--|--|
| Test Location | Refer to Plan | Refer to Plan | Refer to Plan | | | |
| Level/Layer | Layer 2 | Layer 2 | Layer 2 | | | |
| Layer Thickness | mm 200 | mm 200 | mm 200 | | | |
| Test Depth | mm 175 | mm 175 | mm 175 | | | |
| Field Wet Density | t/m ³ 1.95 | t/m ³ 1.82 | t/m ³ 1.83 | | | |
| Field Moisture Content | % 21.9 | % 24.6 | % 23.3 | | | |
| Material: | Imported Clay | Imported Clay | Imported Clay | | | |

| | | | | | | |
|----------------------------|-----------------------|-----------------------|-----------------------|--|--|--|
| Oversize Material | WET, % 4.5 | WET, % 2.1 | WET, % 3.6 | | | |
| Sieve Size | mm 19 | mm 19 | mm 19 | | | |
| Peak Converted Wet Density | t/m ³ 2.00 | t/m ³ 1.87 | t/m ³ 1.86 | | | |
| Optimum Moisture Content | % 22.5 | % 23 | % 21.5 | | | |

| | | | | | | |
|---------------------------|--------|--------|---------|--|--|--|
| Moisture Ratio | % 97.5 | % 107 | % 108.5 | | | |
| Moisture Variation | % -0.5 | % 1.5 | % 2.0 | | | |
| from OMC | Drier | Wetter | Wetter | | | |
| Density Ratio | % 97.0 | % 97.0 | % 97.5 | | | |

| | | | |
|-----------------------|---------------------------------|-------------------------|----------------------|
| Specification: | 95% STD | Test Selection: | N/A |
| Notes: | Ref : 1120 0349-1 (SI03) | | |
| Test Method | AS1289 5.8.1, 5.7.1, 2.1.1, 1.1 | Sampling Method: | AS 1289 1.2.1 6.4(b) |





NATA Accredited Laboratory No. 20172
Accreditation for compliance with ISO/IEC 17025 - Testing
The results of tests, calibrations and/or measurements included
in this document, are traceable to Australian / National Standards

Approved Signatory:



David Burns
Date: 28/07/2022

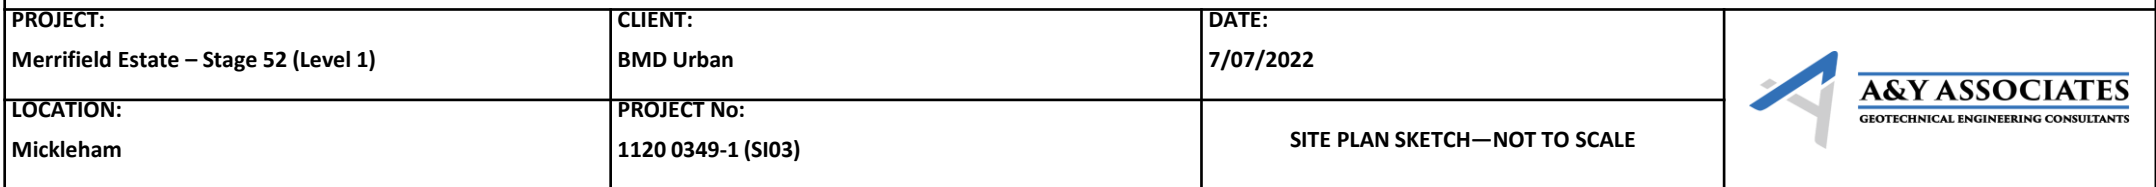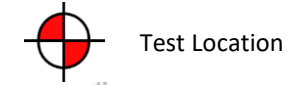

Field Density Test Results AS1289.5.7.1

A & Y Associates Pty Ltd
5/16 Network Drive
Truganina VIC 3029
PH: 0400 413 531
info@ayassociates.com.au

| | | | | | | |
|----------------------------|--|-----------------------|-----------------------|----------------|---------|--|
| Client: | BMD Urban | | | Job No: | BMD2365 | |
| Project: | Merrifield Estate - Stage 52 (Level 1) | | | Report: | 4 | |
| Location: | Mickleham | | | | | |
| Sample No | 10 | 11 | 12 | | | |
| Date Tested | 8/07/2022 | 8/07/2022 | 8/07/2022 | | | |
| Time Tested | AM | AM | AM | | | |
| Test Location | Refer to Plan | Refer to Plan | Refer to Plan | | | |
| Level/Layer | Layer 2 | Layer 2 | Layer 2 | | | |
| Layer Thickness | mm 200 | mm 200 | mm 200 | | | |
| Test Depth | mm 175 | mm 175 | mm 175 | | | |
| Field Wet Density | t/m ³ 1.82 | t/m ³ 1.91 | t/m ³ 1.83 | | | |
| Field Moisture Content | % 23.3 | % 24.7 | % 23.5 | | | |
| Material: | Imported Clay | Imported Clay | Imported Clay | | | |
| Oversize Material | WET, % 2.8 | WET, % 2.1 | WET, % 2.6 | | | |
| Sieve Size | mm 19 | mm 19 | mm 19 | | | |
| Peak Converted Wet Density | t/m ³ 1.87 | t/m ³ 1.99 | t/m ³ 1.86 | | | |
| Optimum Moisture Content | % 21.5 | % 23 | % 21.5 | | | |
| Moisture Ratio | % 108.5 | % 107.5 | % 109.5 | | | |
| Moisture Variation | % 1.5 | % 1.5 | % 2.0 | | | |
| from OMC | Wetter | Wetter | Wetter | | | |
| Density Ratio | % 97.0 | % 95.5 | % 98.0 | | | |

| | | | |
|-----------------------|---------------------------------|-------------------------|----------------------|
| Specification: | 95% STD | Test Selection: | N/A |
| Notes: | Ref : 1120 0349-1 (SI04) | | |
| Test Method | AS1289 5.8.1, 5.7.1, 2.1.1, 1.1 | Sampling Method: | AS 1289 1.2.1 6.4(b) |



NATA Accredited Laboratory No. 20172
Accreditation for compliance with ISO/IEC 17025 - Testing
The results of tests, calibrations and/or measurements included
in this document, are traceable to Australian / National Standards

Approved Signatory:





David Burns
28/07/2022

Date:



Test Location

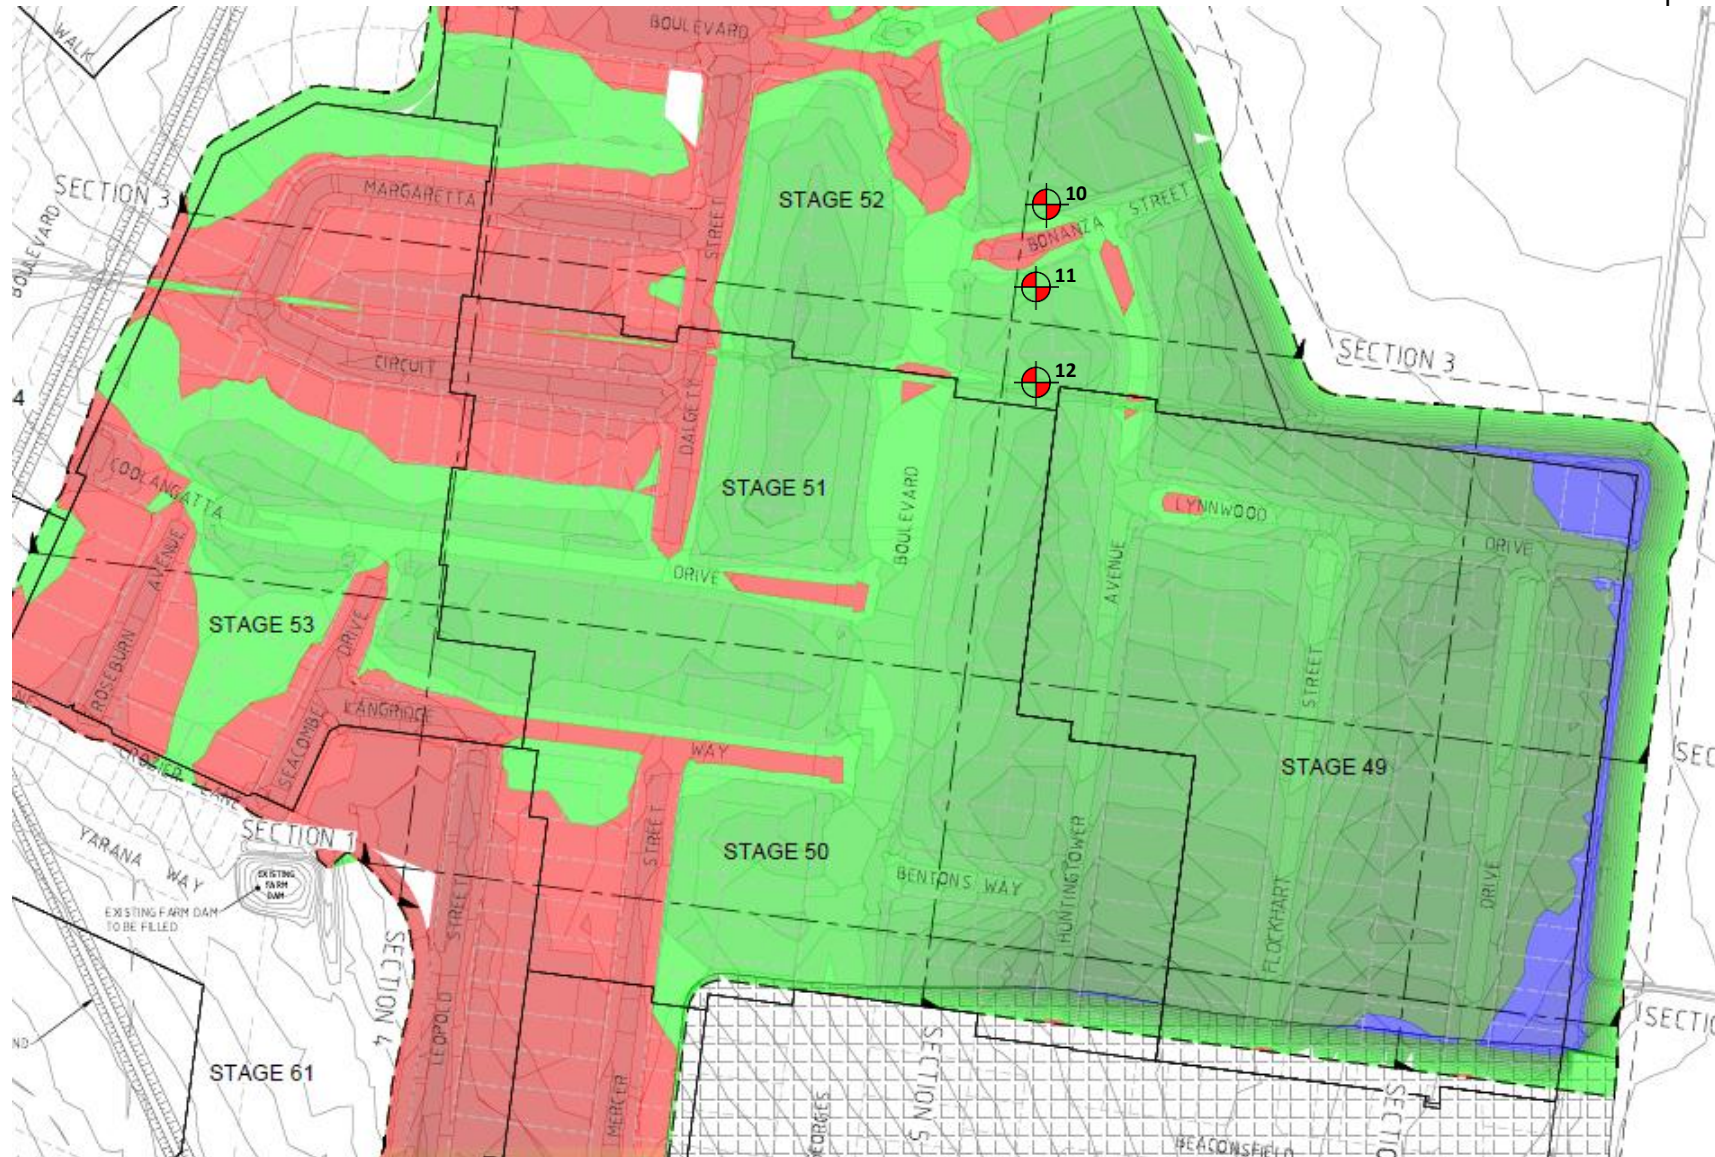

| | | | |
|--|-----------------------------------|-------------------------------|---|
| PROJECT: Merrifield Estate – Stage 52 (Level 1) | CLIENT: BMD Urban | DATE: 8/07/2022 |  A&Y ASSOCIATES GEOTECHNICAL ENGINEERING CONSULTANTS |
| LOCATION: Mickleham | PROJECT No: 1120 0349-1 (SI04) | SITE PLAN SKETCH—NOT TO SCALE | |



Field Density Test Results AS1289.5.7.1

| | | | | | | |
|----------------------------|--|-----------------------|-----------------------|----------------|---------|--|
| Client: | BMD Urban | | | Job No: | BMD2365 | |
| Project: | Merrifield Estate - Stage 52 (Level 1) | | | Report: | 5 | |
| Location: | Mickleham | | | | | |
| Sample No | 13 | 14 | 15 | | | |
| Date Tested | 01/09/2022 | 01/09/2022 | 01/09/2022 | | | |
| Time Tested | AM | AM | AM | | | |
| Test Location | Refer to Plan | Refer to Plan | Refer to Plan | | | |
| Level/Layer | 1 | 1 | 1 | | | |
| Layer Thickness | mm 200 | mm 200 | mm 200 | | | |
| Test Depth | mm 175 | mm 175 | mm 175 | | | |
| Field Wet Density | t/m ³ 1.85 | t/m ³ 1.82 | t/m ³ 1.82 | | | |
| Field Moisture Content | % 24.1 | % 25.3 | % 25.0 | | | |
| Material: | Imported Clay | Imported Clay | Imported Clay | | | |
| Oversize Material | WET, % 0.0 | WET, % 0.0 | WET, % 0.0 | | | |
| Sieve Size | mm 19 | mm 19 | mm 19 | | | |
| Peak Converted Wet Density | t/m ³ 1.88 | t/m ³ 1.86 | t/m ³ 1.86 | | | |
| Optimum Moisture Content | % 22.5 | % 23.5 | % 23.5 | | | |
| Moisture Ratio | % 107 | % 107.5 | % 106.5 | | | |
| Moisture Variation | % 1.5 | % 1.5 | % 1.5 | | | |
| from OMC | Wetter | Wetter | Wetter | | | |
| Density Ratio | % 98.5 | % 98.0 | % 97.5 | | | |

| | | | |
|-----------------------|---------------------------------|-------------------------|----------------------|
| Specification: | 95% STD | Test Selection: | N/A |
| Notes: | Ref : 1120 0349-1 (SI05) | | |
| Test Method | AS1289 5.8.1, 5.7.1, 2.1.1, 1.1 | Sampling Method: | AS 1289 1.2.1 6.4(b) |



NATA Accredited Laboratory No. 20172

Accreditation for compliance with ISO/IEC 17025 - Testing

The results of tests, calibrations and/or measurements included

in this document, are traceable to Australian / National Standards

Approved Signatory:


David Burns


Date:

13/10/2022



Test Location

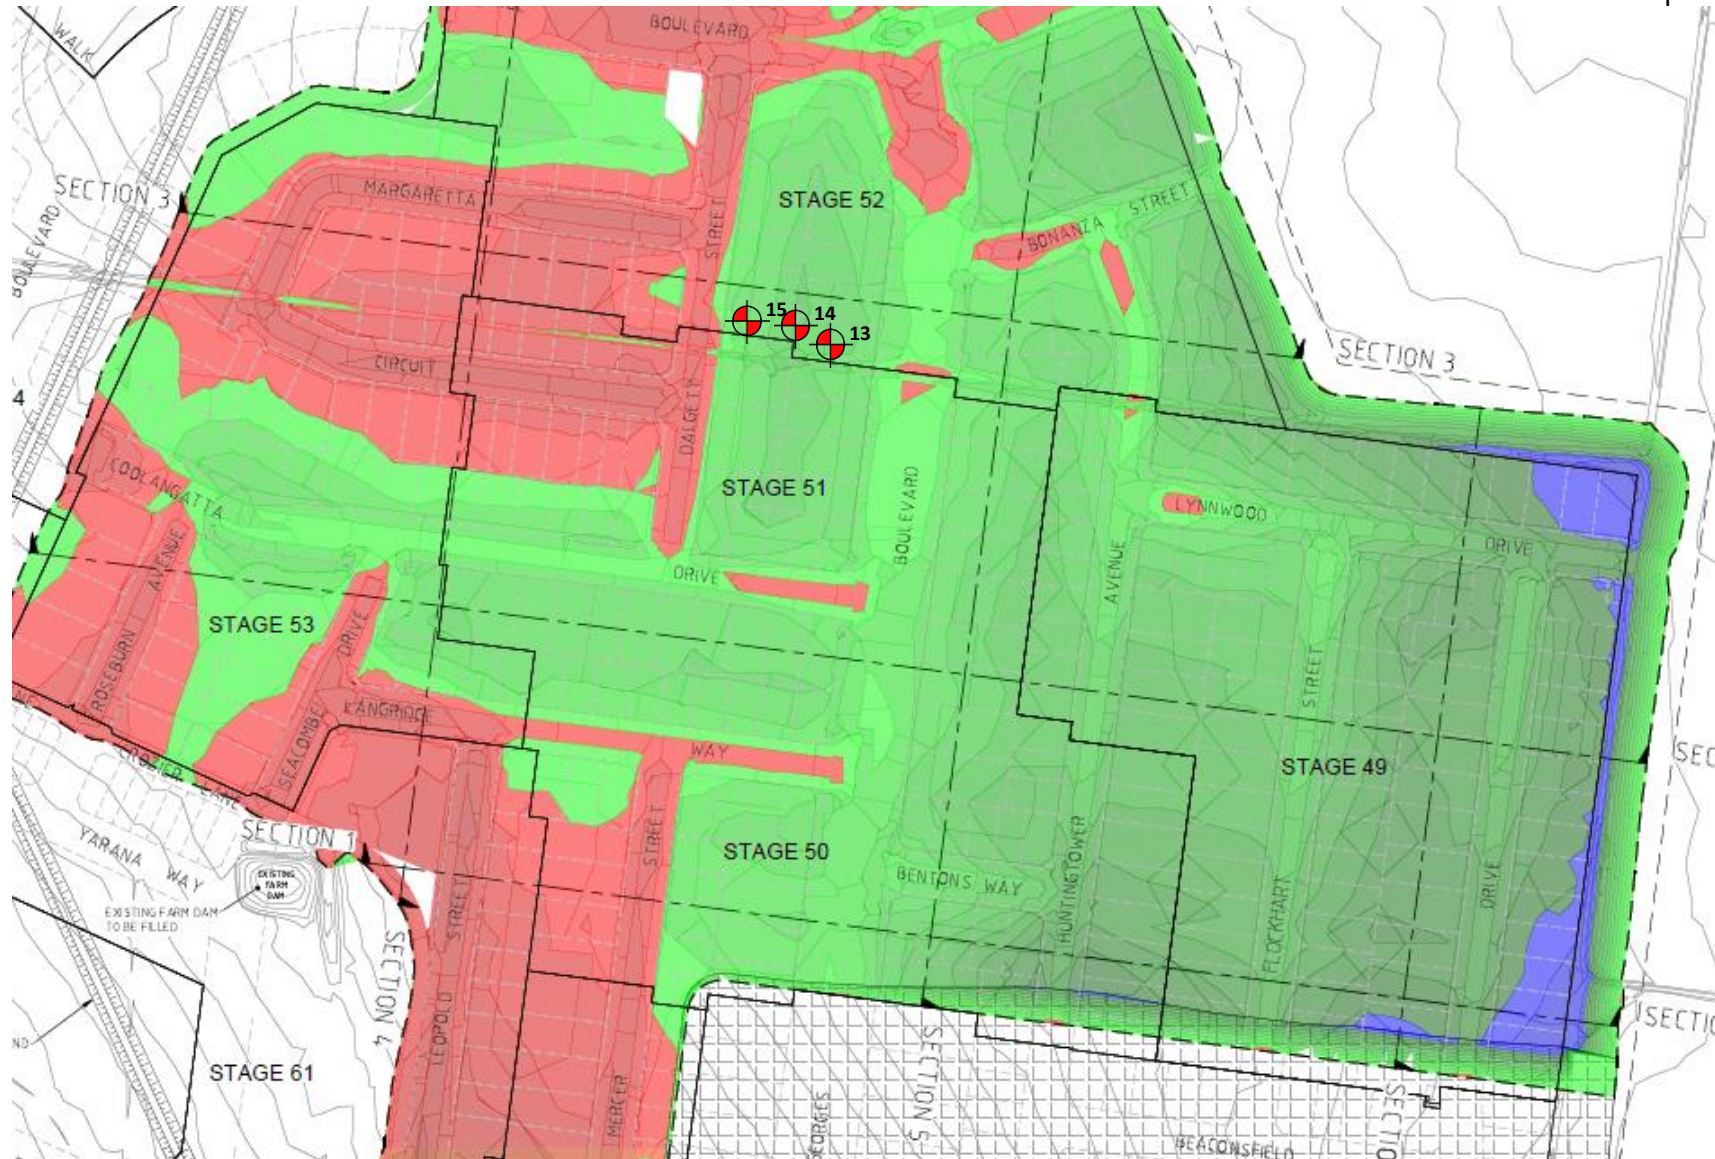

| | | | |
|--|-----------------------------------|-------------------------------|---|
| PROJECT: Merrifield Estate – Stage 52 (Level 1) | CLIENT: BMD Urban | DATE: 01/09/2022 |  A&Y ASSOCIATES GEOTECHNICAL ENGINEERING CONSULTANTS |
| LOCATION: Mickleham | PROJECT No: 1120 0349-1 (SI05) | SITE PLAN SKETCH—NOT TO SCALE | |

Field Density Test Results AS1289.5.7.1

A & Y Associates Pty Ltd
5/16 Network Drive
Truganina VIC 3029
PH: 0400 413 531
info@ayassociates.com.au

| | | | | | | |
|------------------|--|--|--|----------------|---------|--|
| Client: | BMD Urban | | | Job No: | BMD2365 | |
| Project: | Merrifield Estate - Stage 52 (Level 1) | | | Report: | 6 | |
| Location: | Mickleham | | | | | |

| | | | | | | |
|-------------|------------|------------|------------|--|--|--|
| Sample No | 16 | 17 | 18 | | | |
| Date Tested | 05/09/2022 | 05/09/2022 | 05/09/2022 | | | |
| Time Tested | AM | AM | AM | | | |

| | | | | | | |
|------------------------|-----------------------|-----------------------|-----------------------|--|--|--|
| Test Location | Refer to Plan | Refer to Plan | Refer to Plan | | | |
| Level/Layer | 1 | 1 | 1 | | | |
| Layer Thickness | mm 200 | mm 200 | mm 200 | | | |
| Test Depth | mm 175 | mm 175 | mm 175 | | | |
| Field Wet Density | t/m ³ 1.82 | t/m ³ 1.80 | t/m ³ 1.85 | | | |
| Field Moisture Content | % 24.8 | % 25.3 | % 24.1 | | | |
| Material: | Imported Clay Fill | Imported Clay Fill | Imported Clay Fill | | | |

| | | | | | | |
|----------------------------|-----------------------|-----------------------|-----------------------|--|--|--|
| Oversize Material | WET, % 0.0 | WET, % 0.0 | WET, % 0.0 | | | |
| Sieve Size | mm 19 | mm 19 | mm 19 | | | |
| Peak Converted Wet Density | t/m ³ 1.85 | t/m ³ 1.84 | t/m ³ 1.89 | | | |
| Optimum Moisture Content | % 23 | % 23.5 | % 22.5 | | | |

| | | | | | | |
|---------------------------|--------|--------|--------|--|--|--|
| Moisture Ratio | % 108 | % 108 | % 107 | | | |
| Moisture Variation | % 1.5 | % 2.0 | % 1.5 | | | |
| from OMC | Wetter | Wetter | Wetter | | | |
| Density Ratio | % 98.5 | % 98.0 | % 97.5 | | | |

| | | | |
|-----------------------|---------------------------------|-------------------------|----------------------|
| Specification: | 95% STD | Test Selection: | N/A |
| Notes: | Ref : 1120 0349-1 (SI06) | | |
| Test Method | AS1289 5.8.1, 5.7.1, 2.1.1, 1.1 | Sampling Method: | AS 1289 1.2.1 6.4(b) |



NATA Accredited Laboratory No. 20172
Accreditation for compliance with ISO/IEC 17025 - Testing
The results of tests, calibrations and/or measurements included
in this document, are traceable to Australian / National Standards


Approved Signatory:




David Burns
Date: 13/10/2022



Test Location

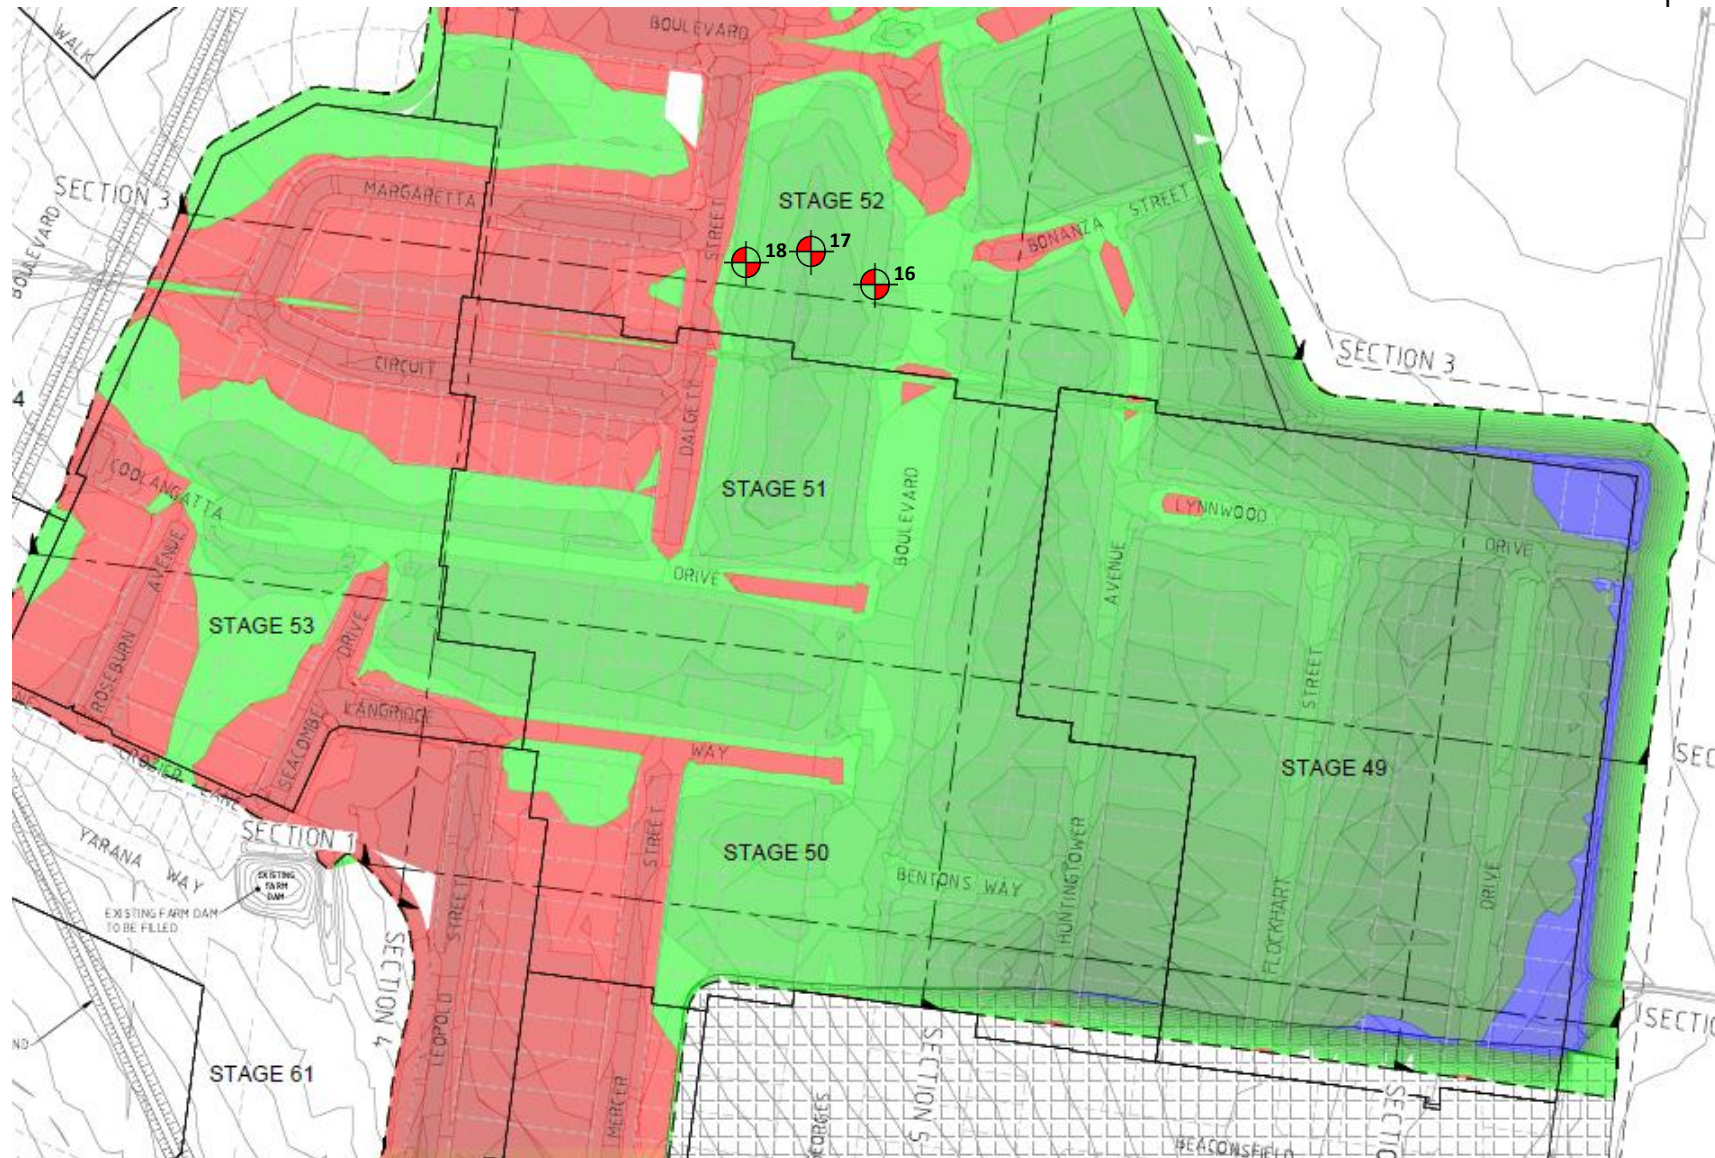

| | | | |
|--|-----------------------------------|-------------------------------|---|
| PROJECT: Merrifield Estate – Stage 52 (Level 1) | CLIENT: BMD Urban | DATE: 05/09/2022 |  A&Y ASSOCIATES GEOTECHNICAL ENGINEERING CONSULTANTS |
| LOCATION: Mickleham | PROJECT No: 1120 0349-1 (SI06) | SITE PLAN SKETCH—NOT TO SCALE | |

Field Density Test Results AS1289.5.7.1

A & Y Associates Pty Ltd
5/16 Network Drive
Truganina VIC 3029
PH: 0400 413 531
info@ayassociates.com.au

| | | | | | | |
|------------------|--|--|--|----------------|---------|--|
| Client: | BMD Urban | | | Job No: | BMD2365 | |
| Project: | Merrifield Estate - Stage 52 (Level 1) | | | Report: | 7 | |
| Location: | Mickleham | | | | | |



| | | | | | | |
|-------------|------------|------------|------------|--|--|--|
| Sample No | 19 | 20 | 21 | | | |
| Date Tested | 03/10/2022 | 03/10/2022 | 03/10/2022 | | | |
| Time Tested | AM | AM | AM | | | |

| | | | | | | |
|------------------------|-----------------------|-----------------------|-----------------------|--|--|--|
| Test Location | Refer to Plan | Refer to Plan | Refer to Plan | | | |
| Level/Layer | 2 | 2 | 2 | | | |
| Layer Thickness | mm 200 | mm 200 | mm 200 | | | |
| Test Depth | mm 175 | mm 175 | mm 175 | | | |
| Field Wet Density | t/m ³ 1.82 | t/m ³ 1.86 | t/m ³ 1.85 | | | |
| Field Moisture Content | % 24.9 | % 25.1 | % 24.5 | | | |
| Material: | Imported Clay Fill | Imported Clay Fill | Imported Clay Fill | | | |

| | | | | | | |
|----------------------------|-----------------------|-----------------------|-----------------------|--|--|--|
| Oversize Material | WET, % 0.0 | WET, % 0.0 | WET, % 0.0 | | | |
| Sieve Size | mm 19 | mm 19 | mm 19 | | | |
| Peak Converted Wet Density | t/m ³ 1.84 | t/m ³ 1.88 | t/m ³ 1.88 | | | |
| Optimum Moisture Content | % 23 | % 26 | % 22.5 | | | |


| | | | | | | |
|---------------------------|--------|--------|--------|--|--|--|
| Moisture Ratio | % 108 | % 96.5 | % 109 | | | |
| Moisture Variation | % 2.0 | % -1.0 | % 2.0 | | | |
| from OMC | Wetter | Drier | Wetter | | | |
| Density Ratio | % 99.0 | % 99.0 | % 98.5 | | | |


| | | | |
|-----------------------|---------------------------------|-------------------------|----------------------|
| Specification: | 95% STD | Test Selection: | N/A |
| Notes: | Ref : 1120 0349-1 (SI07) | | |
| Test Method | AS1289 5.8.1, 5.7.1, 2.1.1, 1.1 | Sampling Method: | AS 1289 1.2.1 6.4(b) |

| | | |
|---|--|---|
|  NATA WORLD RECOGNISED ACCREDITATION | NATA Accredited Laboratory No. 20172 | Approved Signatory:  David Burns Date: 13/10/2022 |
| | Accreditation for compliance with ISO/IEC 17025 - Testing | |
| | The results of tests, calibrations and/or measurements included in this document, are traceable to Australian / National Standards | |



Test Location

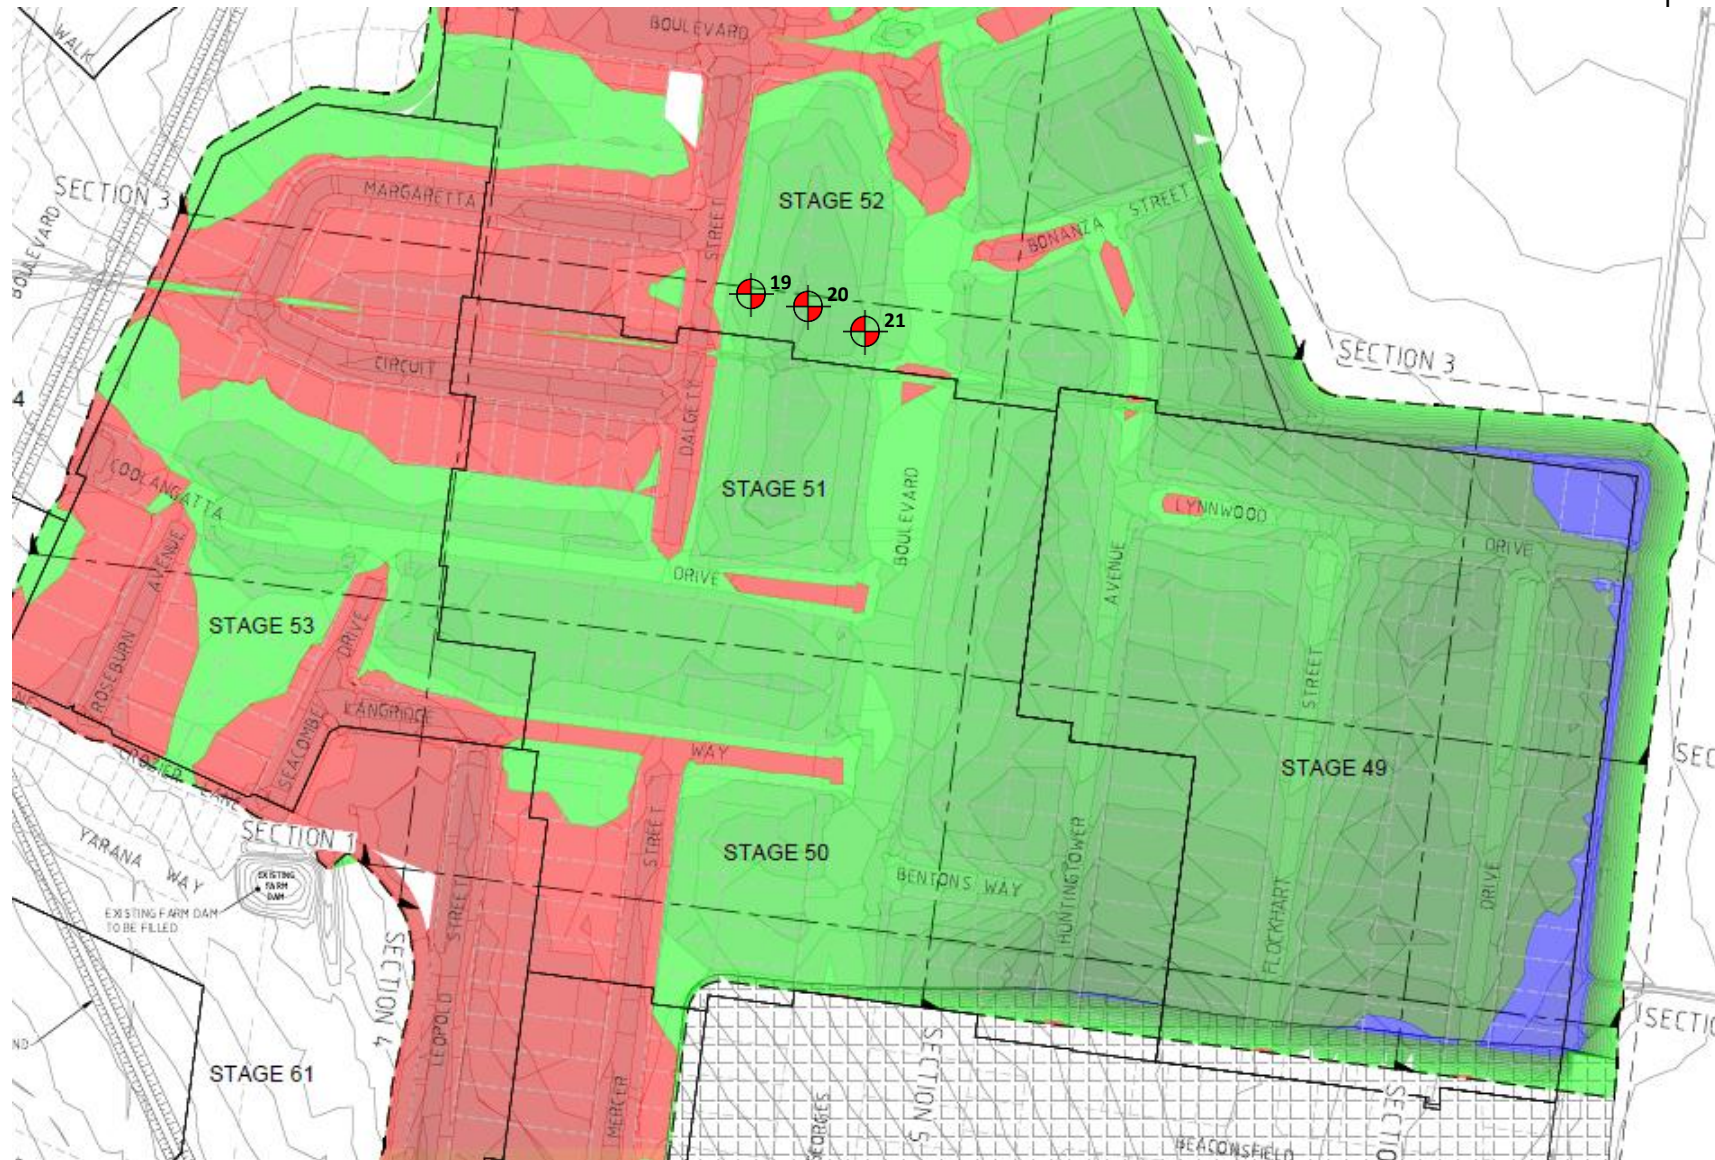

| | | | |
|--|-----------------------------------|-------------------------------|---|
| PROJECT: Merrifield Estate – Stage 52 (Level 1) | CLIENT: BMD Urban | DATE: 03/10/2022 |  A&Y ASSOCIATES GEOTECHNICAL ENGINEERING CONSULTANTS |
| LOCATION: Mickleham | PROJECT No: 1120 0349-1 (SI07) | SITE PLAN SKETCH—NOT TO SCALE | |

Field Density Test Results AS1289.5.7.1

A & Y Associates Pty Ltd
5/16 Network Drive
Truganina VIC 3029
PH: 0400 413 531
info@ayassociates.com.au

| | | | | | | |
|------------------|--|--|--|----------------|---------|--|
| Client: | BMD Urban | | | Job No: | BMD2365 | |
| Project: | Merrifield Estate - Stage 52 (Level 1) | | | Report: | 8 | |
| Location: | Mickleham | | | | | |



| | | | | | | |
|-------------|------------|------------|------------|--|--|--|
| Sample No | 22 | 23 | 24 | | | |
| Date Tested | 06/02/2023 | 06/02/2023 | 06/02/2023 | | | |
| Time Tested | PM | PM | PM | | | |

| | | | | | | |
|------------------------|-----------------------|-----------------------|-----------------------|--|--|--|
| Test Location | Refer to Plan | Refer to Plan | Refer to Plan | | | |
| Level/Layer | 3 | 3 | 3 | | | |
| Layer Thickness | mm 200 | mm 200 | mm 200 | | | |
| Test Depth | mm 175 | mm 175 | mm 175 | | | |
| Field Wet Density | t/m ³ 1.94 | t/m ³ 1.91 | t/m ³ 1.89 | | | |
| Field Moisture Content | % 20.0 | % 22.8 | % 23.3 | | | |
| Material: | Imported Clay | Imported Clay | Imported Clay | | | |

| | | | | | | |
|----------------------------|-----------------------|-----------------------|-----------------------|--|--|--|
| Oversize Material | WET, % 4.0 | WET, % 3.6 | WET, % 2.4 | | | |
| Sieve Size | mm 19 | mm 19 | mm 19 | | | |
| Peak Converted Wet Density | t/m ³ 1.99 | t/m ³ 1.97 | t/m ³ 1.93 | | | |
| Optimum Moisture Content | % 18.5 | % 23.5 | % 23.5 | | | |

| | | | | | | |
|---------------------------|--------|--------|--------|--|--|--|
| Moisture Ratio | % 108 | % 97 | % 99 | | | |
| Moisture Variation | % 1.5 | % -0.5 | % -0.5 | | | |
| from OMC | Wetter | Drier | Drier | | | |
| Density Ratio | % 97.0 | % 97.0 | % 98.0 | | | |

| | | | |
|-----------------------|---------------------------------|-------------------------|----------------------|
| Specification: | 95% STD | Test Selection: | N/A |
| Notes: | Ref: 1120 0349-1 (SI08) | | |
| Test Method | AS1289 5.8.1, 5.7.1, 2.1.1, 1.1 | Sampling Method: | AS 1289 1.2.1 6.4(b) |

| | | |
|---|---|---|
|  NATA WORLD RECOGNISED ACCREDITATION | NATA Accredited Laboratory No. 20172 Accreditation for compliance with ISO/IEC 17025 - Testing | Approved Signatory:  Date: 20/02/2023 |
| | | |



NOTE: All Terms are in Accordance with the Existing Schedule (if any)

| | | | |
|-------------------------------|--------------|-------------------|-----------|
| PROJECT | | HUME CITY COUNCIL | |
| SUBJECT | | LAYOUT PLAN | |
| MERRIFIELD LIVING - SECTION E | | | |
| BULK EARTHWORKS - STAGE 49-53 | | | |
| MICKLEHAM | | | |
| DATE | CONSTRUCTION | SCALE | 1:7040.49 |
| | 366 F1 | PROJECT NO. | EW201 |



A&Y ASSOCIATES
GEOTECHNICAL ENGINEERING CONSULTANTS

Field Density Test Results AS1289.5.7.1

A & Y Associates Pty Ltd
5/16 Network Drive
Truganina VIC 3029
PH: 0400 413 531
info@ayassociates.com.au

| | | | | | | |
|------------------|--|--|--|----------------|---------|--|
| Client: | BMD Urban | | | Job No: | BMD2365 | |
| Project: | Merrifield Estate - Stage 52 (Level 1) | | | Report: | 9 | |
| Location: | Mickleham | | | | | |



| | | | | | | |
|-------------|------------|------------|------------|--|--|--|
| Sample No | 25 | 26 | 27 | | | |
| Date Tested | 07/02/2023 | 07/02/2023 | 07/02/2023 | | | |
| Time Tested | AM | AM | AM | | | |

| | | | | | | |
|------------------------|-----------------------|-----------------------|-----------------------|--|--|--|
| Test Location | Refer to Plan | Refer to Plan | Refer to Plan | | | |
| Level/Layer | 1 | 1 | 1 | | | |
| Layer Thickness | mm 200 | mm 200 | mm 200 | | | |
| Test Depth | mm 175 | mm 175 | mm 175 | | | |
| Field Wet Density | t/m ³ 1.87 | t/m ³ 1.84 | t/m ³ 1.83 | | | |
| Field Moisture Content | % 24.1 | % 24.8 | % 25.3 | | | |
| Material: | Imported Clay | Imported Clay | Imported Clay | | | |

| | | | | | | |
|----------------------------|------------------|------|------|------|--|--|
| Oversize Material | WET, % | 0.0 | 0.0 | 0.0 | | |
| Sieve Size | mm | 19 | 19 | 19 | | |
| Peak Converted Wet Density | t/m ³ | 1.90 | 1.86 | 1.85 | | |
| Optimum Moisture Content | % | 25 | 25.5 | 26 | | |


| | | | | | | |
|---------------------------|---|-------|-------|-------|--|--|
| Moisture Ratio | % | 96.5 | 97 | 97.5 | | |
| Moisture Variation | % | -0.5 | -0.5 | -0.5 | | |
| from OMC | | Drier | Drier | Drier | | |
| Density Ratio | % | 98.5 | 98.5 | 98.5 | | |

| | | | |
|-----------------------|---------------------------------|-------------------------|----------------------|
| Specification: | 95% STD | Test Selection: | N/A |
| Notes: | Ref: 1120 0349-1 (SI09) | | |
| Test Method | AS1289 5.8.1, 5.7.1, 2.1.1, 1.1 | Sampling Method: | AS 1289 1.2.1 6.4(b) |

| | | |
|---|---|---|
|  NATA WORLD RECOGNISED ACCREDITATION | NATA Accredited Laboratory No. 20172 Accreditation for compliance with ISO/IEC 17025 - Testing | Approved Signatory:  Date: 20/02/2023 |
| | | David Burns |



Test Location

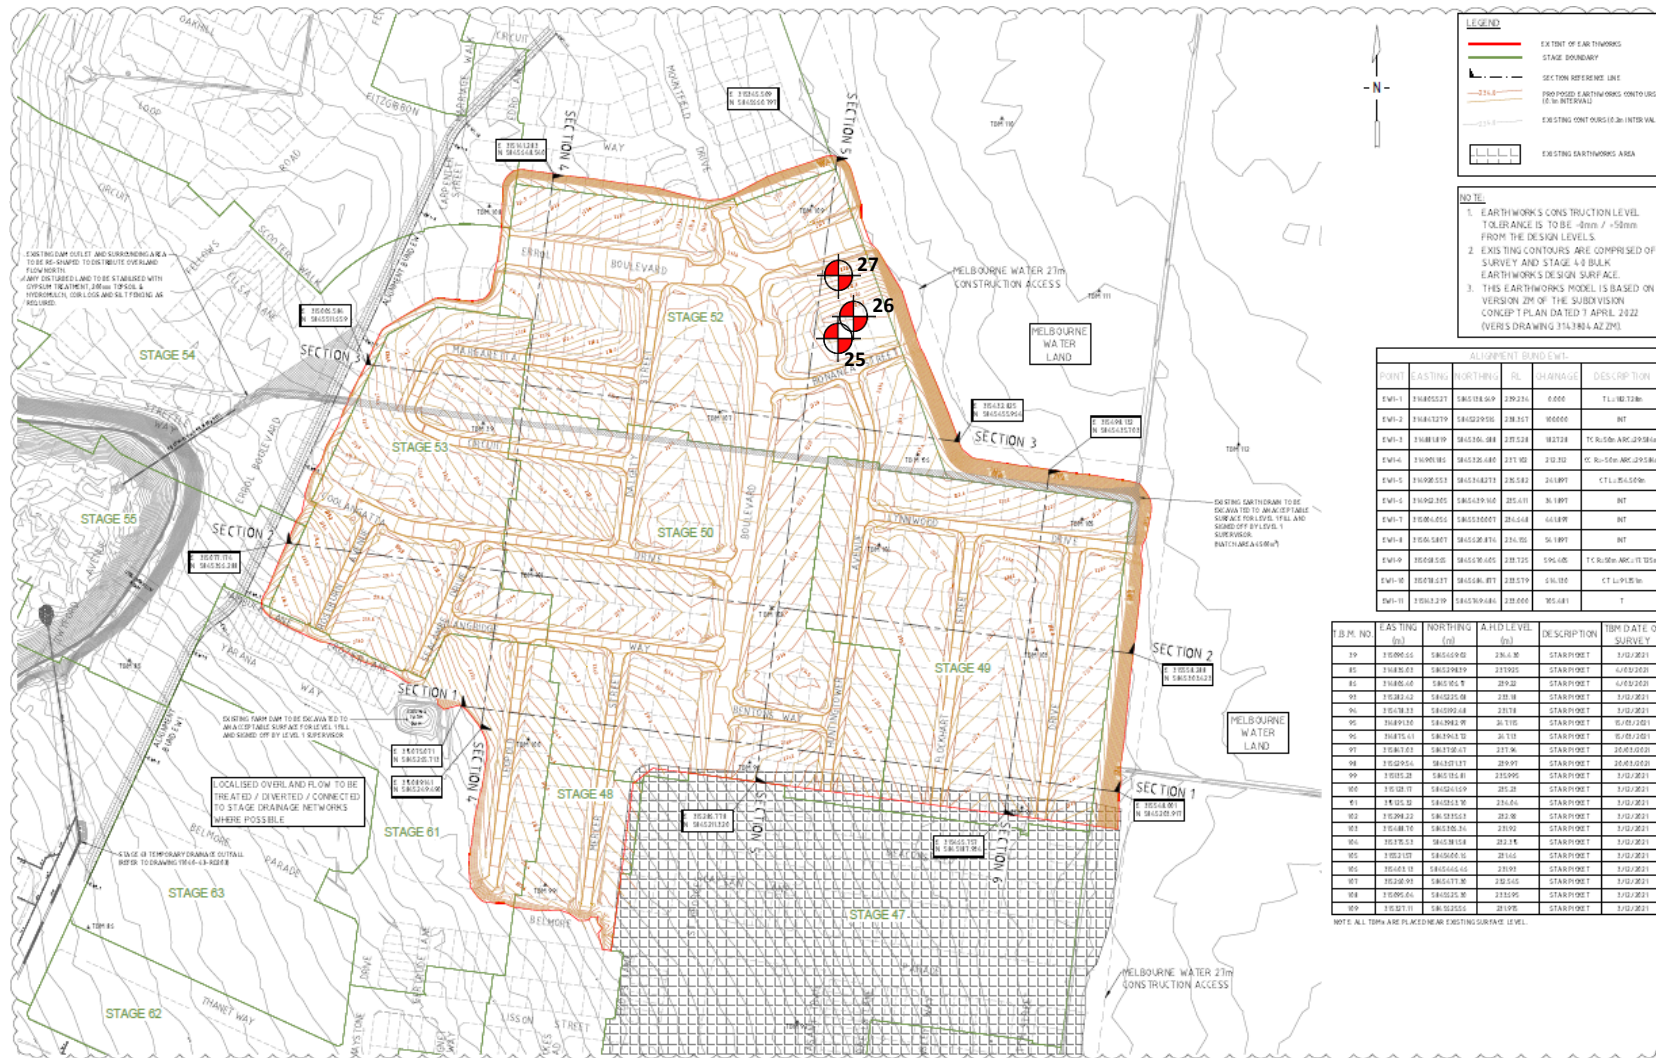




T. MUSTAC

P. MASEMAN

G. ROMANZ

1:1,000

0 10 20 30 40 50 60 70 80 90 100

merrifield

MAB gpc

verve

Ground Floor, 307-323 Waverley Road, Malvern East VIC 3145

TEL: 03 8573 1500 | verveprojects.com

© Verve Projects Pty Ltd.

HUME CITY COUNCIL

MERRIFIELD LIVING - SECTION E

BULK EARTHWORKS - STAGE 49-53

MICKLEHAM

CONSTRUCTION

366 F1

17040-49

EW201

1

| | | |
|--|-----------------------------------|-------------------------------|
| PROJECT: Merrifield Estate – Stage 52 (Level 1) | CLIENT: BMD Urban | DATE: 07/02/2023 |
| LOCATION: Mickleham | PROJECT No: 1120 0349-1 (SI09) | SITE PLAN SKETCH—NOT TO SCALE |



Field Density Test Results AS1289.5.7.1

A & Y Associates Pty Ltd
5/16 Network Drive
Truganina VIC 3029
PH: 0400 413 531
info@ayassociates.com.au

| | | | | | | |
|------------------|--|--|--|----------------|---------|--|
| Client: | BMD Urban | | | Job No: | BMD2365 | |
| Project: | Merrifield Estate - Stage 52 (Level 1) | | | Report: | 10 | |
| Location: | Mickleham | | | | | |



| | | | | | | |
|-------------|------------|------------|------------|--|--|--|
| Sample No | 28 | 29 | 30 | | | |
| Date Tested | 08/02/2023 | 08/02/2023 | 08/02/2023 | | | |
| Time Tested | AM | AM | AM | | | |

| | | | | | | |
|------------------------|-----------------------|-----------------------|-----------------------|--|--|--|
| Test Location | Refer to Plan | Refer to Plan | Refer to Plan | | | |
| Level/Layer | 1 | 1 | 1 | | | |
| Layer Thickness | mm 200 | mm 200 | mm 200 | | | |
| Test Depth | mm 175 | mm 175 | mm 175 | | | |
| Field Wet Density | t/m ³ 1.90 | t/m ³ 1.94 | t/m ³ 1.85 | | | |
| Field Moisture Content | % 22.8 | % 21.6 | % 24.4 | | | |
| Material: | Imported Clay | Imported Clay | Imported Clay | | | |

| | | | | | | |
|----------------------------|-----------------------|-----------------------|-----------------------|--|--|--|
| Oversize Material | WET, % 0.0 | WET, % 4.6 | WET, % 2.5 | | | |
| Sieve Size | mm 19 | mm 19 | mm 19 | | | |
| Peak Converted Wet Density | t/m ³ 1.96 | t/m ³ 2.02 | t/m ³ 1.89 | | | |
| Optimum Moisture Content | % 21 | % 21 | % 23 | | | |


| | | | | | | |
|---------------------------|---------|--------|--------|--|--|--|
| Moisture Ratio | % 108.5 | % 103 | % 106 | | | |
| Moisture Variation | % 2.0 | % 0.5 | % 1.5 | | | |
| from OMC | Wetter | Wetter | Wetter | | | |
| Density Ratio | % 97.0 | % 95.5 | % 97.0 | | | |

| | | | |
|-----------------------|---------------------------------|-------------------------|----------------------|
| Specification: | 95% STD | Test Selection: | N/A |
| Notes: | Ref: 1120 0349-1 (SI10) | | |
| Test Method | AS1289 5.8.1, 5.7.1, 2.1.1, 1.1 | Sampling Method: | AS 1289 1.2.1 6.4(b) |

| | | |
|---|---|---|
|  NATA WORLD RECOGNISED ACCREDITATION | NATA Accredited Laboratory No. 20172 Accreditation for compliance with ISO/IEC 17025 - Testing | Approved Signatory:  Date: 20/02/2023 |
| | | David Burns |



Test Location

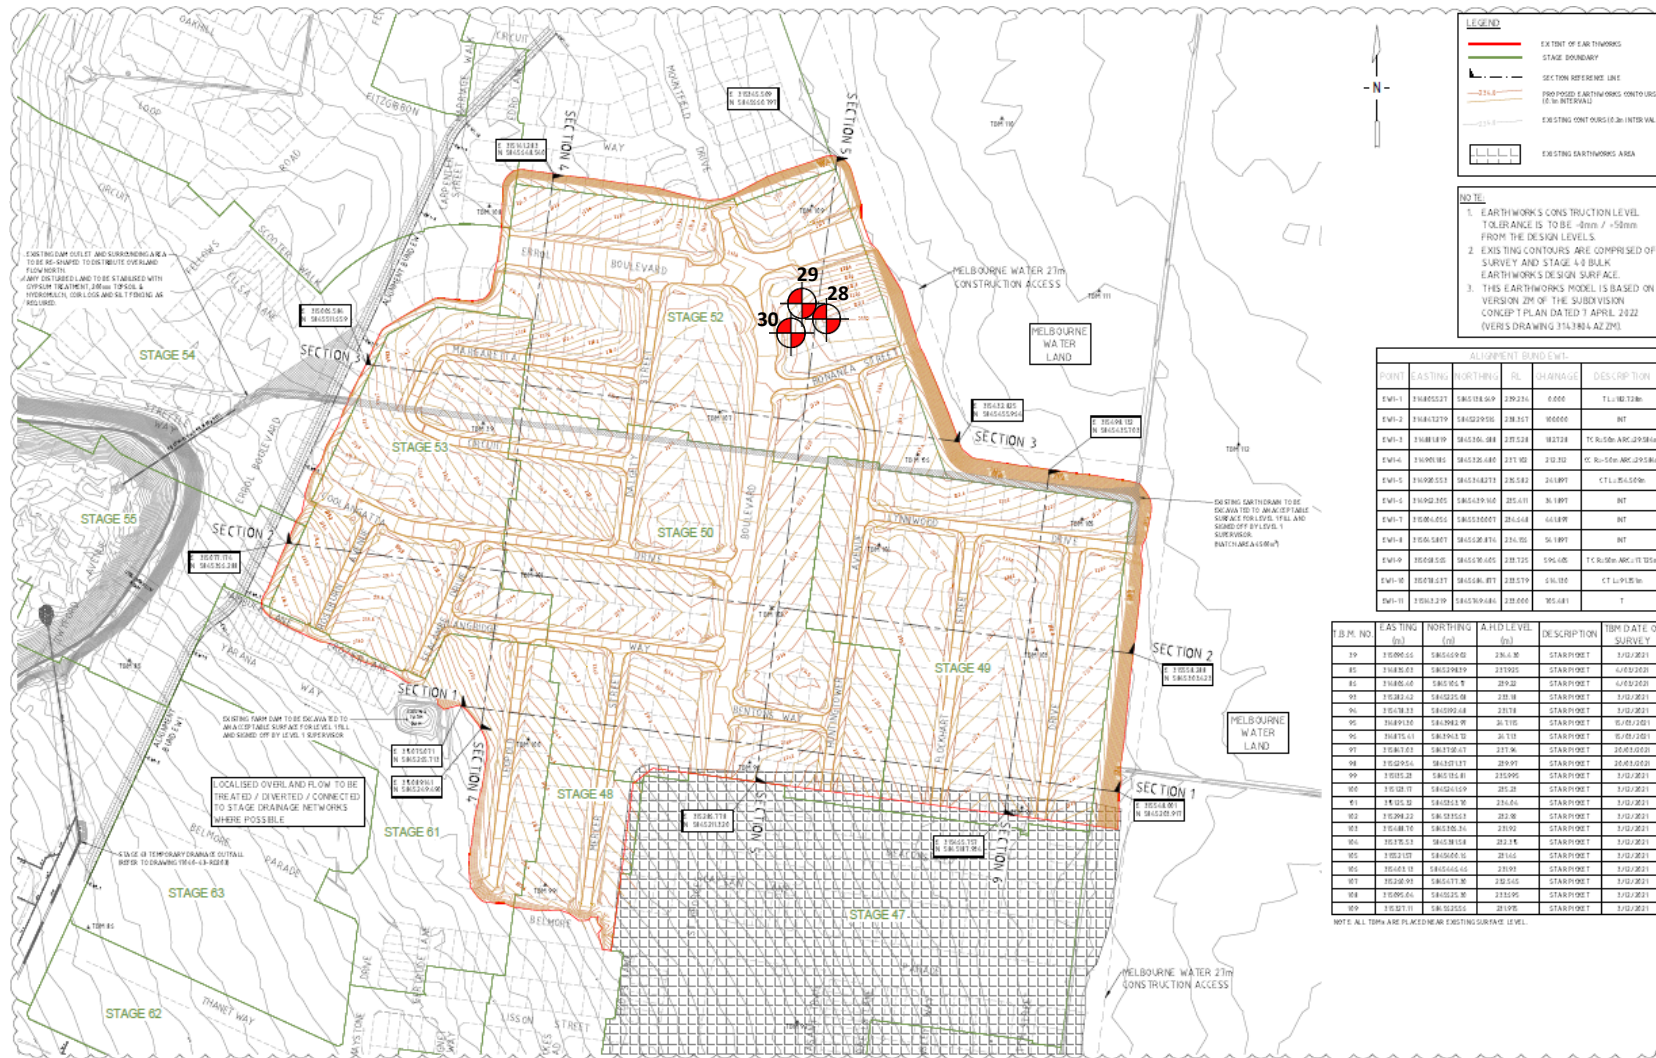

| | | | | | | | |
|-------------|--|---------|--|---|--|-------------------------------|--|
| T. MUSTAC | | 1:1,000 | | merrifield | | HUME CITY COUNCIL | |
| P. MASEMANN | | DATE | | MAB gpc | | PROJECT | |
| G. ROMANZ | | DATE | | Ground Floor, 307-323 Waverley Road, Mickleham VIC 3145 | | MERRIFIELD LIVING - SECTION E | |
| | | | | TEL: 03 8373 1500 | | BULK EARTHWORKS - STAGE 49-53 | |
| | | | | © Verve Projects Pty Ltd. | | MICKLEHAM | |
| | | | | | | CONSTRUCTION | |
| | | | | | | 366 F1 | |
| | | | | | | 17040-49 | |
| | | | | | | EW201 | |

| | |
|-----------|--|
| PROJECT: | Merrifield Estate – Stage 52 (Level 1) |
| LOCATION: | Mickleham |

| | |
|-------------|-------------------|
| CLIENT: | BMD Urban |
| PROJECT No: | 1120 0349-1 (S10) |

| | |
|-------------------------------|------------|
| DATE: | 08/02/2023 |
| SITE PLAN SKETCH—NOT TO SCALE | |



Field Density Test Results AS1289.5.7.1

A & Y Associates Pty Ltd
5/16 Network Drive
Truganina VIC 3029
PH: 0400 413 531
info@ayassociates.com.au

| | | | | | | |
|------------------|--|--|--|----------------|---------|--|
| Client: | BMD Urban | | | Job No: | BMD2365 | |
| Project: | Merrifield Estate - Stage 52 (Level 1) | | | Report: | 11 | |
| Location: | Mickleham | | | | | |



| | | | | | | |
|-------------|------------|------------|------------|--|--|--|
| Sample No | 31 | 32 | 33 | | | |
| Date Tested | 16/02/2023 | 16/02/2023 | 16/02/2023 | | | |
| Time Tested | PM | PM | PM | | | |

| | | | | | | |
|------------------------|-----------------------|-----------------------|-----------------------|--|--|--|
| Test Location | Refer to Plan | Refer to Plan | Refer to Plan | | | |
| Level/Layer | 3 | 3 | 3 | | | |
| Layer Thickness | mm 200 | mm 200 | mm 200 | | | |
| Test Depth | mm 175 | mm 175 | mm 175 | | | |
| Field Wet Density | t/m ³ 1.94 | t/m ³ 1.89 | t/m ³ 1.96 | | | |
| Field Moisture Content | % 23.1 | % 25.8 | % 22.5 | | | |
| Material: | Imported Clay | Imported Clay | Imported Clay | | | |

| | | | | | | |
|----------------------------|-----------------------|-----------------------|-----------------------|--|--|--|
| Oversize Material | WET, % 3.6 | WET, % 2.0 | WET, % 5.2 | | | |
| Sieve Size | mm 19 | mm 19 | mm 19 | | | |
| Peak Converted Wet Density | t/m ³ 1.99 | t/m ³ 1.95 | t/m ³ 2.04 | | | |
| Optimum Moisture Content | % 21.5 | % 24 | % 21 | | | |


| | | | | | | |
|---------------------------|---------|---------|--------|--|--|--|
| Moisture Ratio | % 107.5 | % 107.5 | % 107 | | | |
| Moisture Variation | % 1.5 | % 2.0 | % 1.5 | | | |
| from OMC | Wetter | Wetter | Wetter | | | |
| Density Ratio | % 97.0 | % 97.0 | % 95.5 | | | |

| | | | |
|-----------------------|---------------------------------|-------------------------|----------------------|
| Specification: | 95% STD | Test Selection: | N/A |
| Notes: | Ref: 1120 0349-1 (SI11) | | |
| Test Method | AS1289 5.8.1, 5.7.1, 2.1.1, 1.1 | Sampling Method: | AS 1289 1.2.1 6.4(b) |

| | | |
|---|---|---|
|  NATA WORLD RECOGNISED ACCREDITATION | NATA Accredited Laboratory No. 20172 Accreditation for compliance with ISO/IEC 17025 - Testing | Approved Signatory:  Date: 20/02/2023 |
| | | |



Test Location

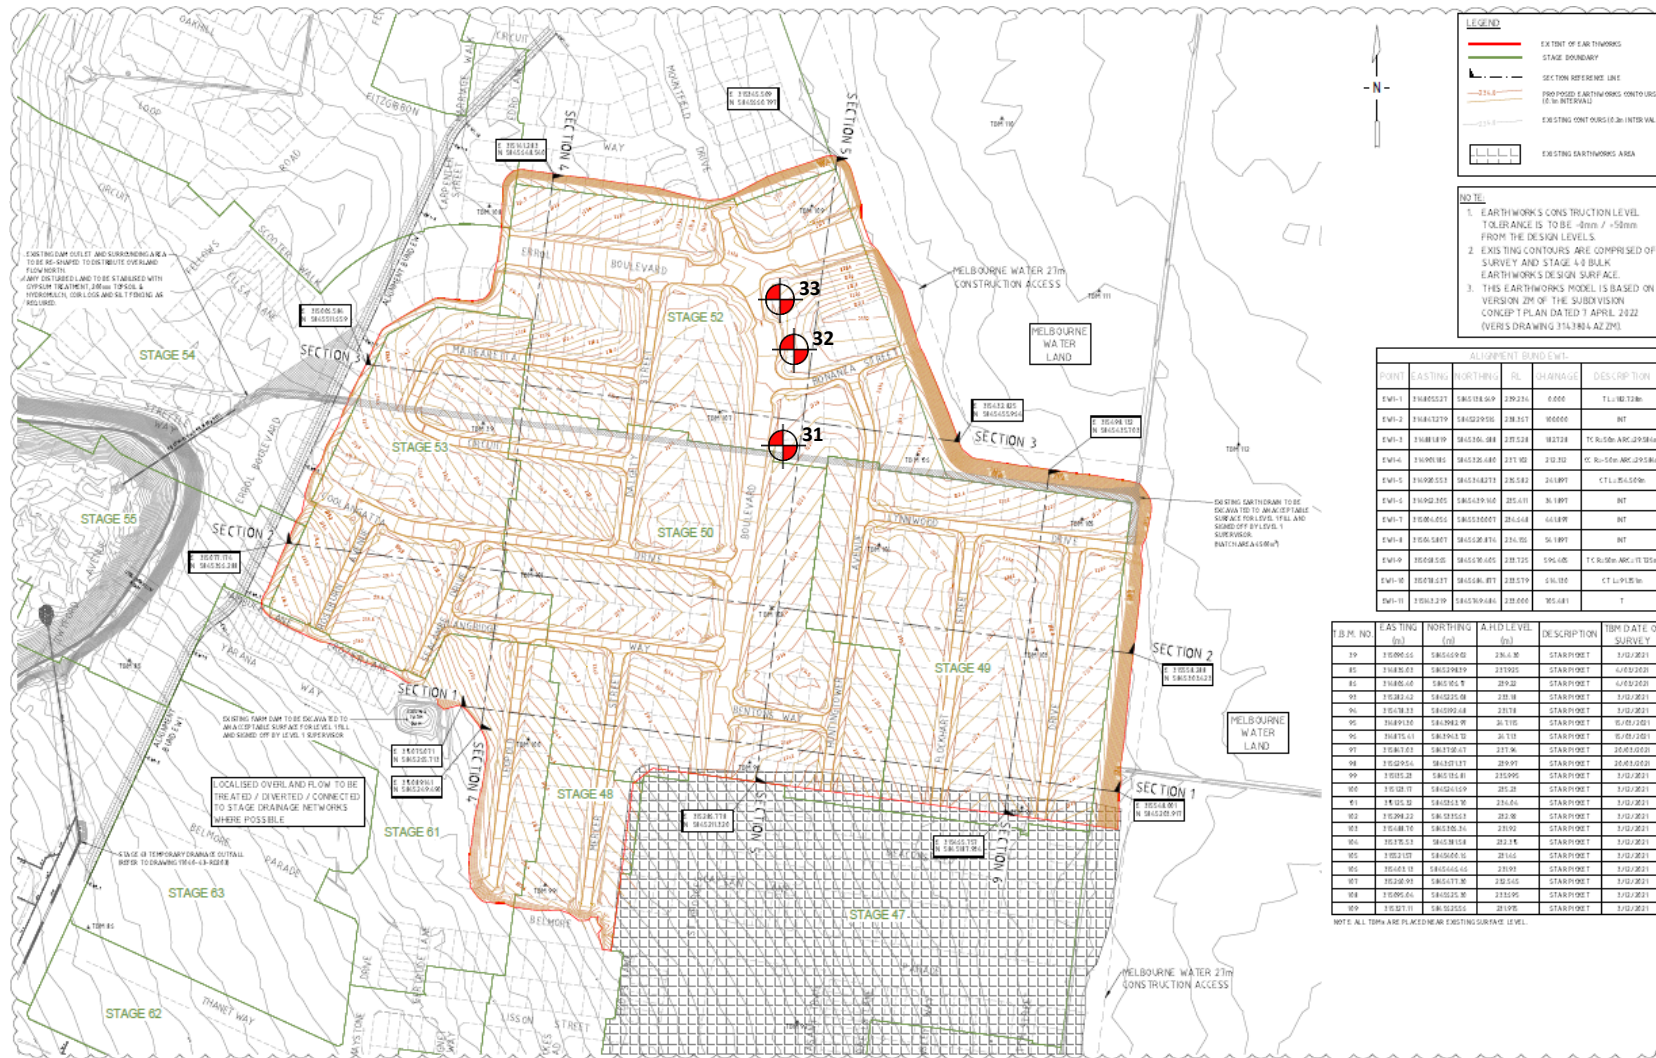

| | | | | | | | |
|-------------|--|---------|--|---|--|-------------------------------|--|
| T. MUSTAC | | 1:1,000 | | merrifield | | HUME CITY COUNCIL | |
| P. MASEMANN | | DATE | | MAB gpc | | MERRIFIELD LIVING - SECTION E | |
| G. ROMANOV | | DATE | | Ground Floor, 307-323 Waverley Road, Mickleham VIC 3145 | | BULK EARTHWORKS - STAGE 49-53 | |
| | | | | TEL: 03 8373 1500 verveprojects.com | | MICKLEHAM | |
| | | | | © Verve Projects Pty Ltd. | | CONSTRUCTION | |
| | | | | | | 366 F1 | |
| | | | | | | 17040-49 | |
| | | | | | | EW201 | |

| | |
|-----------|--|
| PROJECT: | Merrifield Estate – Stage 52 (Level 1) |
| LOCATION: | Mickleham |

| | |
|-------------|--------------------|
| CLIENT: | BMD Urban |
| PROJECT No: | 1120 0349-1 (SI11) |

| | |
|-------------------------------|------------|
| DATE: | 16/02/2023 |
| SITE PLAN SKETCH—NOT TO SCALE | |



Field Density Test Results AS1289.5.7.1

A & Y Associates Pty Ltd
5/16 Network Drive
Truganina VIC 3029
PH: 0400 413 531
info@ayassociates.com.au

| | | | | | | |
|------------------|--|--|--|----------------|---------|--|
| Client: | BMD Urban | | | Job No: | BMD2365 | |
| Project: | Merrifield Estate - Stage 52 (Level 1) | | | Report: | 12 | |
| Location: | Mickleham | | | | | |

| | | | | | | |
|-------------|------------|------------|------------|--|--|--|
| Sample No | 34 | 35 | 36 | | | |
| Date Tested | 20/02/2023 | 20/02/2023 | 20/02/2023 | | | |
| Time Tested | AM | AM | AM | | | |

| | | | | | | |
|------------------------|-----------------------|-----------------------|-----------------------|--|--|--|
| Test Location | Refer to Plan | Refer to Plan | Refer to Plan | | | |
| Level/Layer | 4 | 5 | 5 | | | |
| Layer Thickness | mm 200 | mm 200 | mm 200 | | | |
| Test Depth | mm 175 | mm 175 | mm 175 | | | |
| Field Wet Density | t/m ³ 1.85 | t/m ³ 1.91 | t/m ³ 1.81 | | | |
| Field Moisture Content | % 26.3 | % 25.2 | % 26.7 | | | |
| Material: | Imported Clay | Imported Clay | Imported Clay | | | |

| | | | | | | |
|----------------------------|-----------------------|-----------------------|-----------------------|--|--|--|
| Oversize Material | WET, % 0.0 | WET, % 3.1 | WET, % 0.0 | | | |
| Sieve Size | mm 19 | mm 19 | mm 19 | | | |
| Peak Converted Wet Density | t/m ³ 1.89 | t/m ³ 1.98 | t/m ³ 1.85 | | | |
| Optimum Moisture Content | % 24.5 | % 26 | % 25 | | | |

| | | | | | | |
|---------------------------|---------|--------|--------|--|--|--|
| Moisture Ratio | % 107.5 | % 97 | % 107 | | | |
| Moisture Variation | % 2.0 | % -0.5 | % 2.0 | | | |
| from OMC | Wetter | Drier | Wetter | | | |
| Density Ratio | % 97.5 | % 96.0 | % 98.0 | | | |

| | | | |
|-----------------------|---------------------------------|-------------------------|----------------------|
| Specification: | 95% STD | Test Selection: | N/A |
| Notes: | Ref: 1120 0349-1 (SI12) | | |
| Test Method | AS1289 5.8.1, 5.7.1, 2.1.1, 1.1 | Sampling Method: | AS 1289 1.2.1 6.4(b) |



NATA Accredited Laboratory No. 20172
Accreditation for compliance with ISO/IEC 17025 - Testing

Approved Signatory:




David Burns

Date: 24/02/2023



Test Location

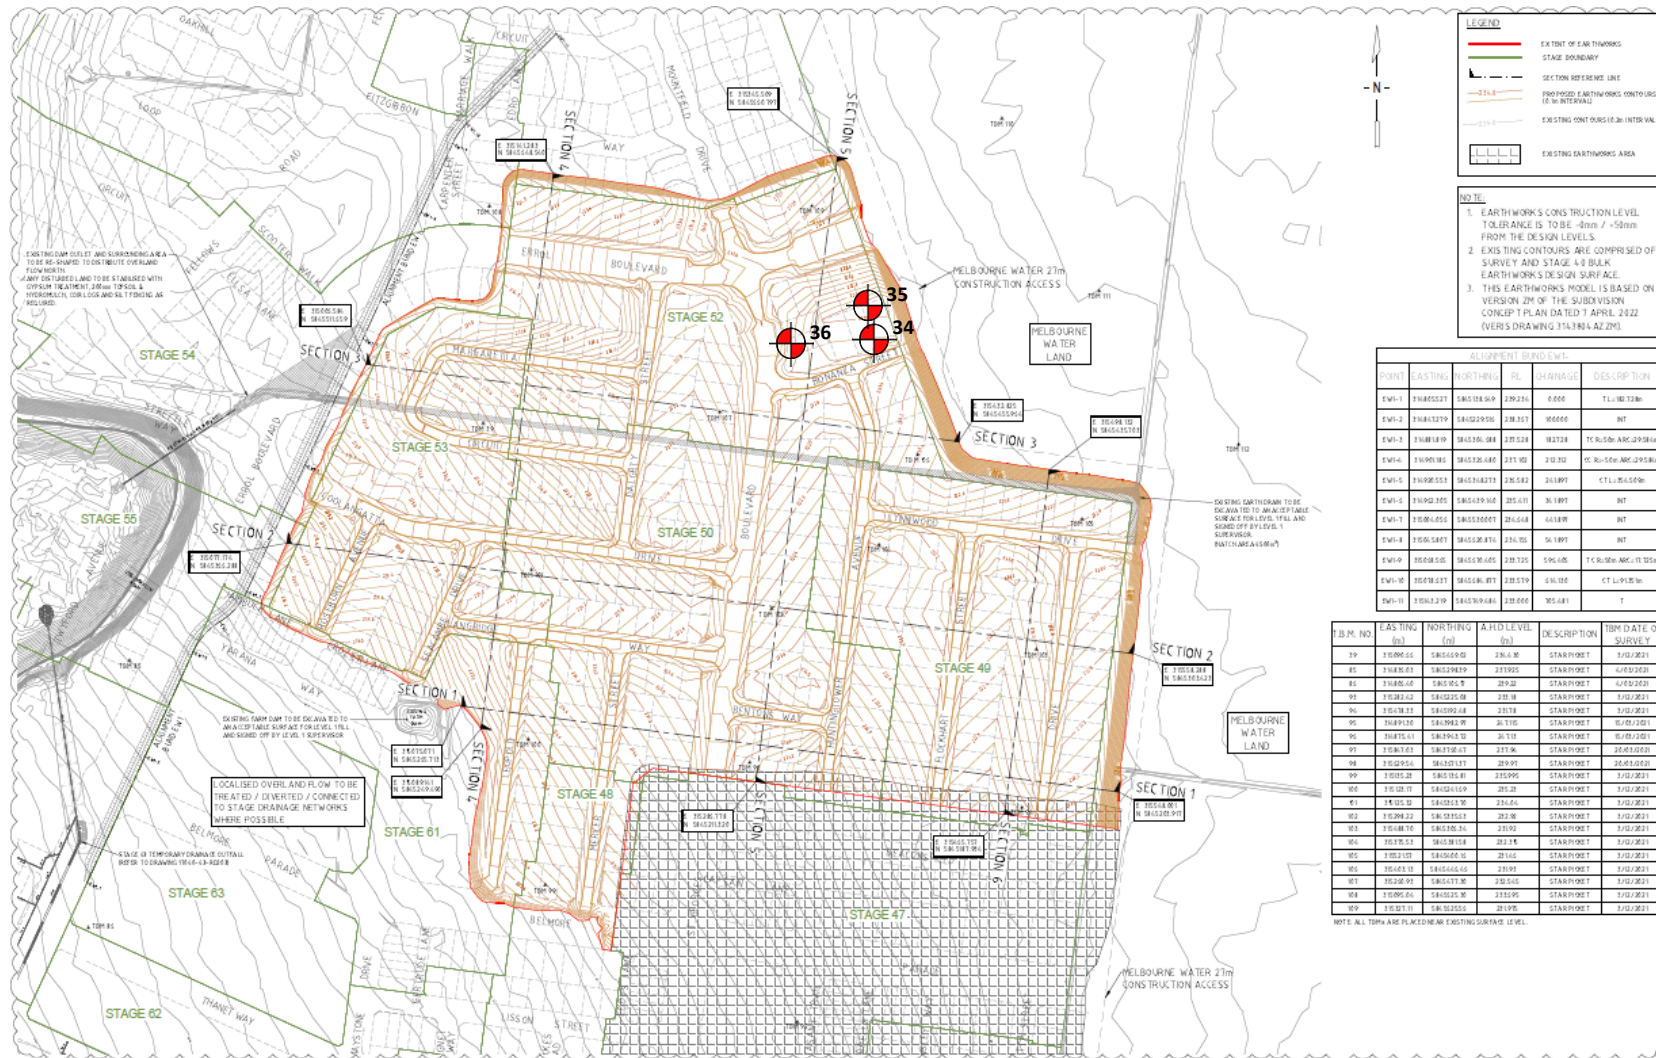

| | | | | | | | |
|---|--|---------------|--|---|--|---|--|
| T. MUSTAC | | 1:1,000 | | merrifield | | HUME CITY COUNCIL | |
| P. MASEMANN | | DATE | | MAB gpc | | PROJECT | |
| G. ROMANOV | | DATE | | Ground Floor, 307-323 Waverley Road, Mickleham VIC 3145 | | MERRIFIELD LIVING - SECTION E BULK EARTHWORKS - STAGE 49-53 | |
| 1. CONTINGENT BOUND & NOTES UP DATED, DESIGNED EARTHWORKS NOTED | | G.D. 10/12/21 | | TEL: 03 8373 1500 | | MICKLEHAM | |
| 2. CONSTRUCTION ISSUE | | G.D. 02/02/23 | | © Verve Projects Pty Ltd. | | CONSTRUCTION | |
| 3. DESCRIPTION | | DATE | | 366 F1 | | 17040-49 | |
| | | | | | | EW201 | |

| | | |
|--|--------------------|-------------------------------|
| PROJECT: | CLIENT: | DATE: |
| Merrifield Estate – Stage 52 (Level 1) | BMD Urban | 20/02/2023 |
| LOCATION: | PROJECT No: | SITE PLAN SKETCH—NOT TO SCALE |
| Mickleham | 1120 0349-1 (SI12) | |



Field Density Test Results AS1289.5.7.1

A & Y Associates Pty Ltd
5/16 Network Drive
Truganina VIC 3029
PH: 0400 413 531
info@ayassociates.com.au

| | | | | | | |
|------------------|--|--|--|----------------|---------|--|
| Client: | BMD Urban | | | Job No: | BMD2365 | |
| Project: | Merrifield Estate - Stage 52 (Level 1) | | | Report: | 13 | |
| Location: | Mickleham | | | | | |

| | | | | | | |
|-------------|------------|------------|------------|--|--|--|
| Sample No | 37 | 38 | 39 | | | |
| Date Tested | 21/02/2023 | 21/02/2023 | 21/02/2023 | | | |
| Time Tested | AM | AM | AM | | | |

| | | | | | | |
|------------------------|-----------------------|-----------------------|-----------------------|--|--|--|
| Test Location | Refer to Plan | Refer to Plan | Refer to Plan | | | |
| Level/Layer | 6 | 6 | 6 | | | |
| Layer Thickness | mm 200 | mm 200 | mm 200 | | | |
| Test Depth | mm 175 | mm 175 | mm 175 | | | |
| Field Wet Density | t/m ³ 2.00 | t/m ³ 1.81 | t/m ³ 1.86 | | | |
| Field Moisture Content | % 23.0 | % 26.5 | % 25.6 | | | |
| Material: | Imported Clay | Imported Clay | Imported Clay | | | |

| | | | | | | |
|----------------------------|-----------------------|-----------------------|-----------------------|--|--|--|
| Oversize Material | WET, % 2.1 | WET, % 0.0 | WET, % 4.2 | | | |
| Sieve Size | mm 19 | mm 19 | mm 19 | | | |
| Peak Converted Wet Density | t/m ³ 2.02 | t/m ³ 1.86 | t/m ³ 1.90 | | | |
| Optimum Moisture Content | % 23.5 | % 25 | % 26.5 | | | |

| | | | | | | |
|---------------------------|--------|--------|--------|--|--|--|
| Moisture Ratio | % 98 | % 106 | % 96.5 | | | |
| Moisture Variation | % -0.5 | % 1.5 | % -1.0 | | | |
| from OMC | Drier | Wetter | Drier | | | |
| Density Ratio | % 98.5 | % 97.5 | % 97.5 | | | |

| | | | |
|-----------------------|---------------------------------|-------------------------|----------------------|
| Specification: | 95% STD | Test Selection: | N/A |
| Notes: | Ref: 1120 0349-1 (SI13) | | |
| Test Method | AS1289 5.8.1, 5.7.1, 2.1.1, 1.1 | Sampling Method: | AS 1289 1.2.1 6.4(b) |



NATA Accredited Laboratory No. 20172
Accreditation for compliance with ISO/IEC 17025 - Testing

Approved Signatory:




David Burns

Date: 24/02/2023



Test Location

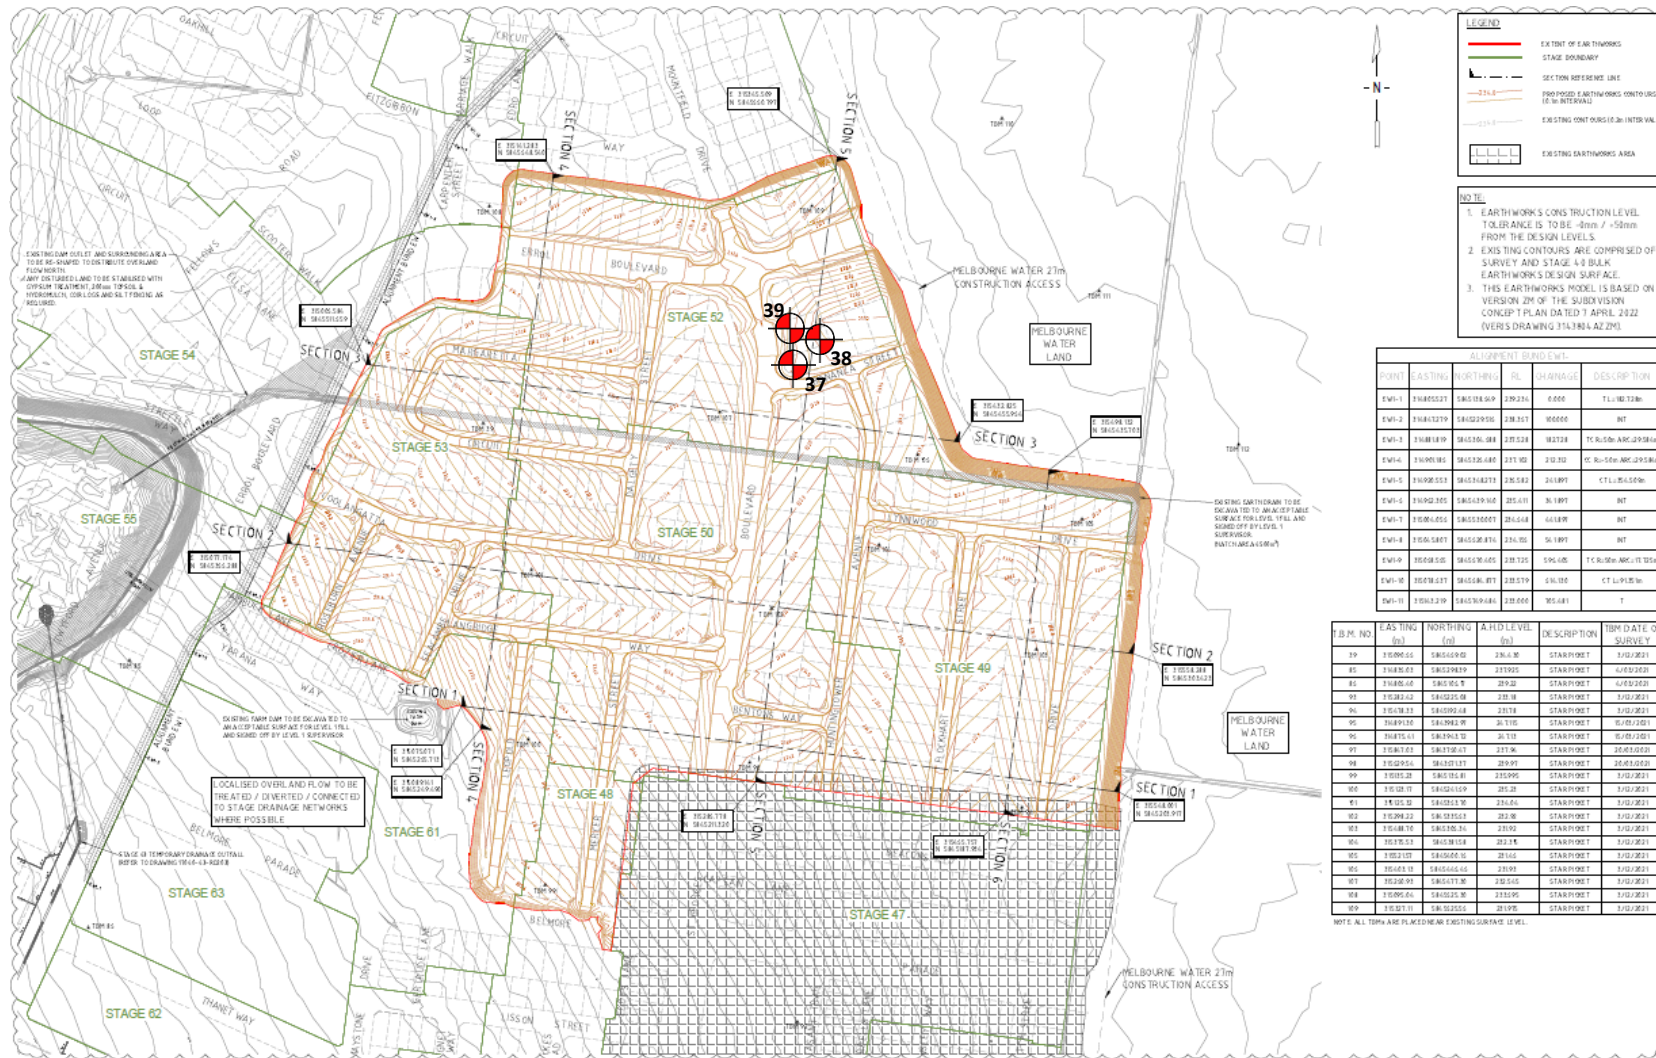


NOTE: ALL TOPS ARE PLACED NEAR EXISTING SURFACE LEVEL.

1









T. MUSTAC

P. MASEMANN

G. ROMANOV

1:1,000

0 10 20 30 40 50

merrifield

MAB gpc

verve

Ground Floor, 307-323 Waverley Road, Mickleham VIC 3145

TEL: 03 8373 1500

verveprojects.com

© Verve Projects Pty Ltd.

HUME CITY COUNCIL

MERRIFIELD LIVING - SECTION E

BULK EARTHWORKS - STAGE 49-53

MICKLEHAM

CONSTRUCTION

366 F1

17040-49

EW201

1

| | | |
|--|-----------------------------------|-------------------------------|
| PROJECT: Merrifield Estate – Stage 52 (Level 1) | CLIENT: BMD Urban | DATE: 21/02/2023 |
| LOCATION: Mickleham | PROJECT No: 1120 0349-1 (SI13) | SITE PLAN SKETCH—NOT TO SCALE |



Field Density Test Results AS1289.5.7.1

A & Y Associates Pty Ltd
5/16 Network Drive
Truganina VIC 3029
PH: 0400 413 531
info@ayassociates.com.au

| | | | | | | |
|------------------|--|--|--|----------------|---------|--|
| Client: | BMD Urban | | | Job No: | BMD2365 | |
| Project: | Merrifield Estate - Stage 52 (Level 1) | | | Report: | 14 | |
| Location: | Mickleham | | | | | |

| | | | | | | |
|-------------|------------|------------|------------|--|--|--|
| Sample No | 40 | 41 | 42 | | | |
| Date Tested | 22/02/2023 | 22/02/2023 | 22/02/2023 | | | |
| Time Tested | PM | PM | PM | | | |

| | | | | | | |
|------------------------|-----------------------|-----------------------|-----------------------|--|--|--|
| Test Location | Refer to Plan | Refer to Plan | Refer to Plan | | | |
| Level/Layer | FSL | FSL | FSL | | | |
| Layer Thickness | mm 200 | mm 200 | mm 200 | | | |
| Test Depth | mm 175 | mm 175 | mm 175 | | | |
| Field Wet Density | t/m ³ 1.95 | t/m ³ 1.82 | t/m ³ 1.87 | | | |
| Field Moisture Content | % 22.8 | % 24.8 | % 24.1 | | | |
| Material: | Imported Clay | Imported Clay | Imported Clay | | | |

| | | | | | | |
|----------------------------|-----------------------|-----------------------|-----------------------|--|--|--|
| Oversize Material | WET, % 4.6 | WET, % 0.0 | WET, % 2.9 | | | |
| Sieve Size | mm 19 | mm 19 | mm 19 | | | |
| Peak Converted Wet Density | t/m ³ 2.00 | t/m ³ 1.87 | t/m ³ 1.90 | | | |
| Optimum Moisture Content | % 23 | % 23 | % 22.5 | | | |

| | | | | | | |
|---------------------------|--------|--------|--------|--|--|--|
| Moisture Ratio | % 99 | % 108 | % 107 | | | |
| Moisture Variation | % -0.5 | % 2.0 | % 2.0 | | | |
| from OMC | Drier | Wetter | Wetter | | | |
| Density Ratio | % 97.0 | % 97.5 | % 97.5 | | | |

| | | | |
|-----------------------|---------------------------------|-------------------------|----------------------|
| Specification: | 95% STD | Test Selection: | N/A |
| Notes: | Ref: 1120 0349-1 (SI14) | | |
| Test Method | AS1289 5.8.1, 5.7.1, 2.1.1, 1.1 | Sampling Method: | AS 1289 1.2.1 6.4(b) |



NATA Accredited Laboratory No. 20172
Accreditation for compliance with ISO/IEC 17025 - Testing


Approved Signatory:



David Burns
Date: 24/02/2023



Test Location

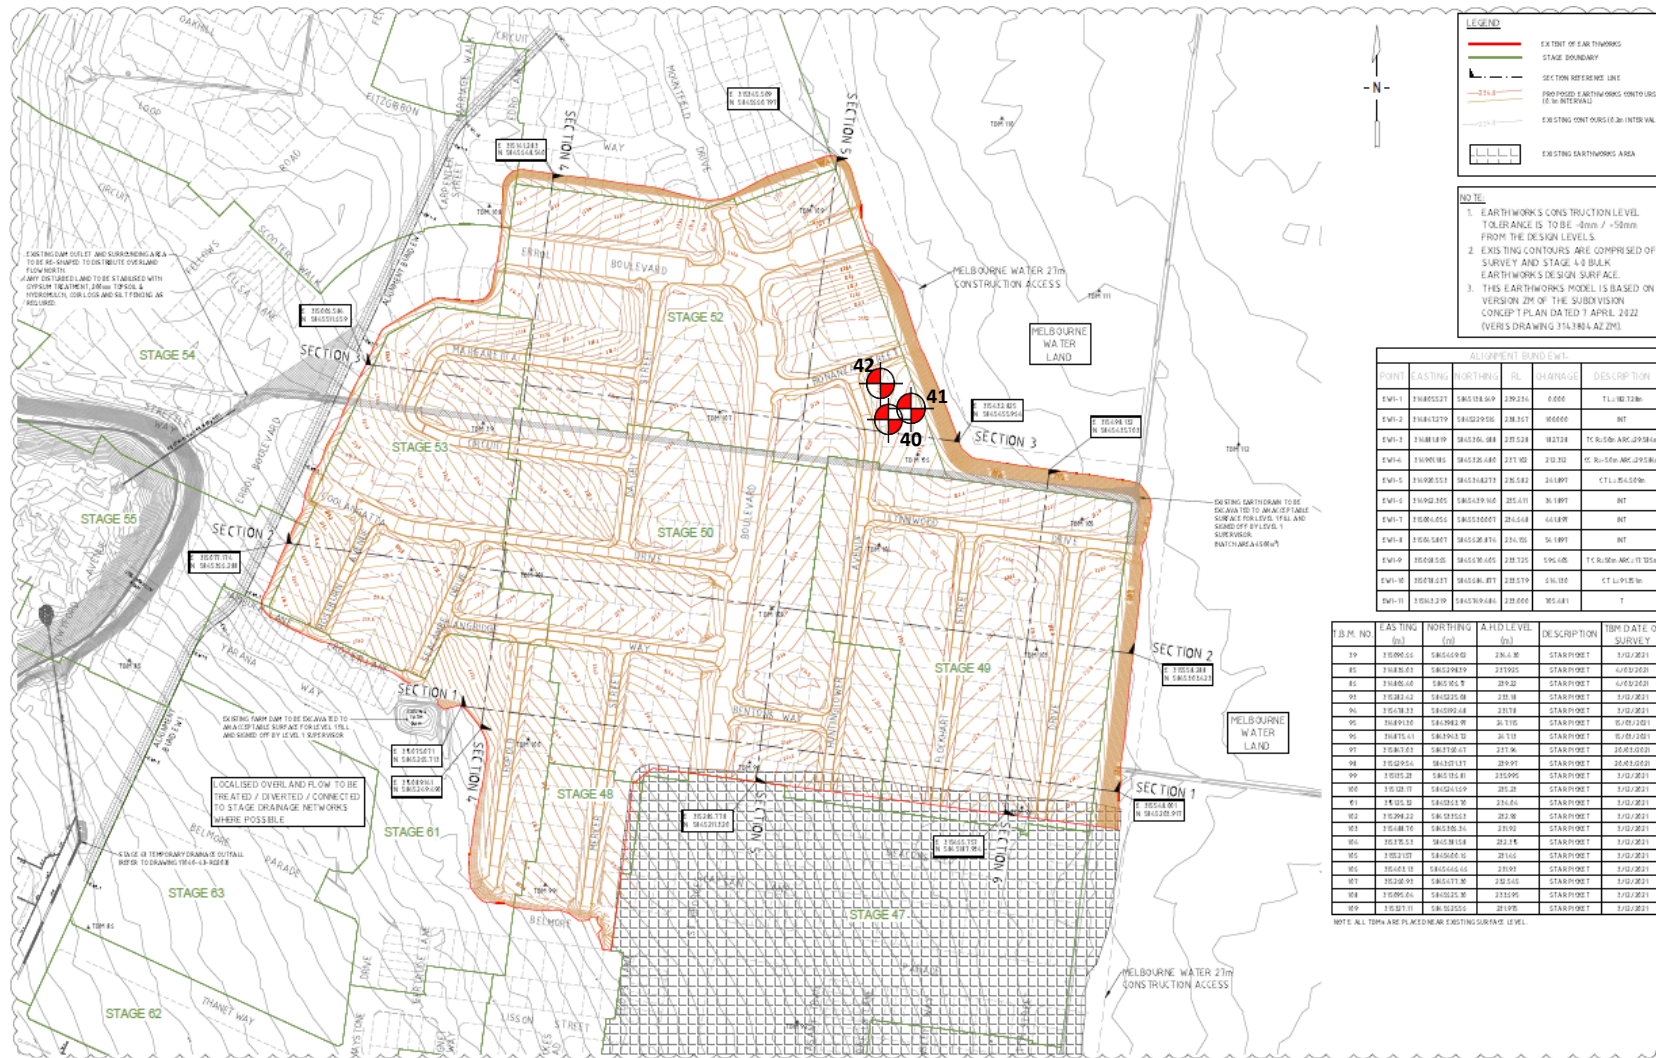

| | | | | | | | |
|-------------|--|---------|--|---|--|-------------------------------|--|
| T. MUSTAC | | 1:1,000 | | merrifield | | HUME CITY COUNCIL | |
| P. MASEMANN | | DATE | | MAB gpc | | PROJECT | |
| G. ROMANOV | | DATE | | Ground Floor, 307-323 Waverley Road, Mickleham VIC 3145 | | MERRIFIELD LIVING - SECTION E | |
| | | | | TEL: 03 8373 1500 verveprojects.com | | BULK EARTHWORKS - STAGE 49-53 | |
| | | | | © Verve Projects Pty Ltd. | | MICKLEHAM | |
| | | | | | | CONSTRUCTION | |
| | | | | | | 366 F1 | |
| | | | | | | 17040-49 | |
| | | | | | | EW201 | |

| | | |
|--|--------------------|-------------------------------|
| PROJECT: | CLIENT: | DATE: |
| Merrifield Estate – Stage 52 (Level 1) | BMD Urban | 22/02/2023 |
| LOCATION: | PROJECT No: | SITE PLAN SKETCH—NOT TO SCALE |
| Mickleham | 1120 0349-1 (S114) | |



Field Density Test Results AS1289.5.7.1

A & Y Associates Pty Ltd
5/16 Network Drive
Truganina VIC 3029
PH: 0400 413 531
info@ayassociates.com.au

| | | | | | | |
|------------------|--|--|--|----------------|---------|--|
| Client: | BMD Urban | | | Job No: | BMD2365 | |
| Project: | Merrifield Estate - Stage 52 (Level 1) | | | Report: | 15 | |
| Location: | Mickleham | | | | | |



| | | | | | | |
|-------------|------------|------------|------------|--|--|--|
| Sample No | 43 | 44 | 45 | | | |
| Date Tested | 23/02/2023 | 23/02/2023 | 23/02/2023 | | | |
| Time Tested | AM | AM | AM | | | |

| | | | | | | |
|------------------------|-----------------------|-----------------------|-----------------------|--|--|--|
| Test Location | Refer to Plan | Refer to Plan | Refer to Plan | | | |
| Level/Layer | 4 | 4 | 4 | | | |
| Layer Thickness | mm 200 | mm 200 | mm 200 | | | |
| Test Depth | mm 175 | mm 175 | mm 175 | | | |
| Field Wet Density | t/m ³ 1.94 | t/m ³ 1.90 | t/m ³ 1.88 | | | |
| Field Moisture Content | % 22.1 | % 22.9 | % 23.6 | | | |
| Material: | Imported Clay | Imported Clay | Imported Clay | | | |

| | | | | | | |
|----------------------------|-----------------------|-----------------------|-----------------------|--|--|--|
| Oversize Material | WET, % 0.0 | WET, % 3.8 | WET, % 2.5 | | | |
| Sieve Size | mm 19 | mm 19 | mm 19 | | | |
| Peak Converted Wet Density | t/m ³ 1.94 | t/m ³ 1.95 | t/m ³ 1.92 | | | |
| Optimum Moisture Content | % 22.5 | % 23.5 | % 22 | | | |


| | | | | | | |
|---------------------------|---------|--------|---------|--|--|--|
| Moisture Ratio | % 98 | % 97.5 | % 107.5 | | | |
| Moisture Variation | % -0.5 | % -0.5 | % 1.5 | | | |
| from OMC | Drier | Drier | Wetter | | | |
| Density Ratio | % 100.0 | % 97.0 | % 97.5 | | | |

| | | | |
|-----------------------|---------------------------------|-------------------------|----------------------|
| Specification: | 95% STD | Test Selection: | N/A |
| Notes: | Ref: 1120 0349-1 (SI15) | | |
| Test Method | AS1289 5.8.1, 5.7.1, 2.1.1, 1.1 | Sampling Method: | AS 1289 1.2.1 6.4(b) |

| | | |
|---|---|---|
|  NATA WORLD RECOGNISED ACCREDITATION | NATA Accredited Laboratory No. 20172 Accreditation for compliance with ISO/IEC 17025 - Testing | Approved Signatory:  Date: 28/02/2023 |
| | | David Burns |



Test Location

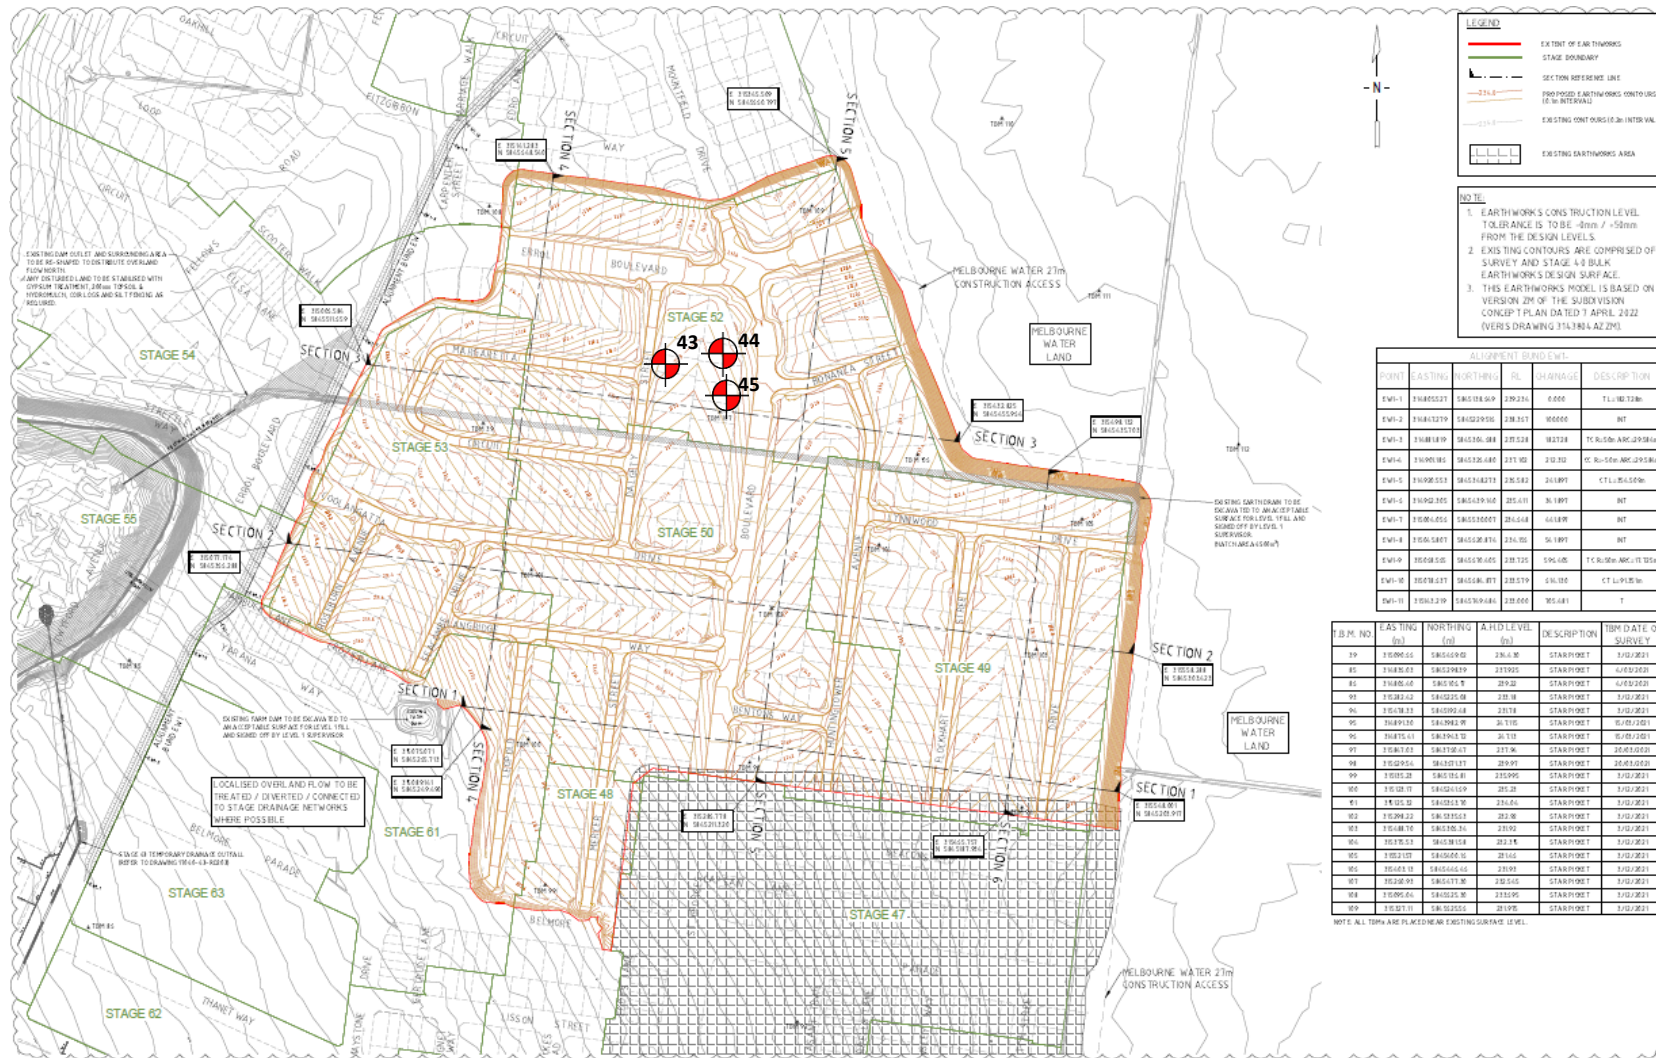

| | | | | | | | |
|------------|--|---------|--|---|--|-------------------------------|--|
| T. MUSTAC | | 1:1,000 | | merrifield | | HUME CITY COUNCIL | |
| P. MASEMAN | | DATE | | MAB gpc | | MERRIFIELD LIVING - SECTION E | |
| G. ROMANOV | | DATE | | Ground Floor, 307-323 Waverley Road, Mickleham VIC 3145 | | BULK EARTHWORKS - STAGE 49-53 | |
| | | | | TEL: 03 8373 1500 verveprojects.com | | MICKLEHAM | |
| | | | | © Verve Projects Pty Ltd. | | CONSTRUCTION | |
| | | | | | | 366 F1 | |
| | | | | | | 17040-49 | |
| | | | | | | EW201 | |

PROJECT:
Merrifield Estate – Stage 52 (Level 1)

LOCATION:
Mickleham

CLIENT:
BMD Urban

PROJECT No:
1120 0349-1 (SI15)

DATE:
23/02/2023

SITE PLAN SKETCH—NOT TO SCALE



Field Density Test Results AS1289.5.7.1

A & Y Associates Pty Ltd
5/16 Network Drive
Truganina VIC 3029
PH: 0400 413 531
info@ayassociates.com.au

| | | | | | | |
|------------------|--|--|--|----------------|---------|--|
| Client: | BMD Urban | | | Job No: | BMD2365 | |
| Project: | Merrifield Estate - Stage 52 (Level 1) | | | Report: | 16 | |
| Location: | Mickleham | | | | | |



| | | | | | | |
|-------------|------------|------------|------------|--|--|--|
| Sample No | 46 | 47 | 48 | | | |
| Date Tested | 28/02/2023 | 28/02/2023 | 28/02/2023 | | | |
| Time Tested | PM | PM | PM | | | |

| | | | | | | |
|------------------------|-----------------------|-----------------------|-----------------------|--|--|--|
| Test Location | Refer to Plan | Refer to Plan | Refer to Plan | | | |
| Level/Layer | 1 | 1 | 1 | | | |
| Layer Thickness | mm 200 | mm 200 | mm 200 | | | |
| Test Depth | mm 175 | mm 175 | mm 175 | | | |
| Field Wet Density | t/m ³ 1.94 | t/m ³ 1.92 | t/m ³ 1.84 | | | |
| Field Moisture Content | % 21.1 | % 22.6 | % 23.9 | | | |
| Material: | Imported Clay | Imported Clay | Imported Clay | | | |

| | | | | | | |
|----------------------------|-----------------------|-----------------------|-----------------------|--|--|--|
| Oversize Material | WET, % 4.2 | WET, % 2.6 | WET, % 0.0 | | | |
| Sieve Size | mm 19 | mm 19 | mm 19 | | | |
| Peak Converted Wet Density | t/m ³ 2.00 | t/m ³ 1.95 | t/m ³ 1.91 | | | |
| Optimum Moisture Content | % 21.5 | % 23.5 | % 22 | | | |


| | | | | | | |
|---------------------------|--------|--------|---------|--|--|--|
| Moisture Ratio | % 98 | % 96 | % 108.5 | | | |
| Moisture Variation | % -0.5 | % -0.5 | % 2.0 | | | |
| from OMC | Drier | Drier | Wetter | | | |
| Density Ratio | % 96.5 | % 98.0 | % 96.5 | | | |

| | | | |
|-----------------------|---------------------------------|-------------------------|----------------------|
| Specification: | 95% STD | Test Selection: | N/A |
| Notes: | Ref: 1120 0349-1 (SI16) | | |
| Test Method | AS1289 5.8.1, 5.7.1, 2.1.1, 1.1 | Sampling Method: | AS 1289 1.2.1 6.4(b) |

| | | |
|---|---|---|
|  NATA WORLD RECOGNISED ACCREDITATION | NATA Accredited Laboratory No. 20172 Accreditation for compliance with ISO/IEC 17025 - Testing | Approved Signatory:  Date: 09/03/2023 |
| | | |



Test Location

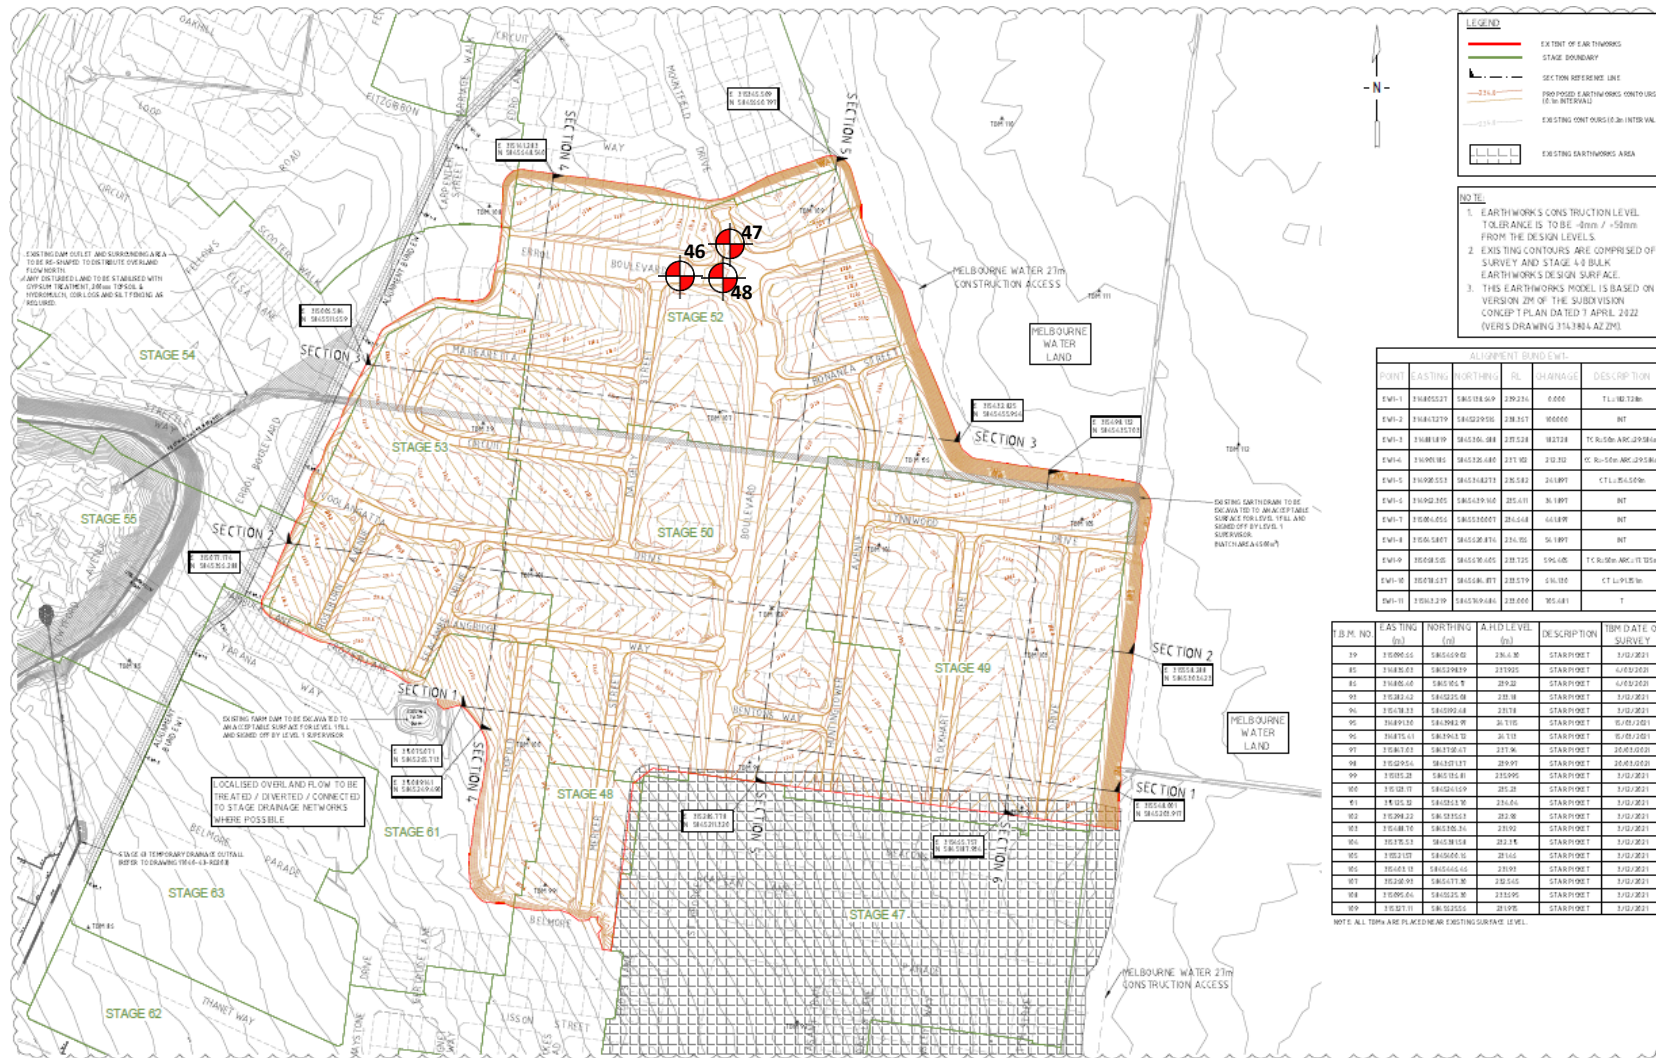

| | | | | | | | |
|-------------|--|---------|--|---|--|-------------------------------|--|
| T. MUSTAC | | 1:1,000 | | merrifield | | HUME CITY COUNCIL | |
| P. MASEMANN | | DATE | | MAB gpc | | PROJECT | |
| G. ROMANOV | | DATE | | Ground Floor, 307-323 Waverley Road, Mickleham VIC 3145 | | MERRIFIELD LIVING - SECTION E | |
| | | | | TEL: 03 8373 1500 verveprojects.com | | BULK EARTHWORKS - STAGE 49-53 | |
| | | | | © Verve Projects Pty Ltd. | | MICKLEHAM | |
| | | | | | | CONSTRUCTION | |
| | | | | | | 366 F1 | |
| | | | | | | 17040-49 | |
| | | | | | | EW201 | |

| | |
|-----------|--|
| PROJECT: | Merrifield Estate – Stage 52 (Level 1) |
| LOCATION: | Mickleham |

| | |
|-------------|--------------------|
| CLIENT: | BMD Urban |
| PROJECT No: | 1120 0349-1 (SI16) |

| | |
|-------------------------------|------------|
| DATE: | 28/02/2023 |
| SITE PLAN SKETCH—NOT TO SCALE | |



Field Density Test Results AS1289.5.7.1

A & Y Associates Pty Ltd
5/16 Network Drive
Truganina VIC 3029
PH: 0400 413 531
info@ayassociates.com.au

| | | | | | | |
|------------------|--|--|--|----------------|---------|--|
| Client: | BMD Urban | | | Job No: | BMD2365 | |
| Project: | Merrifield Estate - Stage 52 (Level 1) | | | Report: | 17 | |
| Location: | Mickleham | | | | | |



| | | | | | | |
|-------------|------------|------------|------------|--|--|--|
| Sample No | 49 | 50 | 51 | | | |
| Date Tested | 01/03/2023 | 01/03/2023 | 01/03/2023 | | | |
| Time Tested | AM | AM | AM | | | |

| | | | | | | |
|------------------------|-----------------------|-----------------------|-----------------------|--|--|--|
| Test Location | Refer to Plan | Refer to Plan | Refer to Plan | | | |
| Level/Layer | 2 | 2 | 2 | | | |
| Layer Thickness | mm 200 | mm 200 | mm 200 | | | |
| Test Depth | mm 175 | mm 175 | mm 175 | | | |
| Field Wet Density | t/m ³ 1.91 | t/m ³ 1.95 | t/m ³ 1.93 | | | |
| Field Moisture Content | % 23.2 | % 21.6 | % 22.2 | | | |
| Material: | Imported Clay | Imported Clay | Imported Clay | | | |

| | | | | | | |
|----------------------------|-----------------------|-----------------------|-----------------------|--|--|--|
| Oversize Material | WET, % 0.0 | WET, % 3.9 | WET, % 0.0 | | | |
| Sieve Size | mm 19 | mm 19 | mm 19 | | | |
| Peak Converted Wet Density | t/m ³ 1.97 | t/m ³ 1.98 | t/m ³ 1.96 | | | |
| Optimum Moisture Content | % 21.5 | % 22.5 | % 22.5 | | | |


| | | | | | | |
|---------------------------|--------|--------|--------|--|--|--|
| Moisture Ratio | % 108 | % 96 | % 98.5 | | | |
| Moisture Variation | % 2.0 | % -1.0 | % -0.5 | | | |
| from OMC | Wetter | Drier | Drier | | | |
| Density Ratio | % 97.0 | % 97.5 | % 98.5 | | | |

| | | | |
|-----------------------|---------------------------------|-------------------------|----------------------|
| Specification: | 95% STD | Test Selection: | N/A |
| Notes: | Ref: 1120 0349-1 (SI17) | | |
| Test Method | AS1289 5.8.1, 5.7.1, 2.1.1, 1.1 | Sampling Method: | AS 1289 1.2.1 6.4(b) |

| | | |
|---|---|---|
|  NATA WORLD RECOGNISED ACCREDITATION | NATA Accredited Laboratory No. 20172 Accreditation for compliance with ISO/IEC 17025 - Testing | Approved Signatory:  Date: 09/03/2023 |
| | | |



Test Location

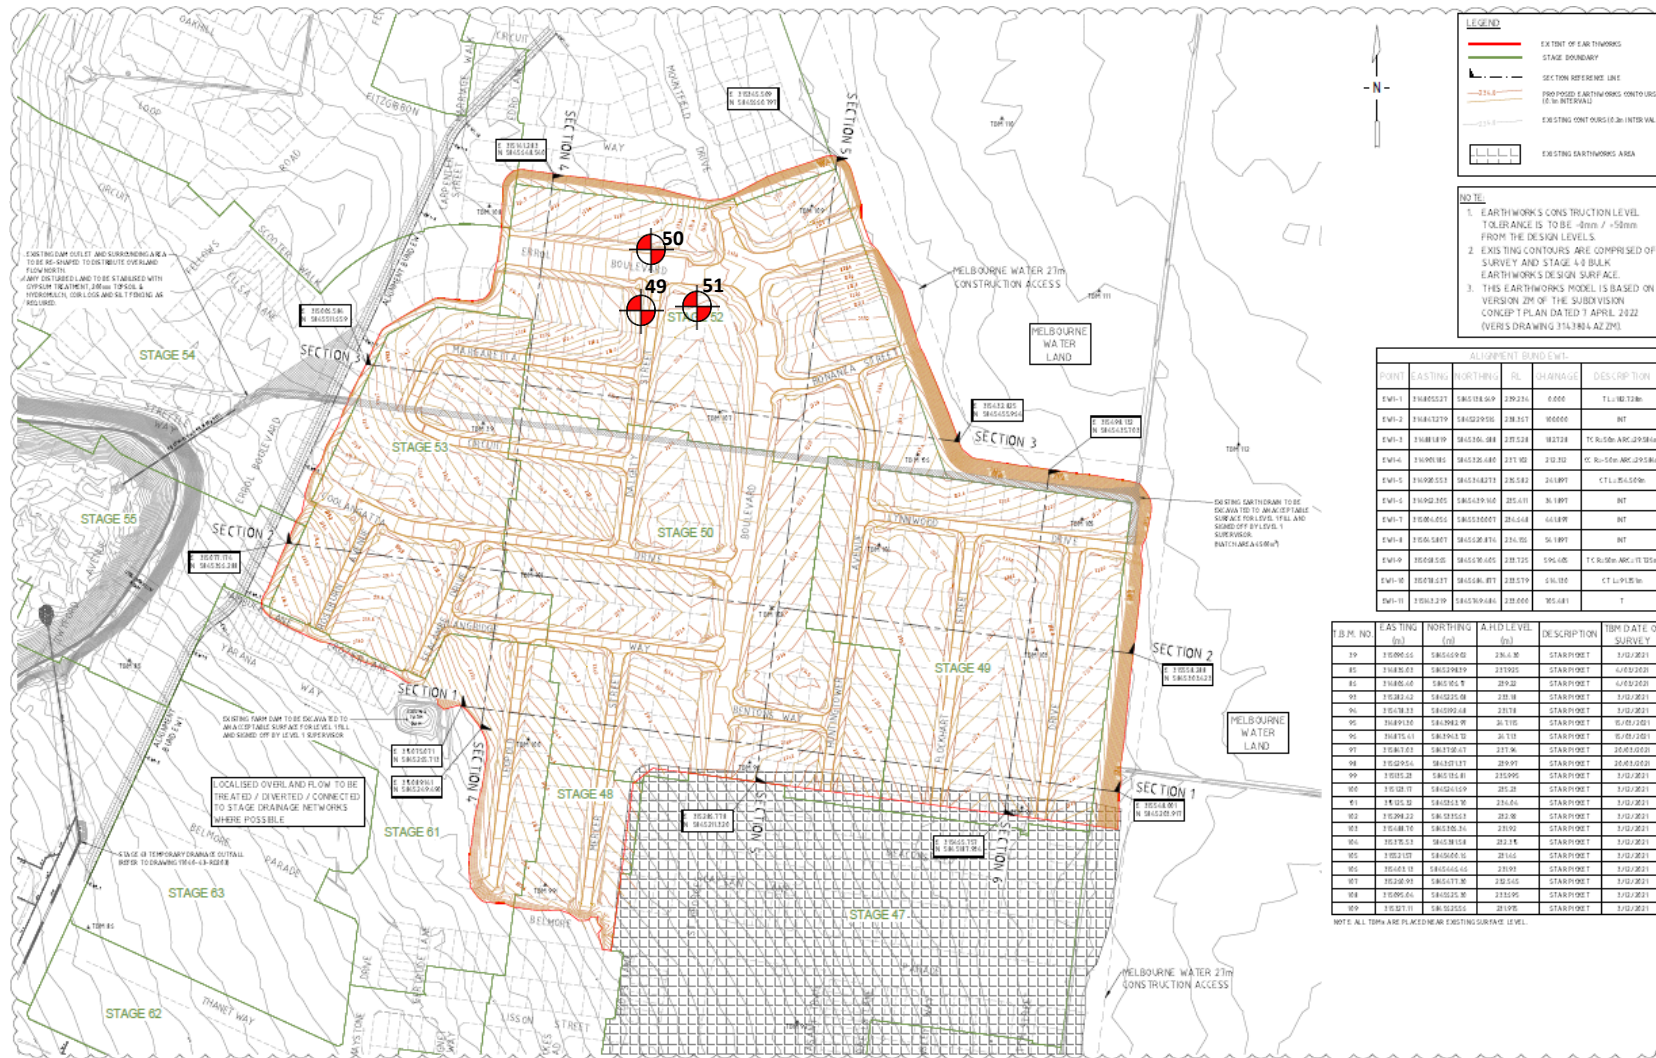

1. CONTINGENT BOUND & NOTES UP DATED, DUE EARTHWORKS NOTED

2. CONSTRUCTION ISSUE

T. MUSTAC

P. MASEMAN

G. ROMANZ

1:1,000

0 10 20 30 40 50 60 70 80 90 100

merrifield

MAB gpc

verve

Ground Floor, 307-323 Waverley Road, Mickleham VIC 3145
TEL: 03 8373 1500 verveprojects.com
© Verve Projects Pty Ltd.

HUME CITY COUNCIL

MERRIFIELD LIVING - SECTION E
BULK EARTHWORKS - STAGE 49-53
MICKLEHAM

CONSTRUCTION

366 F1

17040-49

EW201

1

| | | |
|--|----------------------------------|-------------------------------|
| PROJECT: Merrifield Estate – Stage 52 (Level 1) | CLIENT: BMD Urban | DATE: 01/03/2023 |
| LOCATION: Mickleham | PROJECT No: 1120 0349-1 (S17) | SITE PLAN SKETCH—NOT TO SCALE |



Field Density Test Results AS1289.5.7.1

A & Y Associates Pty Ltd
5/16 Network Drive
Truganina VIC 3029
PH: 0400 413 531
info@ayassociates.com.au

| | | | | | | |
|------------------|--|--|--|----------------|---------|--|
| Client: | BMD Urban | | | Job No: | BMD2365 | |
| Project: | Merrifield Estate - Stage 52 (Level 1) | | | Report: | 18 | |
| Location: | Mickleham | | | | | |



| | | | | | | |
|-------------|------------|------------|------------|--|--|--|
| Sample No | 52 | 53 | 54 | | | |
| Date Tested | 02/03/2023 | 02/03/2023 | 02/03/2023 | | | |
| Time Tested | PM | PM | PM | | | |

| | | | | | | |
|------------------------|-----------------------|-----------------------|-----------------------|--|--|--|
| Test Location | Refer to Plan | Refer to Plan | Refer to Plan | | | |
| Level/Layer | 2 | 2 | 2 | | | |
| Layer Thickness | mm 200 | mm 200 | mm 200 | | | |
| Test Depth | mm 175 | mm 175 | mm 175 | | | |
| Field Wet Density | t/m ³ 1.95 | t/m ³ 1.93 | t/m ³ 1.94 | | | |
| Field Moisture Content | % 21.2 | % 23.1 | % 22.5 | | | |
| Material: | Imported Clay | Imported Clay | Imported Clay | | | |

| | | | | | | |
|----------------------------|-----------------------|-----------------------|-----------------------|--|--|--|
| Oversize Material | WET, % 4.8 | WET, % 2.1 | WET, % 3.4 | | | |
| Sieve Size | mm 19 | mm 19 | mm 19 | | | |
| Peak Converted Wet Density | t/m ³ 2.01 | t/m ³ 1.96 | t/m ³ 1.96 | | | |
| Optimum Moisture Content | % 21.5 | % 23.5 | % 20.5 | | | |


| | | | | | | |
|---------------------------|--------|--------|--------|--|--|--|
| Moisture Ratio | % 98.5 | % 98.5 | % 110 | | | |
| Moisture Variation | % -0.5 | % -0.5 | % 2.0 | | | |
| from OMC | Drier | Drier | Wetter | | | |
| Density Ratio | % 96.5 | % 98.0 | % 98.0 | | | |

| | | | |
|-----------------------|---------------------------------|-------------------------|----------------------|
| Specification: | 95% STD | Test Selection: | N/A |
| Notes: | Ref: 1120 0349-1 (SI18) | | |
| Test Method | AS1289 5.8.1, 5.7.1, 2.1.1, 1.1 | Sampling Method: | AS 1289 1.2.1 6.4(b) |

| | | |
|---|---|---|
|  NATA WORLD RECOGNISED ACCREDITATION | NATA Accredited Laboratory No. 20172 Accreditation for compliance with ISO/IEC 17025 - Testing | Approved Signatory:  Date: 09/03/2023 |
| | | |



Test Location

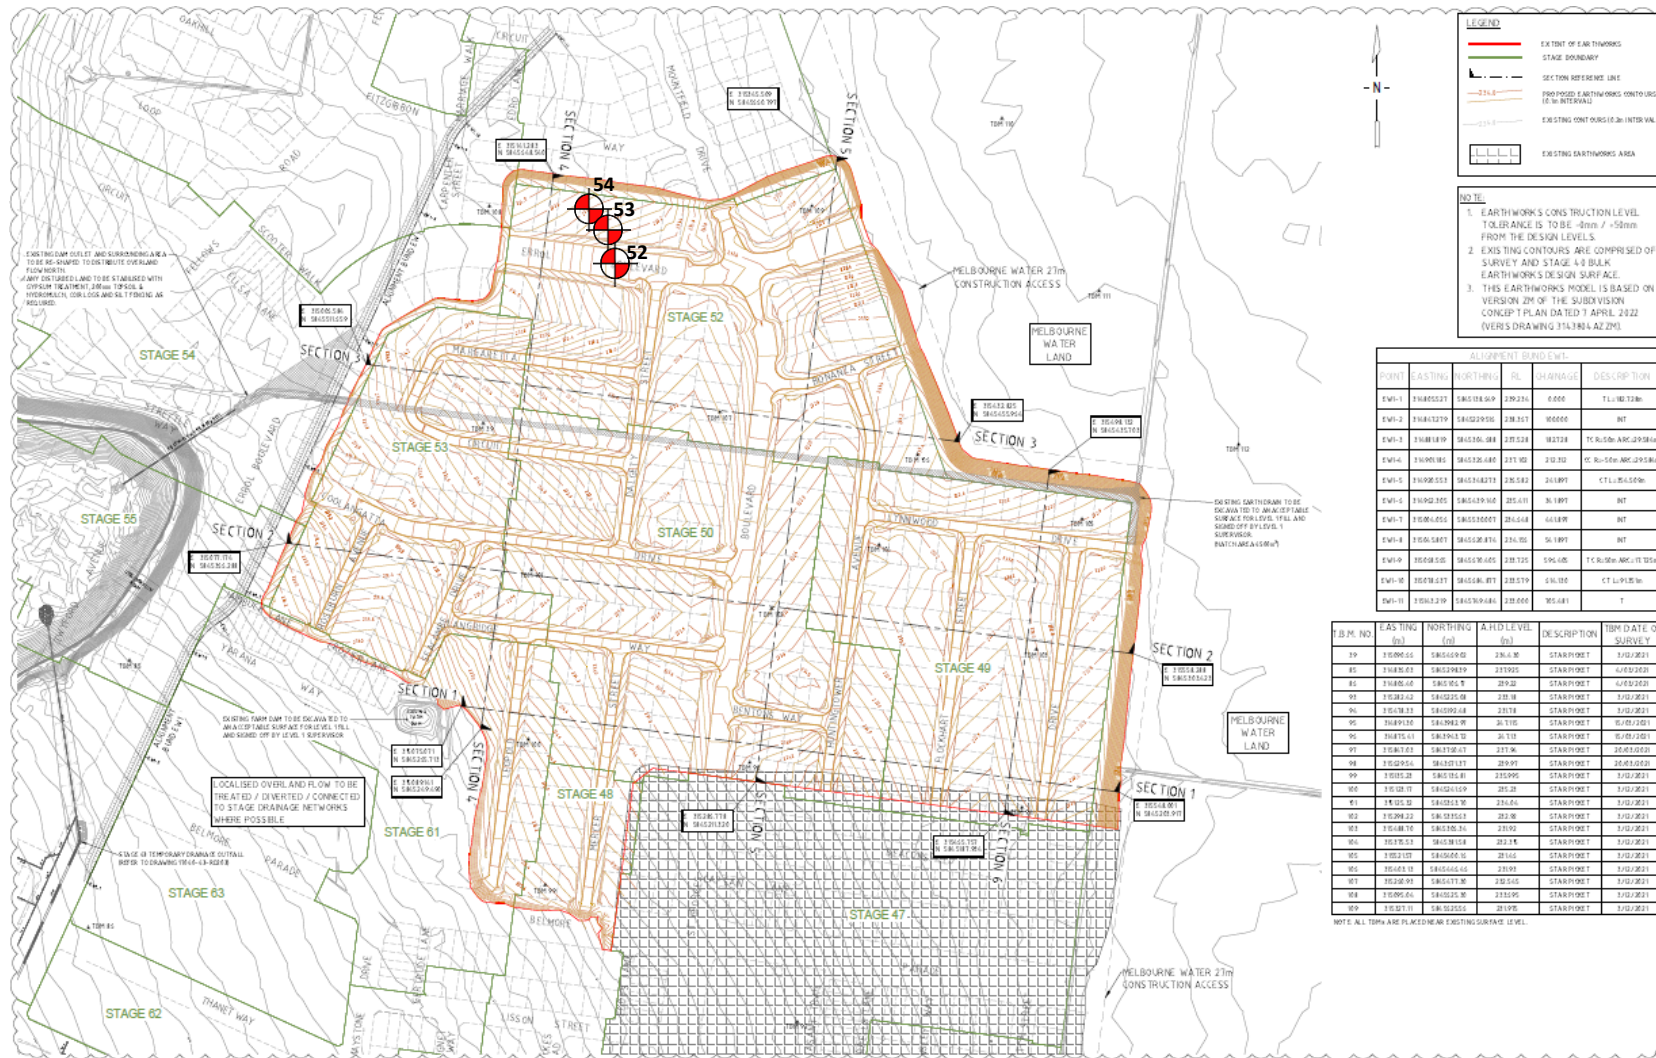

| | | | | | | | |
|-------------|--|---------|--|---|--|-------------------------------|--|
| T. MUSTAC | | 1:1,000 | | merrifield | | HUME CITY COUNCIL | |
| P. MASEMANN | | DATE | | MAB gpc | | PROJECT | |
| G. ROMANOV | | DATE | | verve | | MERRIFIELD LIVING - SECTION E | |
| | | | | Ground Floor, 307-323 Waverley Road, Mickleham VIC 3145 | | BULK EARTHWORKS - STAGE 49-53 | |
| | | | | TEL: 03 8373 1500 verveprojects.com | | MICKLEHAM | |
| | | | | © Verve Projects Pty Ltd. | | CONSTRUCTION | |
| | | | | | | 366 F1 | |
| | | | | | | 17040-49 | |
| | | | | | | EW201 | |

PROJECT:
Merrifield Estate – Stage 52 (Level 1)

LOCATION:
Mickleham

CLIENT:
BMD Urban

PROJECT No:
1120 0349-1 (SI18)

DATE:
02/03/2023

SITE PLAN SKETCH—NOT TO SCALE



Field Density Test Results AS1289.5.7.1

A & Y Associates Pty Ltd
5/16 Network Drive
Truganina VIC 3029
PH: 0400 413 531
info@ayassociates.com.au

| | | | | | | |
|------------------|--|--|--|----------------|---------|--|
| Client: | BMD Urban | | | Job No: | BMD2365 | |
| Project: | Merrifield Estate - Stage 52 (Level 1) | | | Report: | 19 | |
| Location: | Mickleham | | | | | |



| | | | | | | |
|-------------|------------|------------|------------|--|--|--|
| Sample No | 55 | 56 | 57 | | | |
| Date Tested | 03/03/2023 | 03/03/2023 | 03/03/2023 | | | |
| Time Tested | AM | AM | AM | | | |

| | | | | | | |
|------------------------|-----------------------|---------------|---------------|--|--|--|
| Test Location | Refer to Plan | Refer to Plan | Refer to Plan | | | |
| Level/Layer | 2 | 3 | 3 | | | |
| Layer Thickness | mm 200 | 200 | 200 | | | |
| Test Depth | mm 175 | 175 | 175 | | | |
| Field Wet Density | t/m ³ 1.92 | 2.00 | 1.99 | | | |
| Field Moisture Content | % 22.7 | 20.1 | 20.6 | | | |
| Material: | Imported Clay | Imported Clay | Imported Clay | | | |

| | | | | | | |
|----------------------------|------------------|------|------|------|--|--|
| Oversize Material | WET, % | 4.2 | 5.9 | 5.4 | | |
| Sieve Size | mm | 19 | 19 | 19 | | |
| Peak Converted Wet Density | t/m ³ | 1.98 | 2.07 | 2.03 | | |
| Optimum Moisture Content | % | 21 | 18 | 21 | | |


| | | | | | | |
|---------------------------|---|--------|--------|-------|--|--|
| Moisture Ratio | % | 108 | 111.5 | 98 | | |
| Moisture Variation | % | 1.5 | 2.0 | -0.5 | | |
| from OMC | | Wetter | Wetter | Drier | | |
| Density Ratio | % | 96.5 | 96.0 | 97.5 | | |

| | | | |
|-----------------------|---------------------------------|-------------------------|----------------------|
| Specification: | 95% STD | Test Selection: | N/A |
| Notes: | Ref: 1120 0349-1 (SI19) | | |
| Test Method | AS1289 5.8.1, 5.7.1, 2.1.1, 1.1 | Sampling Method: | AS 1289 1.2.1 6.4(b) |

| | | |
|---|---|---|
|  NATA WORLD RECOGNISED ACCREDITATION | NATA Accredited Laboratory No. 20172 Accreditation for compliance with ISO/IEC 17025 - Testing | Approved Signatory:  Date: 30/03/2023 |
| | | |



Test Location

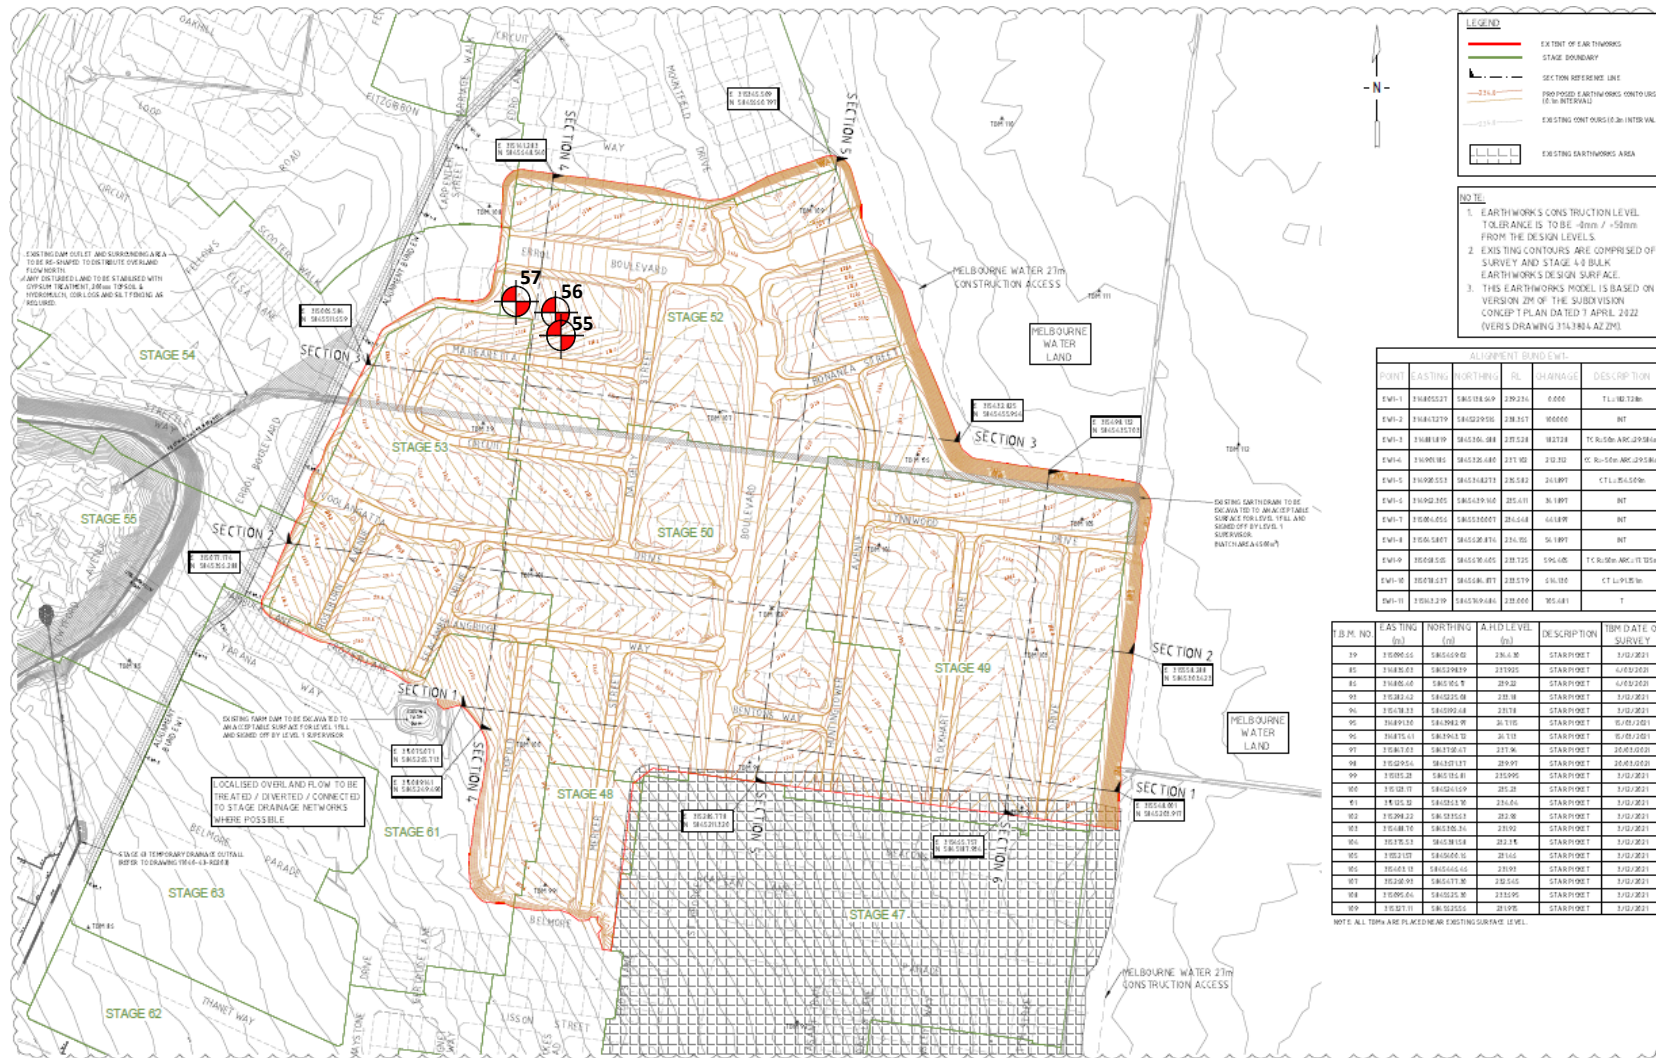

| | | | | | | | |
|-------------|--|---------|--|---|--|-------------------------------|--|
| T. MUSTAC | | 1:1,000 | | merrifield | | HUME CITY COUNCIL | |
| P. MASEMANN | | DATE | | MAB gpc | | MERRIFIELD LIVING - SECTION E | |
| G. ROMANOV | | DATE | | Ground Floor, 307-323 Waverley Road, Mickleham VIC 3445 | | BULK EARTHWORKS - STAGE 49-53 | |
| | | | | TEL: 03 8373 1500 | | MICKLEHAM | |
| | | | | © Verve Projects Pty Ltd. | | CONSTRUCTION | |
| | | | | | | 366 F1 | |
| | | | | | | 17040-49 | |
| | | | | | | EW201 | |

PROJECT:
Merrifield Estate – Stage 52 (Level 1)

LOCATION:
Mickleham

CLIENT:
BMD Urban

PROJECT No:
1120 0349-1 (SI19)

DATE:
03/03/2023

SITE PLAN SKETCH—NOT TO SCALE



Field Density Test Results AS1289.5.7.1

A & Y Associates Pty Ltd
5/16 Network Drive
Truganina VIC 3029
PH: 0400 413 531
info@ayassociates.com.au

| | | | | | | |
|------------------|--|--|--|----------------|---------|--|
| Client: | BMD Urban | | | Job No: | BMD2365 | |
| Project: | Merrifield Estate - Stage 52 (Level 1) | | | Report: | 20 | |
| Location: | Mickleham | | | | | |



| | | | | | | |
|-------------|------------|------------|------------|--|--|--|
| Sample No | 58 | 59 | 60 | | | |
| Date Tested | 06/03/2023 | 06/03/2023 | 06/03/2023 | | | |
| Time Tested | AM | AM | AM | | | |

| | | | | | | |
|------------------------|-----------------------|-----------------------|-----------------------|--|--|--|
| Test Location | Refer to Plan | Refer to Plan | Refer to Plan | | | |
| Level/Layer | 4 | 4 | 4 | | | |
| Layer Thickness | mm 200 | mm 200 | mm 200 | | | |
| Test Depth | mm 175 | mm 175 | mm 175 | | | |
| Field Wet Density | t/m ³ 1.93 | t/m ³ 1.85 | t/m ³ 1.88 | | | |
| Field Moisture Content | % 22.7 | % 24.8 | % 23.2 | | | |
| Material: | Imported Clay | Imported Clay | Imported Clay | | | |

| | | | | | | |
|----------------------------|-----------------------|-----------------------|-----------------------|--|--|--|
| Oversize Material | WET, % 4.2 | WET, % 0.0 | WET, % 0.0 | | | |
| Sieve Size | mm 19 | mm 19 | mm 19 | | | |
| Peak Converted Wet Density | t/m ³ 1.99 | t/m ³ 1.91 | t/m ³ 1.92 | | | |
| Optimum Moisture Content | % 23.5 | % 23 | % 21.5 | | | |


| | | | | | | |
|---------------------------|--------|--------|--------|--|--|--|
| Moisture Ratio | % 96.5 | % 108 | % 108 | | | |
| Moisture Variation | % -0.5 | % 2.0 | % 2.0 | | | |
| from OMC | Drier | Wetter | Wetter | | | |
| Density Ratio | % 96.5 | % 96.5 | % 98.0 | | | |

| | | | |
|-----------------------|---------------------------------|-------------------------|----------------------|
| Specification: | 95% STD | Test Selection: | N/A |
| Notes: | Ref: 1120 0349-1 (SI20) | | |
| Test Method | AS1289 5.8.1, 5.7.1, 2.1.1, 1.1 | Sampling Method: | AS 1289 1.2.1 6.4(b) |

| | | |
|---|---|---|
|  NATA WORLD RECOGNISED ACCREDITATION | NATA Accredited Laboratory No. 20172 Accreditation for compliance with ISO/IEC 17025 - Testing | Approved Signatory:  Date: 30/03/2023 |
| | | |



Test Location

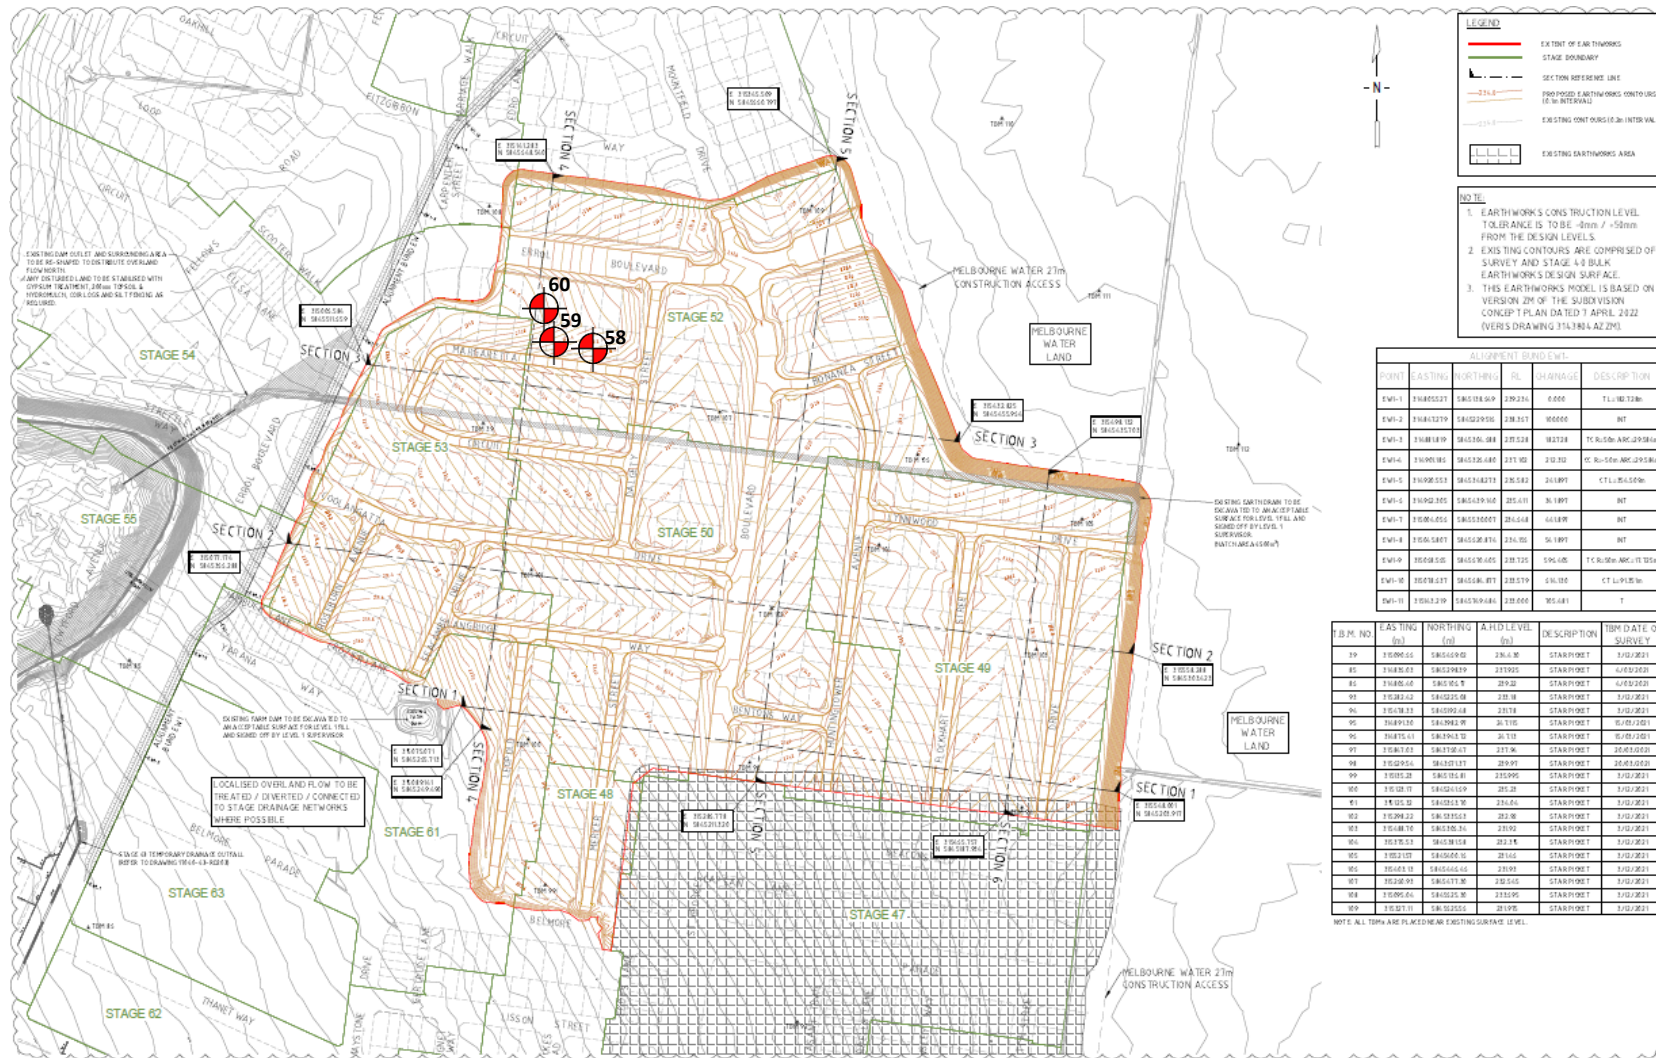

| | | | | | | | |
|-------------|--|---------|--|---|--|-------------------------------|--|
| T. MUSTAC | | 1:1,000 | | merrifield | | HUME CITY COUNCIL | |
| P. MASEMANN | | DATE | | MAB gpc | | PROJECT | |
| G. ROMANOV | | DATE | | Ground Floor, 307-323 Waverley Road, Mickleham VIC 3145 | | MERRIFIELD LIVING - SECTION E | |
| | | | | TEL: 03 8373 1500 verveprojects.com | | BULK EARTHWORKS - STAGE 49-53 | |
| | | | | © Verve Projects Pty Ltd. | | MICKLEHAM | |
| | | | | | | CONSTRUCTION | |
| | | | | | | 366 F1 | |
| | | | | | | 17040-49 | |
| | | | | | | EW201 | |

PROJECT:
Merrifield Estate – Stage 52 (Level 1)

LOCATION:
Mickleham

CLIENT:
BMD Urban

PROJECT No:
1120 0349-1 (S120)

DATE:
06/03/2023

SITE PLAN SKETCH—NOT TO SCALE



Field Density Test Results AS1289.5.7.1

A & Y Associates Pty Ltd
5/16 Network Drive
Truganina VIC 3029
PH: 0400 413 531
info@ayassociates.com.au

| | | | | | | |
|------------------|--|--|--|----------------|---------|--|
| Client: | BMD Urban | | | Job No: | BMD2365 | |
| Project: | Merrifield Estate - Stage 52 (Level 1) | | | Report: | 21 | |
| Location: | Mickleham | | | | | |



| | | | | | | |
|-------------|------------|------------|------------|--|--|--|
| Sample No | 61 | 62 | 63 | | | |
| Date Tested | 08/03/2023 | 08/03/2023 | 08/03/2023 | | | |
| Time Tested | PM | PM | PM | | | |

| | | | | | | |
|------------------------|-----------------------|-----------------------|-----------------------|--|--|--|
| Test Location | Refer to Plan | Refer to Plan | Refer to Plan | | | |
| Level/Layer | 5 | 5 | 5 | | | |
| Layer Thickness | mm 200 | mm 200 | mm 200 | | | |
| Test Depth | mm 175 | mm 175 | mm 175 | | | |
| Field Wet Density | t/m ³ 1.94 | t/m ³ 1.99 | t/m ³ 1.93 | | | |
| Field Moisture Content | % 23.7 | % 21.8 | % 24.1 | | | |
| Material: | Imported Clay | Imported Clay | Imported Clay | | | |

| | | | | | | |
|----------------------------|-----------------------|-----------------------|-----------------------|--|--|--|
| Oversize Material | WET, % 4.0 | WET, % 6.5 | WET, % 3.6 | | | |
| Sieve Size | mm 19 | mm 19 | mm 19 | | | |
| Peak Converted Wet Density | t/m ³ 1.97 | t/m ³ 2.06 | t/m ³ 1.99 | | | |
| Optimum Moisture Content | % 21.5 | % 22.5 | % 22 | | | |


| | | | | | | |
|---------------------------|--------|--------|---------|--|--|--|
| Moisture Ratio | % 110 | % 97 | % 109.5 | | | |
| Moisture Variation | % 2.0 | % -0.5 | % 2.0 | | | |
| from OMC | Wetter | Drier | Wetter | | | |
| Density Ratio | % 98.0 | % 96.0 | % 97.0 | | | |

| | | | |
|-----------------------|---------------------------------|-------------------------|----------------------|
| Specification: | 95% STD | Test Selection: | N/A |
| Notes: | Ref: 1120 0349-1 (SI21) | | |
| Test Method | AS1289 5.8.1, 5.7.1, 2.1.1, 1.1 | Sampling Method: | AS 1289 1.2.1 6.4(b) |

| | | |
|---|---|---|
|  NATA WORLD RECOGNISED ACCREDITATION | NATA Accredited Laboratory No. 20172 Accreditation for compliance with ISO/IEC 17025 - Testing | Approved Signatory:  Date: 30/03/2023 |
| | | |



Test Location

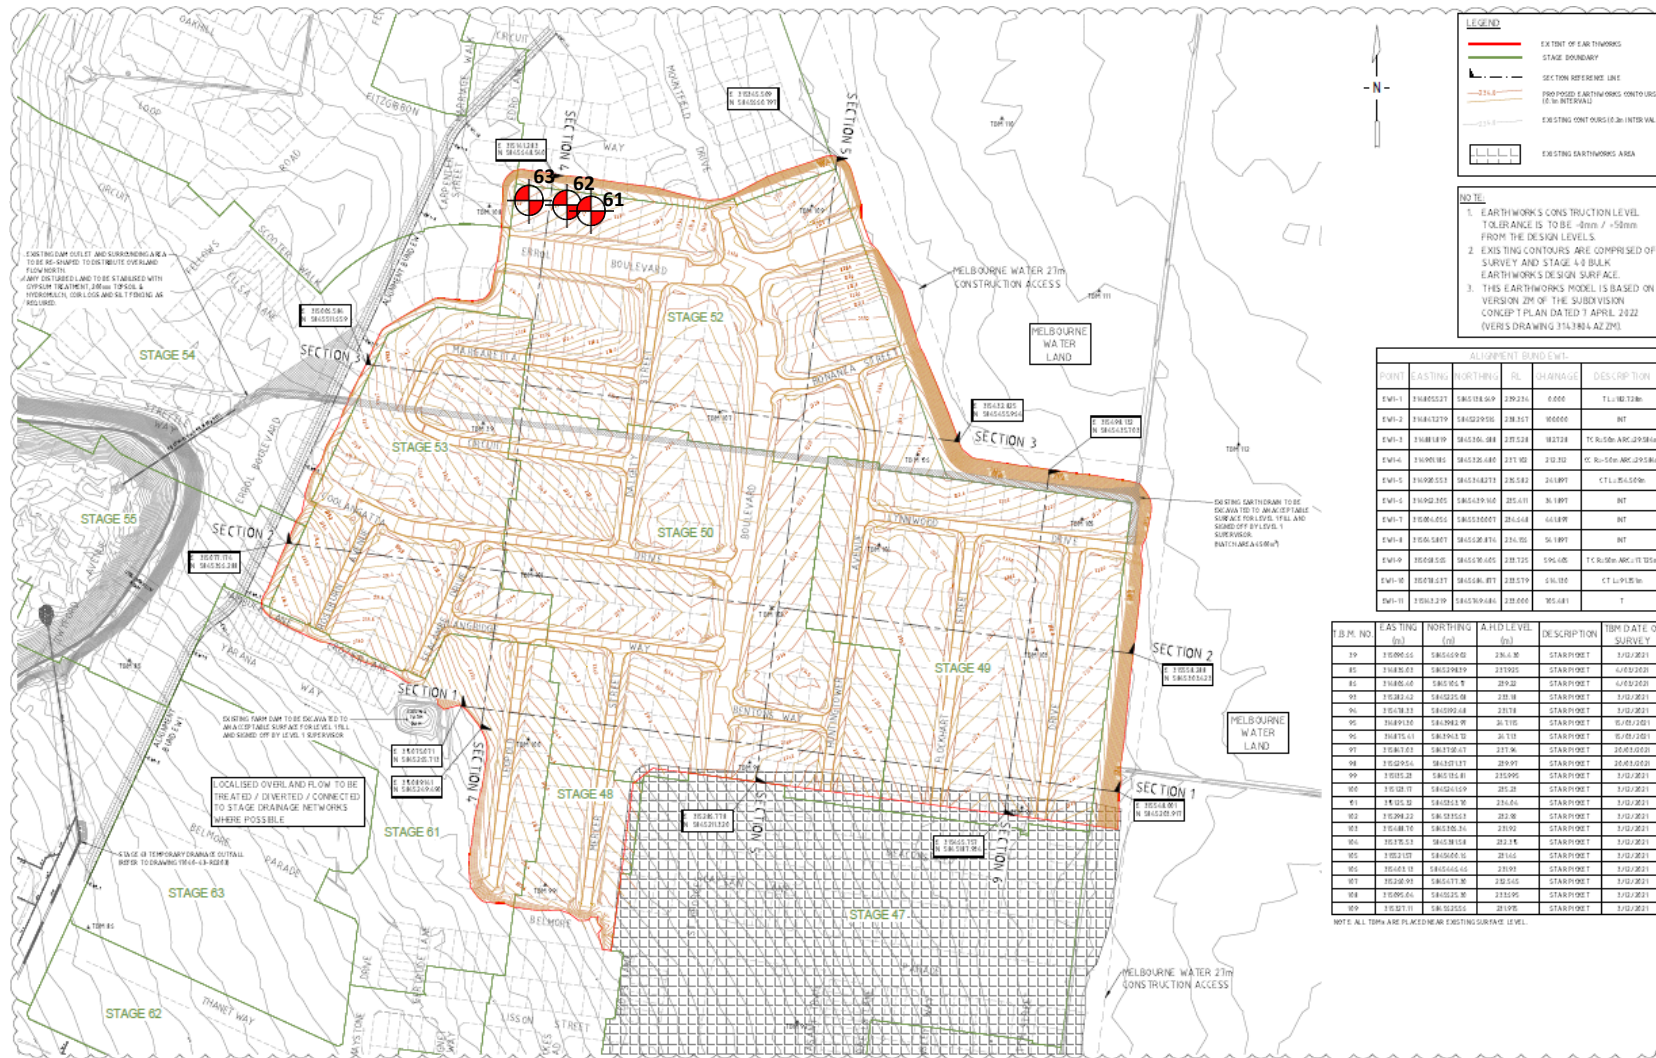

1. CONTINGENCY FUND & NOTES UP DATED, DESIGNED EARTHWORKS NOTED

2. CONSTRUCTION FUND

3. APPROVED

4. DATE

T. MUSTAC

P. MASEMAN

G. ROMANOV

1:1,000

0 10 20 30 40 50

merrifield

MAB gpc

verve

Ground Floor, 307-323 Waverley Road, Malvern East VIC 3145

TEL: 03 8573 1500 verveprojects.com

© Verve Projects Pty Ltd.

HUME CITY COUNCIL

MERRIFIELD LIVING - SECTION E

BULK EARTHWORKS - STAGE 49-53

MICKLEHAM

CONSTRUCTION

366 F1

17040-49

EW201

1

| | | |
|--|-----------------------------------|-------------------------------|
| PROJECT: Merrifield Estate – Stage 52 (Level 1) | CLIENT: BMD Urban | DATE: 08/03/2023 |
| LOCATION: Mickleham | PROJECT No: 1120 0349-1 (SI21) | SITE PLAN SKETCH—NOT TO SCALE |



Field Density Test Results AS1289.5.7.1

A & Y Associates Pty Ltd
5/16 Network Drive
Truganina VIC 3029
PH: 0400 413 531
info@ayassociates.com.au

| | | | | | | |
|------------------|--|--|--|----------------|---------|--|
| Client: | BMD Urban | | | Job No: | BMD2365 | |
| Project: | Merrifield Estate - Stage 52 (Level 1) | | | Report: | 22 | |
| Location: | Mickleham | | | | | |


| | | | | | | |
|-------------|------------|------------|------------|--|--|--|
| Sample No | 64 | 65 | 66 | | | |
| Date Tested | 09/03/2023 | 09/03/2023 | 09/03/2023 | | | |
| Time Tested | PM | PM | PM | | | |

| | | | | | | |
|------------------------|-----------------------|-----------------------|-----------------------|--|--|--|
| Test Location | Refer to Plan | Refer to Plan | Refer to Plan | | | |
| Level/Layer | 6 | 6 | 6 | | | |
| Layer Thickness | mm 200 | mm 200 | mm 200 | | | |
| Test Depth | mm 175 | mm 175 | mm 175 | | | |
| Field Wet Density | t/m ³ 1.98 | t/m ³ 1.93 | t/m ³ 1.91 | | | |
| Field Moisture Content | % 23.4 | % 23.8 | % 24.3 | | | |
| Material: | Imported Clay | Imported Clay | Imported Clay | | | |

| | | | | | | |
|----------------------------|------------------|------|------|------|--|--|
| Oversize Material | WET, % | 5.7 | 4.1 | 3.6 | | |
| Sieve Size | mm | 19 | 19 | 19 | | |
| Peak Converted Wet Density | t/m ³ | 2.01 | 1.99 | 1.96 | | |
| Optimum Moisture Content | % | 24 | 24.5 | 22.5 | | |


| | | | | | | |
|---------------------------|---|-------|-------|--------|--|--|
| Moisture Ratio | % | 97.5 | 97 | 108 | | |
| Moisture Variation | % | -0.5 | -0.5 | 2.0 | | |
| from OMC | | Drier | Drier | Wetter | | |
| Density Ratio | % | 97.5 | 96.5 | 97.0 | | |

| | | | |
|-----------------------|---------------------------------|-------------------------|----------------------|
| Specification: | 95% STD | Test Selection: | N/A |
| Notes: | Ref: 1120 0349-1 (SI22) | | |
| Test Method | AS1289 5.8.1, 5.7.1, 2.1.1, 1.1 | Sampling Method: | AS 1289 1.2.1 6.4(b) |



NATA
WORLD RECOGNISED
ACCREDITATION


NATA Accredited Laboratory No. 20172
Accreditation for compliance with ISO/IEC 17025 - Testing

Approved Signatory: 

David Burns
Date: 30/03/2023



Test Location

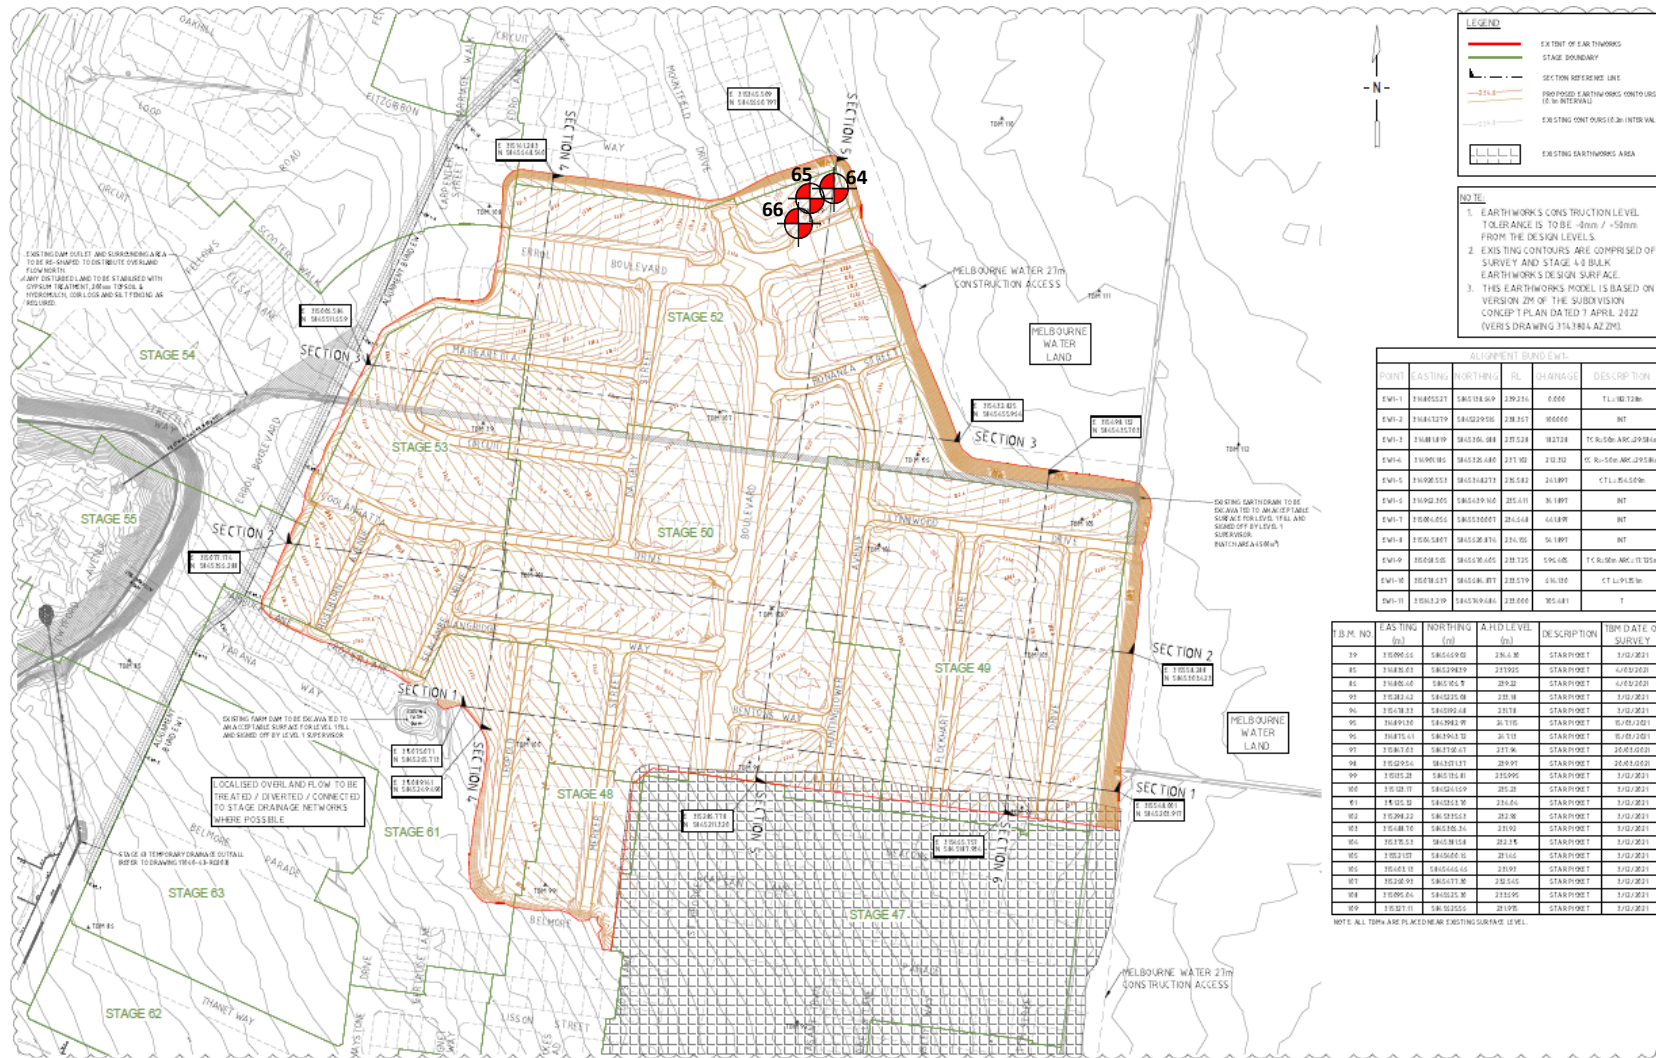

1. CONTINGENT BOUNDARY & NOTES UP DATED, DESIGNED EARTHWORKS NOTED

2. CONSTRUCTION ISSUE

DATE: 10/03/23

DATE: 02/03/23

APPROVED: T. MUSTAC

APPROVED: P. MASEMANN

APPROVED: G. ROMANOV

merrifield

MAB gpc

verve

Ground Floor, 307-323 Waverley Road, Mickleham VIC 3145
TEL: 03 8373 1500 | verveprojects.com | © Verve Projects Pty Ltd.

HUME CITY COUNCIL

MERRIFIELD LIVING - SECTION E
BULK EARTHWORKS - STAGE 49-53
MICKLEHAM

CONSTRUCTION

366 F1

17040-49

EW201

1

| | | |
|--|-----------------------------------|-------------------------------|
| PROJECT: Merrifield Estate – Stage 52 (Level 1) | CLIENT: BMD Urban | DATE: 09/03/2023 |
| LOCATION: Mickleham | PROJECT No: 1120 0349-1 (SI22) | SITE PLAN SKETCH—NOT TO SCALE |



Field Density Test Results AS1289.5.7.1

A & Y Associates Pty Ltd
5/16 Network Drive
Truganina VIC 3029
PH: 0400 413 531
info@ayassociates.com.au

| | | | | | | |
|------------------------------------|--|-----------------------|-----------------------|----------------|---------|--|
| Client: | BMD Urban | | | Job No: | BMD2365 | |
| Project: | Merrifield Estate - Stage 52 (Level 1) | | | Report: | 23 | |
| Location: | Mickleham | | | | | |
| Sample No | 67 | 68 | 69 | | | |
| Date Tested | 20/03/2023 | 20/03/2023 | 20/03/2023 | | | |
| Time Tested | PM | PM | PM | | | |
| Test Location | Refer to Plan | Refer to Plan | Refer to Plan | | | |
| Level/Layer | 7 | 7 | 7 | | | |
| Layer Thickness | mm 200 | mm 200 | mm 200 | | | |
| Test Depth | mm 175 | mm 175 | mm 175 | | | |
| Field Wet Density | t/m ³ 1.94 | t/m ³ 1.90 | t/m ³ 1.85 | | | |
| Field Moisture Content | % 22.7 | % 23.3 | % 24.3 | | | |
| Material: | Imported Clay | Imported Clay | Imported Clay | | | |
| Oversize Material | WET, % 4.7 | WET, % 2.2 | WET, % 0.0 | | | |
| Sieve Size | mm 19 | mm 19 | mm 19 | | | |
| Peak Converted Wet Density | t/m ³ 1.96 | t/m ³ 1.92 | t/m ³ 1.91 | | | |
| Optimum Moisture Content | % 23.5 | % 24 | % 22.5 | | | |
| Moisture Ratio | % 97 | % 97 | % 108 | | | |
| Moisture Variation from OMC | % -0.5 Drier | % -0.5 Drier | % 2.0 Wetter | | | |
| Density Ratio | % 98.0 | % 98.5 | % 97.0 | | | |

| | | | |
|-----------------------|---------------------------------|-------------------------|----------------------|
| Specification: | 95% STD | Test Selection: | N/A |
| Notes: | Ref: 1120 0349-1 (SI23) | | |
| Test Method | AS1289 5.8.1, 5.7.1, 2.1.1, 1.1 | Sampling Method: | AS 1289 1.2.1 6.4(b) |



NATA Accredited Laboratory No. 20172
Accreditation for compliance with ISO/IEC 17025 - Testing


Approved Signatory:



David Burns
Date: 30/03/2023



Test Location

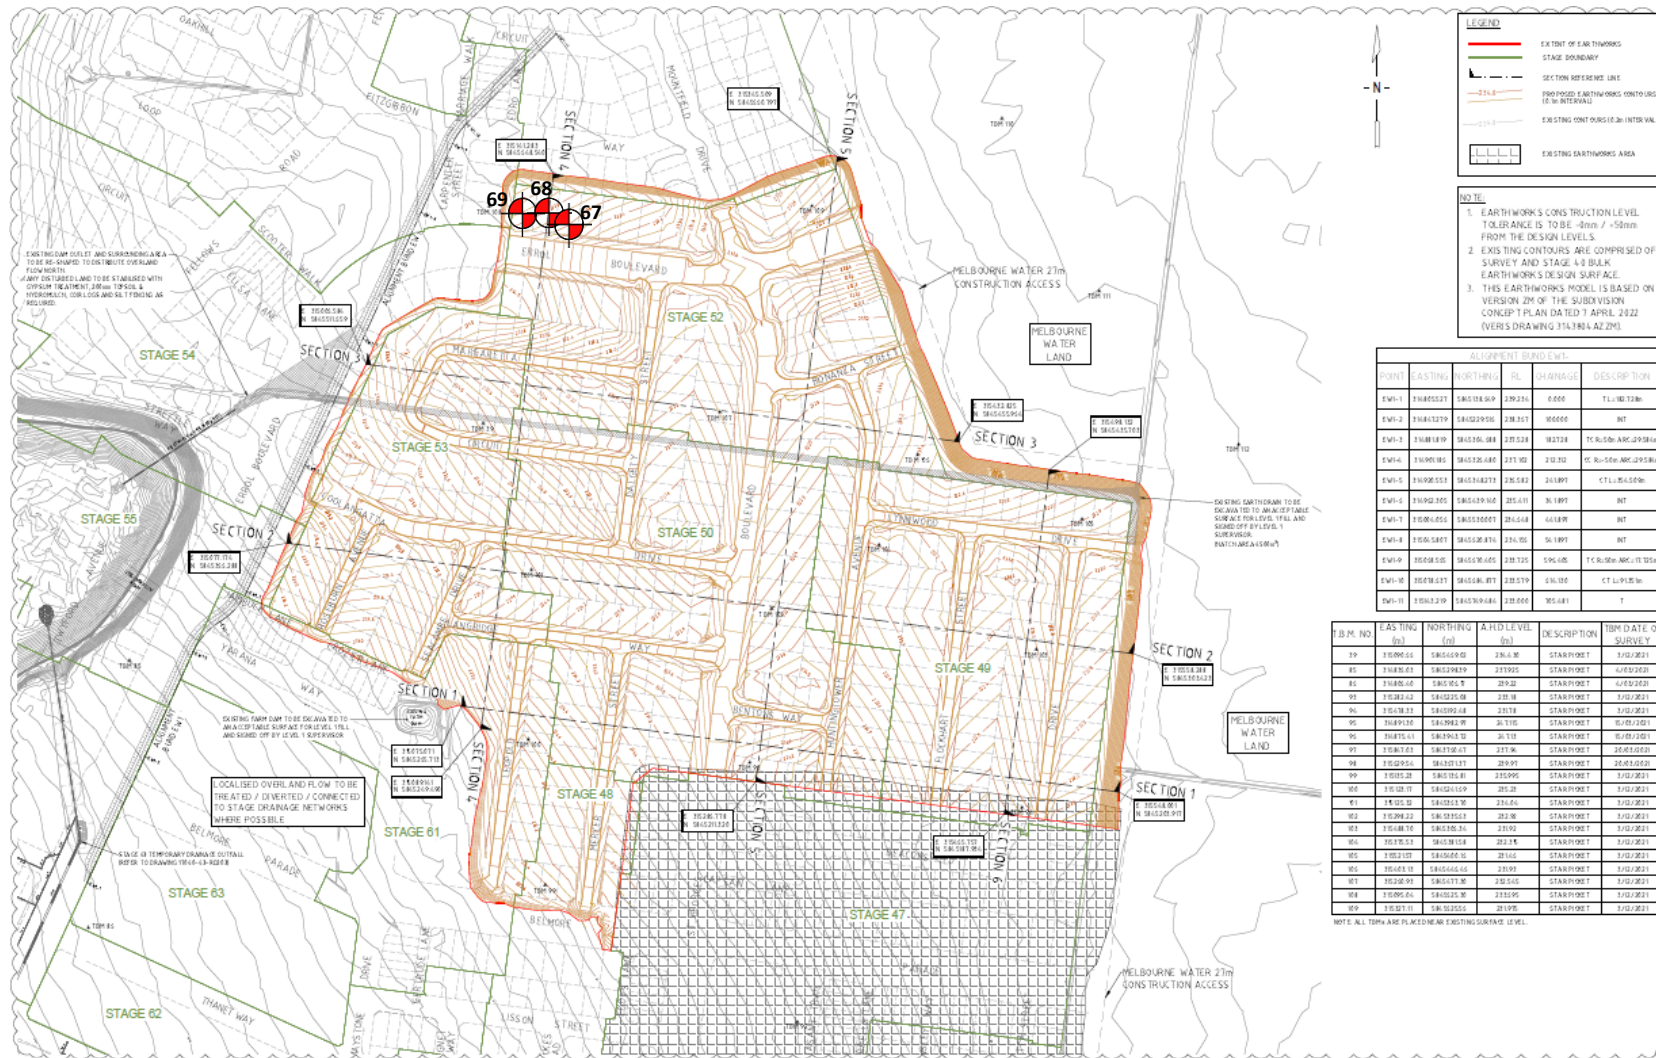

1. CONTINGENT BOUND & NOTES UP DATED, DESIGNED EARTHWORKS NOTED

2. CONSTRUCTION ISSUE

3. APPROVED

4. DATE

T. MUSTAC

P. MASEMANN

G. ROMANOV

1:1,000

0 10 20 30 40 50 60 70 80 90 100

merrifield

MAB gpc

verve

Ground Floor, 307-323 Waverley Road, Mickleham VIC 3145
TEL: 03 8373 1500 | verveprojects.com | © Verve Projects Pty Ltd.

HUME CITY COUNCIL

MERRIFIELD LIVING - SECTION E
BULK EARTHWORKS - STAGE 49-53
MICKLEHAM

CONSTRUCTION

366 F1

17040-49

EW201

1

| | | |
|--|-----------------------------------|-------------------------------|
| PROJECT: Merrifield Estate – Stage 52 (Level 1) | CLIENT: BMD Urban | DATE: 20/03/2023 |
| LOCATION: Mickleham | PROJECT No: 1120 0349-1 (SI23) | SITE PLAN SKETCH—NOT TO SCALE |

